


Col. Center to South = 176.5 FT ✓  
 Granular Backfill for Str = 102.0 FT ✓  
 Unclassified Channel Exc = 106.1 FT ✓  
 Stone Fill, type III = 49.9 FT ✓  
 Geo. Drain Stone Fill = 22.5' ✓ 6/26/15  
 JFB 7-1-15

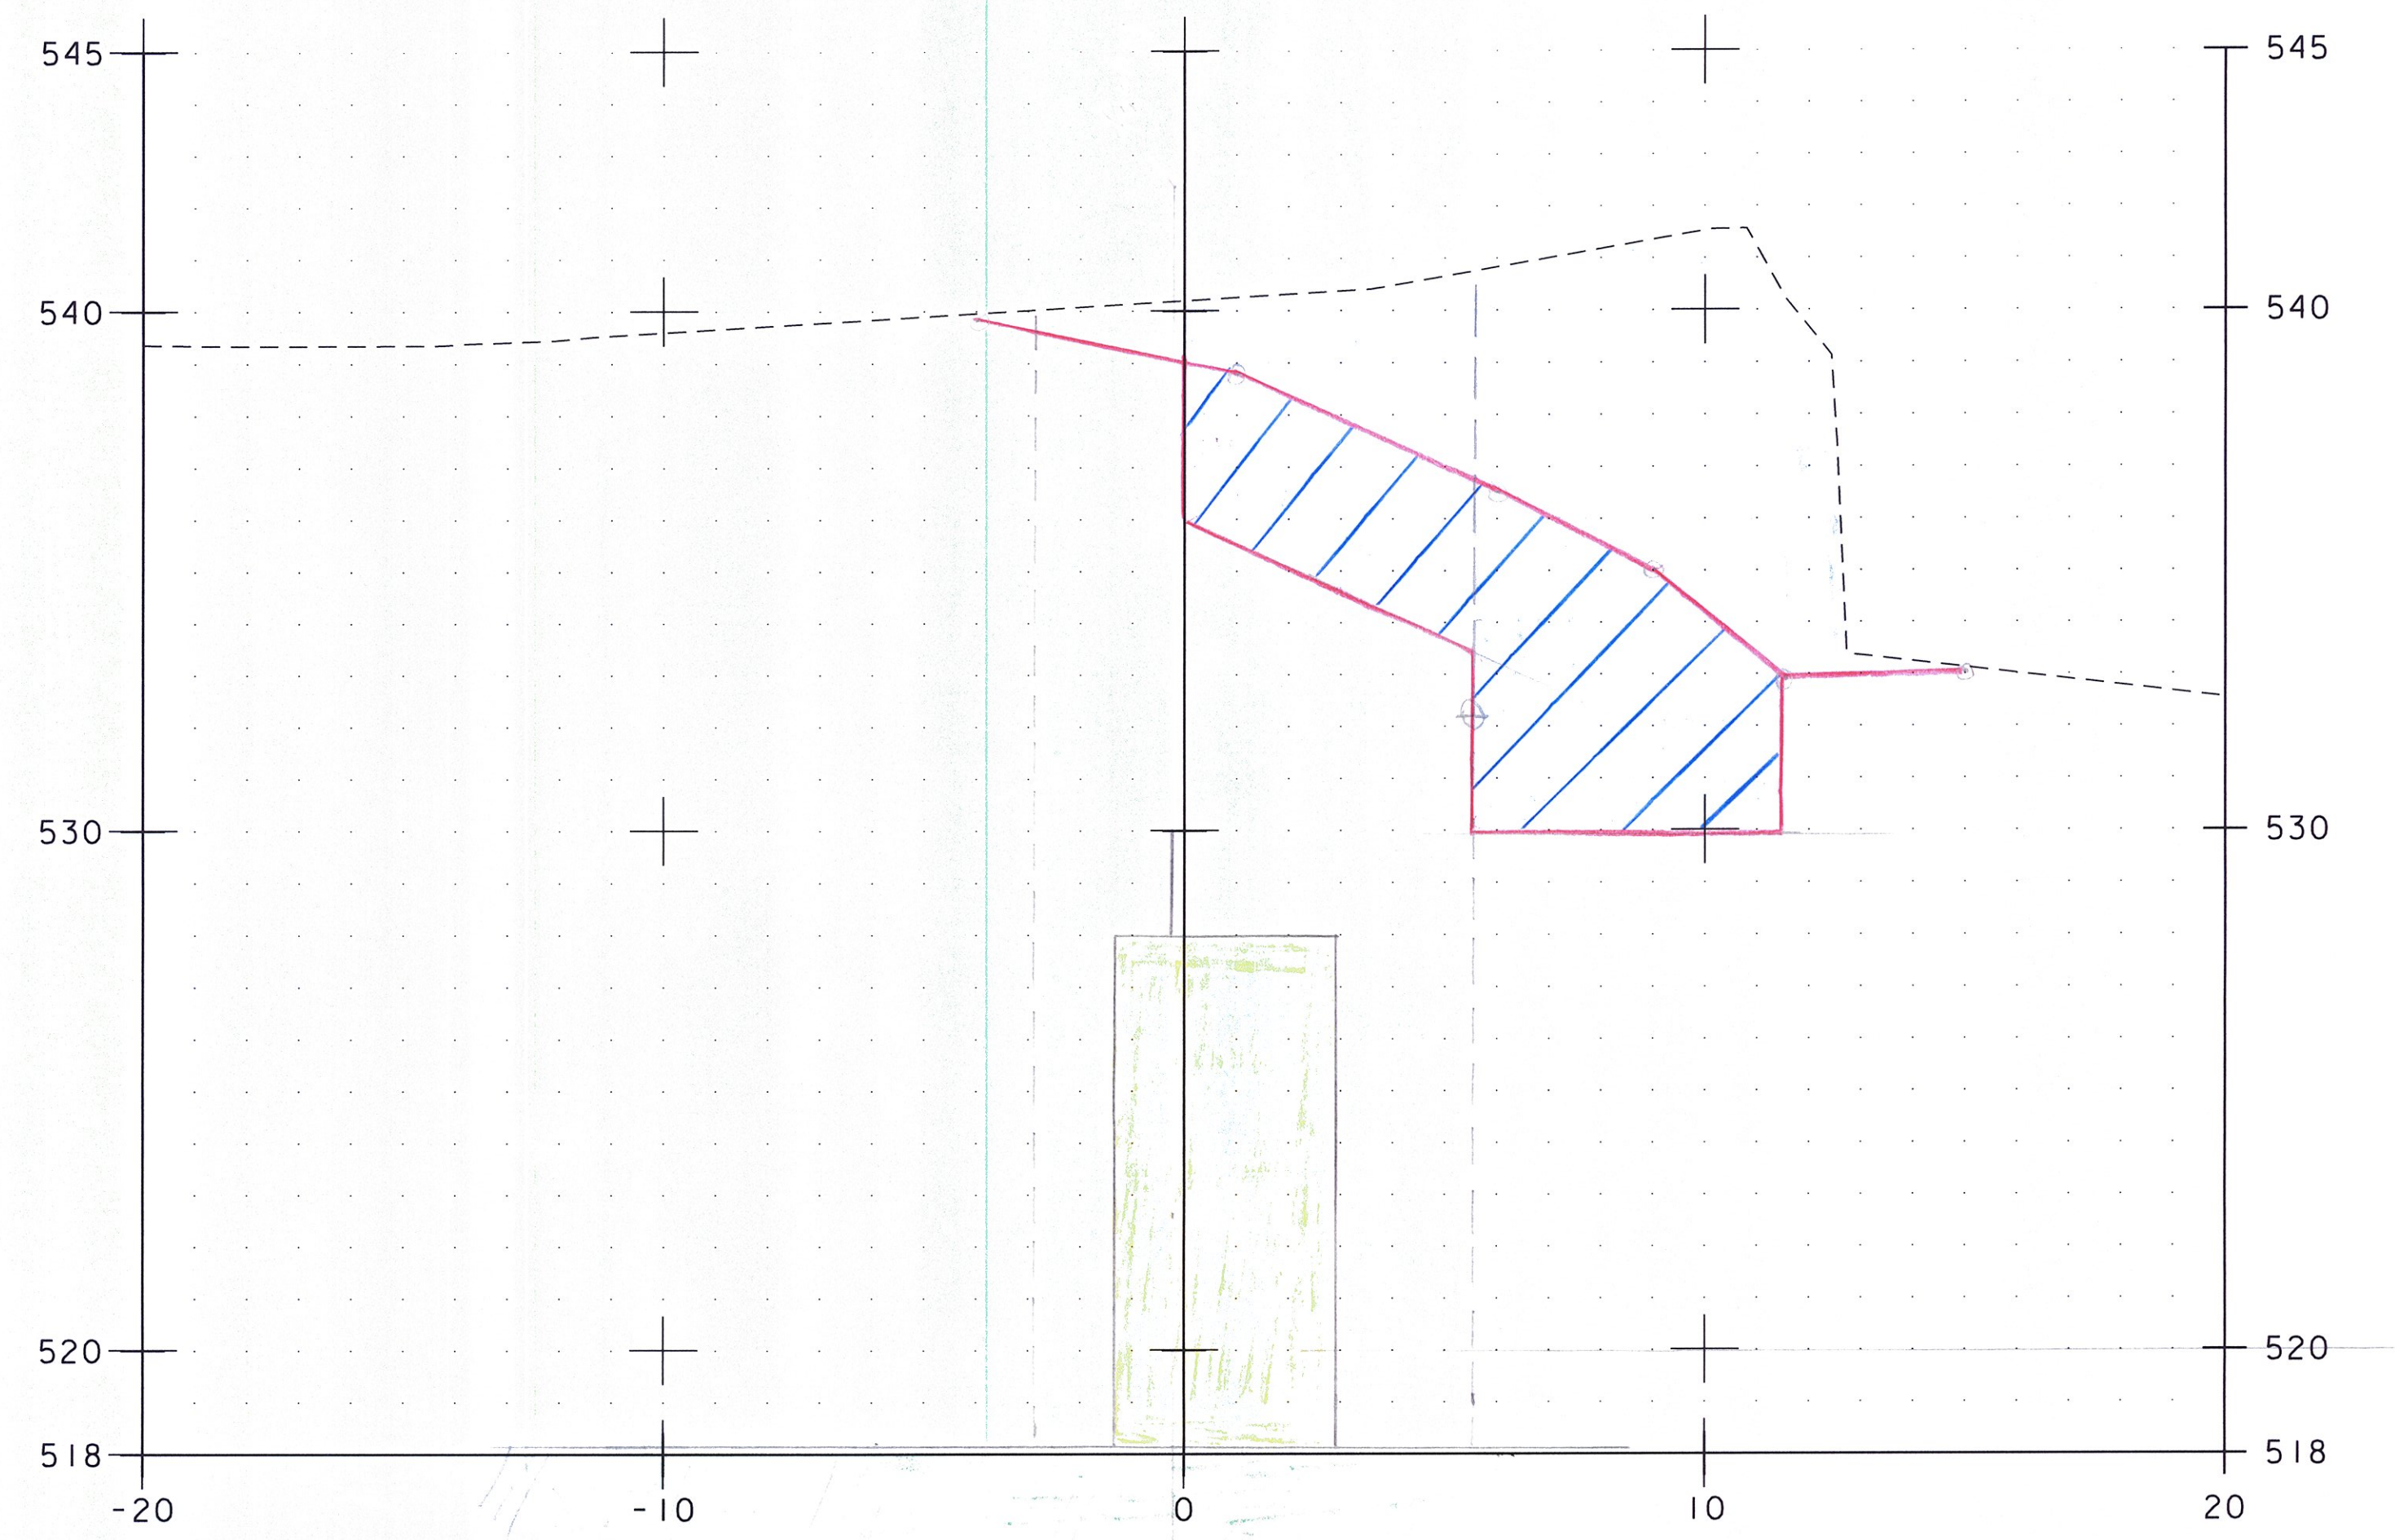

Col. Center to South = 154.3 FT ✓  
 Granular Backfill for Str = 112.7 FT ✓  
 Unclassified Channel Exc = 105.0 FT ✓  
 Stone Fill, type III = 42.2 FT ✓  
 Geo. Drain Stone Fill = 21.5' ✓ M.W.H. 6/26/15  
 JFB 7-1-15

NOTE: LOCATION OF SUBBASE IS APPROXIMATE, PROPOSED GRADE IS NOT SHOWN.

PROJECT NAME: BRATTLEBORO	
PROJECT NUMBER: BRO 1442(35)	
FILE NAME: z10j062_customEL.dgn	PLOT DATE: 3/2/2015
PROJECT LEADER: S.E. BURBANK	DRAWN BY: E.F. LAWES
DESIGNED BY: E.F. LAWES	CHECKED BY: S.E. BURBANK
ABUTMENT NO. 2 CROSS SECTIONS (7 OF 9)	SHEET 7 OF 28

SCALE 1" = 3'-0"

