


STATE OF VERMONT
AGENCY OF TRANSPORTATION



PROPOSED IMPROVEMENT
BRIDGE PROJECT
TOWN OF GUILFORD
COUNTY OF WINDHAM

ROUTE: T.H. 10, CLASS III (LOCAL ROAD), BRIDGE NO. 65

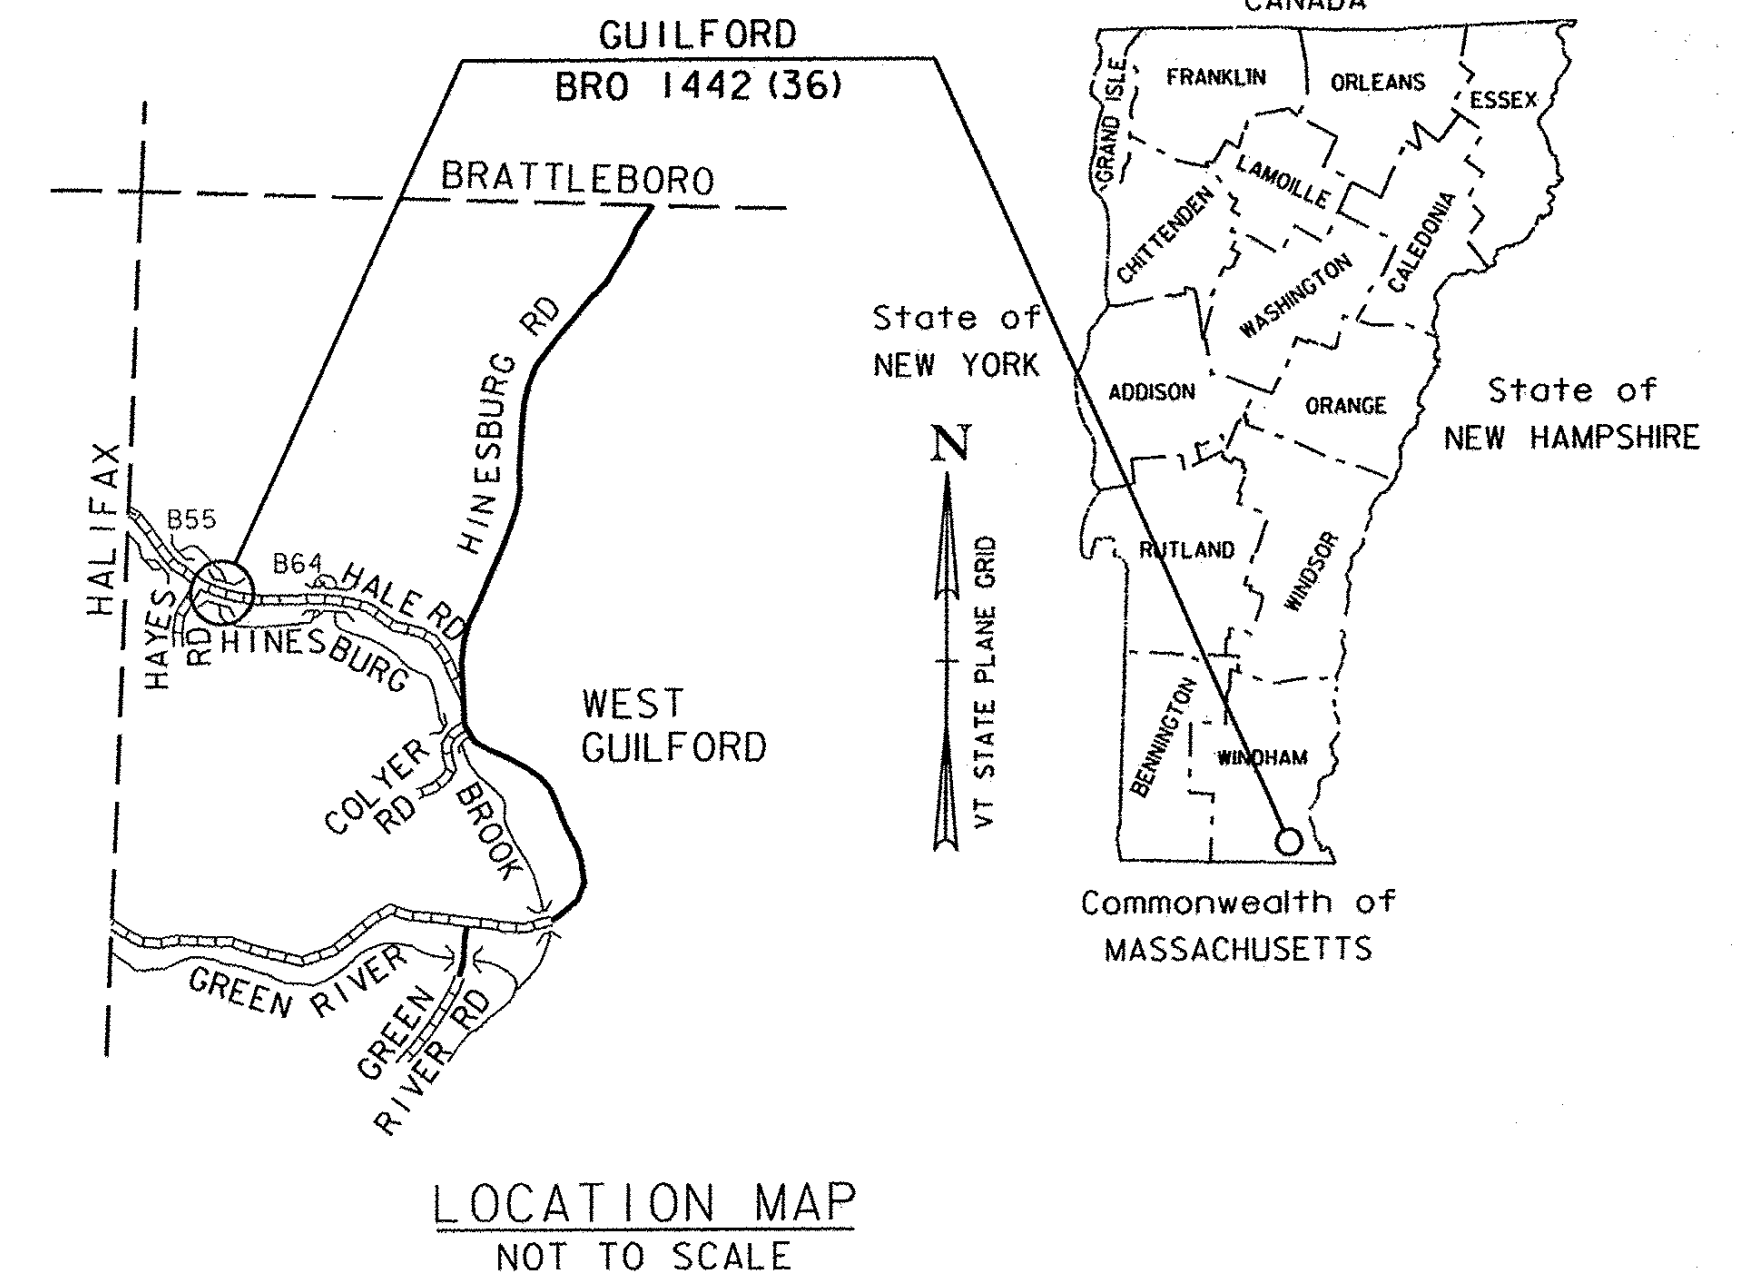

RECORD PLANS

CONTRACTOR: RENAUD BROTHERS, INC. - VERNON, VT

RESIDENT ENGINEER: FRED ROSS

CONSTRUCTION BEGAN: APRIL 1, 2014

CONSTRUCTION COMPLETE: OCTOBER 15, 2014

RECORD PLANS BY: FRED ROSS & JENNA HYDE

I HEREBY CERTIFY THAT ALL THE CONSTRUCTION REQUIRED BY THIS SET OF DRAWINGS HAS BEEN ACCOMPLISHED AS INDICATED HEREIN.



BY *[Signature]* RESIDENT ENGINEER
DATE 2/1/16 FOR FRED ROSS

NOTE: Any further information concerning final quantities, amounts or other details relative to this project may be found at Central Files in the electronic archives.

PROJECT LOCATION: LOCATED IN THE COUNTY OF WINDHAM, TOWN OF GUILFORD, ON HALE ROAD (T.H. 10); BRIDGE NO. 65 OVER HINESBURG BROOK, APPROXIMATELY 0.90 MILES NORTHWESTERLY OF THE INTERSECTION OF HINESBURG ROAD (T.H. 2) AND HALE ROAD (T.H. 10).

LENGTH OF ROADWAY: 182.00 FEET
LENGTH OF BRIDGE: 58.19 FEET
LENGTH OF PROJECT: 240.19 FEET



PROJECT DESCRIPTION: WORK TO BE PERFORMED UNDER THIS PROJECT INCLUDES REMOVAL AND REPLACEMENT OF BRIDGE NO. 65, ON THE EXISTING ALIGNMENT, WITH ASSOCIATED ROADWAY AND CHANNEL WORK.

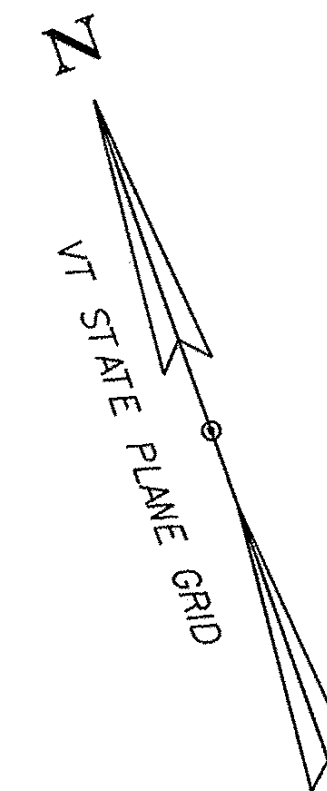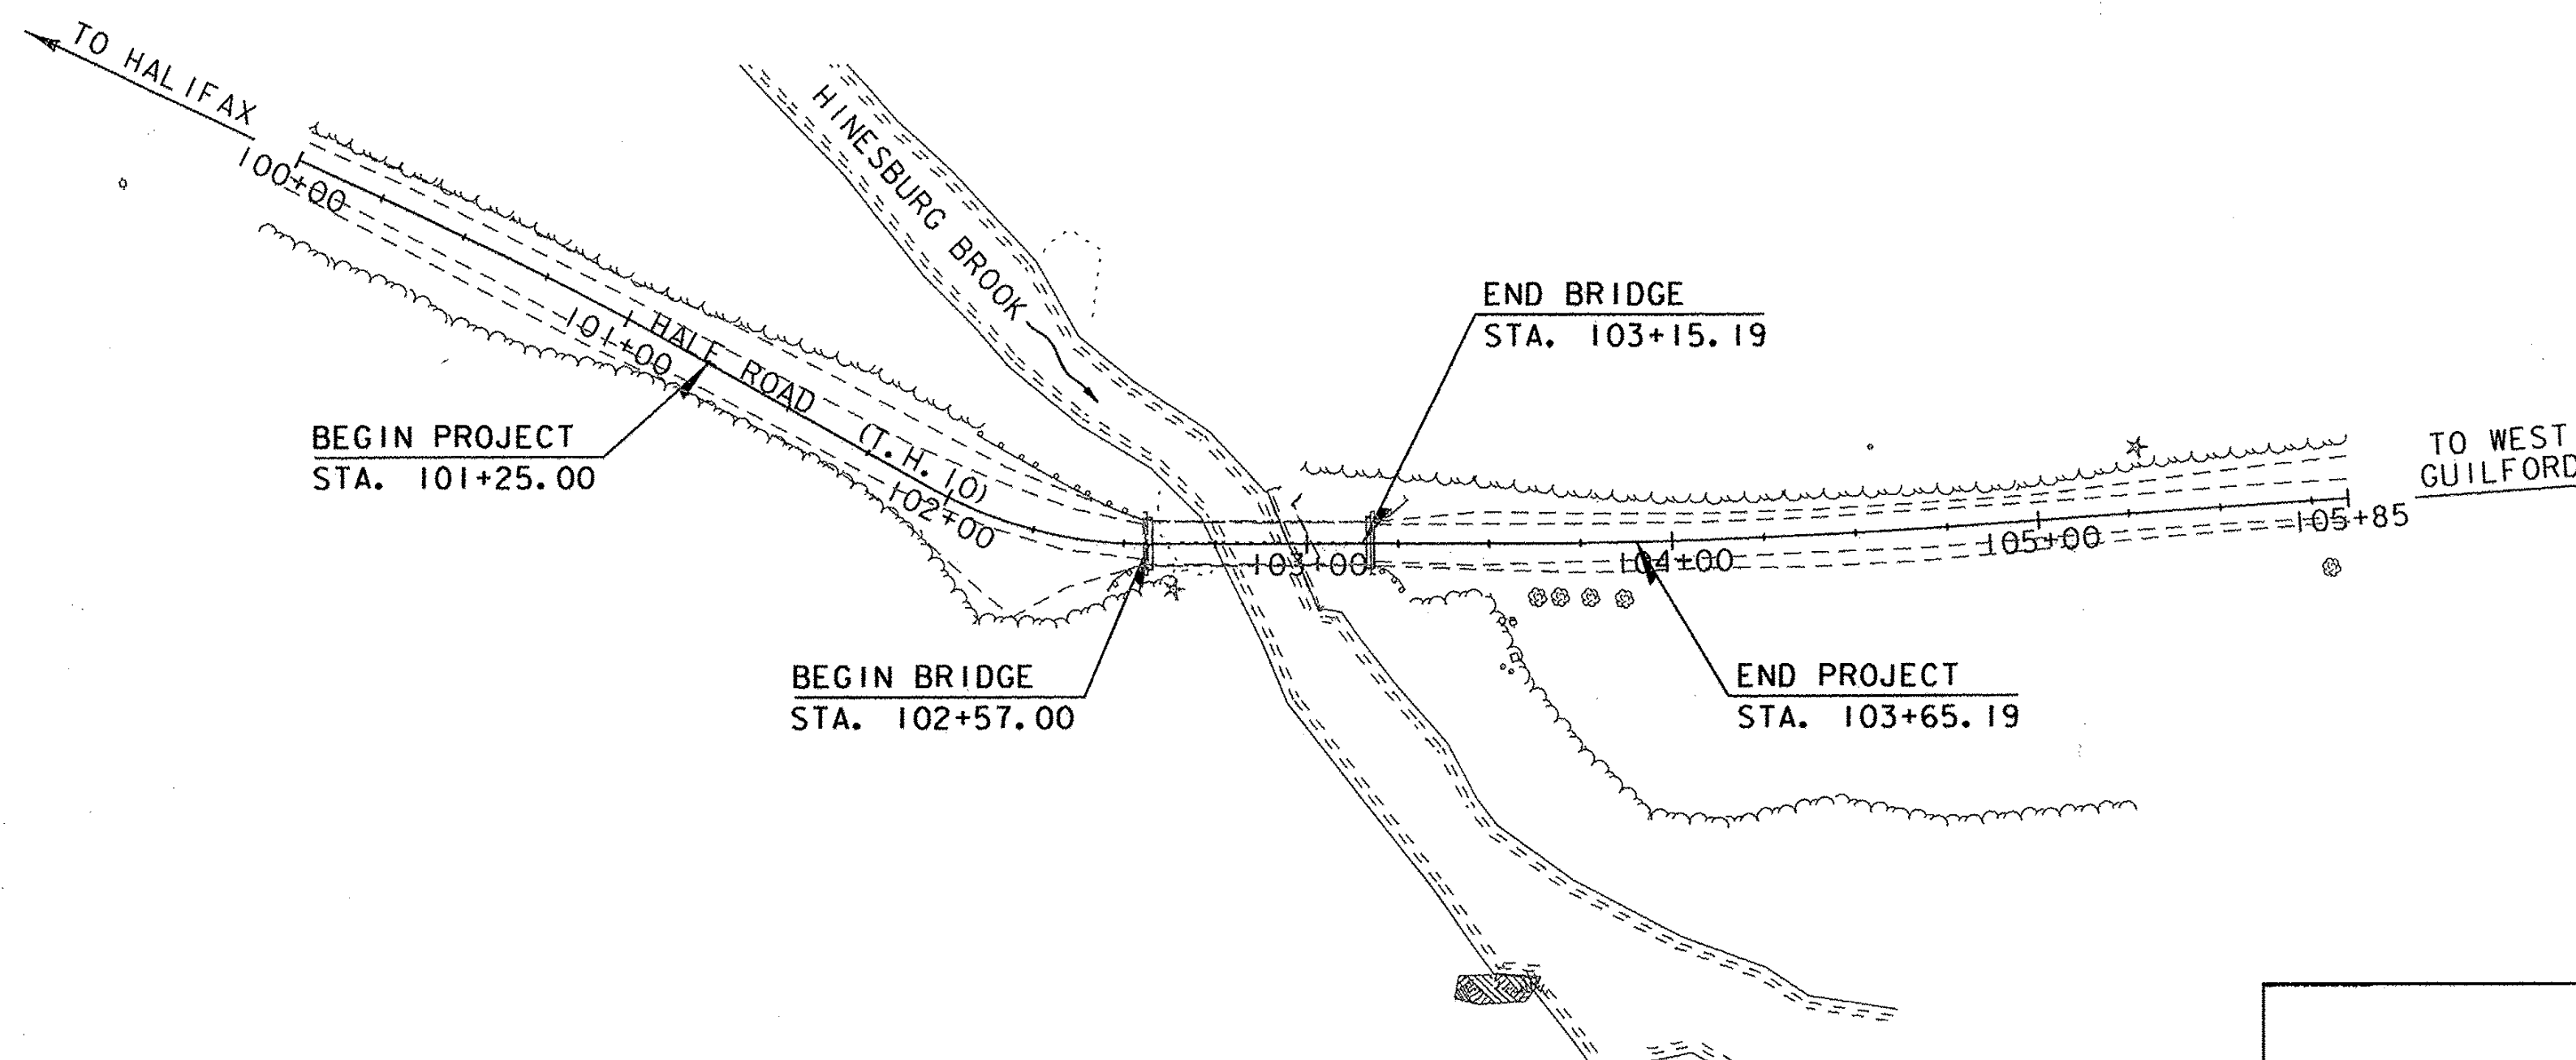

THESE PLANS ARE SUBJECT TO SUCH ENGINEERING CHANGES AS MAY BE REQUIRED BY THE FEDERAL HIGHWAY ADMINISTRATION OR THE DIRECTOR OF PROGRAM DEVELOPMENT.

CONSTRUCTION IS TO BE CARRIED ON IN ACCORDANCE WITH THESE PLANS AND THE STANDARD SPECIFICATIONS FOR CONSTRUCTION DATED 2011, AS APPROVED BY THE FEDERAL HIGHWAY ADMINISTRATION ON JULY 20, 2011 FOR USE ON THIS PROJECT, INCLUDING ALL SUBSEQUENT REVISIONS AND SUCH REVISED SPECIFICATIONS AND SPECIAL PROVISIONS AS ARE INCORPORATED IN THESE PLANS.

QUALITY ASSURANCE PROGRAM : LEVEL 2
SURVEYED BY : VHB
SURVEYED DATE : NOV 2010
DATUM
VERTICAL NAVD 88
HORIZONTAL NAD 83 (07)

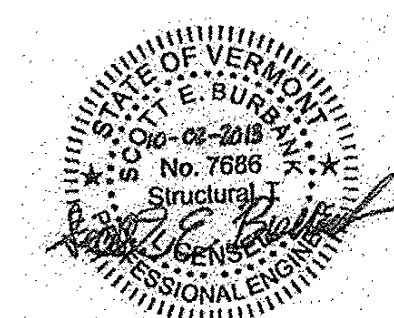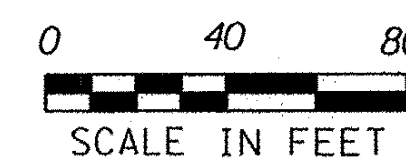

	DIRECTOR OF PROGRAM DEVELOPMENT
	APPROVED <i>[Signature]</i> DATE 10/4/13
	PROJECT MANAGER : TODD A. SUMNER, P.E.
	PROJECT NAME : GUILFORD PROJECT NUMBER : BRO 1442 (36)
SHEET 1 OF 42 SHEETS	