


SPECIAL PROVISION (BRIDGE RAILING, GALVANIZED HDSB/FASCIA MOUNTED/STEEL TUBING) (TYP) SEE BRIDGE RAIL DETAILS SHEET 29

△ PRECAST CONCRETE CURB (TYP) SEE NOTE 21 ON PROJECT NOTES SHEET (1 OF 2)

SEE DETAIL A

TYPICAL BRIDGE SECTION  
SCALE 1/2" = 1'-0"

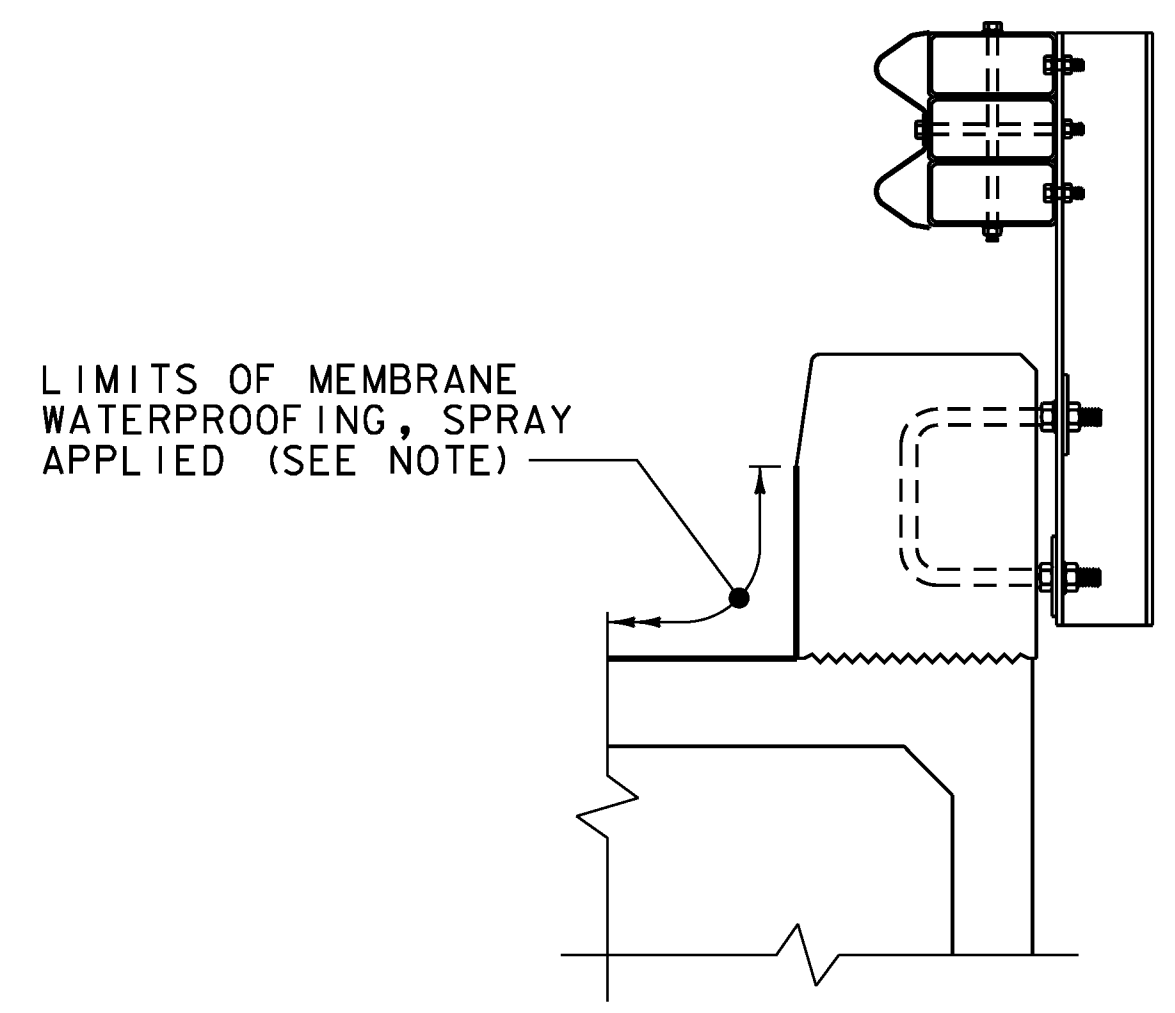

DETAIL A  
SCALE 1" = 1'-0"

NOTE:

ITEM 520.10, "MEMBRANE WATERPROOFING, SPRAY APPLIED" SHALL BE APPLIED TO THE BRIDGE DECK AS PER THE MANUFACTURER'S INSTRUCTIONS AND SHALL INCLUDE A REINFORCEMENT SCRIM COAT OVER GROUTED SHEAR KEYS.

REVISION	DESCRIPTION	DATE
△	PRECAST CONCRETE CURB	12/3/2013
PROJECT NAME: GUILFORD		
PROJECT NUMBER: BRO 1442(36)		
FILE NAME: z10j064typ.dgn		PLOT DATE: 12/3/2013
PROJECT LEADER: S.E. BURBANK		DRAWN BY: E.A. FIALA
DESIGNED BY: E.A. FIALA		CHECKED BY: S.E. BURBANK
TYPICAL BRIDGE SECTION		SHEET 3 OF 42

