



STA. 11+86, LT
 END UNCLASSIFIED CHANNEL EXCAVATION
 GEOTEXTILE UNDER STONE FILL
 STONE FILL, TYPE III
 GRUBBING MATERIAL

12+25

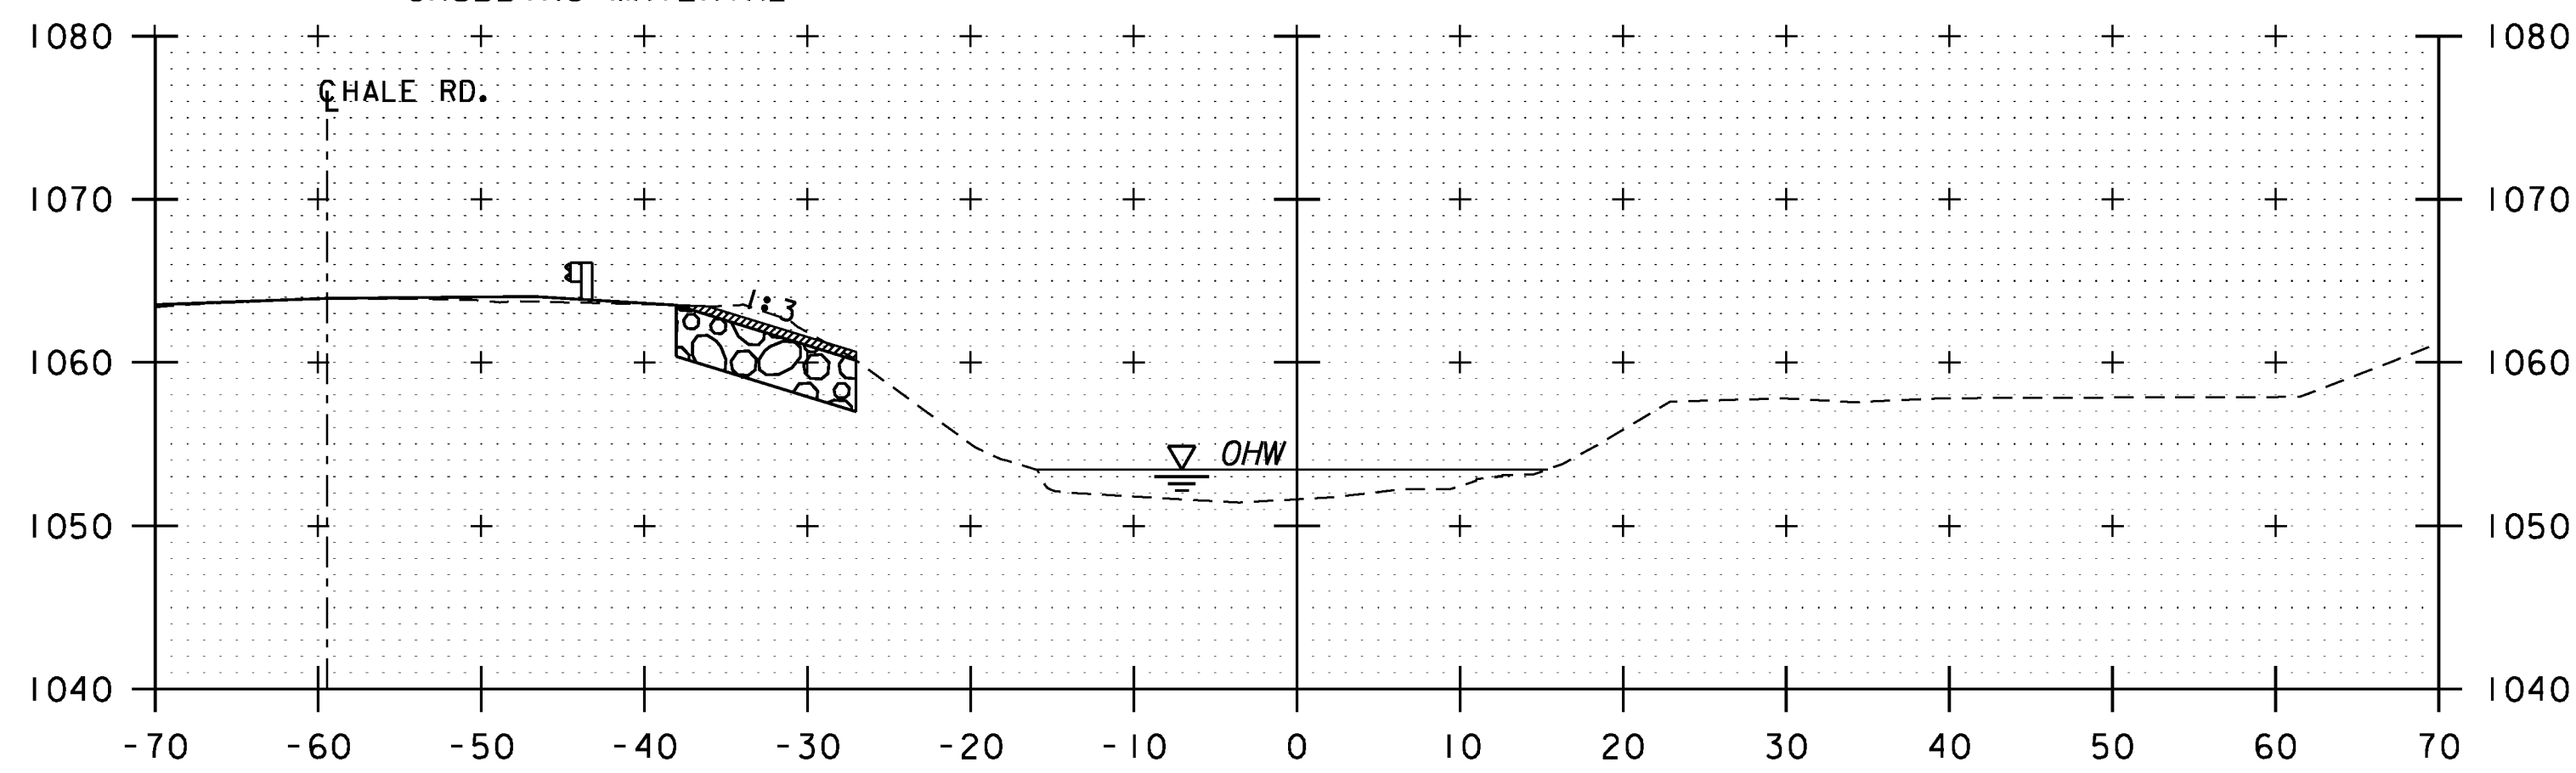


STA. 11+86, LT
 BEGIN GRUBBING MATERIAL

12+00

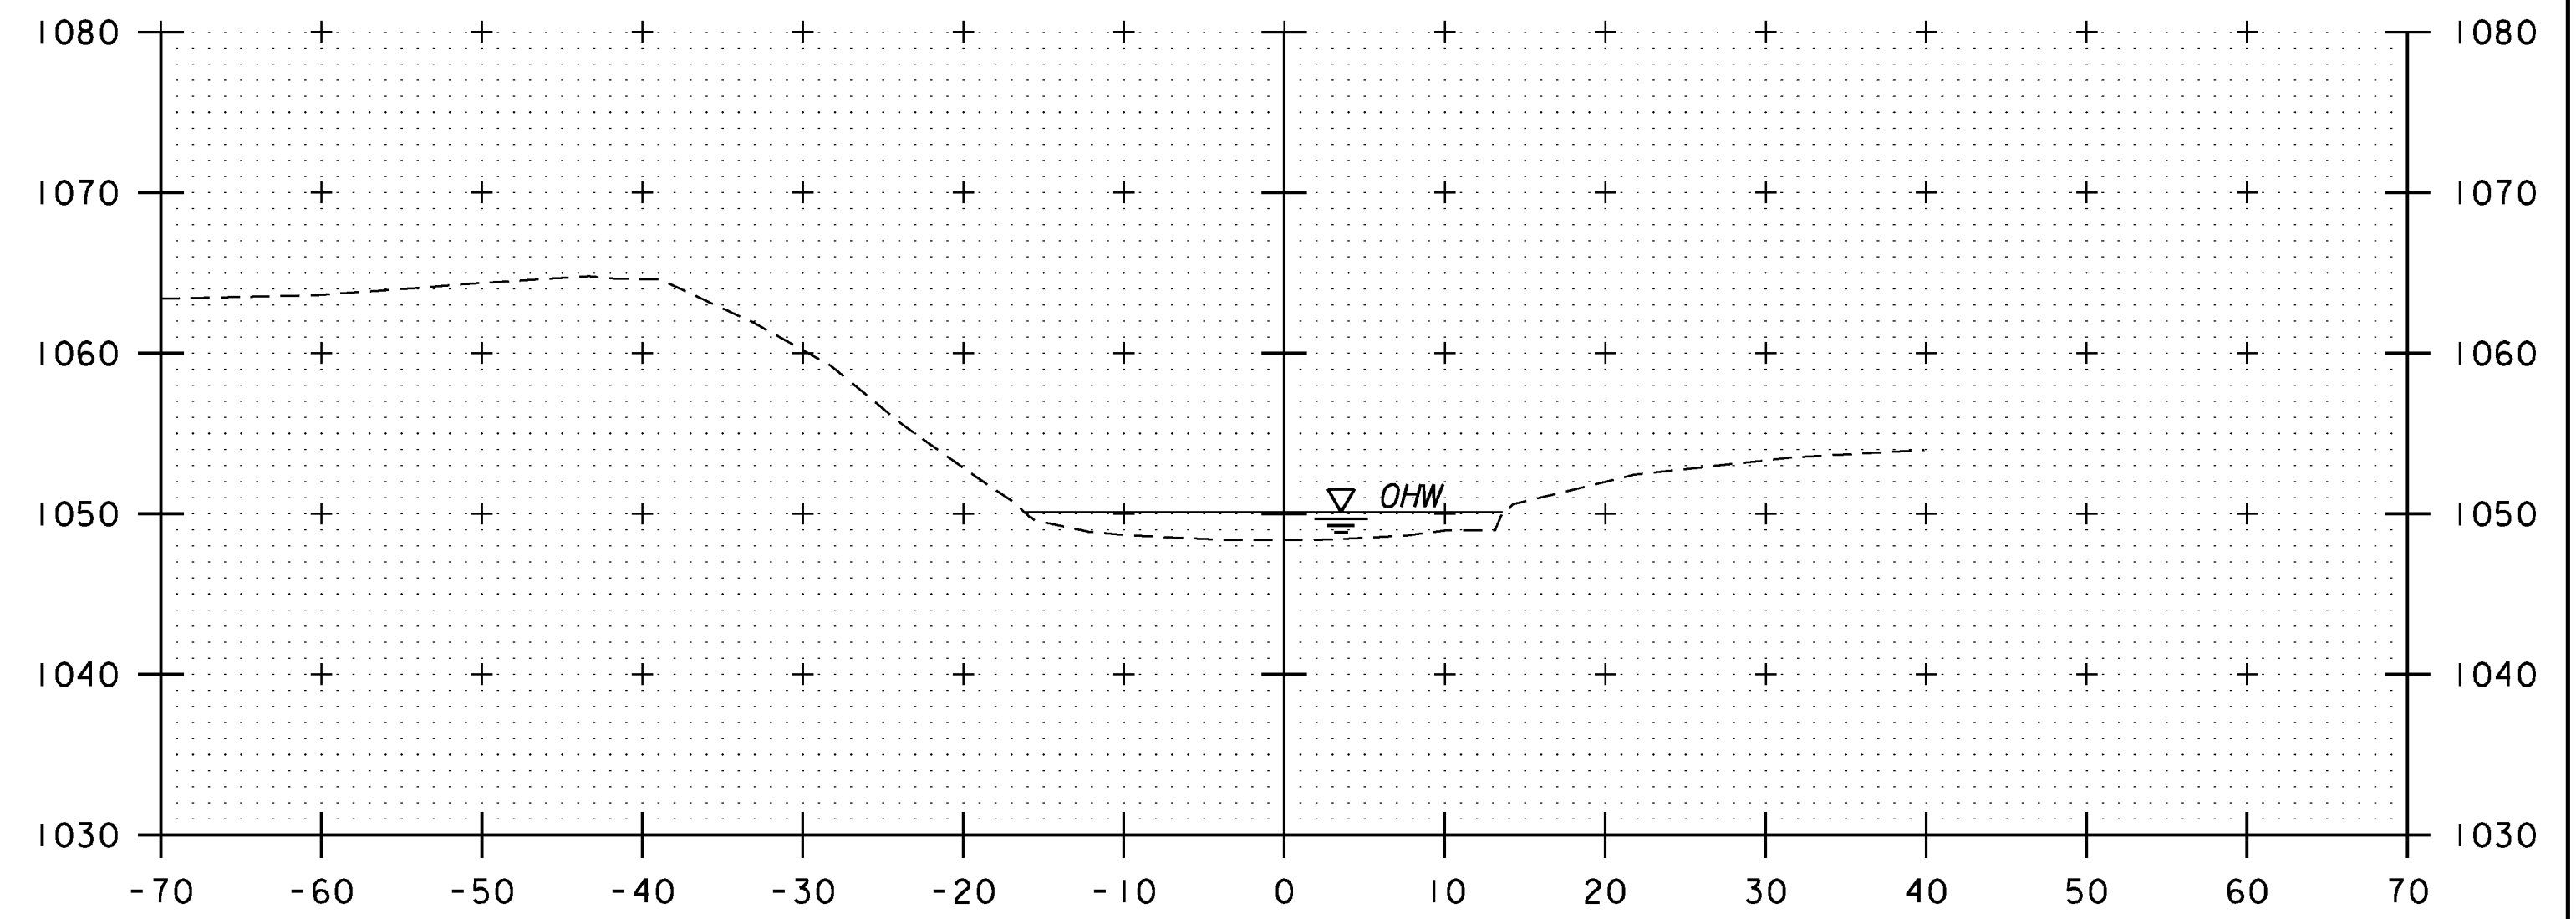

12+75

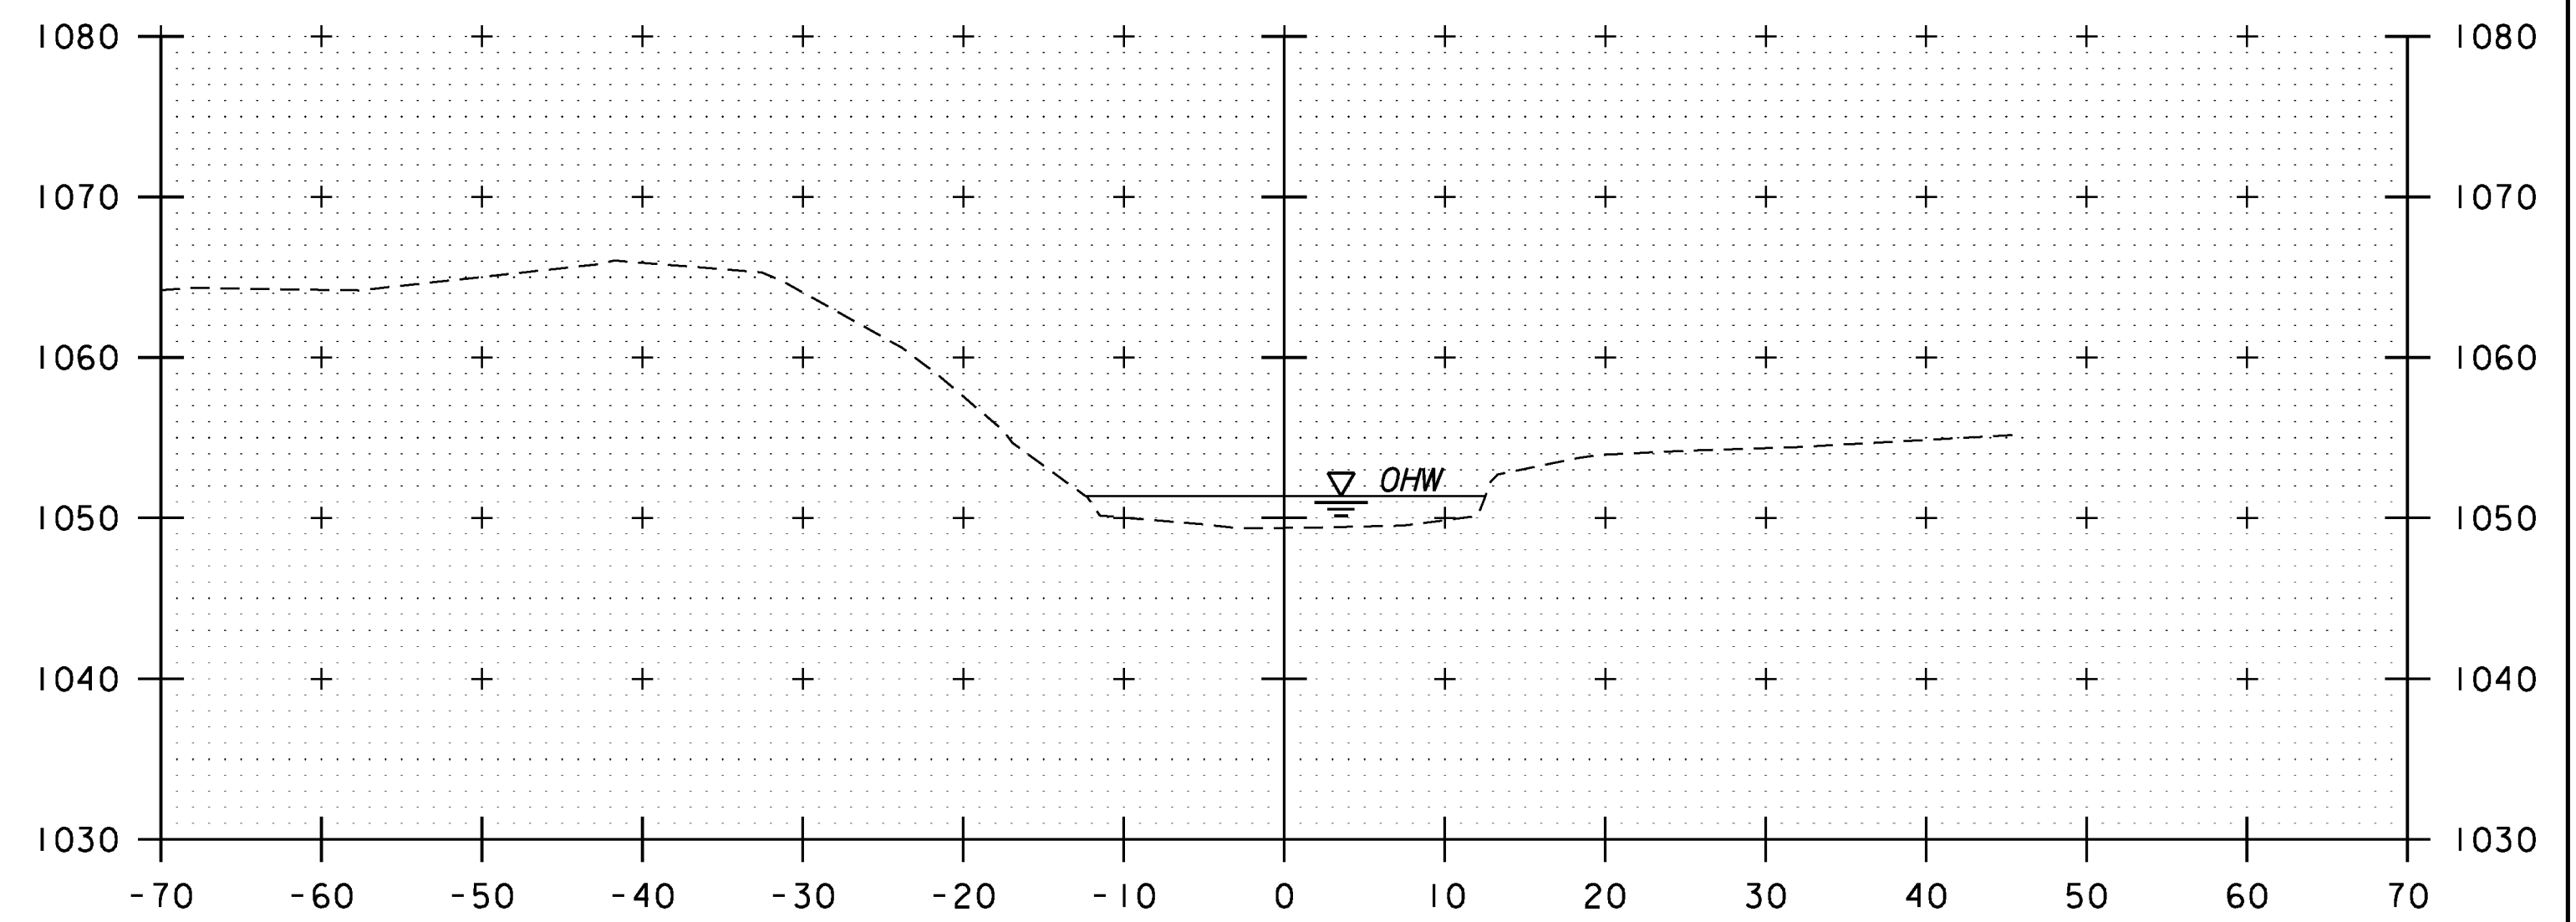

12+50

CHANNEL CROSS SECTIONS
 STA. 12+00 - STA. 12+75

SCALE 1" = 10'-0"
 10 0 10



PROJECT NAME: GUILFORD
 PROJECT NUMBER: BRO 1442(36)

FILE NAME: z10j064xsl.dgn
 PROJECT LEADER: S.E. BURBANK
 DESIGNED BY: E.A. FIALA
 CHANNEL CROSS SECTIONS (3 OF 4)

PLOT DATE: 10/2/2013
 DRAWN BY: E.A. FIALA
 CHECKED BY: S.E. BURBANK
 SHEET 35 OF 42