


STATE OF VERMONT
AGENCY OF TRANSPORTATION



PROPOSED IMPROVEMENT
BRIDGE PROJECT
TOWN OF GUILFORD
COUNTY OF WINDHAM

ROUTE: T.H. 10, CLASS III (LOCAL ROAD), BRIDGE NO. 65

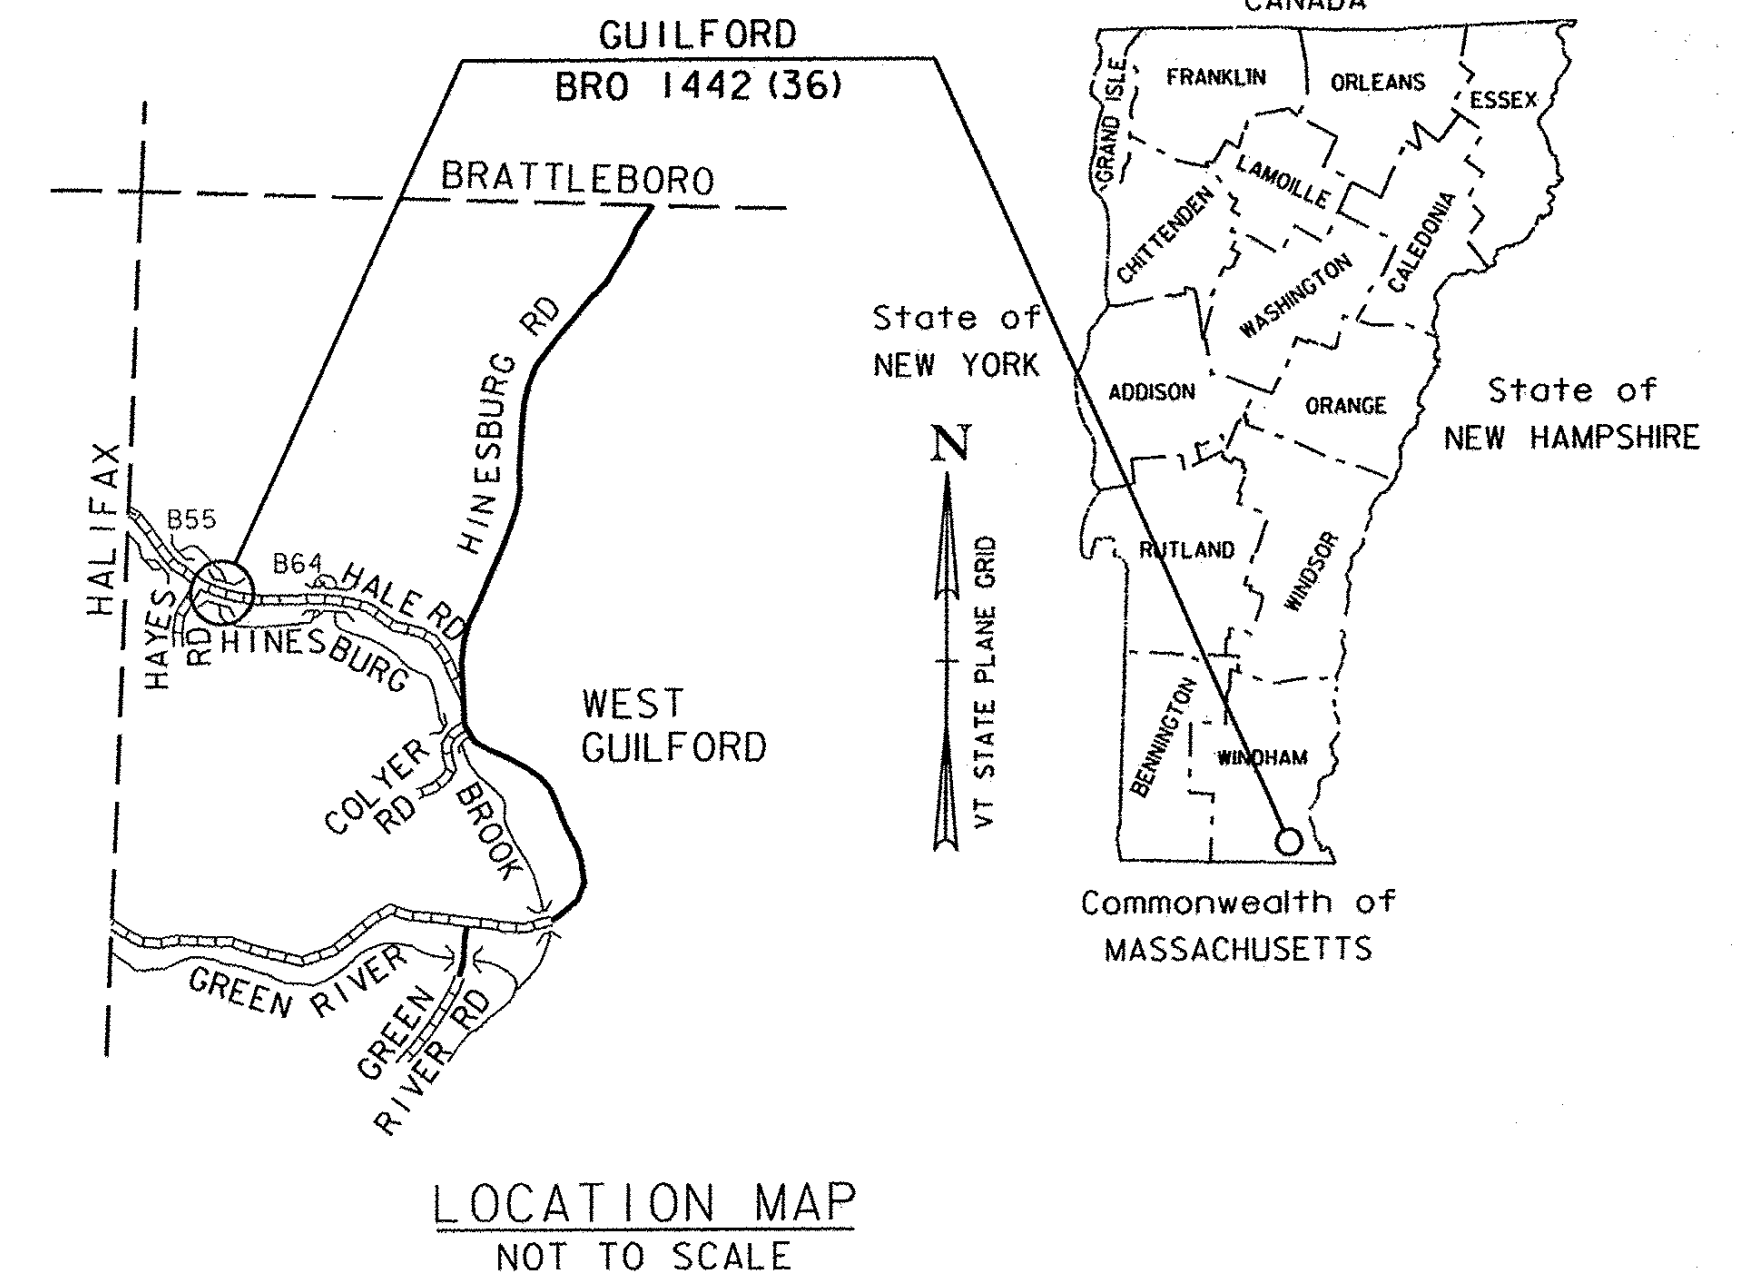

RECORD PLANS

CONTRACTOR: RENAUD BROTHERS, INC. - VERNON, VT

RESIDENT ENGINEER: FRED ROSS

CONSTRUCTION BEGAN: APRIL 1, 2014

CONSTRUCTION COMPLETE: OCTOBER 15, 2014

RECORD PLANS BY: FRED ROSS & JENNA HYDE

I HEREBY CERTIFY THAT ALL THE CONSTRUCTION REQUIRED BY THIS SET OF DRAWINGS HAS BEEN ACCOMPLISHED AS INDICATED HEREIN.



BY *Fred Ross* RESIDENT ENGINEER
DATE 2/1/16 FOR FRED ROSS

NOTE: Any further information concerning final quantities, amounts or other details relative to this project may be found at Central Files in the electronic archives.

PROJECT LOCATION: LOCATED IN THE COUNTY OF WINDHAM, TOWN OF GUILFORD, ON HALE ROAD (T.H. 10); BRIDGE NO. 65 OVER HINESBURG BROOK, APPROXIMATELY 0.90 MILES NORTHWESTERLY OF THE INTERSECTION OF HINESBURG ROAD (T.H. 2) AND HALE ROAD (T.H. 10).

LENGTH OF ROADWAY: 182.00 FEET
LENGTH OF BRIDGE: 58.19 FEET
LENGTH OF PROJECT: 240.19 FEET



PROJECT DESCRIPTION: WORK TO BE PERFORMED UNDER THIS PROJECT INCLUDES REMOVAL AND REPLACEMENT OF BRIDGE NO. 65, ON THE EXISTING ALIGNMENT, WITH ASSOCIATED ROADWAY AND CHANNEL WORK.

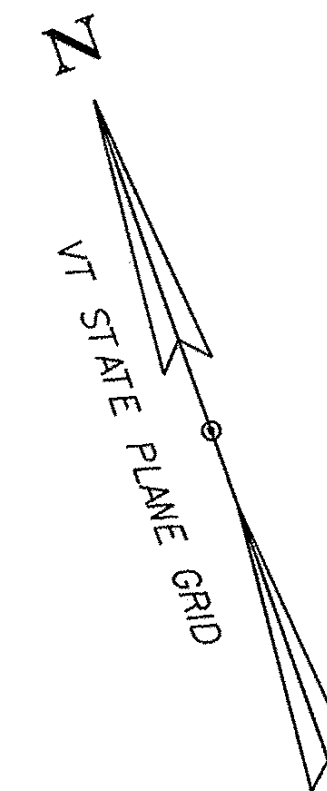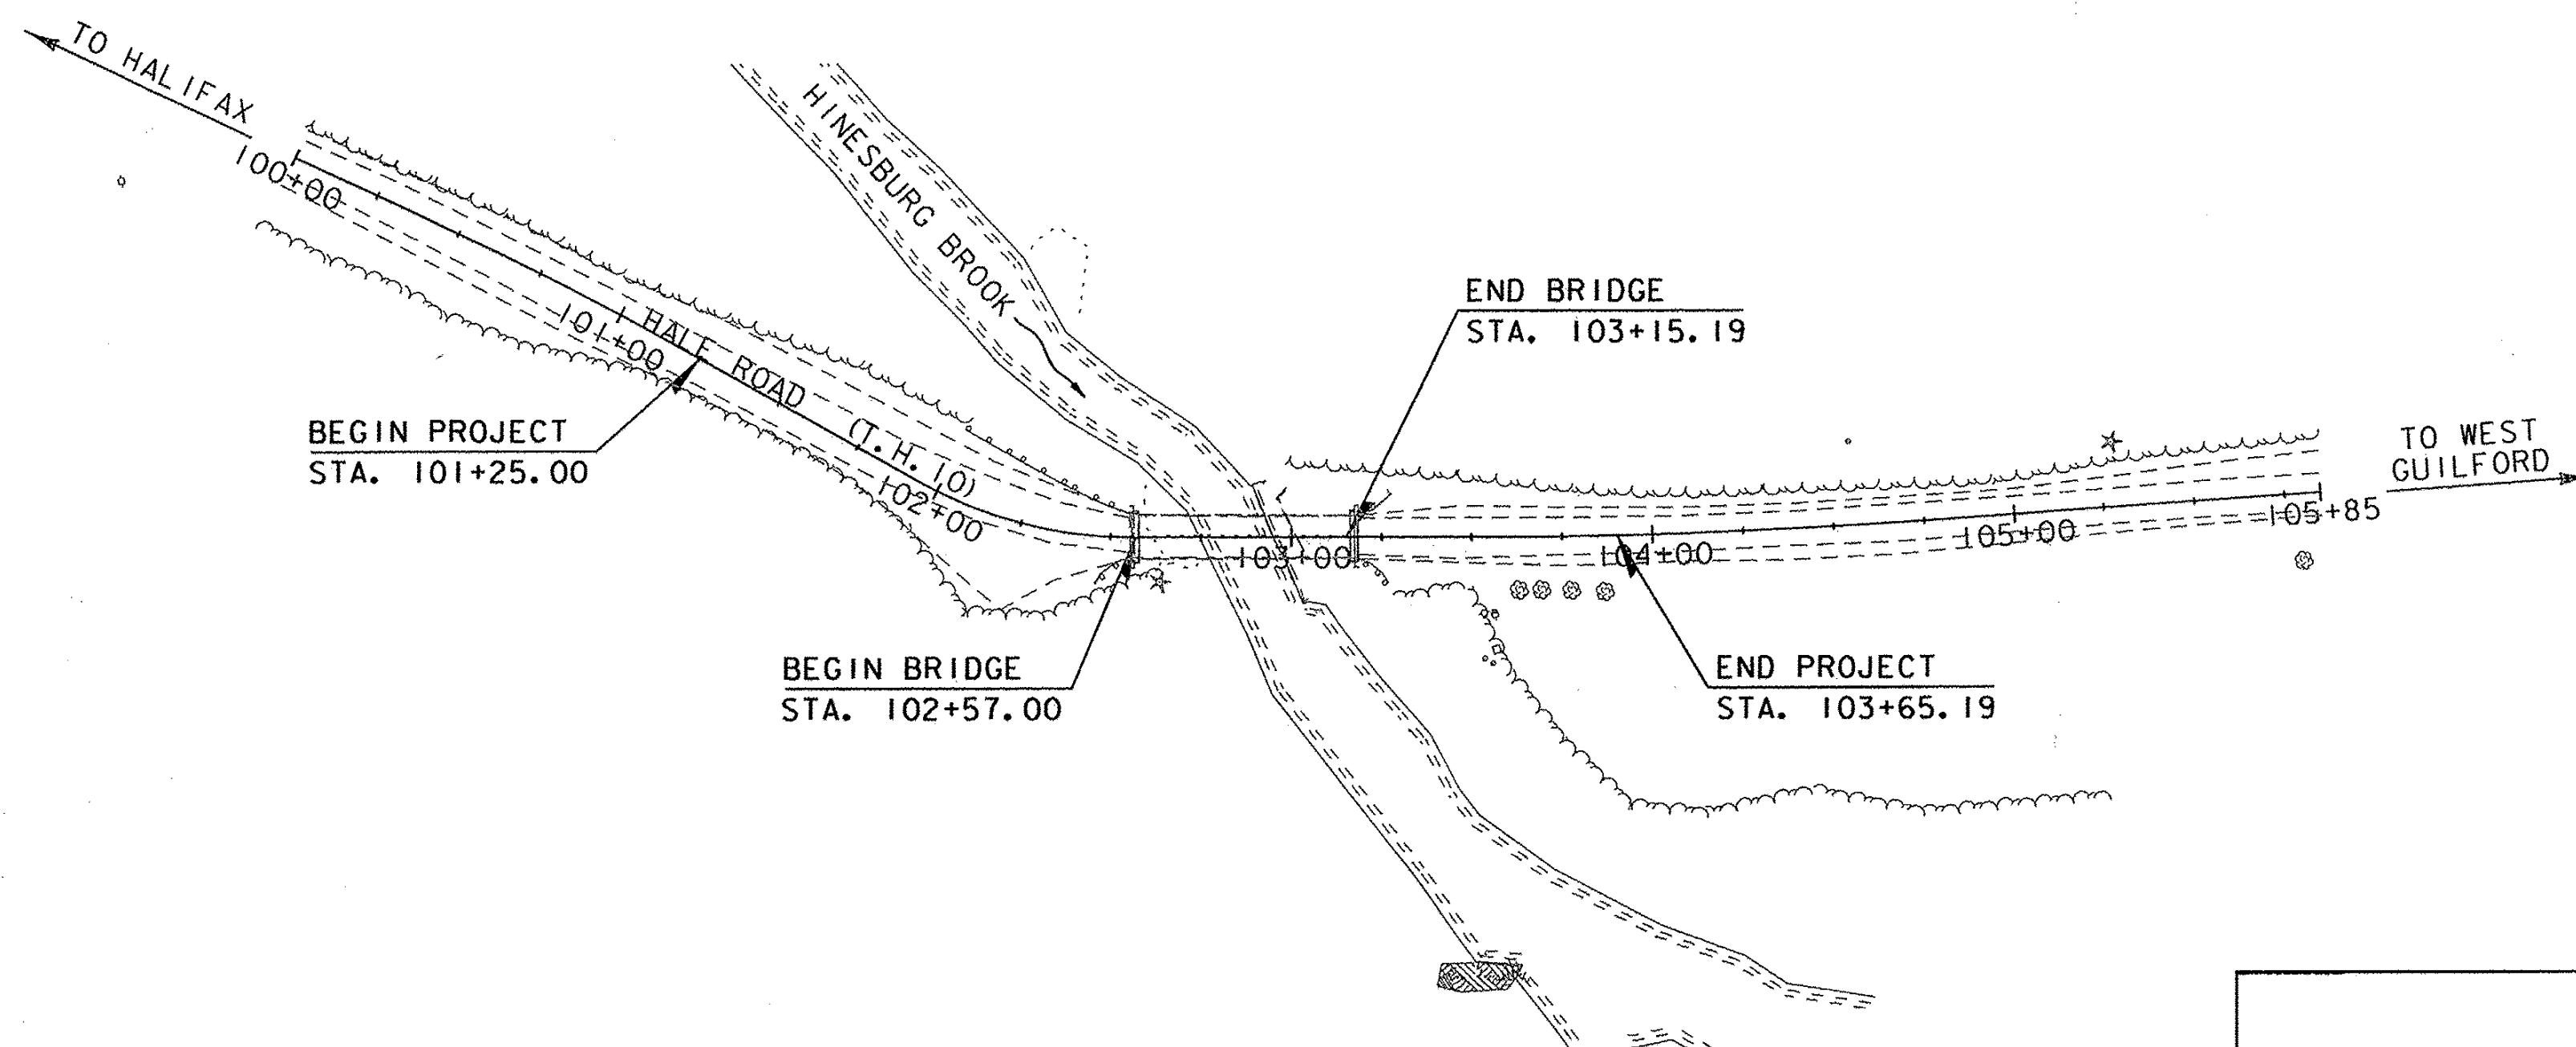

THESE PLANS ARE SUBJECT TO SUCH ENGINEERING CHANGES AS MAY BE REQUIRED BY THE FEDERAL HIGHWAY ADMINISTRATION OR THE DIRECTOR OF PROGRAM DEVELOPMENT.

CONSTRUCTION IS TO BE CARRIED ON IN ACCORDANCE WITH THESE PLANS AND THE STANDARD SPECIFICATIONS FOR CONSTRUCTION DATED 2011, AS APPROVED BY THE FEDERAL HIGHWAY ADMINISTRATION ON JULY 20, 2011 FOR USE ON THIS PROJECT, INCLUDING ALL SUBSEQUENT REVISIONS AND SUCH REVISED SPECIFICATIONS AND SPECIAL PROVISIONS AS ARE INCORPORATED IN THESE PLANS.

QUALITY ASSURANCE PROGRAM : LEVEL 2
SURVEYED BY : VHB
SURVEYED DATE : NOV 2010
DATUM
VERTICAL NAVD 88
HORIZONTAL NAD 83 (07)

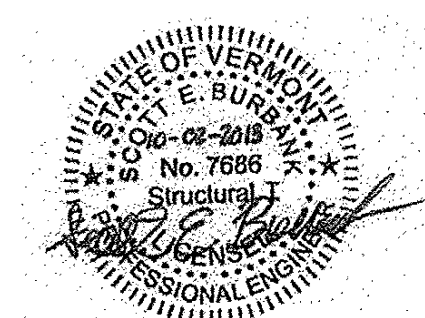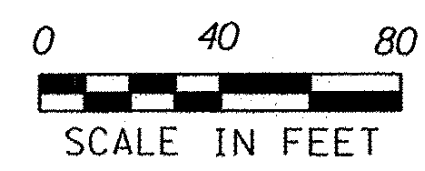

	DIRECTOR OF PROGRAM DEVELOPMENT
	APPROVED <i>Kurt A. Nash</i> DATE 10/4/13
	PROJECT MANAGER : TODD A. SUMNER, P.E.
	PROJECT NAME : GUILFORD PROJECT NUMBER : BRO 1442 (36)
SHEET 1 OF 42 SHEETS	

PRELIMINARY INFORMATION SHEET (BRIDGE)

LRFD

INDEX OF SHEETS

PLAN SHEETS

1	TITLE SHEET
2	PRELIMINARY INFORMATION SHEET
3	TYPICAL BRIDGE SECTION
4	TYP EARTHWORK AND ROADWAY SECTIONS
5 - 6	PROJECT NOTES
7 - 8	QUANTITY SHEETS
9	CONVENTIONAL SYMBOLOGY SHEET
10	TIE SHEET
11	LAYOUT SHEET
12	PROFILE
13	TRAFFIC CONTROL PLAN
14	TRAFFIC SIGN SHEET
15	TRAFFIC SIGN SUMMARY SHEET
16	BORING INFORMATION SHEET
17 - 18	BORING LOGS
19	PLAN AND ELEVATION
20	FRAMING PLAN
21 - 22	BOX BEAM DETAILS
23	BEARING DETAILS
24	ABUTMENT PLAN & ELEVATION
25	ABUTMENT REINFORCING
26	WINGWALL DETAILS
27	RETAINING WALL DETAILS
28	BRIDGE RAIL LAYOUT
29	BRIDGE RAIL DETAILS
30 - 32	ROADWAY CROSS SECTIONS
33 - 36	CHANNEL CROSS SECTIONS
37	EPSC NARRATIVE
38	EPSC EXISTING CONDITIONS PLAN
39	EPSC CONSTRUCTION CONDITIONS PLAN
40	EPSC FINAL CONDITIONS PLAN
41 - 42	EROSION CONTROL DETAILS

STANDARDS LIST

E-121	STANDARD SIGN PLACEMENT - CONVENTIONAL ROAD	08-08-1995
E-164	SQUARE STEEL SIGN POST	06-08-2009
G-1	STEEL BEAM GUARDRAIL DETAILS (POST, DELINEATOR, TYPICALS)	01-03-2000
G1-D	STEEL BEAM GUARDRAIL DETAILS (END TERMINAL, ANCHOR, MEDIAN)	01-03-2000
S-367B	GUARDRAIL APPROACH SECTION, GALVANIZED HD STEEL BEAM	05-24-2012
T-1	TRAFFIC CONTROL GENERAL NOTES	08-06-2012
T-10	CONVENTIONAL ROADS CONSTRUCTION APPROACH SIGNING	08-06-2012
T-30	CONSTRUCTION SIGN DETAILS	08-06-2012
T-35	CONSTRUCTION ZONE LONGITUDINAL DROP-OFFS	08-06-2012

STRUCTURES DETAILS

SD-501.00	CONCRETE DETAILS AND NOTES	05-10-2010
SD-502.00	CONCRETE DETAILS AND NOTES	10-10-2012

FINAL HYDRAULIC REPORT

HYDROLOGIC DATA

Date: 7/02/2013

DRAINAGE AREA : 2.75 sq. mi.
 CHARACTER OF TERRAIN : Hilly to mountainous, mostly forested
 STREAM CHARACTERISTICS : Stable, Moderately entrenched, Moderately Sinuous
 NATURE OF STREAMBED : Gravel and cobbles

PEAK FLOW DATA

Q 2.33 =	150 cfs	Q 50 =	700 cfs
Q 10 =	380 cfs	Q 100 =	800 cfs
Q 25 =	525 cfs	Q 500 =	1,040 cfs

DATE OF FLOOD OF RECORD : 1927
 ESTIMATED DISCHARGE : Unknown
 WATER SURFACE ELEV. : Unknown
 NATURAL STREAM VELOCITY : @ Q25 = 14.3 ft/s
 ICE CONDITIONS : Moderate
 DEBRIS : Moderate
 DOES THE STREAM REACH MAXIMUM HIGHWATER ELEV. RAPIDLY? Yes
 IS ORDINARY RISE RAPID? Yes
 IS STAGE AFFECTED BY UPSTREAM OR DOWNSTREAM CONDITIONS? No
 IF YES, DESCRIBE:

WATERSHED STORAGE : < 1 % HEADWATERS :
 UNIFORM : X
 IMMEDIATELY ABOVE SITE :

EXISTING STRUCTURE INFORMATION

STRUCTURE TYPE : Single span, rolled steel beam supported by concrete stub abutments
 YEAR BUILT : Built 1939, reconstructed in 1966
 CLEAR SPAN(NORMAL TO STREAM) : 34' (measured from stone retaining wall)
 VERTICAL CLEARANCE ABOVE STREAMBED : 11.7 ft
 WATERWAY OF FULL OPENING : 265 sf
 DISPOSITION OF STRUCTURE : Remove and replace with a new bridge
 TYPE OF MATERIAL UNDER SUBSTRUCTURE : See boring information

WATER SURFACE ELEVATIONS AT:

Q2.33 =	1055.0 ft	VELOCITY =	7.4 ft/s
Q10 =	1056.2 ft	"	9.5 ft/s
Q25 =	1056.8 ft	"	10.2 ft/s
Q50 =	1057.3 ft	"	11.1 ft/s
Q100 =	1057.9 ft	"	11.7 ft/s

LONG TERM STREAMBED CHANGES : None noted

IS THE ROADWAY OVERTOPPED BELOW Q100: No
 FREQUENCY: Above Q100
 RELIEF ELEVATION: 1064.5 ft
 DISCHARGE OVER ROAD @Q100: 0 cfs

UPSTREAM STRUCTURE

TOWN: Guilford DISTANCE: 1,000 ft
 HIGHWAY #: T.H. 10 STRUCTURE #: 55
 CLEAR SPAN: 25 ft CLEAR HEIGHT:
 YEAR BUILT: 1966 FULL WATERWAY:
 STRUCTURE TYPE: Steel stringer with bituminous wearing surface

DOWNSTREAM STRUCTURE

TOWN: Guilford DISTANCE: 1,690 ft
 HIGHWAY #: T.H. 10 STRUCTURE #: 64
 CLEAR SPAN: 55 ft CLEAR HEIGHT:
 YEAR BUILT: 1964 FULL WATERWAY:
 STRUCTURE TYPE: Steel stringer with bituminous wearing surface

LRFR LOAD RATING FACTORS

LOADING LEVELS	TRUCK						
	H-20	HL-93	3S2	6 AXLE	3A STR.	4A STR.	5A SEMI
TONNAGE	20	36	36	66	30	34.5	38
INVENTORY	2.31	1.49					
POSTING							
OPERATING	3.00	1.93	2.26	1.30	1.69	1.53	1.80

COMMENTS:

* SEE PROJECT NOTES

PILE DRIVING AND TESTING REQUIREMENTS

- NOMINAL PILE DRIVING CAPACITY R_{nd} : *
- PILE TEST RESISTANCE FACTOR ϕ : 0.65
- MAXIMUM PILE TIP ELEVATION *
- A MINIMUM OF 3 DYNAMIC TESTS SHALL BE PERFORMED DURING INSTALLATION. NO LESS THAN 1 TEST SHOULD BE PERFORMED AT EACH ABUTMENT. THE REMAINING PILES SHOULD BE CALIBRATED BY WAVE EQUATION ANALYSIS.

PROPOSED STRUCTURE

STRUCTURE TYPE: Single span voided slab bridge
 CLEAR SPAN(NORMAL TO STREAM): 45 ft
 VERTICAL CLEARANCE ABOVE STREAMBED: 10.8 ft
 WATERWAY OF FULL OPENING: 270 sf

WATER SURFACE ELEVATIONS AT:

Q2.33 =	1055.0 ft	VELOCITY=	7.4 ft/s
Q10 =	1056.2 ft	"	9.5 ft/s
Q25 =	1056.8 ft	"	10.5 ft/s
Q50 =	1057.3 ft	"	11.5 ft/s
Q100 =	1057.9 ft	"	11.9 ft/s

IS THE ROADWAY OVERTOPPED BELOW Q100: No
 FREQUENCY: Above Q100
 RELIEF ELEVATION: 1064.8
 DISCHARGE OVER ROAD @Q100: 0 cfs

AVERAGE LOW ELEVATION OF SUPERSTRUCTURE: 1061.6 ft
 VERTICAL CLEARANCE: @ Q25 = 4.8 ft

SCOUR: Contraction Scour = 0.5 ft (Q100), 0.5 ft (Q500)
 Abutment Scour - n/a (abutments located outside of flow area)
 REQUIRED CHANNEL PROTECTION: Stone Fill, Type III

PERMIT INFORMATION

AVERAGE DAILY FLOW: 10 cfs DEPTH OR ELEVATION:
 ORDINARY LOW WATER: 1.0 cfs Depth = 0.1 ft
 ORDINARY HIGH WATER: 60 cfs Depth = 1.1 ft

TEMPORARY BRIDGE REQUIREMENTS

STRUCTURE TYPE: No temporary bridge required.
 CLEAR SPAN (NORMAL TO STREAM):
 VERTICAL CLEARANCE ABOVE STREAMBED:
 WATERWAY AREA OF FULL OPENING:

ADDITIONAL INFORMATION

TRAFFIC MAINTENANCE NOTES

- MAINTAIN TRAFFIC ON AN OFF SITE DETOUR.
- TRAFFIC SIGNALS ARE NOT NECESSARY.
- SIDEWALKS ARE NOT NECESSARY

DESIGN VALUES

1. DESIGN LIVE LOAD	HL-93
2. FUTURE PAVEMENT	d_p : 7.0 INCH
3. DESIGN SPAN	L: 55.00 FT
4. MIN. MID-SPAN POS. CAMBER @ RELEASE (PRESTRESSED UNITS)	Δ : SEE NOTES
5. PRESTRESSING STRAND (0.60 INCH DIAMETER - LOW RELAX)	f_y : 270 KSI
6. PRESTRESSED CONCRETE STRENGTH	f'_{ci} : 6.0 KSI
7. PRESTRESSED CONCRETE RELEASE STRENGTH	f'_{cr} : 4.8 KSI
8. CONCRETE, HIGH PERFORMANCE CLASS AA	f'_{c} : ---
9. CONCRETE, HIGH PERFORMANCE CLASS A	f'_{c} : ---
10. CONCRETE, HIGH PERFORMANCE CLASS B	f'_{c} : ---
11. CONCRETE, CLASS C	f'_{c} : ---
12. REINFORCING STEEL	f_y : 60 KSI
13. STRUCTURAL STEEL AASHTO M270	f_y : ---
14. SOIL UNIT WEIGHT	γ : 0.140 KCF
15. NOMINAL BEARING RESISTANCE OF SOIL	q_n : ---
16. SOIL BEARING RESISTANCE FACTOR (REFER TO AASHTO LRFD)	ϕ : ---
17. NOMINAL BEARING RESISTANCE OF ROCK	q_n : 10.0 KSF
18. ROCK BEARING RESISTANCE FACTOR (REFER TO AASHTO LRFD)	ϕ : ---
19. NOMINAL AXIAL PILE RESISTANCE	q_p : ---
20. PILE YIELD STRENGTH ASTM A572	f_y : 50 KSI
21. PILE SIZE	HP 14X 89
22. EST. AVG PILE LENGTH	L _p : 34.0 ft
23. PILE RESISTANCE FACTOR	ϕ : ---
24. LATERAL PILE DEFLECTION	Δ : ---
25. BASIC WIND SPEED	V _{3s} : ---
26. MINIMUM GROUND SNOW LOAD	p _g : ---
27. SEISMIC DATA	PGA: --- S ₁ : ---


PROJECT NAME: GUILFORD
 PROJECT NUMBER: BRO 1442(36)
 FILE NAME: z10j062pi.dgn PLOT DATE: 9/11/2013
 PROJECT LEADER: S.E. BURBANK DRAWN BY: D.A. GINGRAS
 DESIGNED BY: A.J. GOUDREAU CHECKED BY: S.E. BURBANK
 PRELIMINARY INFORMATION SHEET SHEET 2 OF 42




AS BUILT "REBAR" DETAIL		
LEVEL I	LEVEL II	LEVEL III
TYPE:	TYPE:	TYPE:
GRADE:	GRADE:	GRADE:

TRAFFIC DATA

YEAR	ADT	DHV	% D	% T	ADTT	
2012	80	10	58	7.2	5	20 year ESAL for flexible pavement from 2012 to 2032 : 19000
2032	85	10	58	8.8	5	40 year ESAL for flexible pavement from 2012 to 2052 : 38000
Design Speed : 25 mph						

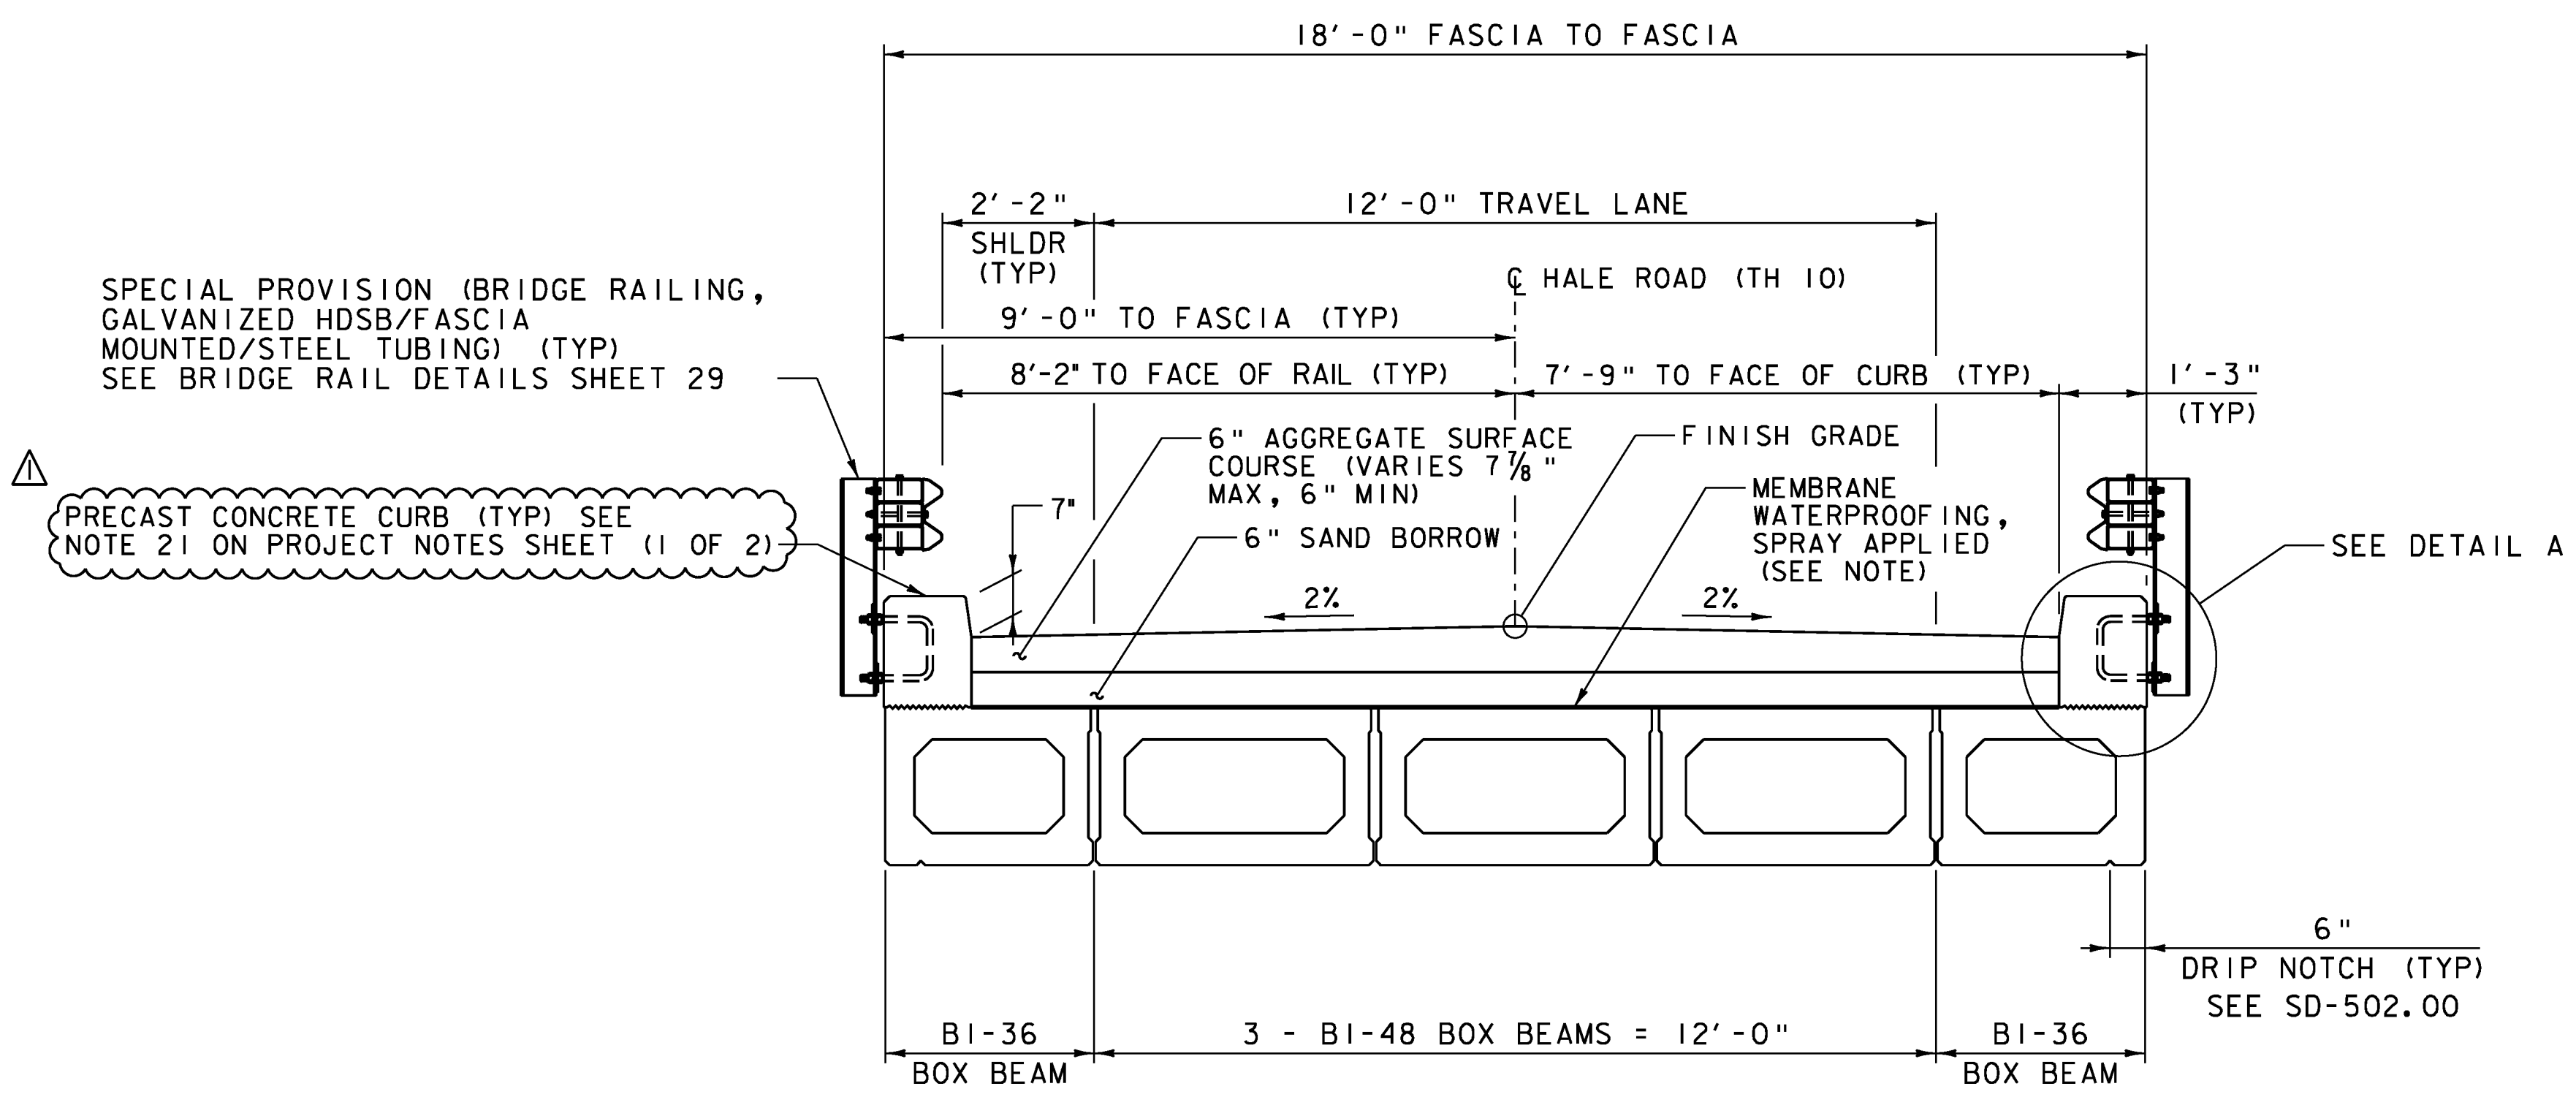

TYPICAL BRIDGE SECTION
SCALE 1/2" = 1'-0"

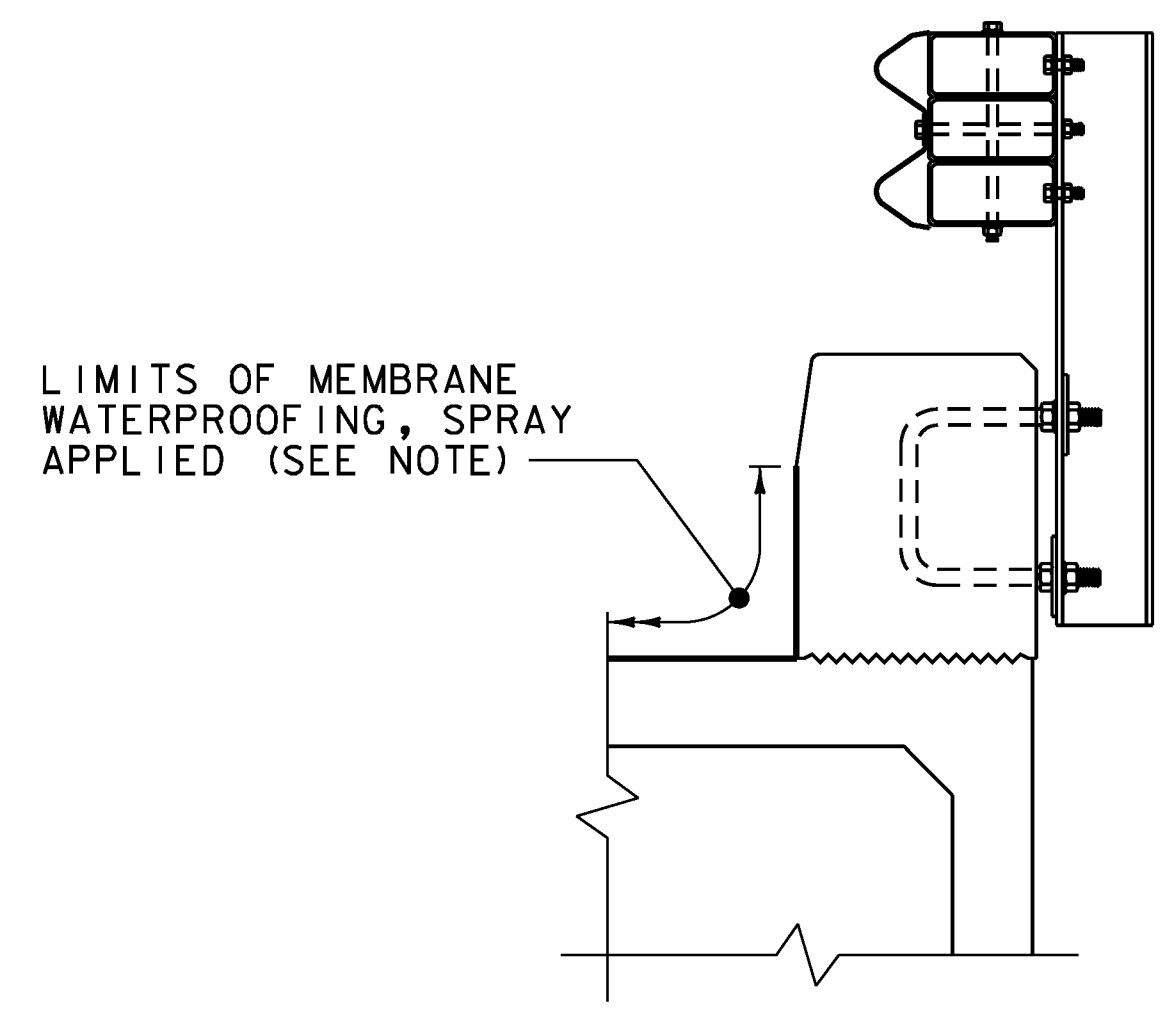


DETAIL A
SCALE 1" = 1'-0"

NOTE:

ITEM 520.10, "MEMBRANE WATERPROOFING, SPRAY APPLIED" SHALL BE APPLIED TO THE BRIDGE DECK AS PER THE MANUFACTURER'S INSTRUCTIONS AND SHALL INCLUDE A REINFORCEMENT SCRIM COAT OVER GROUTED SHEAR KEYS.

REVISION	DESCRIPTION	DATE
△	PRECAST CONCRETE CURB	12/3/2013
PROJECT NAME: GUILFORD		
PROJECT NUMBER: BRO 1442(36)		
FILE NAME: z10j064typ.dgn		PLOT DATE: 12/3/2013
PROJECT LEADER: S.E. BURBANK		DRAWN BY: E.A. FIALA
DESIGNED BY: E.A. FIALA		CHECKED BY: S.E. BURBANK
TYPICAL BRIDGE SECTION		SHEET 3 OF 42




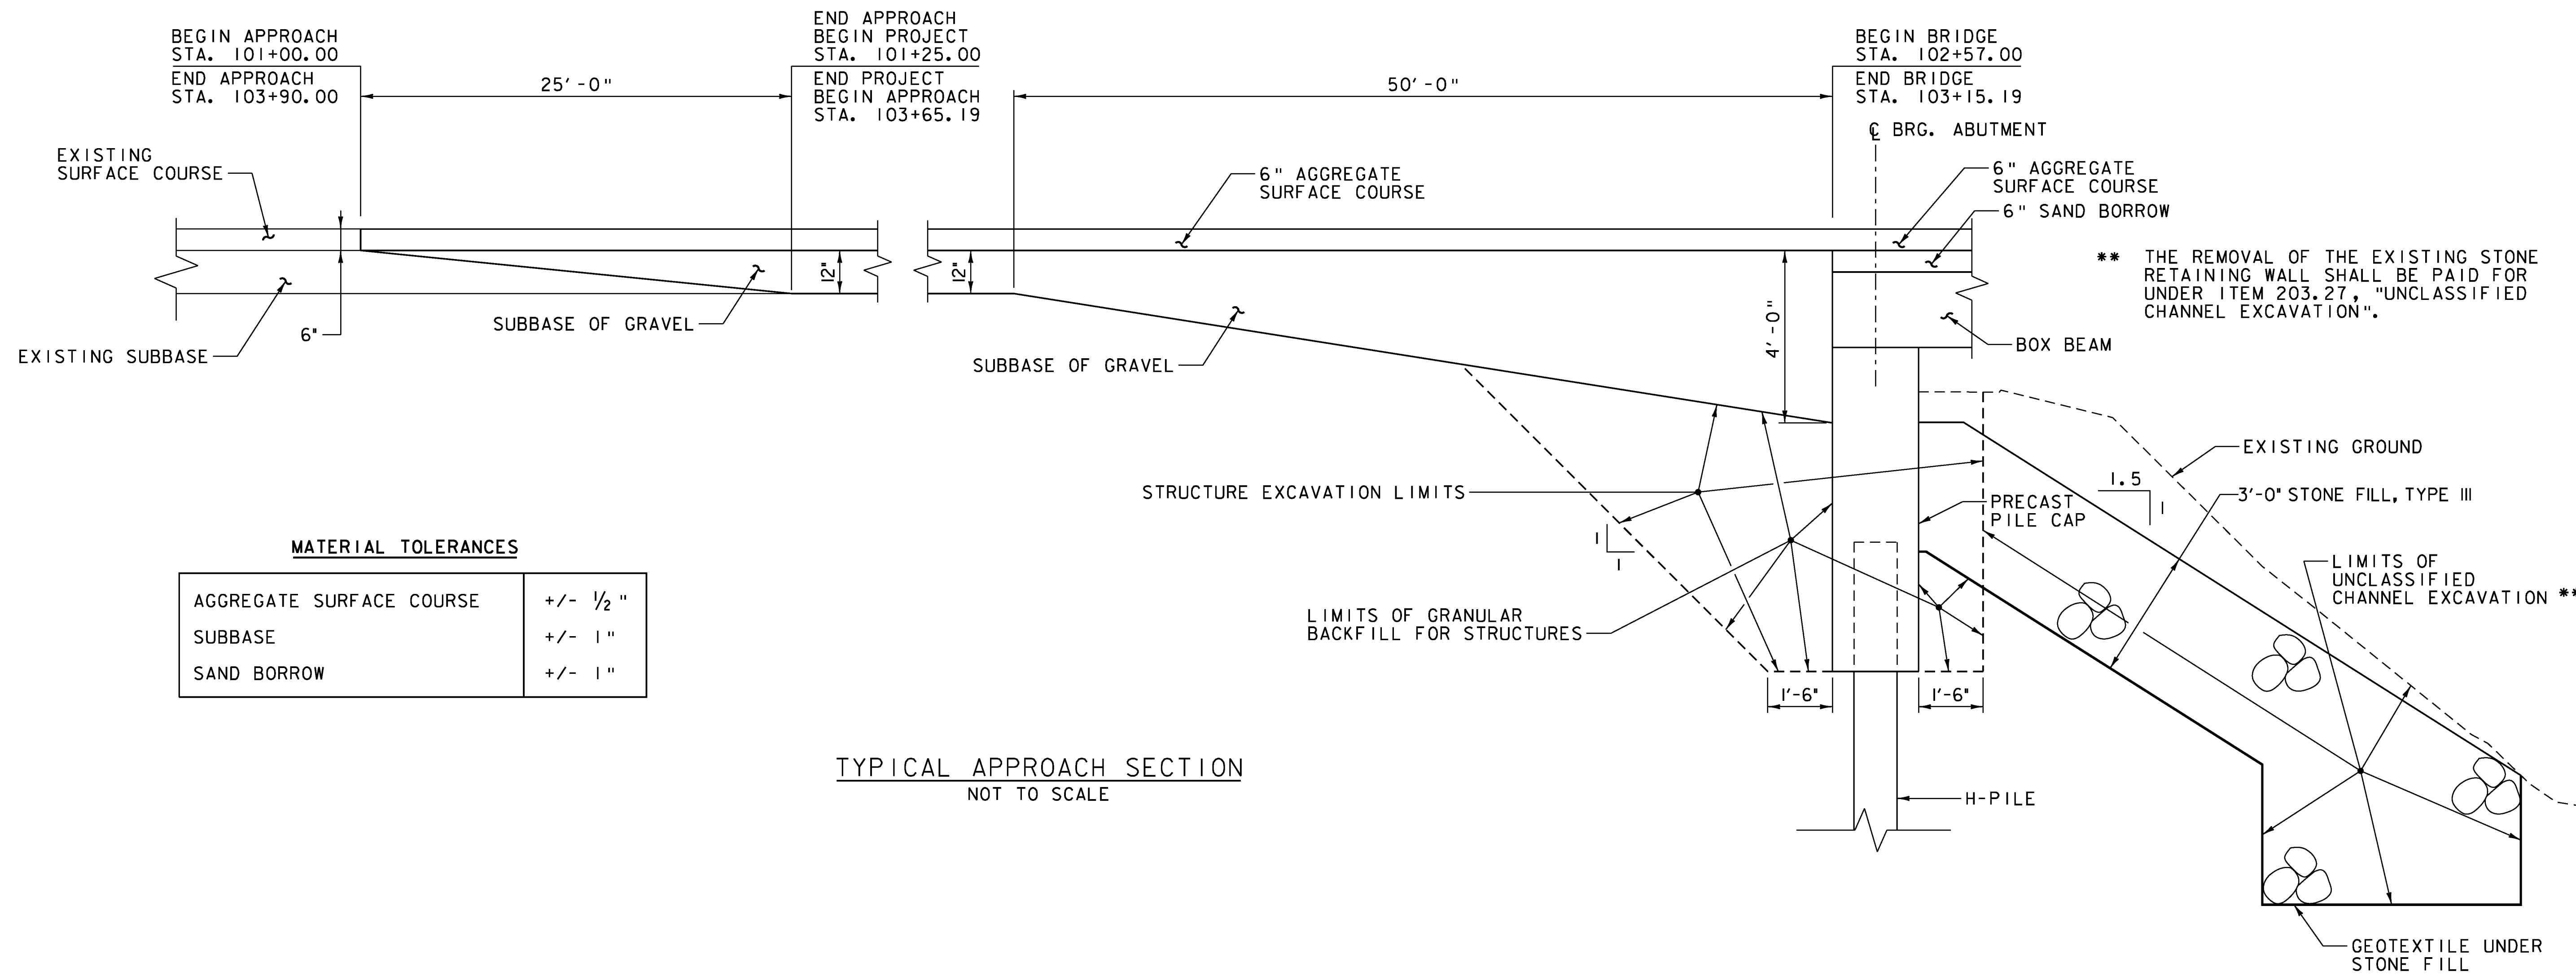


MATERIAL TOLERANCES

AGGREGATE SURFACE COURSE	+/- 1/2"
SUBBASE	+/- 1"
SAND BORROW	+/- 1"

TYPICAL APPROACH SECTION
NOT TO SCALE

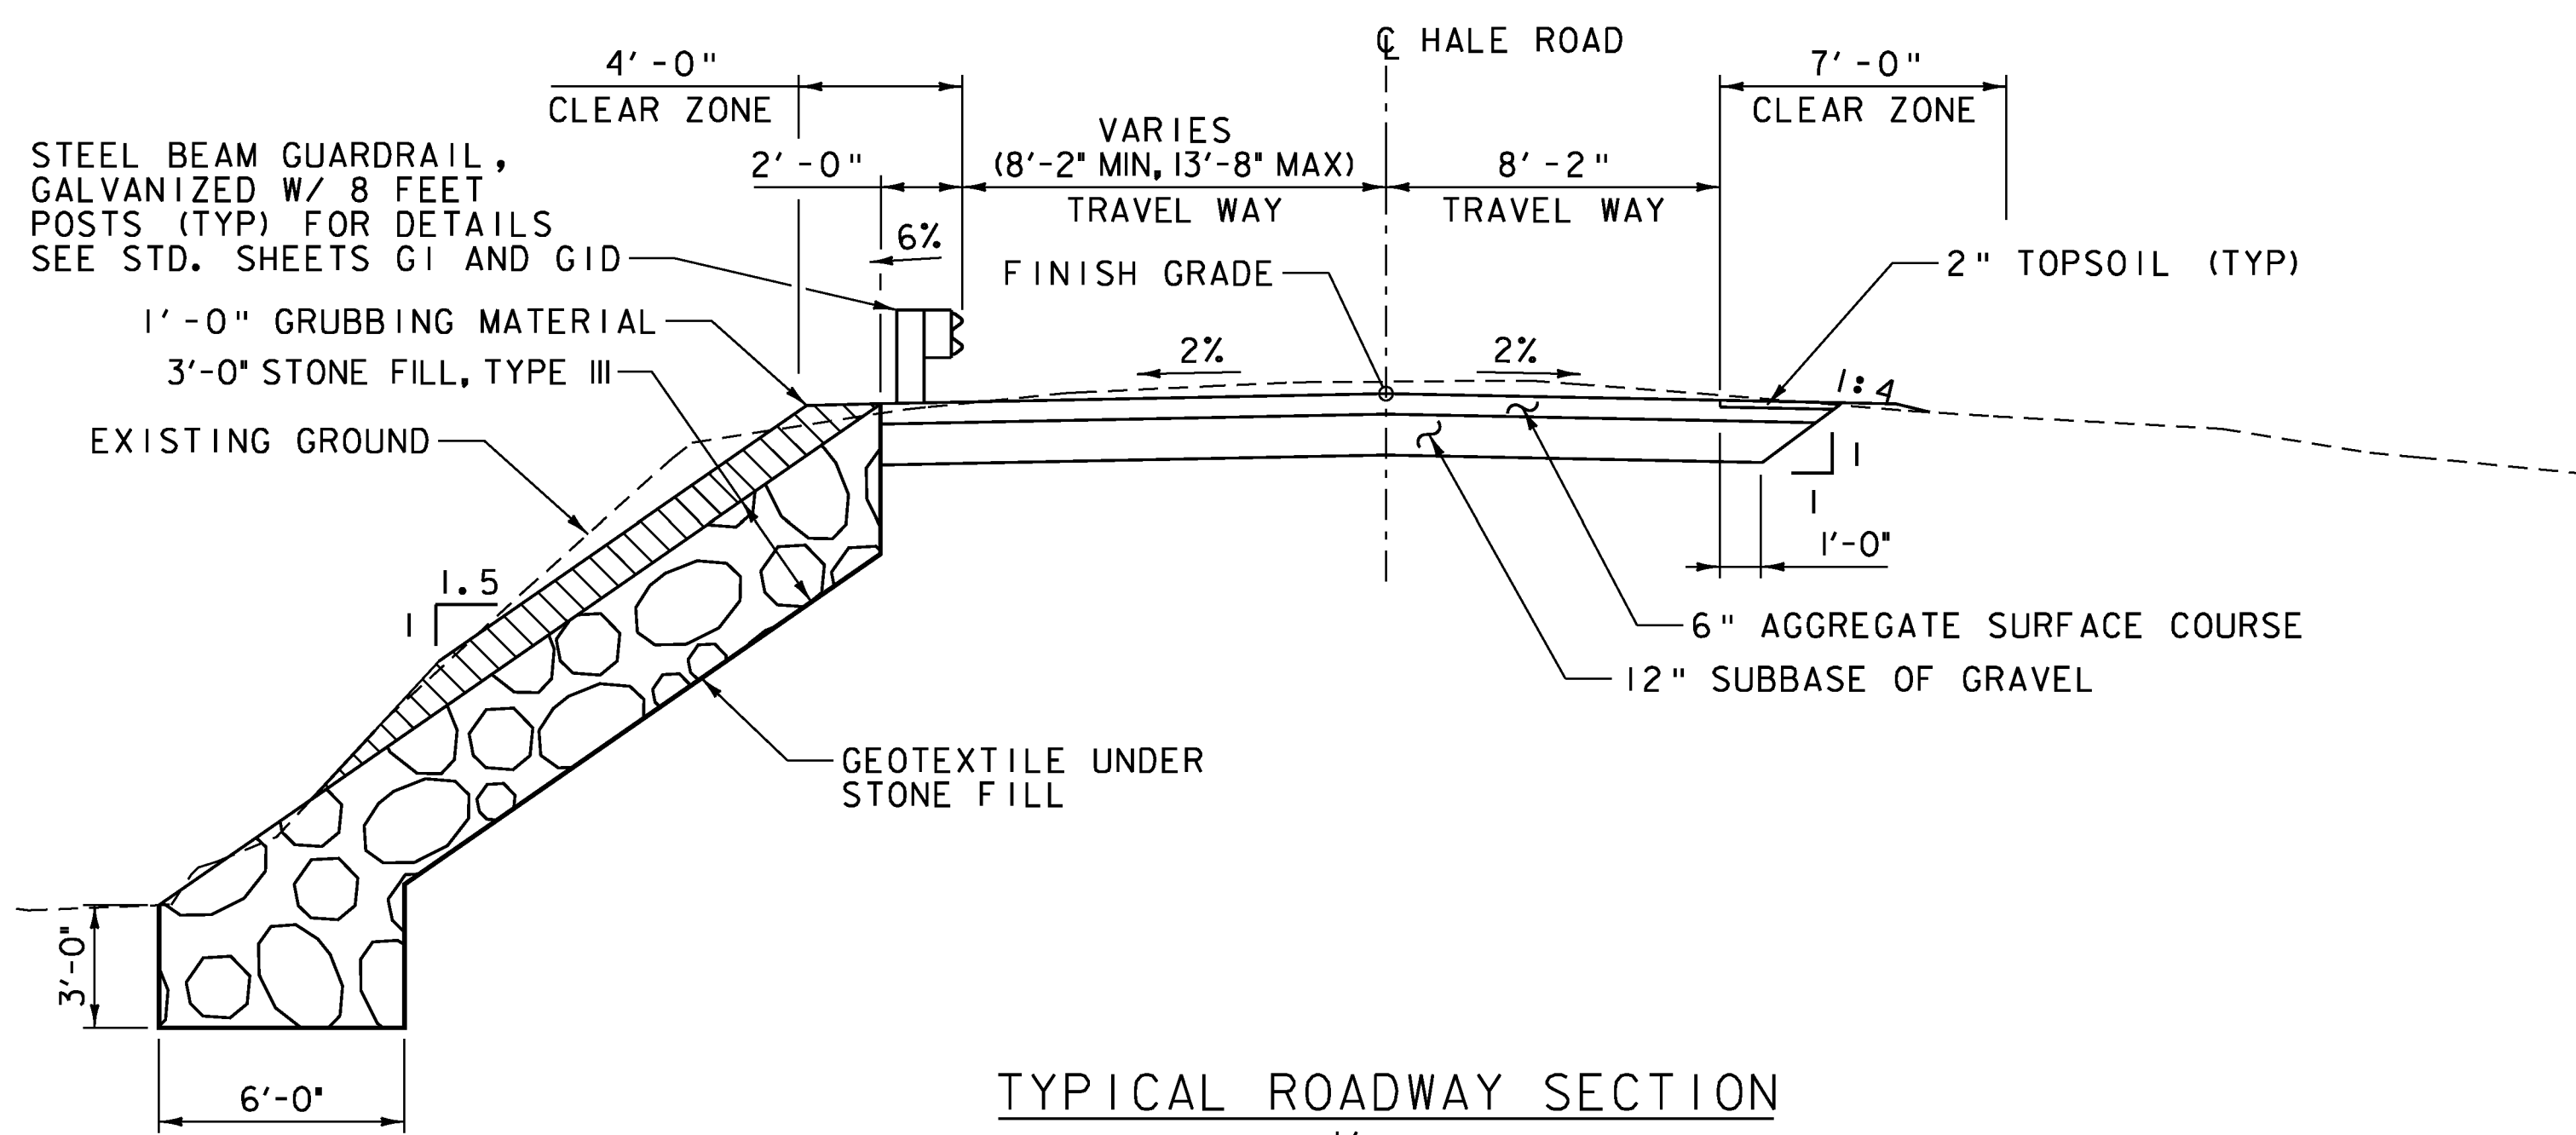

TYPICAL ROADWAY SECTION
SCALE 1/4" = 1'-0"

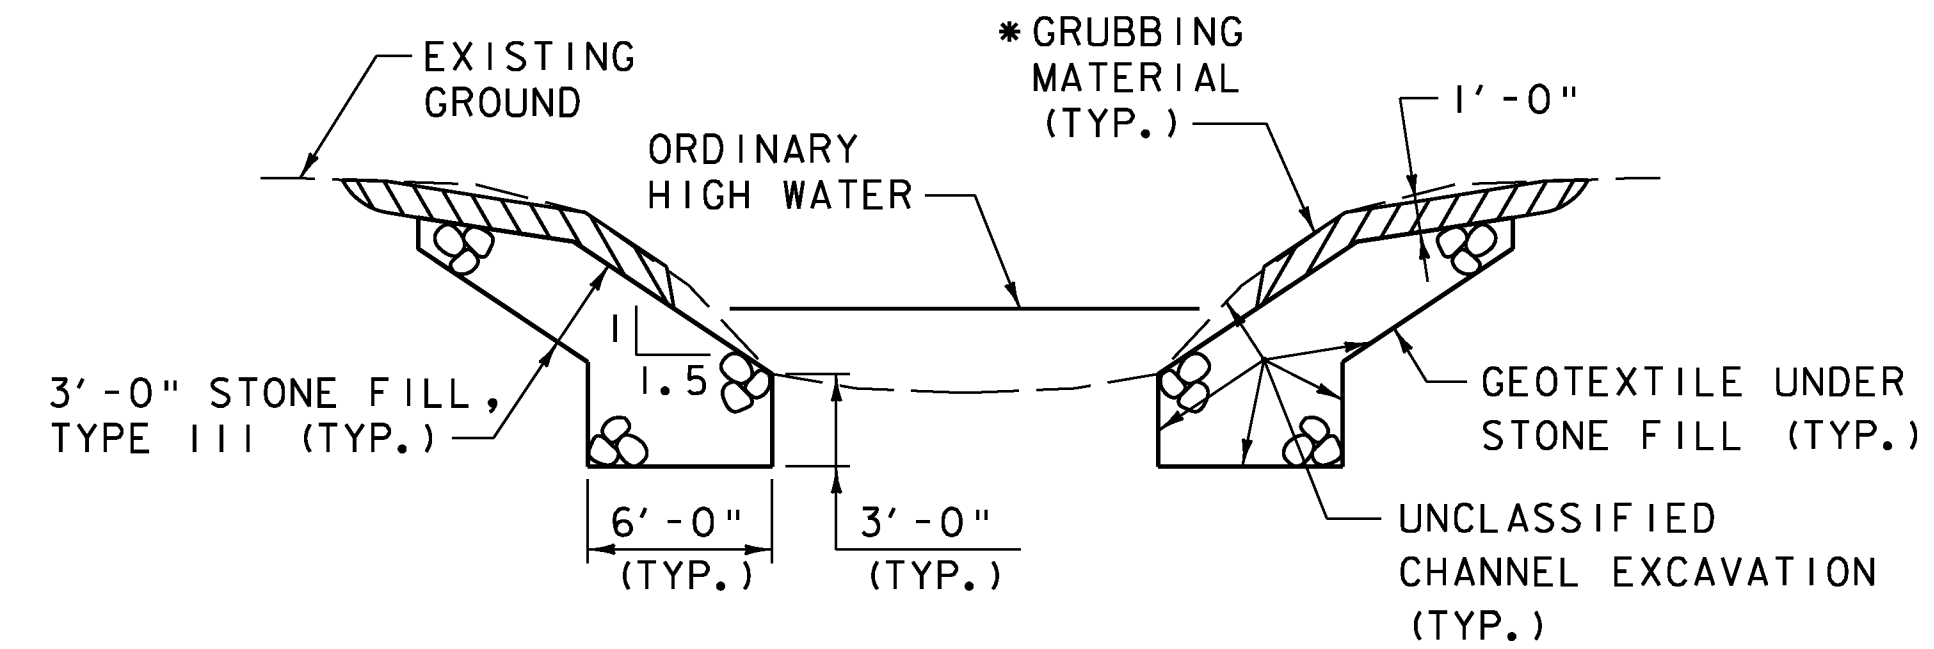

TYPICAL CHANNEL SECTION
(NOT TO SCALE)

*GRUBBING MATERIAL SHALL NOT BE PLACED ON THE STONE FILL IN THE AREA UNDER THE BRIDGE. WHENEVER CHANNEL SLOPE INTERSECTS ROADWAY SUBBASE, GRUBBING MATERIAL SHALL BEGIN AT THE BOTTOM OF SUBBASE.

PROJECT NAME:	GUILFORD
PROJECT NUMBER:	BR01442(36)
FILE NAME:	z10j064typ.dgn
PROJECT LEADER:	S.E. BURBANK
DESIGNED BY:	E.A. FIALA
TYP EARTHWORK AND ROADWAY SECTIONS	
PLOT DATE:	10/2/2013
DRAWN BY:	E.A. FIALA
CHECKED BY:	S.E. BURBANK
SHEET	4 OF 42



PROJECT NOTES

GENERAL

1. ALL MATERIALS AND CONSTRUCTION SHALL CONFORM TO THE STATE OF VERMONT AGENCY OF TRANSPORTATION STANDARD SPECIFICATIONS FOR CONSTRUCTION, DATED 2011, AND ITS LATEST REVISIONS, AND THE AASHTO LRFD BRIDGE DESIGN SPECIFICATIONS, 6TH EDITION, AND ITS LATEST REVISIONS.
2. ALL PRECAST CONCRETE ELEMENTS TO BE FABRICATED TO THE SPECIFIED DIMENSIONS WITHIN THE TOLERANCES DICTATED IN THE PRECAST/PRESTRESSED CONCRETE INSTITUTE TOLERANCE MANUAL FOR PRECAST AND PRESTRESSED CONCRETE CONSTRUCTION, MNL 135-00, AND ITS LATEST REVISIONS.
3. THE BRIDGE IS DESIGNED FOR HL-93 LIVE LOAD WITH A 7 INCH ALLOWANCE FOR FUTURE AGGREGATE SURFACE COURSE.
4. ALL WORK AND ANY ASSOCIATED ACTIVITY ON THIS PROJECT SHALL BE PERFORMED WITHIN THE EXISTING RIGHT-OF-WAY LIMITS UNLESS OTHERWISE DESIGNATED BY THE TOWN OR NEGOTIATED BY THE CONTRACTOR WITH APPROPRIATE LANDOWNERS.
5. ALL DIMENSIONS ARE HORIZONTAL OR VERTICAL AND ARE GIVEN AT 68 DEGREES FAHRENHEIT UNLESS NOTED OTHERWISE.
6. ITEM 529.15 "REMOVAL OF STRUCTURE" IS FOR THE COMPLETE REMOVAL AND DISPOSAL OF THE EXISTING BRIDGE SUBSTRUCTURE AND SUPERSTRUCTURE, INCLUDING ALL BRIDGE RAIL, BEARINGS, AND ANCHOR BOLTS, WHERE THE REMOVAL IS OUTSIDE OF THE AREAS COVERED BY ANY OF THE EXCAVATION ITEMS.
7. THE EXISTING BRIDGE CONTAINS STRUCTURAL STEEL. THE STRUCTURAL STEEL MAY BE PAINTED WITH A MATERIAL THAT MAY CONTAIN LEAD. THE CONTRACTOR SHALL FOLLOW ALL APPLICABLE REGULATIONS WHEN HANDLING AND WORKING WITH THIS STEEL. THE REMOVED STRUCTURAL STEEL IS THE PROPERTY OF THE CONTRACTOR. THE CONTRACTOR SHALL IDENTIFY AND HOLD THE STATE, ITS OFFICERS, AND EMPLOYEES HARMLESS CONCERNING THE CONTRACTOR'S USE OR DISPOSITION OF THE REMOVED EXISTING STRUCTURAL STEEL.
8. THE CONTRACTOR SHALL VERIFY THE LOCATION OF ALL BURIED AND AERIAL UTILITIES AND POLES PRIOR TO STARTING WORK. SOME UTILITIES HAVE BEEN RELOCATED DURING THE PREPARATION OF THE PLANS AND THE CONTRACTOR WILL NEED TO COORDINATE WITH ALL UTILITY OWNERS TO CONFIRM ACTUAL LOCATION PRIOR TO CONSTRUCTION. SEE THE UTILITY SPECIAL PROVISIONS FOR ADDITIONAL INFORMATION AND REQUIREMENTS.
9. NO SUBSTITUTION FOR PRECAST CONCRETE WILL BE PERMITTED.

EARTHWORK AND RELATED ITEMS

10. STONE FILL, TYPE III SHALL BE PLACED IN FRONT OF THE ABUTMENTS BEFORE THE NEW BEAMS ARE SET.

TRAFFIC MAINTENANCE DURING CONSTRUCTION

11. THE CONTACTOR SHALL IMPLEMENT THE ROAD CLOSURE, AS SHOWN ON THE PLANS.
12. THE CONTRACTOR SHALL NOTIFY THE TOWN A MINIMUM OF TWO (2) WEEKS PRIOR TO CLOSING THE ROAD.
13. FULL ACCESS TO ALL SIDE ROADS AND DRIVES WITHIN THE PROJECT LIMITS SHALL BE MAINTAINED AT ALL TIMES. THIS WORK SHALL BE CONSIDERED INCIDENTAL TO ITEM 641.10, "TRAFFIC CONTROL".
14. THE DETOUR FOR THE BRIDGE CLOSURE IS THE RESPONSIBILITY OF THE TOWN.
15. UNLESS COVERED UNDER INDIVIDUAL PAY ITEMS OR NOTED OTHERWISE, ALL COSTS FOR TEMPORARY TRAFFIC CONTROL DEVICES WILL BE CONSIDERED TO BE INCLUDED IN THE CONTRACT LUMP SUM PRICE FOR TRAFFIC CONTROL, ITEM 641.10, "TRAFFIC CONTROL". THIS INCLUDES, BUT IS NOT LIMITED TO, THE FOLLOWING ITEMS:

TEMPORARY TRAFFIC BARRIERS
RETROREFLECTIVE DRUMS
TYPE III BARRICADES
SIGNS
SIGN POSTS

TEMPORARY TRAFFIC BARRIER SHALL BE FURNISHED IN ACCORDANCE WITH SECTION 621.

16. ALL SIGNS SHALL BE IN ACCORDANCE WITH THE CURRENT EDITIONS OF THE "MANUAL ON UNIFORM TRAFFIC CONTROL DEVICES" (MUTCD) AND THE "STANDARD HIGHWAY SIGNS AND MARKINGS" BOOK (SHSM) PUBLISHED BY THE FEDERAL HIGHWAY ADMINISTRATION (FHWA).

CONCRETE

17. ITEM 514.10, "WATER REPELLENT, SILANE" SHALL BE APPLIED TO ALL EXPOSED CONCRETE SURFACES ON THE BRIDGE SUPERSTRUCTURE AND SUBSTRUCTURE, WITH THE EXCEPTION OF THE UNDERSIDE OF THE BOX BEAMS BETWEEN THE DRIP NOTCHES.
18. ALL REINFORCING STEEL SHALL BE DETAILED AND FABRICATED USING PROCEDURES AND TOLERANCES IN ACCORDANCE WITH APPLICABLE PUBLICATIONS OF THE CONCRETE REINFORCING STEEL INSTITUTE (CRSI).
19. ALL PRECAST SUBSTRUCTURE CONCRETE SHALL MEET THE REQUIREMENTS OF SECTION 540-PRECAST CONCRETE.
20. ALL REINFORCEMENT IN THE PILE CAP AND WINGWALLS SHALL BE REINFORCING STEEL, LEVEL I IN ACCORDANCE WITH SECTION 507. ALL REINFORCING STEEL IN THE BOX BEAMS SHALL BE REINFORCING STEEL, LEVEL II IN ACCORDANCE WITH SECTION 507. PAYMENT FOR REINFORCING STEEL WILL BE INCLUDED IN THE UNIT PRICE BID FOR THE APPROPRIATE SECTION 510 OR 540 CONTRACT ITEM.
21. THE COST FOR THE PRECAST CONCRETE CURBS SHALL BE INCLUDED IN ITEM 510.21, "PRESTRESSED CONCRETE BOX BEAMS (BI-36)". THE CURBS SHALL BE CAST AT THE FABRICATION PLANT FOR THE BOX BEAMS IN ACCORDANCE WITH SECTION 540.

PRECAST ABUTMENTS AND POST-TENSIONING

22. IF VERTICAL CONSTRUCTION JOINTS ARE REQUIRED BY THE CONTRACTOR FOR SHIPMENT OF THE ABUTMENTS, THEN THE SECTIONS SHALL BE KEYED AND MATCH CAST. A JOINT DETAIL SHALL BE SHOWN ON THE FABRICATION DRAWINGS.
23. POST-TENSIONING AND ASSOCIATED ITEMS ARE ONLY REQUIRED IF THE PILE CAP IS CONSTRUCTED OF MORE THAN ONE UNIT. ANY POST-TENSIONING STRANDS AND CONDUIT SHALL ADHERE TO THE REQUIREMENTS OF SECTION 510 - PRESTRESSED CONCRETE. GALVANIZED ANCHOR ASSEMBLIES, CONDUIT, AND POST-TENSIONING STRANDS SHALL BE INCLUDED UNDER ITEM 540.10, "PRECAST CONCRETE STRUCTURE (ABUTMENT NO. 1)" OR "PRECAST CONCRETE STRUCTURE (ABUTMENT NO. 2)" AS APPROPRIATE. POST-TENSIONING STRANDS SHALL BE COVERED WITH SEAMLESS POLYPROPYLENE SHEATH (WITH CORROSION INHIBITOR GREASE BETWEEN SHEATH AND STRAND) FOR THE LENGTH OF THE STRAND, EXCEPT AT ANCHORAGE LOCATIONS.
24. GALVANIZE ANCHOR ASSEMBLIES AFTER FABRICATION ACCORDING TO AASHTO M23 2M/M 232.
25. DESIGN VALUES
 - A. CONCRETE COMPRESSIVE STRENGTH: $f'c = 5000$ PSI.
 - B. POST-TENSIONING STRANDS: 0.5 INCH DIAMETER, 270 KSI, LOW RELAXATION 7-WIRE STRANDS.
 - C. ASSUMED MODULUS OF ELASTICITY IS 28500 KSI.
 - D. THERE SHALL BE 2 STRANDS PER CONDUIT.
 - E. THE JACKING FORCE PER STRAND = 32 KIPS.
26. THE CONCRETE FOR THE ABUTMENT NO. 1 AND ABUTMENT NO. 2 PILE CAVITIES SHALL MEET THE REQUIREMENTS OF ITEM 900.608, "SPECIAL PROVISION (HIGH PERFORMANCE CONCRETE, RAPID SET)(FPQ)".
27. PROPOSED SEQUENCE OF CONSTRUCTION:
 - A. PREPARE AND GRADE FOUNDATION TO REQUIRED ELEVATION.
 - B. DRIVE PILES.
 - C. PLACE PRECAST ABUTMENTS AND INSTALL TRANSVERSE STRANDS (IF MORE THAN ONE UNIT).
 - D. APPLY EPOXY TO MATCH CAST FACES OF VERTICAL CONSTRUCTION JOINT.
 - E. USE A CALIBRATED JACK TO TENSION TO 3 KIPS TO REMOVE SAG IN STRANDS.
 - F. CHECK ALIGNMENT OF PILE CAP ELEMENTS.
 - G. STRESS POST-TENSIONING STRANDS USING A CALIBRATED JACK OPERATED BY QUALIFIED PERSONNEL WHO HAVE PREVIOUS EXPERIENCE IN POST-TENSIONING.
 - H. FILL PILE CAVITIES WITH ITEM 900.608, "SPECIAL PROVISION (HIGH PERFORMANCE CONCRETE, RAPID SET)(FPQ)".
 - I. PLACE PRECAST WINGWALLS AND GROUT SPLICE CONNECTORS.
 - J. BACKFILL MAY BE COMPLETE AFTER SPLICE CONNECTOR GROUT HAS REACHED 85% OF 5,000 PSI.
28. ALTERNATE SEQUENCE OF CONSTRUCTION MAY BE SUBMITTED FOR APPROVAL BY THE PROJECT MANAGER.

PRESTRESSED BOX BEAMS

29. ITEM 510.21 "PRESTRESSED CONCRETE BOX BEAMS" SHALL:
 - A. CONFORM TO SECTION 510 "PRESTRESSED CONCRETE".
 - B. HAVE THE ENDS OF THE STRANDS RECESSED AND GROUTED ACCORDING TO STANDARD PRACTICE.
 - C. INCLUDE COLD POURED JOINT FILLER, AND TRANSVERSE TENDONS.
 - D. GALVANIZE TRANSVERSE TENDON PLATES AND CHUCKS AFTER FABRICATION ACCORDING TO AASHTO M 232M/M 232.
30. ITEM 510.24 "GROUTING SHEAR KEYS": FILL THE JOINTS BETWEEN THE BEAMS WITH MORTAR, TYPE IV, AS SPECIFIED IN SUBSECTION 510.13.

PRESTRESSED BOX BEAMS (CONT.)

31. DESIGN VALUES
 - A. CONCRETE: $f'c = 6.0$ KSI AND $f'ci = 4.8$ KSI
 - B. LIVE LOAD: AASHTO HL-93
 - C. PRESTRESSING STRANDS: 0.6" DIAMETER, 270 KSI, LOW-RELAXATION 7-WIRE STRANDS PULLED TO 75% OF THEIR ULTIMATE TENSILE STRENGTH.
 - D. POST-TENSIONING STRANDS: 0.6" DIAMETER, 270 KSI, LOW-RELAXATION 7-WIRE STRANDS.
 - E. THE ASSUMED MODULUS OF ELASTICITY FOR THE STRAND IS 28,500 KSI.
 - F. THERE SHALL BE (1) STRAND PER TRANSVERSE TIE AT THE END DIAPHRAGM LOCATIONS AND (2) STRANDS PER TRANSVERSE TIE AT THE CENTER DIAPHRAGM.
 - G. TRANSVERSE TENDONS SHALL BE COVERED BY SEAMLESS POLYPROPYLENE SHEATH (WITH CORROSIVE INHIBITOR GREASE BETWEEN SHEATH AND STRAND) FOR THE LENGTH OF THE STRAND. TIES SHALL BE TENSIONED TO 47 KIPS FOR EACH 0.6" DIAMETER STRAND.
 - H. SERVICE LOADS

	EXTERIOR	INTERIOR
MEMBER MOMENT	228.4 K-FT	283.5 K-FT
SUPERIMPOSED DEAD LOAD MOMENT	241.3 K-FT	241.3 K-FT
LIVE LOAD & IMPACT MOMENT	284.6 K-FT	287.7 K-FT
DEAD LOAD REACTION	35.8 K	40.5 K
LIVE LOAD & IMPACT REACTION	45.8 K	44.1 K
TOTAL REACTION	81.6 K	84.6 K
RELEASE CAMBER	1.05 IN	0.70 IN
FINAL CAMBER	1.28 IN	0.78 IN
32. THE FABRICATOR MAY, WITH THE APPROVAL OF THE ENGINEER, ALTER THE DESIGN AS DETAILED TO MEET THE PLANT'S PRESTRESSING OPERATION AND MATERIAL REQUIREMENTS. ALTERNATE STRAND, TRANSVERSE TIE AND CROSS-SLOPE CONFIGURATIONS MAY BE SUBMITTED TO THE ENGINEER FOR APPROVAL. ANY DESIGN CHANGES SHALL MEET ALL OF THE APPLICABLE DESIGN CRITERIA, LOADINGS AND CODES; AND SHALL BE STAMPED AND SIGNED BY A PROFESSIONAL ENGINEER LICENSED IN THE STATE OF VERMONT.
33. THE PRECASTER SHALL SANDBLAST SHEAR KEY FACES PRIOR TO DELIVERY.
34. THE CONTRACTOR IS RESPONSIBLE FOR DESIGN OF ALL LIFTING POINTS, POST TENSIONING ELEMENTS IN THE ANCHORAGE ZONE AND ADDITIONAL REINFORCEMENT IN THE ANCHORAGE ZONE (REQUIRED FOR SPLITTING, BURSTING SPALLING, ETC.) INCLUDING THE LOCAL ZONE (REGION IMMEDIATELY SURROUNDING THE POST TENSIONING DEVICE). THE CONTRACTOR IS RESPONSIBLE FOR CONSIDERATION OF ADDITIONAL STRESSES DUE TO HANDLING. DESIGN MUST CONFORM TO AASHTO LRFD SPECIFICATIONS.
35. ANCHORING ASSEMBLIES, CONDUITS, GROUT FOR THE CONDUIT, MECHANICAL CONNECTORS, AND POST TENSIONING STRANDS SHALL BE INCLUDED IN ITEM 510.21, "PRESTRESSED CONCRETE BOX BEAMS".

PROPOSED CONSTRUCTION SEQUENCE FOR PRESTRESSED BOX BEAMS

36. LAYOUT WORKING LINES:
 - A. LAYOUT WORKING LINES FOR THE ENTIRE BRIDGE WIDTH ON THE BEAM SEAT.
 - B. MEASURE ALL WORKING LINES FROM A COMMON WORKING POINT.
 - C. BASE THE WORKING LINES ON THE NOMINAL BEAM WIDTHS.
37. VERIFY BEAM SEAT ELEVATIONS:
 - A. MEASURE ELEVATIONS AT BEAM SEATS.
 - B. IF SEATS ARE HIGH OR LOW, TAKE CORRECTIVE ACTION.
 - C. INSTALL BEARINGS.
38. ERECT BEAMS:
 - A. PLACE BEAMS TO FIT WITHIN THE WORKING LINES.
 - B. AS WORK PROGRESSES, INSTALL HARDWOOD WEDGES BETWEEN ADJACENT BEAMS TO MAINTAIN PROPER JOINT OPENING (A MINIMUM OF ONE WEDGE AT EACH TRANSVERSE TENDON).
 - C. DRILL ANCHOR BOLT HOLES
 - D. PLACE ANCHOR BOLTS.
39. INSTALL BACKER ROD: PLACE FILLER BELOW THE KEYWAY BOTTOM, AS SHOWN ON THE PLANS.
40. INSTALL TRANSVERSE TENDONS:
 - A. FEED TENDONS THROUGH DUCTS.
 - B. VERIFY THAT HARDWOOD WEDGES ARE IN PLACE AS REQUIRED TO PREVENT SLIPPAGE OF BEAMS.
 - C. USING A CALIBRATED JACK, POST-TENSION TENDONS TO APPROXIMATELY 5 KIPS TO REMOVE SAG IN THE TENDON AND TO SEAT THE CHUCK.
41. GROUT SHEAR KEYS:
 - A. CLEAN JOINTS WITH AN OIL FREE AIR-BLAST IMMEDIATELY BEFORE GROUT PLACEMENT. VERIFY THAT THE BACKER ROD IS STILL IN PLACE.
 - B. FOLLOW MANUFACTURER'S RECOMMENDATIONS FOR ADDITIONAL JOINT PREPARATION AND GROUT PLACEMENT.
 - C. CAREFULLY ROD JOINTS TO ELIMINATE ANY POSSIBILITY OF VOIDS.

REVISION	DESCRIPTION	DATE
△	REVISED NOTE 29D	12/3/2013
PROJECT NAME: GUILFORD		
PROJECT NUMBER: BRO 1442(3)		
FILE NAME: z10j064pn.dgn	PLOT DATE: 12/3/2013	
PROJECT LEADER: S.E. BURBANK	DRAWN BY: E.A. FIALA	
DESIGNED BY: J.T. KLEIN	CHECKED BY: S.E. BURBANK	
PROJECT NOTES (1 OF 2)	SHEET 5 OF 42	

PROJECT NOTES (CONT.)

42. POST-TENSION TRANSVERSE TENDONS:
- A. GROUT SHALL ATTAIN A MINIMUM COMPRESSIVE STRENGTH OF 1500 PSI, BASED ON THE MANUFACTURER'S RECOMMENDATIONS, PRIOR TO STRESSING. THE GROUT NEED NOT BE CURED FOR THREE DAYS PRIOR TO THE COMMENCING OF POST-TENSIONING.
 - B. PROVIDE APPROPRIATE CUBE MOLDS AS DESCRIBED IN AASHTO T106 FOR 3 SETS OF 3 DAY CUBES, 3 SETS OF 28 DAY CUBES AND A MINIMUM OF 3 MORE CUBES TO TEST FOR THE 3000 PSI MINIMUM COMPRESSIVE STRENGTH.
 - C. POST-TENSION TENDONS TO 47 KIPS EACH USING A CALIBRATED JACK OPERATED BY QUALIFIED PERSONNEL. BEGIN WITH TENDONS AT END AND WORK SYMMETRICALLY TOWARDS MID-SPAN FROM EACH END.
43. END DETAILS:
- A. GROUT ANCHOR BOLTS INTO THE SLEEVES IN THE PRE-STRESSED UNITS, BEFORE THE GROUT CURES, PLACE THE WASHER PLATE, AND INSTALL THE NUT ON TOP AND TIGHTEN.
 - B. GROUT OVER THE NUT AND BOLT IN THE ANCHOR BOLT BLOCK OUTS.
44. FINISH WORK: REMOVE WEDGES, AND PATCH SURFACE AND FASCIA BEAMS AT TRANSVERSE TENDONS.

H-PILES

45. THE PILES SHALL BE HP 14x89.
46. PILES SHALL BE DRIVEN TO REFUSAL IN BEDROCK. A NOMINAL PILE DRIVING RESISTANCE (RNDR) OF 332 KIPS IS REQUIRED BY DESIGN, PROVIDED A MINIMUM PENETRATION OF 25 FEET BELOW THE BOTTOM OF PILE CAP HAS BEEN ACHIEVED. TO PREVENT DAMAGE TO THE PILES, PILE SHOES ARE REQUIRED AND SHALL CONFORM TO SUBSECTION 505.04(f).
47. A MINIMUM OF THREE DYNAMIC TESTS ARE REQUIRED DURING PILE INSTALLATION. NO LESS THAN ONE DYNAMIC PILE TEST SHALL BE CONDUCTED AT EACH ABUTMENT. PAYMENT WILL BE MADE UNDER ITEM 505.45, "DYNAMIC PILE LOADING TEST".
48. THE TOPS OF THE PILES AFTER DRIVING SHALL NOT VARY FROM THE POSITION SHOWN ON THE PLANS BY MORE THAN 3 INCHES. THE PILE ORIENTATION SHALL NOT VARY BY MORE THAN 5 DEGREES. THE CONTRACTOR SHALL DEMONSTRATE TO THE SATISFACTION OF THE ENGINEER HOW THE TOLERANCES WILL BE MET. THESE MEASURES SHALL BE DEMONSTRATED IN A SUBMITTAL TO BE ACCEPTED BEFORE PILE DRIVING COMMENCES.
49. FOR ESTIMATING PURPOSES, THE PILE TIP ELEVATIONS WERE ASSUMED AS SHOWN ON THE BORING LOGS. THE ACTUAL PLACE LENGTHS MAY VARY.

QUANTITY SHEET 1

SUMMARY OF ESTIMATED QUANTITIES										TOTALS		DESCRIPTIONS				DETAILED SUMMARY OF QUANTITIES		
						ROADWAY	EROSION CONTROL	BRIDGE	FULL C.E. ITEMS	GRAND TOTAL	FINAL	UNIT	ITEMS	ITEM NUMBER	ROUND	QUANTITIES	UNIT	ITEMS
						1				1		LS	CLEARING AND GRUBBING, INCLUDING INDIVIDUAL TREES AND STUMPS	201.10				
						500				500		CY	COMMON EXCAVATION	203.15				
								520		520		CY	UNCLASSIFIED CHANNEL EXCAVATION	203.27				
								20		20		CY	SAND BORROW	203.31				
						1				1		CY	TRENCH EXCAVATION OF EARTH, EXPLORATORY (N.A.B.I.)	204.22				
								200		200		CY	STRUCTURE EXCAVATION	204.25				
								150		150		CY	GRANULAR BACKFILL FOR STRUCTURES	204.30				
						280				280		CY	SUBBASE OF GRAVEL	301.15				
						100		20		120		CY	AGGREGATE SURFACE COURSE	401.10				
								1		1		LS	FURNISHING EQUIPMENT FOR DRIVING PILING	504.10				
								335		335		LF	STEEL PILING, HP 14 X 89	505.18				
								4		4		EACH	DYNAMIC PILE LOADING TEST	505.45				
								117		117		LF	PRESTRESSED CONCRETE BOX BEAMS (27" X 36")	510.21				
								175		175		LF	PRESTRESSED CONCRETE BOX BEAMS (27" X 48")	510.21				
								233		233		LF	GROUTING SHEAR KEYS	510.24				
								9		9		GAL	WATER REPELLENT, SILANE	514.10				
								101		101		SY	MEMBRANE WATERPROOFING, SPRAY APPLIED	520.10				
								84		84		SY	REMOVAL OF BRIDGE PAVEMENT	529.10				
								1		1		EACH	REMOVAL OF STRUCTURE (756 SF - EST.)	529.15				
								20		20		EACH	BEARING DEVICE ASSEMBLY, STEEL REINFORCED ELASTOMERIC PAD	531.17				
								1		1		LS	PRECAST CONCRETE STRUCTURE (ABUTMENT NO. 1)	540.10				
								1		1		LS	PRECAST CONCRETE STRUCTURE (ABUTMENT NO. 2)	540.10				
						0.1				0.1		MGAL	DUST CONTROL WITH WATER	609.10				
								400		400		CY	STONE FILL, TYPE III	613.12				
						58				58		LF	STEEL BEAM GUARDRAIL, GALVANIZED	621.20				
						38				38		LF	STEEL BEAM GUARDRAIL, GALVANIZED W/8 FEET POSTS	621.205				
						4				4		EACH	ANCHOR FOR STEEL BEAM RAIL	621.60				
						4				4		EACH	GUARDRAIL APPROACH SECTION, GALV HD STEEL BEAM W/8FT POSTS	621.738				
						87				87		LF	REMOVAL AND DISPOSAL OF GUARDRAIL	621.80				
						40				40		HR	FLAGGERS	630.15				
									1	1		LS	FIELD OFFICE, ENGINEERS	631.10				
									1	1		LS	TESTING EQUIPMENT, CONCRETE	631.16				
									3000	3000		DL	FIELD OFFICE TELEPHONE (N.A.B.I.)	631.26				
						1				1		LS	MOBILIZATION/DEMOBILIZATION	635.11				
						1				1		LS	TRAFFIC CONTROL	641.10				
								540		540		SY	GEOTEXTILE UNDER STONE FILL	649.31				
							60			60		SY	GEOTEXTILE FOR SILT FENCE	649.51				
							90			90		SY	GEOTEXTILE FOR FILTER CURTAIN	649.61				
							4			4		LB	SEED	651.15				
							45			45		LB	FERTILIZER	651.18				

PROJECT NAME:	GUILFORD
PROJECT NUMBER:	BRO 1442(36)
FILE NAME: z10J064qs.dgn	PLOT DATE: 10/01/2013
PROJECT LEADER: S.E. BURBANK	DRAWN BY: A.J. GOUDREAU
DESIGNED BY: S.E. BURBANK	CHECKED BY: E.B. PARIZO
QUANTITY SHEET #1	SHEET 7 OF 42



QUANTITY SHEET 2

SUMMARY OF ESTIMATED QUANTITIES										TOTALS		DESCRIPTIONS				DETAILED SUMMARY OF QUANTITIES		
						ROADWAY	EROSION CONTROL	BRIDGE	FULL C.E. ITEMS	GRAND TOTAL	FINAL	UNIT	ITEMS	ITEM NUMBER	ROUND	QUANTITIES	UNIT	ITEMS
							0.2			0.2		TON	AGRICULTURAL LIMESTONE	651.20				
							0.2			0.2		TON	HAY MULCH	651.25				
							12			12		CY	TOPSOIL	651.35				
							275			275		SY	GRUBBING MATERIAL	651.40				
							1			1		LS	EPSC PLAN	652.10				
							80			80		HR	MONITORING EPSC PLAN	652.20				
							1			1		LU	MAINTENANCE OF EPSC PLAN (N.A.B.I.)	652.30				
							100			100		SY	TEMPORARY EROSION MATTING	653.20				
							30			30		CY	VEHICLE TRACKING PAD	653.35				
							180			180		LF	BARRIER FENCE	653.50				
							315			315		LF	PROJECT DEMARCATION FENCE	653.55				
						30				30		SF	TRAFFIC SIGNS, TYPE A	675.20				
						120				120		LF	SQUARE TUBE SIGN POST AND ANCHOR	675.341				
								6		6		CY	SPECIAL PROVISION (HIGH PERFORMANCE CONCRETE, RAPID SET)(FPQ)	900.608				
								125		125		LF	SPECIAL PROVISION (BRIDGE RAILING, GALVANIZED HDSB/FASCIA MOUNTED/STEEL TUBING)	900.640				
								1		1		LU	SPECIAL PROVISION (INCENTIVE/DISINCENTIVE) (N.A.B.I.)	900.650				
								25		25		SF	SPECIAL PROVISION (RETAINING WALL)	900.670				

PROJECT NAME: **GUILFORD**
 PROJECT NUMBER: **BRO 1442(36)**
 FILE NAME: z10J064qs.dgn PLOT DATE: 10/01/2013
 PROJECT LEADER: S.E. BURBANK DRAWN BY: A.J. GOUDREAU
 DESIGNED BY: S.E. BURBANK CHECKED BY: E.B. PARIZO
 QUANTITY SHEET #2 SHEET 8 OF 42



GENERAL INFORMATION

SYMBOLY LEGEND NOTE

THE SYMBOLY ON THIS SHEET IS INTENDED TO COVER STANDARD CONVENTIONAL SYMBOLY. THE SYMBOLY IS USED FOR EXISTING & PROPOSED FEATURES WITH HEAVIER LINEWEIGHT, IN COMBINATION WITH PROJECT ANNOTATION, AS NOTED ON PROJECT PLAN SHEETS. THIS LEGEND SHEET COVERS THE BASICS. SYMBOLY ON PLANS MAY VARY, PLAN ANNOTATIONS AND NOTES SHOULD BE USED TO CLARIFY AS NEEDED.

COMMON TOPOGRAPHIC POINT SYMBOLS

POINT CODE	DESCRIPTION
⊕	APL BOUND APPARENT LOCATION
◻	BM BENCH MARK
□	BND BOUND
⊠	CB CATCH BASIN
⊕	COMB COMBINATION POLE
⊠	DITHR DROP INLET THROATED DNC
⊕	EL ELECTRIC POWER POLE
◊	FPOLE FLAGPOLE
⊙	GASFIL GAS FILLER
⊙	GP GUIDE POST
⊗	GSO GAS SHUT OFF
◊	GUY GUY POLE
◊	GUYW GUY WIRE
⊗	GV GATE VALVE
⊕	H TREE HARDWOOD
△	HCTRL CONTROL HORIZONTAL
▲	HVCTRL CONTROL HORIZ. & VERTICAL
◇	HYD HYDRANT
◊	IP IRON PIN
◊	IPIPE IRON PIPE
⊕	LI LIGHT - STREET OR YARD
⊕	MB MAILBOX
◊	MH MANHOLE (MH)
□	MM MILE MARKER
◊	PM PARKING METER
⊠	PMK PROJECT MARKER
⊕	POST POST STONE/WOOD
⊕	RRSIG RAILROAD SIGNAL
⊕	RRSL RAILROAD SWITCH LEVER
⊕	S TREE SOFTWOOD
⊕	SAT SATELLITE DISH
⊕	SHRUB SHRUB
⊕	SIGN SIGN
⊕	STUMP STUMP
⊕	TEL TELEPHONE POLE
⊕	TIE TIE
⊕	TSIGN SIGN W/DOUBLE POST
⊕	VCTRL CONTROL VERTICAL
◊	WELL WELL
⊗	WSO WATER SHUT OFF

THESE ARE COMMON VAOT SURVEY POINT SYMBOLS FOR EXISTING FEATURES, ALSO USED FOR PROPOSED FEATURES WITH HEAVIER LINEWEIGHT, IN COMBINATION WITH PROPOSED ANNOTATION.

PROPOSED GEOMETRY CODES

CODE	DESCRIPTION
PC	POINT OF CURVATURE
PI	POINT OF INTERSECTION
CC	CENTER OF CURVE
PT	POINT OF TANGENCY
PCC	POINT OF COMPOUND CURVE
PRC	POINT OF REVERSE CURVE
POB	POINT OF BEGINNING
POE	POINT OF ENDING
STA	STATION PREFIX
AH	AHEAD STATION SUFFIX
BK	BACK STATION SUFFIX
D	CURVE DEGREE OF (100FT)
R	CURVE RADUIS OF
T	CURVE TANGENT LENGTH
L	CURVE LENGTH OF
E	CURVE EXTERNAL DISTANCE

R.O.W. ABBREVIATIONS (CODES) & SYMBOLS

POINT CODE	DESCRIPTION
CH	CHANNEL EASEMENT
CONST	CONSTRUCTION EASEMENT
CUL	CULVERT EASEMENT
D&C	DISCONNECT & CONNECT
DIT	DITCH EASEMENT
DR	DRAINAGE EASEMENT
DRIVE	DRIVEWAY EASEMENT
EC	EROSION CONTROL
I&M	INSTALL & MAINTAIN EASEMENT
LAND	LANDSCAPE EASEMENT
SR	SLOPE RIGHT
UE	UTILITY EASEMENT
(P)	PERMANENT EASEMENT
(T)	TEMPORARY EASEMENT
■	BNDNS BOUND SET
⊠	BNDNS BOUND TO BE SET
●	IPNS IRON PIN SET
⊙	IPNS IRON PIN TO BE SET
⊠	CALC CALCULATED ROW POINT [DISTANCE]
	DISTANCE CARRIED ON NEXT SHEET

UTILITY SYMBOLY

UNDERGROUND UTILITIES

— UT —	TELEPHONE
— UE —	ELECTRIC
— UC —	CABLE (TV)
— UEC —	ELECTRIC+CABLE
— UET —	ELECTRIC+TELEPHONE
— UCT —	CABLE+TELEPHONE
— UECT —	ELECTRIC+CABLE+TELEP.
— G —	GAS LINE
— W —	WATER LINE
— S —	SANITARY SEWER (SEPTIC)

ABOVE GROUND UTILITIES (AERIAL)

— T —	TELEPHONE
— E —	ELECTRIC
— C —	CABLE (TV)
— EC —	ELECTRIC+CABLE
— ET —	ELECTRIC+TELEPHONE
— AER E&T —	ELECTRIC+TELEPHONE
— CT —	CABLE+TELEPHONE
— ECT —	ELECTRIC+CABLE+TELEP.
—	UTILITY POLE GUY WIRE

PROJECT CONSTRUCTION SYMBOLY

PROJECT DESIGN & LAYOUT SYMBOLY

— — — CZ — — —	CLEAR ZONE
—————	PLAN LAYOUT MATCHLINE

PROJECT CONSTRUCTION FEATURES

▲ —▲—▲—▲—▲	TOP OF CUT SLOPE
○ —○—○—○—○	TOE OF FILL SLOPE
⊗ —⊗—⊗—⊗—⊗	STONE FILL
— — — — —	BOTTOM OF DITCH
— — — — —	CULVERT PROPOSED
— — — — —	STRUCTURE SUBSURFACE
PDF — PDF	PROJECT DEMARCATION FENCE
BF — BF	BARRIER FENCE
XXXXXXXXXXXXXXXXXXXX	TREE PROTECTION ZONE (TPZ)
//////	STRIPING LINE REMOVAL
~~~~~	SHEET PILES

**CONVENTIONAL BOUNDARY SYMBOLY**

**BOUNDARY LINES**

—————	TOWN LINE	TOWN BOUNDARY LINE
—————	COUNTY LINE	COUNTY BOUNDARY LINE
—————	STATE LINE	STATE BOUNDARY LINE
———		PROPOSED STATE R.O.W. (LIMITED ACCESS)
———		PROPOSED STATE R.O.W.
———		STATE ROW (LIMITED ACCESS)
———		STATE ROW
———		TOWN ROW
— — — — —		PERMANENT EASEMENT LINE (P)
- - - - -		TEMPORARY EASEMENT LINE (T)
+		SURVEY LINE
P — P		PROPERTY LINE (P/L)
L — L		
SR — SR — SR		SLOPE RIGHTS
6f — 6f — 6f		6F PROPERTY BOUNDARY
4f — 4f — 4f		4F PROPERTY BOUNDARY
HAZ — HAZ		HAZARDOUS WASTE

**EPSC LAYOUT PLAN SYMBOLY**

**EPSC MEASURES**

ONNOONNOONNO	FILTER CURTAIN
— — — — —	SILT FENCE
— — — — —	SILT FENCE WOVEN WIRE
▶ —▶—▶—▶	CHECK DAM
▨	DISTURBED AREAS REQUIRING RE-VEGETATION
⊗	EROSION MATTING

**ENVIRONMENTAL RESOURCES**

— — — — —	WETLAND BOUNDARY
— — — — —	RIPARIAN BUFFER ZONE
— — — — —	WETLAND BUFFER ZONE
— — — — —	SOIL TYPE BOUNDARY
— T&E —	THREATENED & ENDANGERED SPECIES
HAZ — HAZ	HAZARDOUS WASTE AREA
— AG —	AGRICULTURAL LAND
— HABITAT —	FISH & WILDLIFE HABITAT
— FLOOD PLAIN —	FLOOD PLAIN
— OHW —	ORDINARY HIGH WATER (OHW)
— — — — —	STORM WATER
— — — — —	USDA FOREST SERVICE LANDS
— — — — —	WILDLIFE HABITAT SUIT/CONN

**ARCHEOLOGICAL & HISTORIC**

— ARCH —	ARCHEOLOGICAL BOUNDARY
— HISTORIC DIST —	HISTORIC DISTRICT BOUNDARY
— HISTORIC —	HISTORIC AREA
Ⓜ	HISTORIC STRUCTURE

**CONVENTIONAL TOPOGRAPHIC SYMBOLY**

**EXISTING FEATURES**

— — — — —	ROAD EDGE PAVEMENT
— — — — —	ROAD EDGE GRAVEL
— — — — —	DRIVEWAY EDGE
— — — — —	DITCH
—————	FOUNDATION
— — — — —	FENCE (EXISTING)
□ —□—□—□—□	FENCE WOOD POST
○ —○—○—○—○	FENCE STEEL POST
~~~~~	GARDEN
○ —○—○—○—○	ROAD GUARDRAIL
	RAILROAD TRACKS
— — — — —	CULVERT (EXISTING)
— — — — —	STONE WALL
— — — — —	WALL
~~~~~	WOOD LINE
~~~~~	BRUSH LINE
~~~~~	HEDGE
~~~~~	BODY OF WATER EDGE
~~~~~	LEDGE EXPOSED

PROJECT NAME: GUILFORD  
PROJECT NUMBER: BRO 1442(36)

FILE NAME: z10J064Legend_Sheet.dgn  
PROJECT LEADER: S.E. BURBANK  
DESIGNED BY: VTRANS  
CONVENTIONAL SYMBOLY SHEET

PLOT DATE: 10/2/2013  
DRAWN BY: C.L. CILLEY  
CHECKED BY: S.E. BURBANK  
SHEET 9 OF 42

GPS CONTROL POINTS

**HVCTRL #5**

SPIKE SET  
 NORTH = 113221.63  
 EAST = 1593373.11  
 ELEV. = 1043.36

GENERAL LOCATION WEST GUILFORD, VERMONT. TO REACH FROM THE INTERSECTION OF U.S. ROUTE 5 AND GUILFORD CENTER ROAD (T.H.1) IN GUILFORD, PROCEED SOUTHWEST ALONG GUILFORD CENTER ROAD (T.H.1) FOR 3.7 MI (6.0 KM) TO GUILFORD CENTER. FROM GUILFORD CENTER PROCEED WEST ALONG CARPENTER HILL ROAD (T.H.18) FOR 2.2 MI (3.5 KM) TO THE INTERSECTION WITH HINESBURG ROAD (T.H.2) IN WEST GUILFORD. PROCEED NORTHWEST ON HINESBURG ROAD (T.H.2) FOR 0.3 MI (0.5 KM). BEAR LEFT ONTO HALE ROAD (T.H.10) AND PROCEED FOR APPROXIMATELY 0.9 MI (1.4 KM). THE MARK IS SET IN A LAWN APPROXIMATELY 73 FT (22.3 M) SOUTHWEST OF THE CENTERLINE OF HALE ROAD, APPROXIMATELY 163 FT (49.7 M) SOUTHWEST OF UTILITY POLE #17 AND APPROXIMATELY 183 FT (55.8 M) SOUTHWEST OF THE NORTHEAST CORNER OF A 2 STORY WOOD FRAME HOUSE.

**VCTRL #100**

MAG NAIL SET  
 NORTH = 111846.61  
 EAST = 1596492.50  
 ELEV. = 943.43





STATION MARK IS SET IN EDGE OF PAVEMENT EAST OF THE INTERSECTION OF HINESBURG ROAD (T.H.2) AND HALE ROAD (T.H.10). ELEVATION TRANSFERRED FROM NEARBY USGS DISK STAMPED "USGS 25 REM 1942 934".

REFERENCE INFORMATION FOR USGS 25 REM:

GENERAL LOCATION, GUILFORD, VT. IN VILLAGE OF HINESBURG (WEST GUILFORD), 31 FT (9.4 M) WEST OF ROAD, 16 FT (4.9 M) EAST OF FOOT PATH, 50 FT (15.2 M) WEST OF NORTHWEST CORNER OF CORNER BLACKSMITH SHOP, 220 FT (67.1 M) FROM ROAD FORK, IN ROCK LEDGE.

APPROX. LATITUDE: 42°48'24" N  
 APPROX. LONGITUDE: 72°39'49" W  
 ELEVATION: 933.477 FT

TRAVERSE TIES

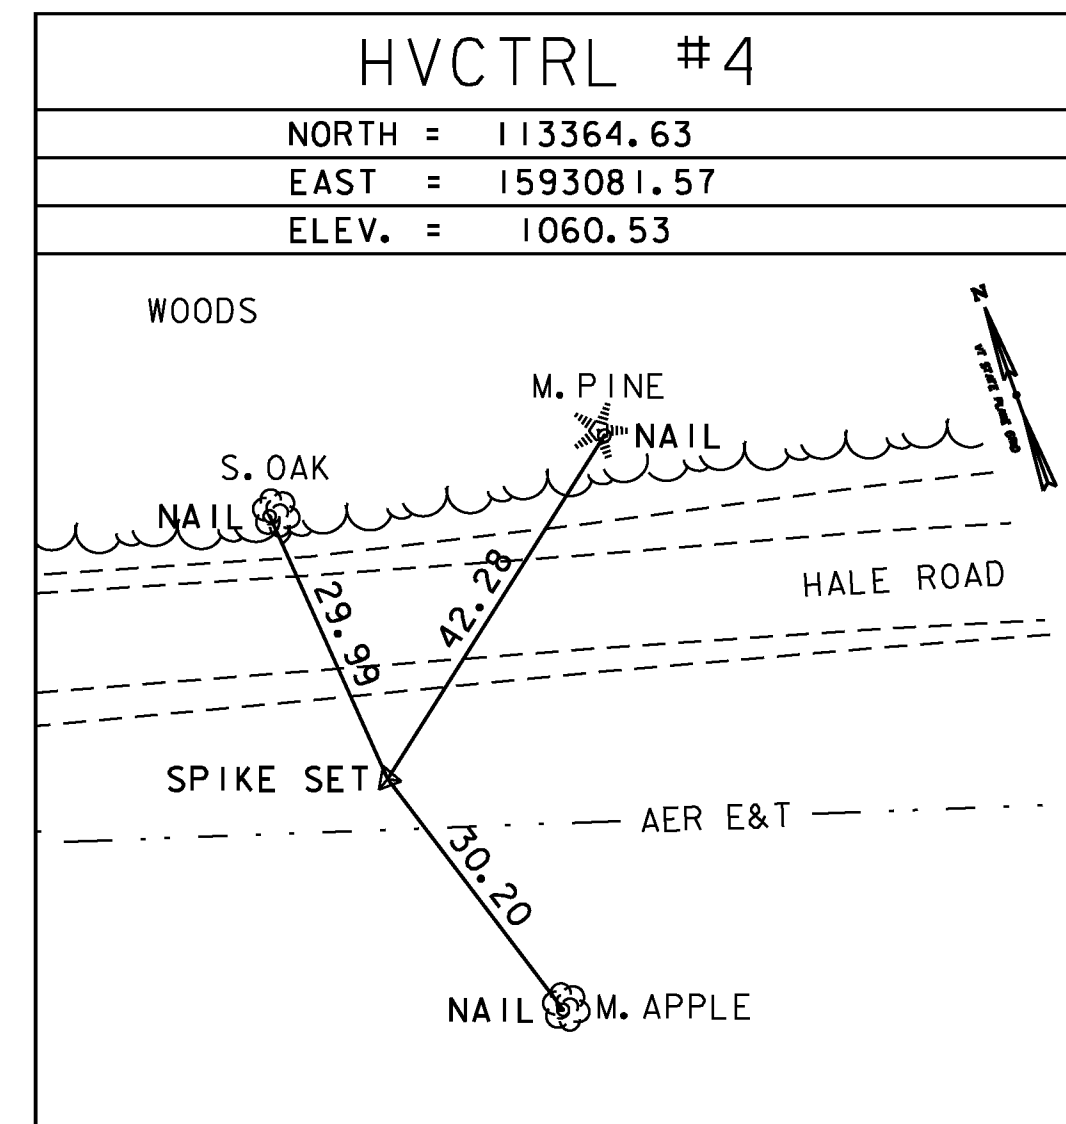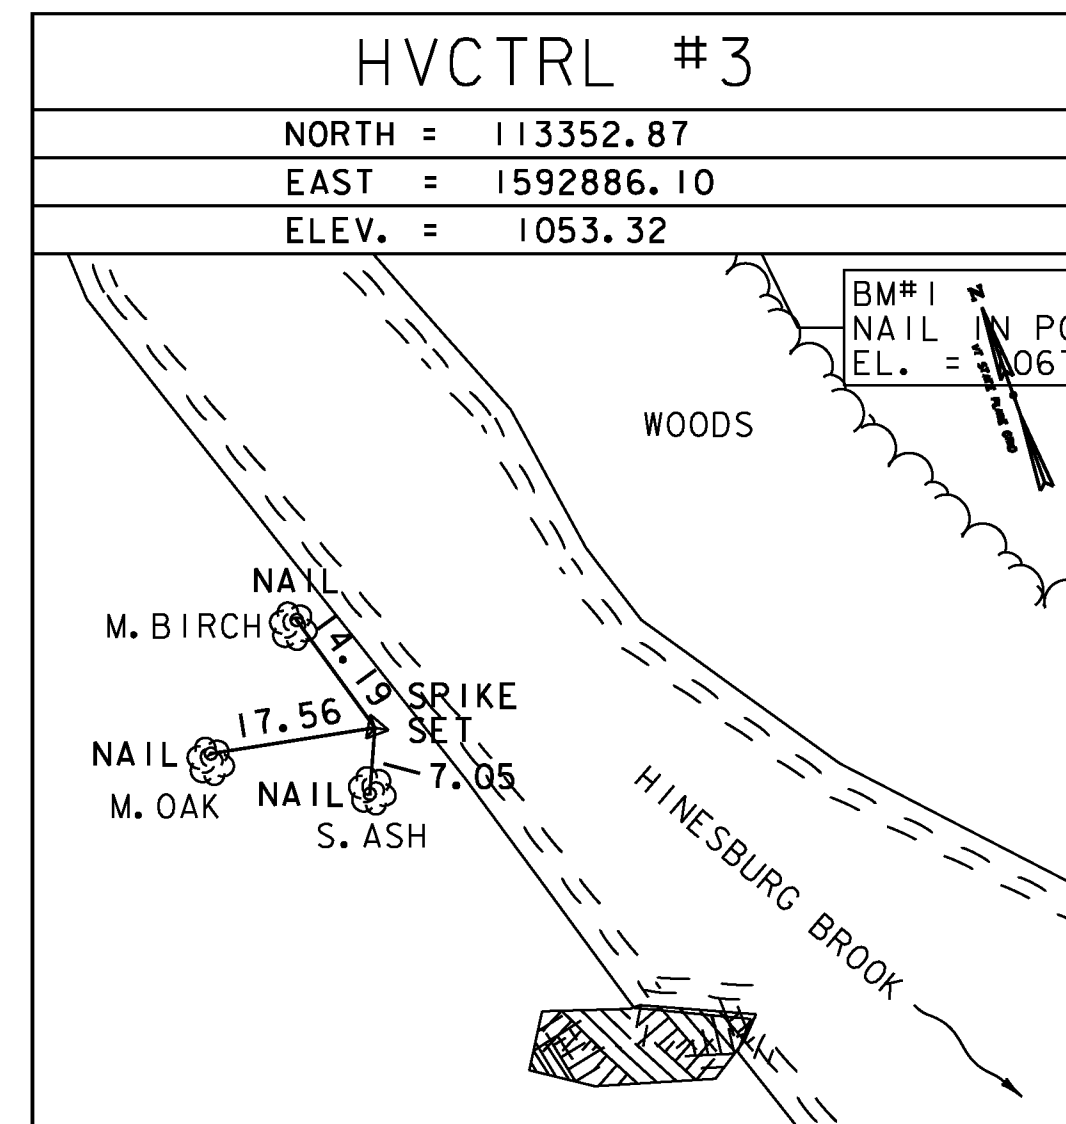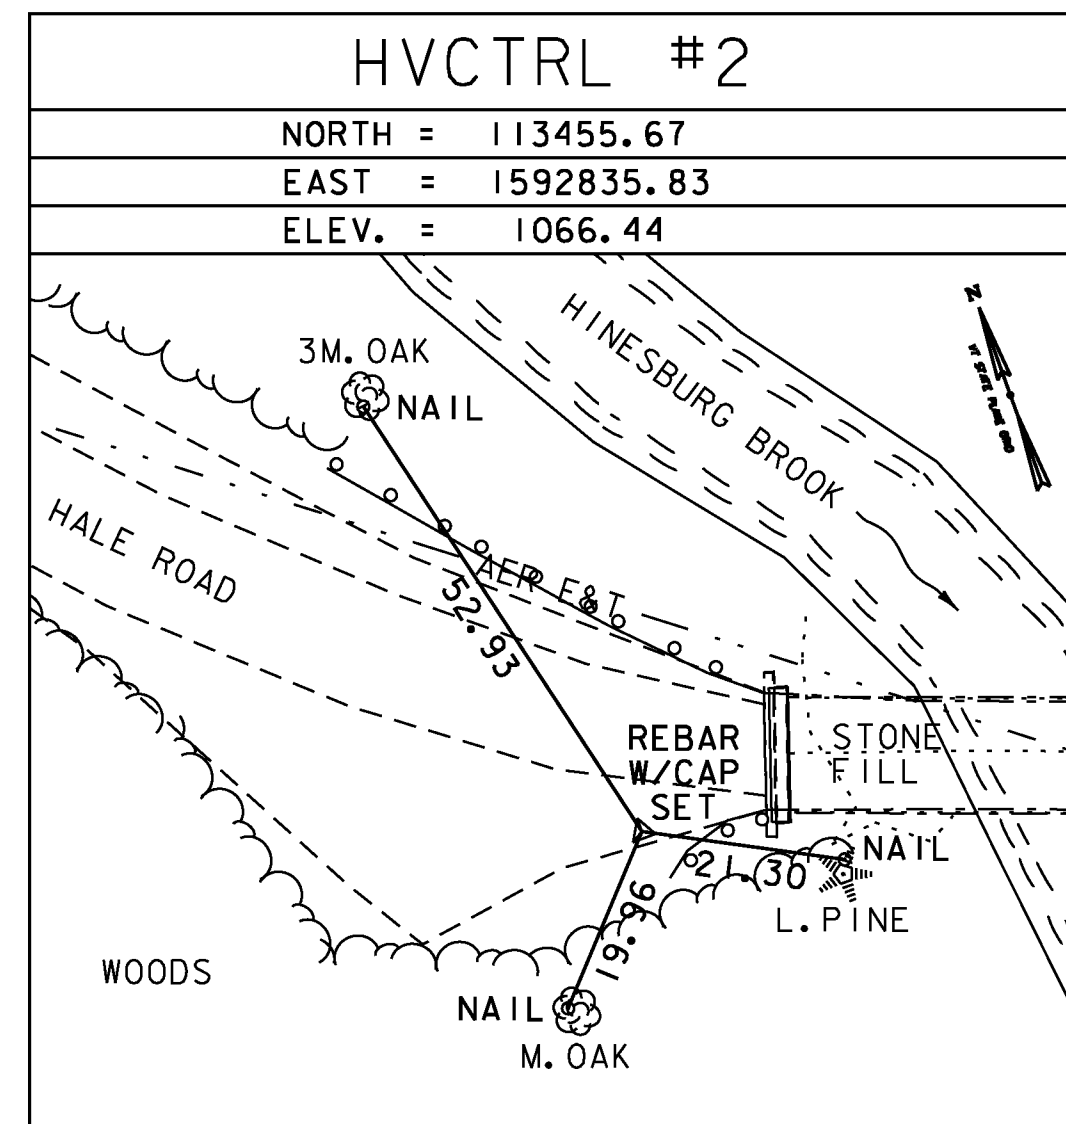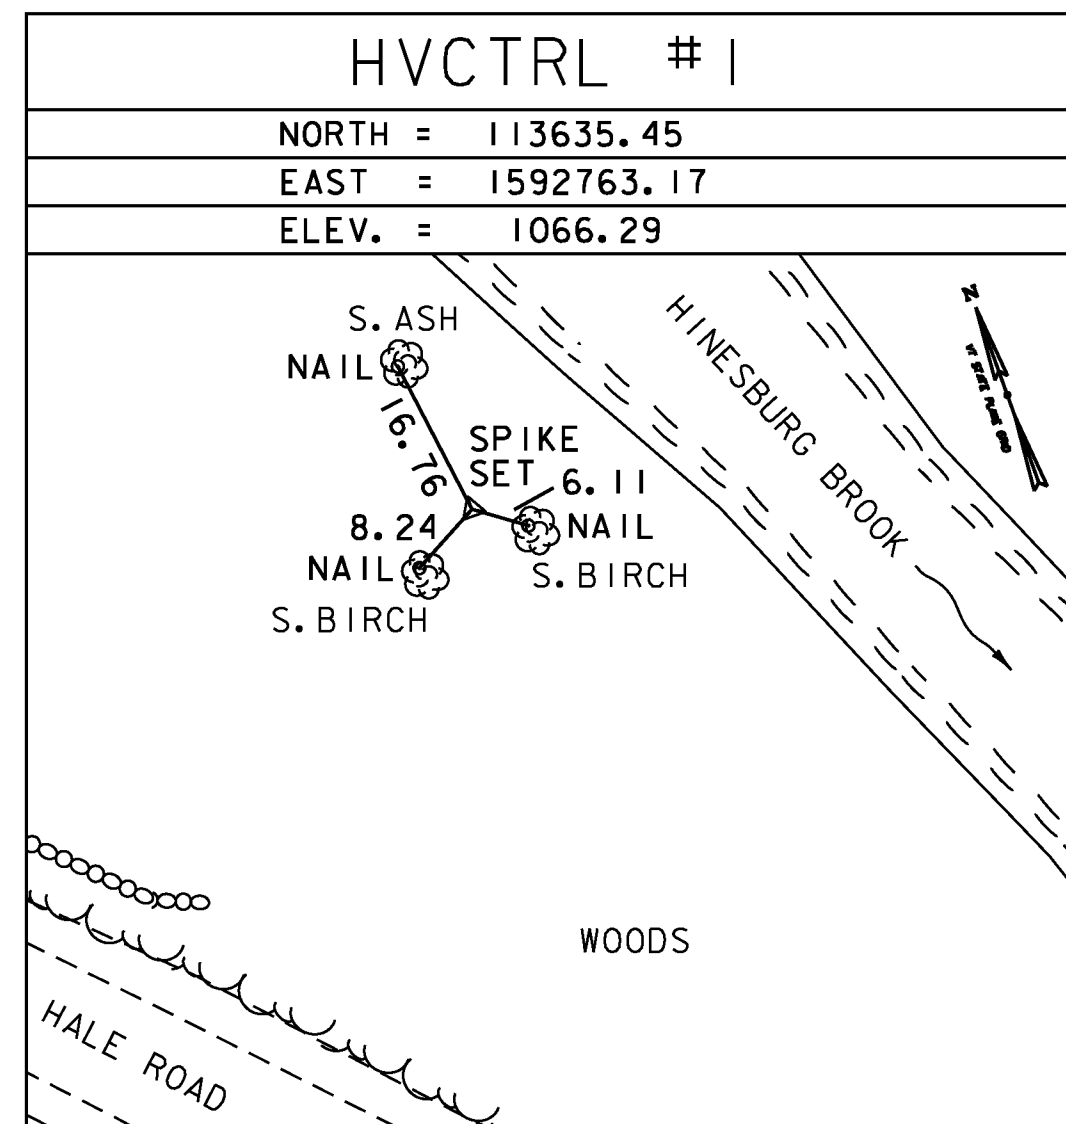

• Main Traverse Completed 11/18/10 by T.J.Gaudet & B.M.Klinefelter

DATUM	
VERTICAL	NAVD 88
HORIZONTAL	NAD 83 (07)



PROJECT NAME: GUILFORD	
PROJECT NUMBER: BRO 1442(36)	
FILE NAME: z10j064t1.dgn	PLOT DATE: 10/2/2013
PROJECT LEADER: S.E. BURBANK	DRAWN BY: B.M. KLINEFELTER
DESIGNED BY: B.M. KLINEFELTER	CHECKED BY: S.E. BURBANK
TIE SHEET	SHEET 10 OF 42



HALE ROAD (T.H. 10)  
 CURVE NO. 1 DATA  
 $\Delta = 4^\circ 34' 56.70''$   
 $D = 5^\circ 43' 46.48''$   
 $R = 1000.00'$   
 $T = 40.01'$   
 $L = 79.98'$   
 $E = 0.80'$   
 BANK = NORMAL CROWN

HALE ROAD (T.H. 10)  
 CURVE NO. 2 DATA  
 $\Delta = 29^\circ 15' 49.39''$   
 $D = 47^\circ 44' 47.34''$   
 $R = 120.00'$   
 $T = 31.33'$   
 $L = 61.29'$   
 $E = 4.02'$   
 BANK = NORMAL CROWN

HALE ROAD (T.H. 10)  
 CURVE NO. 3 DATA  
 $\Delta = 4^\circ 08' 36.55''$   
 $D = 3^\circ 10' 59.16''$   
 $R = 1800.00'$   
 $T = 65.11'$   
 $L = 130.17'$   
 $E = 1.18'$   
 BANK = NORMAL CROWN

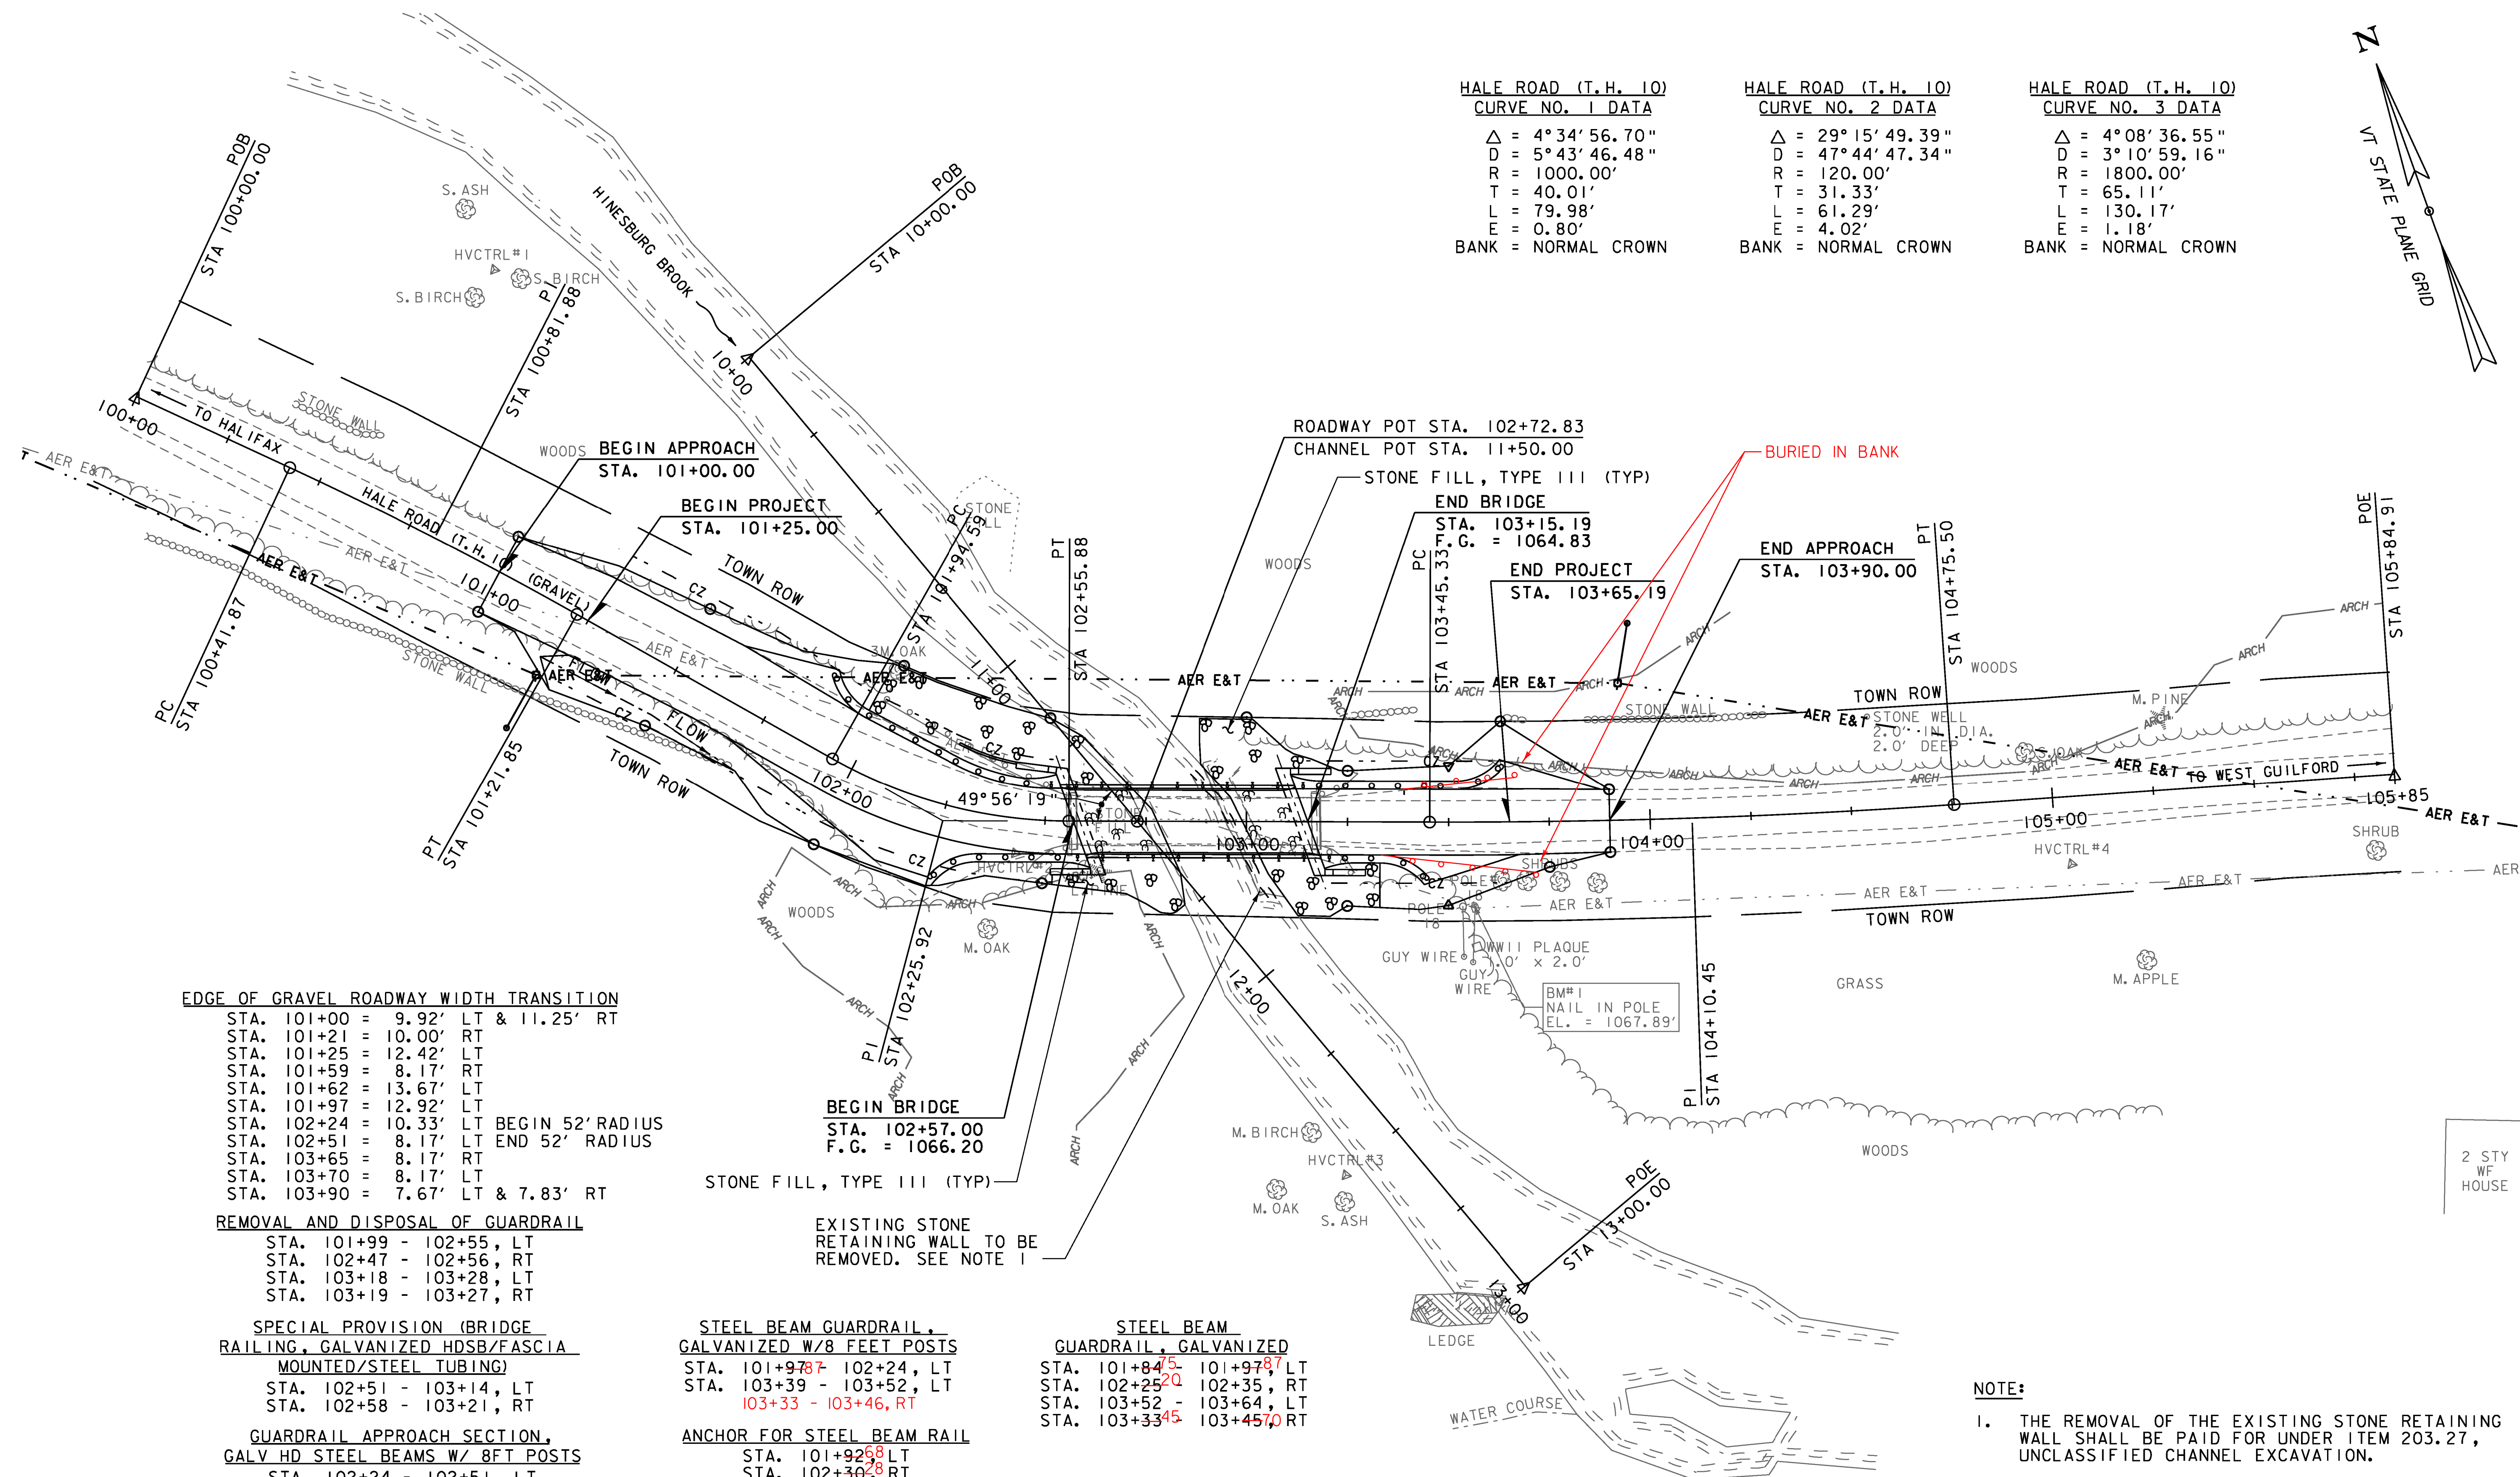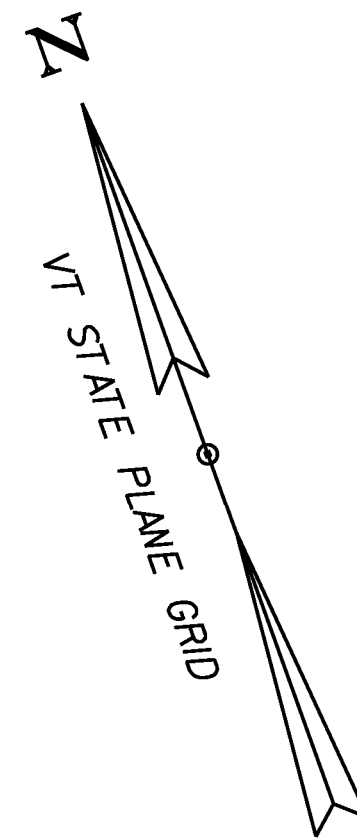

**EDGE OF GRAVEL ROADWAY WIDTH TRANSITION**

STA. 101+00	=	9.92' LT & 11.25' RT
STA. 101+21	=	10.00' RT
STA. 101+25	=	12.42' LT
STA. 101+59	=	8.17' RT
STA. 101+62	=	13.67' LT
STA. 101+97	=	12.92' LT
STA. 102+24	=	10.33' LT BEGIN 52' RADIUS
STA. 102+51	=	8.17' LT END 52' RADIUS
STA. 103+65	=	8.17' RT
STA. 103+70	=	8.17' LT
STA. 103+90	=	7.67' LT & 7.83' RT

**REMOVAL AND DISPOSAL OF GUARDRAIL**  
 STA. 101+99 - 102+55, LT  
 STA. 102+47 - 102+56, RT  
 STA. 103+18 - 103+28, LT  
 STA. 103+19 - 103+27, RT

**SPECIAL PROVISION (BRIDGE RAILING, GALVANIZED HDSB/FASCIA MOUNTED/STEEL TUBING)**  
 STA. 102+51 - 103+14, LT  
 STA. 102+58 - 103+21, RT

**GUARDRAIL APPROACH SECTION, GALV HD STEEL BEAMS W/ 8FT POSTS**  
 STA. 102+24 - 102+51, LT  
 STA. 102+35 - 102+58, RT  
 STA. 103+14 - 103+39, LT  
 STA. 103+21 - 103+33, RT


**SPECIAL PROVISION (RETAINING WALL)**  
 STA. 102+24 - 102+41, LT

**STEEL BEAM GUARDRAIL, GALVANIZED W/8 FEET POSTS**  
 STA. 101+97 - 102+24, LT  
 STA. 103+39 - 103+52, LT  
 103+33 - 103+46, RT

**ANCHOR FOR STEEL BEAM RAIL**  
 STA. 101+92, LT  
 STA. 102+30, RT  
 STA. 103+38, RT  
 STA. 103+57, LT

EXISTING STONE RETAINING WALL TO BE REMOVED. SEE NOTE 1


**STEEL BEAM GUARDRAIL, GALVANIZED**  
 STA. 101+84, LT  
 STA. 102+25, RT  
 STA. 103+52 - 103+64, LT  
 STA. 103+33, RT

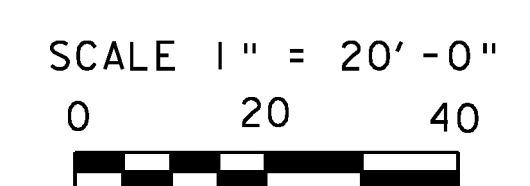

**NOTE:**  
 1. THE REMOVAL OF THE EXISTING STONE RETAINING WALL SHALL BE PAID FOR UNDER ITEM 203.27, UNCLASSIFIED CHANNEL EXCAVATION.

PROJECT NAME:	GUILFORD
PROJECT NUMBER:	BRO 1442(36)
FILE NAME:	z10j064bdr_nul.dgn
PROJECT LEADER:	S.E. BURBANK
DESIGNED BY:	E.A. FIALA
LAYOUT SHEET	
PLOT DATE:	10/2/2013
DRAWN BY:	E.A. FIALA
CHECKED BY:	S.E. BURBANK
SHEET	II OF 42



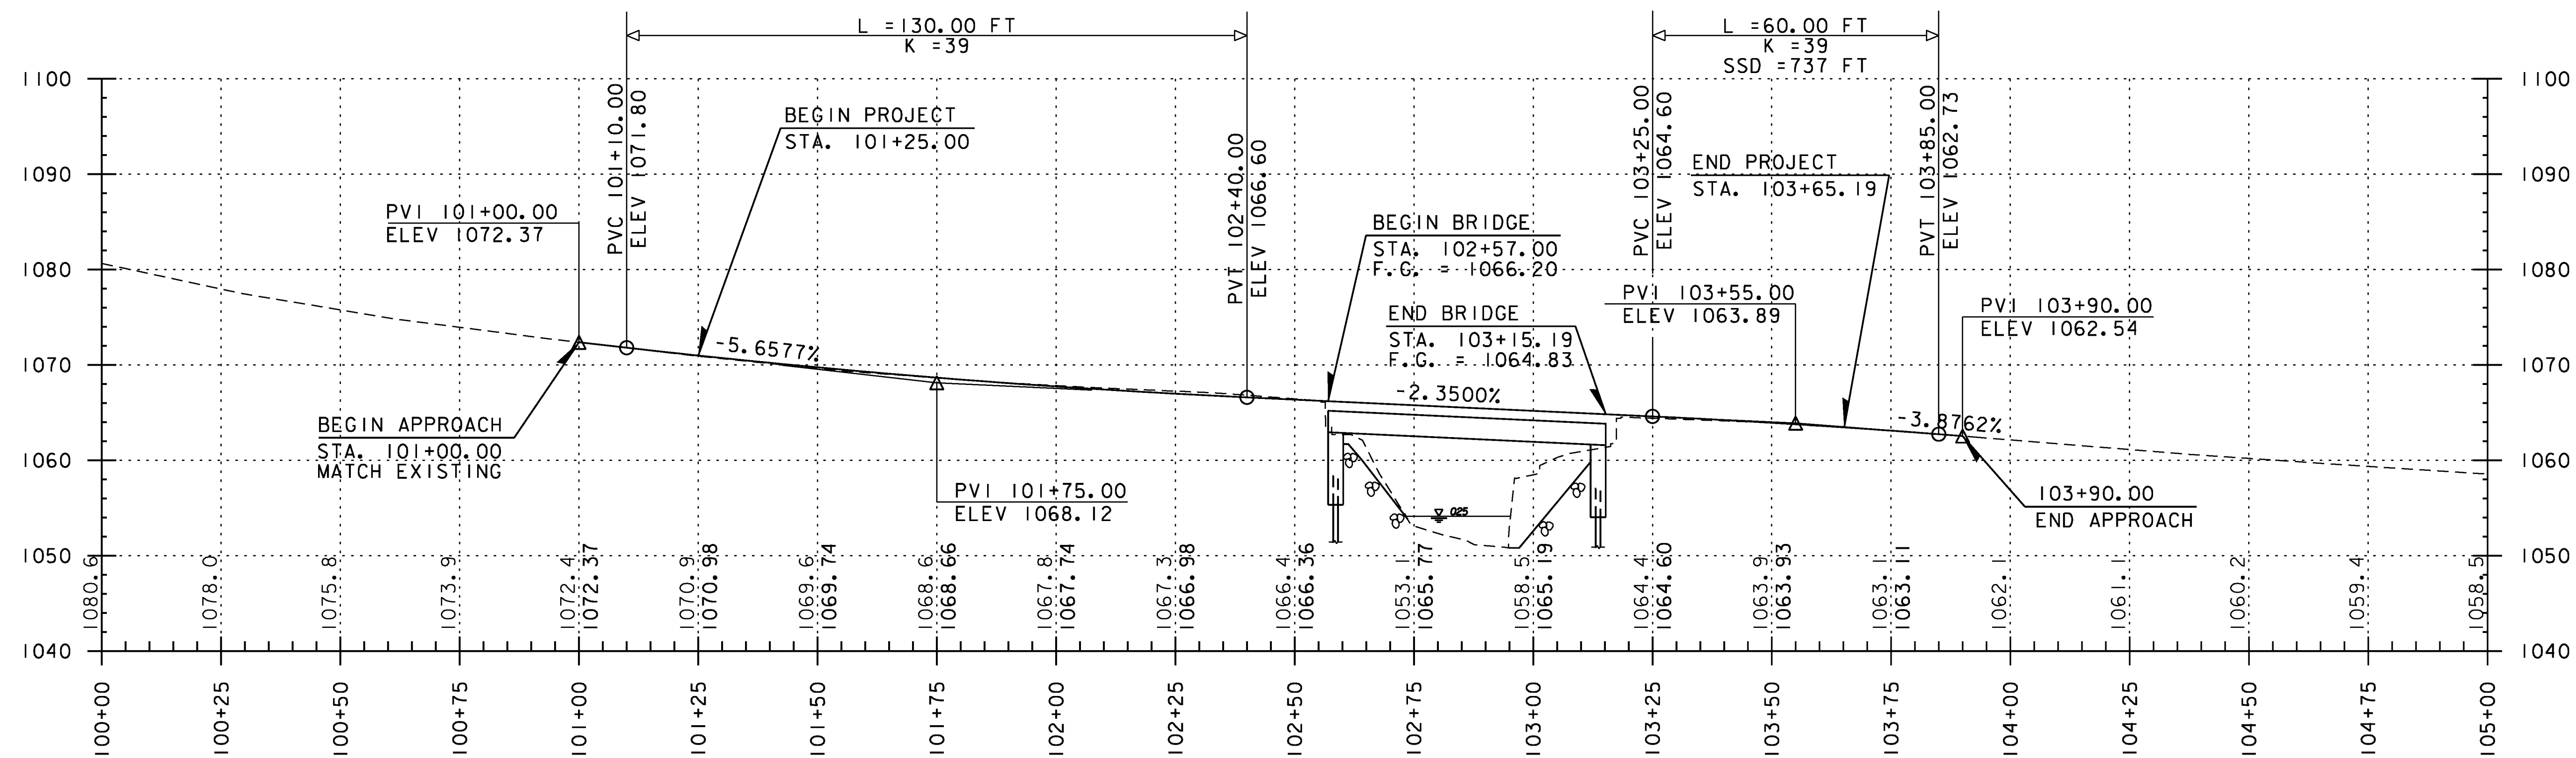

TH 10 PROFILE  
 SCALE 1" = 20' HORIZONTAL  
 1" = 10' VERTICAL



THE GRADES SHOWN TO THE NEAREST TENTH ARE THE ORIGINAL GROUND ELEVATIONS ALONG THE PROPOSED ALIGNMENT. THE GRADES SHOWN TO THE NEAREST HUNDREDTH ARE THE PROPOSED GRADES FOR THE NEW ALIGNMENT.

PROJECT NAME: GUILFORD  
 PROJECT NUMBER: BRO 1442(36)

FILE NAME: z10j064pro.dgn  
 PROJECT LEADER: S.E. BURBANK  
 DESIGNED BY: E.A. FIALA  
 PROFILE

PLOT DATE: 10/2/2013  
 DRAWN BY: E.A. FIALA  
 CHECKED BY: S.E. BURBANK  
 SHEET 12 OF 42



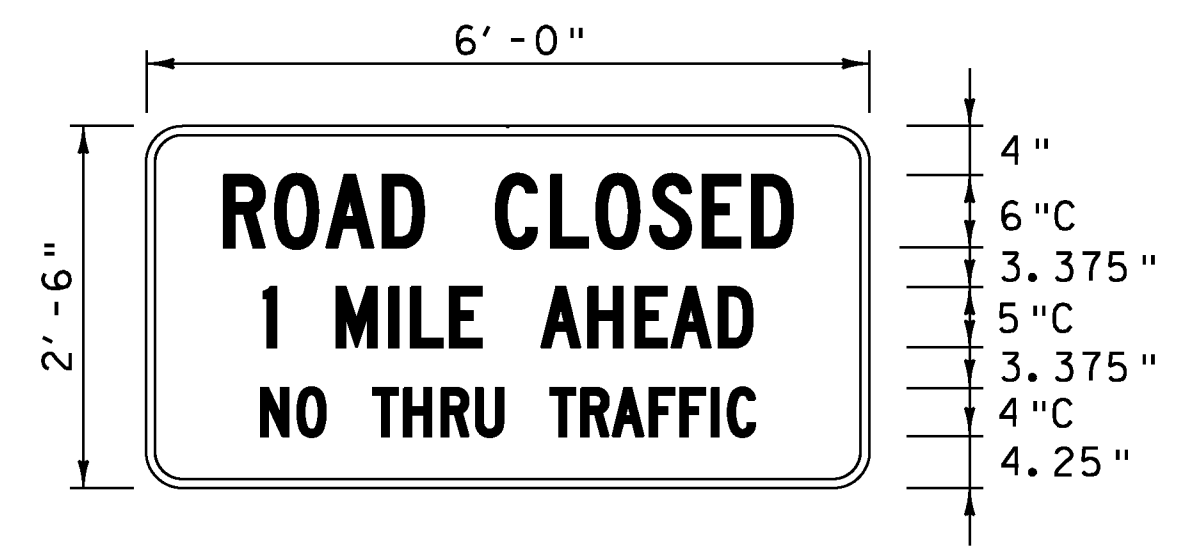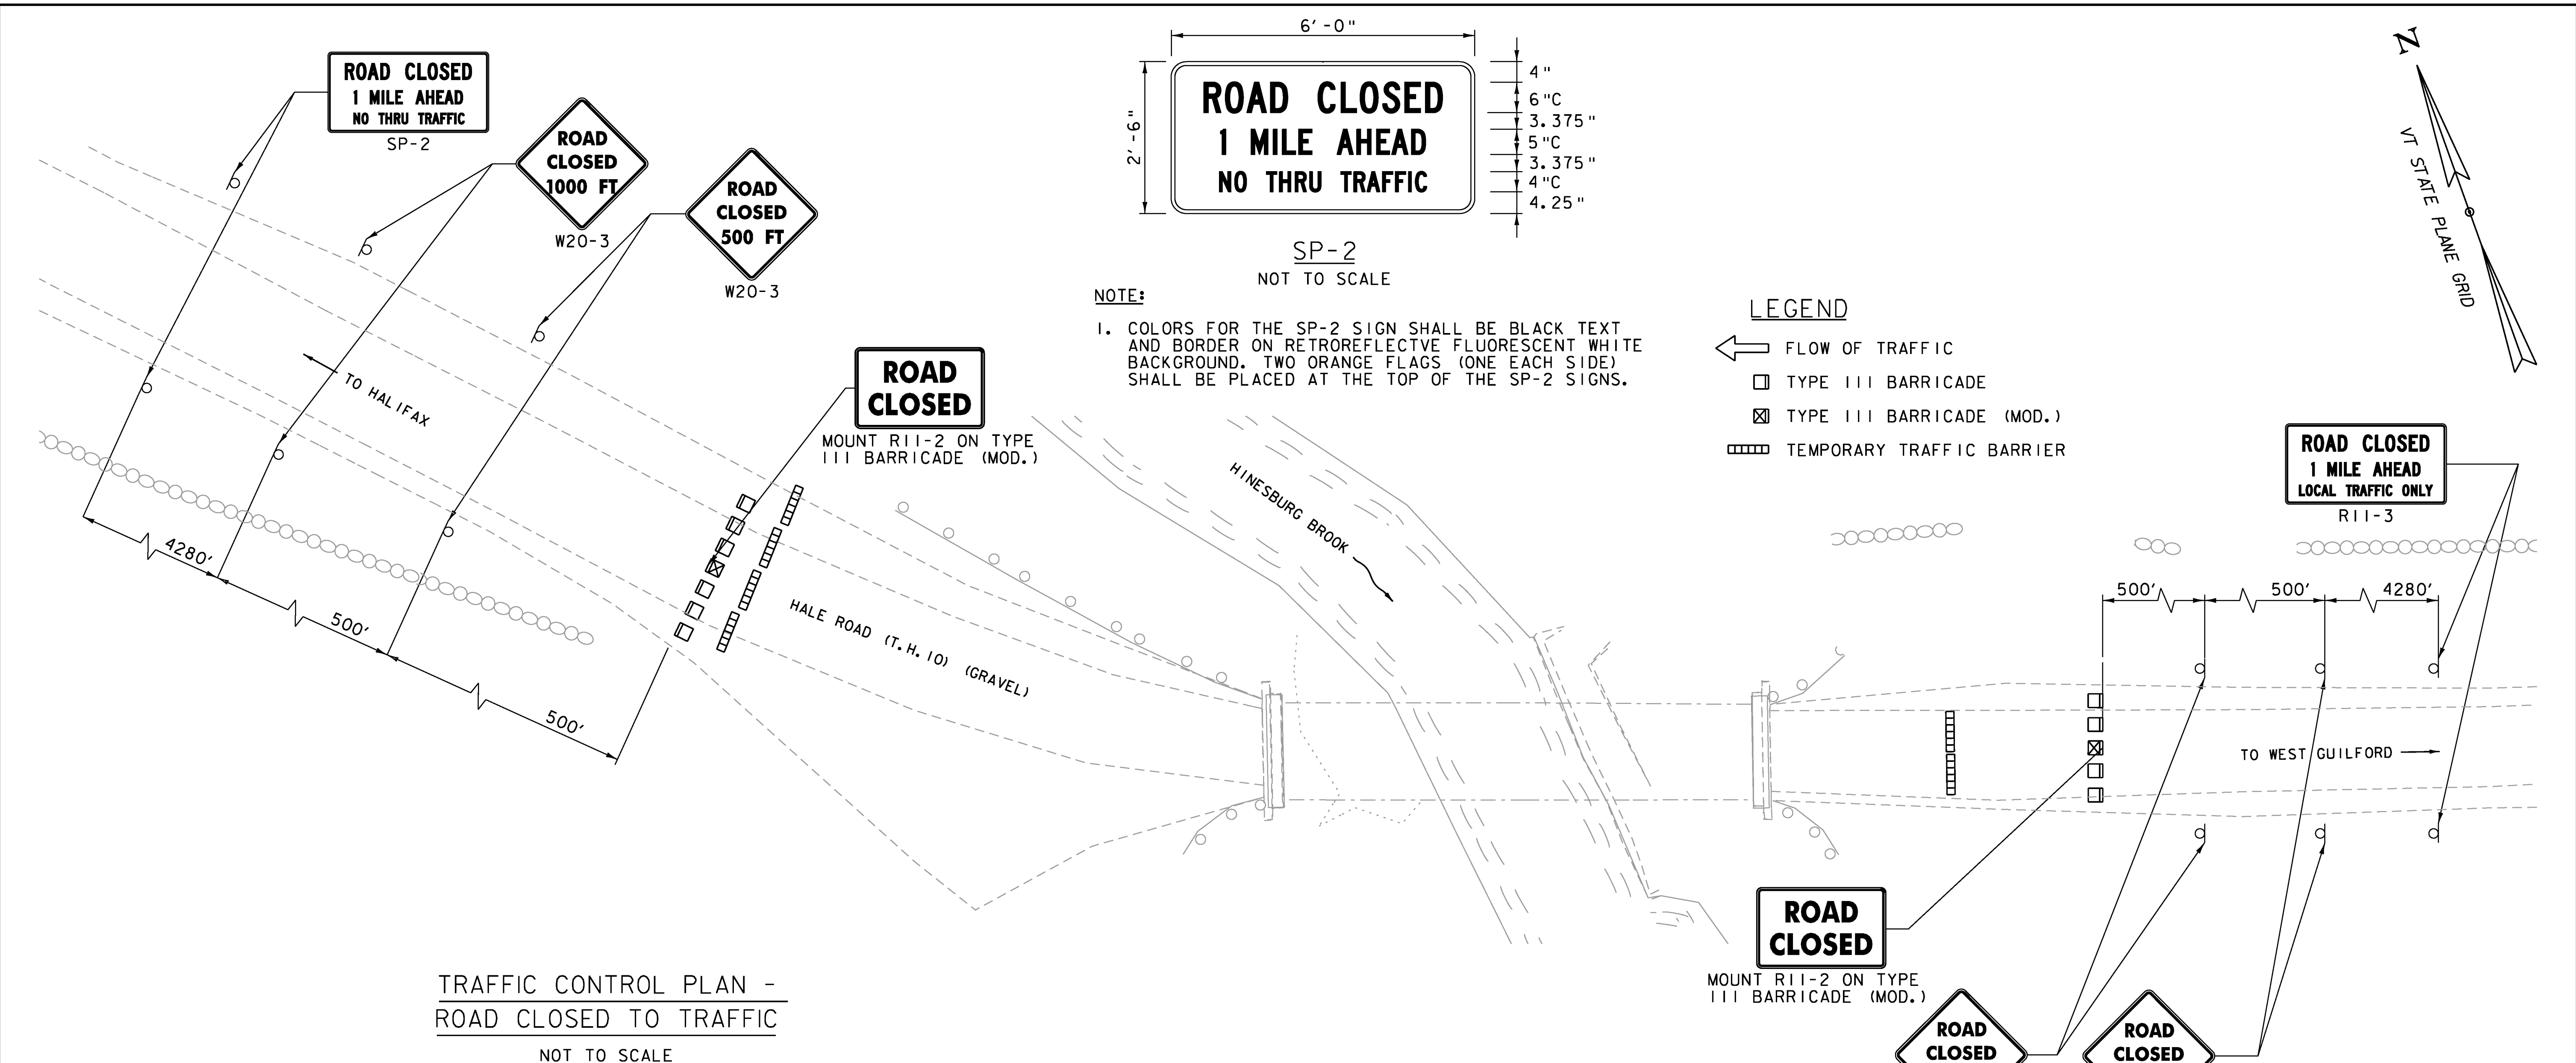

SP-2  
NOT TO SCALE

NOTE:  
1. COLORS FOR THE SP-2 SIGN SHALL BE BLACK TEXT AND BORDER ON RETROREFLECTIVE FLUORESCENT WHITE BACKGROUND. TWO ORANGE FLAGS (ONE EACH SIDE) SHALL BE PLACED AT THE TOP OF THE SP-2 SIGNS.

LEGEND

← FLOW OF TRAFFIC

□ TYPE III BARRICADE

⊠ TYPE III BARRICADE (MOD.)

▬▬▬ TEMPORARY TRAFFIC BARRIER

TRAFFIC CONTROL PLAN -  
ROAD CLOSED TO TRAFFIC  
NOT TO SCALE

IDENTIFICATION NUMBER	SIZE OF SIGN		TEXT	NUMBER OF SIGNS REQ'D	AREA (SQ FT)	TOTAL AREA (SQ FT)	REMARKS
	WIDTH (IN)	HEIGHT (IN)					
R11-2	48	30	<b>ROAD CLOSED</b>	2	10.00	20.00	MOUNT ON TYPE III BARRICADE (MOD.)
W20-3	36	36	<b>ROAD CLOSED 500 FT</b>	4	9.00	36.00	MOUNT ON TWO POSTS
W20-3	36	36	<b>ROAD CLOSED 1000 FT</b>	4	9.00	36.00	MOUNT ON TWO POSTS
SP-2	60	30	<b>ROAD CLOSED 1 MILE AHEAD NO THRU TRAFFIC</b>	4	12.50	50.00	MOUNT ON TWO POSTS

- NOTES:
1. THE NUMBER OF TYPE III BARRICADES AND OTHER TRAFFIC CONTROL DEVICES SHOWN ARE FOR ILLUSTRATIVE PURPOSES ONLY. THE ACTUAL NUMBER REQUIRED ARE TO BE DETERMINED BASED ON INDIVIDUAL ROADWAY CLOSURE REQUIREMENTS.
  2. ALL SIGNS SHALL BE LOCATED SO THEY ARE VISIBLE AND ABLE TO BE READ BY THE TRAVELING PUBLIC. SIGNS SHALL BE INSTALLED SO AS NOT TO OBSTRUCT EXISTING SIGNS.
  3. ALL SIGNS SHALL BE IN ACCORDANCE WITH THE CURRENT EDITIONS OF THE "MANUAL ON UNIFORM TRAFFIC CONTROL DEVICES" (MUTCD) AND THE "STANDARD HIGHWAY SIGNS AND MARKINGS" BOOK (SHSM) PUBLISHED BY THE FEDERAL HIGHWAY ADMINISTRATION (FHWA).
  4. SIGNS SHALL BE ERECTED BEFORE THE START OF ANY WORK AND SHALL BE COVERED UNTIL WORK COMMENCES, AND UPON COMPLETION OF THE WORK, EACH SIGN SHALL BE ERECTED IN A NEAT AND WORKMANLIKE MANNER. SIGNS SHALL BE REMOVED UPON COMPLETION OF THE WORK AT THE DISCRETION OF THE ENGINEER.
  5. WHERE SIGN INSTALLATIONS ARE NOT PROTECTED BY GUARDRAIL OR OTHER APPROVED TRAFFIC BARRIERS, ALL SIGN STANDS AND POST INSTALLATIONS SHALL BE "NATIONAL COOPERATIVE HIGHWAY RESEARCH PROGRAM" (NCHRP) REPORT 350 COMPLIANT. NO SIGN POSTS SHALL EXTEND OVER THE TOP OF THE SIGN INSTALLED ON SAID POST(S). WHEN ANCHORS ARE INSTALLED STUB SHALL NOT BE GREATER THAN FOUR INCHES ABOVE EXISTING GROUND.

PROJECT NAME: GUILFORD  
PROJECT NUMBER: BRO 1442(36)

FILE NAME: z10j064tcp.dgn  
PROJECT LEADER: S.E. BURBANK  
DESIGNED BY: E.A. FIALA  
TRAFFIC CONTROL PLAN

PLOT DATE: 10/2/2013  
DRAWN BY: E.A. FIALA  
CHECKED BY: S.E. BURBANK  
SHEET 13 OF 42





**SIGNING LEGEND**

N = NEW  
 R = REMOVE  
 RET = RETAIN  
 S = SALVAGE

**TRAFFIC SIGNS, TYPE A**

STA. 101+57, RT  
 STA. 102+52, LT  
 STA. 102+57, RT  
 STA. 103+15, LT  
 STA. 103+21, RT  
 STA. 104+15, LT

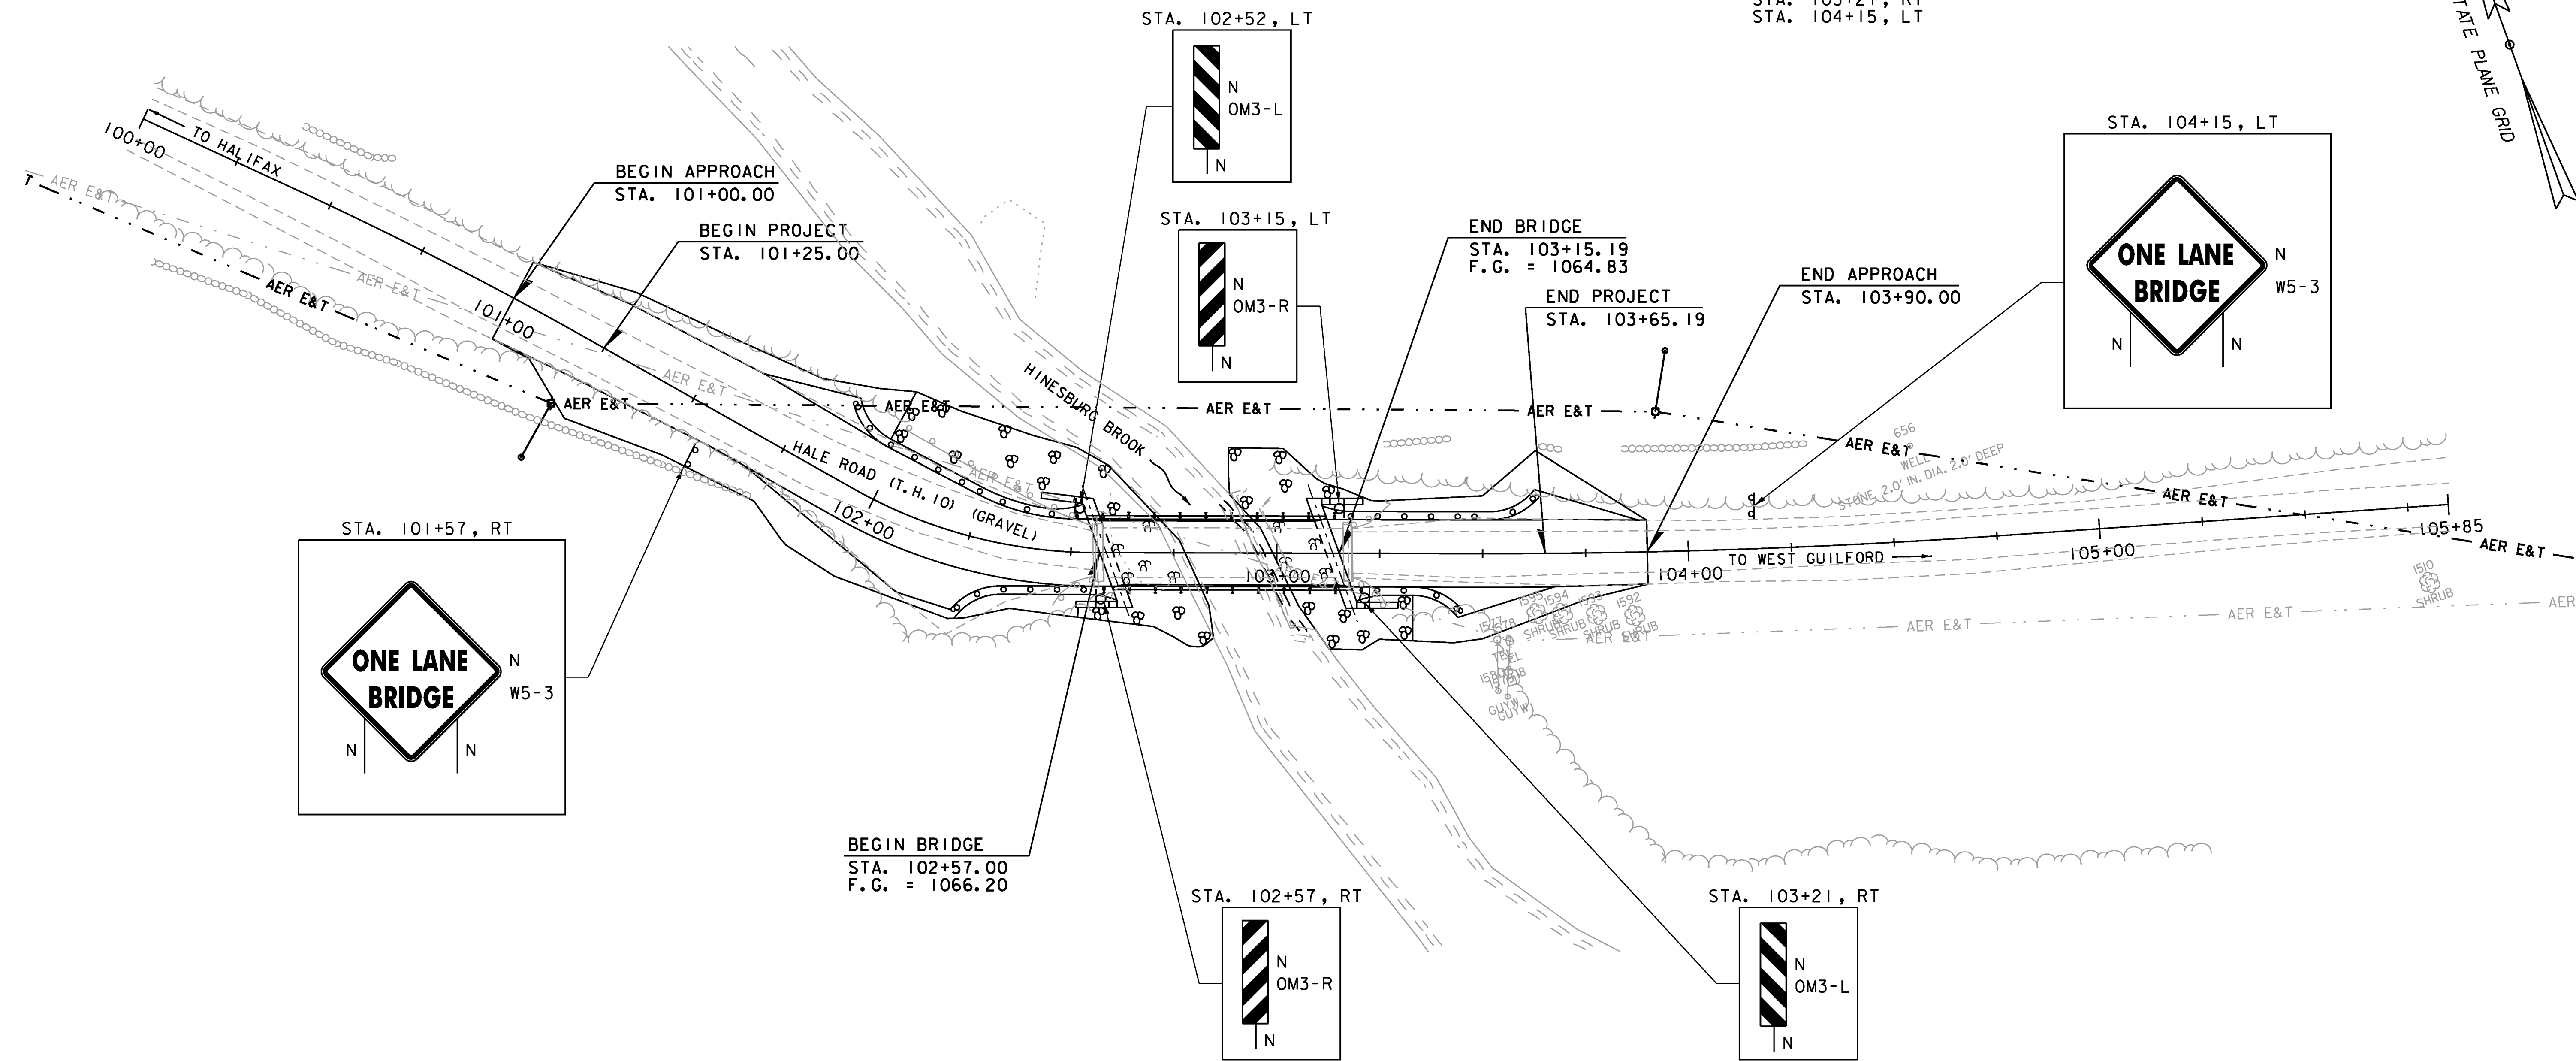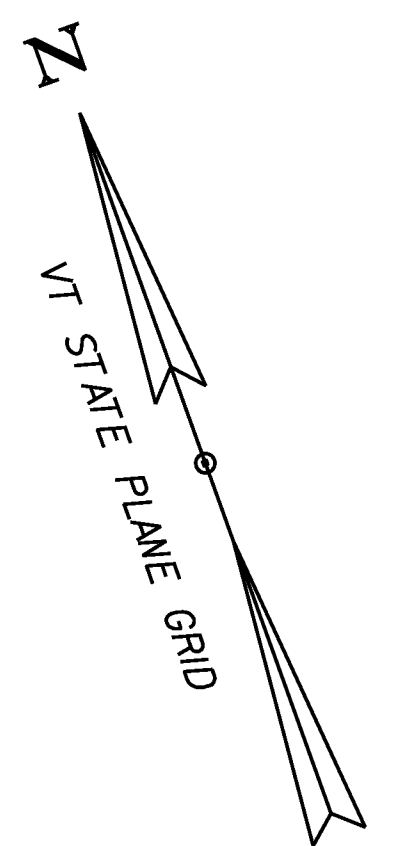

PROJECT NAME: GUILFORD	
PROJECT NUMBER: BRO 1442(36)	
FILE NAME: z10j064+cp.dgn	PLOT DATE: 10/2/2013
PROJECT LEADER: S.E. BURBANK	DRAWN BY: E.A. FIALA
DESIGNED BY: E.A. FIALA	CHECKED BY: S.E. BURBANK
TRAFFIC SIGN SHEET	SHEET 14 OF 42





**SOIL CLASSIFICATION**

**AASHTO**

A1	Gravel and Sand
A3	Fine Sand
A2	Silty or Clayey Gravel and Sand
A4	Silty Soil - Low Compressibility
A5	Silty Soil - Highly Compressible
A6	Clayey Soil - Low Compressibility
A7	Clayey Soil - Highly Compressible

**ROCK QUALITY DESIGNATION**

R.O.D. (%)	ROCK DESCRIPTION
<25	Very Poor
25 to 50	Poor
51 to 75	Fair
76 to 90	Good
>90	Excellent

**SHEAR STRENGTH**

UNDRAINED SHEAR STRENGTH IN P.S.F.	CONSISTENCY
<250	Very Soft
250-500	Soft
500-1000	Med. Stiff
1000-2000	Stiff
2000-4000	Very Stiff
>4000	Hard

**CORRELATION GUIDE OF "N" TO DENSITY/CONSISTENCY**


DENSITY (GRANULAR SOILS)		CONSISTENCY (COHESIVE SOILS)	
N	DESCRIPTIVE TERM	N	DESCRIPTIVE TERM
<5	Very Loose	<2	Very Soft
5-10	Loose	2-4	Soft
11-24	Med. Dense	5-8	Med. Stiff
25-50	Dense	9-15	Stiff
>50	Very Dense	16-30	Very Stiff
		31-60	Hard
		>60	Very Hard

**COMMONLY USED SYMBOLS**

- ▼ Water Elevation
- ⊙ Standard Penetration Boring
- ⊕ Auger Boring
- Rod Sounding
- S Sample
- N Standard Penetration Test
- Blow Count Per Foot For:  
2" O. D. Sampler  
1 3/8" I. D. Sampler  
Hammer Weight Of 140 Lbs.  
Hammer Fall Of 30"
- VS Field Vane Shear Test
- US Undisturbed Soil Sample
- B Blast
- DC Diamond Core
- MD Mud Drill
- WA Wash Ahead
- HSA Hollow Stem Auger
- AX Core Size 1 1/8"
- BX Core Size 1 3/8"
- NX Core Size 2 1/8"
- M Double Tube Core Barrel Used
- LL Liquid Limit
- PL Plastic Limit
- PI Plasticity Index
- NP Non Plastic
- w Moisture Content (Dry Wgt. Basis)
- D Dry
- M Moist
- MTW Moist To Wet
- W Wet
- Sat Saturated
- Bo Boulder
- Gr Gravel
- Sa Sand
- Sl Silt
- Cl Clay
- HP Hardpan
- Le Ledge
- NLTD No Ledge To Depth
- CNPF Can Not Penetrate Further
- TLOB Top of Ledge Or Boulder
- NR No Recovery
- Rec. Recovery
- 1/2 Rec. Percent Recovery
- ROD Rock Quality Designation
- CBR California Bearing Ratio
- < Less Than
- > Greater Than
- R Refusal (N > 100)
- VTSPG NAD83 - See Note 7

**COLOR**

blk	Black	pnk	Pink
bl	Blue	pu	Purple
brn	Brown	rd	Red
dk	Dark	tn	Tan
gr'y	Gray	wh	White
gn	Green	yel	Yellow
lt	Light	mltc	Multicolored
or	Orange		

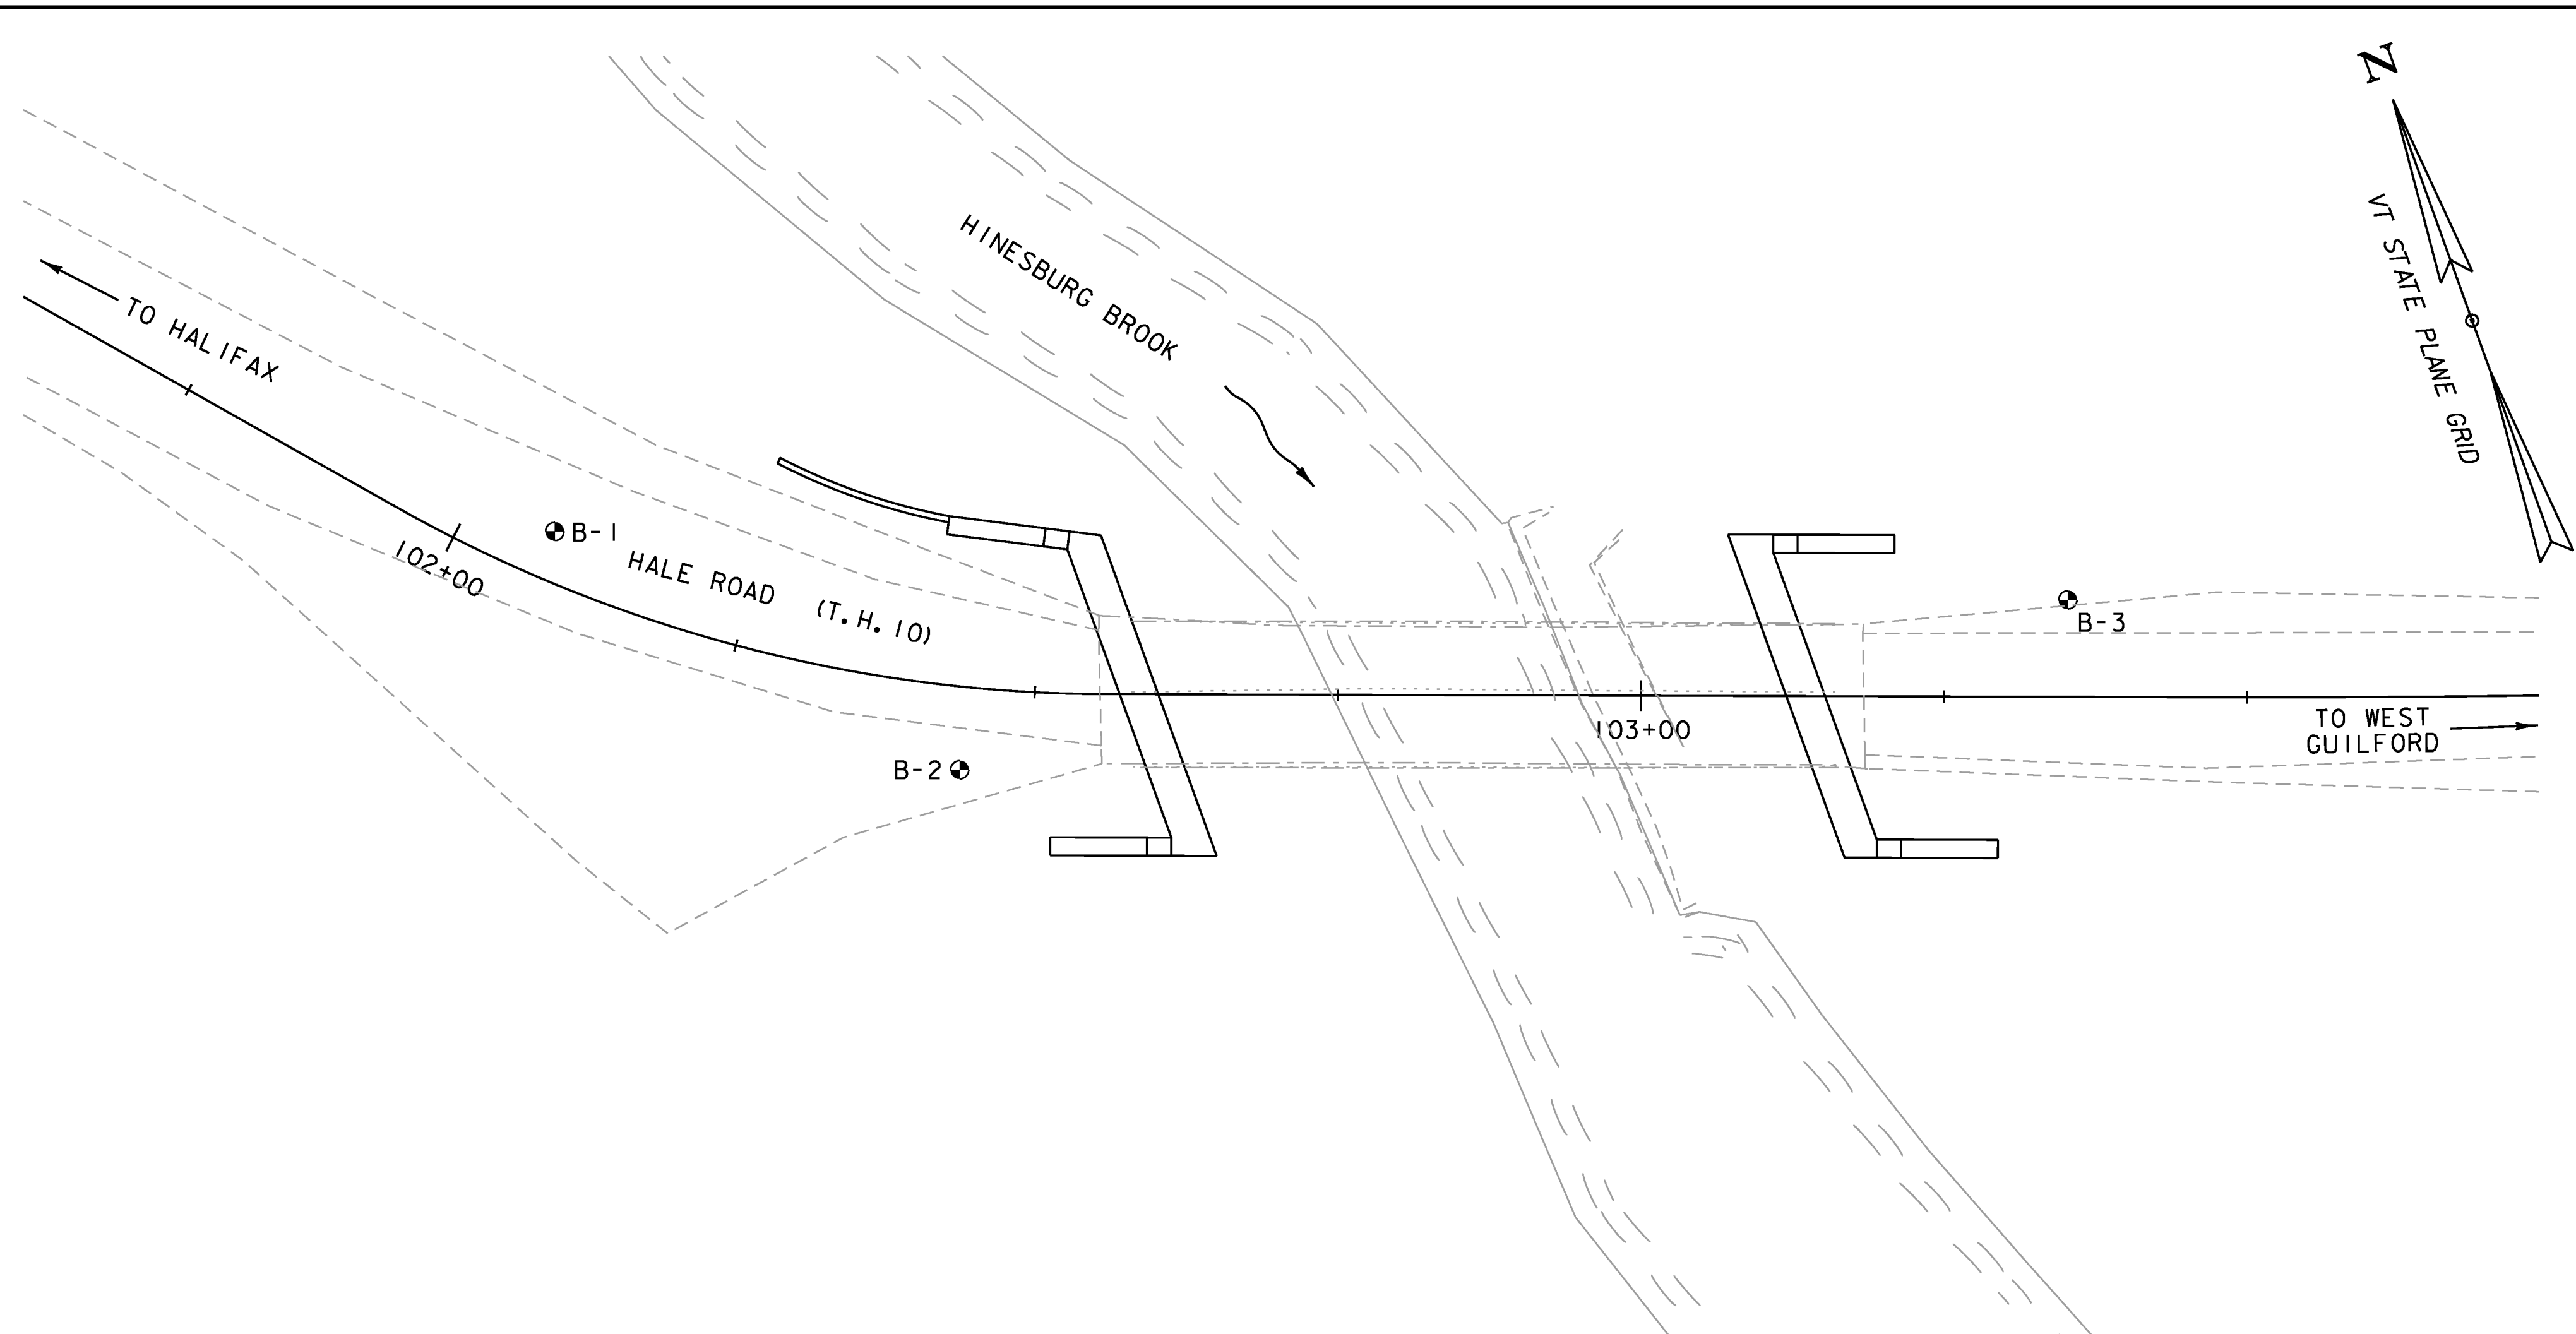

**BORING LAYOUT**

SCALE 1" = 10'-0"  
10 0 10

**BORING CHART**

HOLE NO.	SURV. STATION	OFFSET	GROUND ELEV.	ELEV. TLOB
B-1	102+07.50	4.0 LT	1067.5	N/A
B-2	102+43.50	7.0 RT	1066.5	1031.0
B-3	103+35.20	8.0 LT	1063.9	1019.0

**DEFINITIONS (AASHTO)**

- BEDROCK (LEDGE)** - Rock in its native location of indefinite thickness.
- BOULDER** - A rock fragment with an average dimension > 12 inches.
- COBBLE** - Rock fragments with an average dimension between 3 and 12 inches.
- GRAVEL** - Rounded particles of rock < 3" and > 0.075" (#10 sieve).
- SAND** - Particles of rock < 0.075" (#10 sieve) and > 0.0025" (#200 sieve).
- SLT** - Soil < 0.0025" (#200 sieve), non or slightly plastic and exhibits no strength when air-dried.
- CLAY** - Fine grained soil, exhibits plasticity when moist and considerable strength when air-dried.
- VARVED** - Alternate layers of silt and clay.
- HARDPAN** - Extremely dense soil, cemented layer, not softened when wet.
- MUCK** - Soft organic soil (containing > 10% organic material).
- MOISTURE CONTENT** - Weight of water divided by dry weight of soil.
- FLOWING SAND** - Granular soil so saturated (loose) that it flows into drill casing during extraction of wash rod.
- STRIKE** - Angle from magnetic north to line of intersection of bed with a horizontal plane.
- DIP** - Inclination of bed with a horizontal plane.

**GENERAL NOTES**

1. The subsurface explorations shown herein were made between 11/17/2011 and 12/5/2011 by the Agency.
2. Soil and rock classifications, properties and descriptions are based on engineering interpretation from available subsurface information by the Agency and may not necessarily reflect actual variations in subsurface conditions that may be encountered between individual boring or sample locations.
3. Observed water levels and/or conditions indicated are as recorded at the time of exploration and may vary according to the prevailing rainfall, methods of exploration and other factors.
4. Engineering judgment was exercised in preparing the subsurface information presented herein. Analysis and interpretation of subsurface data was performed and interpreted for Agency design and estimating purposes. Presentation of the information in the Contract is intended to provide the Contractor access to the same data available to the Agency. The subsurface information is presented in good faith and is not intended as a substitute for personal investigation, independent interpretation, independent analysis or judgment by the Contractor.
5. Pictorial structure details shown on the boring plan layout or soils profile are for illustrative purposes only and may not accurately portray final contract details.
6. Terminology used on boring logs to describe the hardness, degree of weathering, and spacing of fractures, joints and other discontinuities in the bedrock is defined in the AASHTO Manual on Subsurface Investigations, 1988.
7. Northing and Easting coordinates are shown in Vermont State Plane Grid North American Datum 1983 in meters and survey feet.



PROJECT NAME: GUILFORD  
PROJECT NUMBER: BRO 1442(36)

FILE NAME: z10j064bor.dgn  
PROJECT LEADER: S.E. BURBANK  
DESIGNED BY: A.J. GOUDREAU  
BORING INFORMATION SHEET

PLOT DATE: 10/2/2013  
DRAWN BY: B.M. KLINEFELTER  
CHECKED BY: S.E. BURBANK  
SHEET 16 OF 42

VT Trans		STATE OF VERMONT AGENCY OF TRANSPORTATION MATERIALS & RESEARCH SECTION SUBSURFACE INFORMATION		BORING LOG		Boring No.: B-1			
Guilford Bridge Replacement 23285.1000.32000		Page No.: 1 of 1		Pin No.: BRO 1442(36)		Checked By:			
Boring Crew: S. Clavette, S. Johnston		Type: WASH BORE	Sampler: SS	Groundwater Observations					
Date Started: 11/22/11	Date Finished: 12/05/11	I.D.: 4 in	1.25 in	Date	Depth (ft)	Notes			
VTSPG NAD83: N 113488.19 ft E 1592811.68 ft		Hammer Wt: 300 lb	140 lb	11/22/11	14.0	casing at 12 feet			
Station: 102+07.50	Offset: 4L	Hammer Fall: 30 in.	30 in.						
Ground Elevation: 1067.5 ft		Hammer/Rod Type: Safety							
		Rig: B53 Mobile	C _r = 1						
Depth (ft)	Strata (1)	CLASSIFICATION OF MATERIALS (Description)			Blow(s) (N Value)	Moisture Content %	Gravel %	Sand %	Fines %
5	x x x	(Granular FILL), f.m.c. SAND, Some Silt, little f.c. gravel, very compact, brown, moist, Rec. = 1.3 ft			25-32-42-40 (74)				
	x x x	(Granular FILL), f.m.c. SAND, And f.c. Gravel, trace silt medium compact, Rec. = 1.4 ft			31-18-12-9 (30)	5.4	41.5	50.3	8.2
	x x x	(Granular FILL), becomes compact, Rec. = 0.6 ft			24-23-14-10 (37)				
	x x x	(Fine Grained FILL), Clayey SILT, Some f.m.c. Sand, little f. gravel, hard, brownish gray, moist, Rec. = 1.2 ft			10-10-9-14 (19)				
	x x x	(Fine Grained FILL), Similar Soil, Rec. = 1.2 ft			11-16-16-19 (32)				
	x x x	(Fine Grained FILL), SILT, Some f. Sand, compact, light brown, moist, Rec. = 0.9 ft			32-20-22-23 (42)				
	x x x	(Fine Grained FILL), becomes very compact, Rec. = 1.3 ft			20-24-33-50/4* (57)				
	x x x	(SM), f.m.c. SAND, Some Silt, little f.c. gravel, compact, light brown, moist, Rec. = 1.0 ft			16-23-20-43 (43)				
	x x x	(SM), becomes very compact, Rec. = 1.2 ft			13-50-50/5* (>100)				
	x x x	(ML)			38-32-38-43 (71)				
	x x x	(ML), SILT, Some f. Sand, very compact, brown, wet, Rec. = 1.0 ft							
	x x x	(Completely Weathered Bedrock)							
	x x x	(Completely Weathered Bedrock), f.m.c. SAND, little silt, little f. gravel, very compact, brown/black/gray, moist, Rec. = 1.2 ft			60-57-59-63 (>100)				
Hole stopped @ 32.0 ft Boring backfilled with cuttings and bituminous cold patch.									
Notes: 1. Stratification lines represent approximate boundary between material types. Transition may be gradual. 2. N Values have not been corrected for hammer energy. C _r is the hammer energy correction factor. 3. Water level readings have been made at times and under conditions stated. Fluctuations of groundwater may occur due to other factors than those present at the time measurements were made.									

VT Trans		STATE OF VERMONT AGENCY OF TRANSPORTATION MATERIALS & RESEARCH SECTION SUBSURFACE INFORMATION		BORING LOG		Boring No.: B-2					
Guilford Bridge Replacement 23285.1000.32000		Page No.: 1 of 2		Pin No.: BRO 1442(36)		Checked By:					
Boring Crew: S. Clavette, K. Owens		Type: WASH BORE	Sampler: SS	Groundwater Observations							
Date Started: 11/17/11	Date Finished: 11/22/11	I.D.: 4 in	1.25 in	Date	Depth (ft)	Notes					
VTSPG NAD83: N 113456.89 ft E 1592837.58 ft		Hammer Wt: 300 lb	140 lb	11/17/11	14.6	casing at 14 feet					
Station: 102+43.50	Offset: 7R	Hammer Fall: 30 in.	30 in.								
Ground Elevation: 1066.5 ft		Hammer/Rod Type: Safety									
		Rig: B53 Mobile	C _r = 1								
Depth (ft)	Strata (1)	CLASSIFICATION OF MATERIALS (Description)			Run (Dip deg.)	Cone Rec. % (RQD %)	Blow(s) (N Value)	Moisture Content %	Gravel %	Sand %	Fines %
5	x x x	(Granular FILL), f.m.c. SAND, Some f.c. Gravel, trace silt, medium compact, brown, moist, Rec. = 0.9 ft					12-11-11-9 (22)				
	x x x	(Granular FILL), becomes loose, Rec. = 1.0 ft					7-4-4-8 (8)				
	x x x	(Fine Grained FILL), Clayey SILT, little f.m.c. sand, trace f.c. gravel, trace organics, medium compact, brown, moist, Rec. = 1.4 ft					4-6-6-6 (12)				
	x x x	(Fine Grained FILL), Similar Soil, Rec. = 1.4 ft					6-6-7-9 (13)				
	x x x	(Fine Grained FILL), Similar Soil, Rec. = 1.2 ft					2-4-7-13 (11)				
	x x x	(SM), f.m.c. SAND, little silt, trace f. gravel, medium compact, brown, moist, Rec. = 0.4 ft					29-44-27-25 (71)				
	x x x	No Recovery, Rec. = 0.0 ft, 12.0 ft - 14.0 ft					29-34-32-29 (66)				
	x x x	(SM), f.m.c. SAND, little silt, compact, brown, wet, Rec. = 1.0 ft					14-19-23-31 (42)				
	x x x	(ML), SILT, little f. sand, trace f. gravel, compact, brown, wet					35-37-50/5* (>100)	24.4	1.8	16.3	81.9
	x x x	(ML), becomes very compact, Rec. = 1.0 ft									
	x x x	(ML), Similar Soil, Rec. = 0.9 ft					26-47-50/4* (>100)				
	x x x	(ML), SILT, trace f.m.c. sand, very compact, brown, wet, Rec. = 0.6 ft, Strata change based on change in drilling.					19-25-25-30 (50)				
	x x x	(Completely Weathered Bedrock)									
	x x x	(Completely Weathered Bedrock), SILT, Some f.m.c. Sand, trace f.c. gravel, very compact, brown/black/orange, moist, Rec. = 0.7 ft					31-92-58 (>100)				
Notes: 1. Stratification lines represent approximate boundary between material types. Transition may be gradual. 2. N Values have not been corrected for hammer energy. C _r is the hammer energy correction factor. 3. Water level readings have been made at times and under conditions stated. Fluctuations of groundwater may occur due to other factors than those present at the time measurements were made.											


VT Trans		STATE OF VERMONT AGENCY OF TRANSPORTATION MATERIALS & RESEARCH SECTION SUBSURFACE INFORMATION		BORING LOG		Boring No.: B-2					
Guilford Bridge Replacement 23285.1000.32000		Page No.: 2 of 2		Pin No.: BRO 1442(36)		Checked By:					
Boring Crew: S. Clavette, K. Owens		Type: WASH BORE	Sampler: SS	Groundwater Observations							
Date Started: 11/17/11	Date Finished: 11/22/11	I.D.: 4 in	1.25 in	Date	Depth (ft)	Notes					
VTSPG NAD83: N 113456.89 ft E 1592837.58 ft		Hammer Wt: 300 lb	140 lb	11/17/11	14.6	casing at 14 feet					
Station: 102+43.50	Offset: 7R	Hammer Fall: 30 in.	30 in.								
Ground Elevation: 1066.5 ft		Hammer/Rod Type: Safety									
		Rig: B53 Mobile	C _r = 1								
Depth (ft)	Strata (1)	CLASSIFICATION OF MATERIALS (Description)			Run (Dip deg.)	Cone Rec. % (RQD %)	Blow(s) (N Value)	Moisture Content %	Gravel %	Sand %	Fines %
35.5		35.5 ft - 40.5 ft, White/gray/brown, Schist, very close fracture spacing. Medium hard, Moderately to severely weathered, NXDC, very poor RQD			R-1	36 (0)					
40		40.5 ft - 42.0 ft, White/gray/brown, Schist, very close fracture spacing. Medium hard, Moderately to severely weathered, NXDC, very poor RQD			R-2	53 (0)					
45		42.0 ft - 48.8 ft, White/gray/brown, Schist, close fracture spacing. Medium hard, Moderately weathered, NXDC, poor RQD			R-3	54 (43.4)					
50		48.8 ft - 53.4 ft, White/gray/brown, Schist, close fracture spacing. Medium hard, Moderately weathered, NXDC, poor RQD			R-4	72 (46.7)					
Hole stopped @ 53.4 ft Boring backfilled with cuttings and bituminous cold patch.											
Notes: 1. Stratification lines represent approximate boundary between material types. Transition may be gradual. 2. N Values have not been corrected for hammer energy. C _r is the hammer energy correction factor. 3. Water level readings have been made at times and under conditions stated. Fluctuations of groundwater may occur due to other factors than those present at the time measurements were made.											

ESTIMATED PILE TIP

PROJECT NAME: GUILFORD  
PROJECT NUMBER: BRO 1442(36)


FILE NAME: z10j064borlogs.dgn  
PROJECT LEADER: S.E. BURBANK  
DESIGNED BY: VTRANS  
BORING LOGS (1 OF 2)

PLOT DATE: 10/2/2013  
DRAWN BY: E.A. FIALA  
CHECKED BY: S.E. BURBANK  
SHEET 17 OF 42

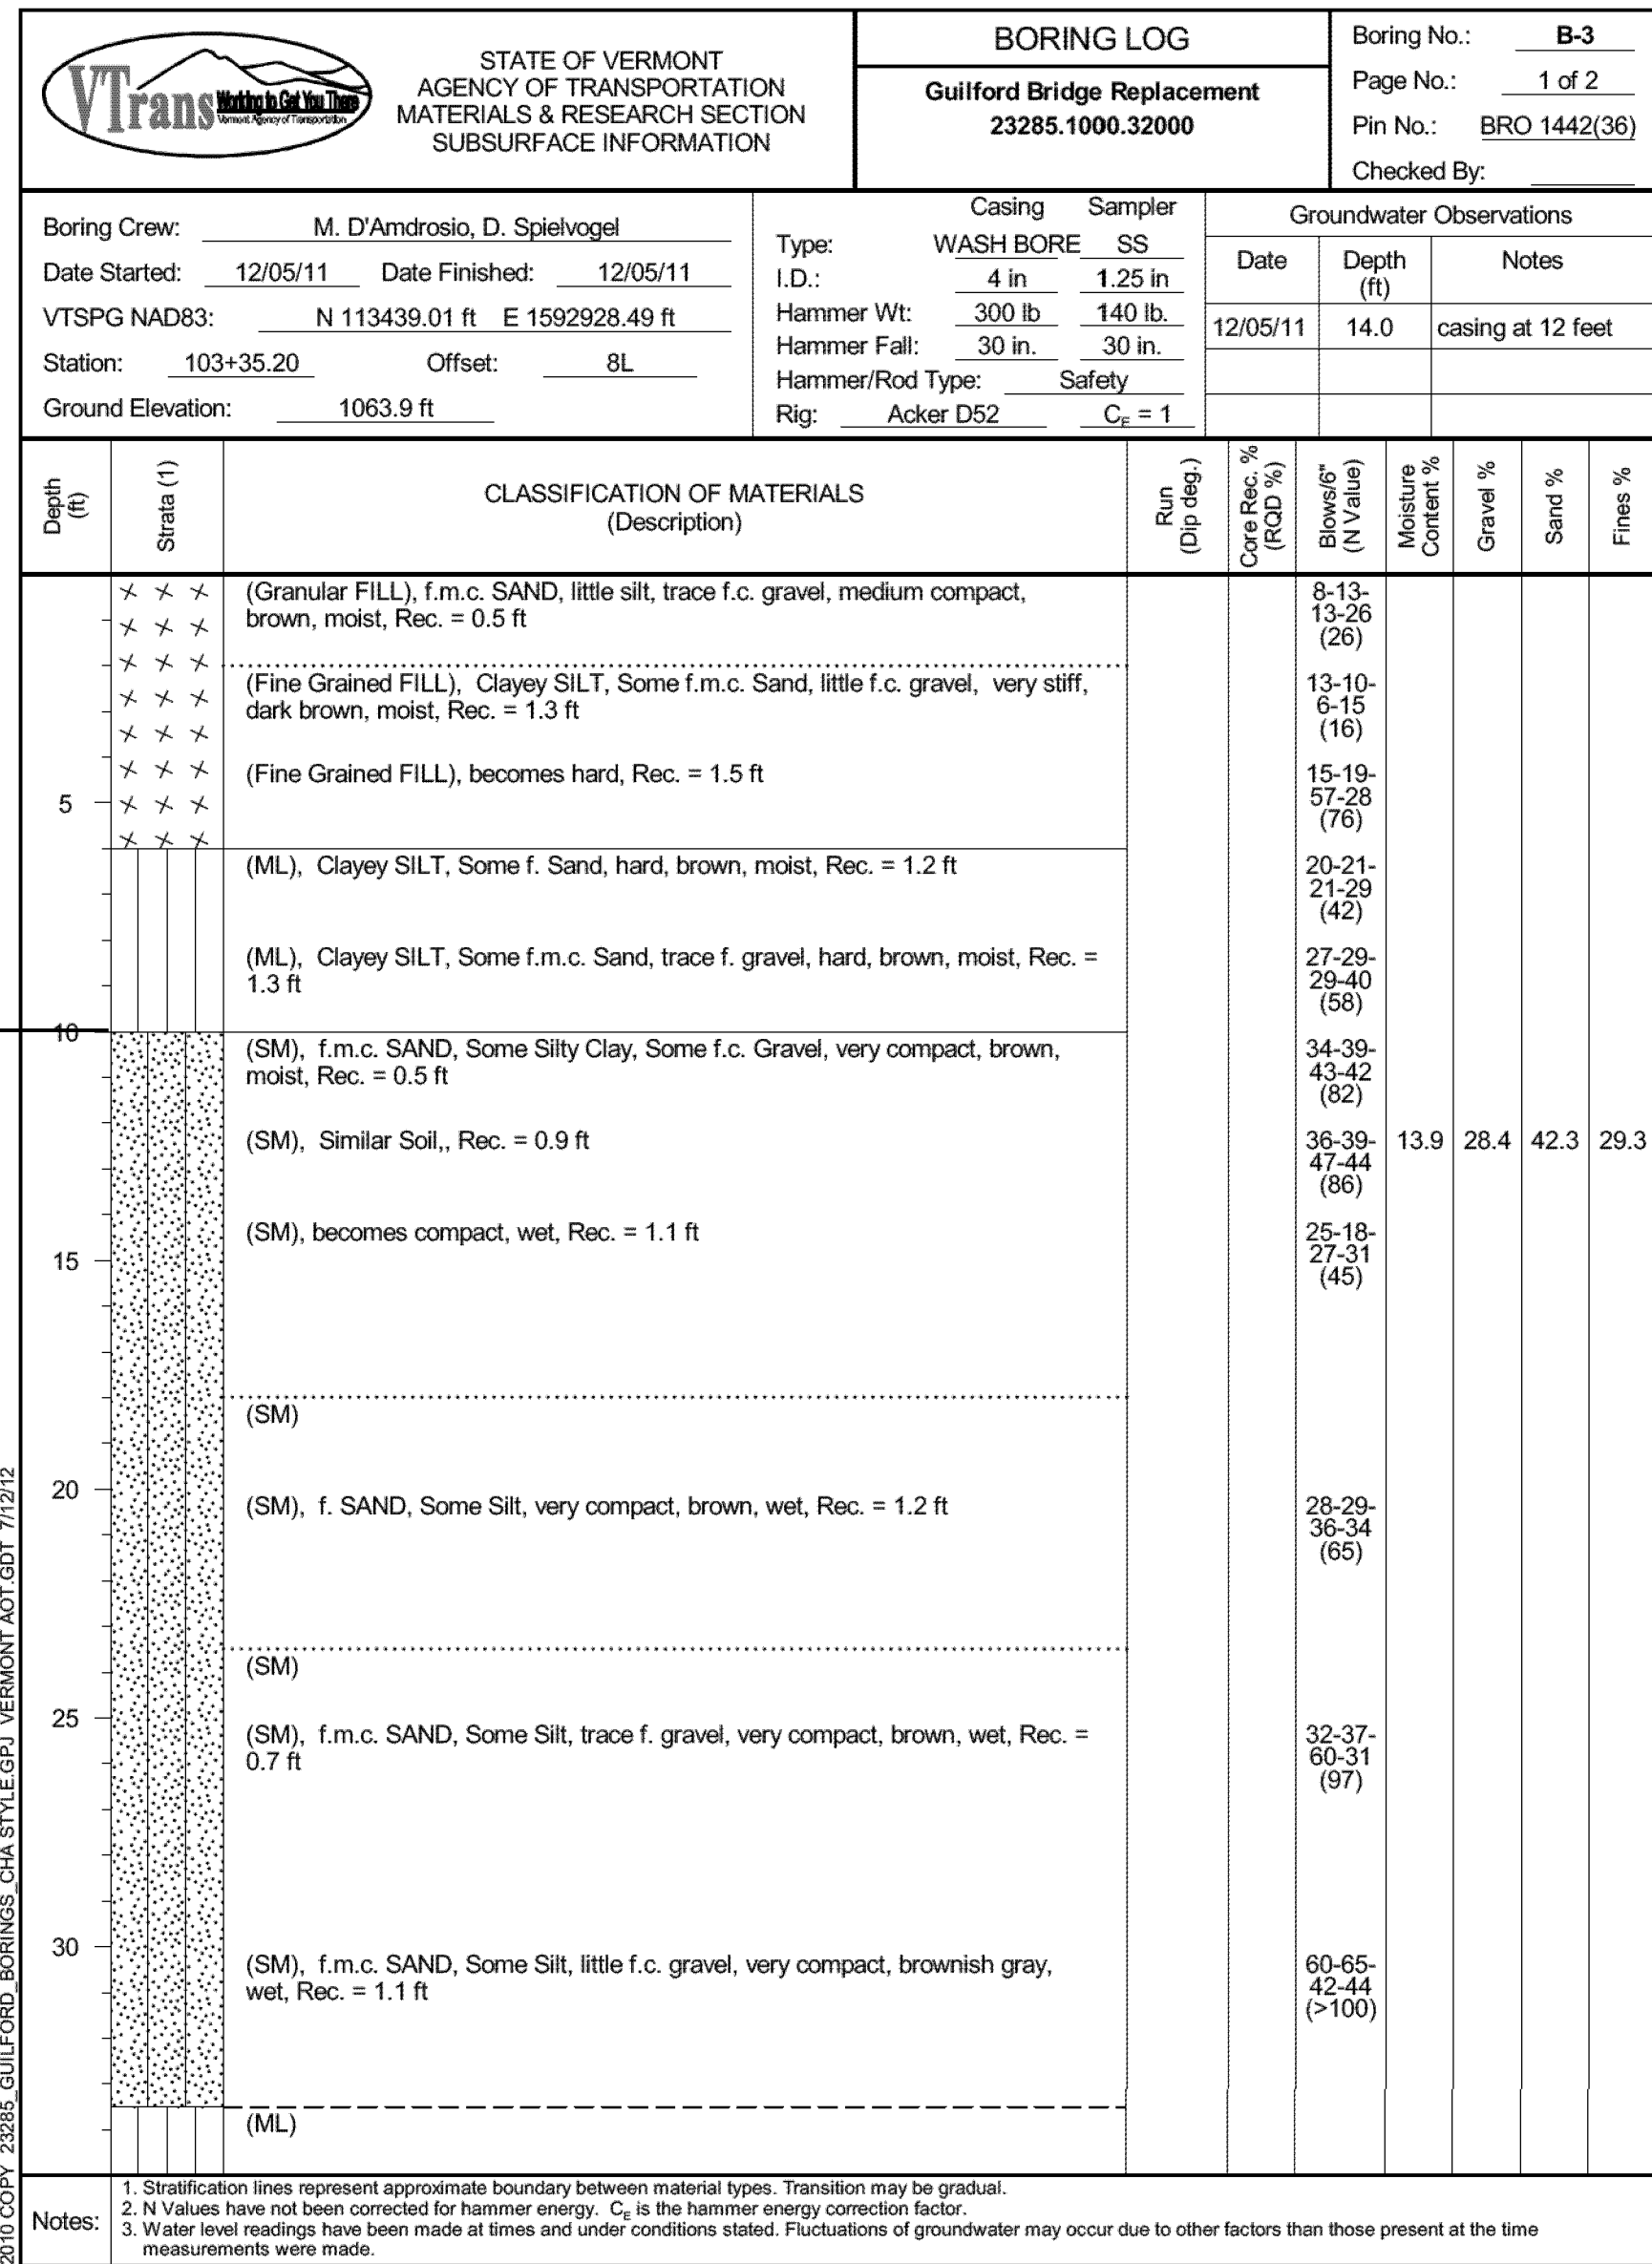



BOTTOM OF PILE CAP  
 EL = 1054.03

ESTIMATED PILE TIP

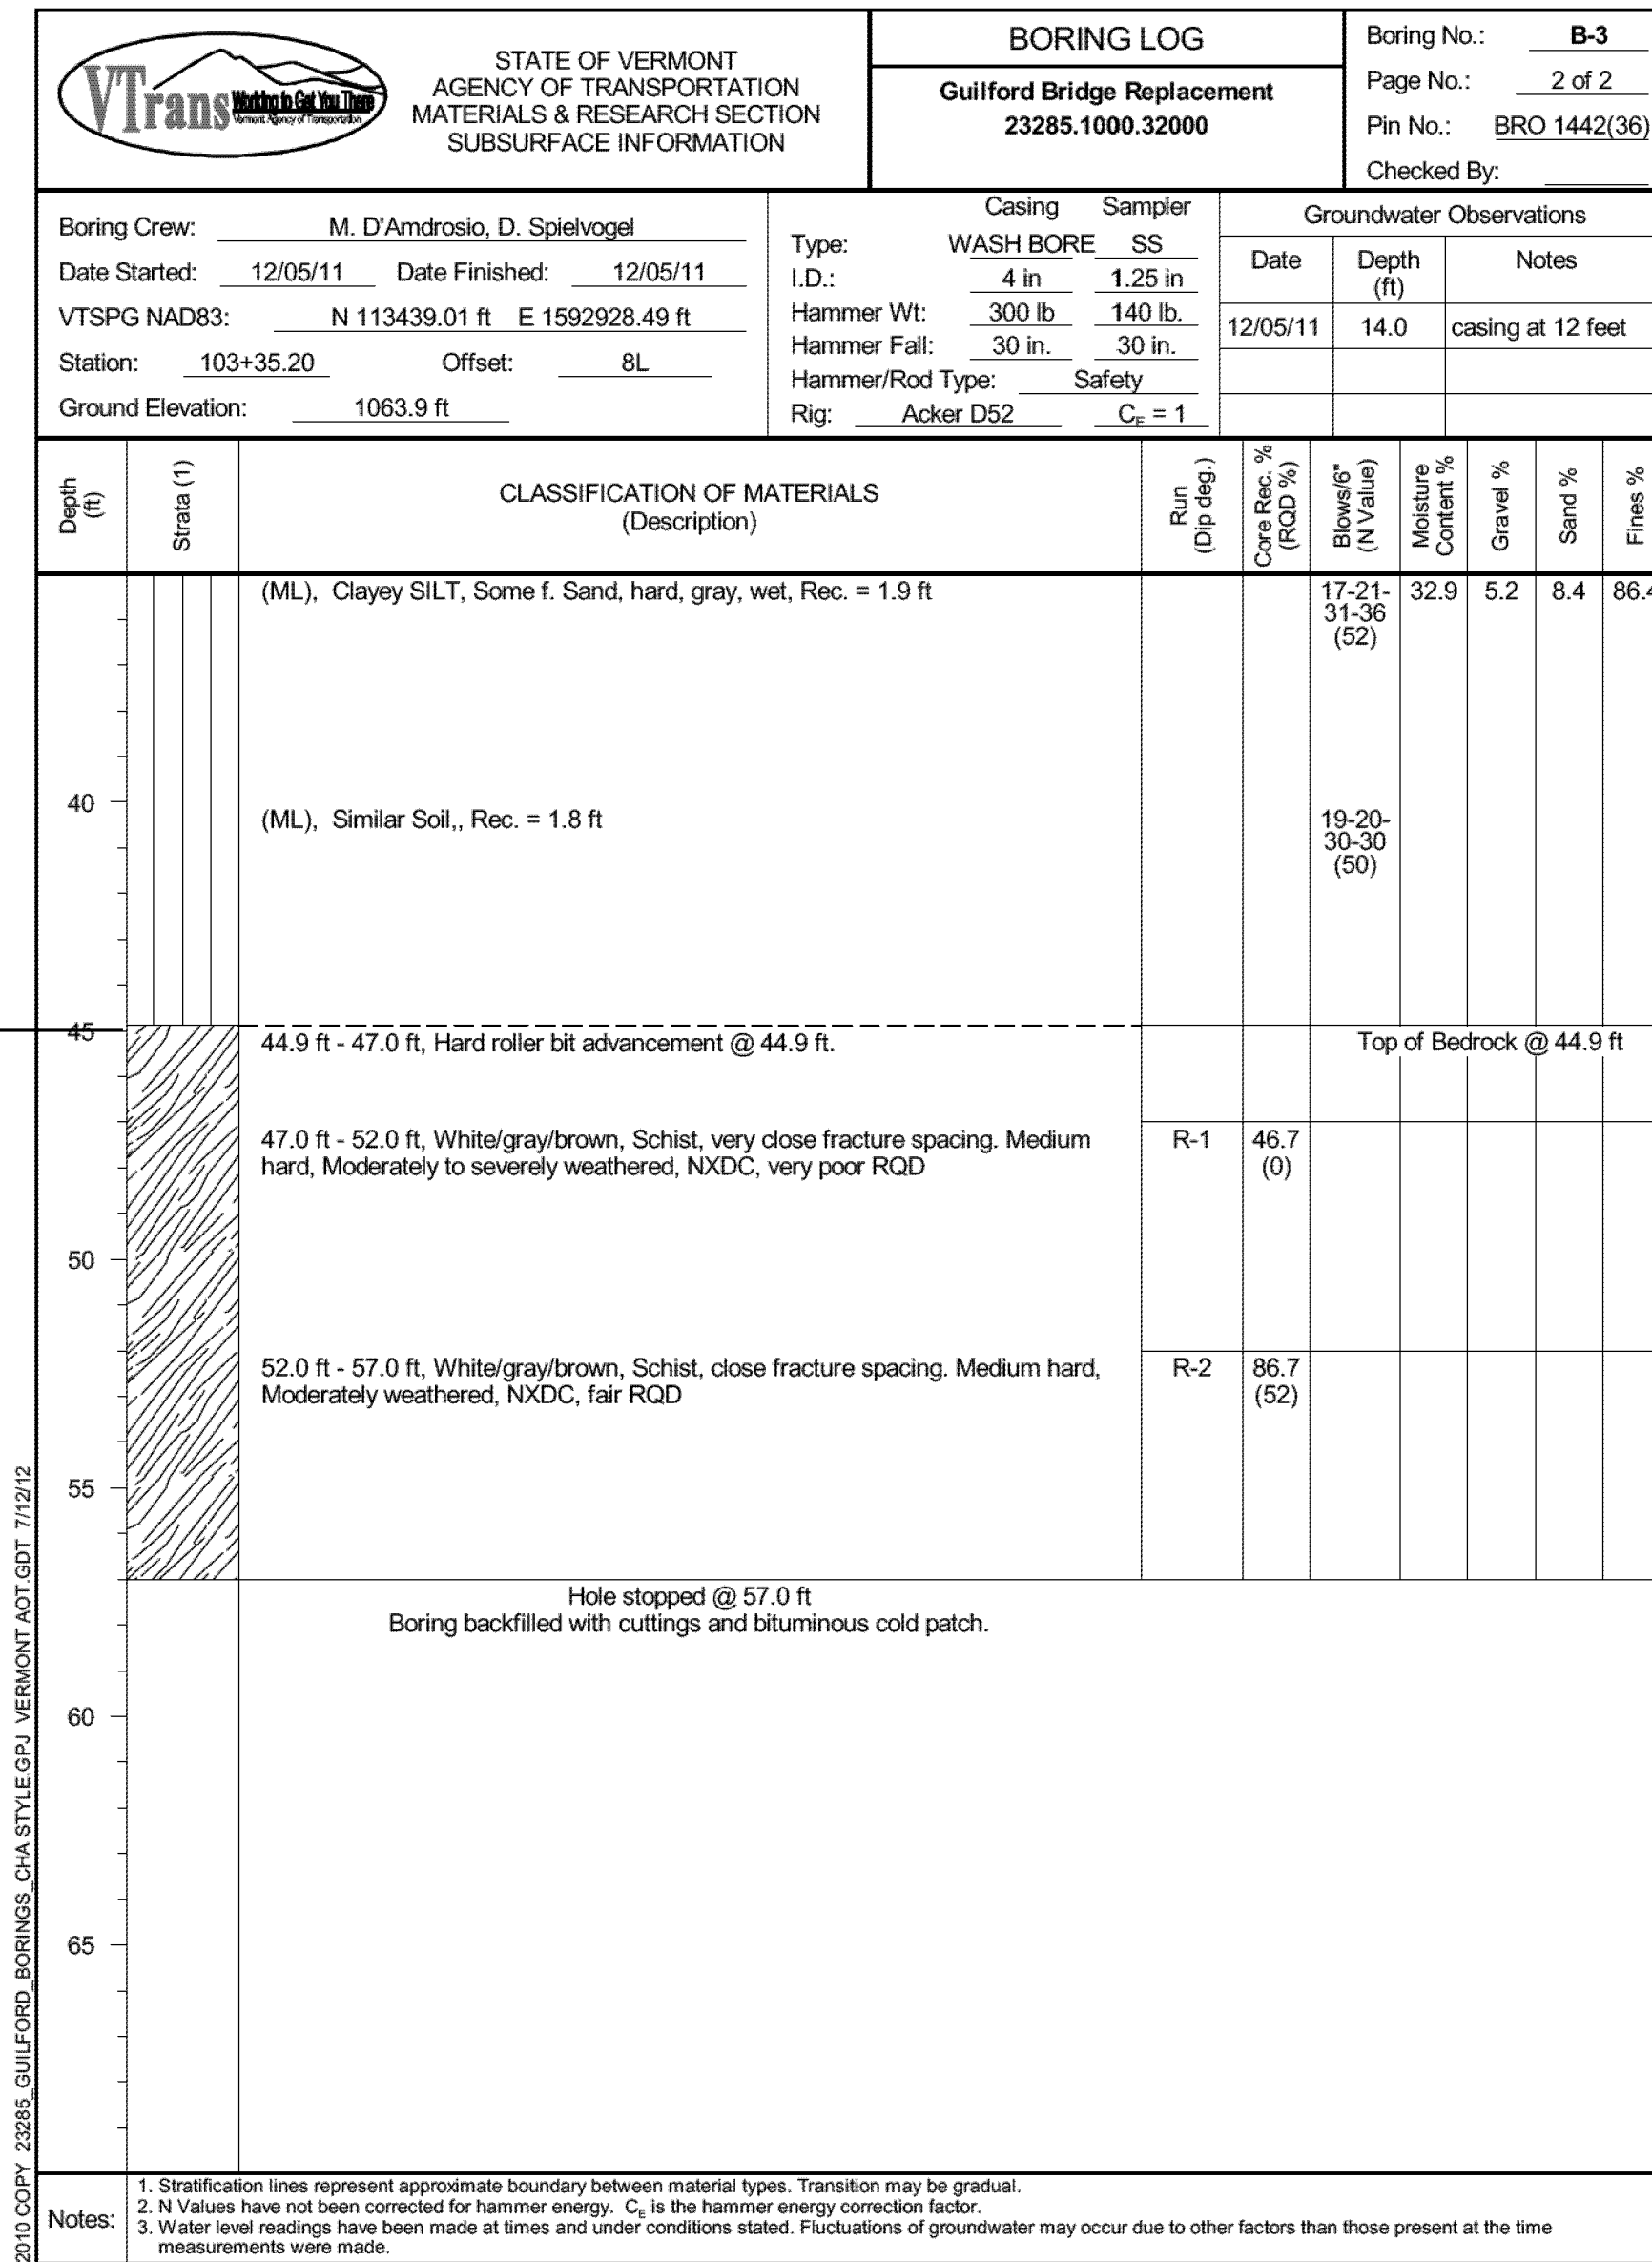


PROJECT NAME: <b>GUILFORD</b>	
PROJECT NUMBER: <b>BRO 1442(36)</b>	
FILE NAME: <b>z10j064borlogs.dgn</b>	PLOT DATE: <b>10/2/2013</b>
PROJECT LEADER: <b>S.E. BURBANK</b>	DRAWN BY: <b>E.A. FIALA</b>
DESIGNED BY: <b>VTRANS</b>	CHECKED BY: <b>S.E. BURBANK</b>
BORING LOGS (2 OF 2)	SHEET <b>18</b> OF <b>42</b>



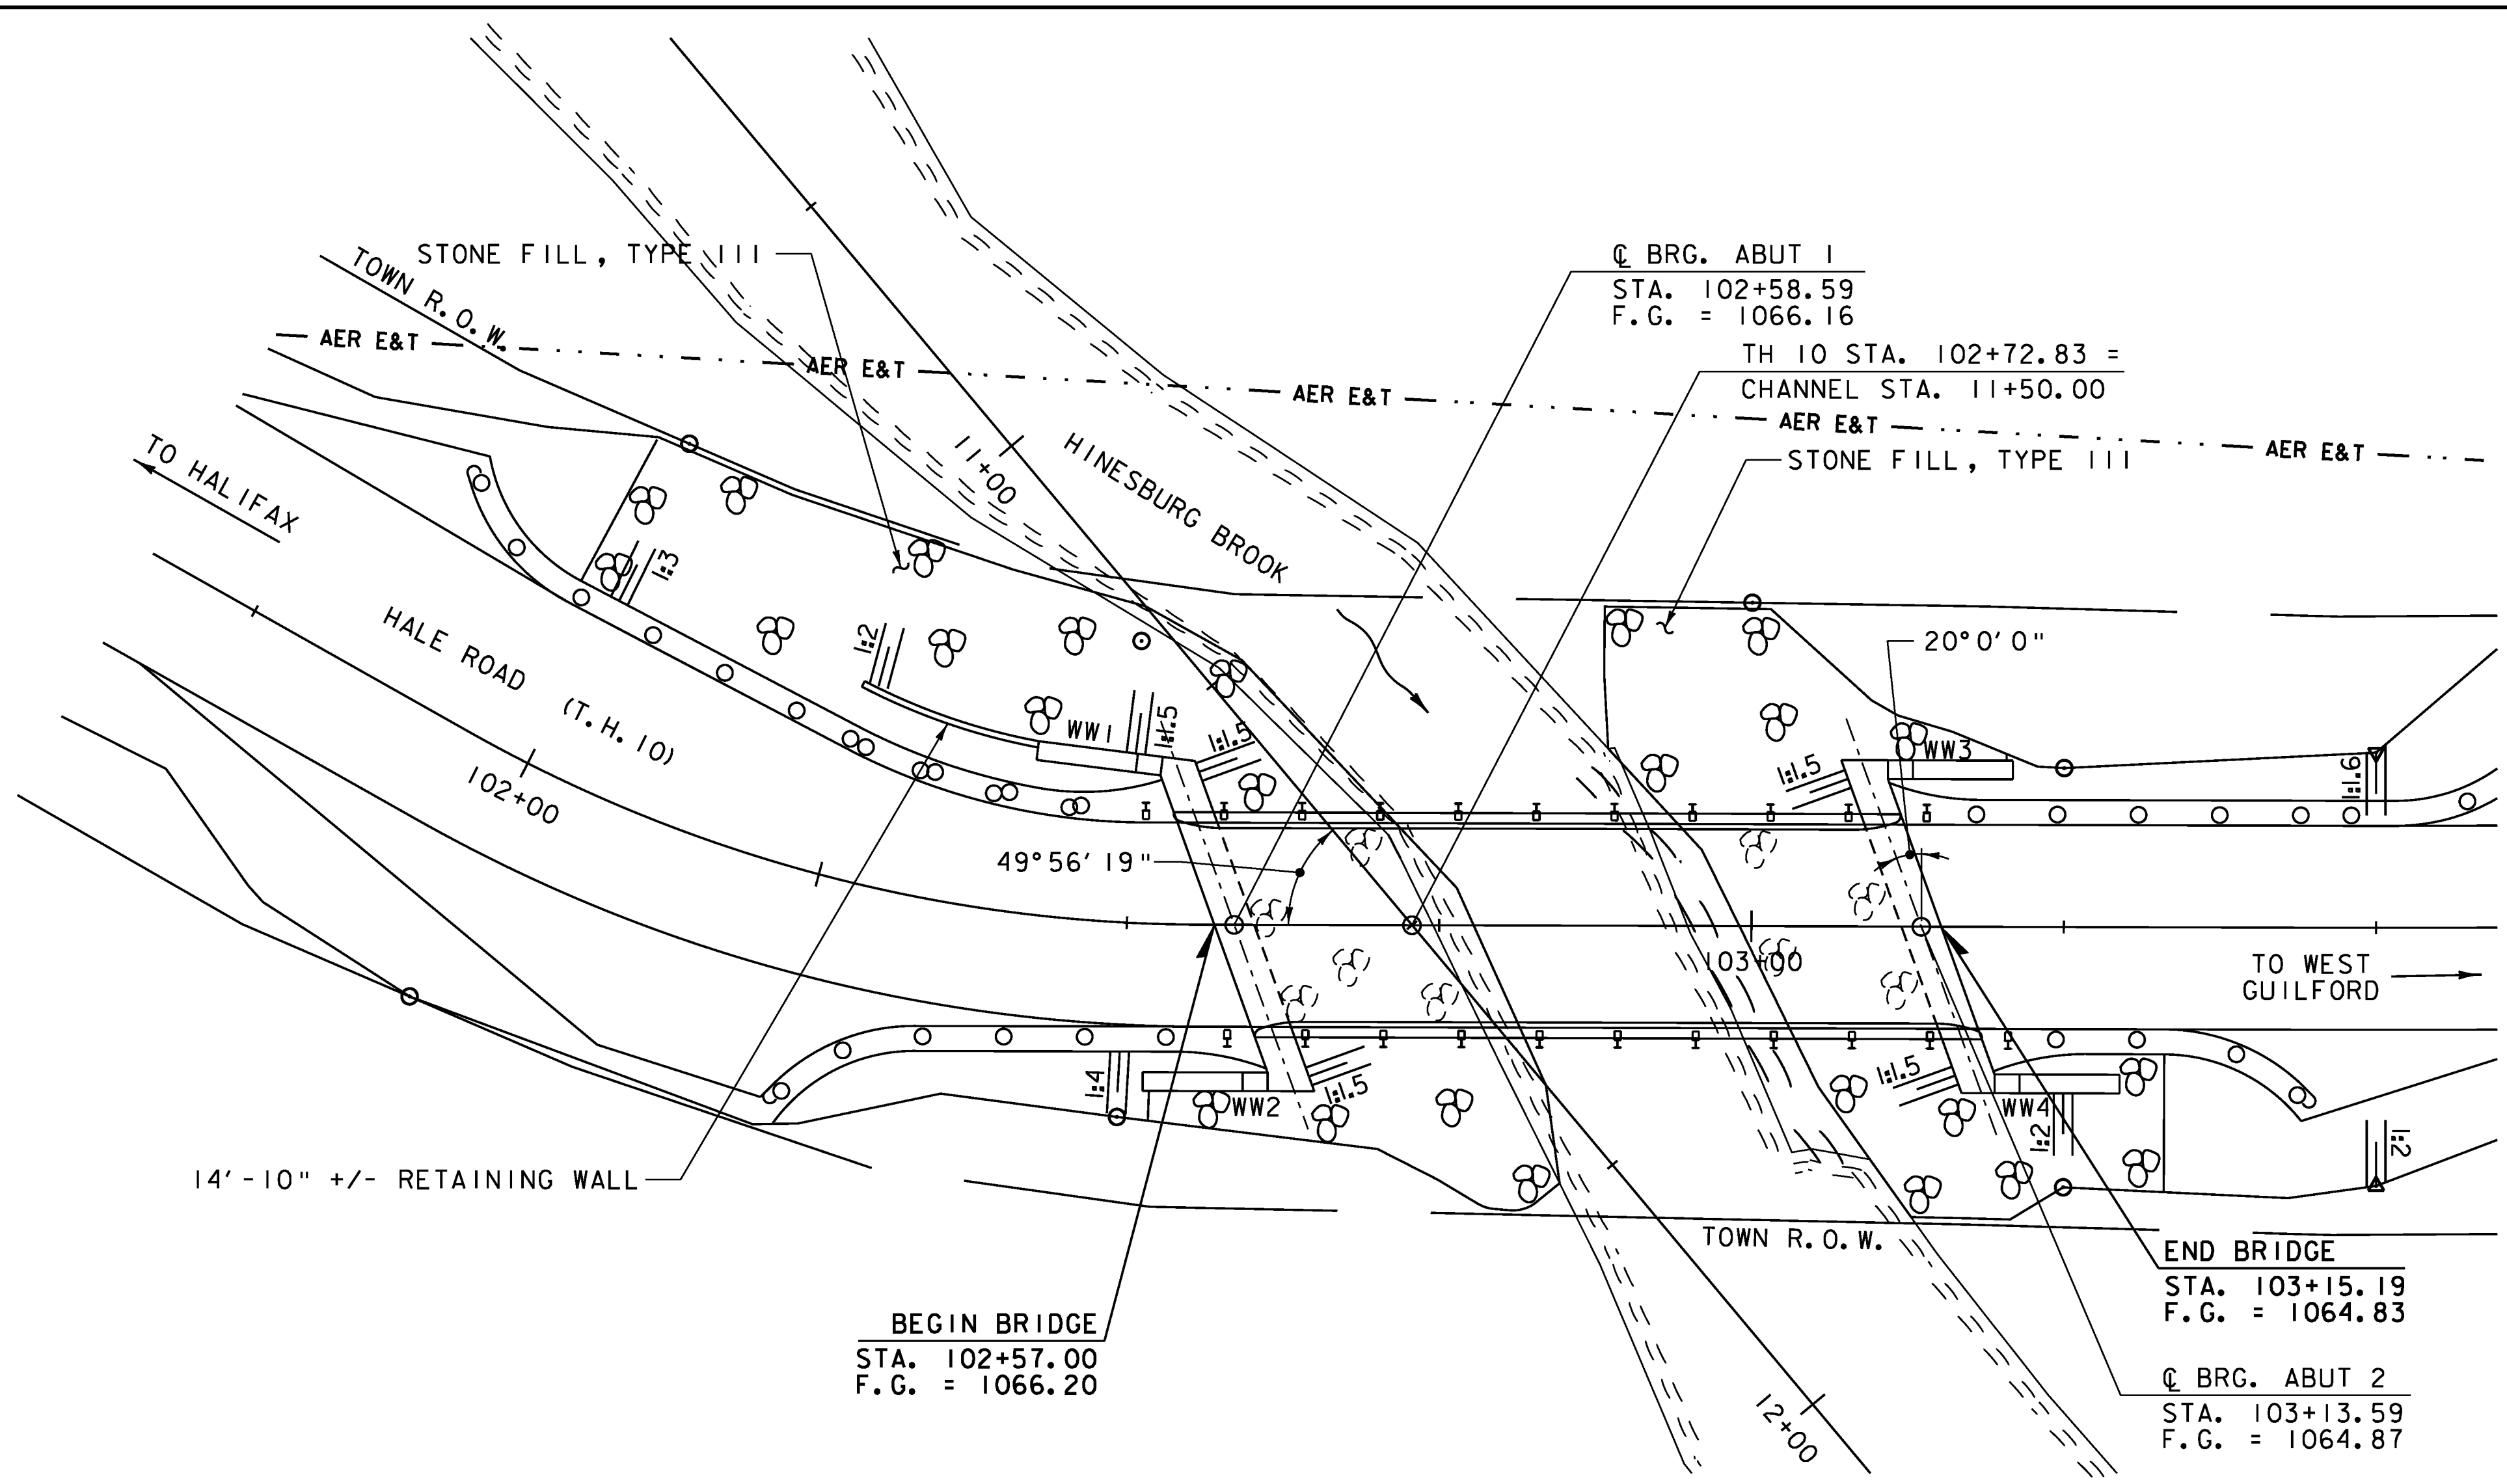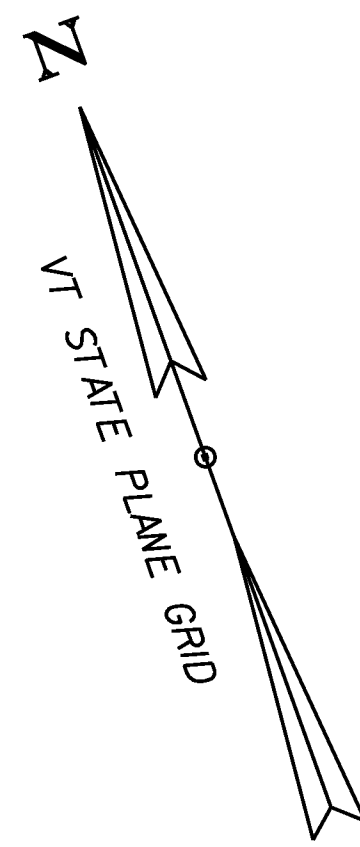


PLAN  
SCALE 1" = 10'-0"  
10 0 10

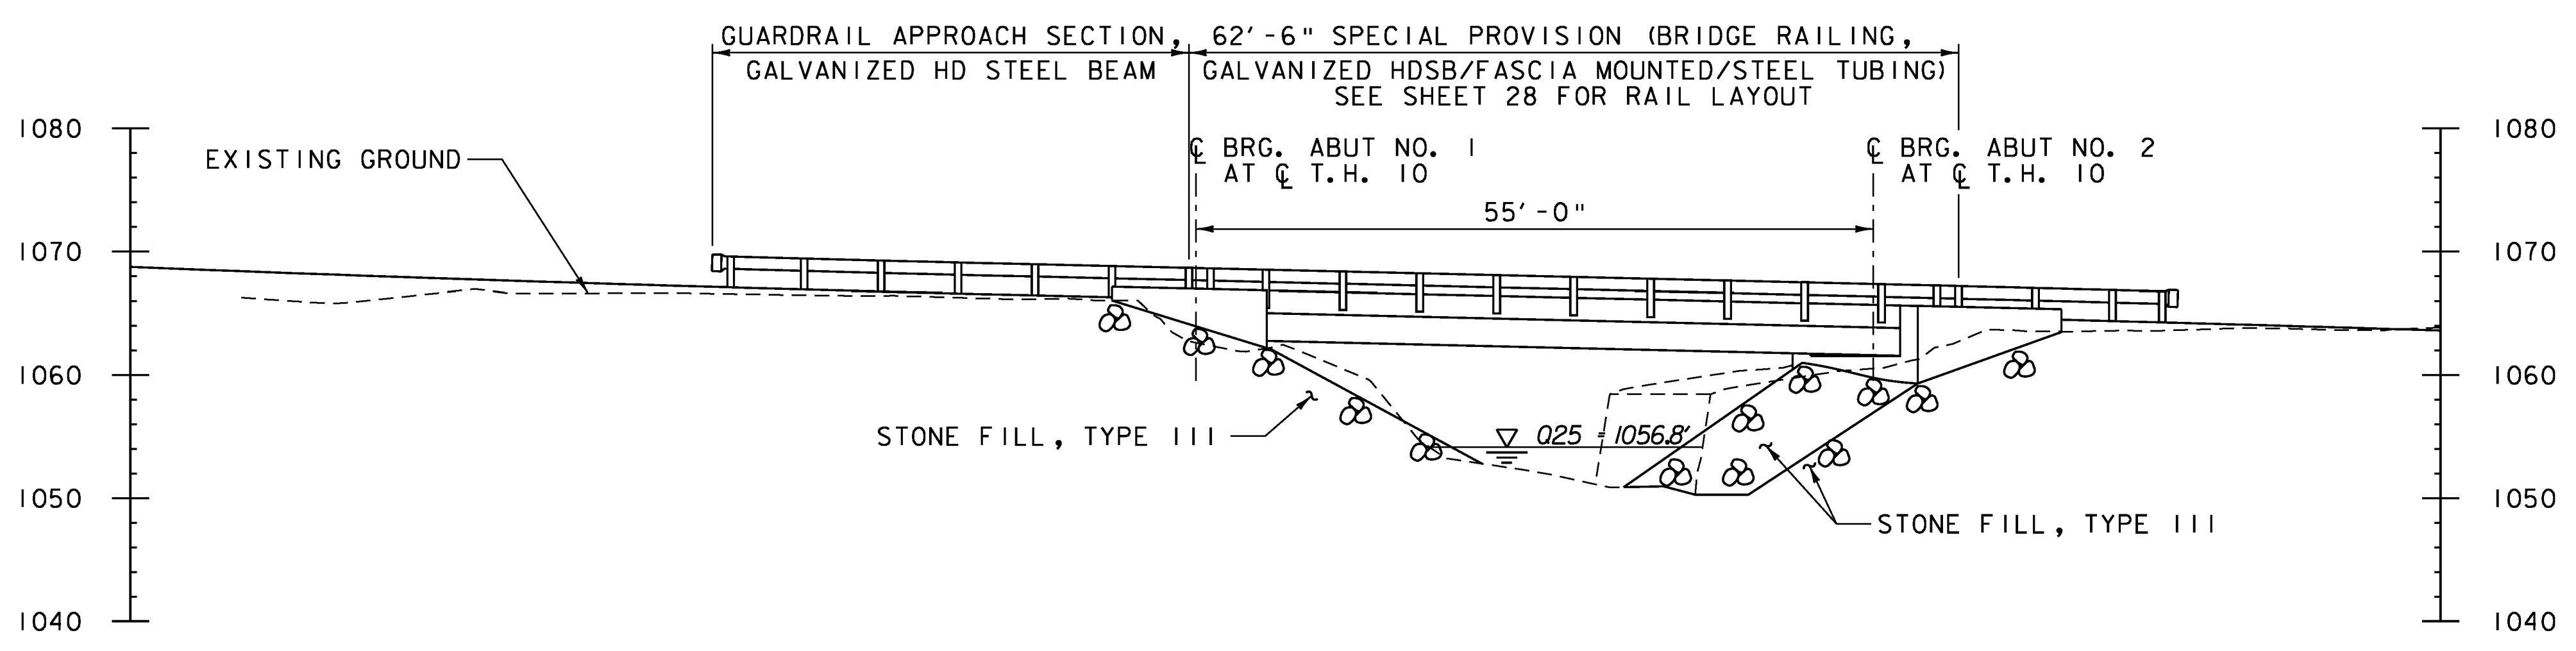


ELEVATION  
SCALE 1" = 10'-0"  
10 0 10

PROJECT NAME: GUILFORD	PLOT DATE: 10/2/2013
PROJECT NUMBER: BRO 1442(36)	DRAWN BY: E.A. FIALA
FILE NAME: z10j064pe.dgn	CHECKED BY: S.E. BURBANK
PROJECT LEADER: S.E. BURBANK	SHEET 19 OF 42
DESIGNED BY: E.A. FIALA	
PLAN AND ELEVATION	



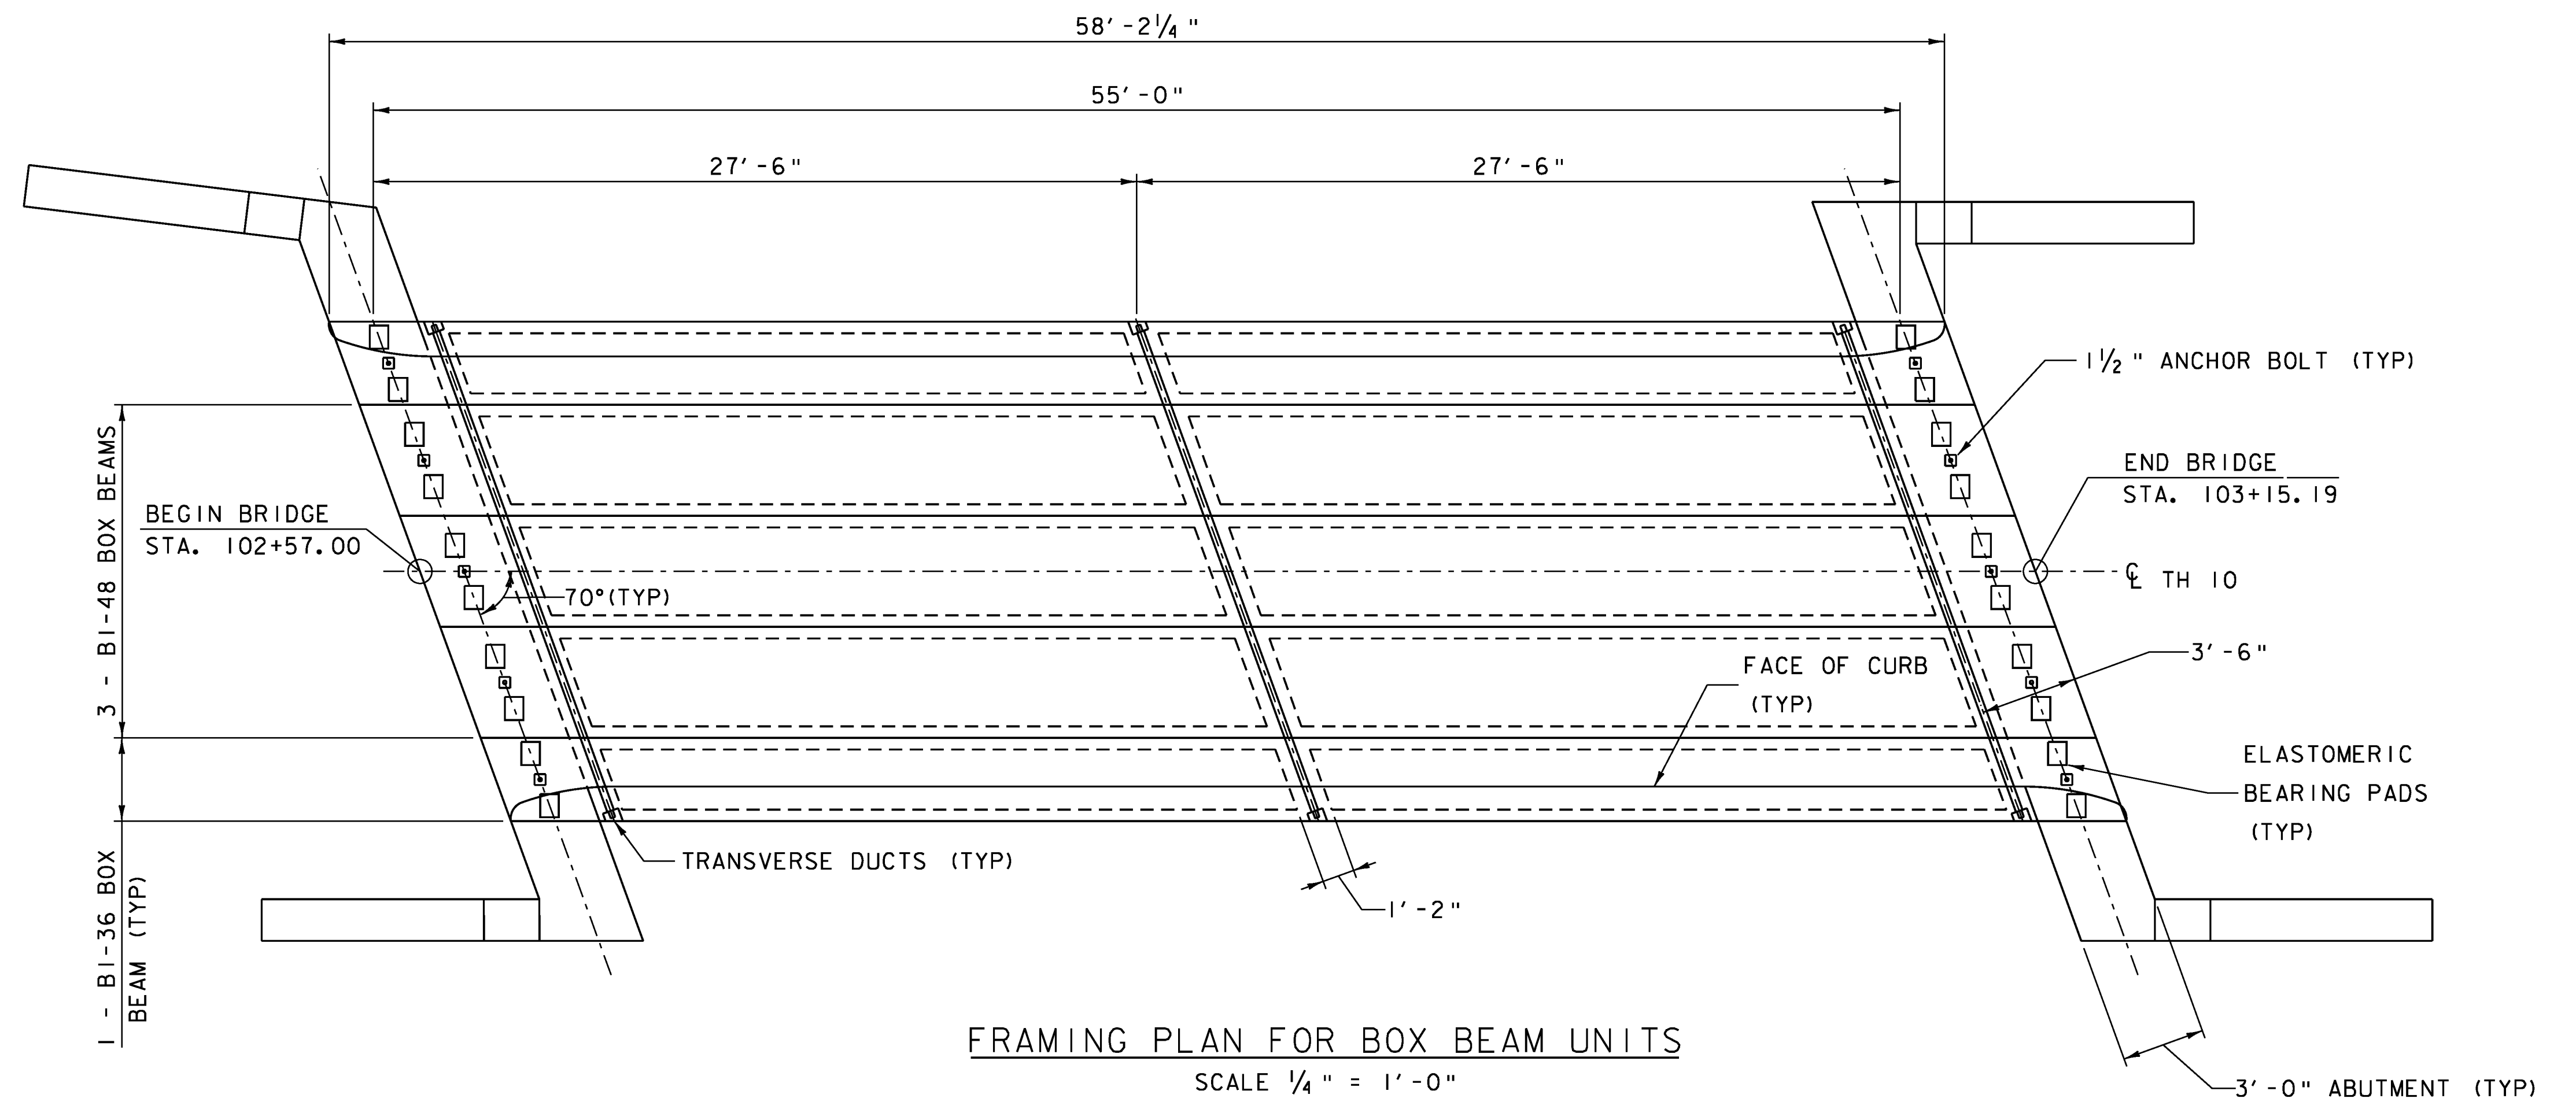

FRAMING PLAN FOR BOX BEAM UNITS  
SCALE 1/4" = 1'-0"

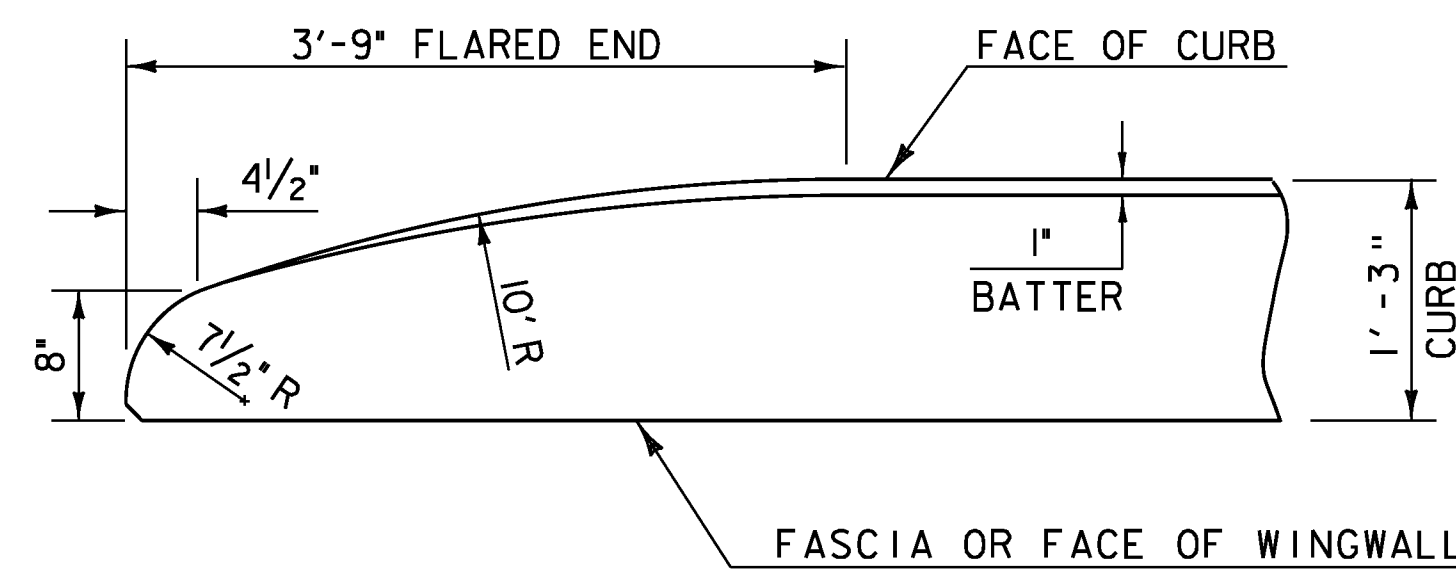


FLARED END DETAIL FOR 1'-3" CURB

CURB REINFORCING STIRRUP BARS SHALL BE TURNED AS REQUIRED TO FIT FLARED ENDS.

**NOTE:**

NF = NEAR FACE  
FF = FAR FACE  
EF = EACH FACE  
▲ = CUT TO FIT IN FIELD  
3" CLEAR, UNLESS OTHERWISE SPECIFIED ON THE PLANS.  
2'-2" BAR LAP UNLESS OTHERWISE SPECIFIED ON THE PLANS.

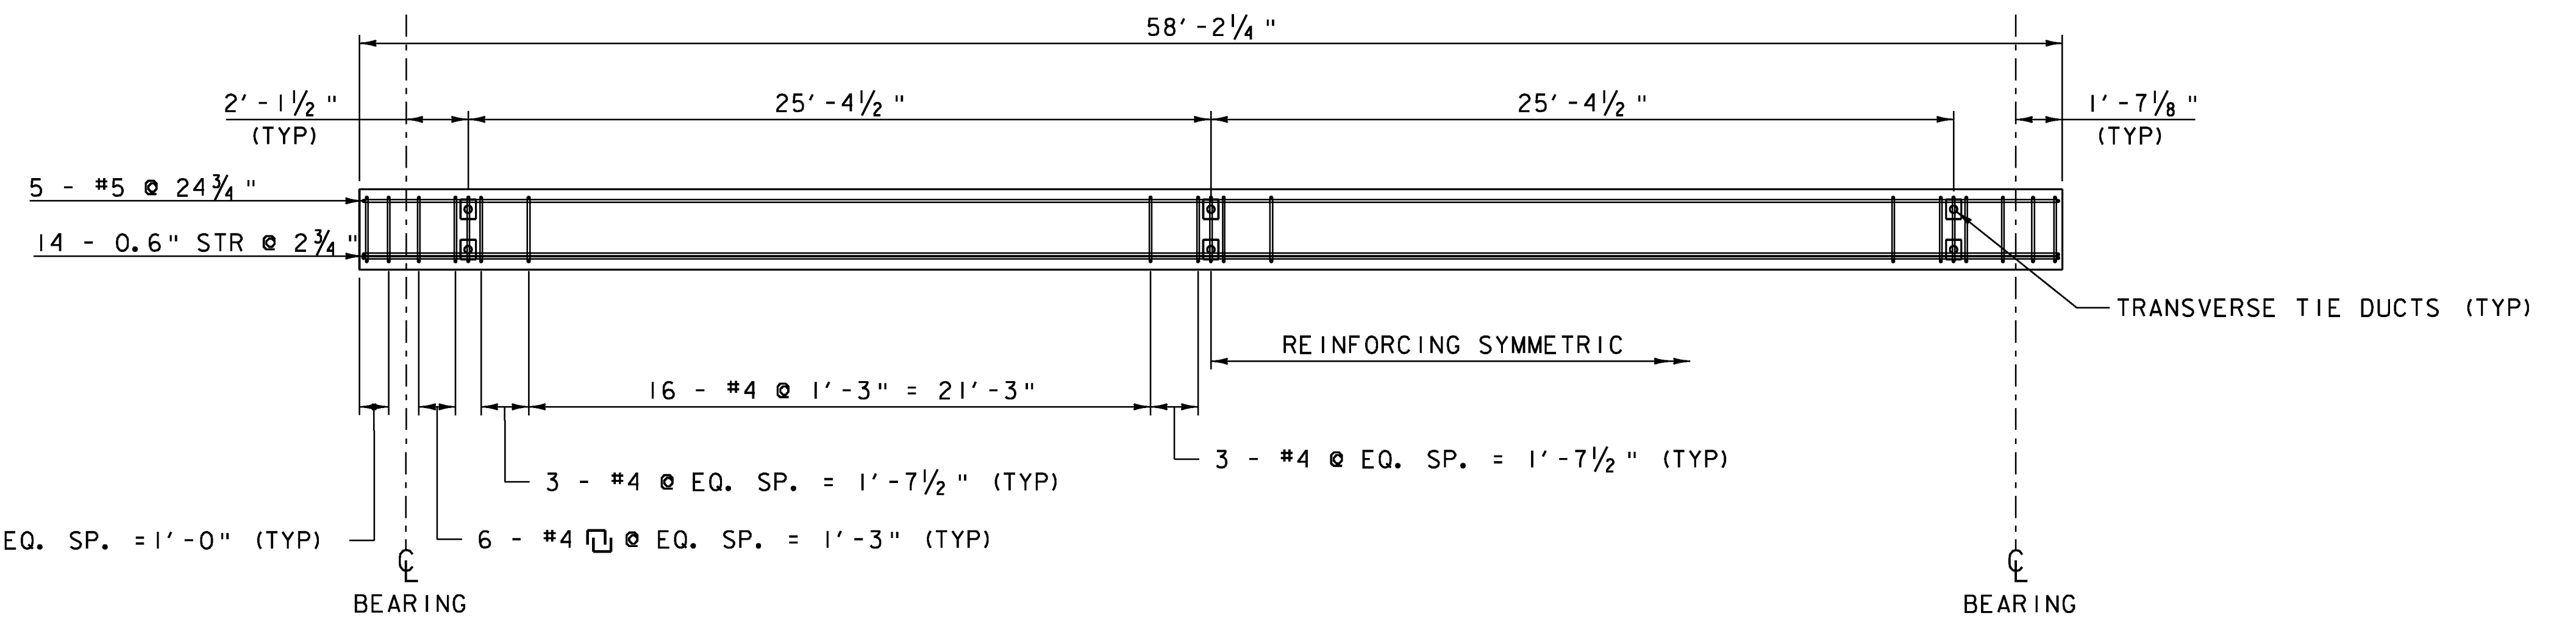

ELEVATION VIEW FOR BOX BEAM UNITS  
SCALE 1/4" = 1'-0"

**NOTES:**

1. SEE END AND INTERMEDIATE DIAGRAM REINFORCING DETAILS FOR BEAM STIRRUP SPACING AND LAYOUT.
2. CURB NOT SHOWN FOR CLARITY


PROJECT NAME: GUILFORD  
PROJECT NUMBER: BRO 1442(36)

FILE NAME: z10j064sup.dgn  
PROJECT LEADER: S.E. BURBANK  
DESIGNED BY: G.H. NEAL  
FRAMING PLAN


PLOT DATE: 10/2/2013  
DRAWN BY: J.L. LEMIEUX  
CHECKED BY: A.F. PREZIOSO  
SHEET 20 OF 42






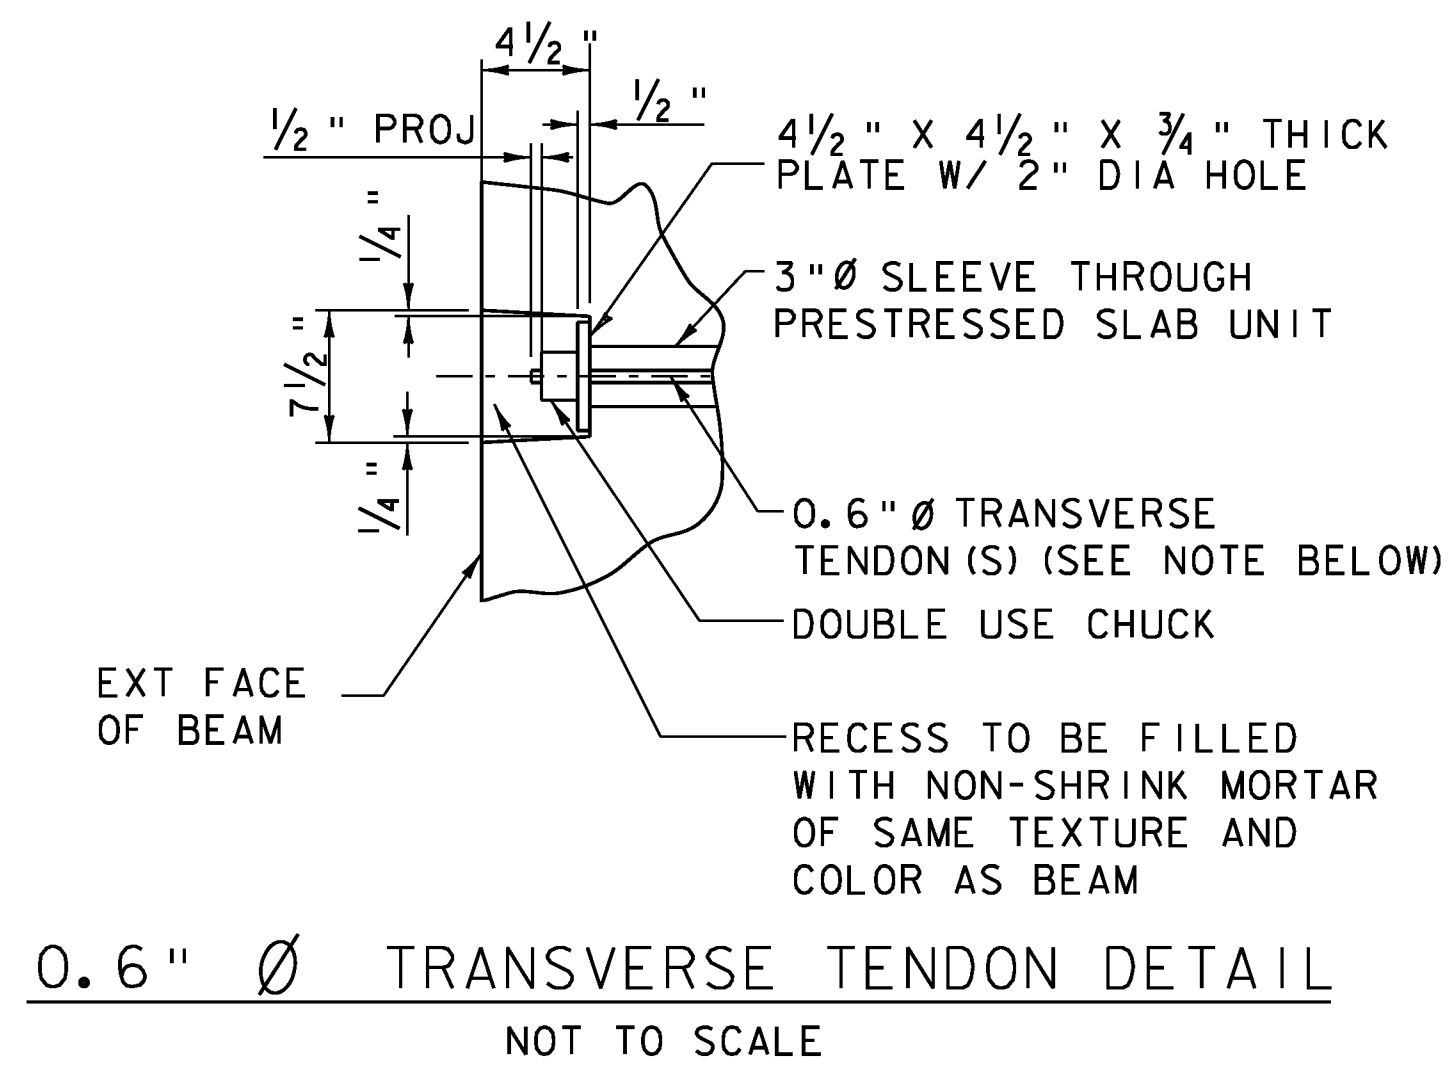



* TRANSVERSE TIES SHALL BE COVERED BY SEAMLESS POLYPROPYLENE SHEATH (WITH CORROSION INHIBITER GREASE BETWEEN SHEATH AND STRAND) FOR THE LENGTH OF STRAND, EXCEPT AT ANCHORAGE LOCATIONS. EACH TIE IS COMPRISED OF A SINGULAR OR MULTIPLE STRAND TENDON. EACH TRANSVERSE STRAND SHALL BE TENSIONED TO 47 KIPS. TENDONS SHALL CONSIST OF 1 STRAND TOP AND BOTTOM AT END DIAPHRAGM LOCATIONS AND 2 STRANDS TOP AND BOTTOM AT THE INTERMEDIATE DIAPHRAGM LOCATION. REFER TO THE PRESTRESSED BOX BEAM NOTES FOR STRAND MATERIAL PROPERTIES.

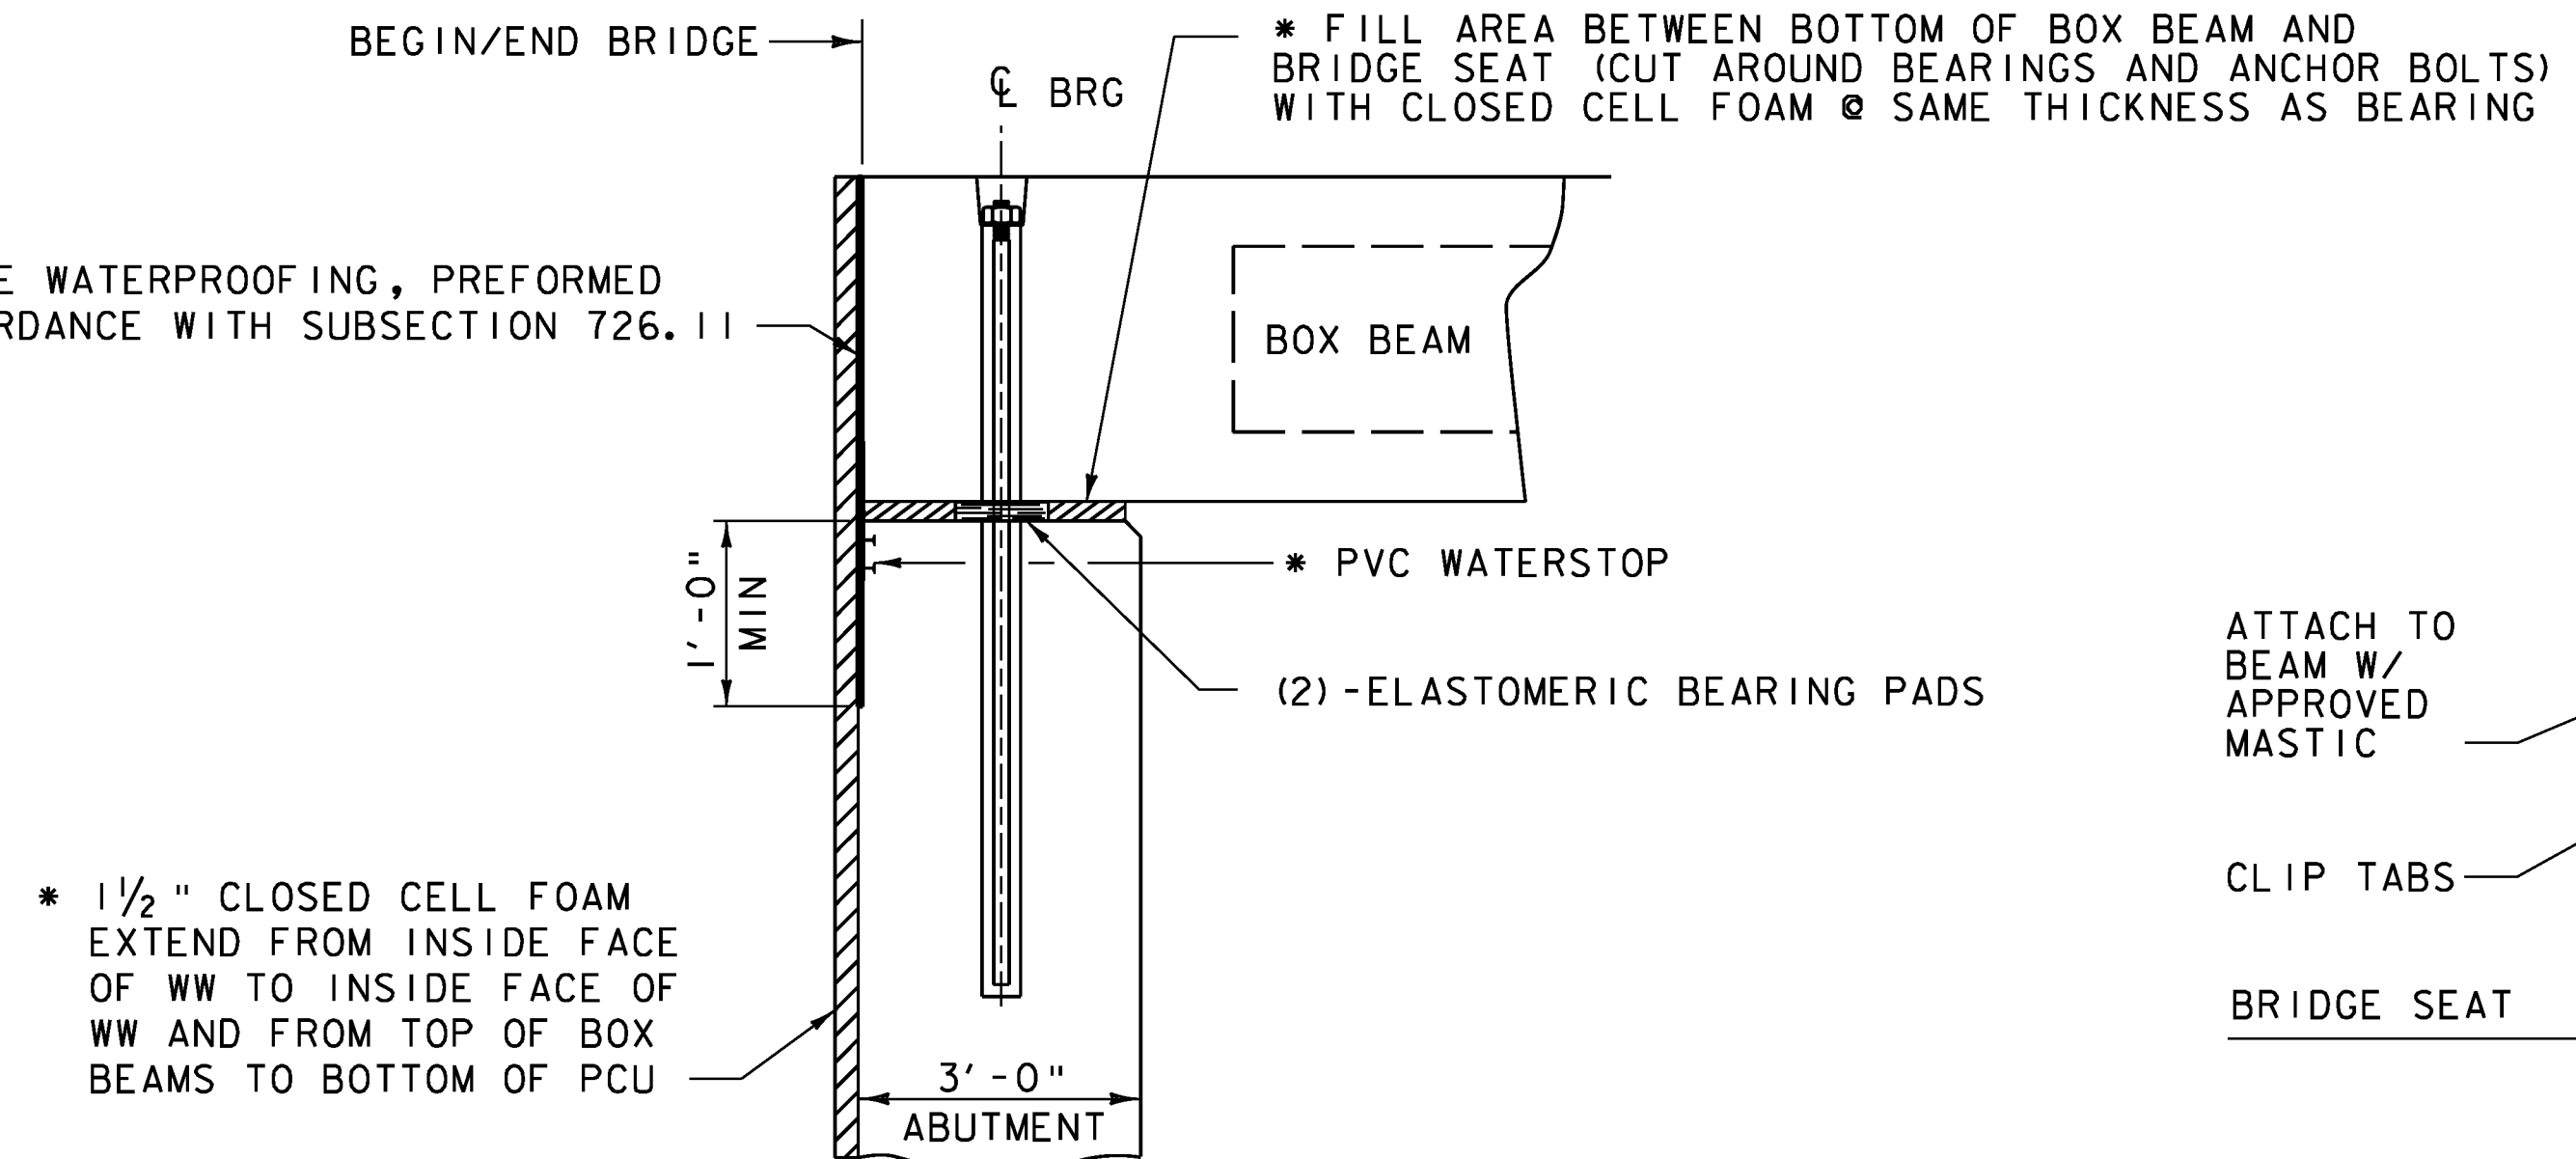

* THESE ITEMS SHALL BE INCIDENTAL TO THE APPROPRIATE PRECAST CONCRETE ITEM 540.10 "PRECAST CONCRETE STRUCTURE (ABUTMENT NO. 1)" OR "PRECAST CONCRETE STRUCTURE (ABUTMENT NO. 2)"

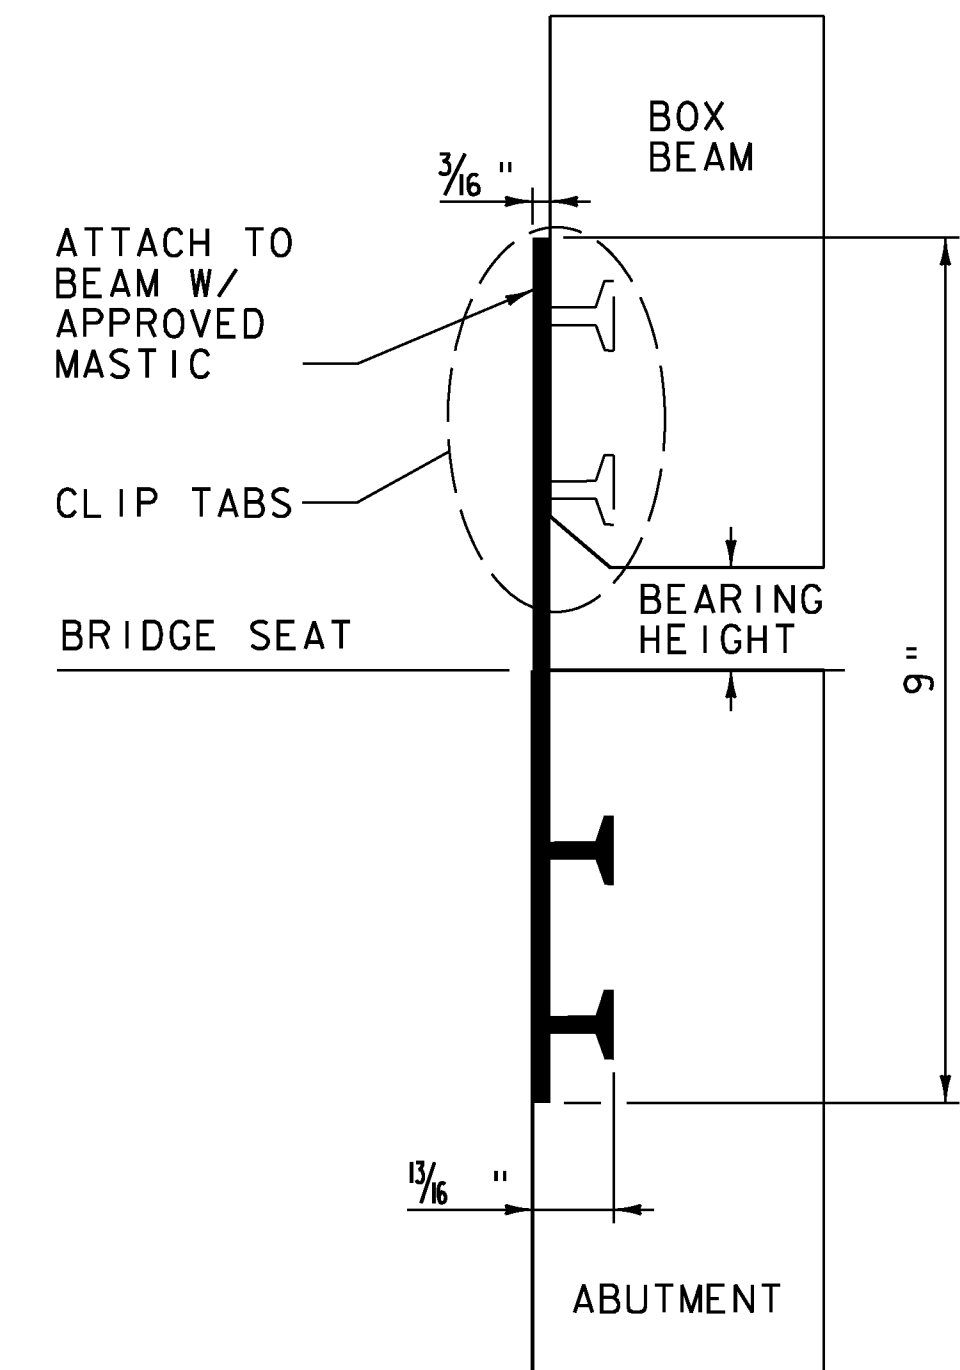

NOTE: PVC WATERSTOP SHALL BE ONE CONTINUOUS STRIP.

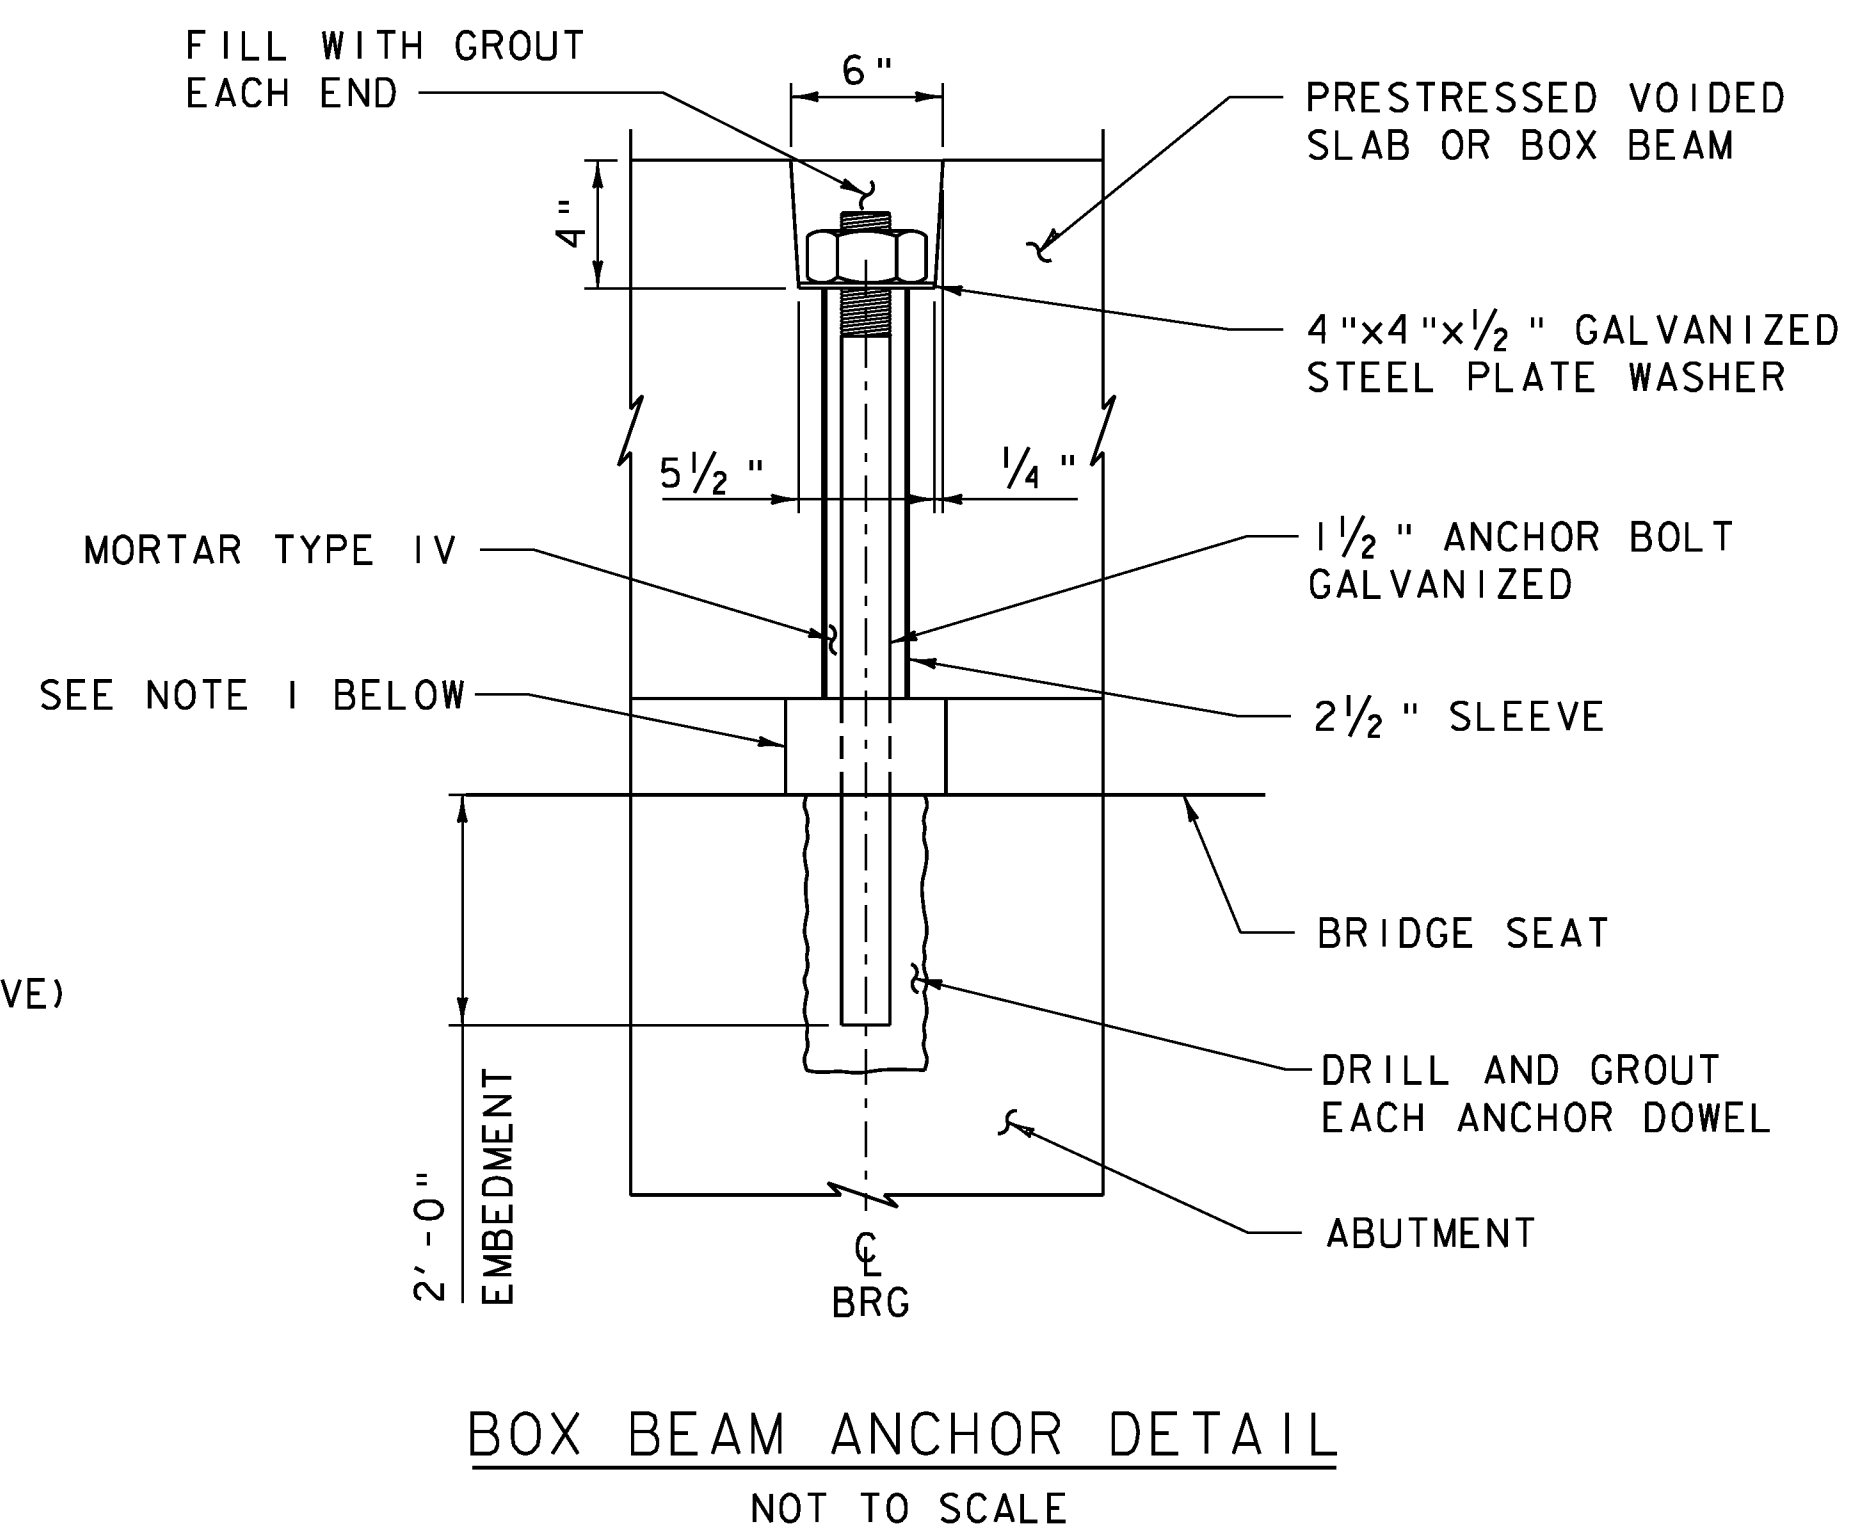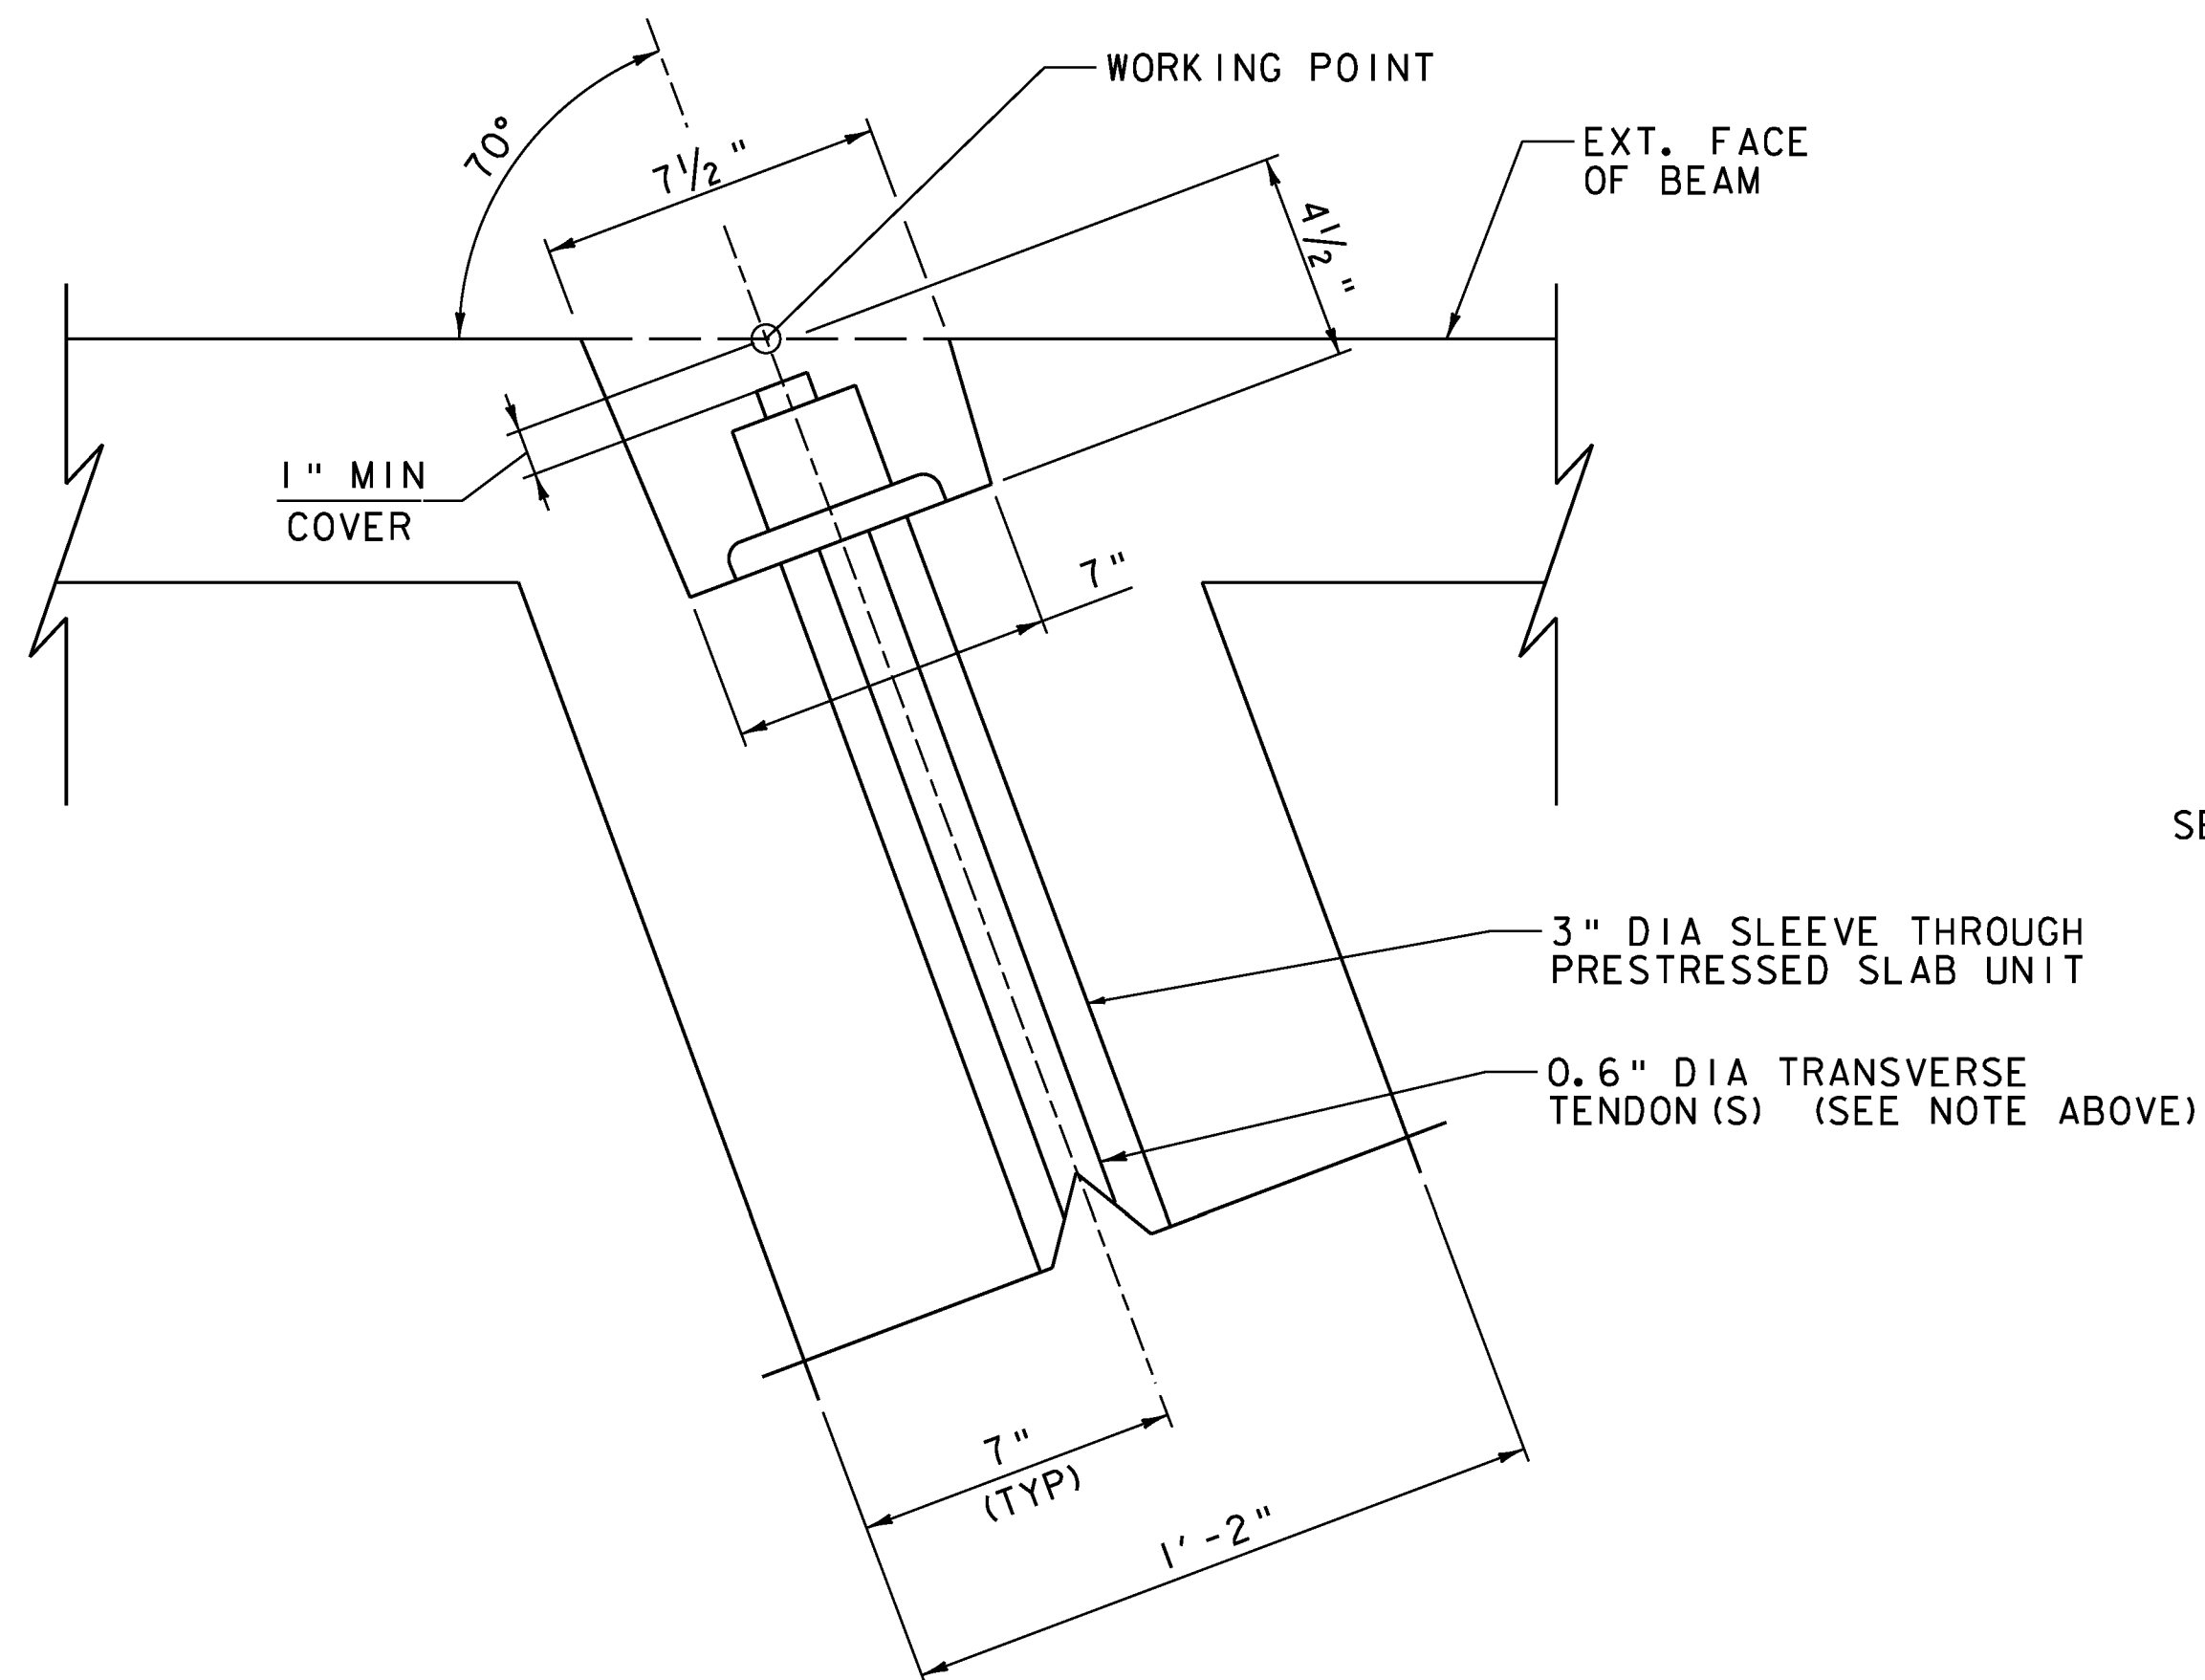


- CONTRACTOR SHALL SUPPLY A SELF ADHESIVE COMPRESSIBLE SEALER BETWEEN THE BOTTOM OF THE UNITS AND THE BRIDGE SEAT. THIS COMPRESSIBLE SEALER SHALL SURROUND THE  $2\frac{1}{2}$ " DIA SLEEVE IN THE UNIT. THE PURPOSE OF THE SEALER IS TO FACILITATE PLACEMENT OF THE GROUT AROUND THE ANCHOR BOLTS.
- GROUT ANCHOR BOLTS INTO THE SLEEVES. BEFORE THE GROUT CURES, PLACE THE WASHER PLATE AND INSTALL THE NUT ON TOP AND TIGHTEN.

**VHB** Vanasse Hangen Brustlin, Inc.

PROJECT NAME: GUILFORD  
PROJECT NUMBER: BRO 1442(36)

FILE NAME: z10j064sup3.dgn  
PROJECT LEADER: S.E. BURBANK  
DESIGNED BY: G.H. NEAL  
BOX BEAM DETAILS (2 OF 2)


PLOT DATE: 10/2/2013  
DRAWN BY: J.L. LEMIEUX  
CHECKED BY: A.F. PREZIOSO  
SHEET 22 OF 42

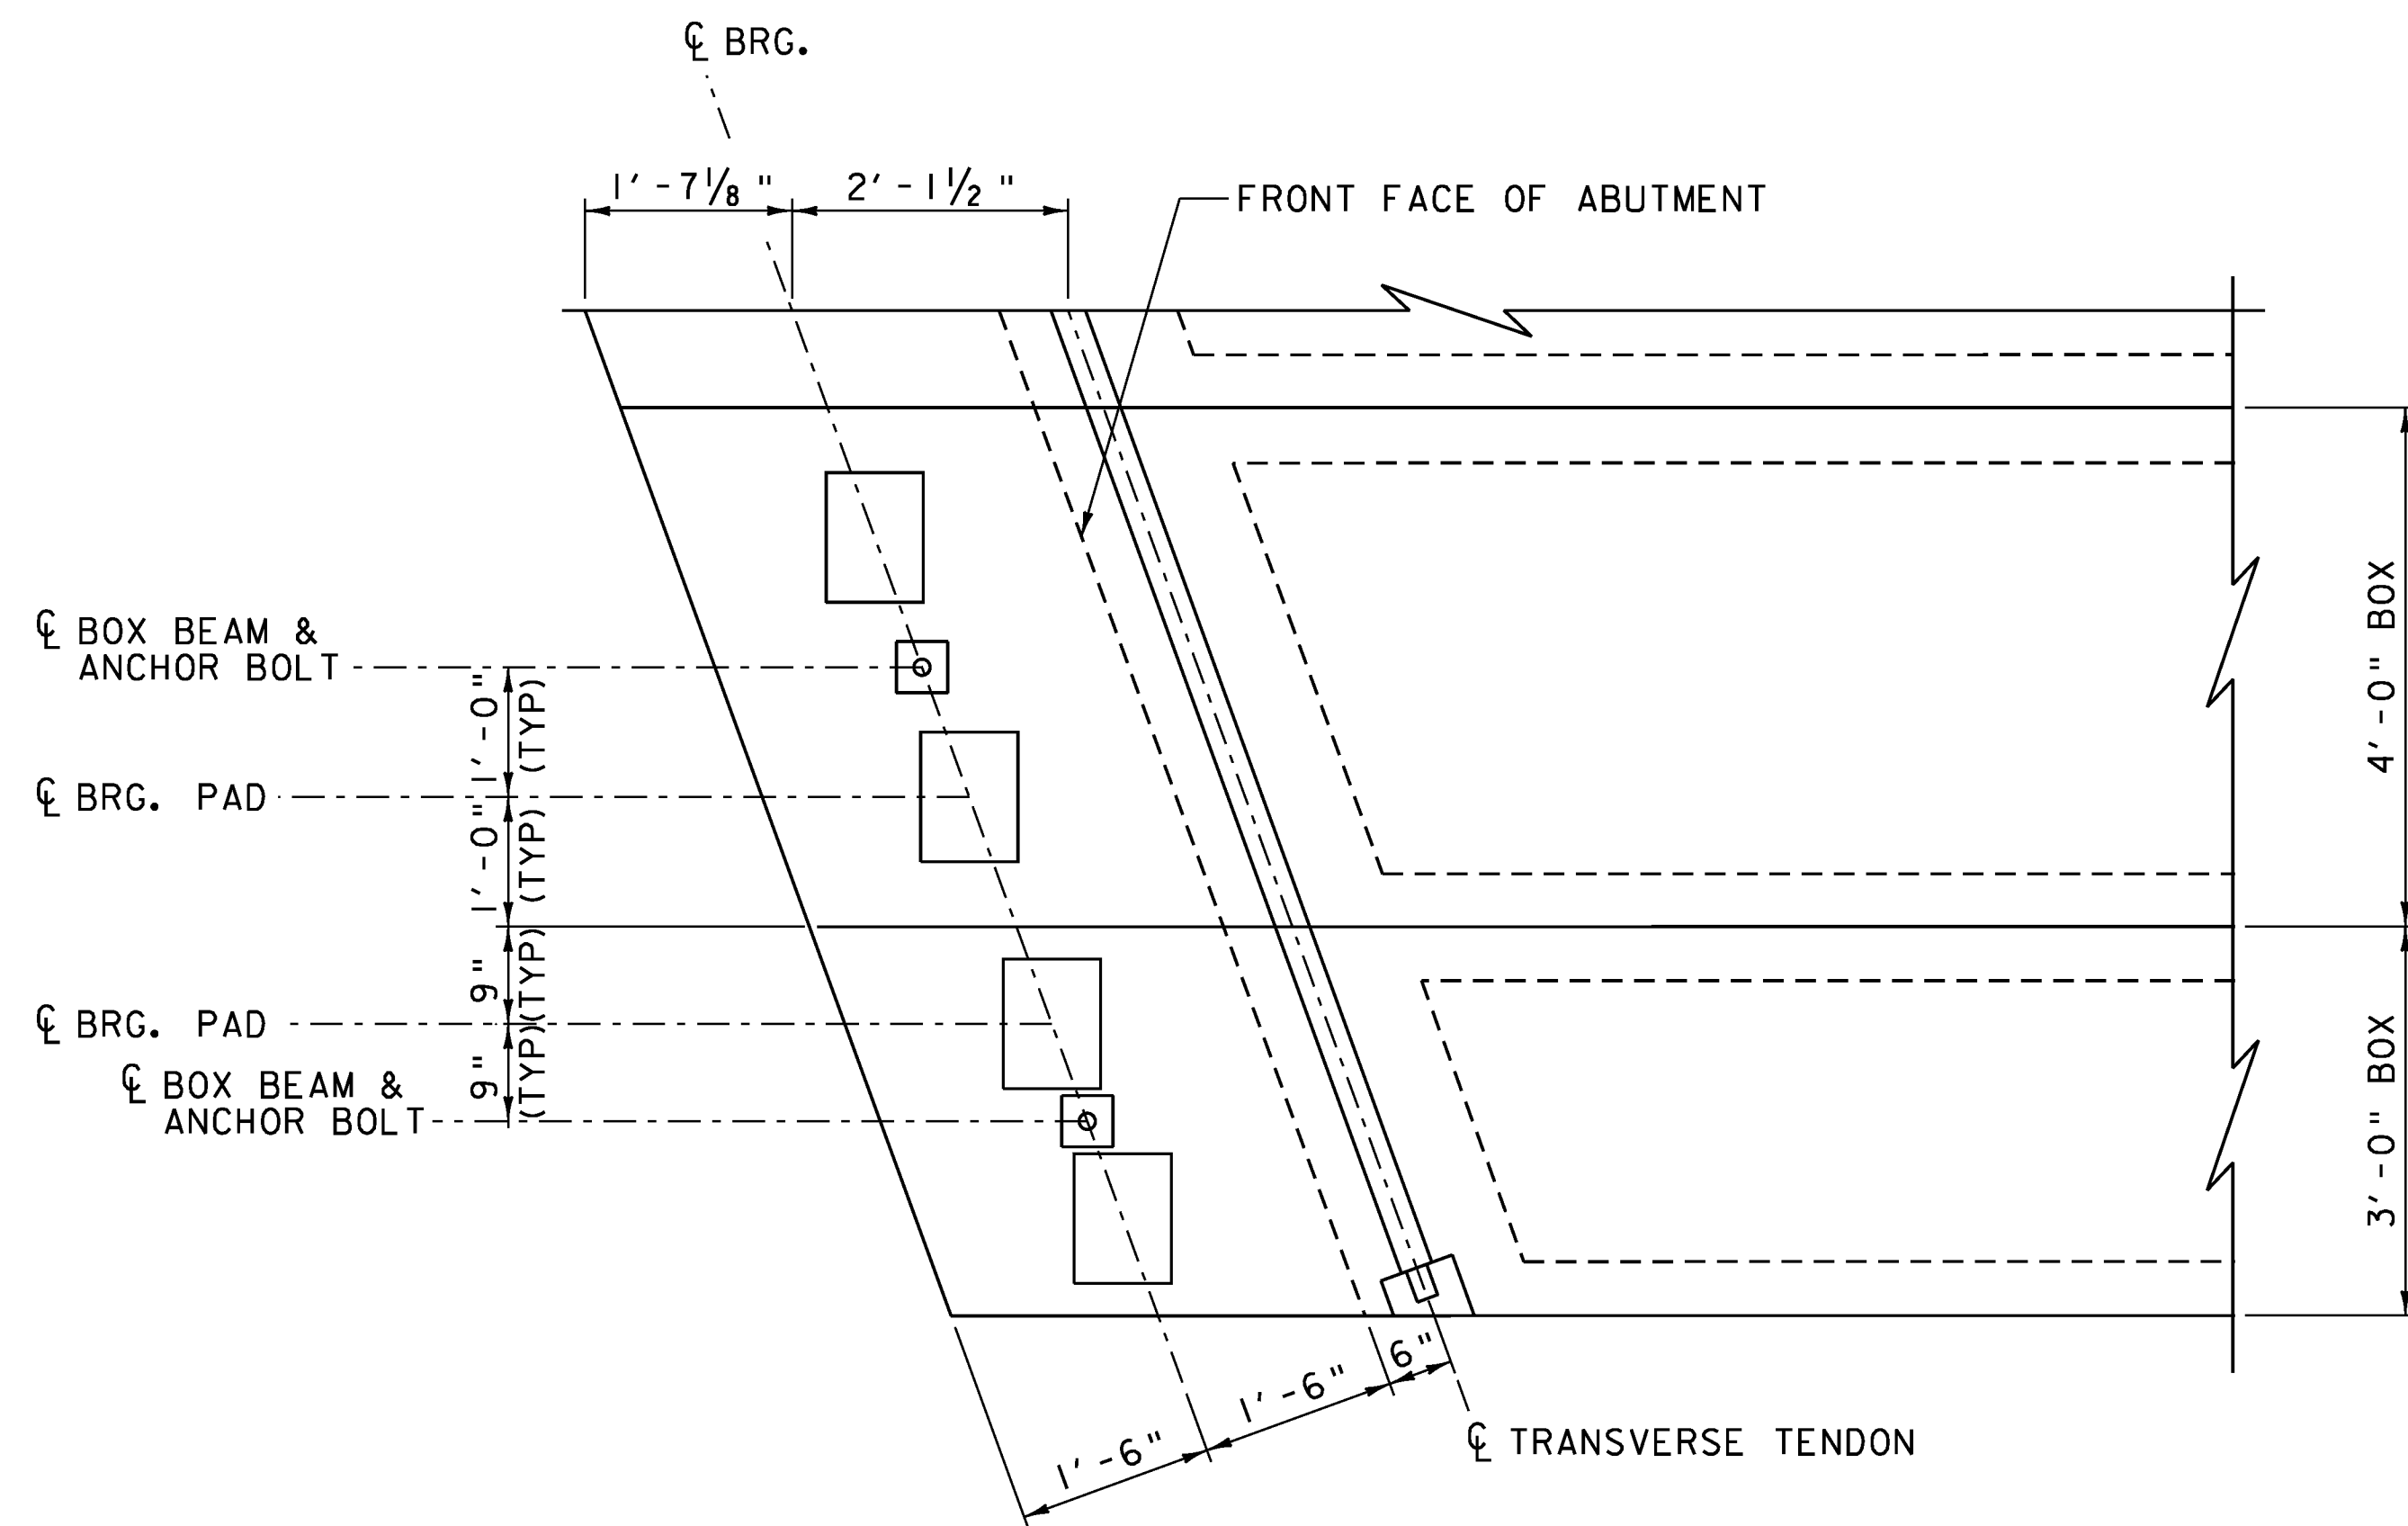

NOTE: CURB NOT SHOWN FOR CLARITY

**BEARING PLACEMENT PLAN**

SCALE 3/4" = 1'-0"

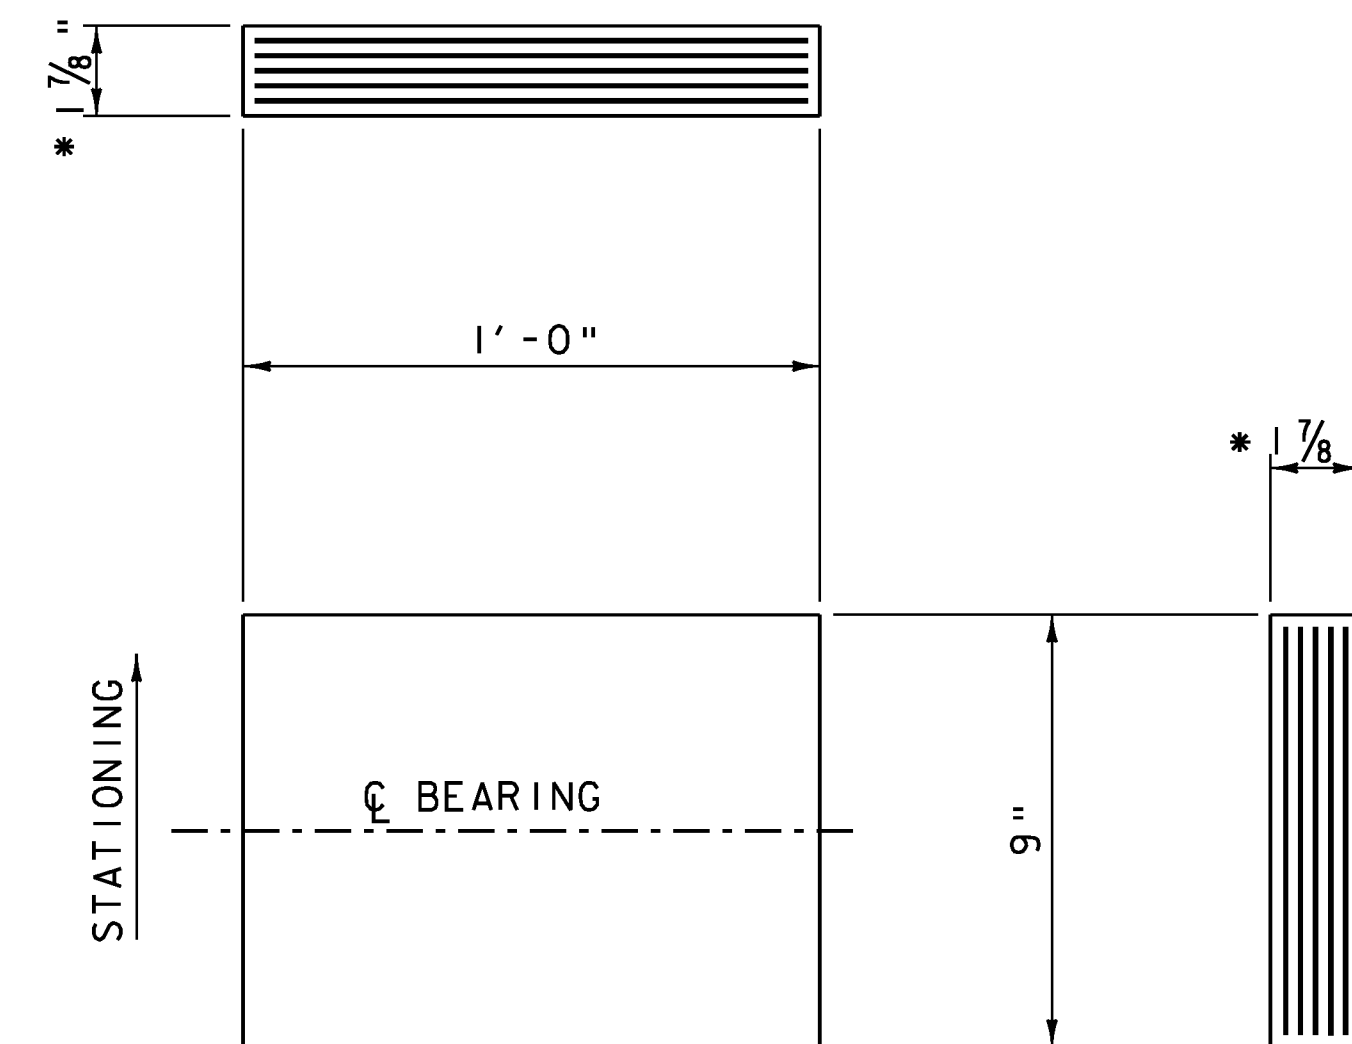

**ELASTOMERIC BEARING DETAIL**

SCALE 3" = 1'-0"

- * 2 - 1/4" EXTERIOR LAYERS OF ELASTOMER
- 2 - 1/2" INTERIOR LAYERS OF ELASTOMER
- 3 - 1/8" STEEL REINFORCING PLATES

**ELASTOMERIC BEARING NOTES:**

1. BEARINGS SHALL CONFORM TO THE APPLICABLE SUBSECTIONS OF SECTIONS 531 AND 731.
2. THE BEARINGS, INCLUDING ANCHOR BOLTS, DRILLING AND GROUTING, WASHERS AND NUTS SHALL BE PAID FOR UNDER THE ITEM 531.17 "BEARING DEVICE ASSEMBLY, STEEL REINFORCED ELASTOMER PAD."
3. ALL PLATES, NUTS, WASHERS AND ANCHOR BOLTS SHALL BE GALVANIZED OR METALIZED AS PER SUBSECTIONS 726.08 AND 726.09. AREAS OF GALVANIZING OR METALIZING DAMAGED BY FIELD WELDING OR HANDLING SHALL BE REPAIRED IN CONFORMANCE WITH SUBSECTIONS 726.08 AND 726.09.
4. ALL WASHERS SHALL BE 1/2" PLATE (MINIMUM). PAYMENT FOR DRILLING AND GROUTING OF ANCHOR BOLTS SHALL BE INCLUDED IN THE BID PRICE FOR CONTRACT ITEM 531.17, "BEARING DEVICE ASSEMBLY, STEEL REINFORCED ELASTOMERIC PAD".
5. ALL REINFORCEMENT BETWEEN LAYERS OF ELASTOMER SHALL BE STEEL, MEETING THE REQUIREMENTS OF SUBSECTION 714.02. ALL INTERNAL STEEL PLATES SHALL BE SAND BLASTED AND FREE OF COATINGS, RUST AND MILL SCALE. THE PLATES SHALL BE FREE OF SHARP EDGES AND BURRS.
6. ANCHOR BOLTS SHALL BE ASTM F1554, GRADE 105 AND MEET THE REQUIREMENTS OF SUBSECTION 714.08.
7. STEEL REINFORCED ELASTOMERIC BEARINGS SHALL HAVE A MINIMUM 1/4" EDGE SEAL OF ELASTOMER INTEGRAL WITH BEARING OVER ALL INTERNAL PLATES.
8. THE CONCRETE UNDER THE BEARING DEVICE SHALL BE LEVEL IN THE LONGITUDINAL DIRECTION.
9. ALL DESIGNS DONE FOR THE BEARINGS SHALL BE PER THE AASHTO LRFD BRIDGE DESIGN SPECIFICATIONS 6TH EDITION AND ITS LATEST REVISIONS.
10. ALTERNATIVE CONFIGURATIONS FOR BEARINGS MAY BE SUBMITTED FOR APPROVAL. ANY ALTERNATE SUBMITTED SHALL BE DESIGNED AND CERTIFIED TO MEET THE DESIGN LOADS AND CRITERIA SHOWN ON THE PLANS.
11. ALL BEARINGS SHALL BE MARKED PRIOR TO SHIPPING. THE MARKS SHALL INCLUDE THE BEARING LOCATION ON THE BRIDGE, AND A DIRECTION ARROW THAT POINTS UP-STATION. ALL MARKS SHALL BE PERMANENT AND BE VISIBLE AFTER THE BEARING IS INSTALLED.
12. BRIDGE SEAT ELEVATIONS MAY BE REVISED TO ACCOMMODATE AN ALTERNATIVE CONFIGURATION.
13. ALL MATERIALS AND FABRICATION SHALL BE PER AASHTO LRFD SECTION 14.7 AND AASHTO MATERIAL SPECIFICATION M251.  
  
ELASTOMER SHALL BE NEOPRENE OR NATURAL VIRGIN RUBBER.  
  
DESIGN CRITERIA: (AASHTO METHOD "A")  
A) TEMPERATURE RANGE: 80° F  
B) 50 DUROMETER ELASTOMETER, LOW TEMPERATURE ZONE D, GRADE 4  
G = 100 PSI +/- 15%  
C) MAXIMUM BEARING STRESS: 419 PSI  
D) DESIGN ROTATION: 0.018 RAD.  
E) MAX. REACTION/BEARING:  
DEAD LOAD: 20.3 KIPS  
LIVE LOAD: 22.9 KIPS (WITH IMPACT)
14. THE CONTRACTOR IS ADVISED TO HAVE A MINIMUM OF 20 - 1/4"x10"x1'-1" GALVANIZED STEEL SHIMS AVAILABLE FOR USE FOR ELEVATION ADJUSTMENTS UPON THE SETTING OF THE SUPERSTRUCTURE UNITS. THE SHIMS SHALL BE FABRICATED ACCORDING TO SECTION 531 AND SHALL BE INCLUDED UNDER ITEM 531.17, "BEARING DEVICE ASSEMBLY, STEEL REINFORCED ELASTOMERIC PAD".

PROJECT NAME: GUILFORD  
 PROJECT NUMBER: BRO 1442(36)  
 FILE NAME: z10j064deck.dgn  
 PROJECT LEADER: S.E. BURBANK  
 DESIGNED BY: G.H. NEAL  
 BEARING DETAILS


PLOT DATE: 10/2/2013  
 DRAWN BY: J.L. LEMIEUX  
 CHECKED BY: A.F. PREZIOSO  
 SHEET 23 OF 42

PCU I ELEVATIONS


	AB1	AB2
ELEV "A"	1066.50	1065.36
ELEV "B"	1066.65	1065.20
ELEV "C"	1062.67	1061.53
ELEV "D"	1062.83	1061.38
ELEV "E"	1055.33	1054.03
DIST "F"	9 ³ / ₁₆ "	6 ⁹ / ₁₆ "
DIST "G"	9 ¹³ / ₁₆ "	11 ¹³ / ₁₆ "
ANGLE "H"	63°	70°

LEGEND


 SPECIAL PROVISION (HIGH PERFORMANCE CONCRETE, RAPID SET) (FPQ)

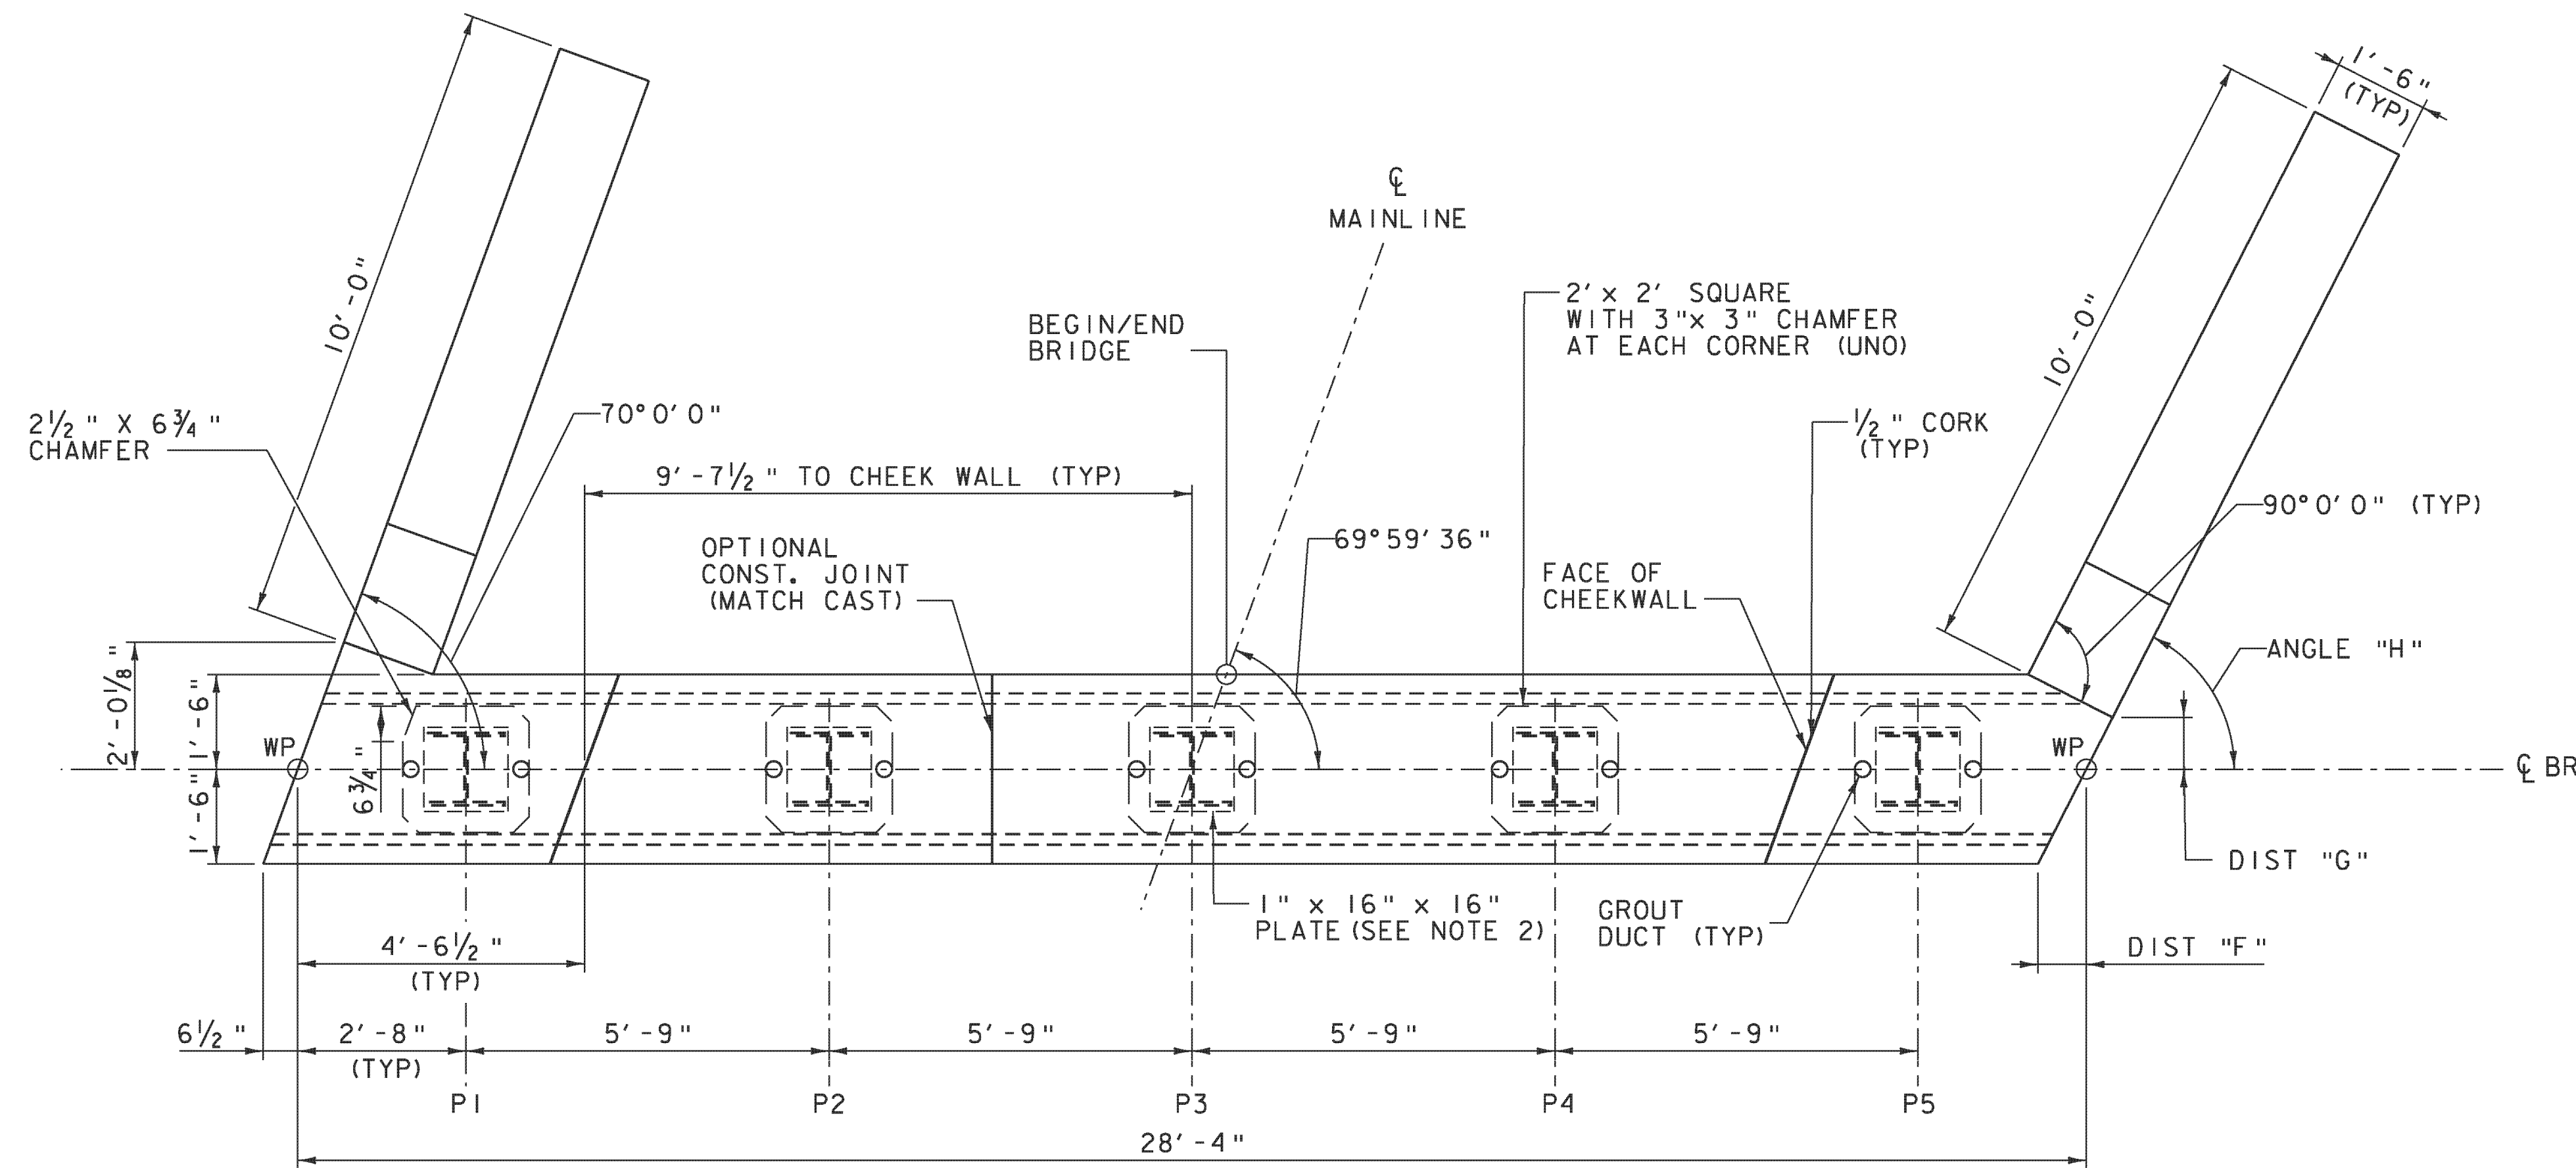

PCU I PLAN  
SCALE 1/2" = 1'-0"

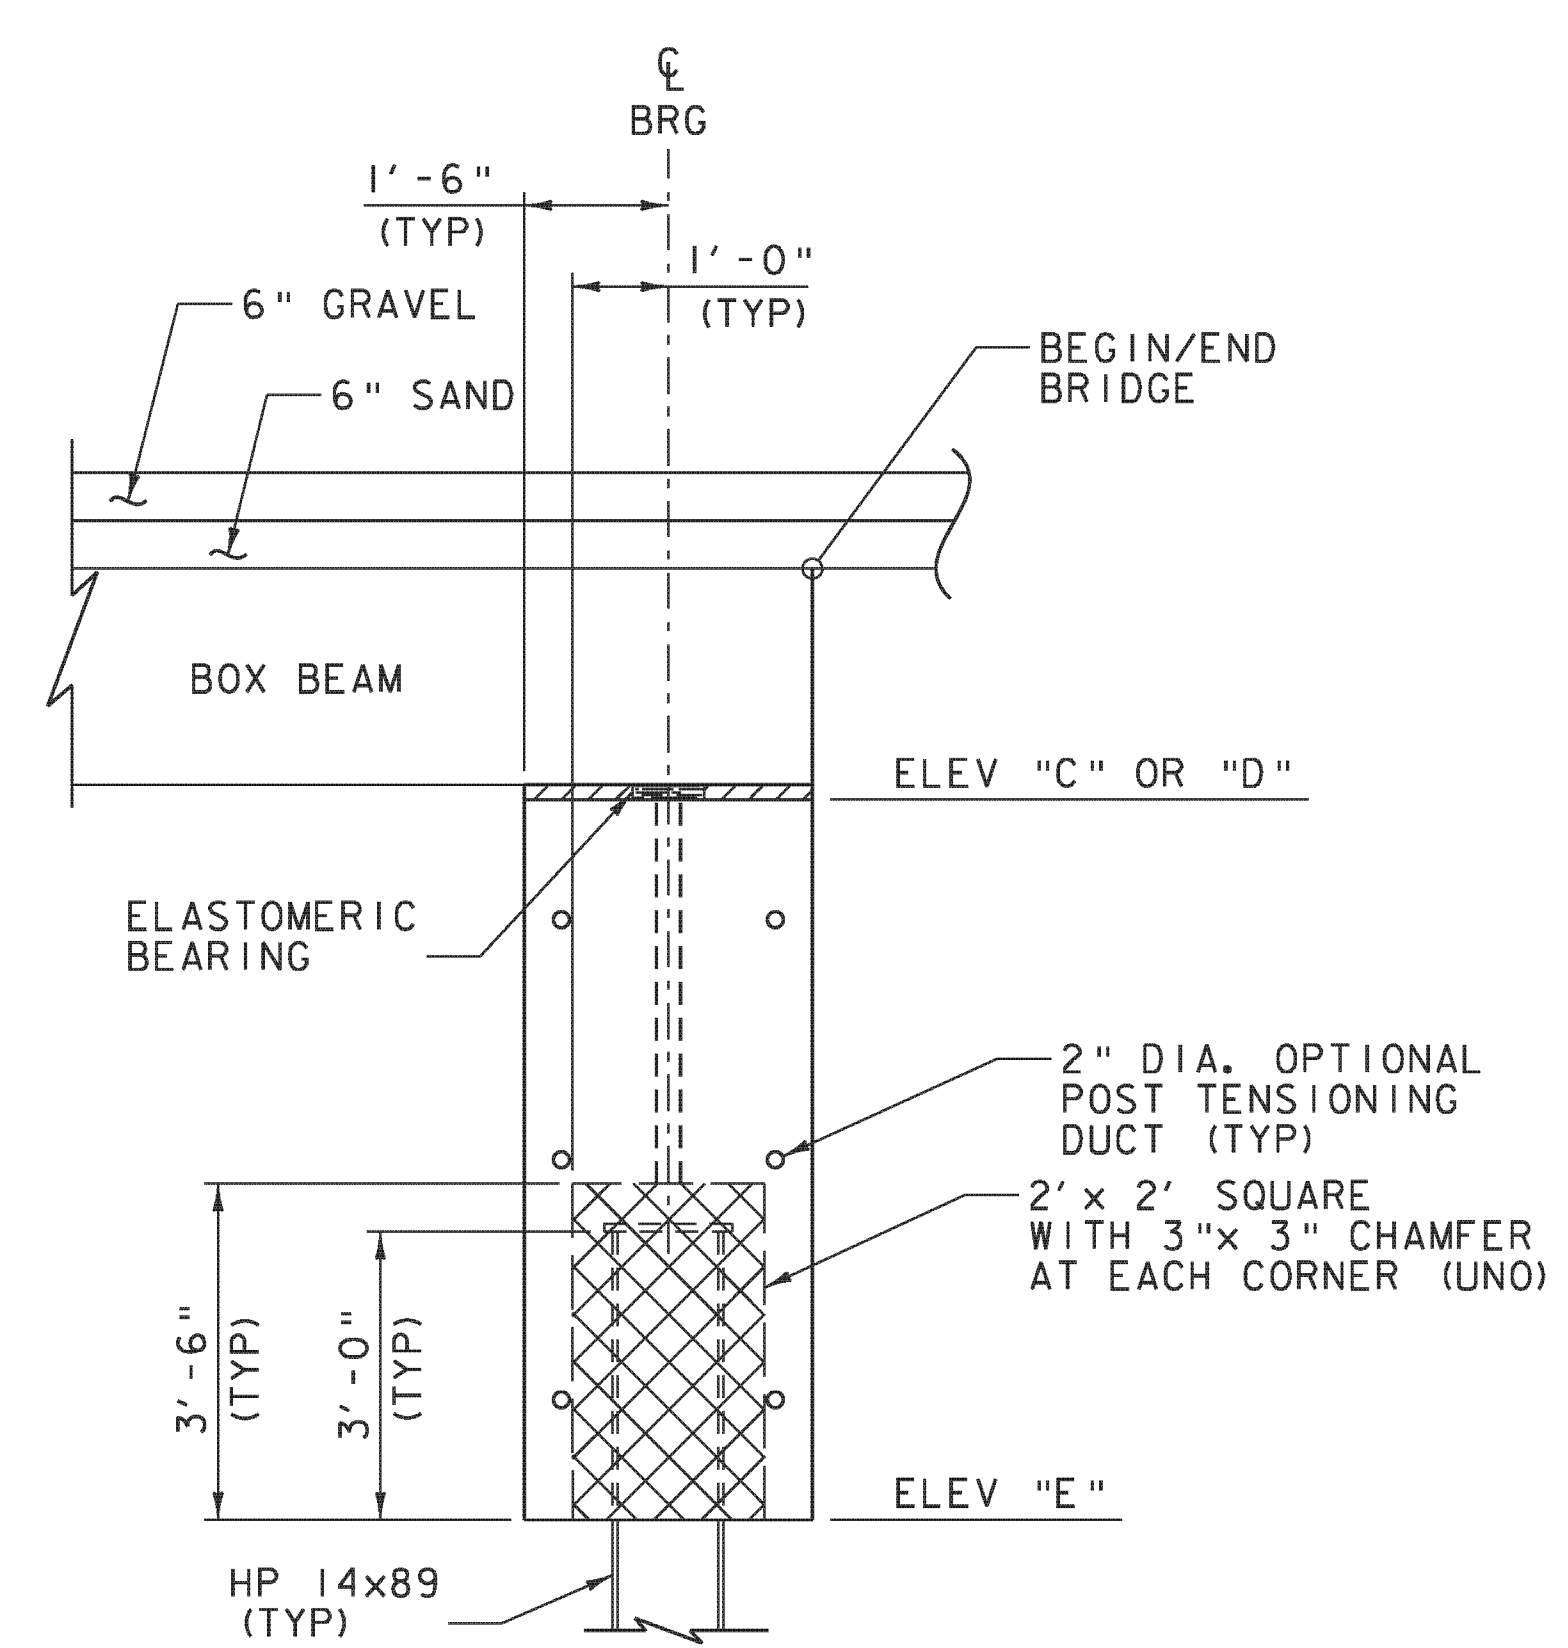


PCU I TYPICAL  
SCALE 1/2" = 1'-0"

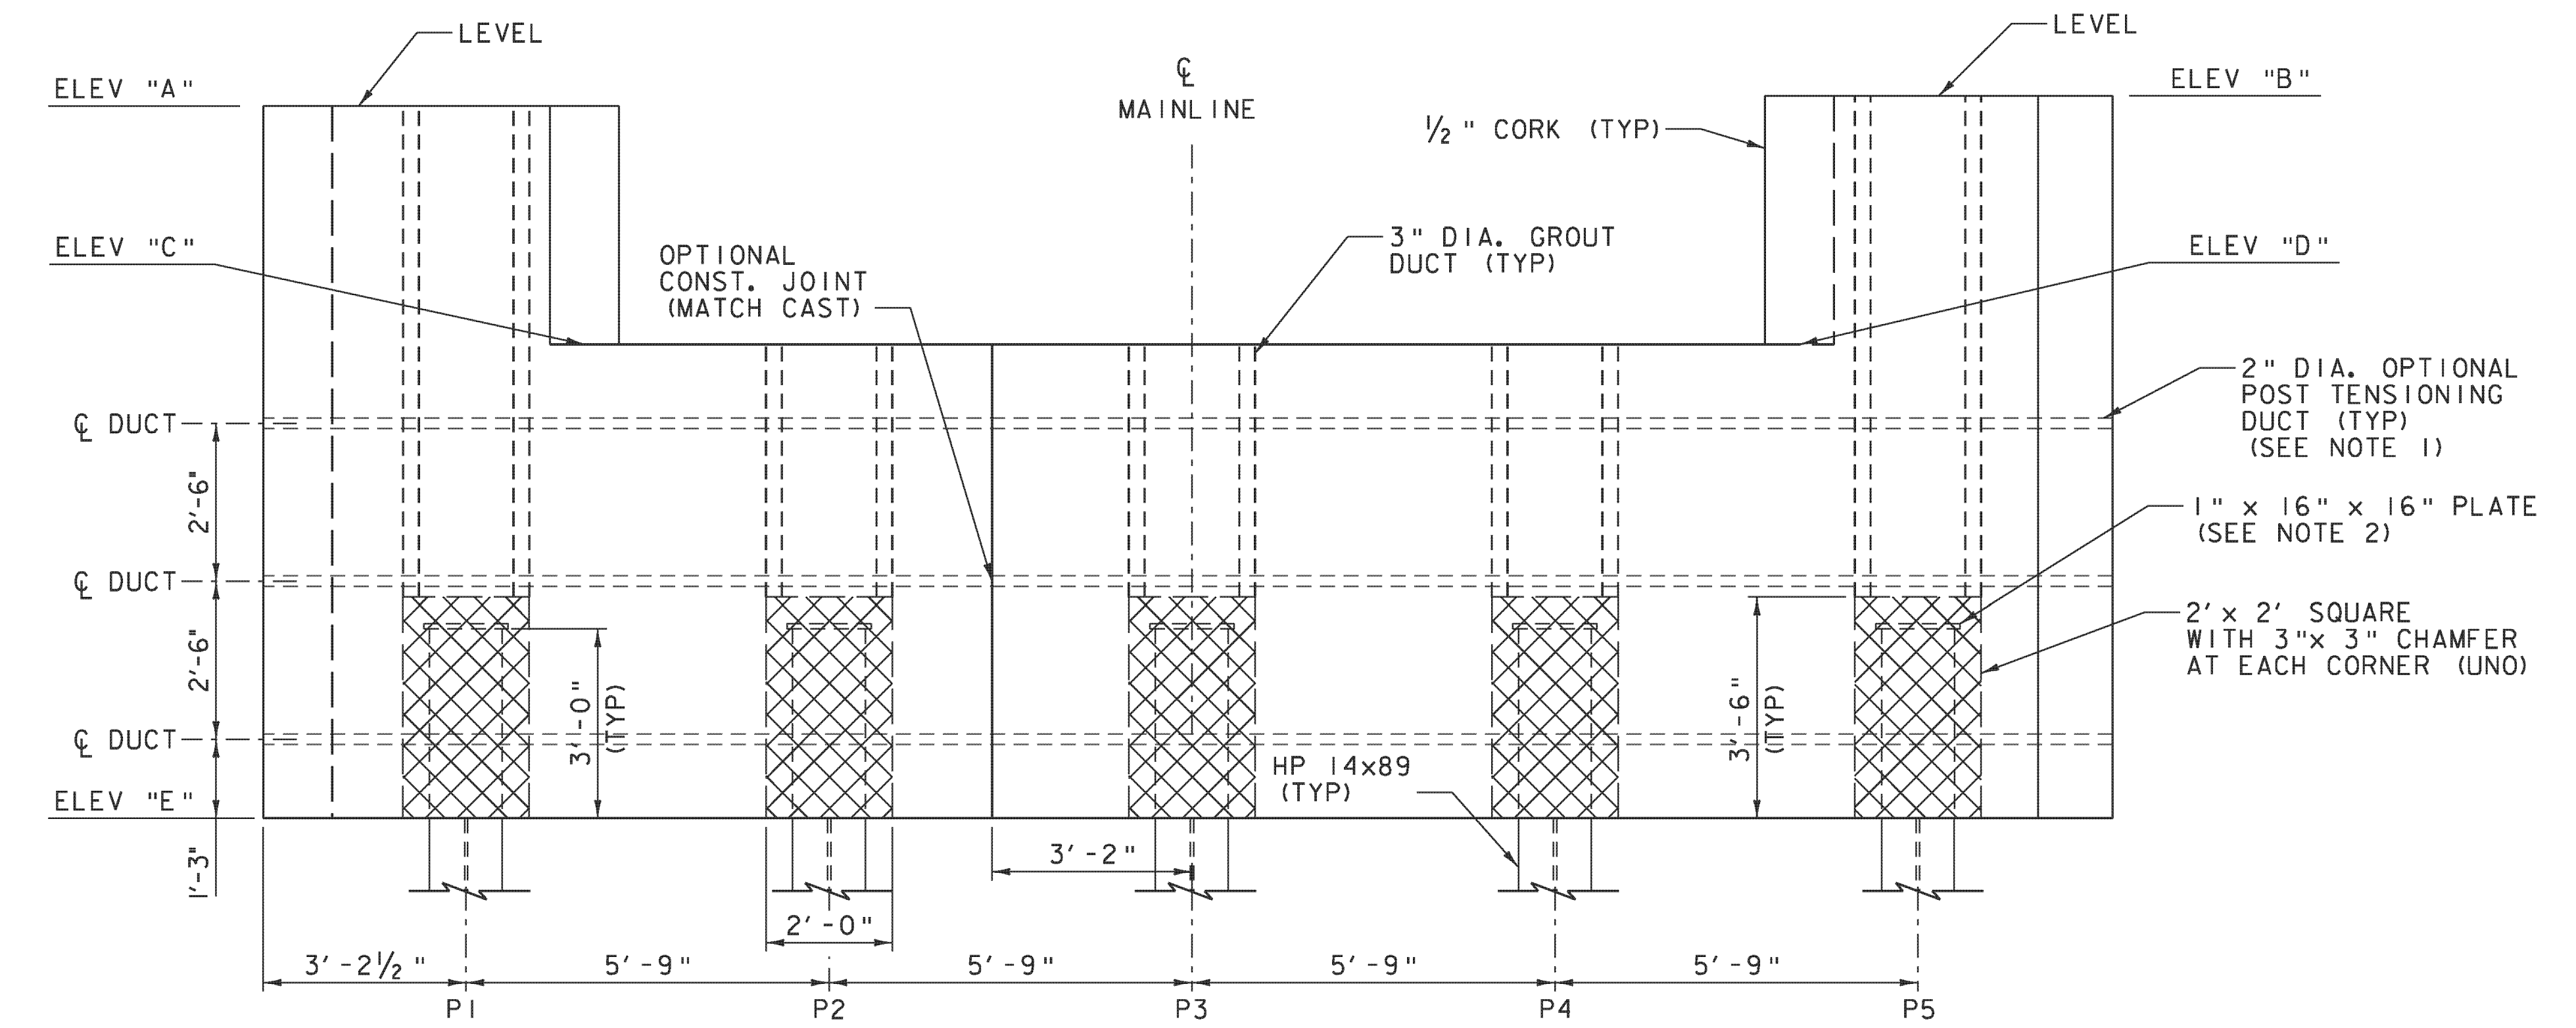


PCU I ELEVATION  
SCALE 1/2" = 1'-0"

- NOTES:
1. POST TENSIONING AND ASSOCIATED ITEMS ONLY REQUIRED IF PILE CAP IS CONSTRUCTED OF MORE THAN ONE UNIT.
  2. ONCE PILES HAVE BEEN CUT TO THEIR FINAL ELEVATIONS, 1" X 16" X 16" STEEL PLATES SHALL BE WELDED TO THE TOP OF THE PILES. PAYMENT FOR THE PLATES SHALL BE INCIDENTAL TO ITEM 505.18, "STEEL PILING, HP 14X89".


PROJECT NAME:	GUILFORD
PROJECT NUMBER:	BRO 1442(36)
FILE NAME:	z10j064sub.dgn
PROJECT LEADER:	S.E. BURBANK
DESIGNED BY:	G.H. NEAL
ABUTMENT PLAN & ELEVATION	
PLOT DATE:	10/2/2013
DRAWN BY:	A.J. GOUDREAU
CHECKED BY:	J.T. KLEIN
SHEET	24 OF 42

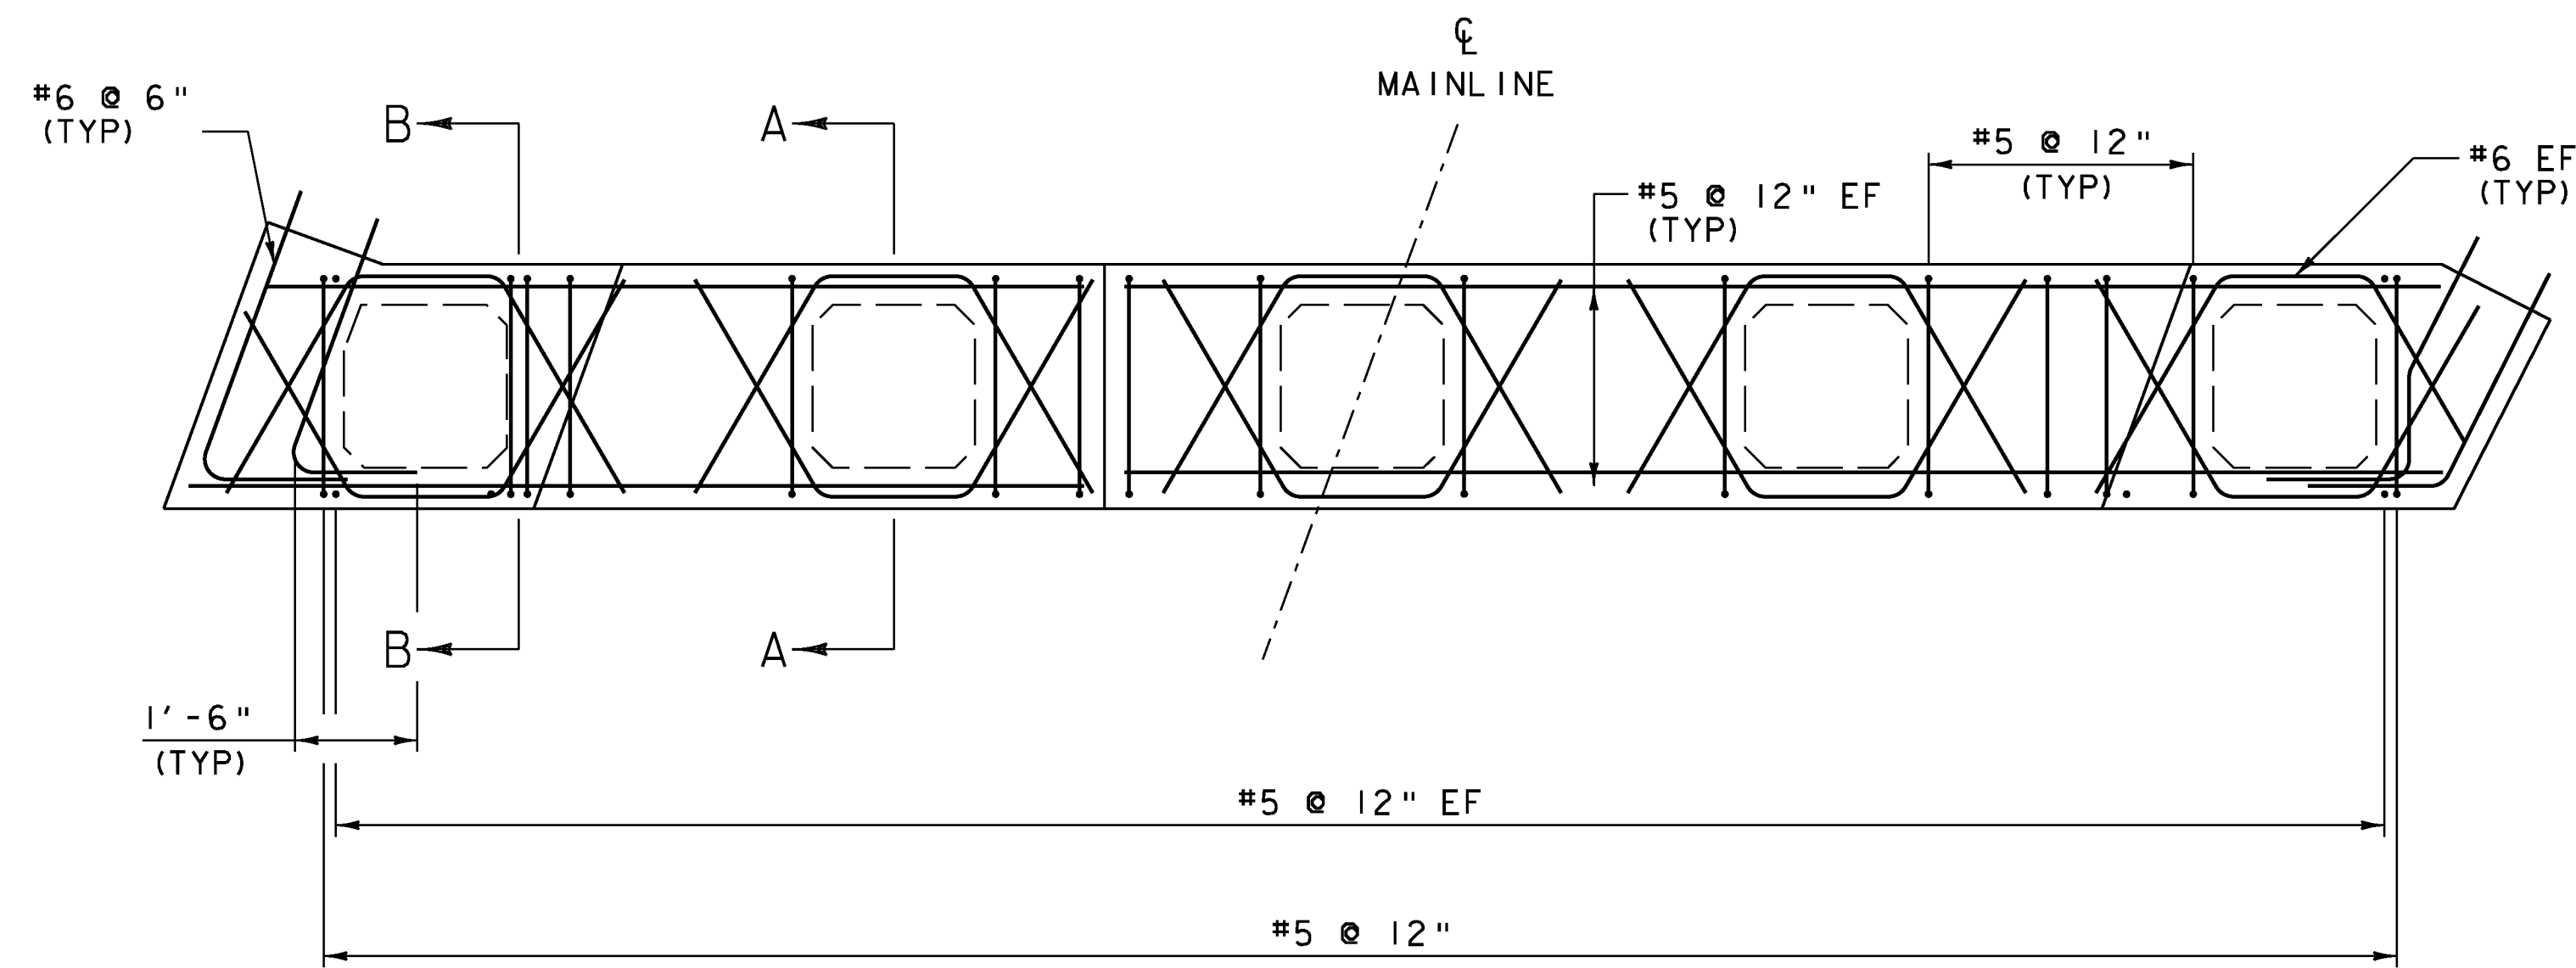



PCU I REINFORCING PLAN  
SCALE 1/2" = 1'-0"

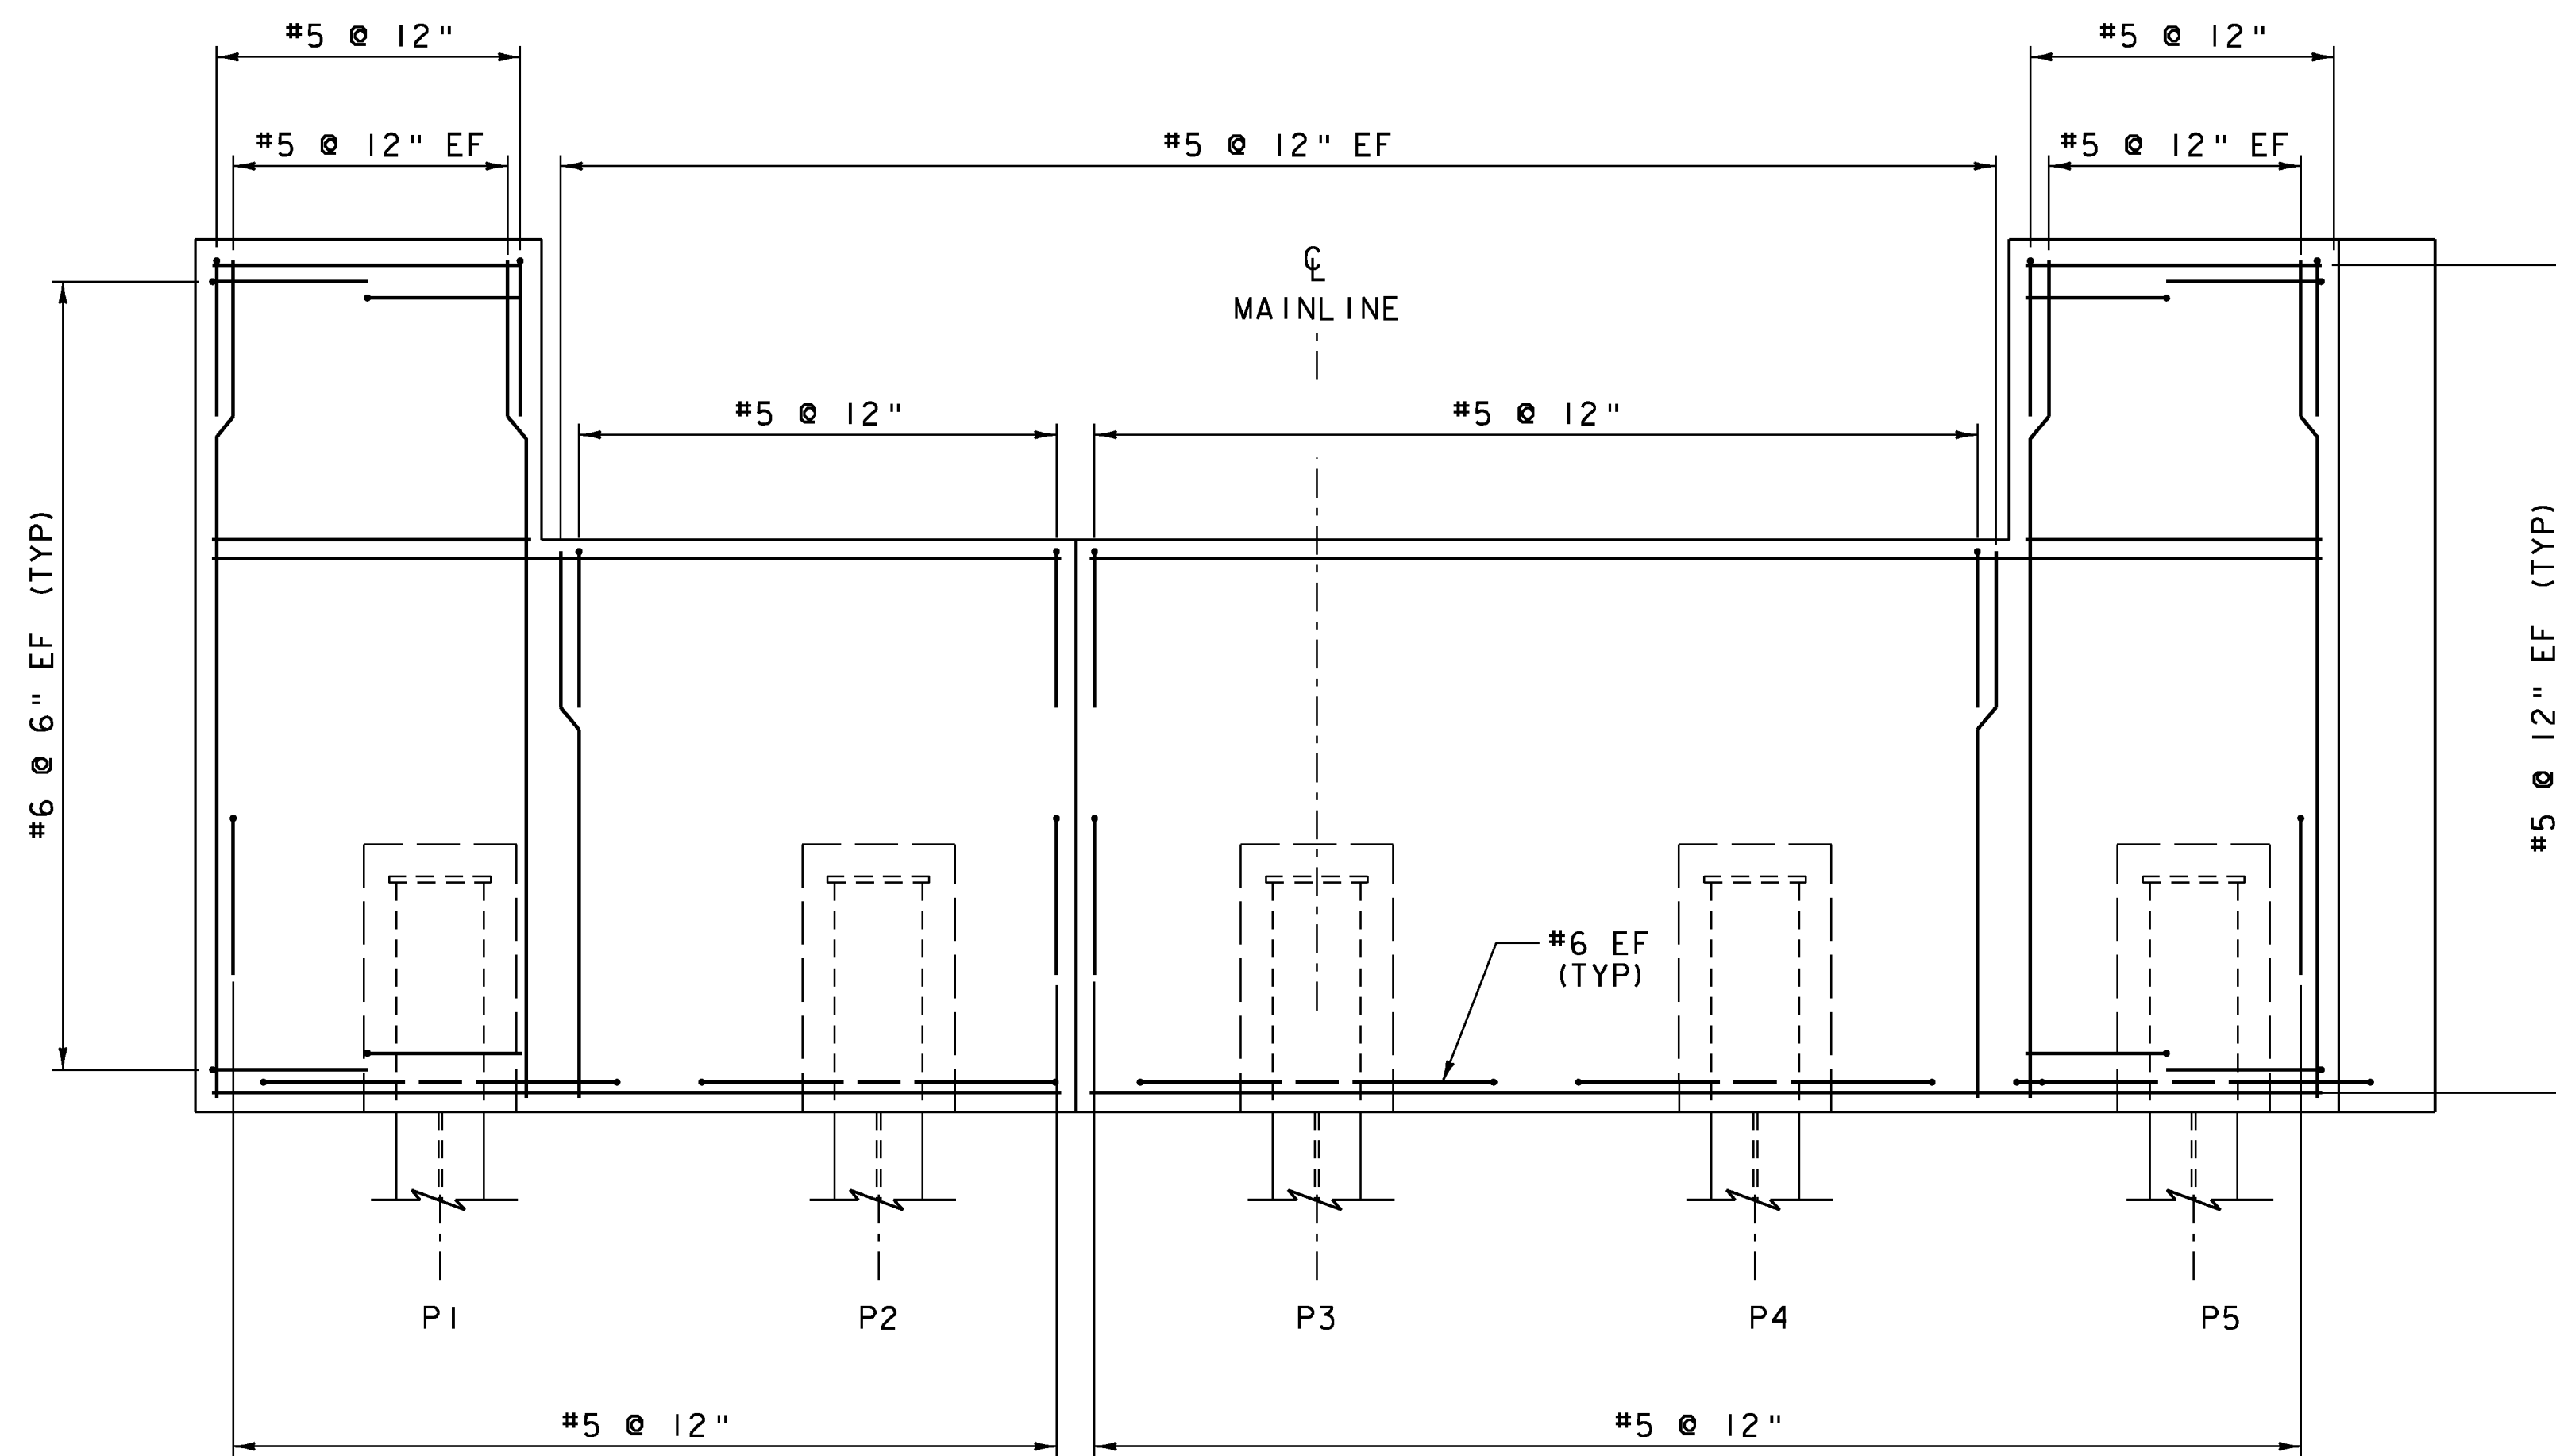

PCU I REINFORCING ELEVATION  
SCALE 1/2" = 1'-0"

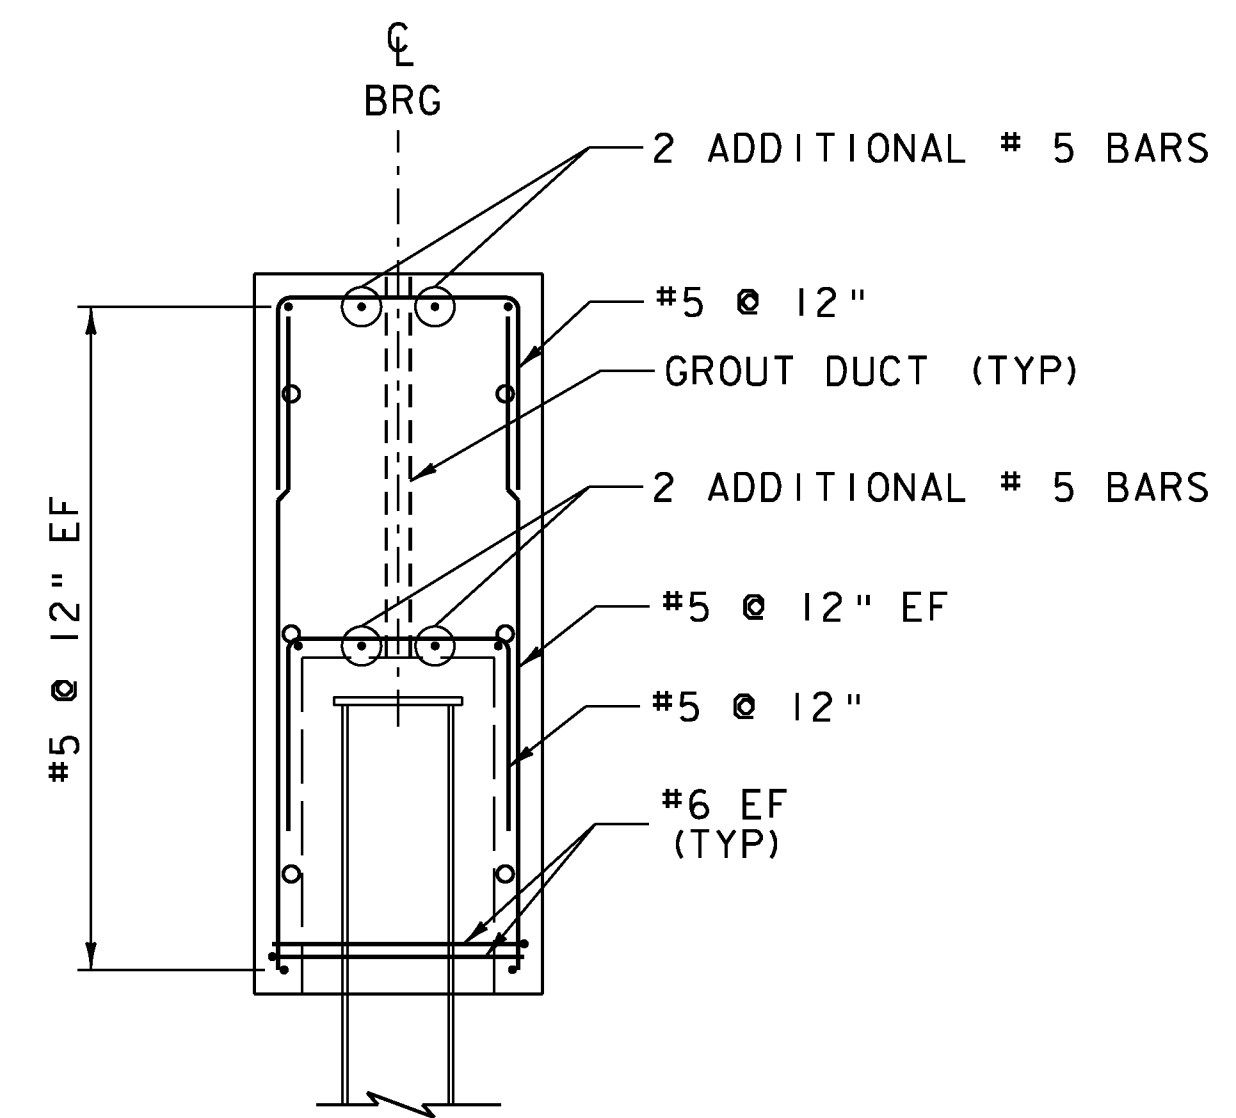

SECTION A-A  
SCALE 1/2" = 1'-0"

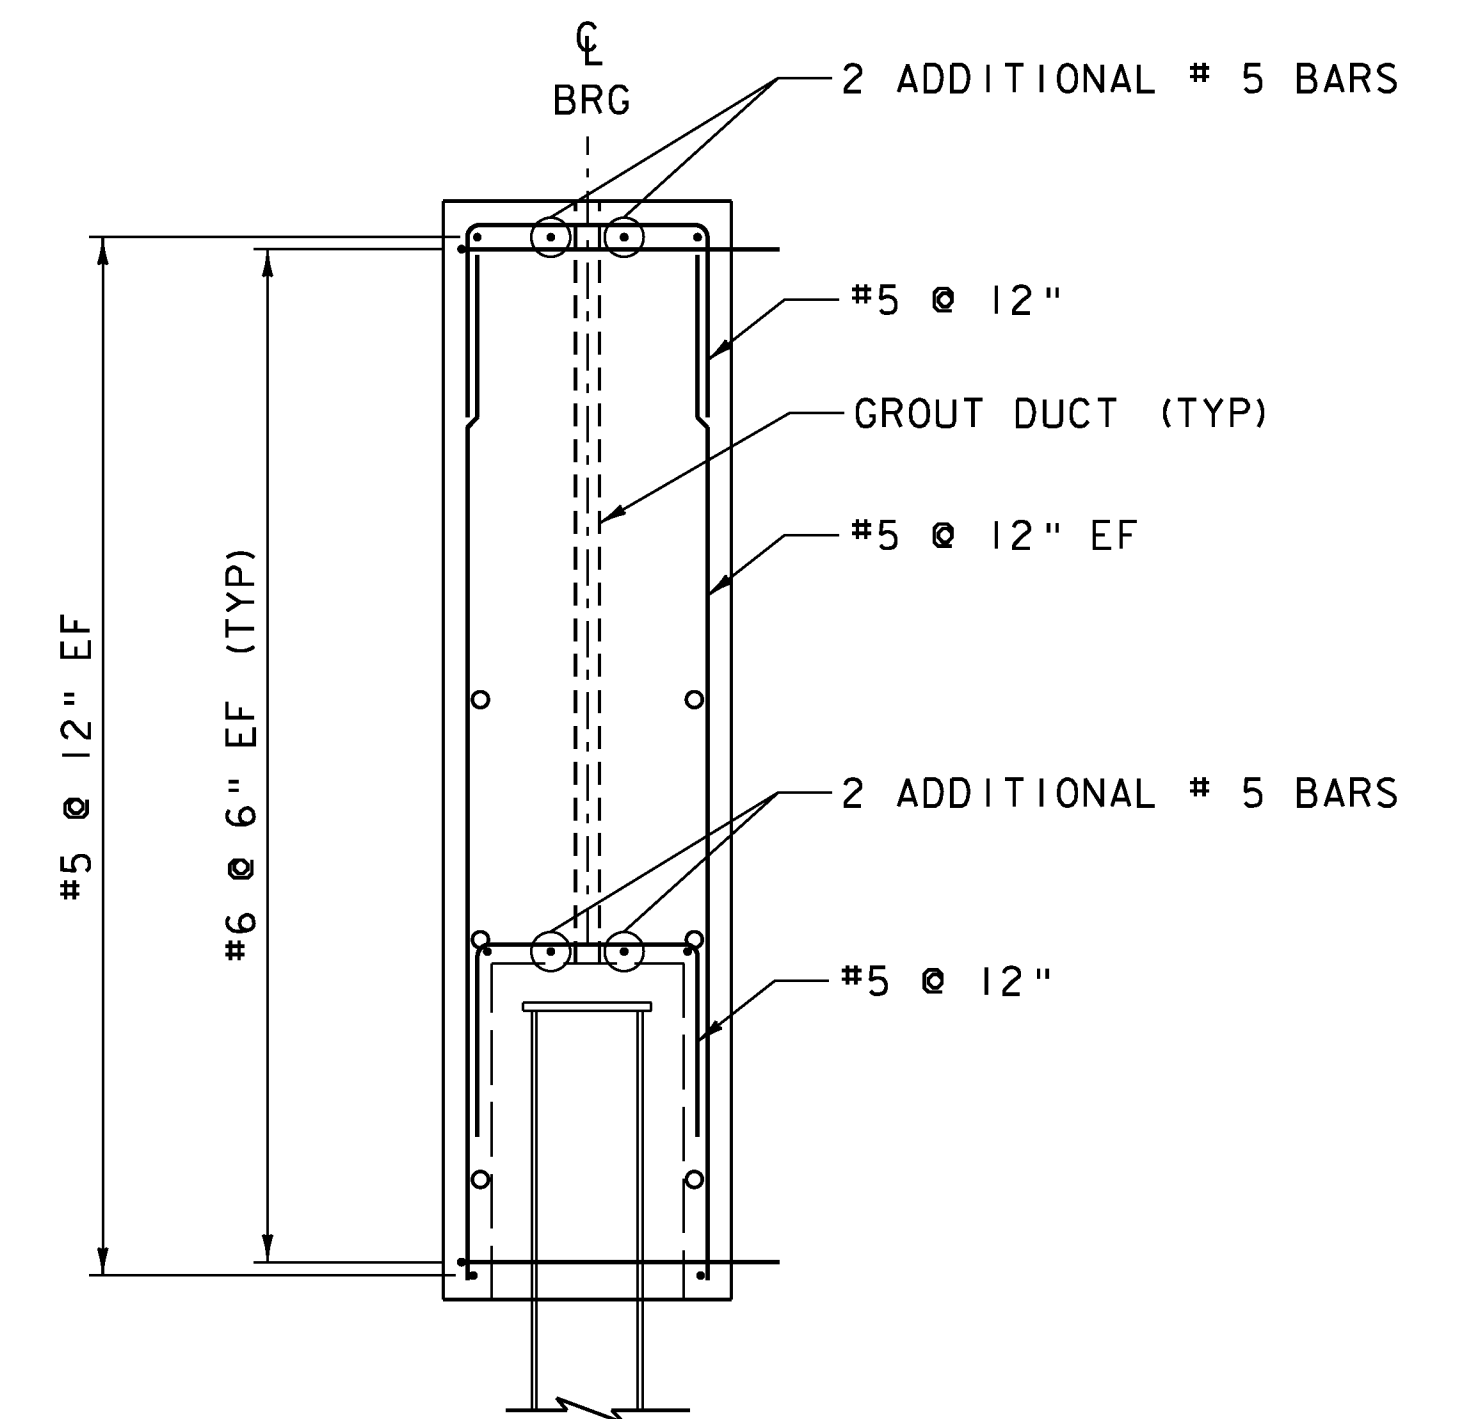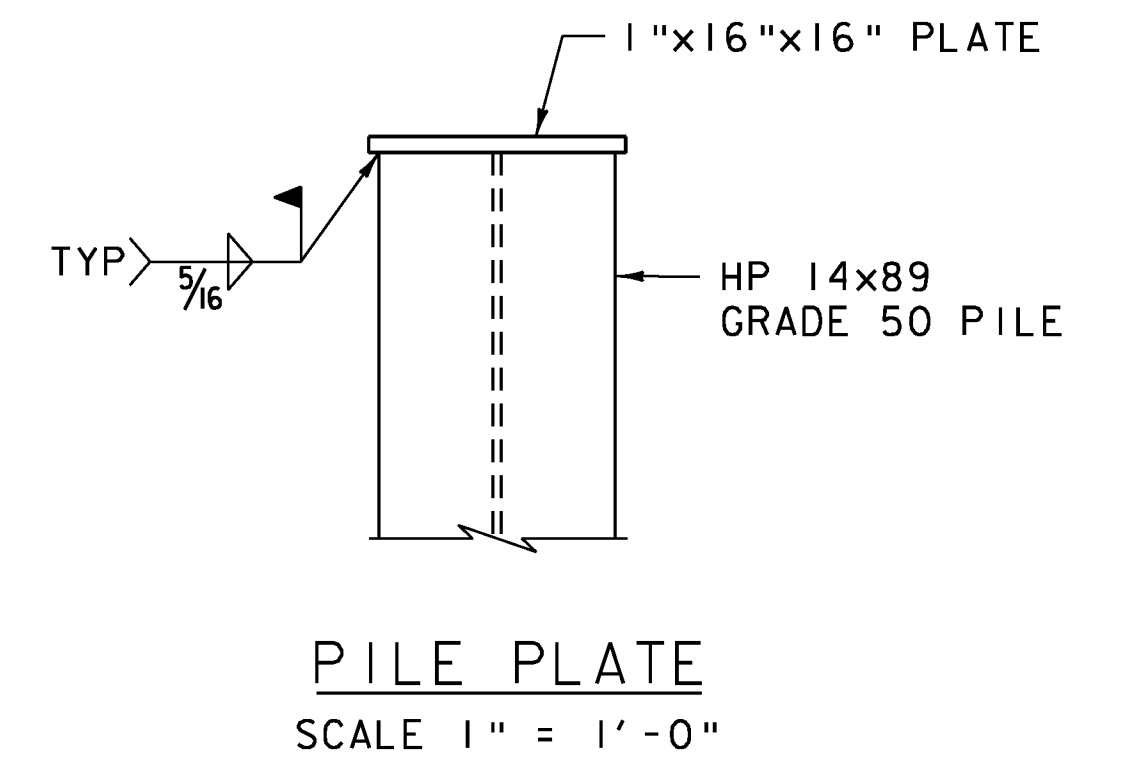

SECTION B-B  
SCALE 1/2" = 1'-0"

**NOTE:**


- NF = NEAR FACE
- FF = FAR FACE
- EF = EACH FACE
- ▲ = CUT TO FIT IN FIELD
- 3" CLEAR, UNLESS OTHERWISE SPECIFIED ON THE PLANS.
- 2'-2" BAR LAP UNLESS OTHERWISE SPECIFIED ON THE PLANS.

PROJECT NAME: GUILFORD  
PROJECT NUMBER: BRO 1442(36)


FILE NAME: z10j064sub.dgn  
PROJECT LEADER: S.E. BURBANK  
DESIGNED BY: G.H. NEAL  
ABUTMENT REINFORCING

PLOT DATE: 10/2/2013  
DRAWN BY: A.J. GOUDREAU  
CHECKED BY: J.T. KLEIN  
SHEET 25 OF 42



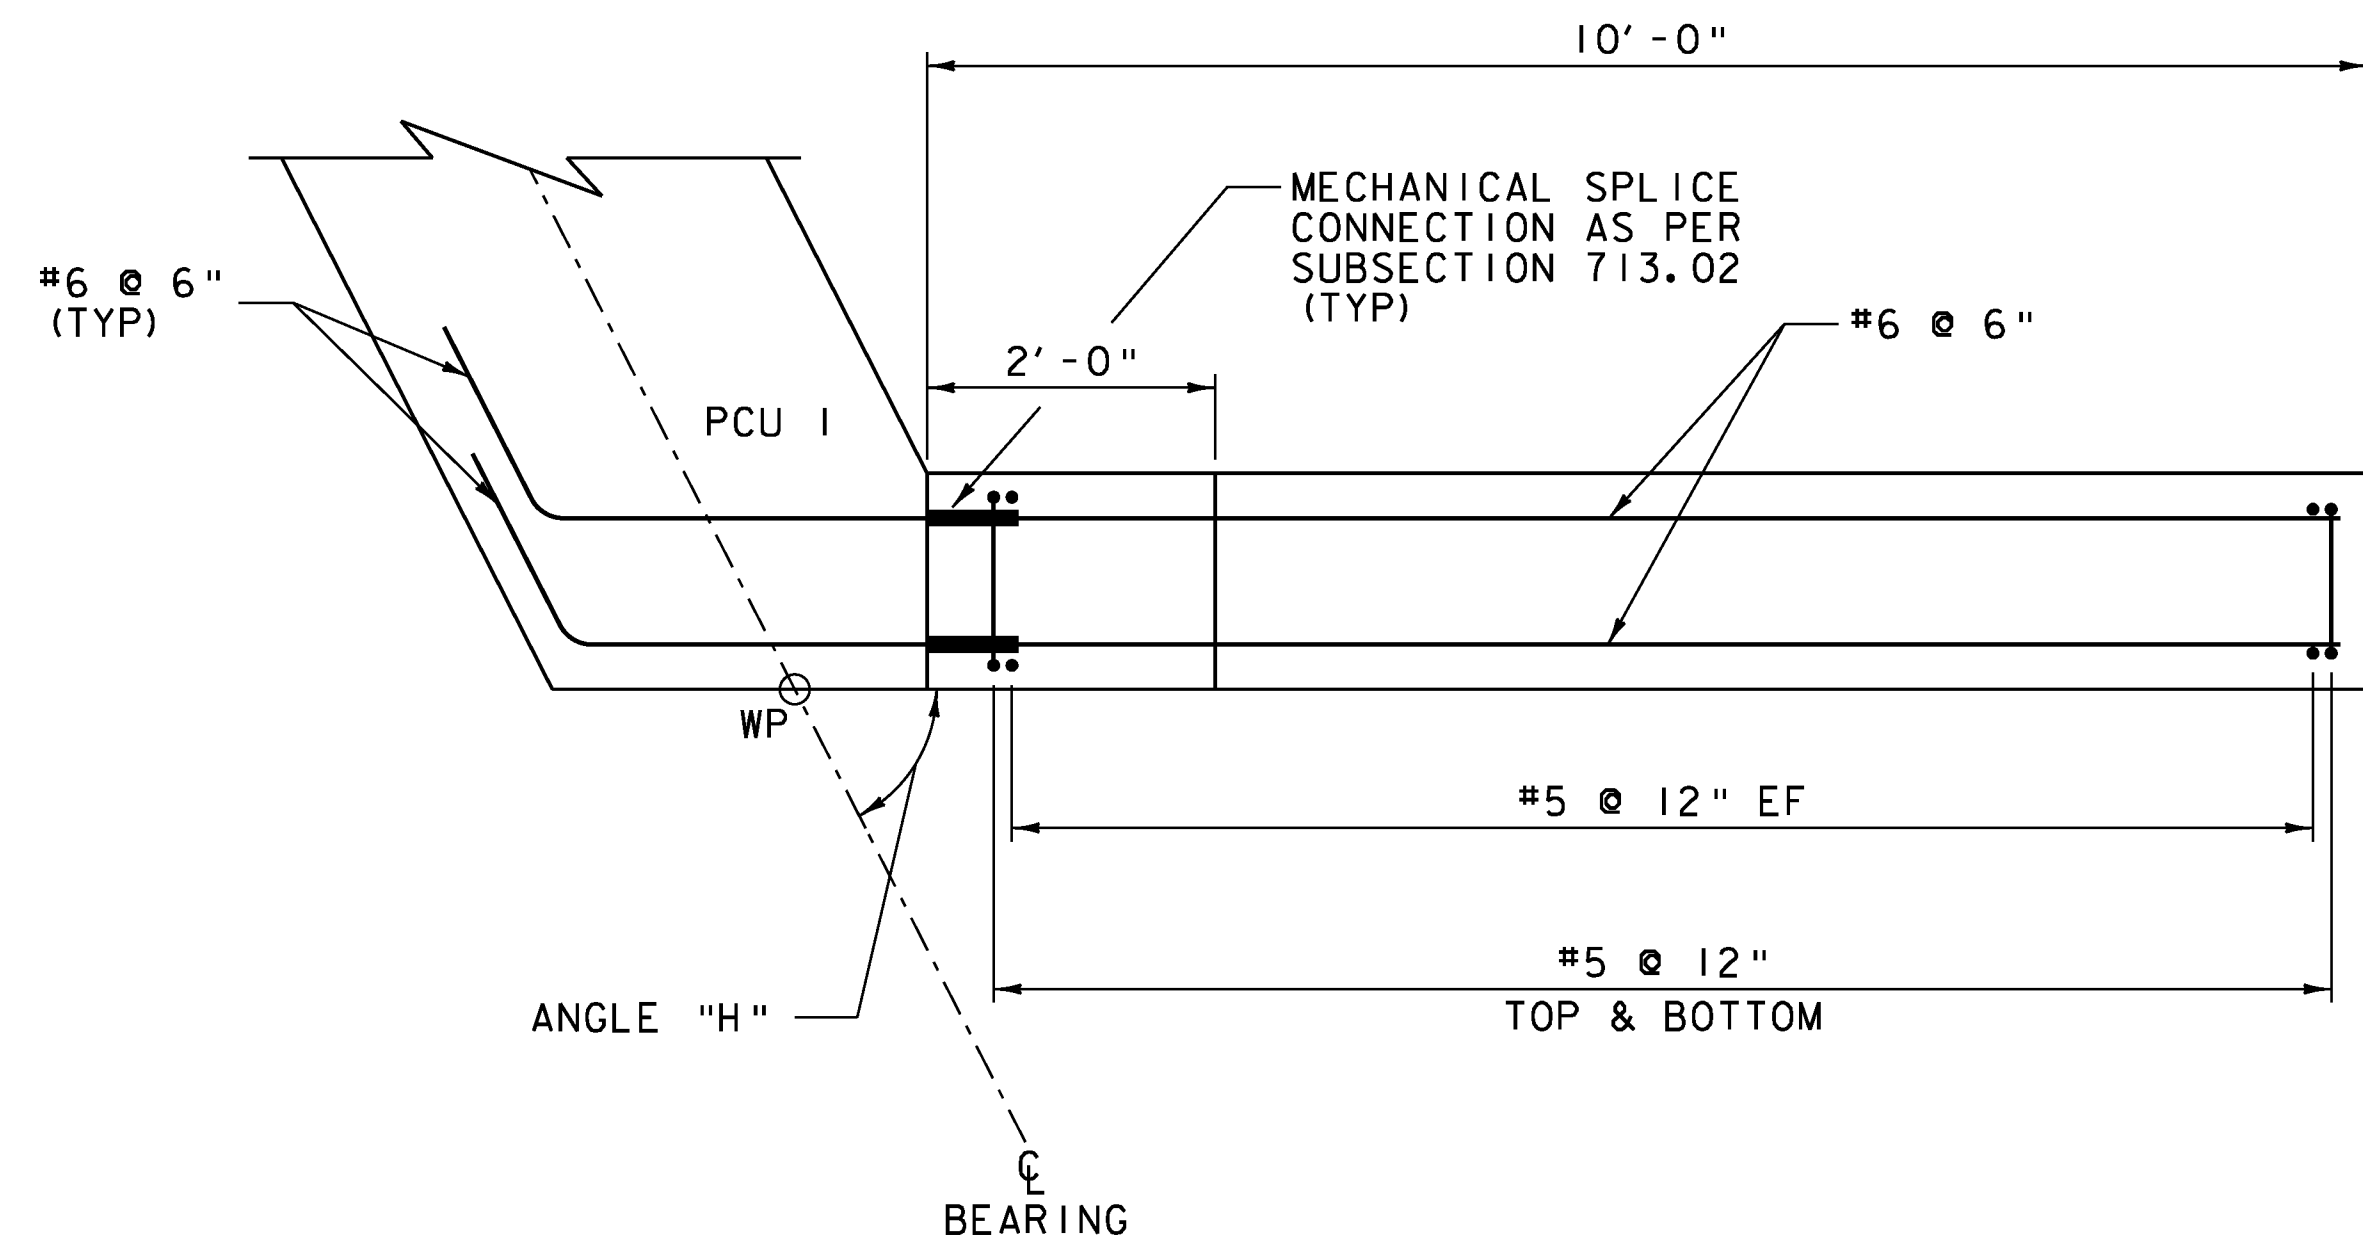


PCU 2 PLAN  
SCALE 3/4" = 1'-0"

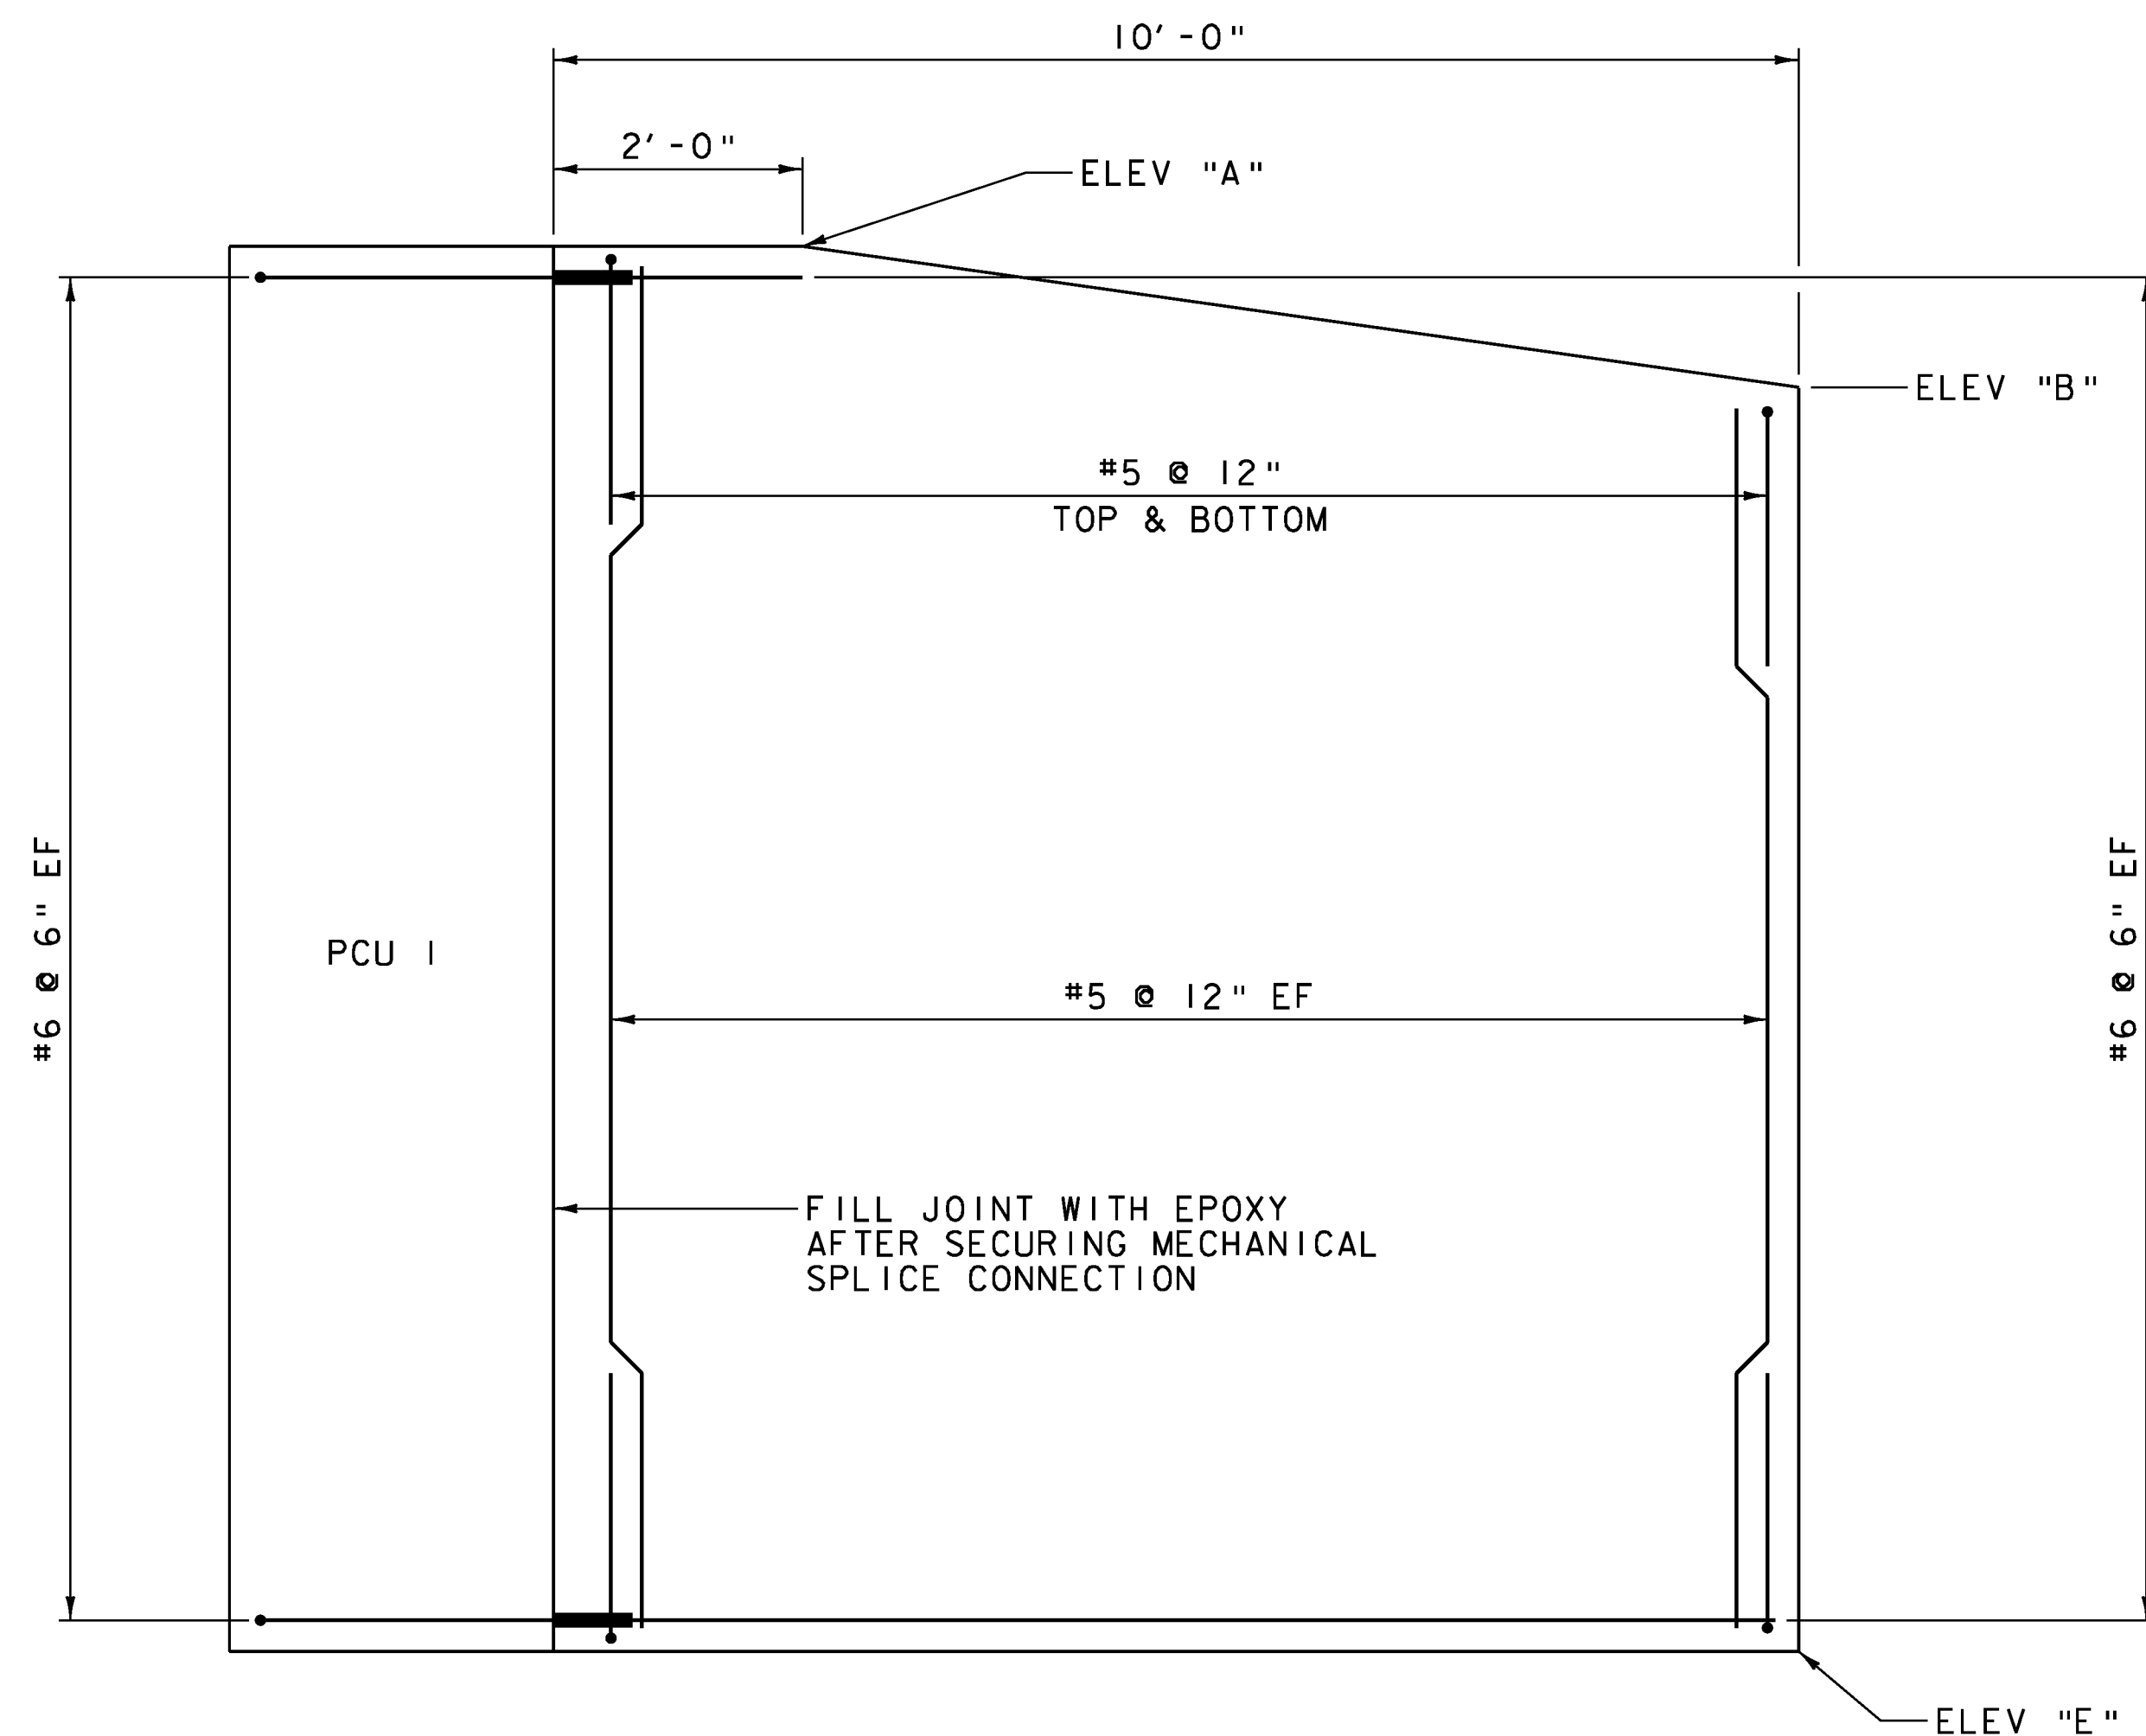

PCU 2 ELEVATION  
SCALE 3/4" = 1'-0"

PCU 2 ELEVATIONS

	WW1 (NW)	WW2 (SW)	WW3 (NE)	WW4 (SE)
ELEV "A"	1066.65	1066.50	1065.36	1065.20
ELEV "B"	1065.67	1065.40	1063.78	1063.56
ELEV "E"	1055.33	1055.33	1054.03	1054.03
ANGLE "H"	63°	110°	110°	70°

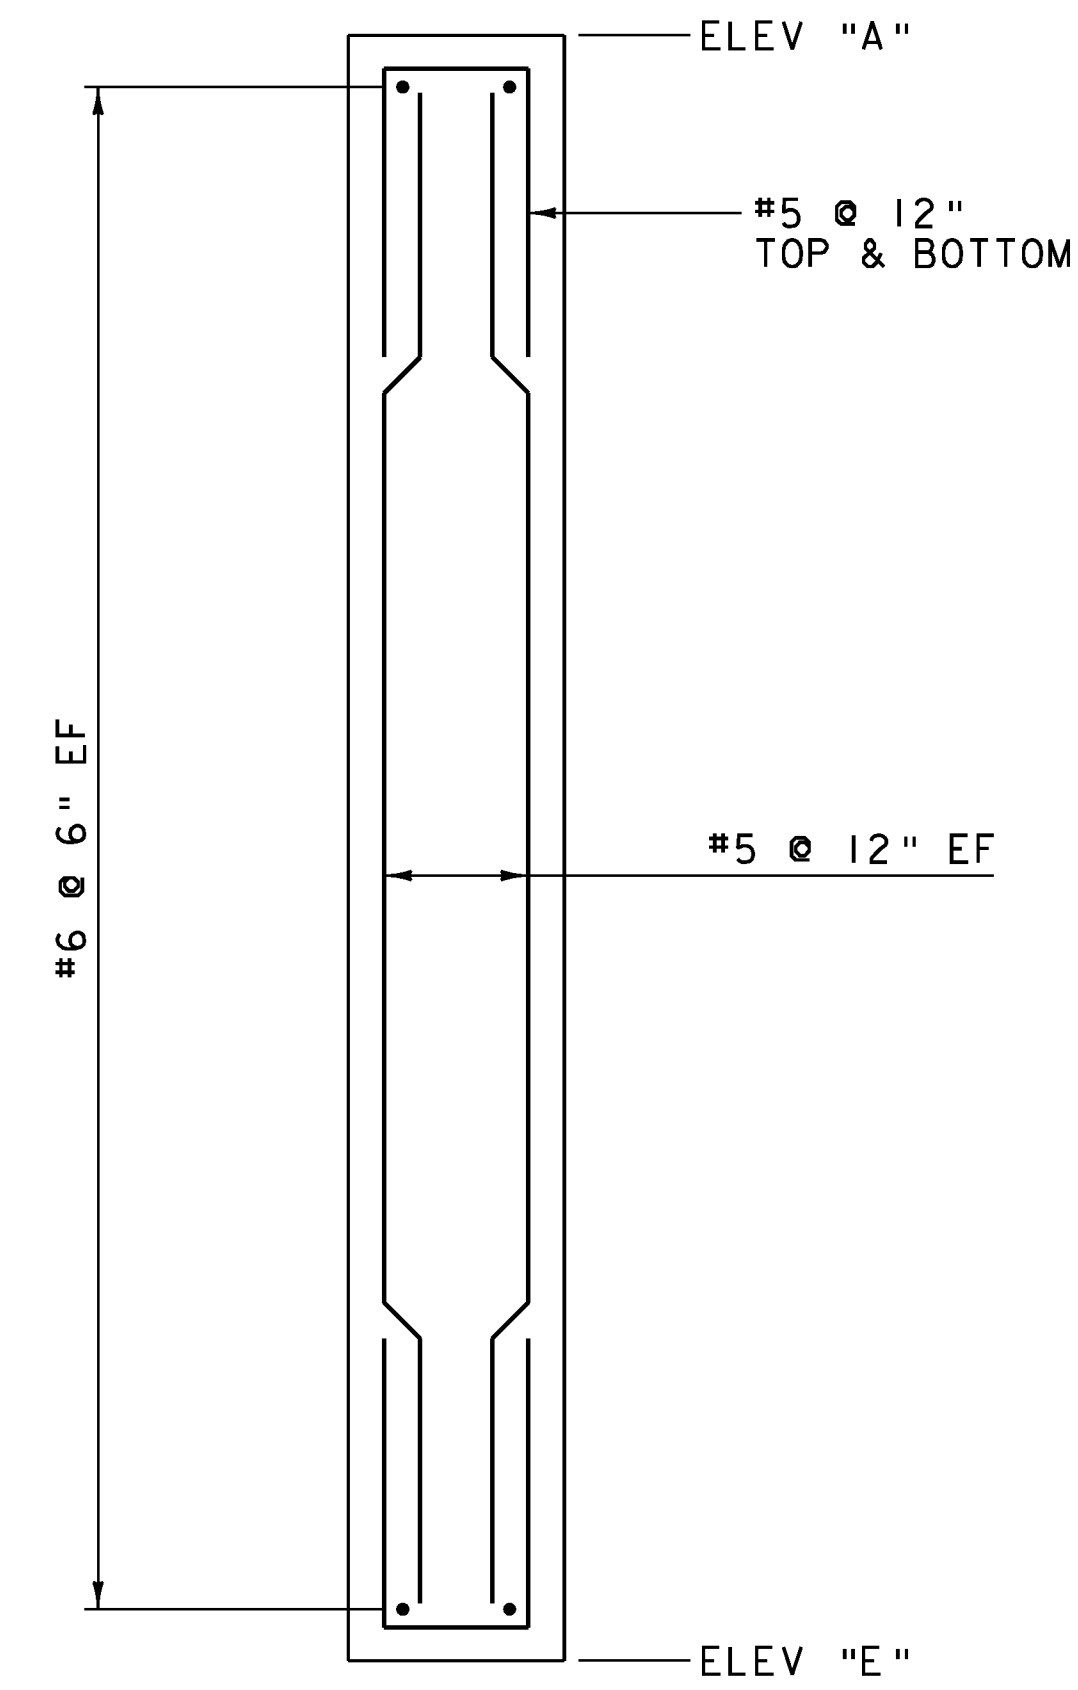

PCU 2 TYPICAL  
SCALE 3/4" = 1'-0"


**NOTE:**  
 NF = NEAR FACE  
 FF = FAR FACE  
 EF = EACH FACE  
 ▲ = CUT TO FIT IN FIELD  
 3" CLEAR, UNLESS OTHERWISE SPECIFIED ON THE PLANS.  
 2'-2" BAR LAP UNLESS OTHERWISE SPECIFIED ON THE PLANS.

PROJECT NAME: GUILFORD	PLOT DATE: 10/2/2013
PROJECT NUMBER: BRO 1442(36)	DRAWN BY: A.J. GOUDREAU
FILE NAME: z10j064sub.dgn	DESIGNED BY: G.H. NEAL
PROJECT LEADER: S.E. BURBANK	CHECKED BY: J.T. KLEIN
WINGWALL DETAILS	SHEET 26 OF 42




**NOTE:**

1. THE WALL SHALL BE PAID FOR UNDER ITEM 900.670 "SPECIAL PROVISION (RETAINING WALL)". SEE THE SPECIAL PROVISIONS FOR INFORMATION AND REQUIREMENTS.

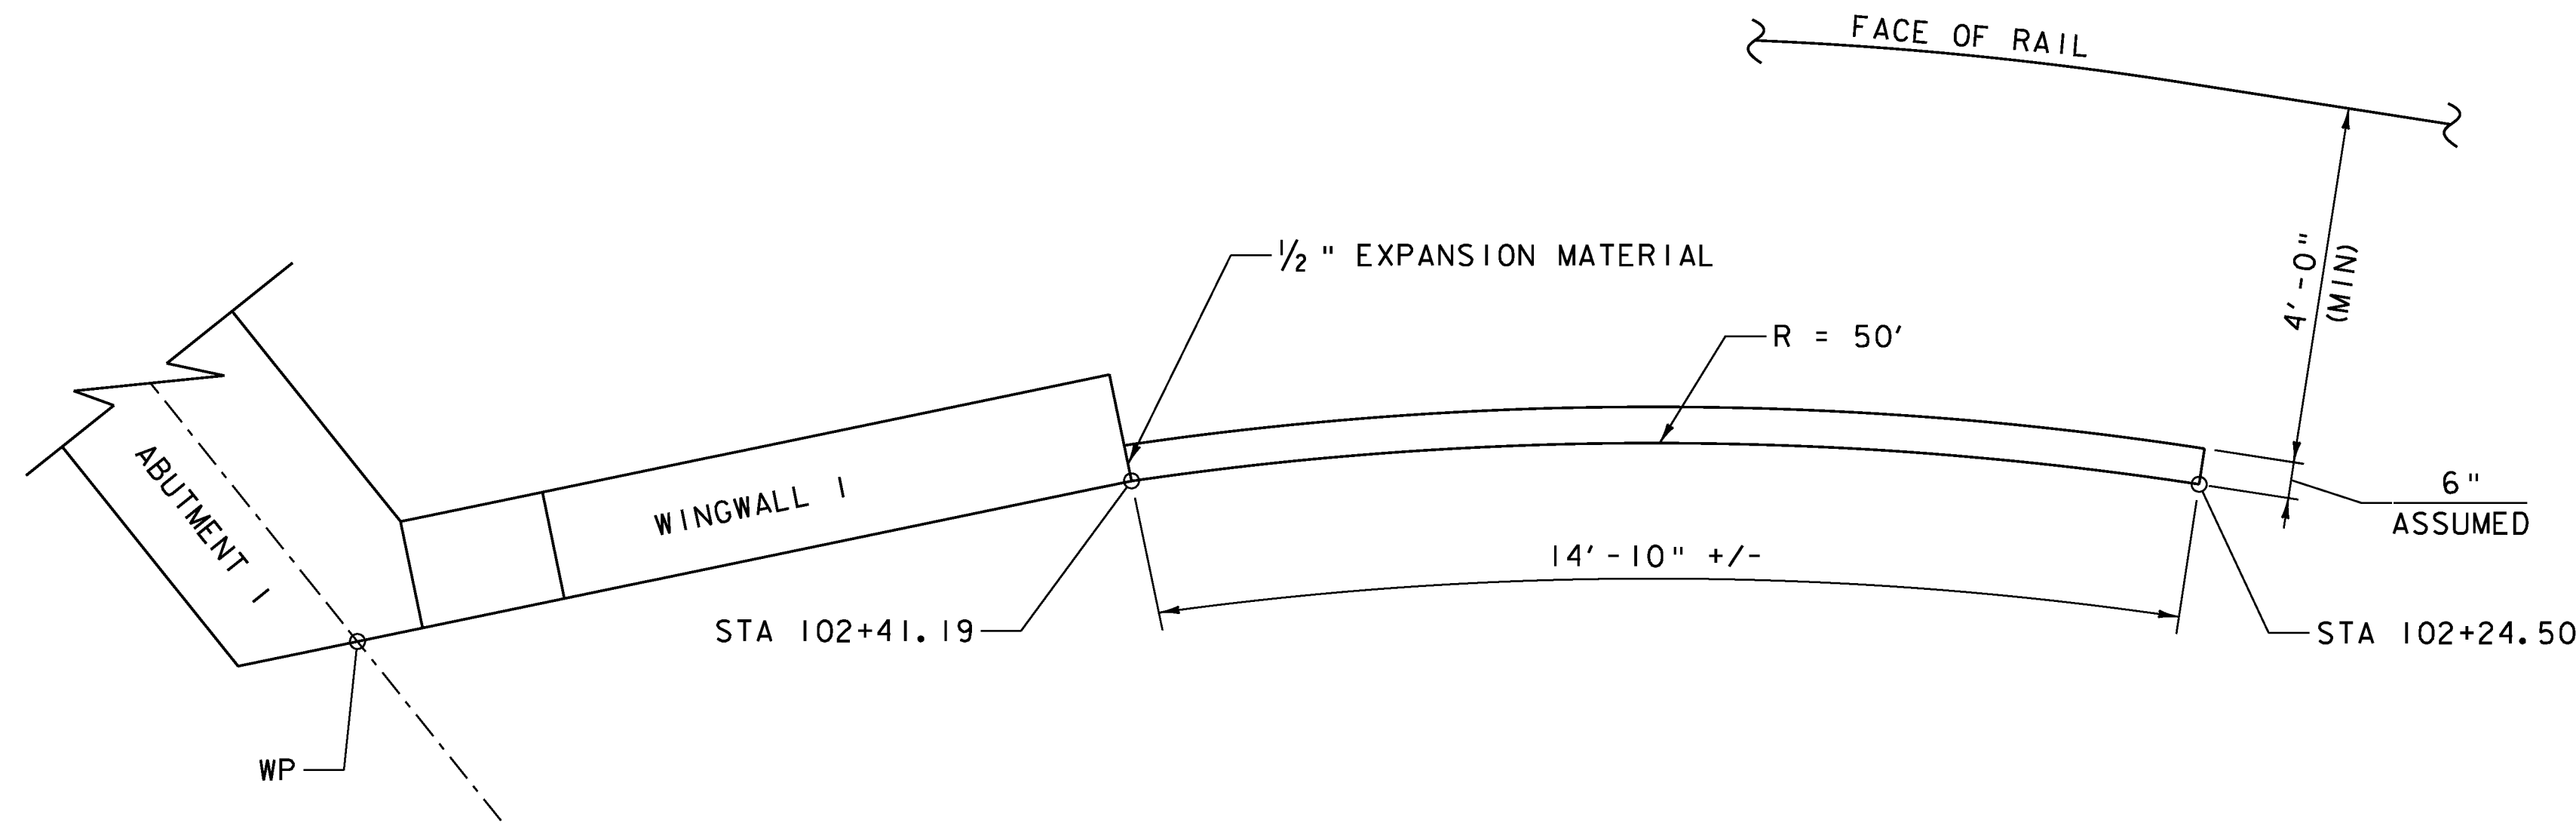

**RETAINING WALL PLAN VIEW**


SCALE 1/2" = 1'-0"

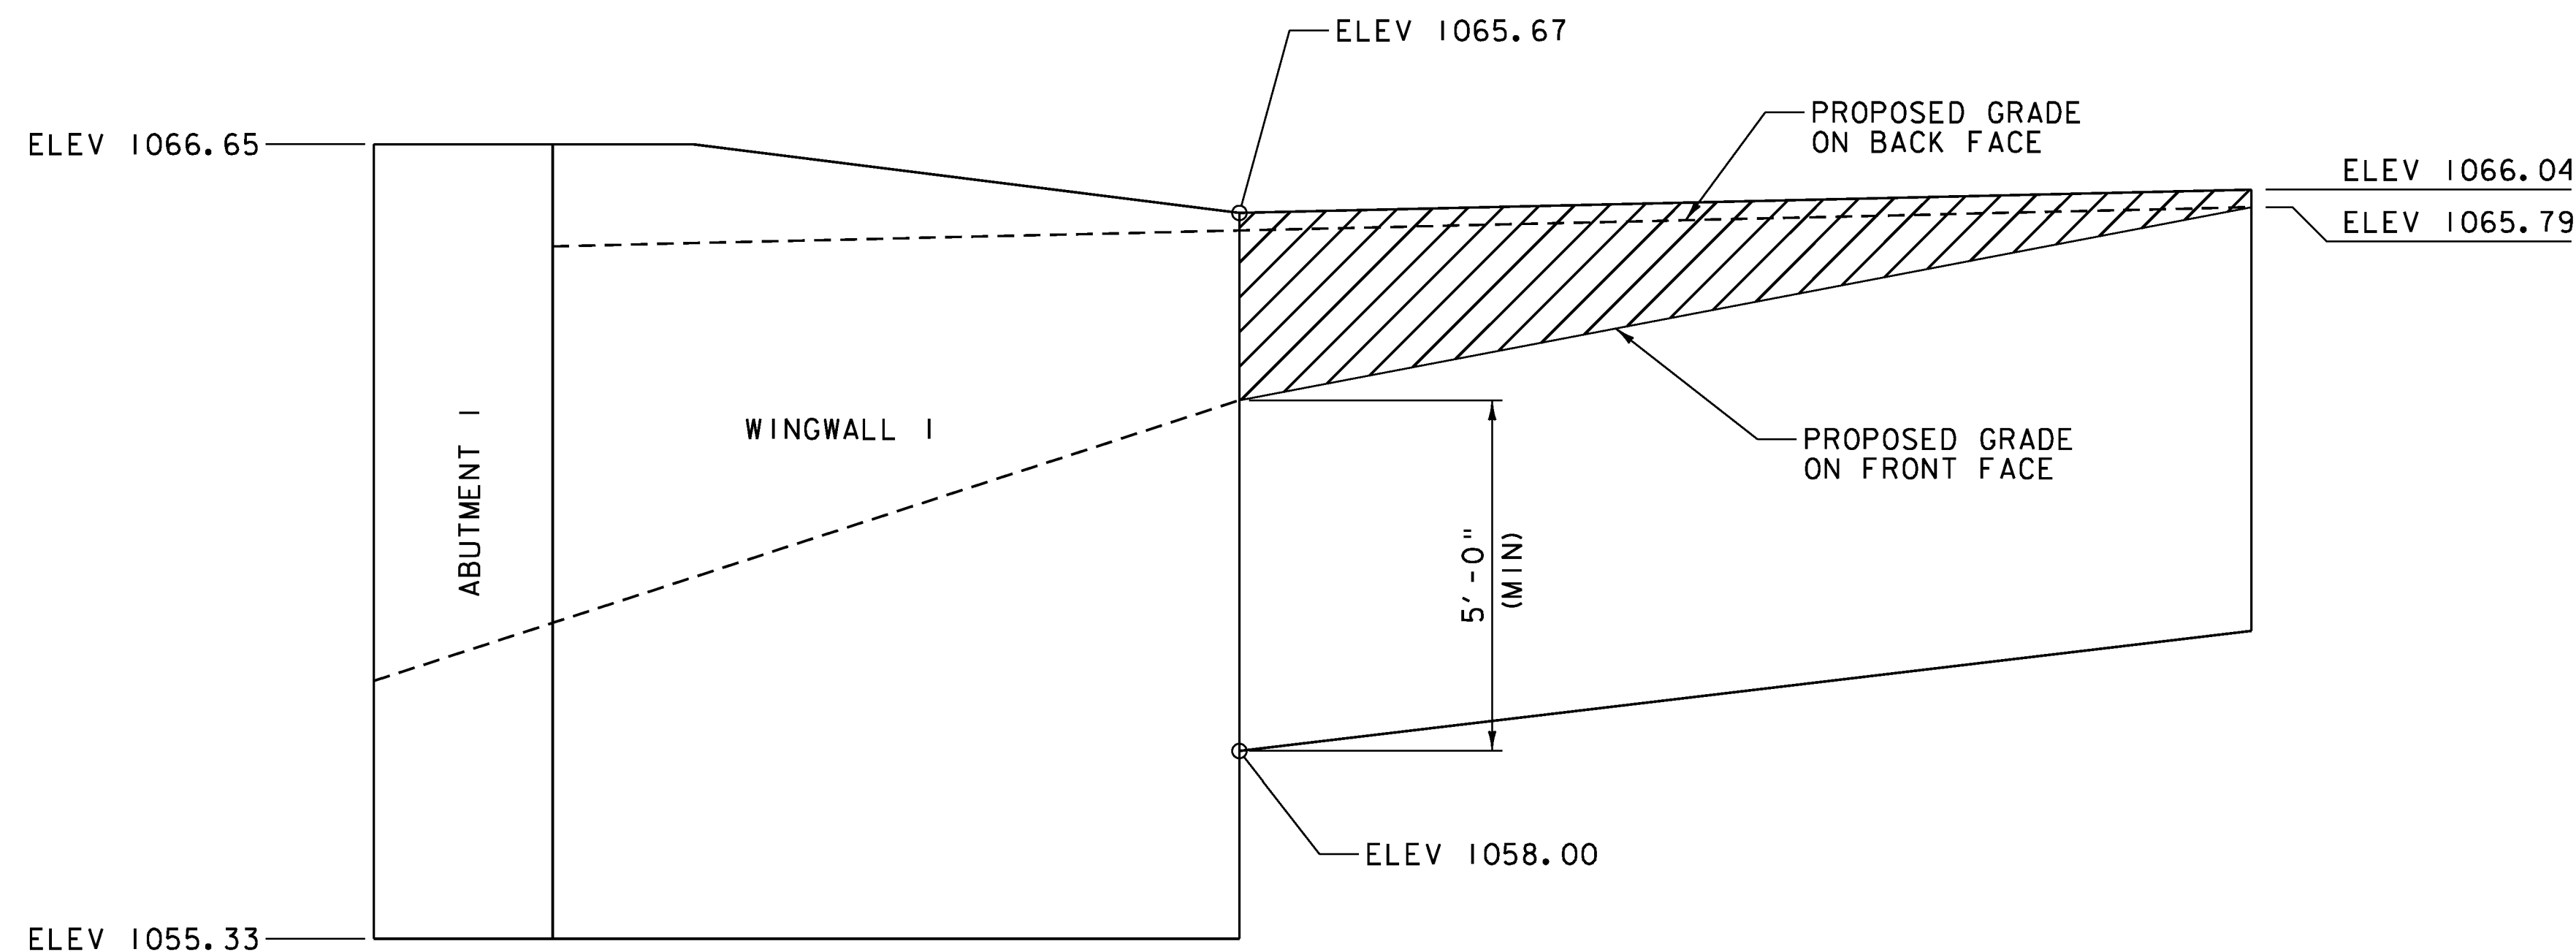

PAY LIMITS OF ITEM 900.670 "SPECIAL PROVISION (RETAINING WALL)"

**RETAINING WALL ELEVATION VIEW**

SCALE 1/2" = 1'-0"

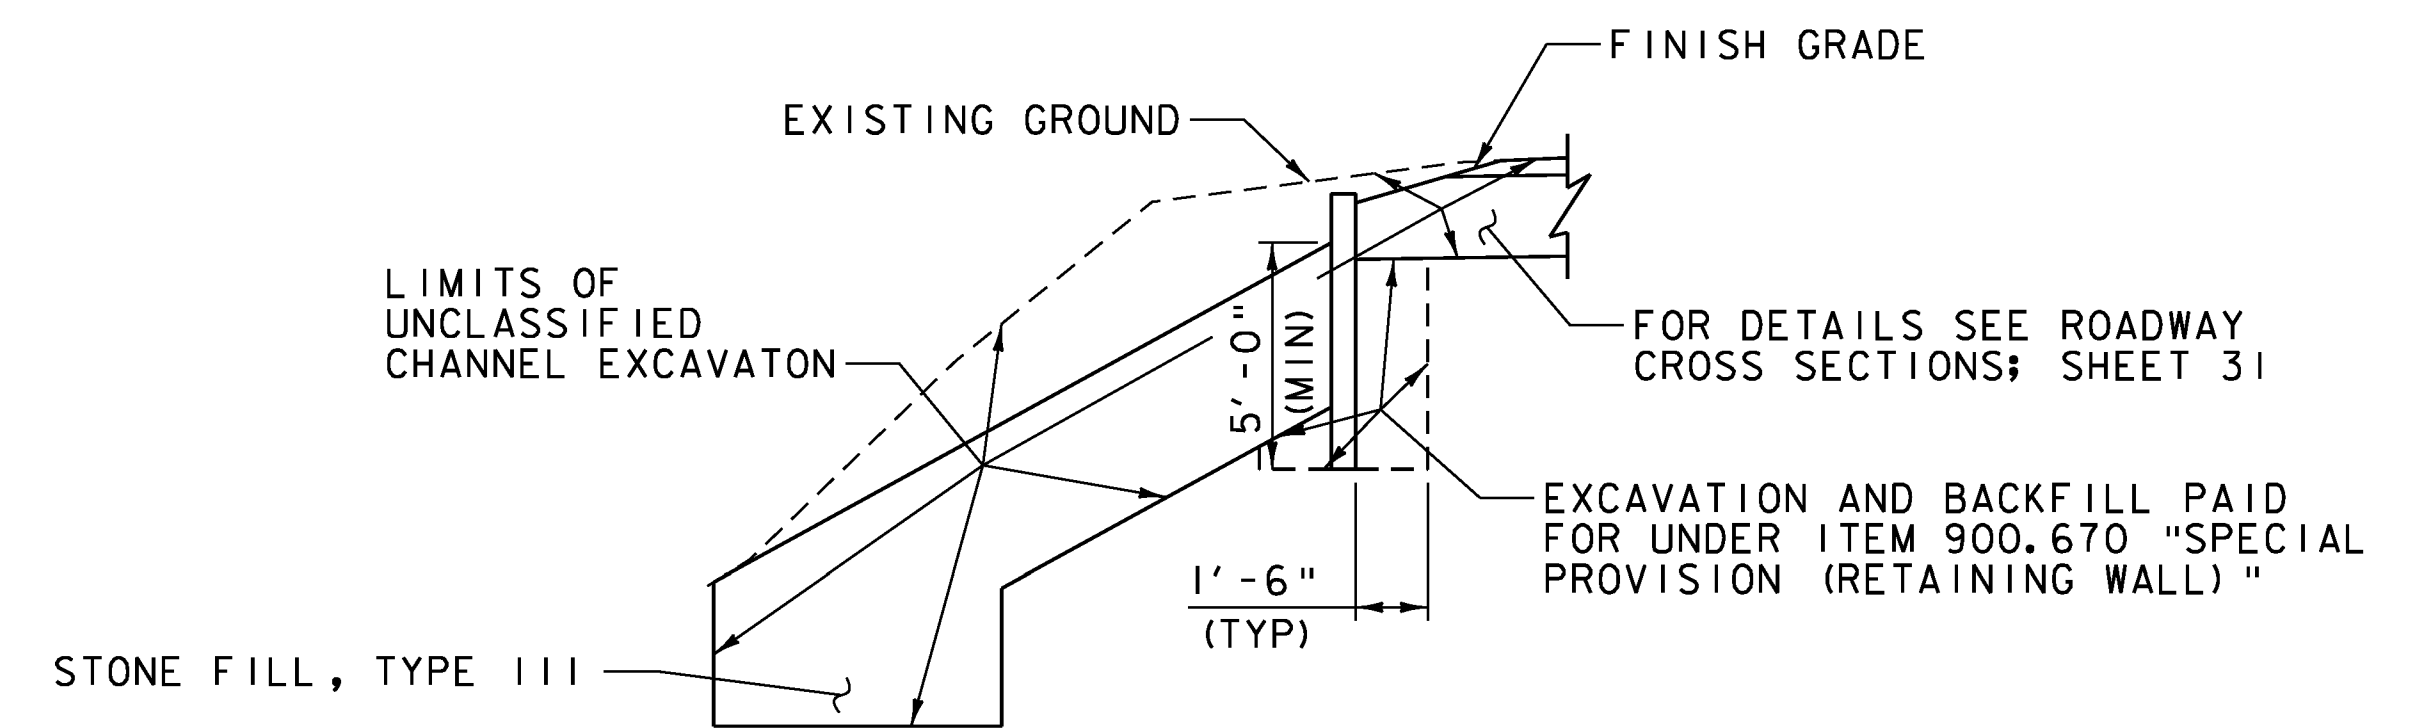

**RETAINING WALL EXCAVATION DETAIL**



NOT TO SCALE

PROJECT NAME: GUILFORD  
PROJECT NUMBER: BRO 1442(36)

FILE NAME: z10j064sub.dgn  
PROJECT LEADER: S.E. BURBANK  
DESIGNED BY: A.J. GOUDREAU  
RETAINING WALL DETAILS

PLOT DATE: 10/2/2013  
DRAWN BY: A.J. GOUDREAU  
CHECKED BY: S.E. BURBANK  
SHEET 27 OF 42




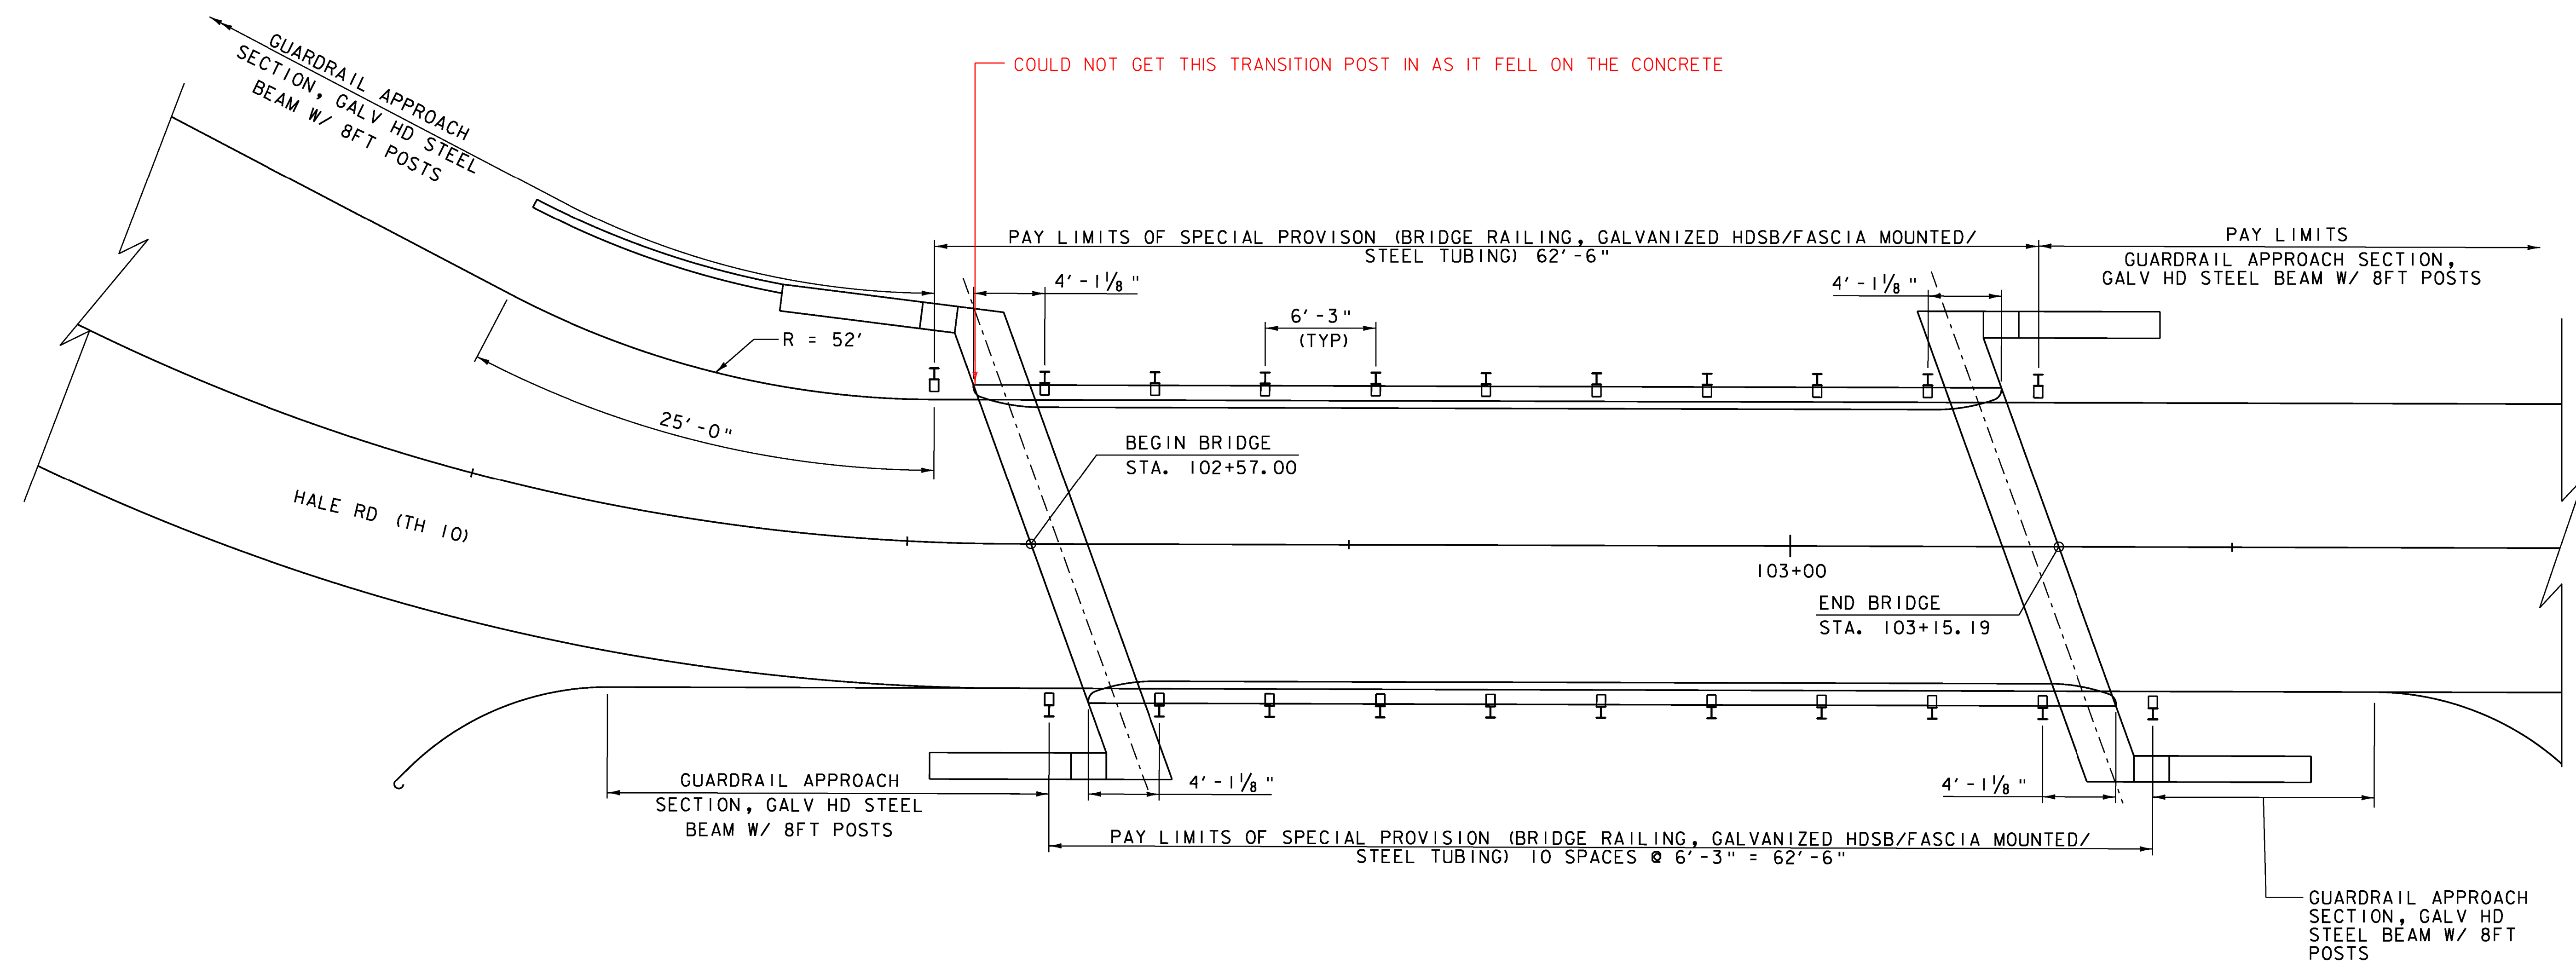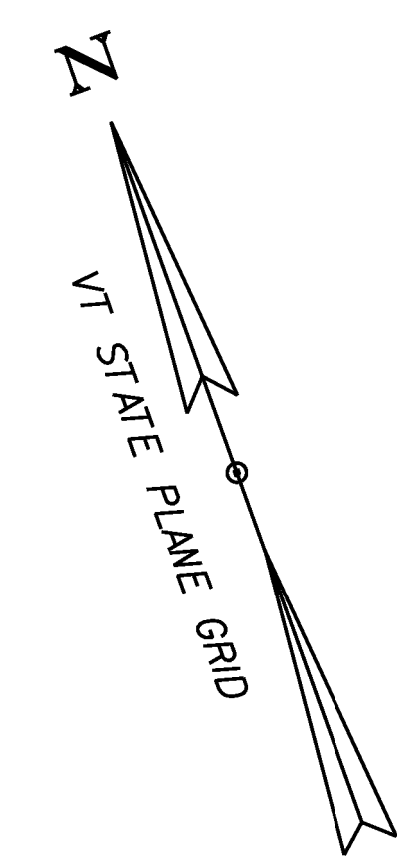


BRIDGE RAIL LAYOUT  
NOT TO SCALE

PROJECT NAME: GUILFORD	
PROJECT NUMBER: BRO 1442(36)	
FILE NAME: z10j064brail.dgn	PLOT DATE: 10/2/2013
PROJECT LEADER: S.E. BURBANK	DRAWN BY: E.A. FIALA
DESIGNED BY: E.A. FIALA	CHECKED BY: S.E. BURBANK
BRIDGE RAIL LAYOUT	SHEET 28 OF 42



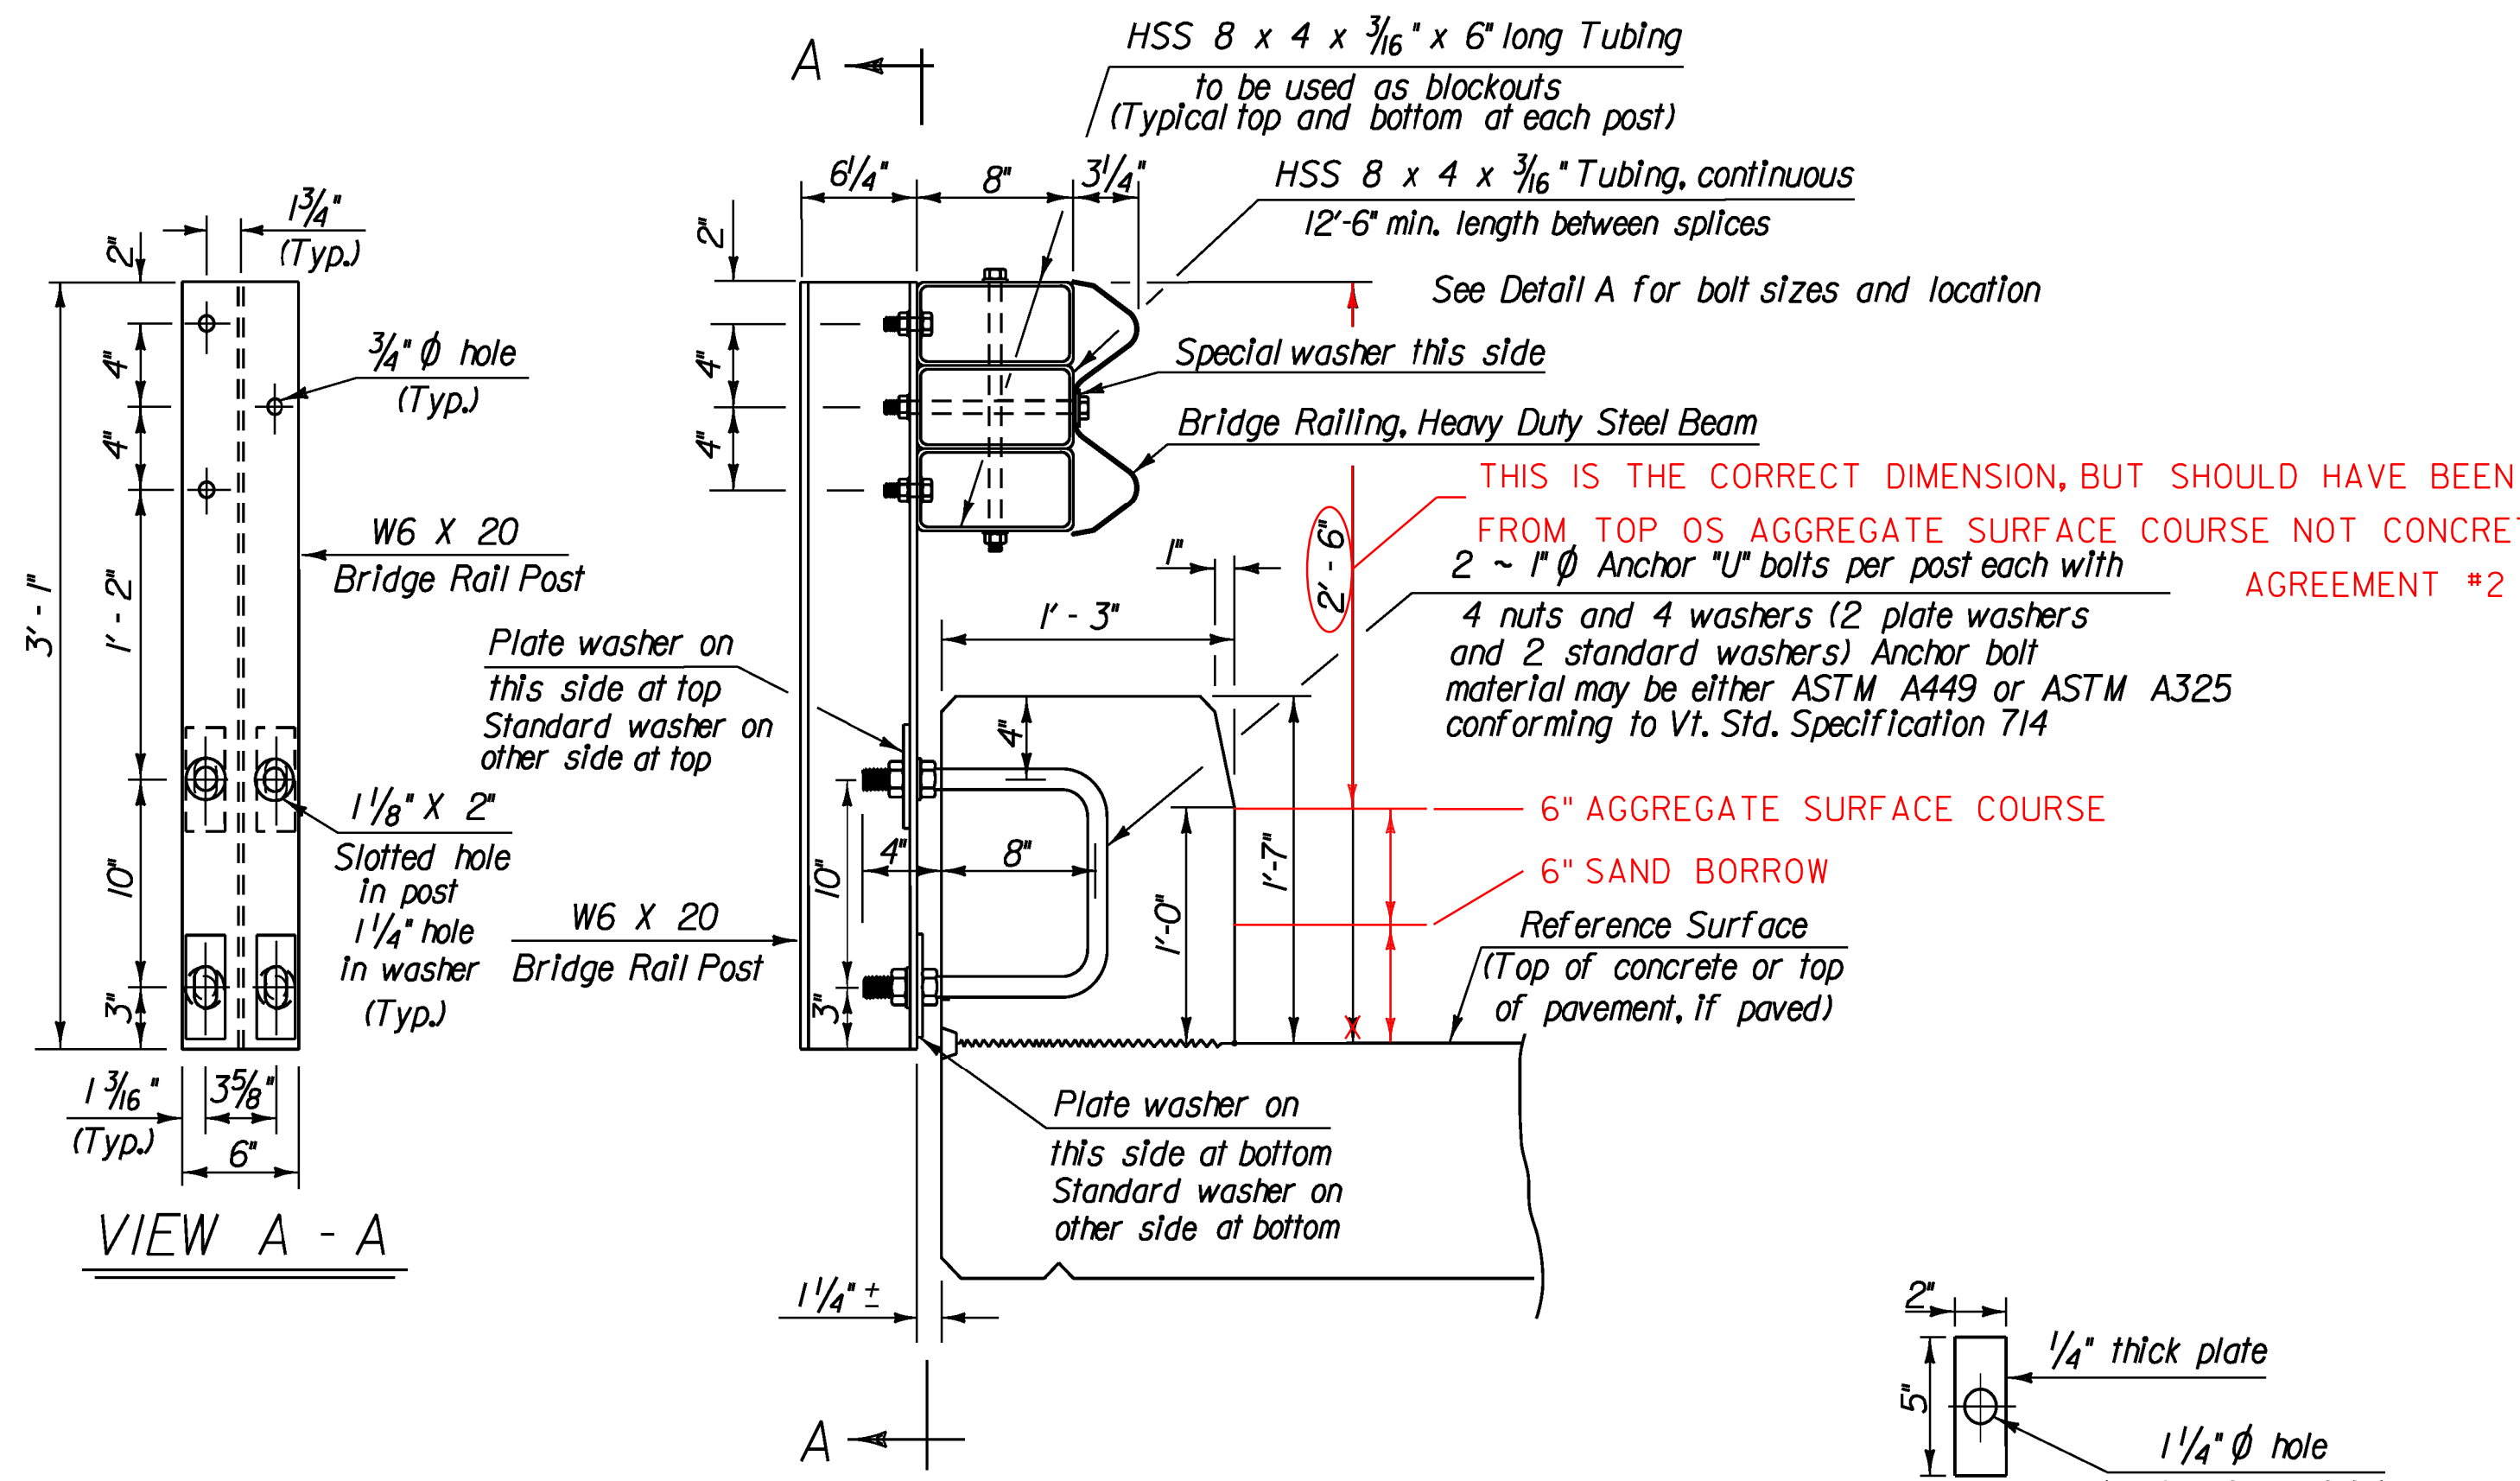

FASCIA MOUNTED WITH CURB

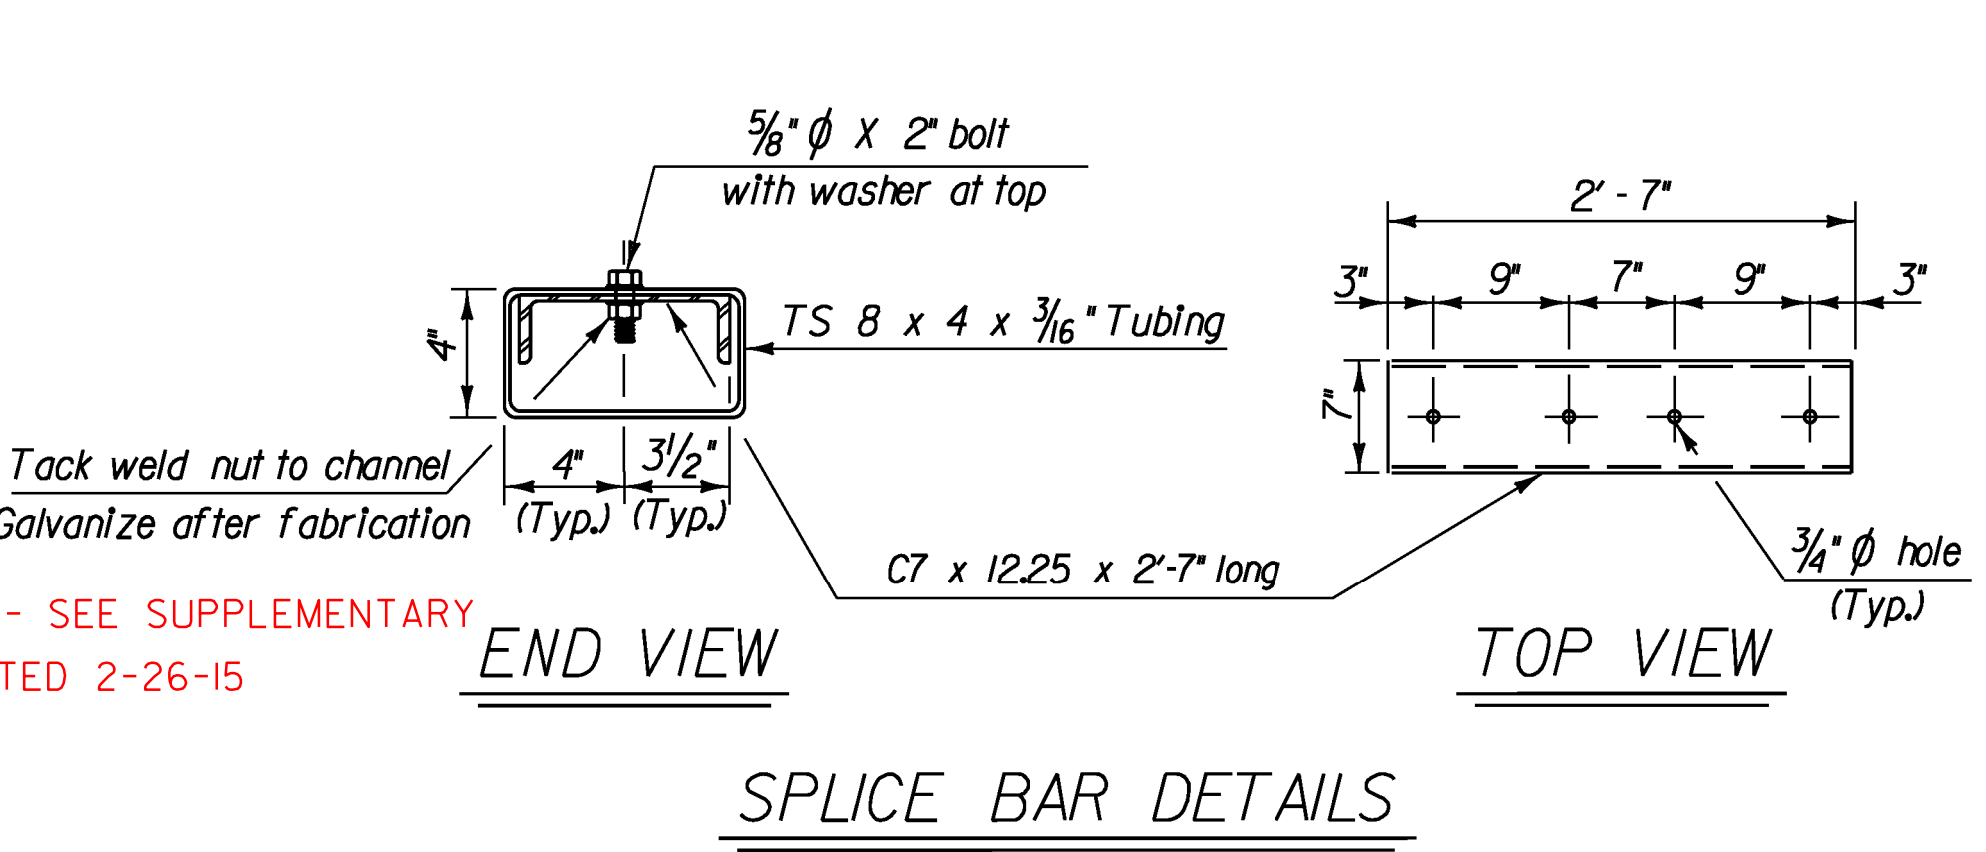

SPLICE BAR DETAILS



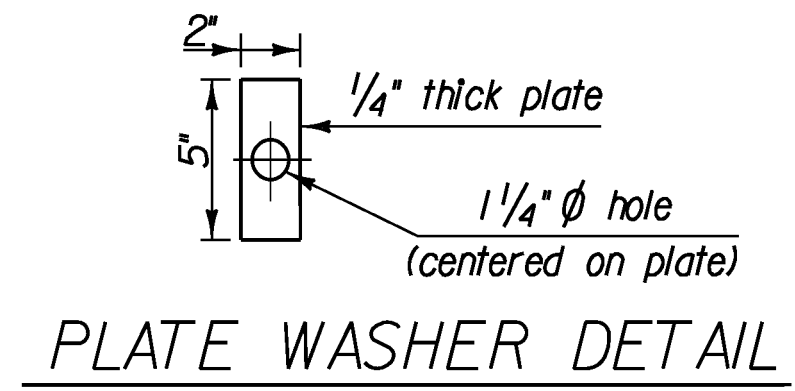



PLATE WASHER DETAIL

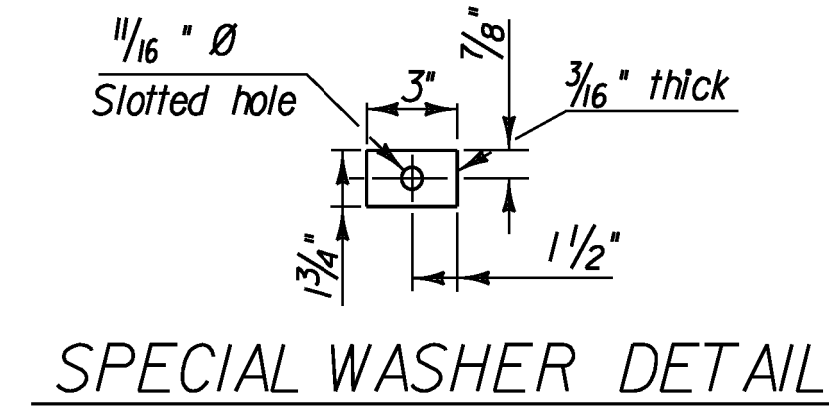


SPECIAL WASHER DETAIL

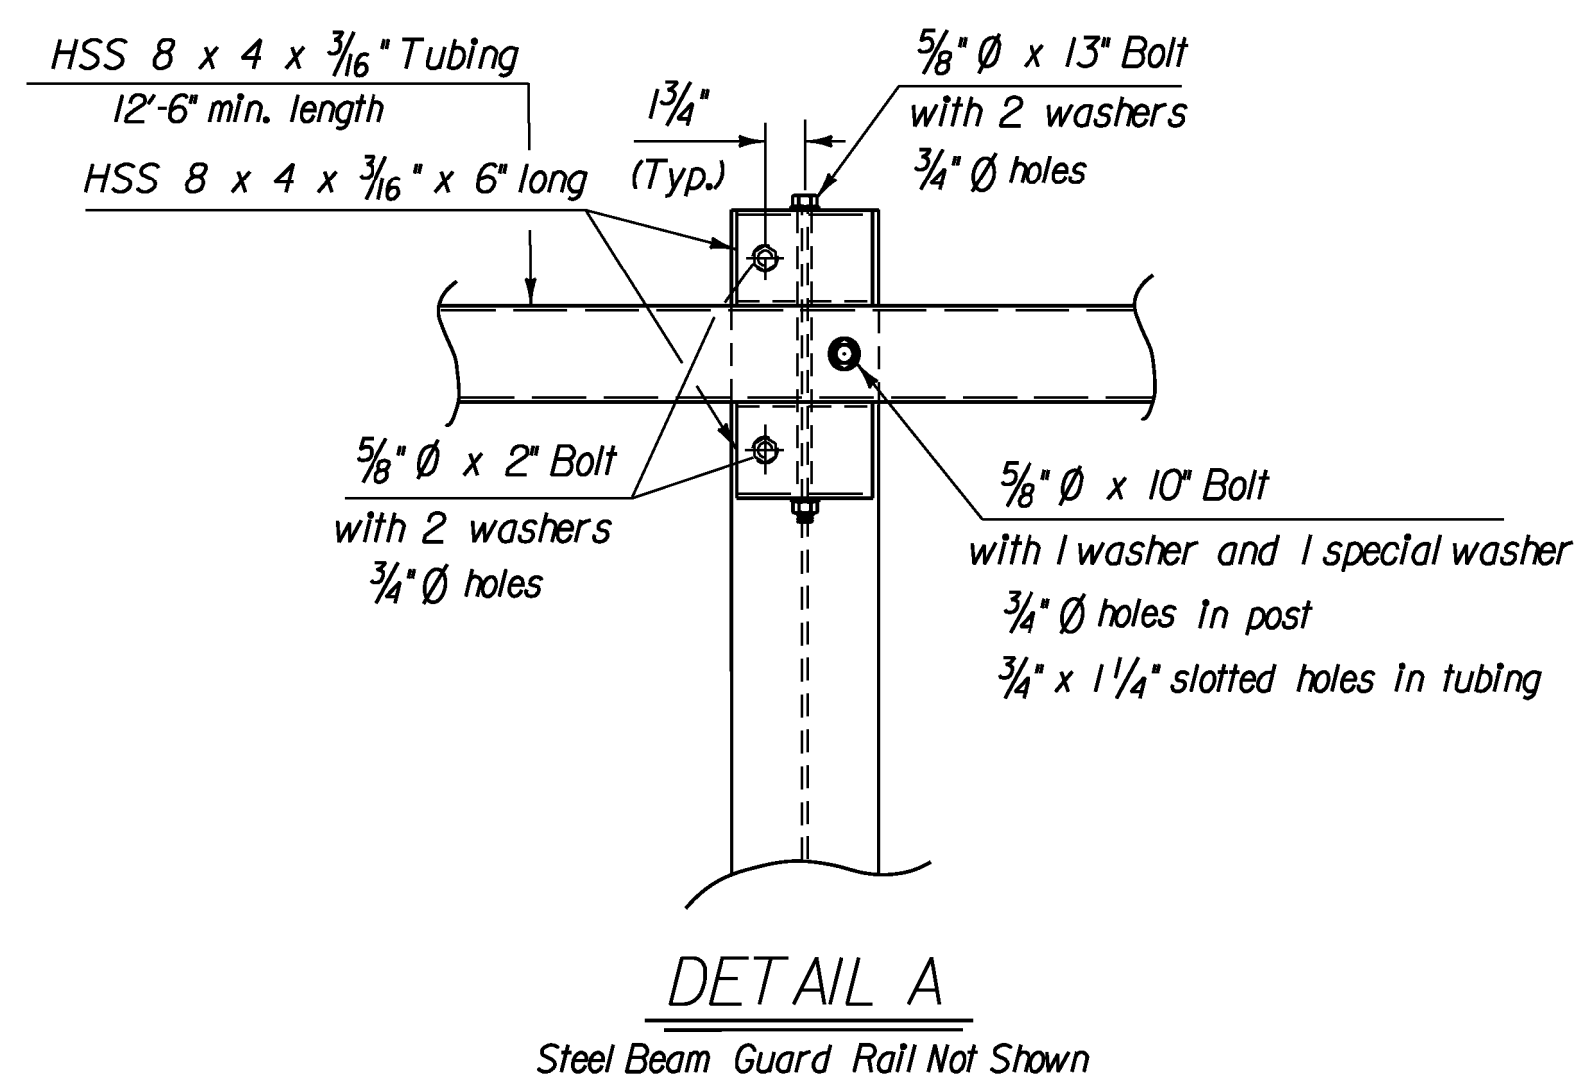

DETAIL A  
Steel Beam Guard Rail Not Shown

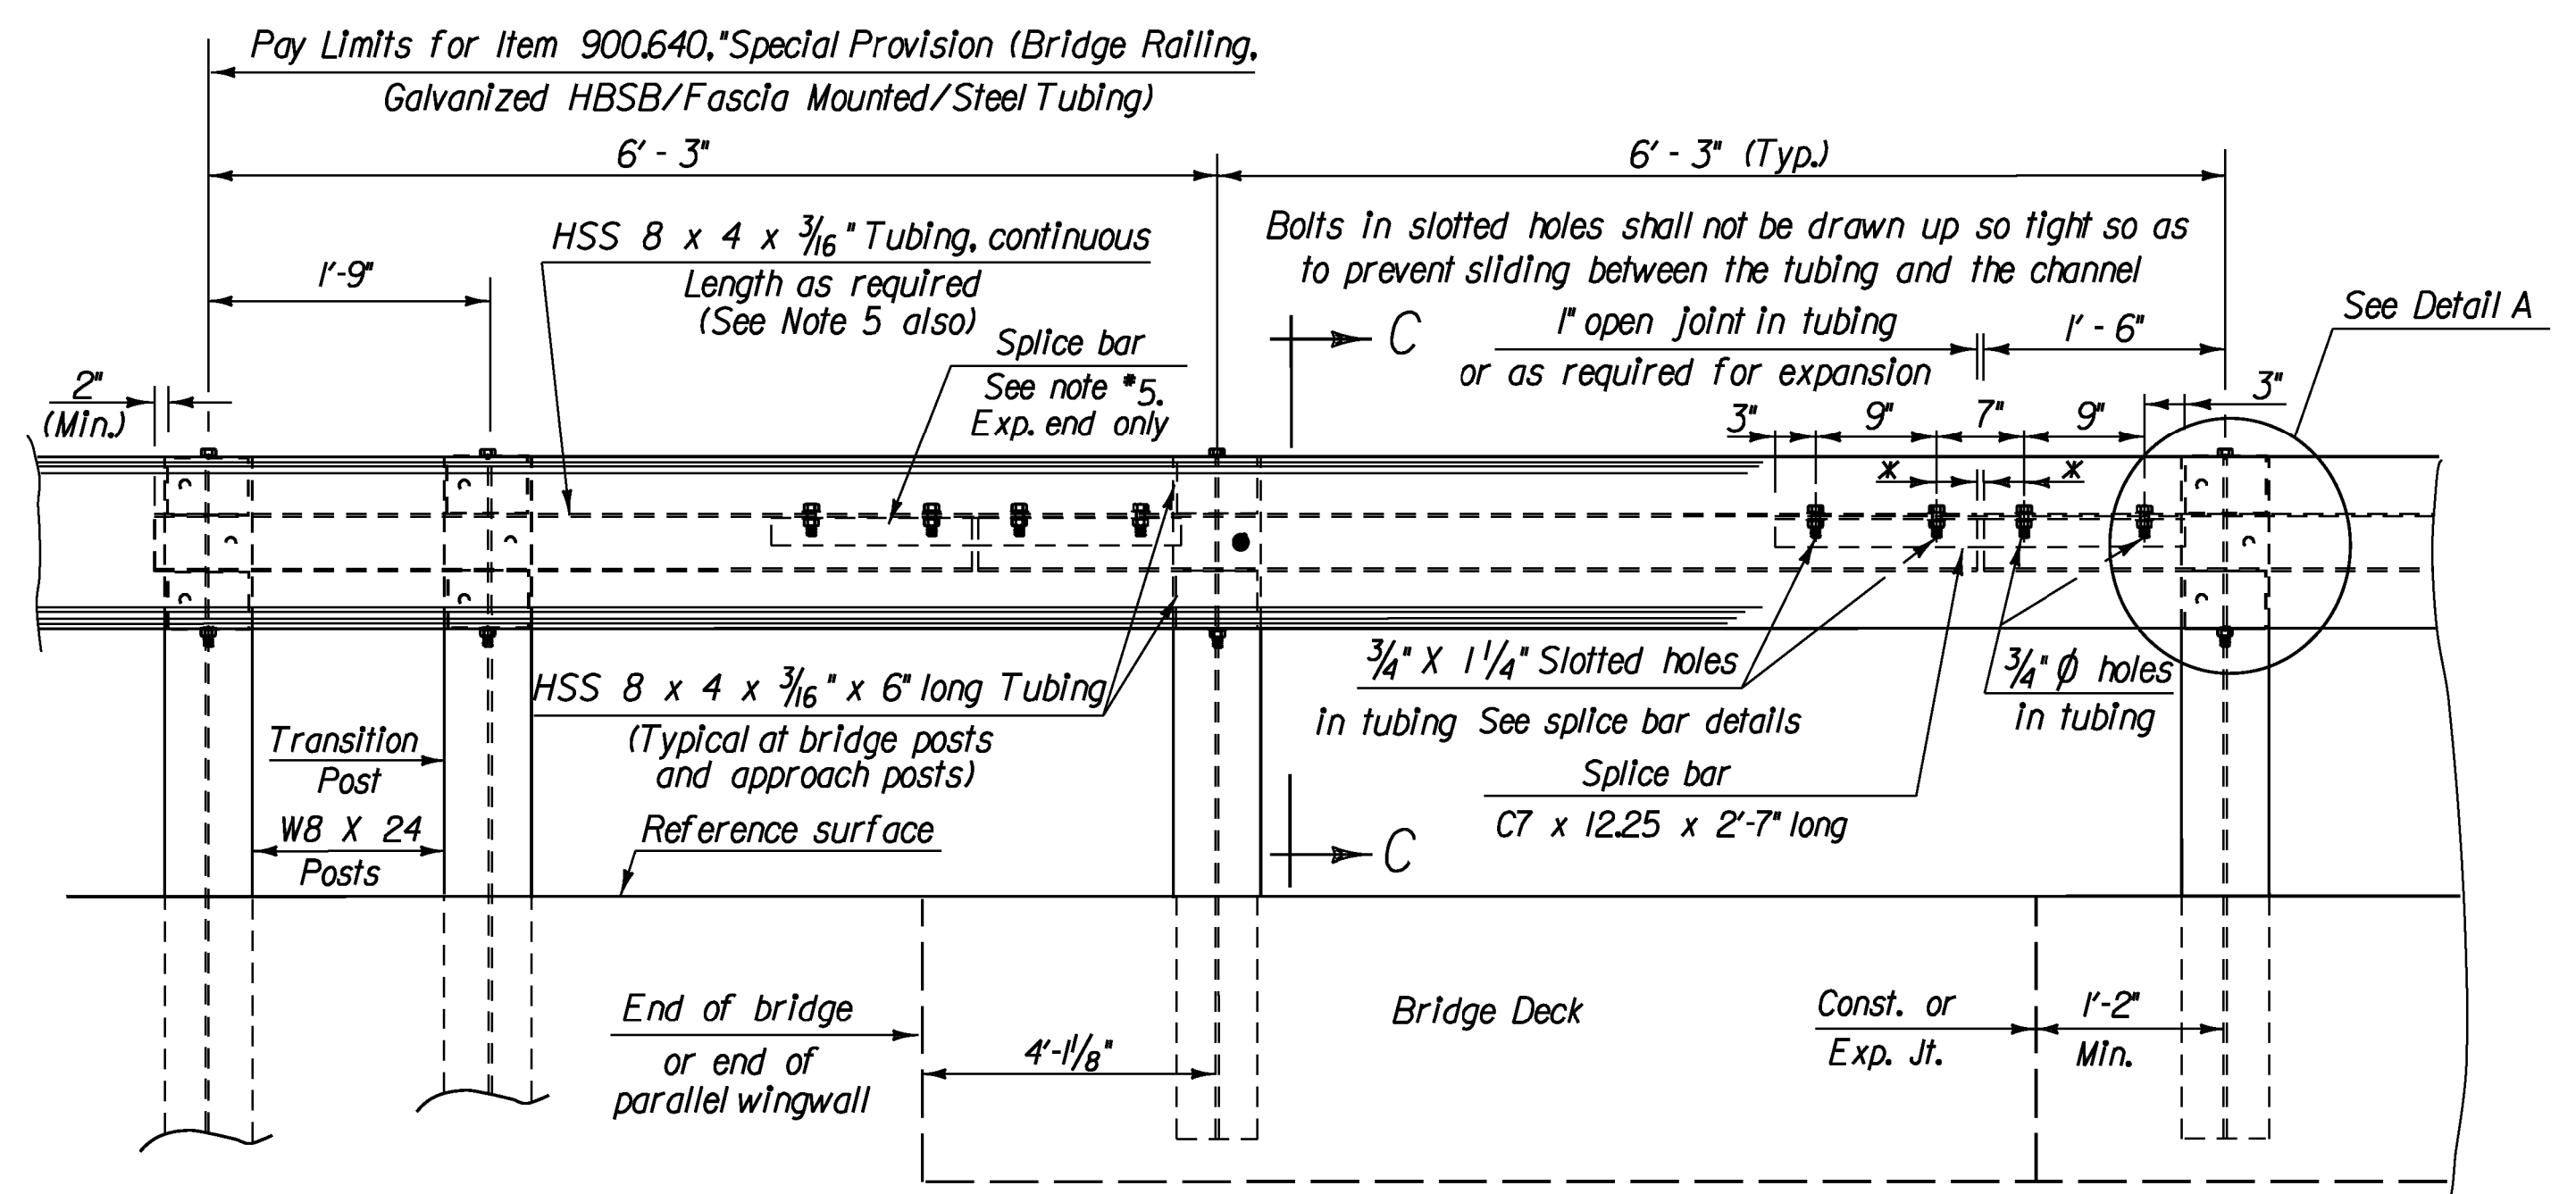

RAILING ELEVATION VIEW  
(SHOWN LOOKING FROM Q WITHOUT CURB)

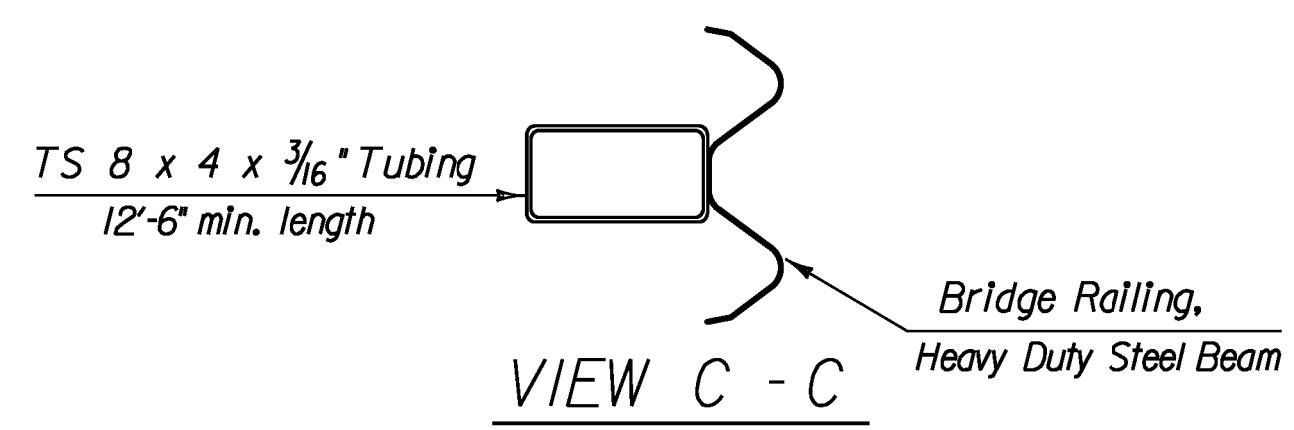


VIEW C - C

NOTES


1. ALL WORK AND MATERIALS SHALL CONFORM TO SECTION 525.
2. PRIOR TO GALVANIZING THE ASSEMBLED POST, GRIND ALL EDGES TO A MINIMUM RADIUS OF 1/16 INCH.
3. ALL POSTS SHALL BE SET NORMAL TO GRADE.
4. SPLICES FOR THE STEEL BEAM GUARDRAIL SHALL LAP IN THE DIRECTION OF TRAFFIC.
5. A RAILING JOINT SPLICE SHALL BE PROVIDED IN ANY RAIL BAY SPANNING THE END OF AN INTEGRAL ABUTMENT BRIDGE AND AT ALL SUPERSTRUCTURE EXPANSION JOINTS.
6. SEE STANDARD DRAWING G-1 FOR DETAILS OF DELINEATORS. A DELINEATOR SHALL BE LOCATED AT EVERY FIFTH POST. WHITE IS TO BE INSTALLED ON THE DRIVER'S RIGHT. FOR ONE WAY BRIDGES, YELLOW IS TO BE INSTALLED ON THE DRIVER'S LEFT.
7. FOR RADII LESS THAN 950 FEET, HSS 8x4 TUBES SHALL BE SHOP BENT TO FIT THE APPLICABLE CURVE.
8. HOLES IN RAIL FOR RAIL TUBE ATTACHMENT MAY BE FIELD DRILLED. HOLES SHALL BE COATED WITH AN APPROVED ZINC-RICH PAINT PRIOR TO INSTALLATION.
9. SEE STANDARD G-1 AND G-1d FOR ADDITIONAL DETAILS CONCERNING GUARDRAIL.

* 3/4 inch min. These dimensions will vary depending upon the total amount of expansion required


PROJECT NAME:	GUILFORD	FILE NAME:	z10j064brail.dgn	PLOT DATE:	10/2/2013
PROJECT NUMBER:	BRO 1442(36)	PROJECT LEADER:	S.E. BURBANK	DRAWN BY:	E.A. FIALA
		DESIGNED BY:	VTRANS/VHB	CHECKED BY:	S.E. BURBANK
		BRIDGE RAIL DETAILS		SHEET	29 OF 42

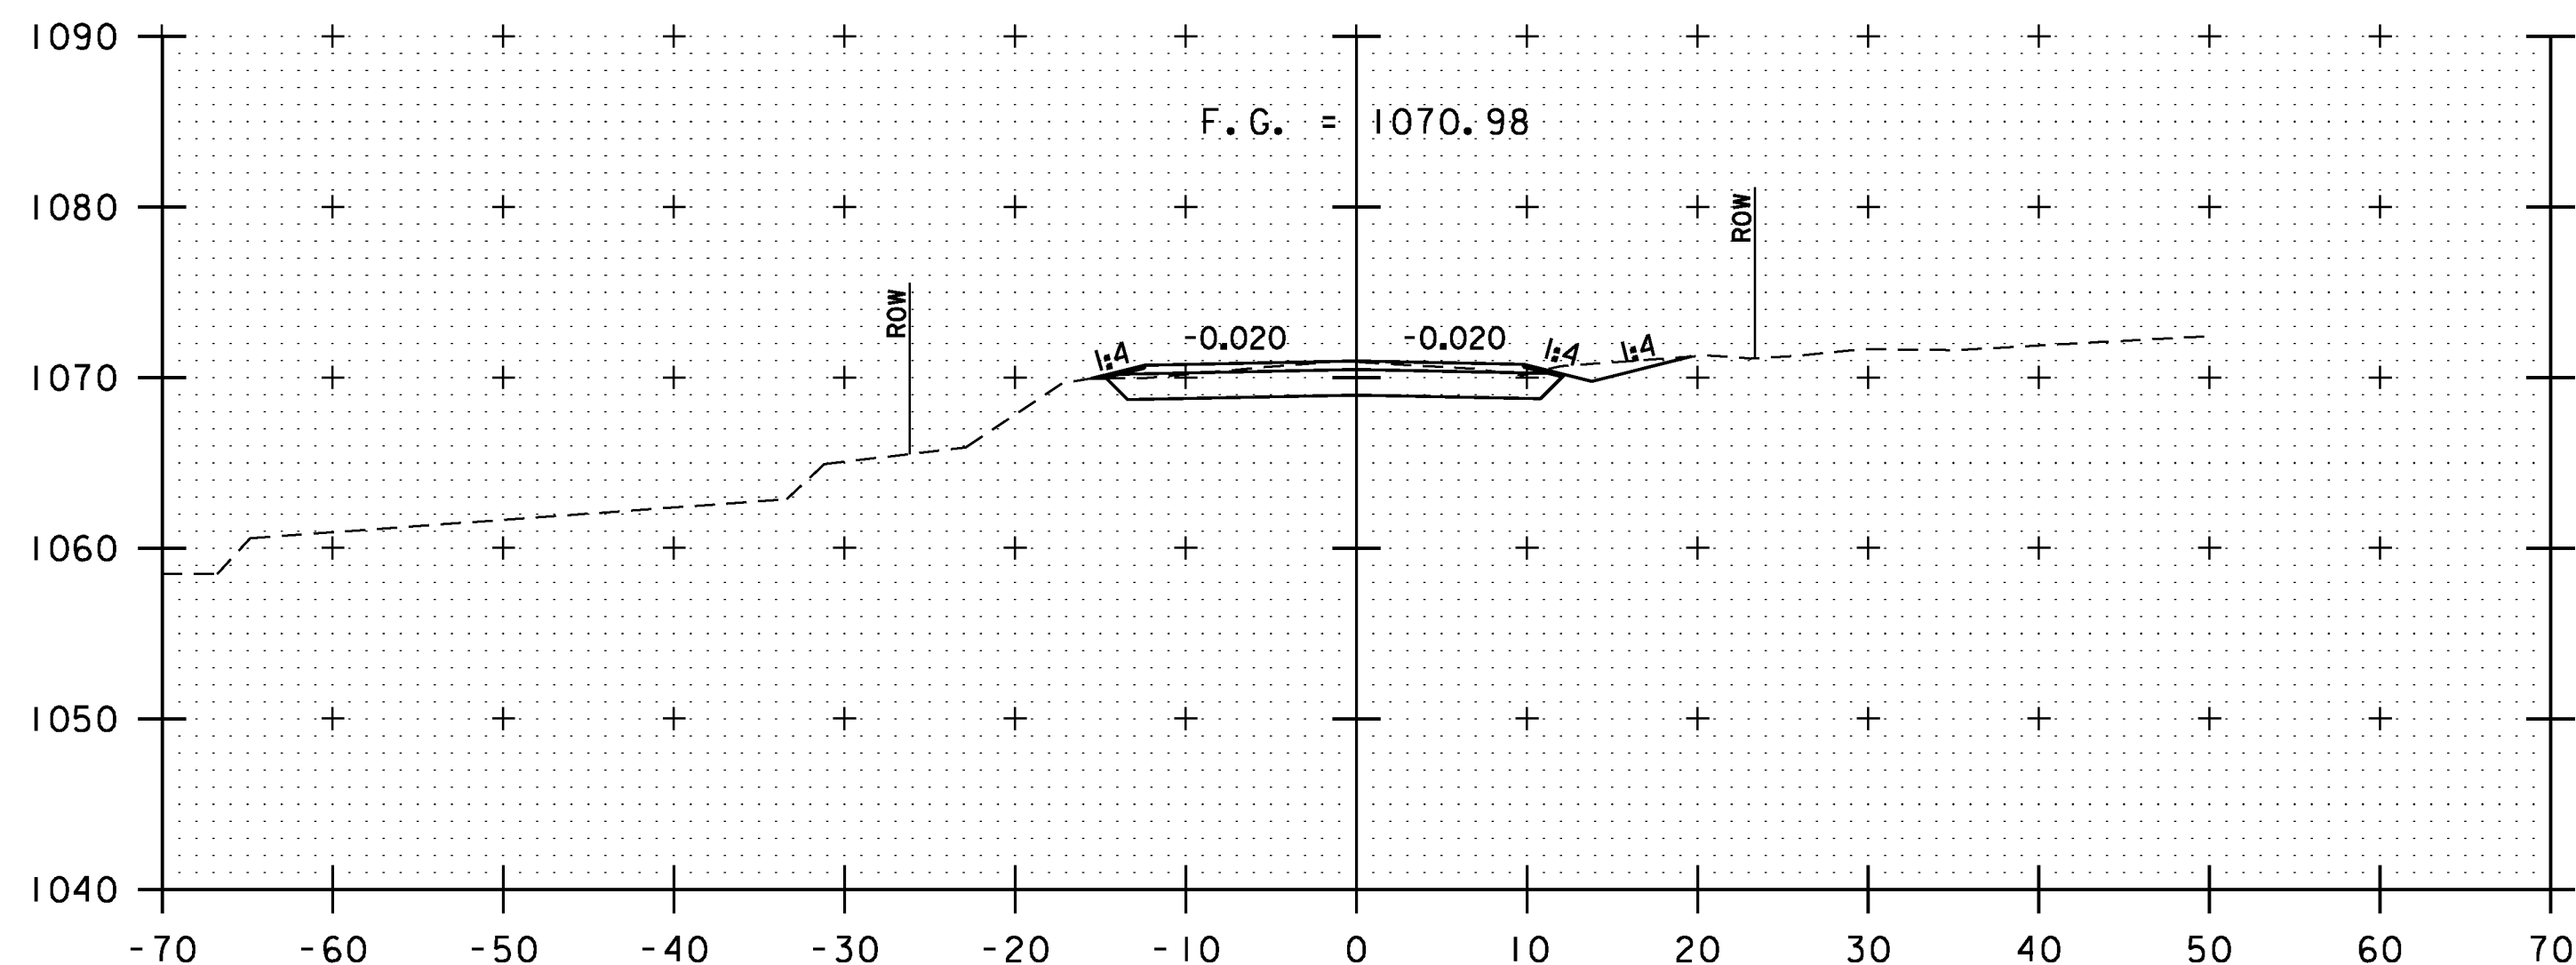


101+25  
BEGIN PROJECT

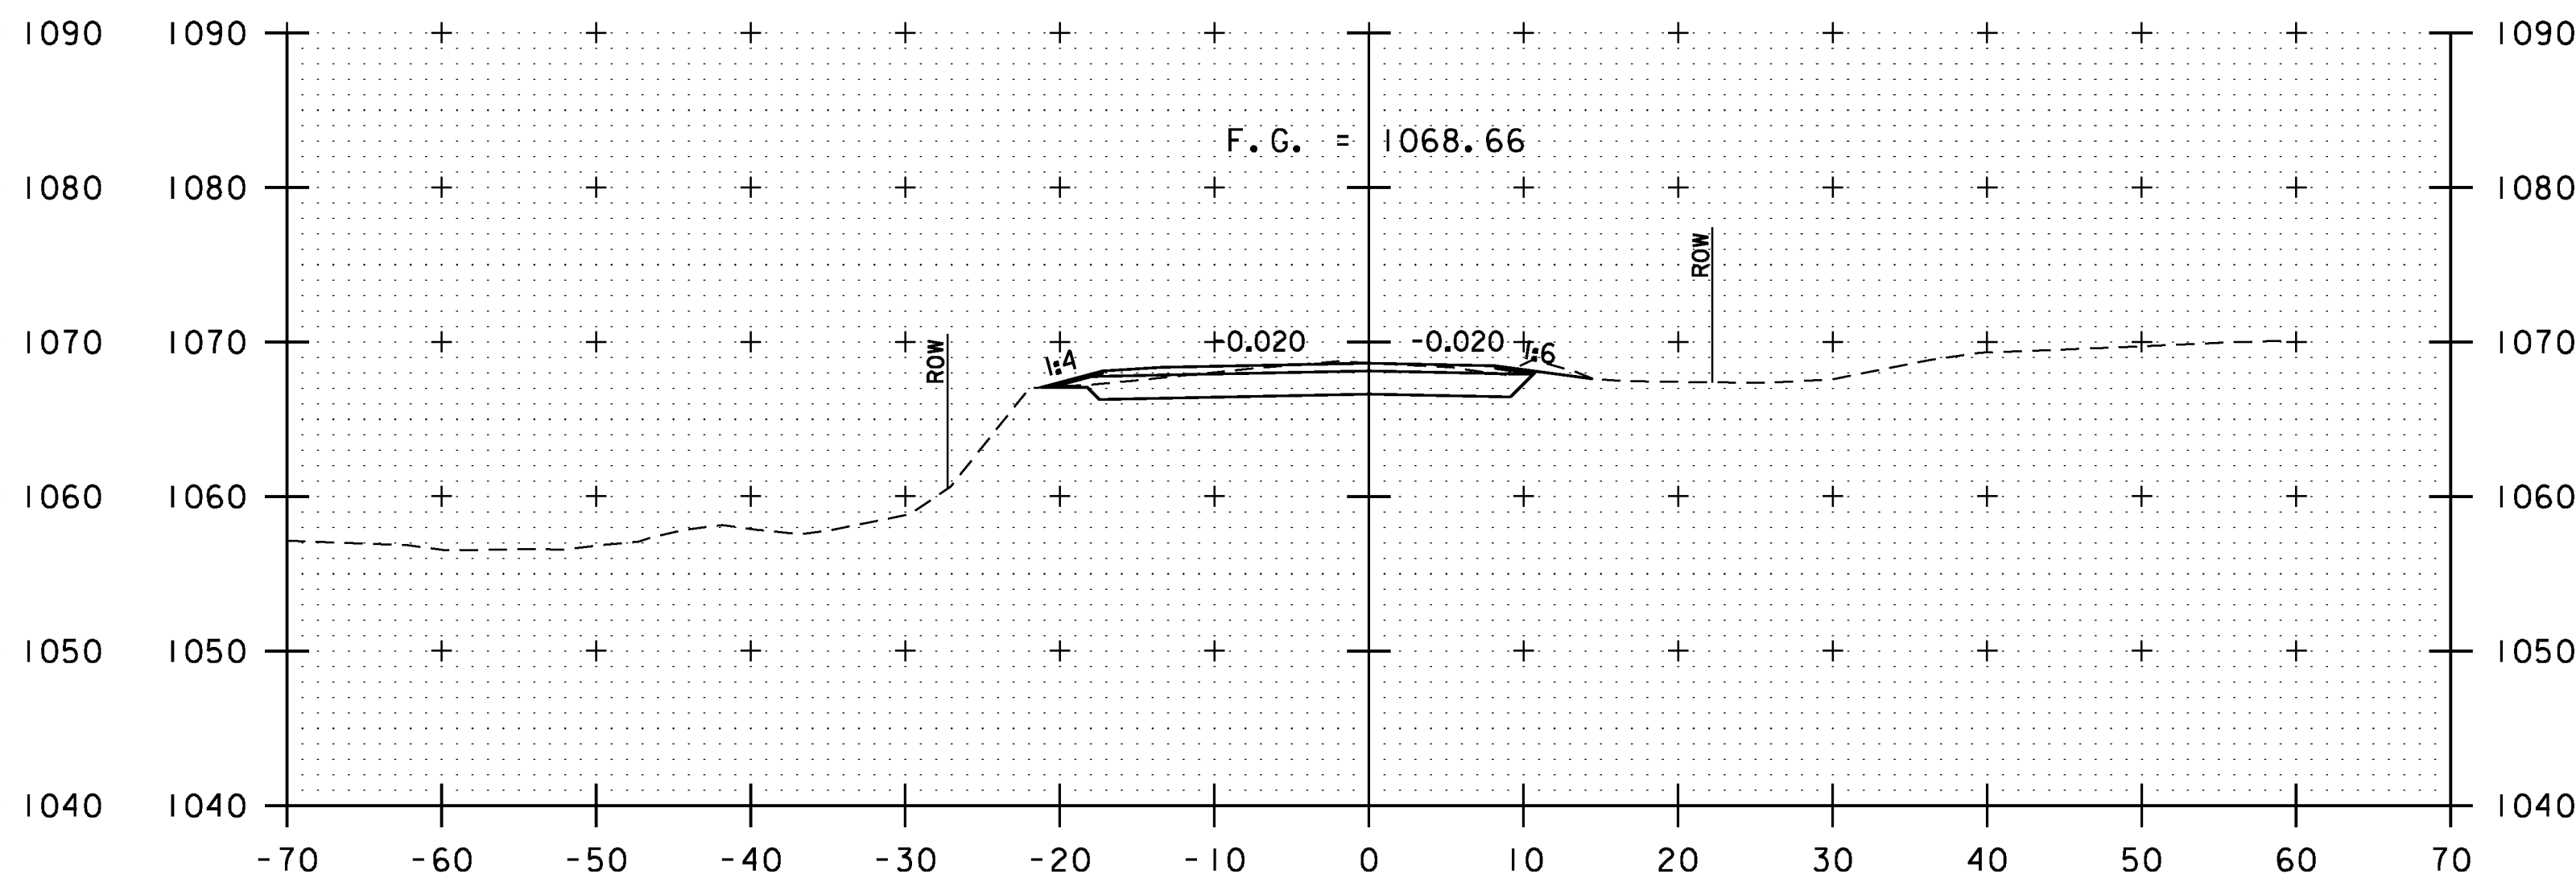

101+75

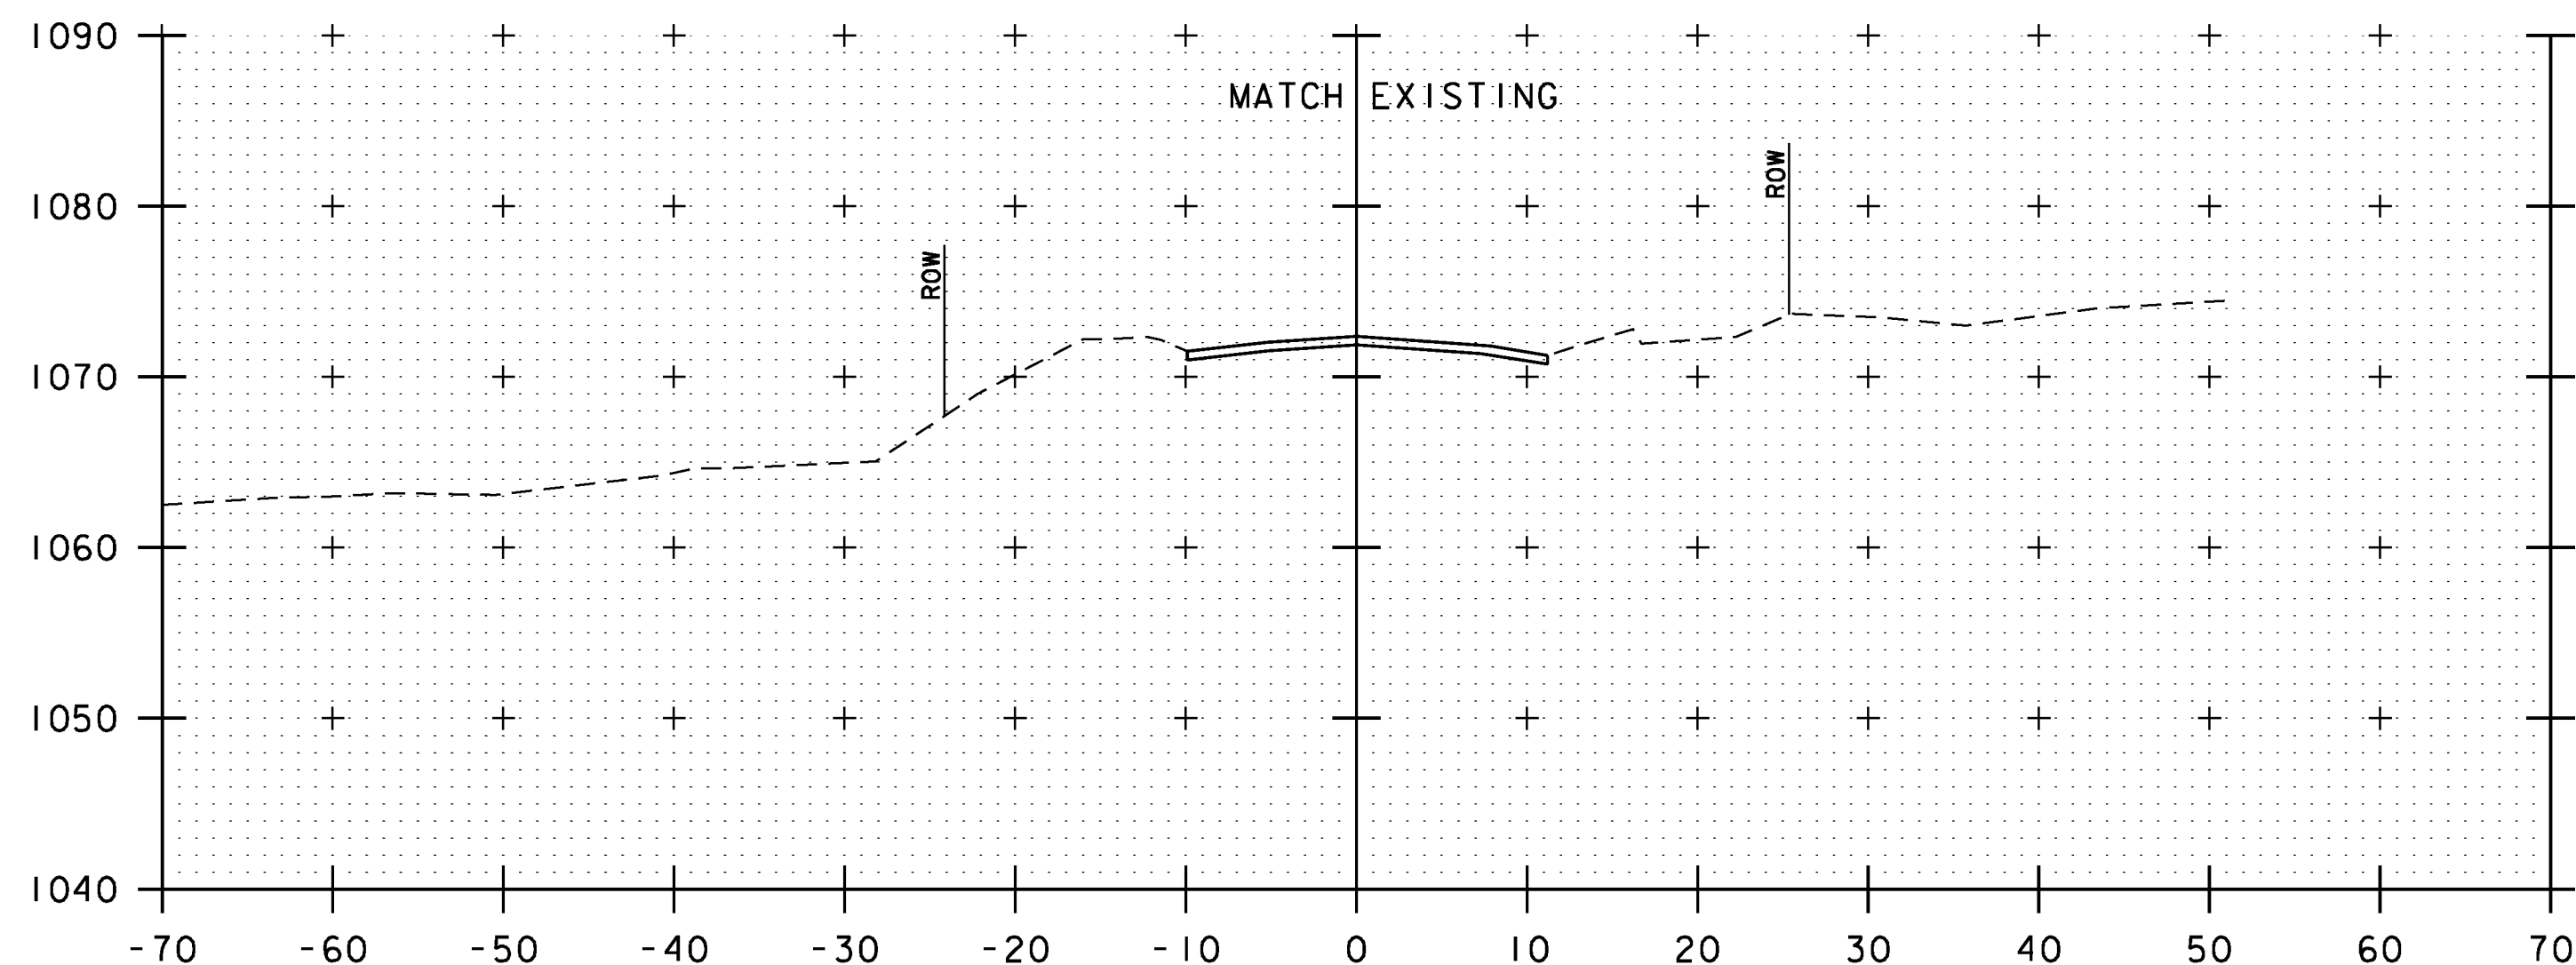

101+00  
BEGIN APPROACH

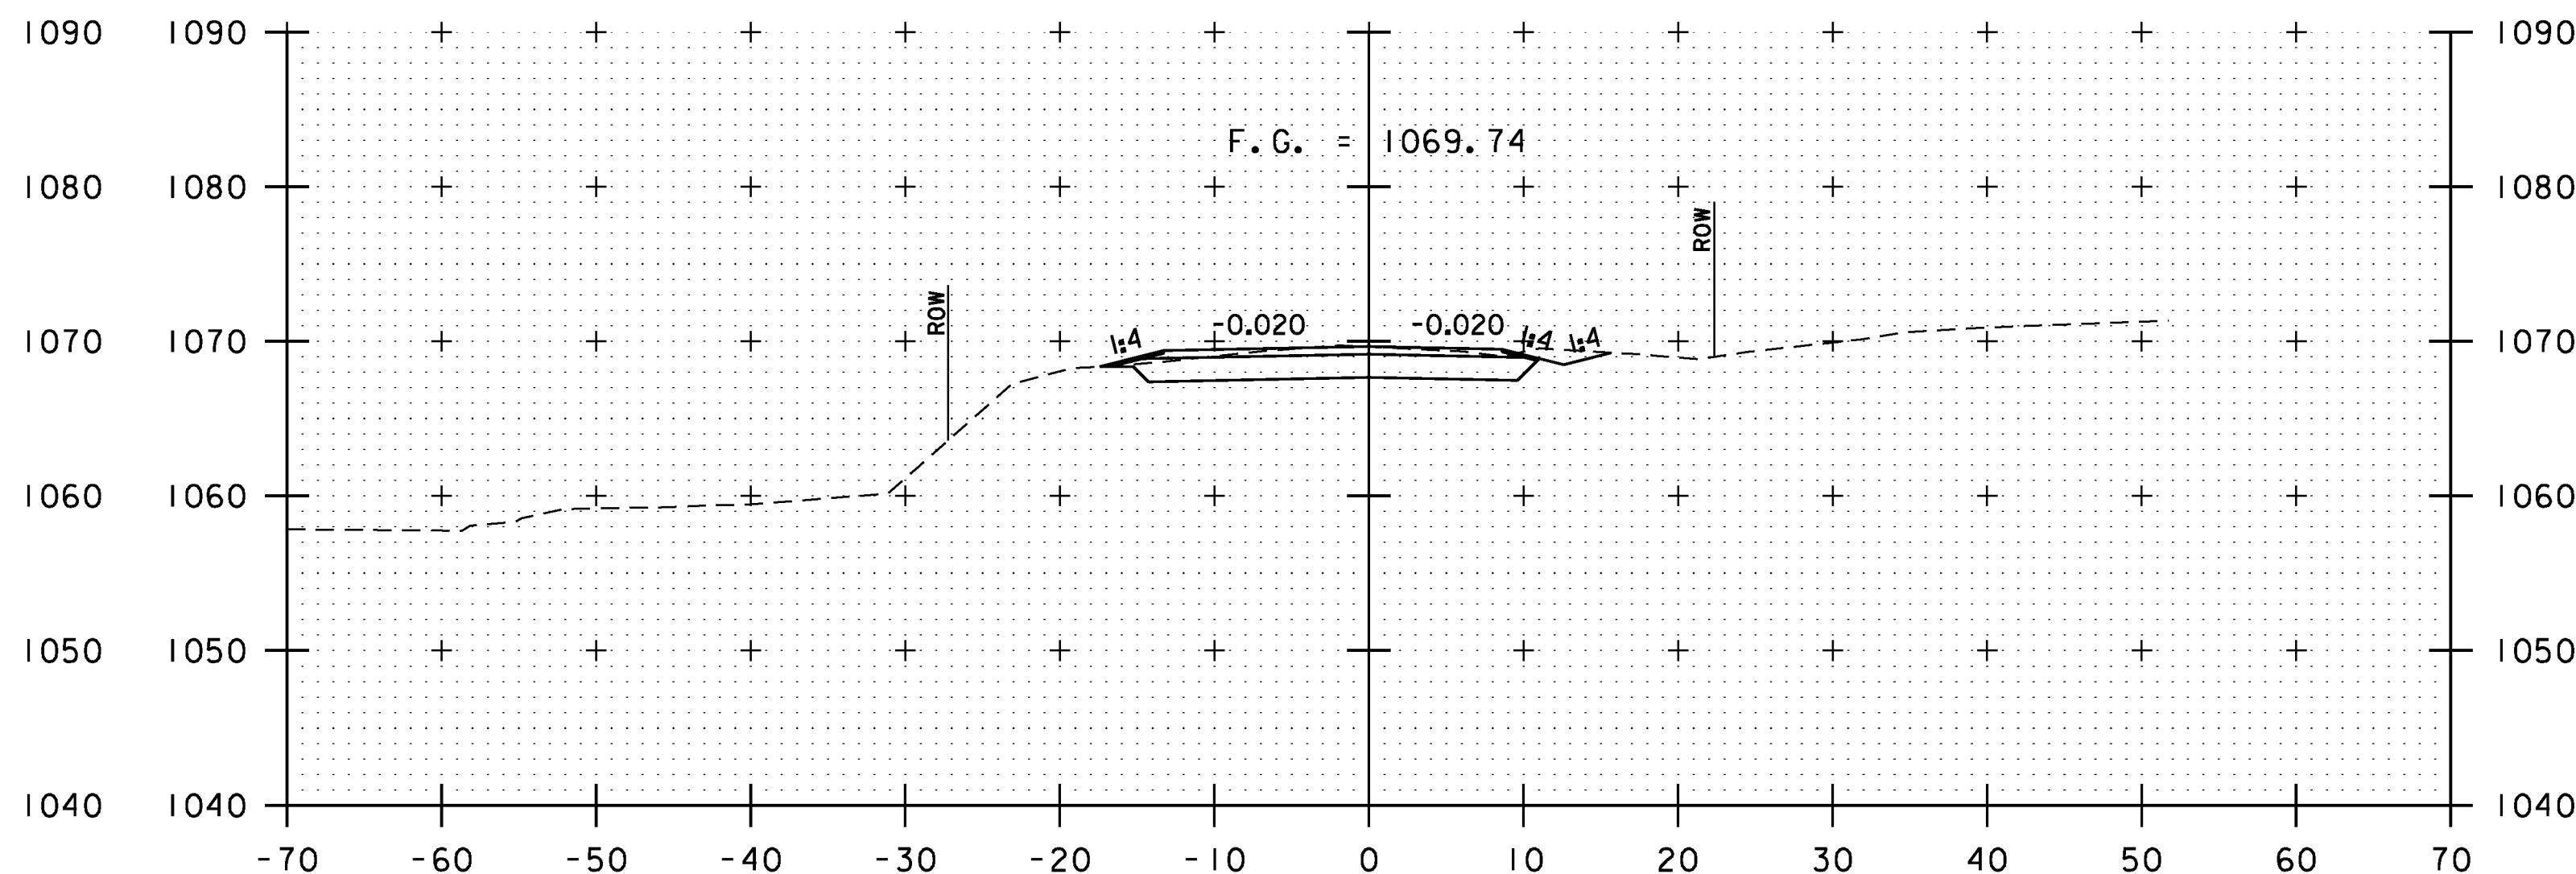

101+50


ROADWAY CROSS SECTIONS  
SCALE 1"=10'-0"  
STA. 101+00 TO STA. 101+75




PROJECT NAME: GUILFORD  
PROJECT NUMBER: BRO 1442(36)

FILE NAME: z10j064xsl.dgn  
PROJECT LEADER: S.E. BURBANK  
DESIGNED BY: E.A. FIALA  
ROADWAY CROSS SECTIONS (1 OF 3)


PLOT DATE: 10/2/2013  
DRAWN BY: E.A. FIALA  
CHECKED BY: S.E. BURBANK  
SHEET 30 OF 42

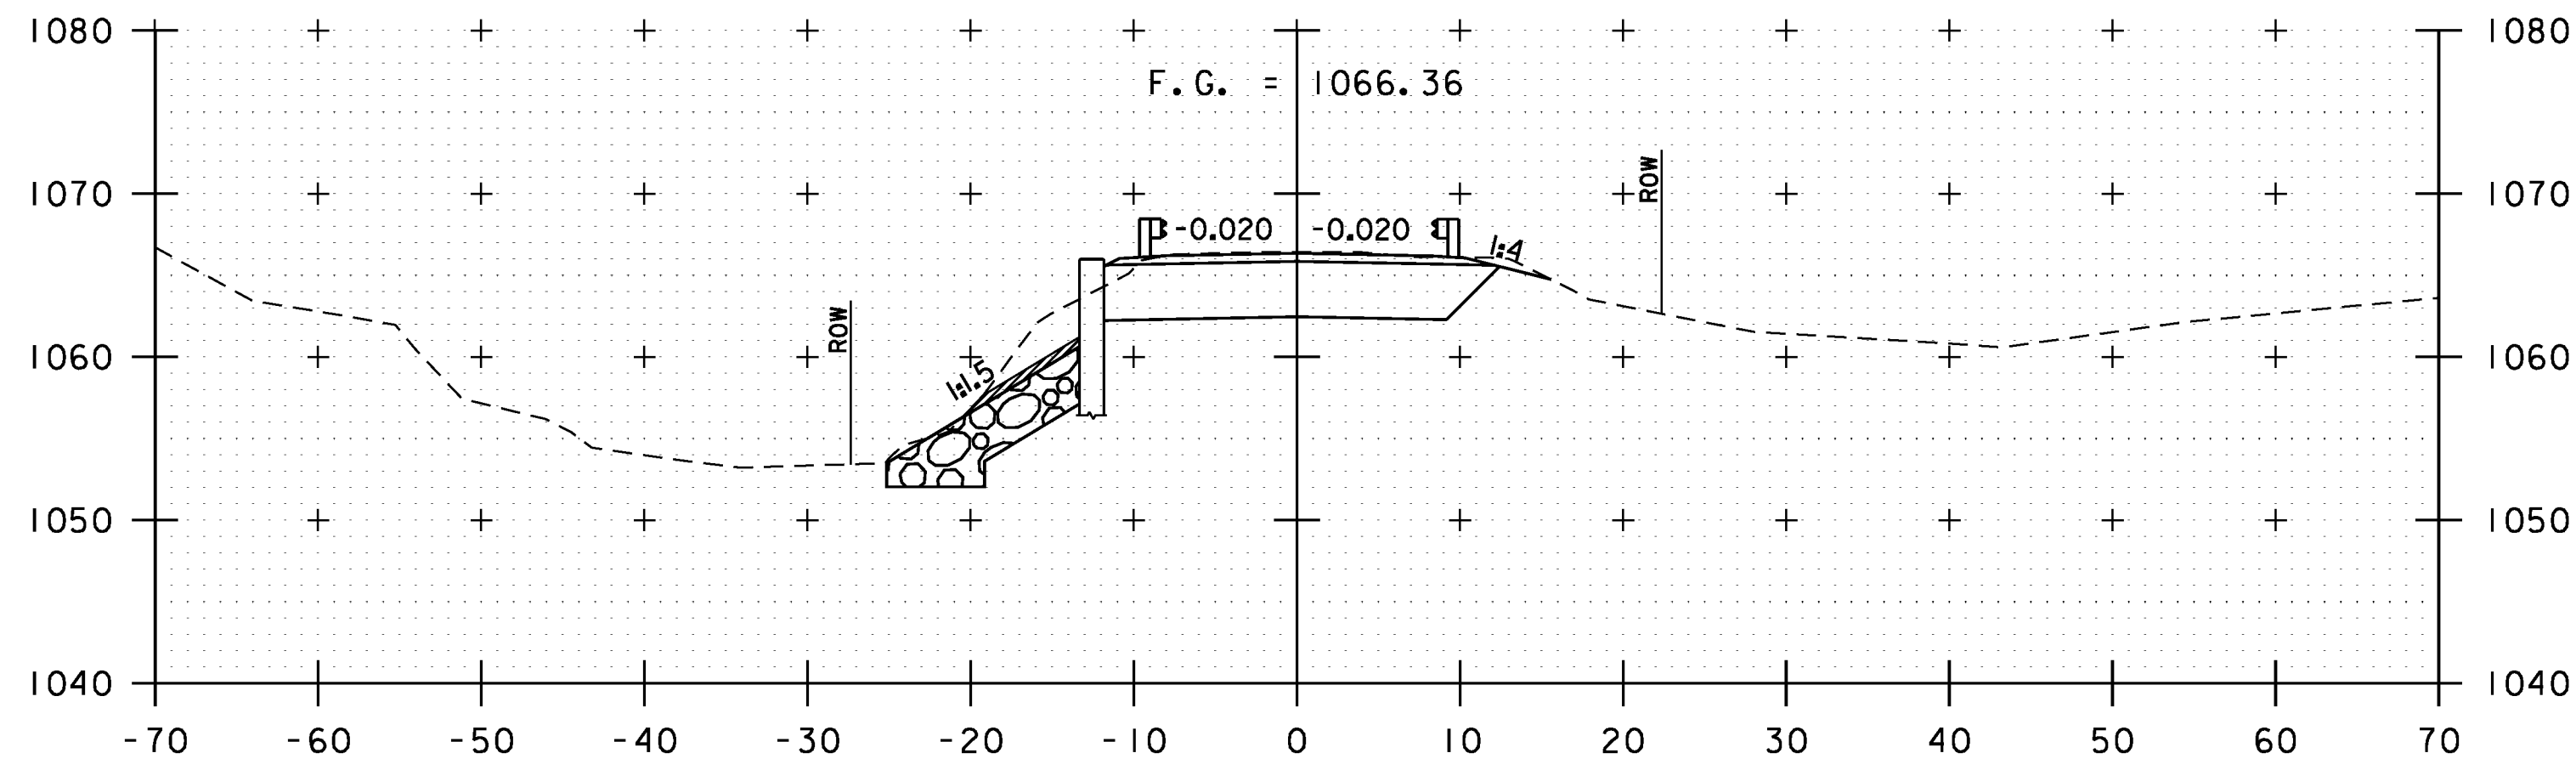


102+50

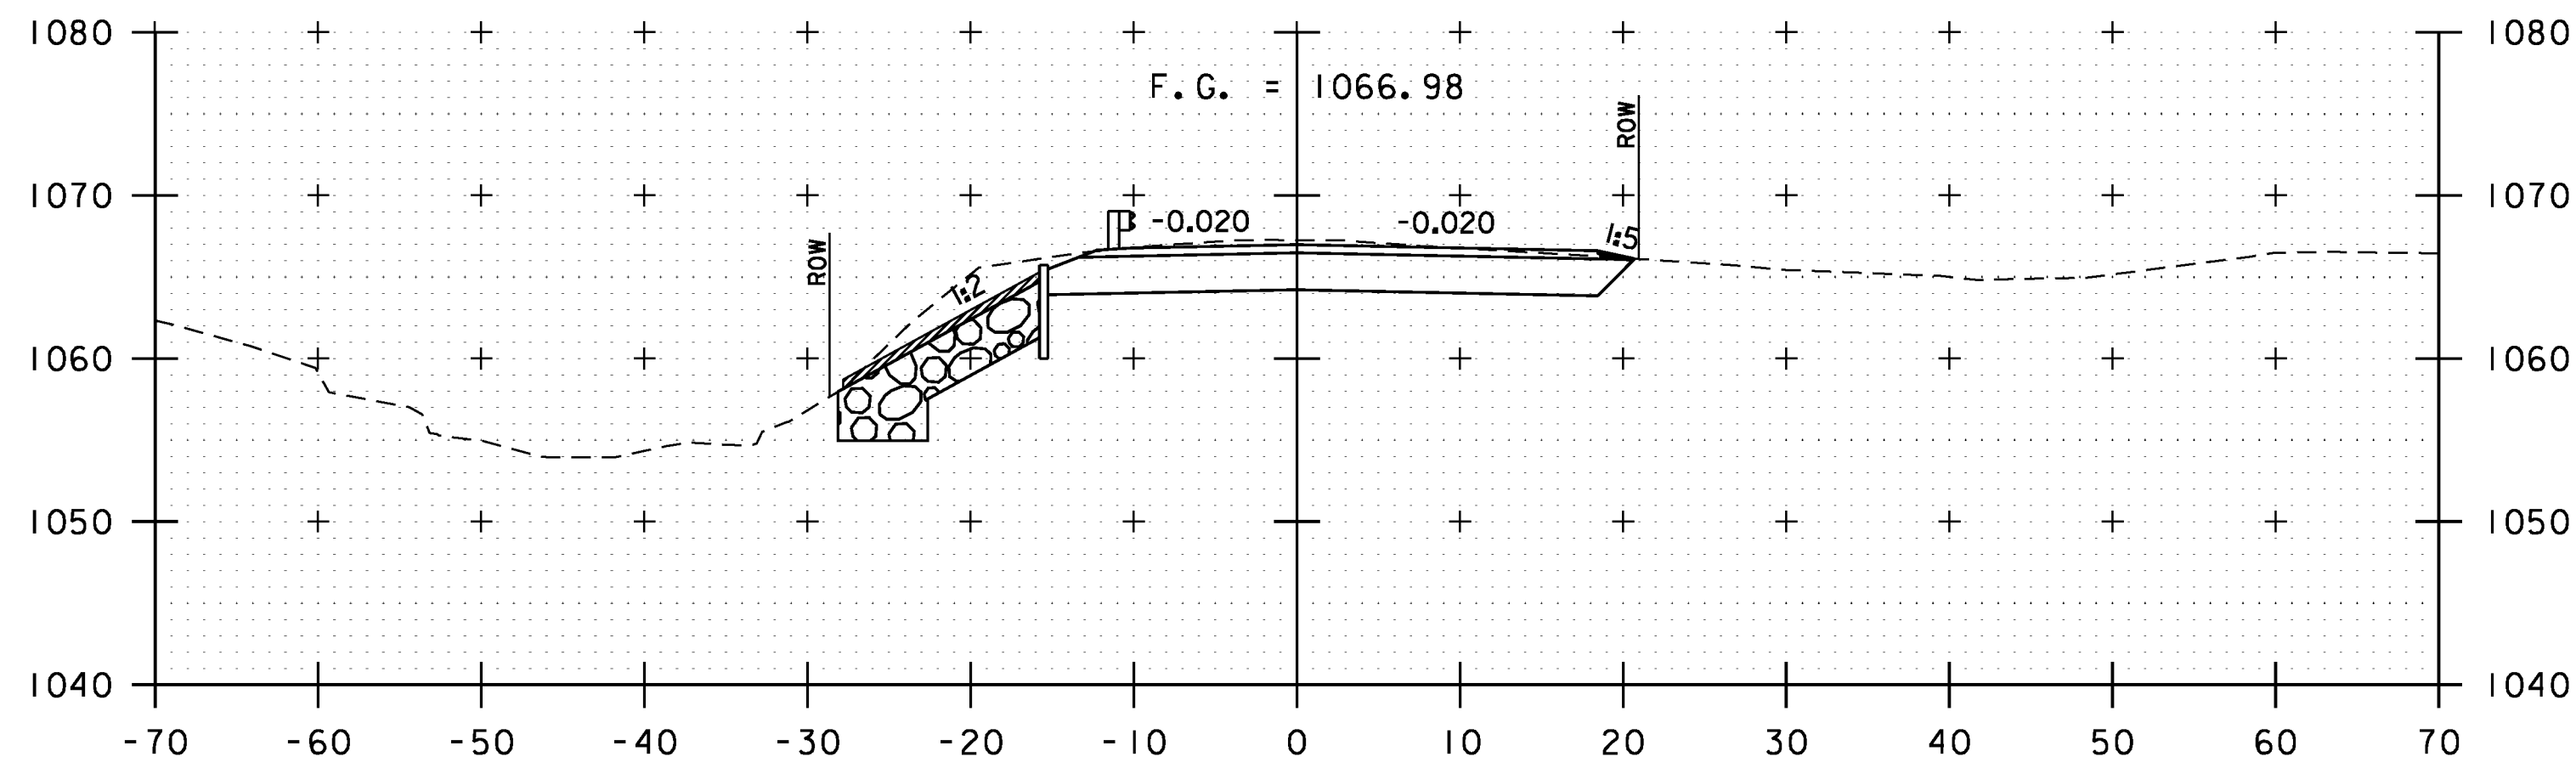


102+25

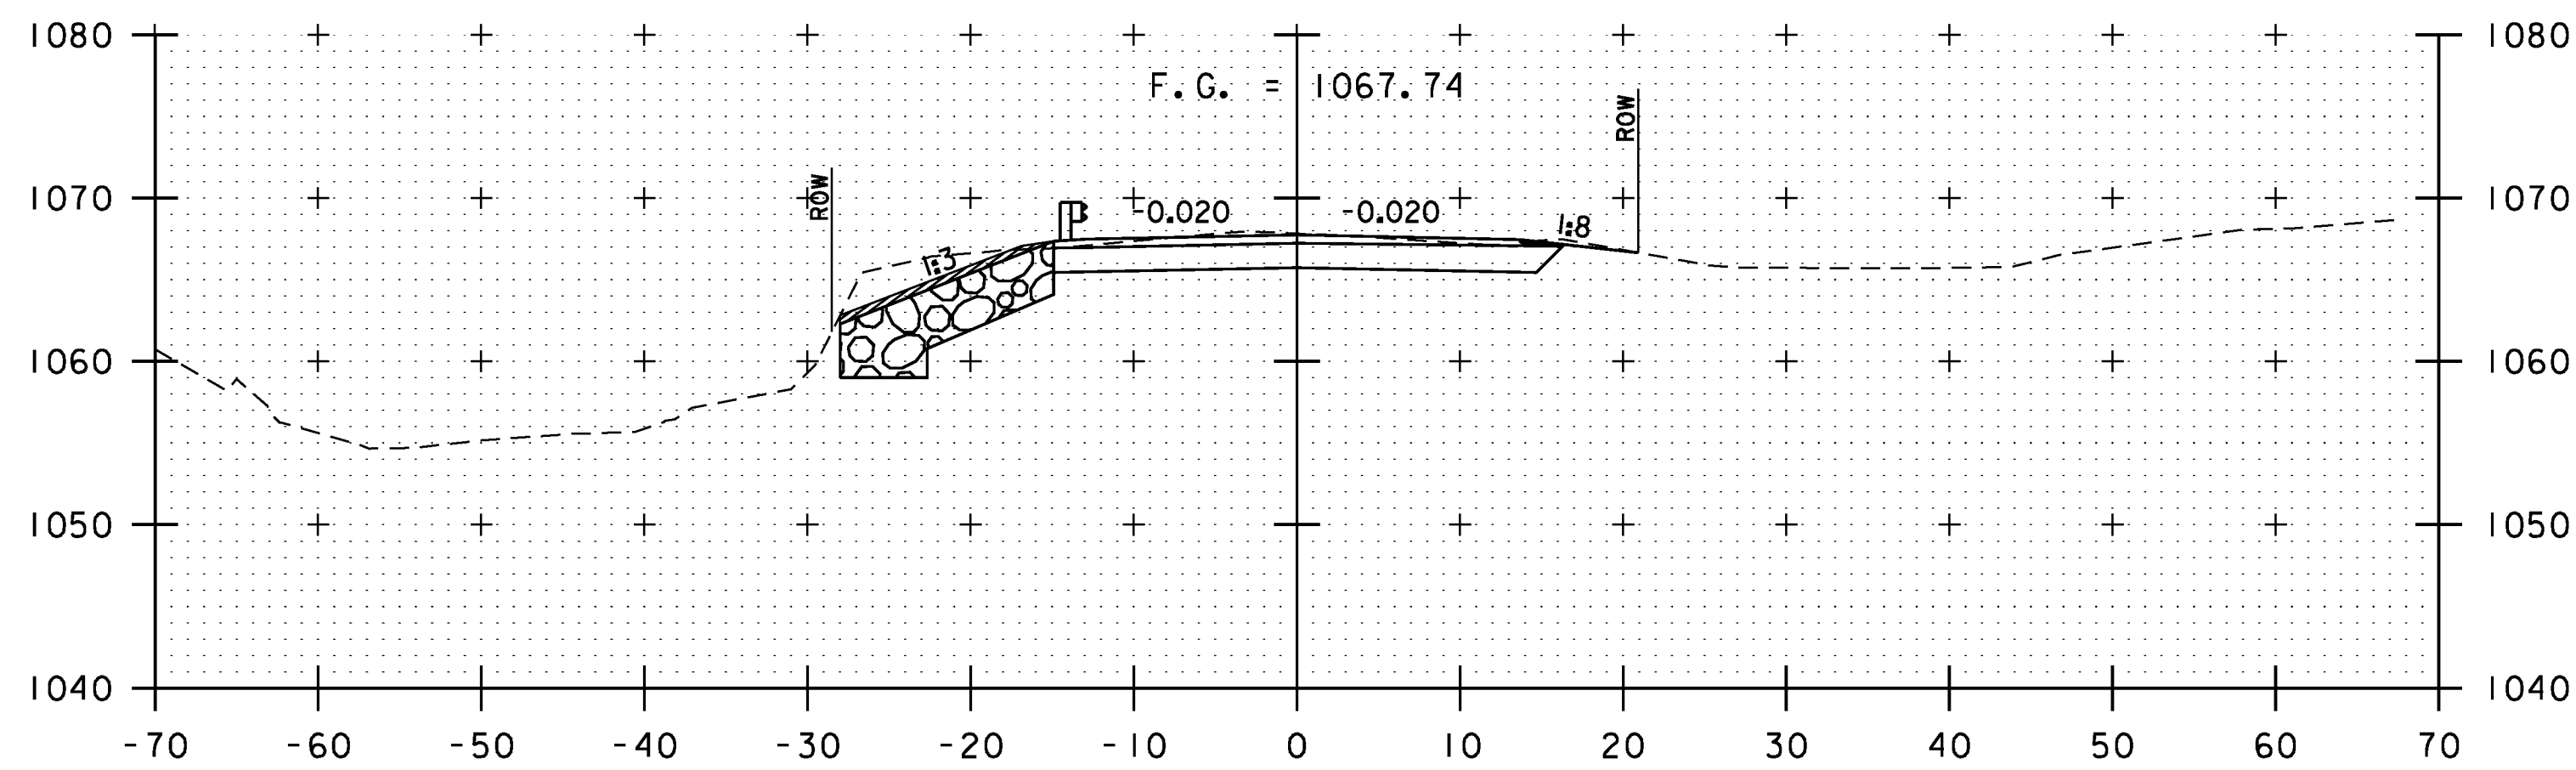

102+00

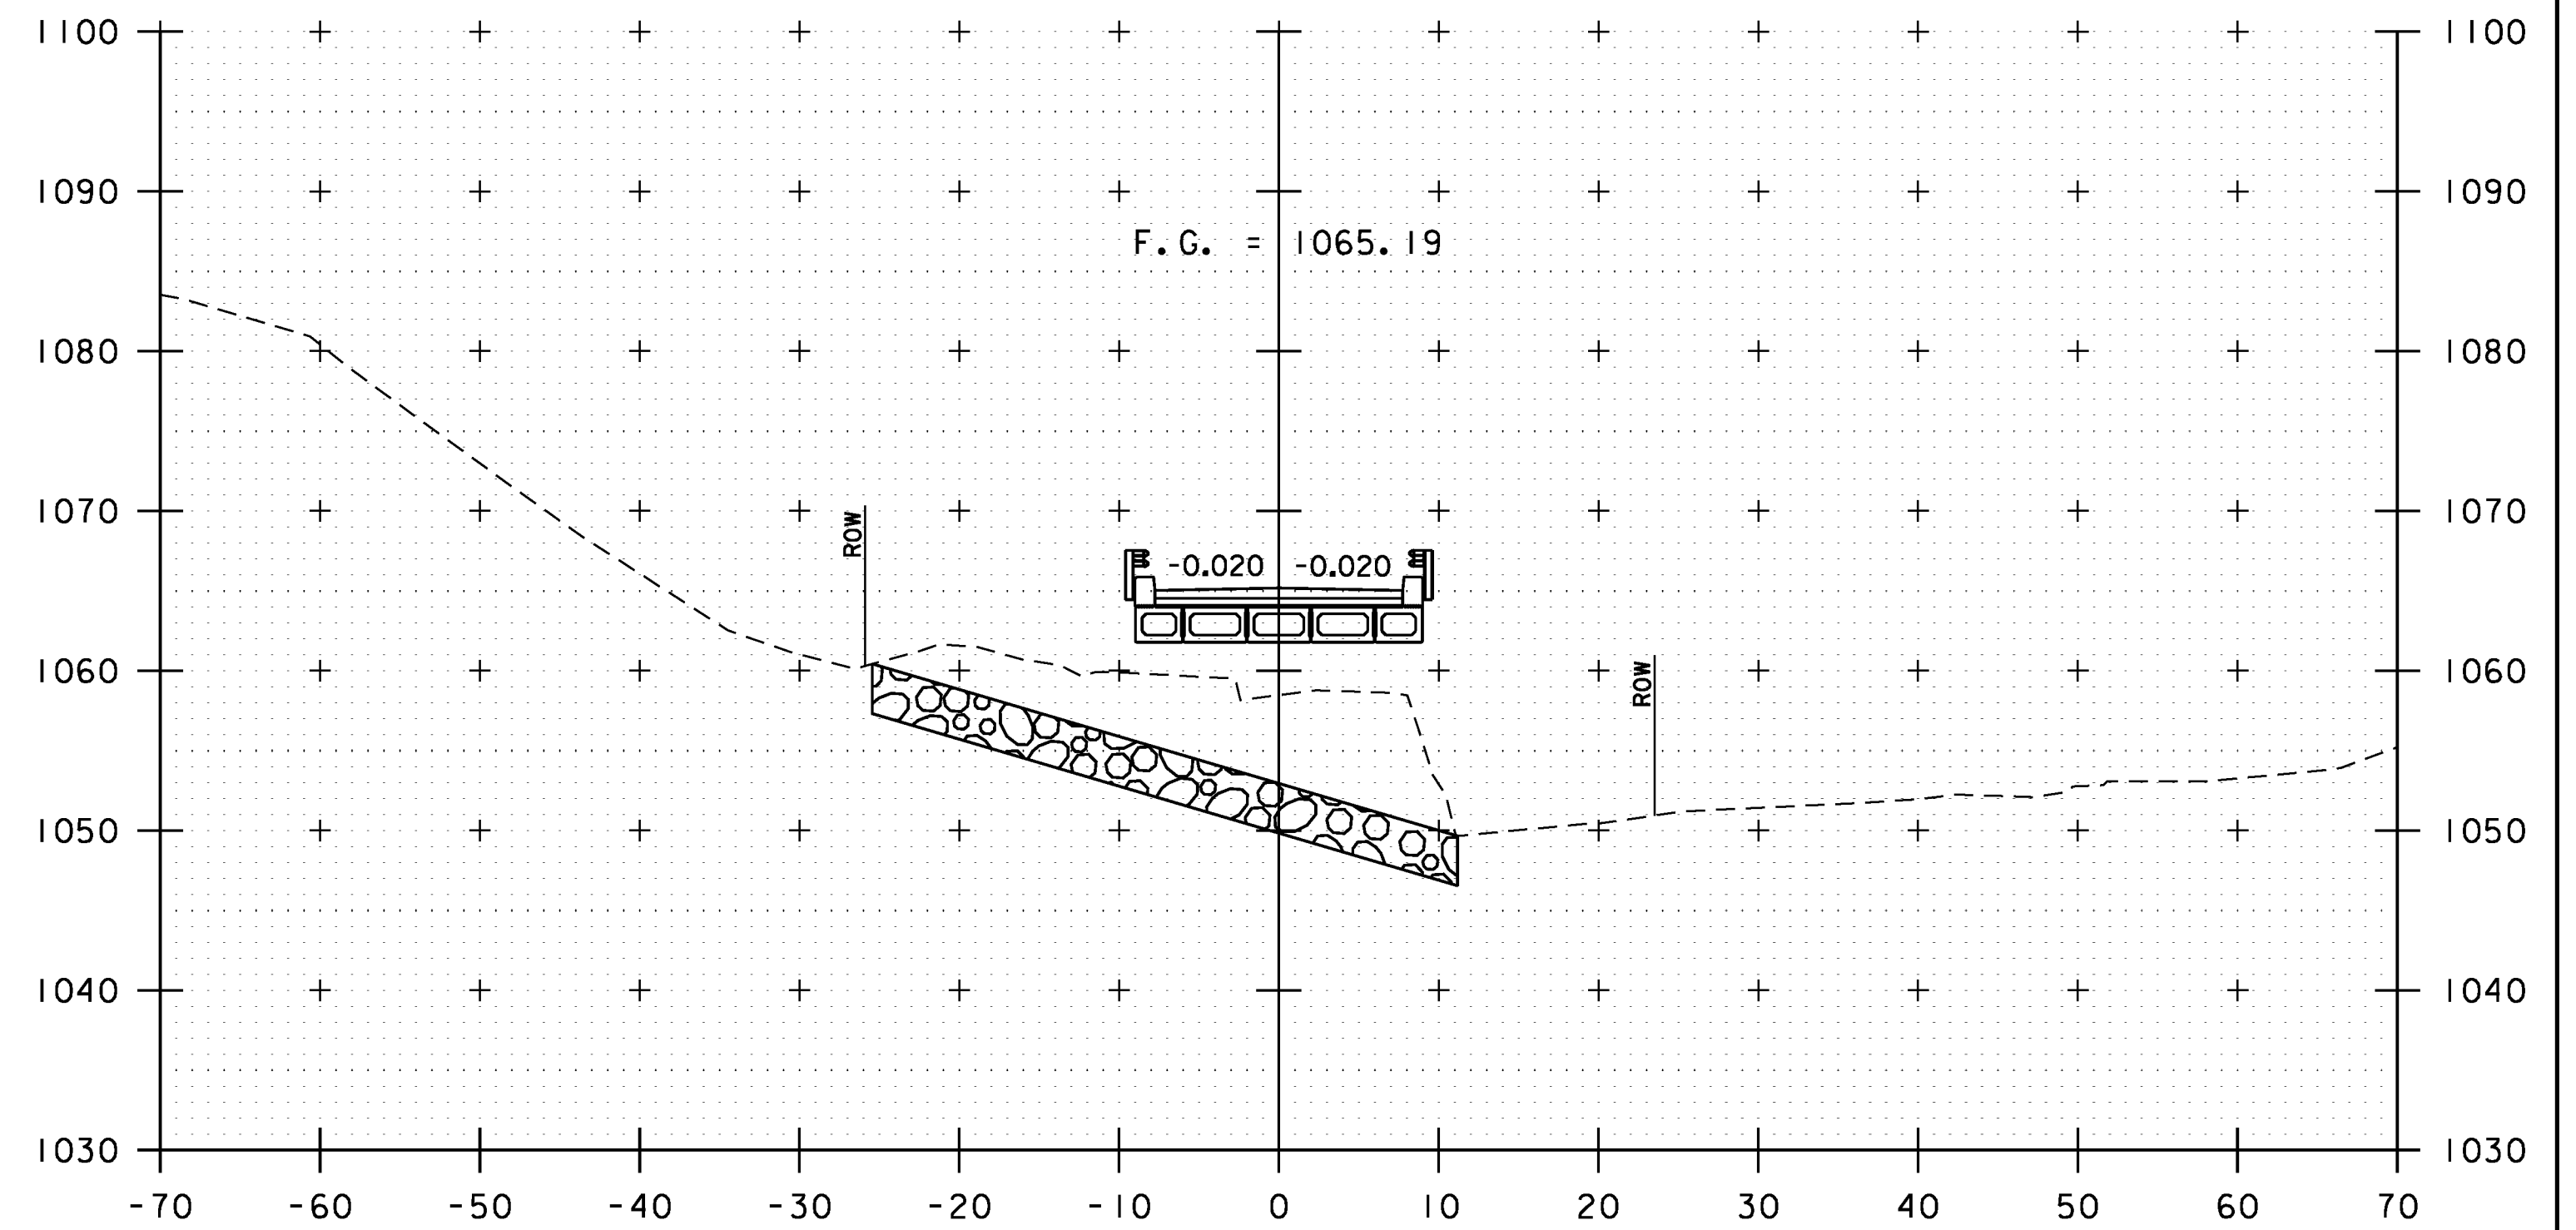

103+00

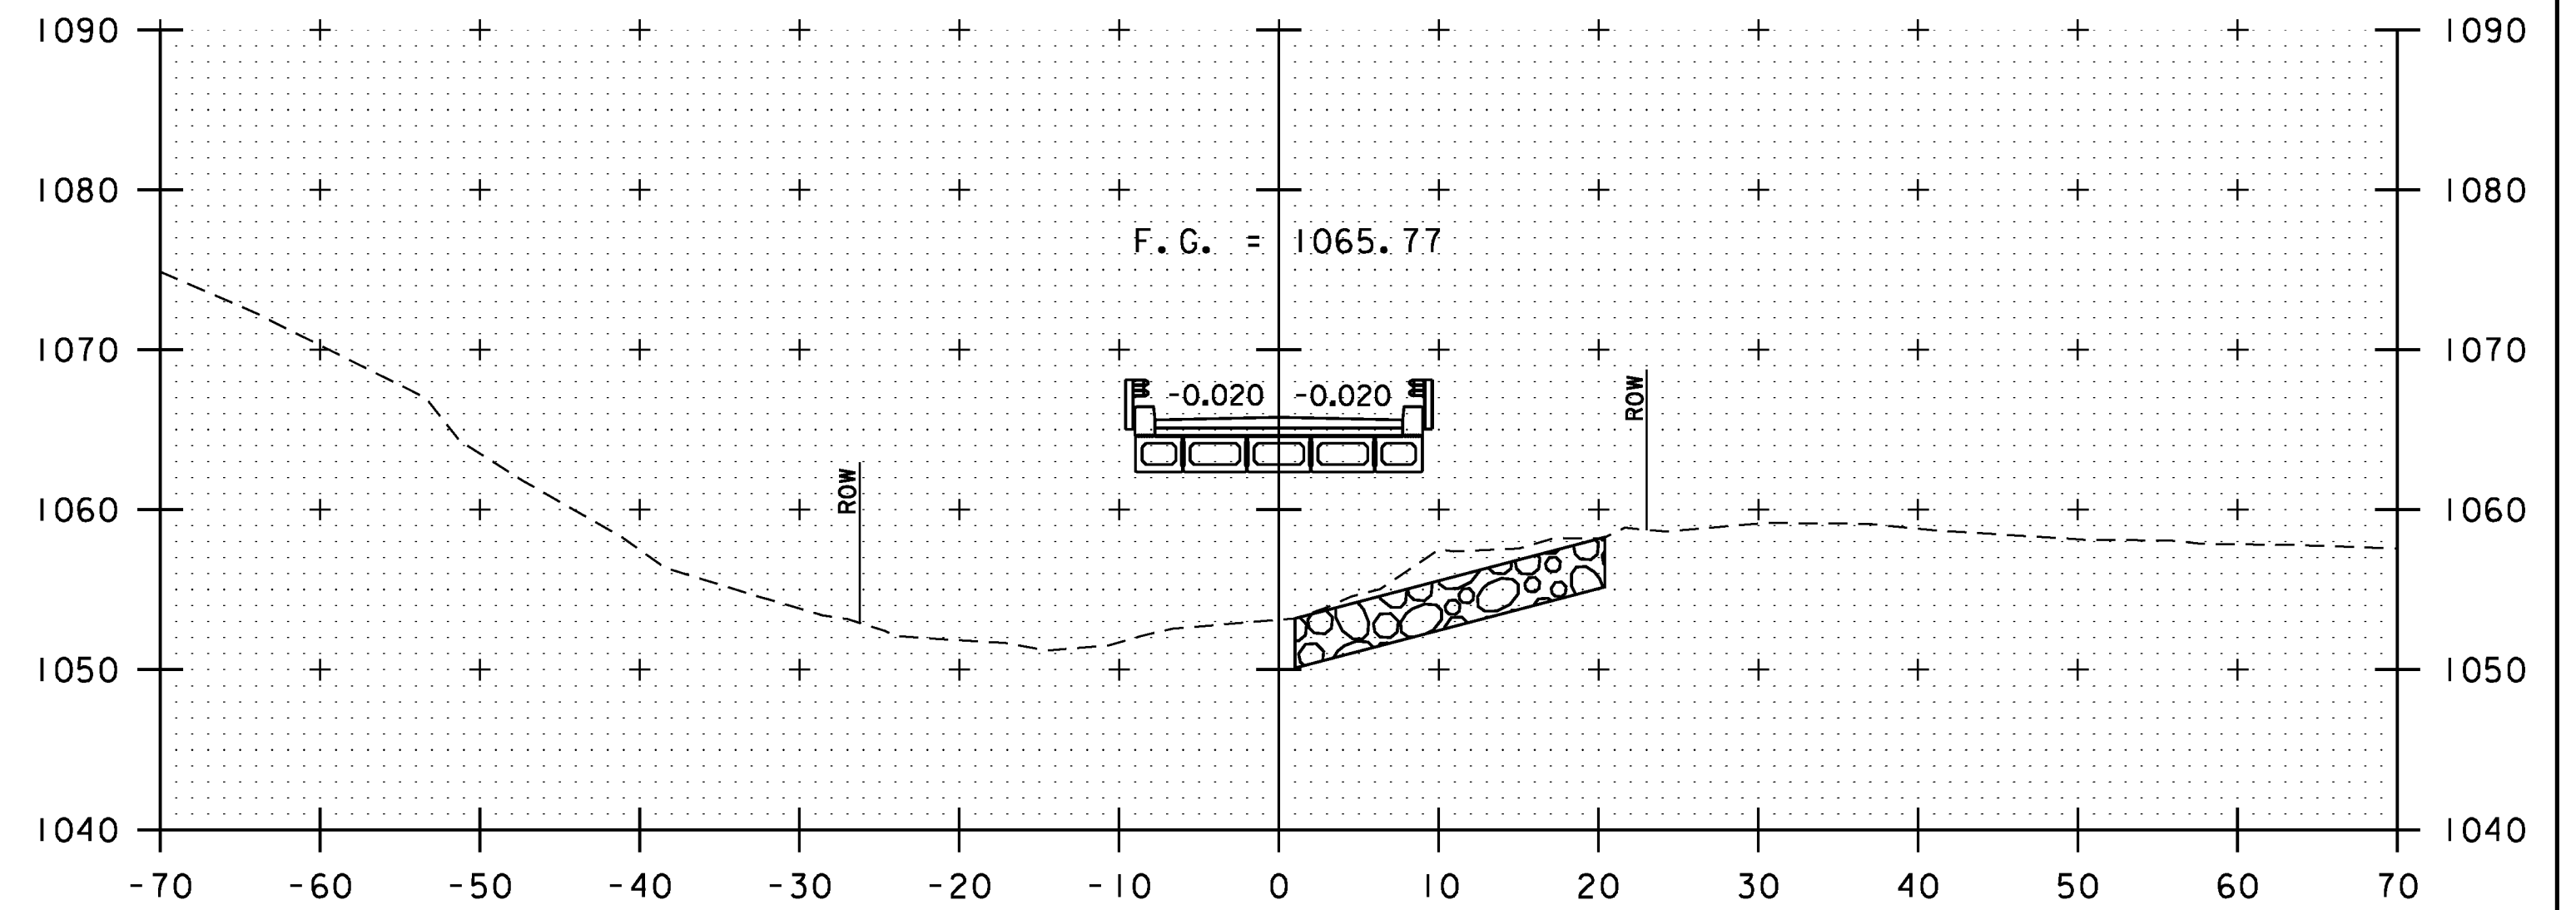

102+75

BEGIN BRIDGE  
STA 102+57.00


ROADWAY CROSS SECTIONS  
SCALE 1"=10'-0"  
STA. 102+00 TO STA. 103+00




PROJECT NAME: GUILFORD  
PROJECT NUMBER: BRO 1442(36)

FILE NAME: z10j064xsl.dgn  
PROJECT LEADER: S.E. BURBANK  
DESIGNED BY: E.A. FIALA  
ROADWAY CROSS SECTIONS (2 OF 3)


PLOT DATE: 10/2/2013  
DRAWN BY: E.A. FIALA  
CHECKED BY: S.E. BURBANK  
SHEET 31 OF 42

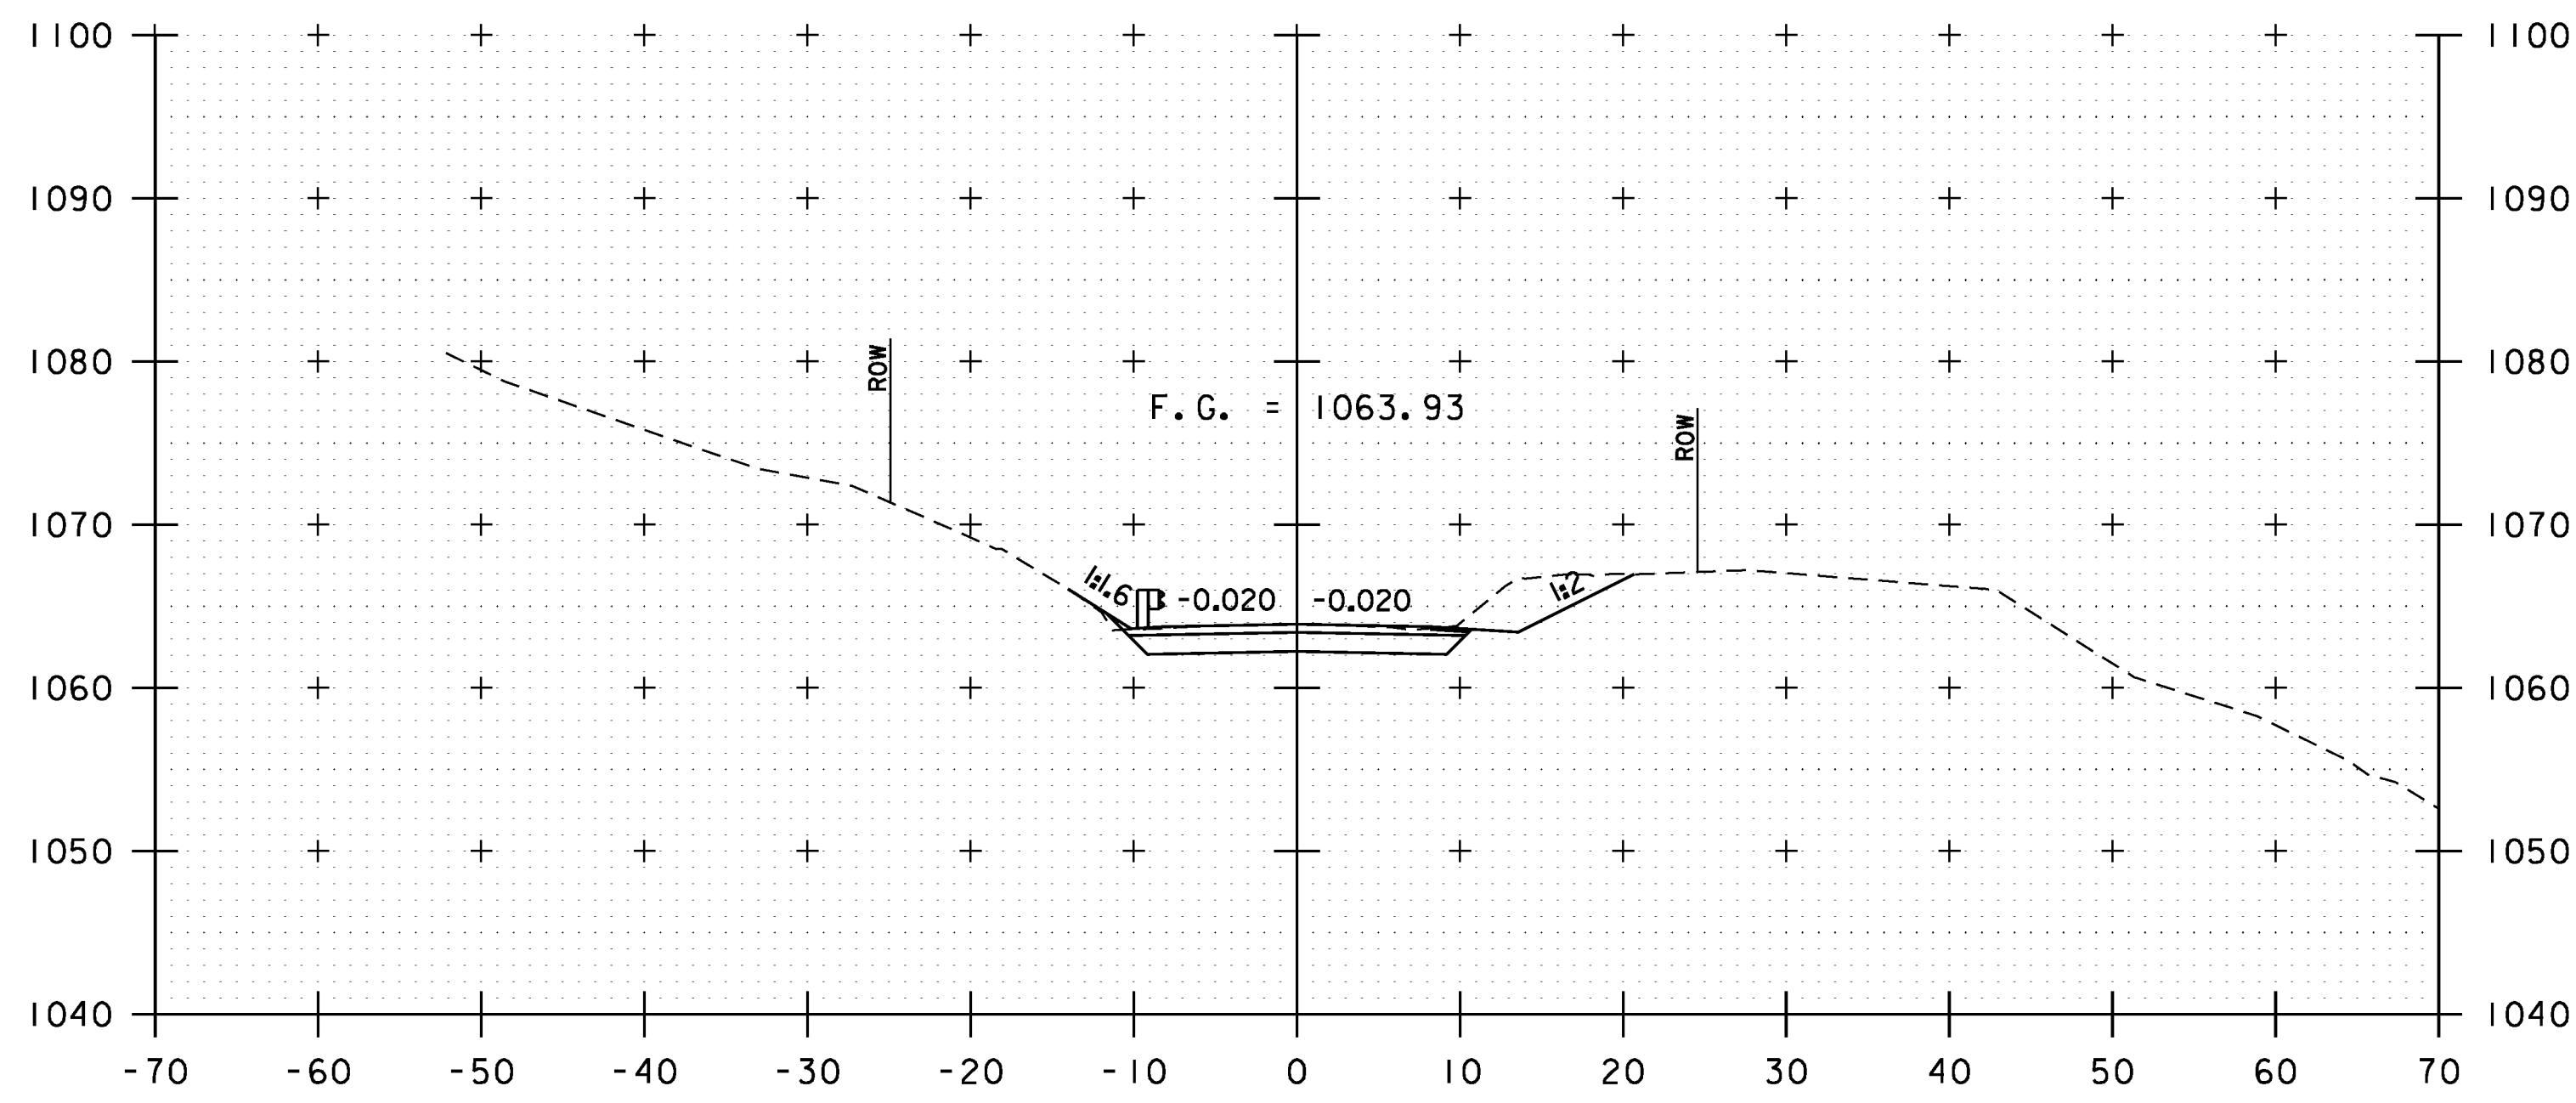


103+50

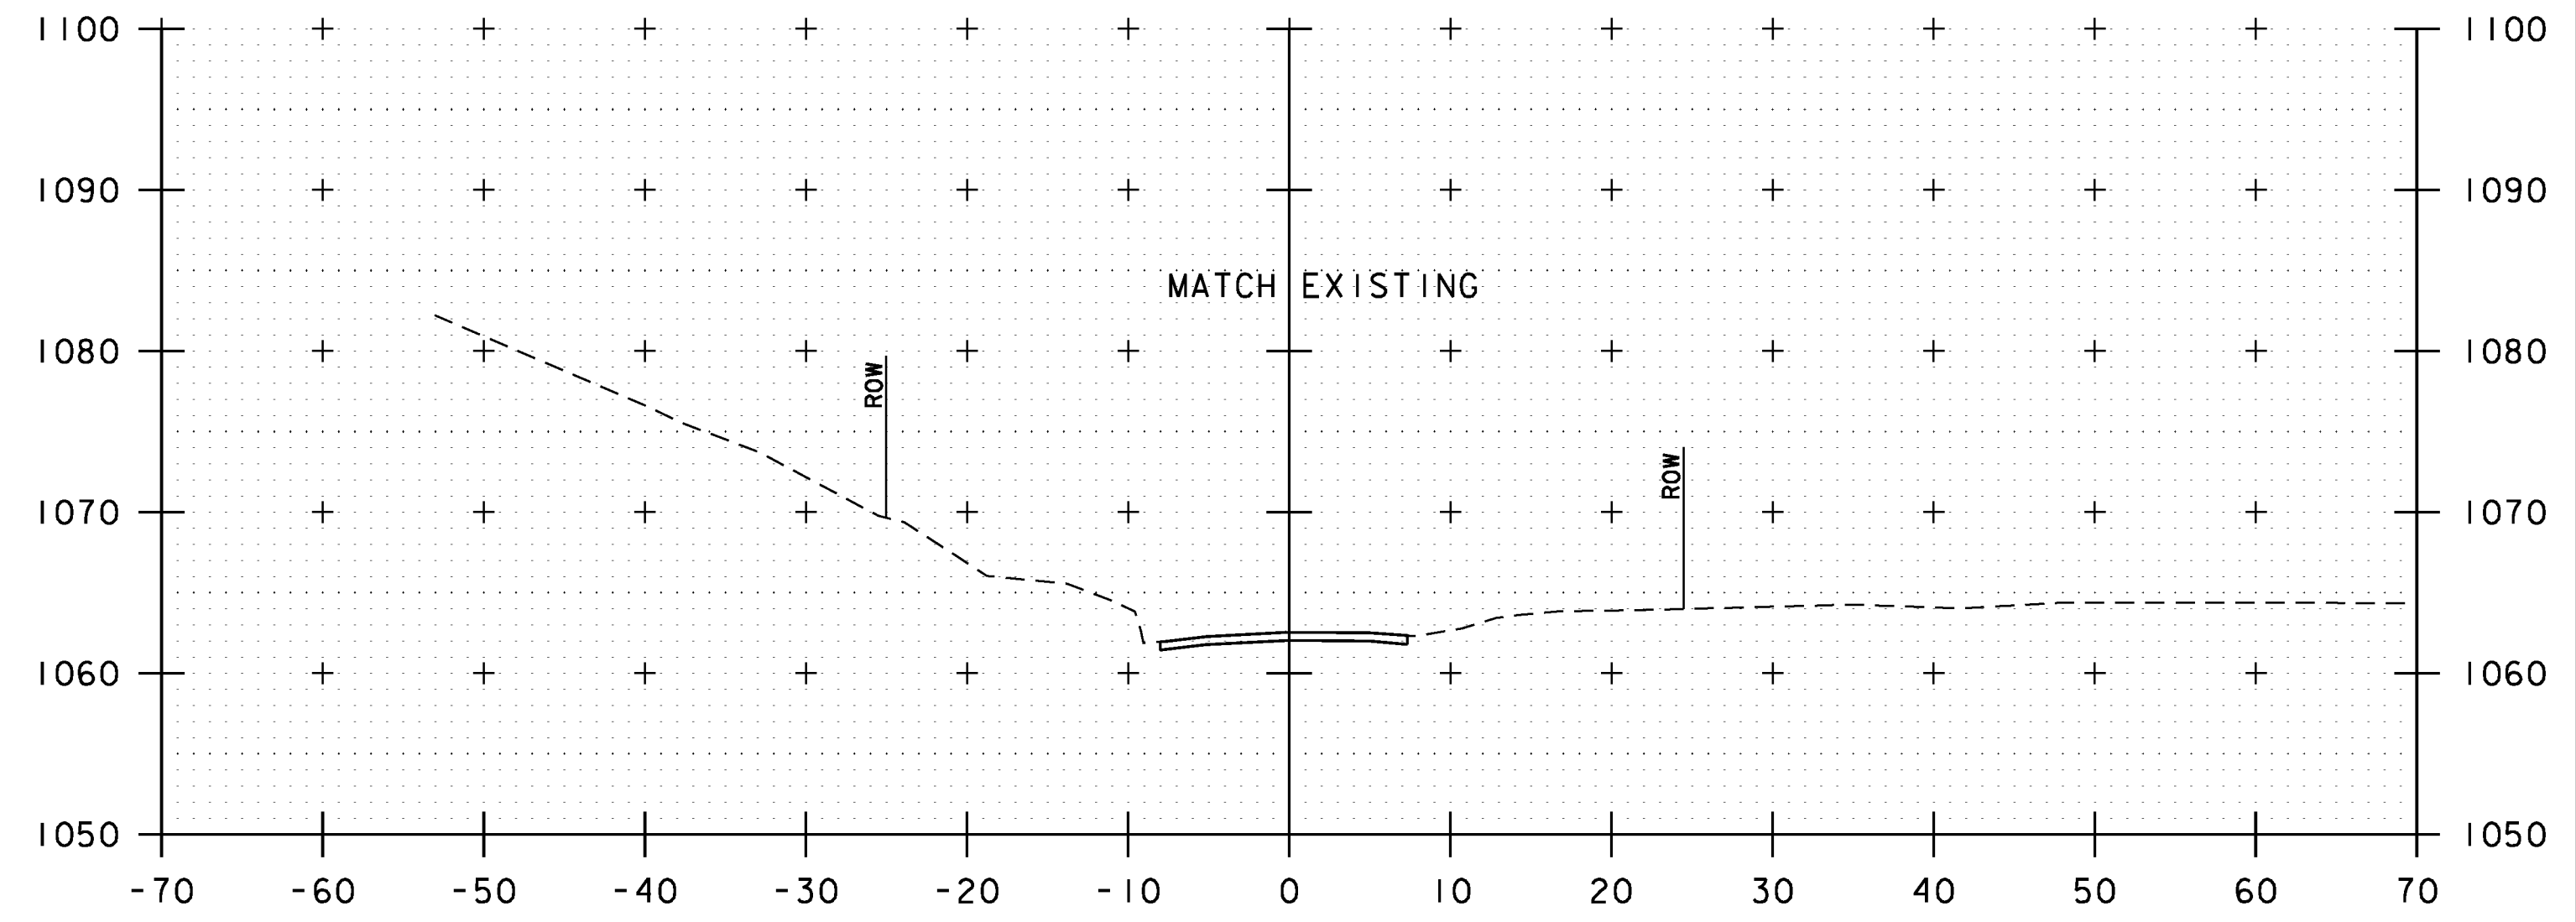

103+90  
END APPROACH  
STA 103+90.00

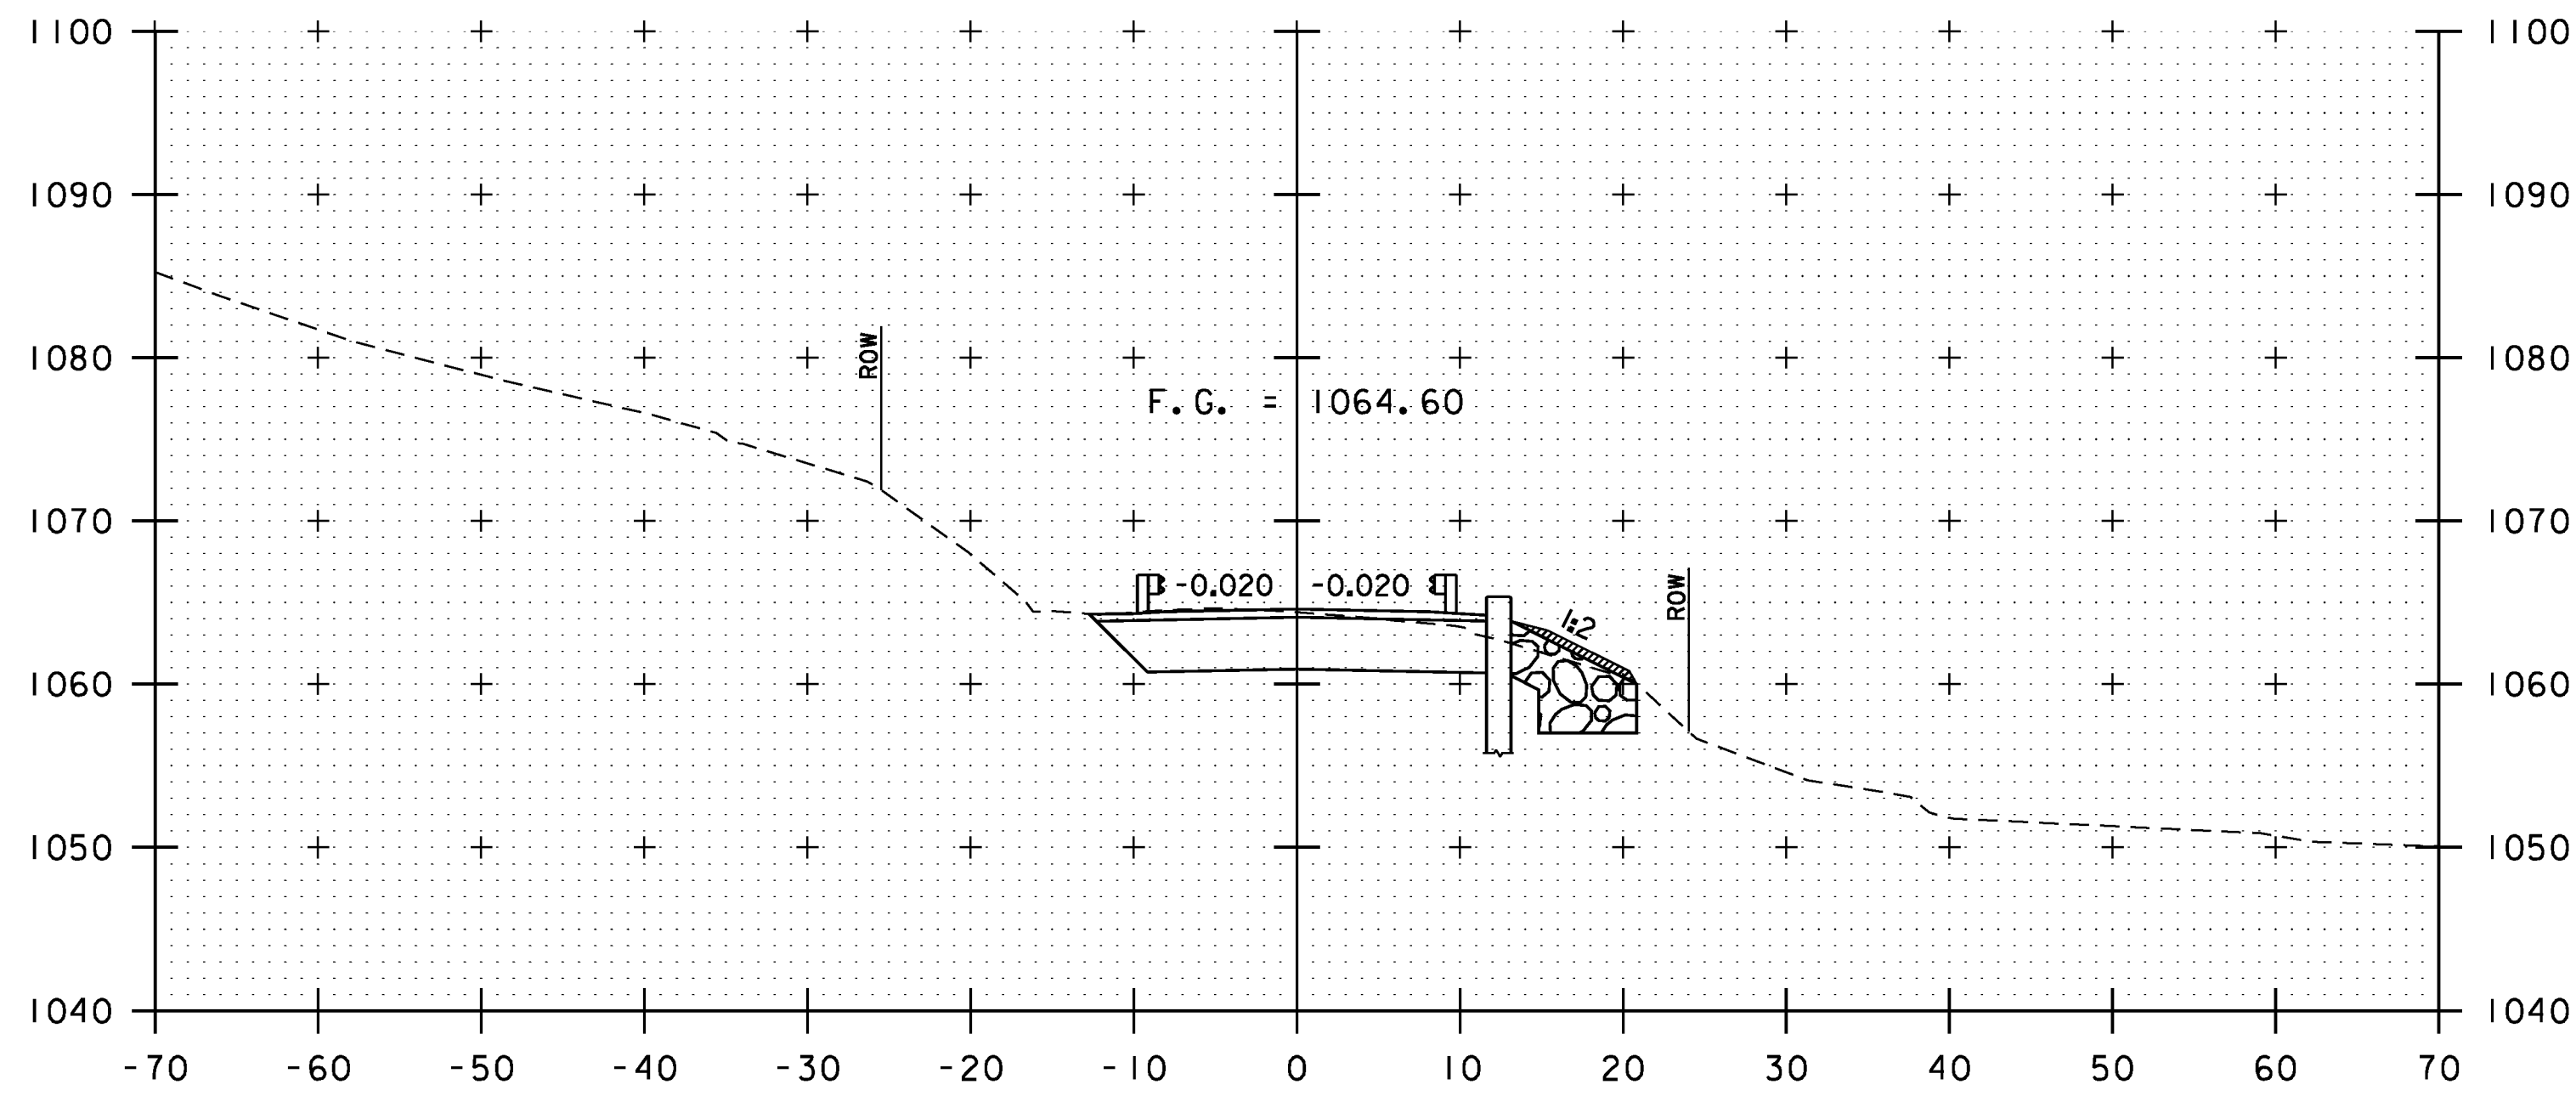

103+25  
END BRIDGE  
STA 103+15.19

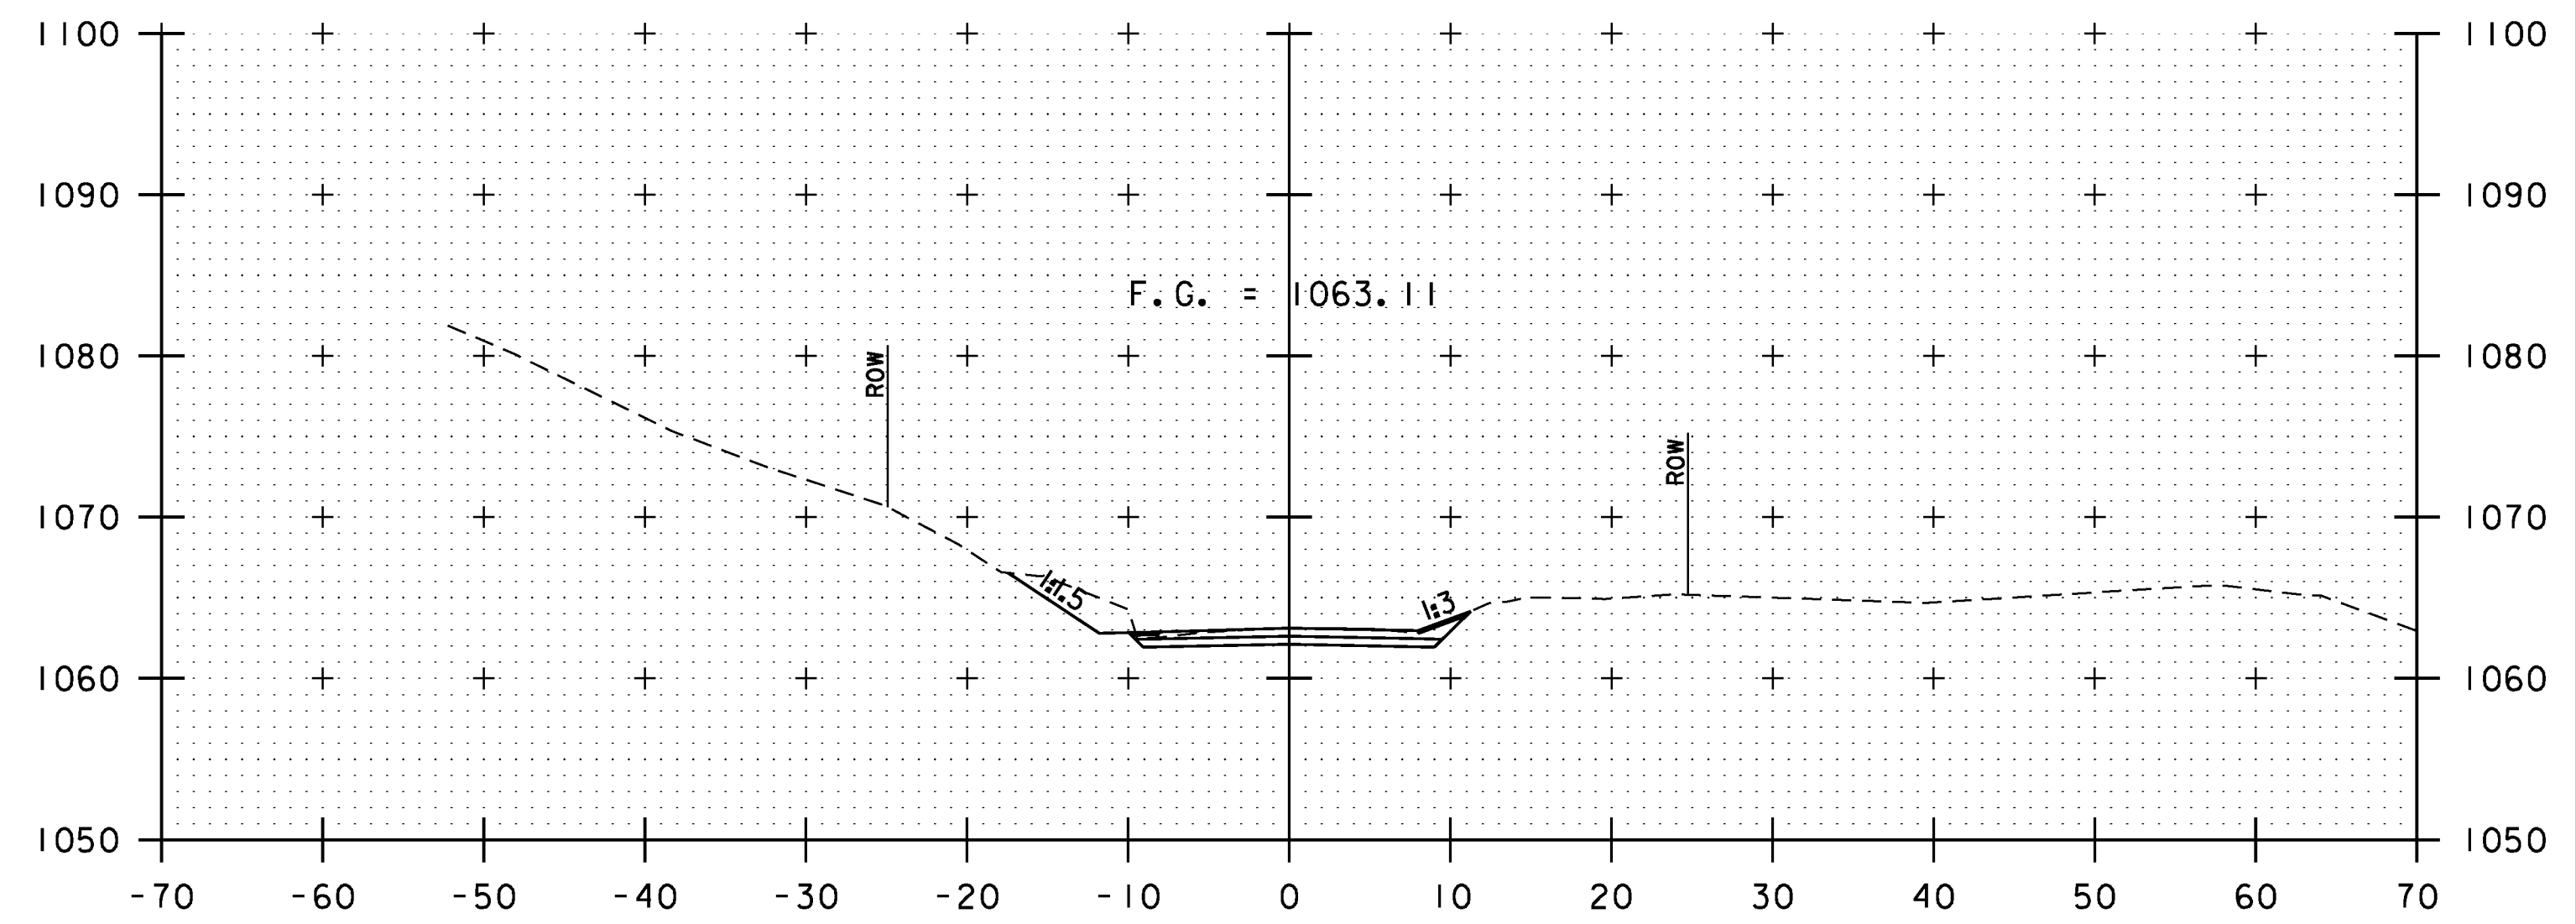


103+75  
END PROJECT  
STA 103+65.19


ROADWAY CROSS SECTIONS  
SCALE 1"=10'-0"  
STA. 103+25 TO STA. 103+90

PROJECT NAME: GUILFORD	
PROJECT NUMBER: BRO 1442(36)	
FILE NAME: z10j064xsl.dgn	PLOT DATE: 10/8/2013
PROJECT LEADER: S.E. BURBANK	DRAWN BY: E.A. FIALA
DESIGNED BY: E.A. FIALA	CHECKED BY: S.E. BURBANK
ROADWAY CROSS SECTIONS (3 OF 3)	SHEET 32 OF 42




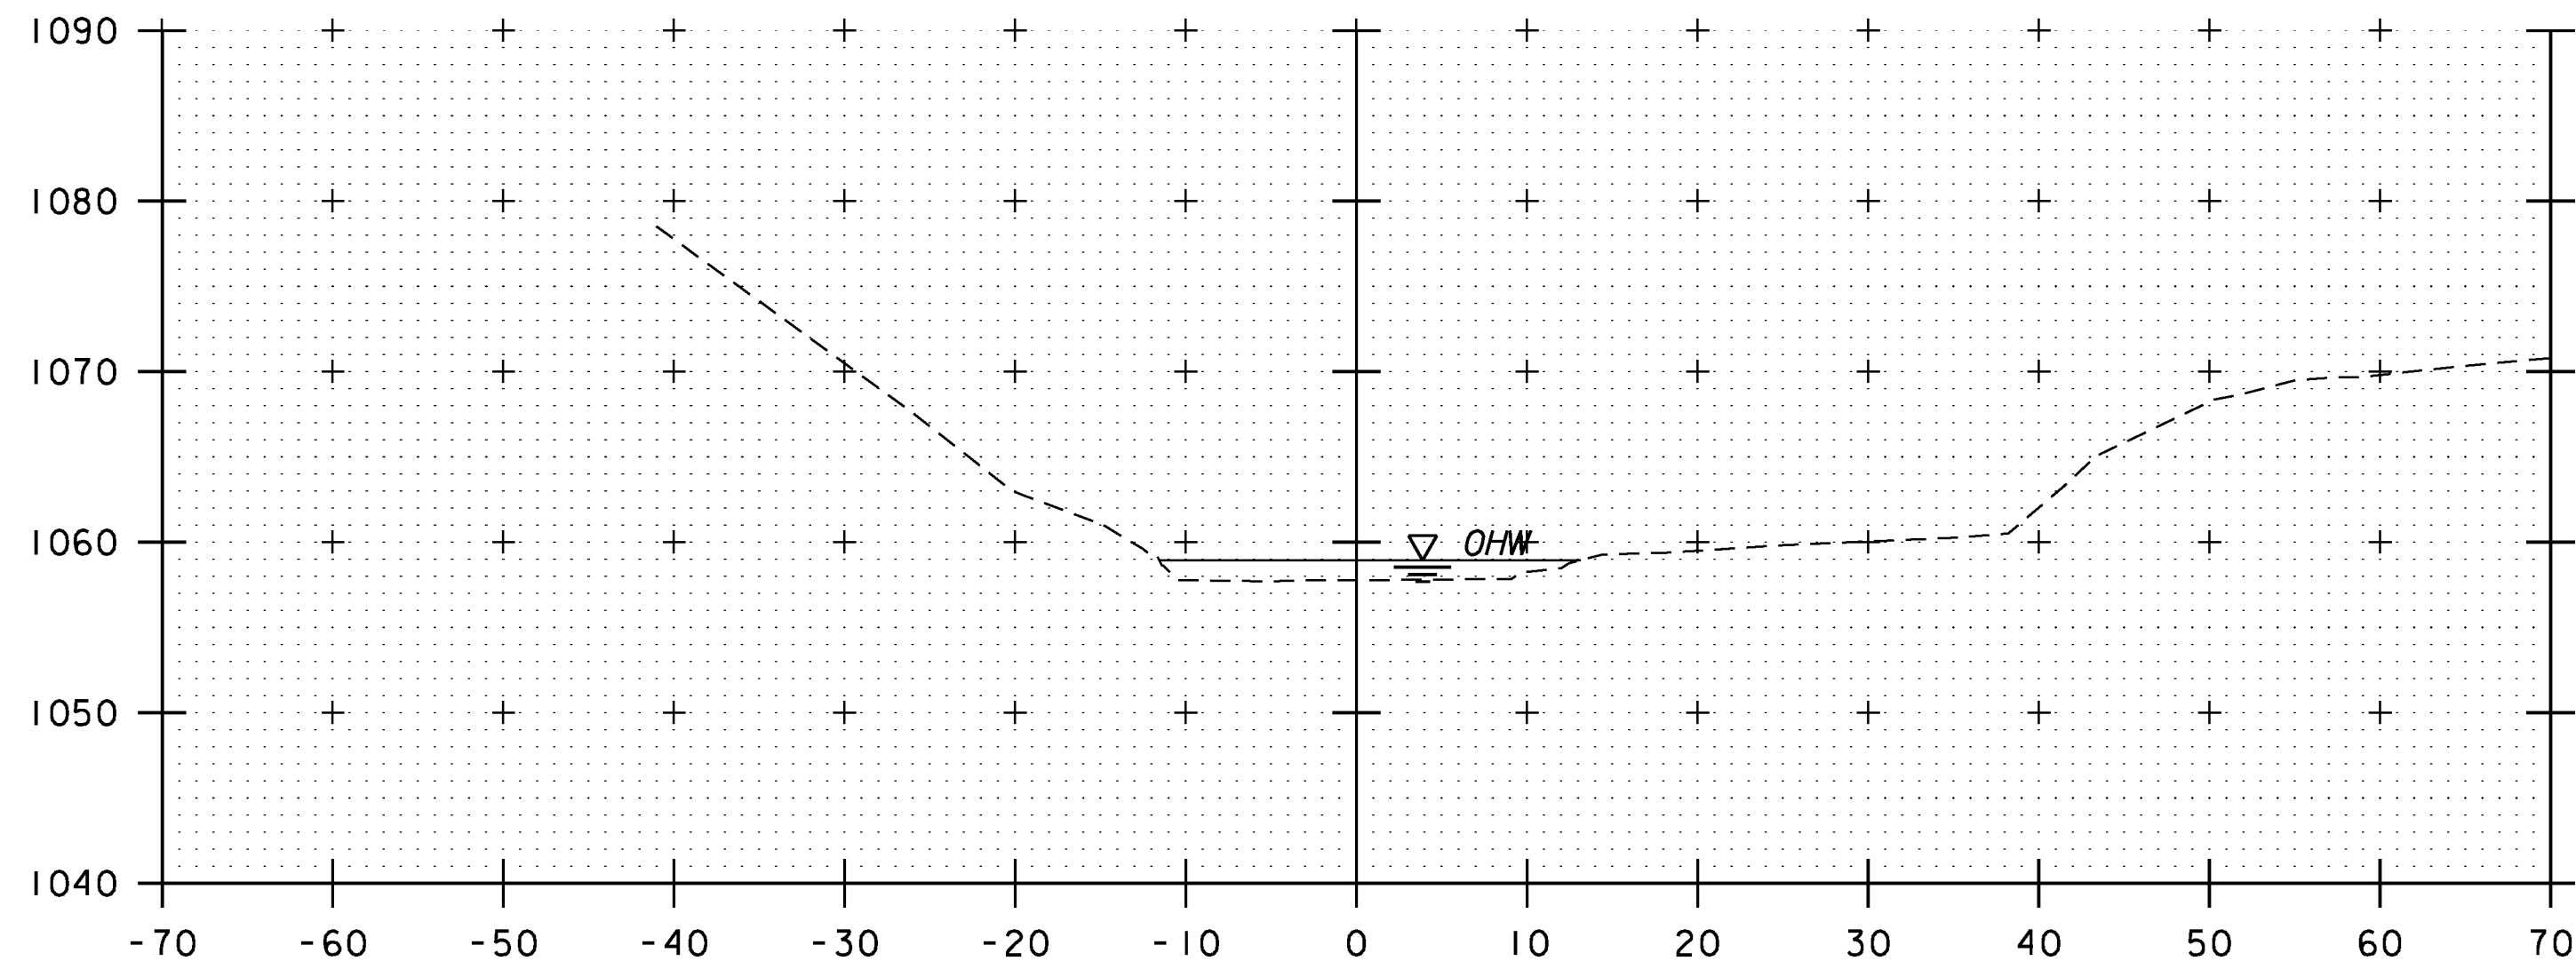


10+25

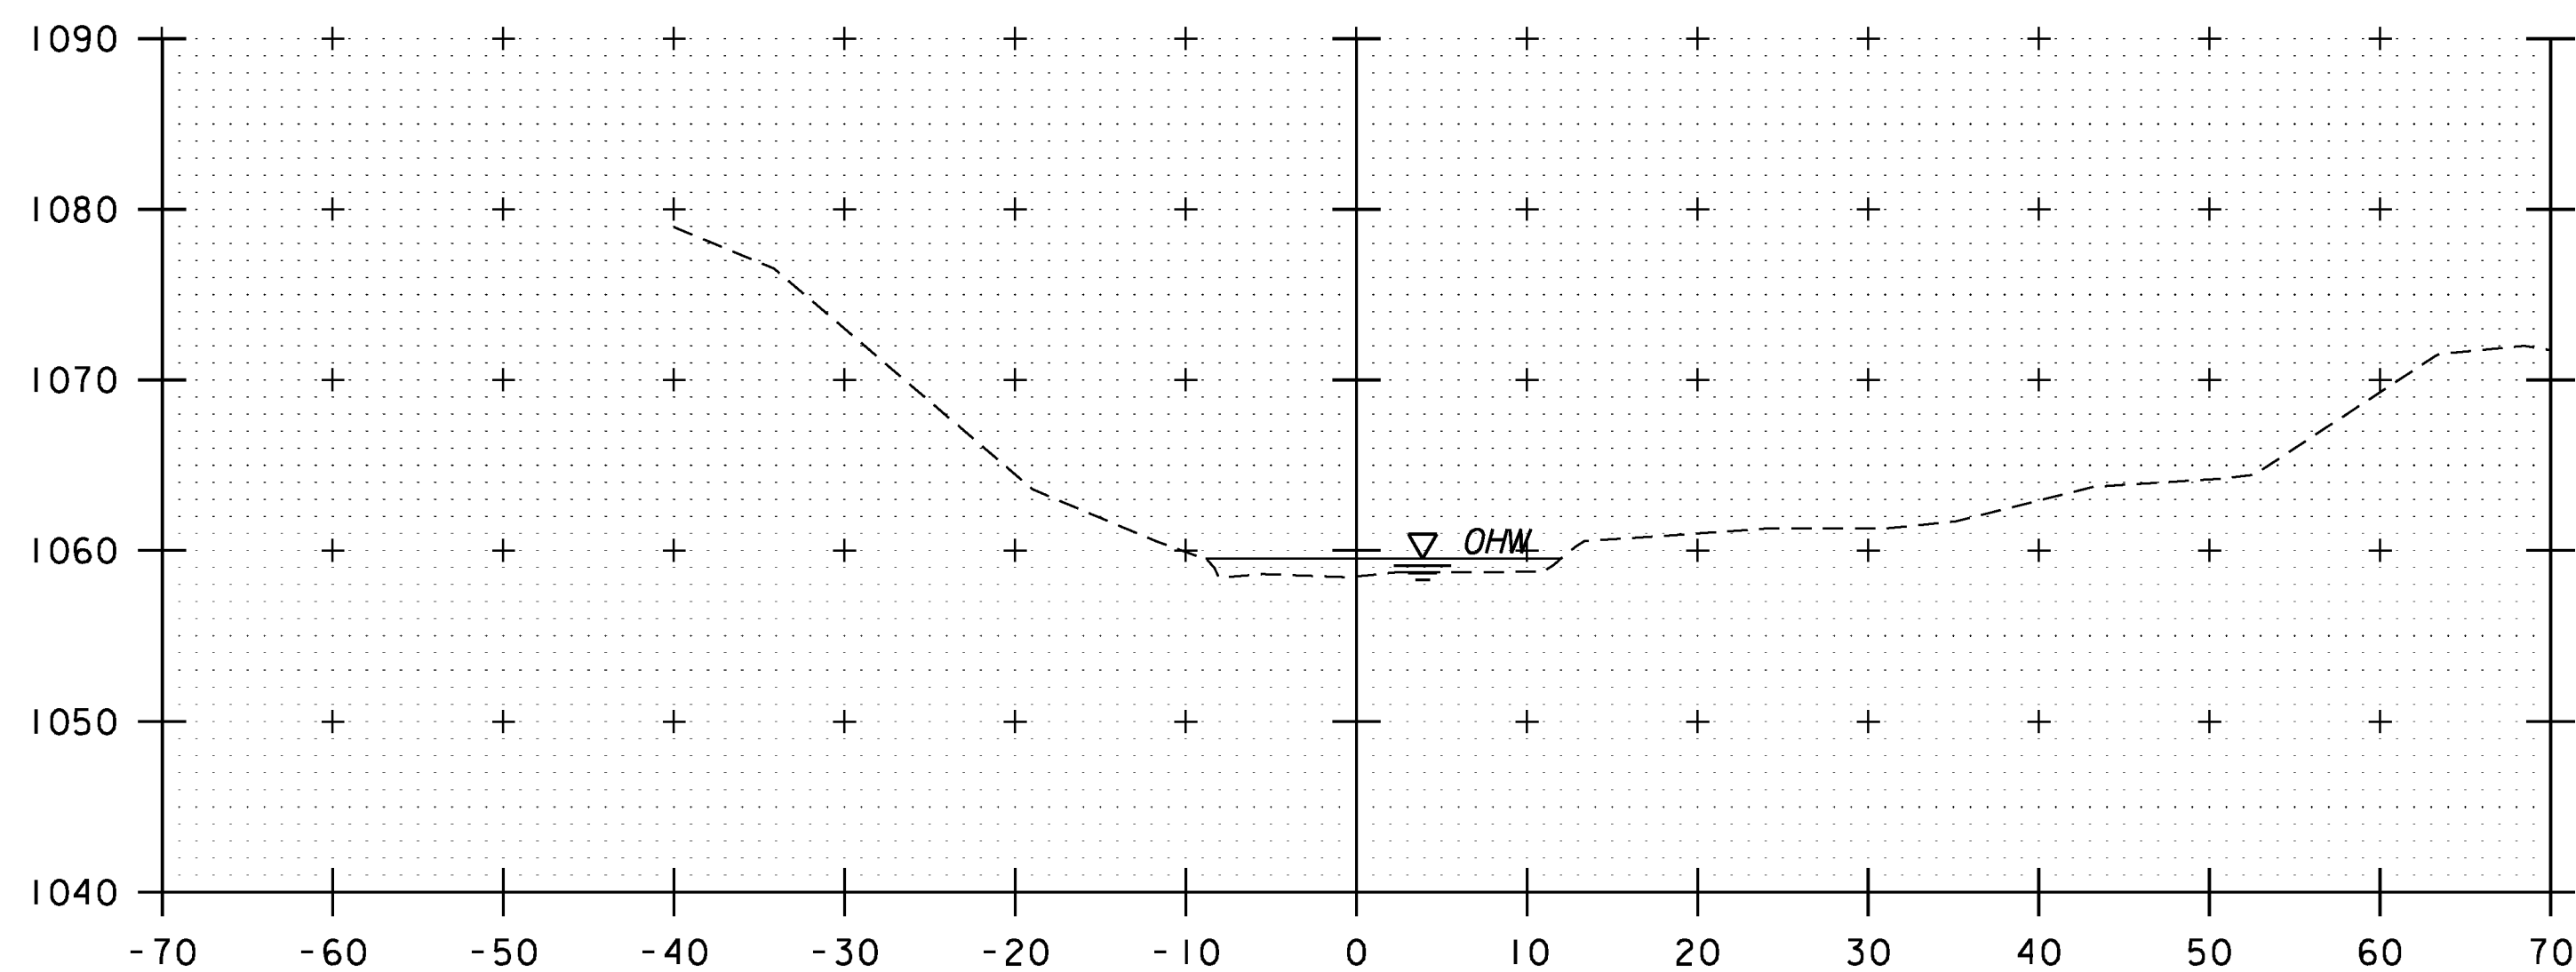

10+00

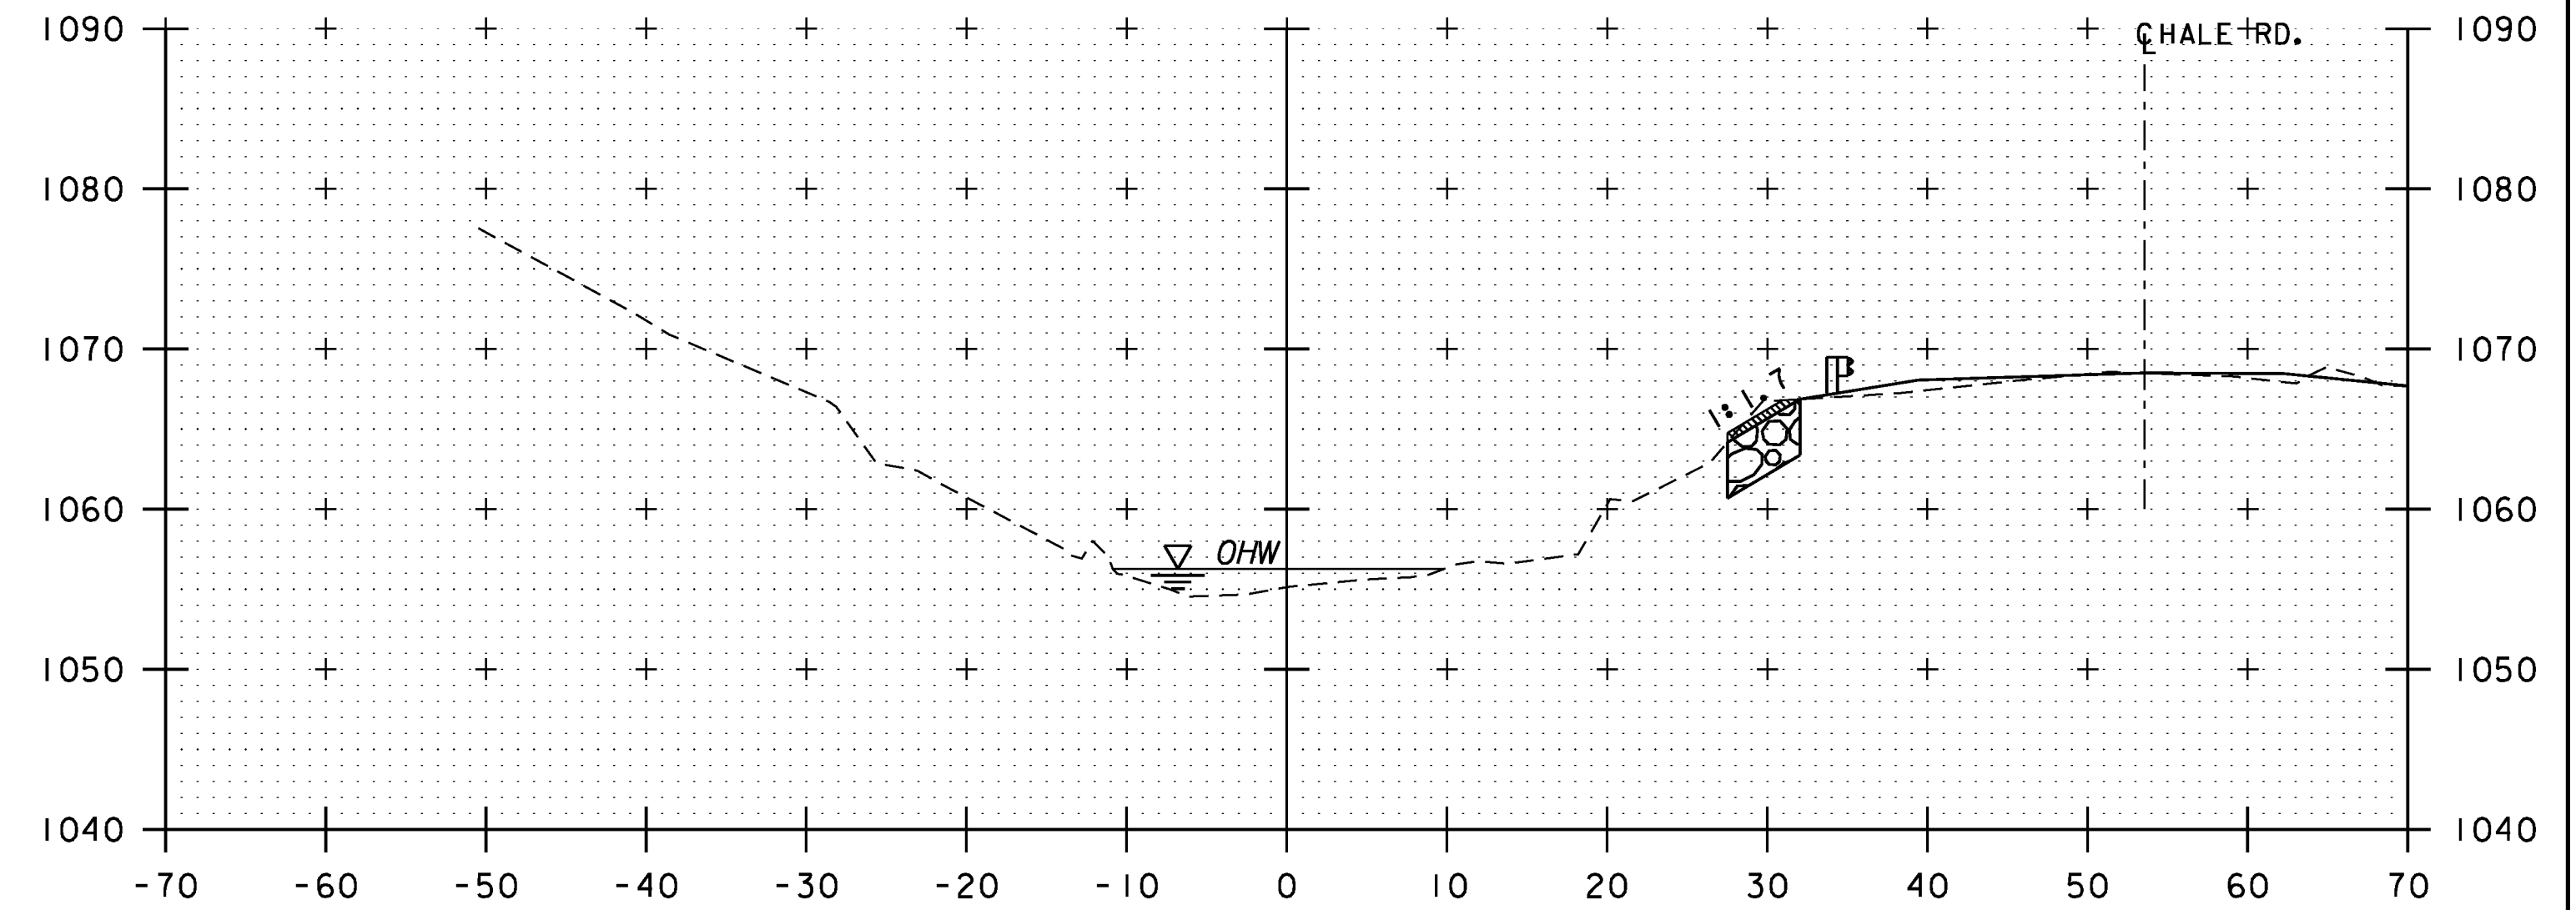

10+75

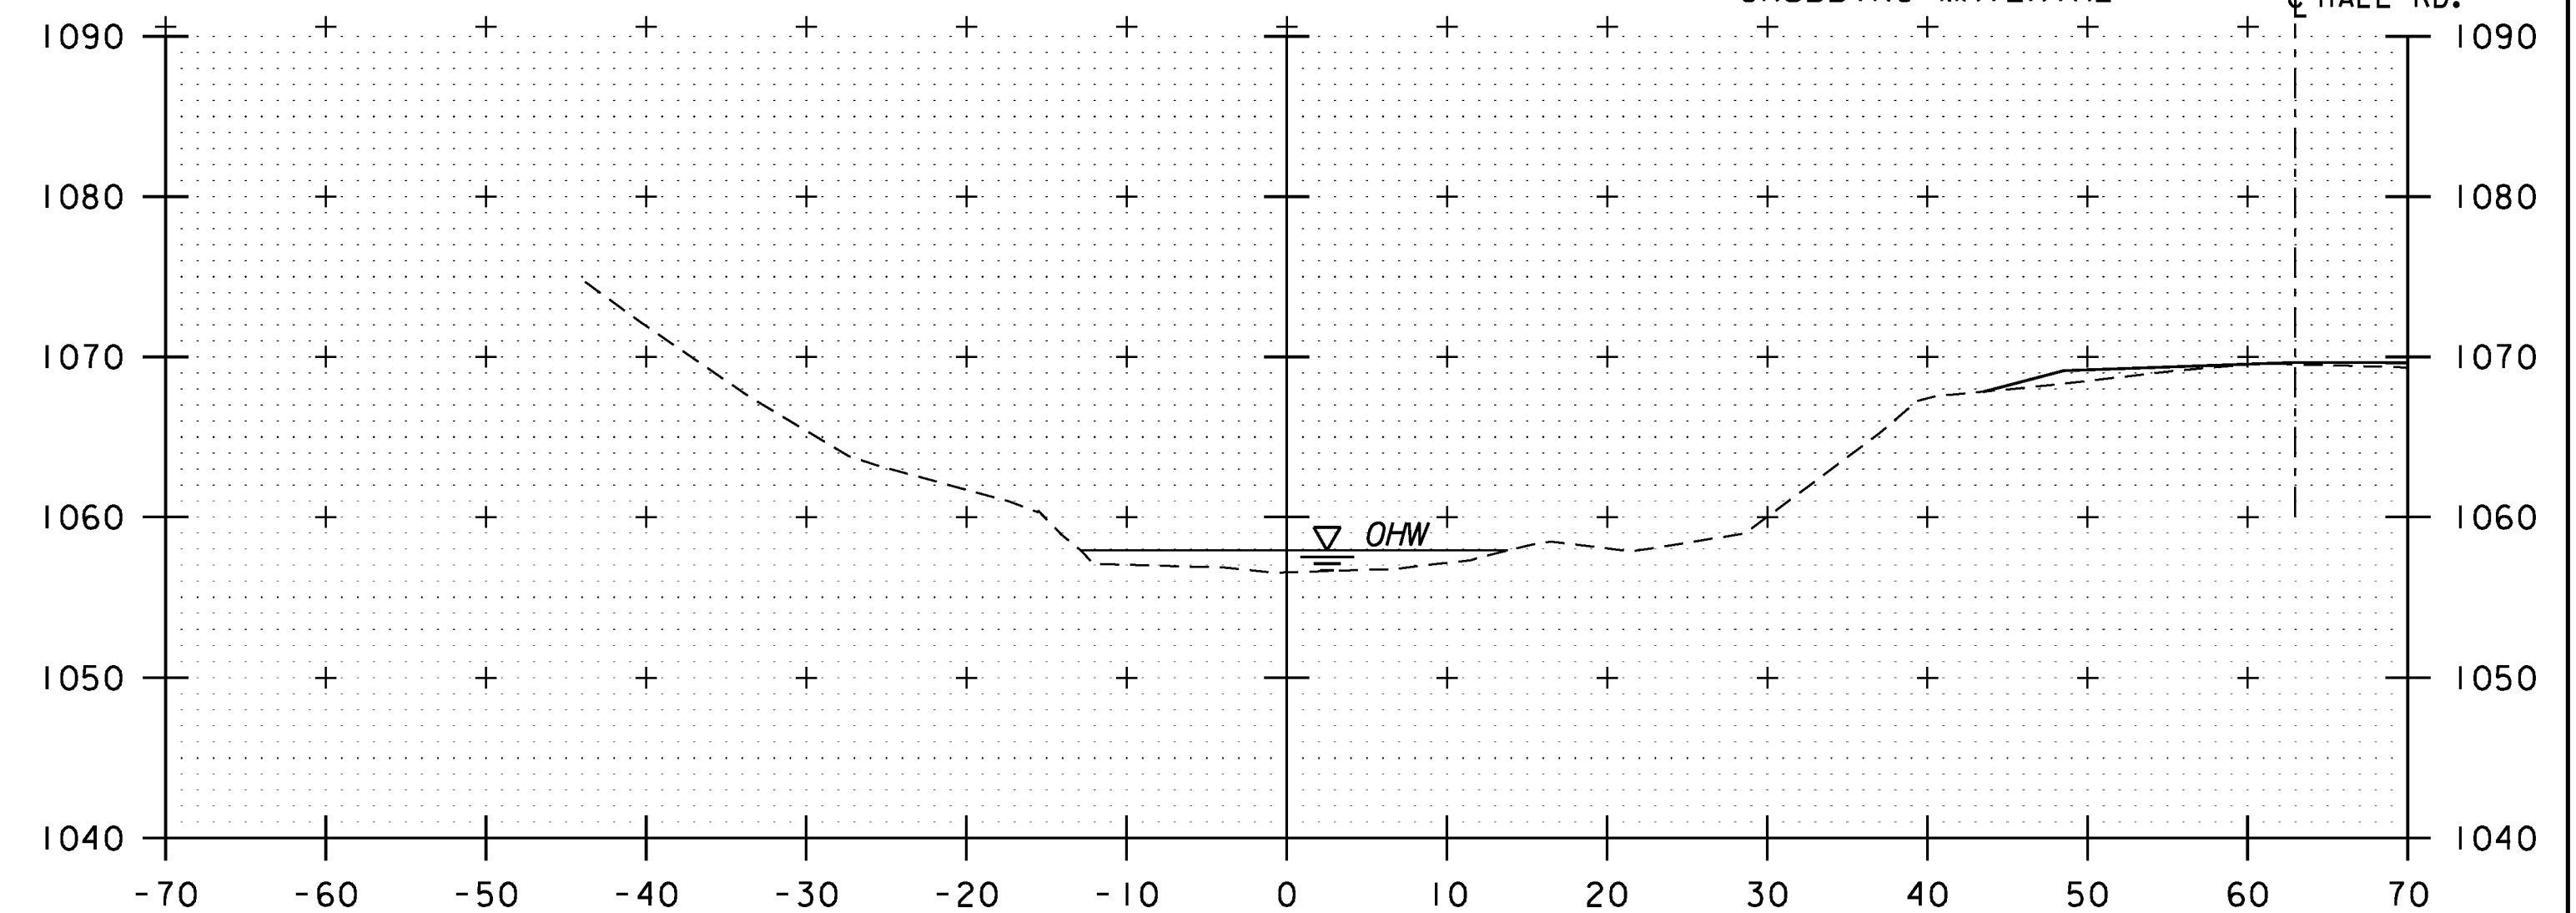

10+50


STA. 10+81, RT  
 BEGIN UNCLASSIFIED CHANNEL EXCAVATION  
 GEOTEXTILE UNDER STONE FILL  
 STONE FILL, TYPE III  
 GRUBBING MATERIAL

CHANNEL CROSS SECTIONS  
 STA. 10+00 - 10+75


SCALE 1" = 10'-0"  
 10 0 10




PROJECT NAME: GUILFORD	PLOT DATE: 10/2/2013
PROJECT NUMBER: BRO 1442(36)	DRAWN BY: E.A. FIALA
FILE NAME: z10j064xsl.dgn	CHECKED BY: S.E. BURBANK
PROJECT LEADER: S.E. BURBANK	SHEET 33 OF 42
DESIGNED BY: E.A. FIALA	
CHANNEL CROSS SECTIONS (1 OF 4)	

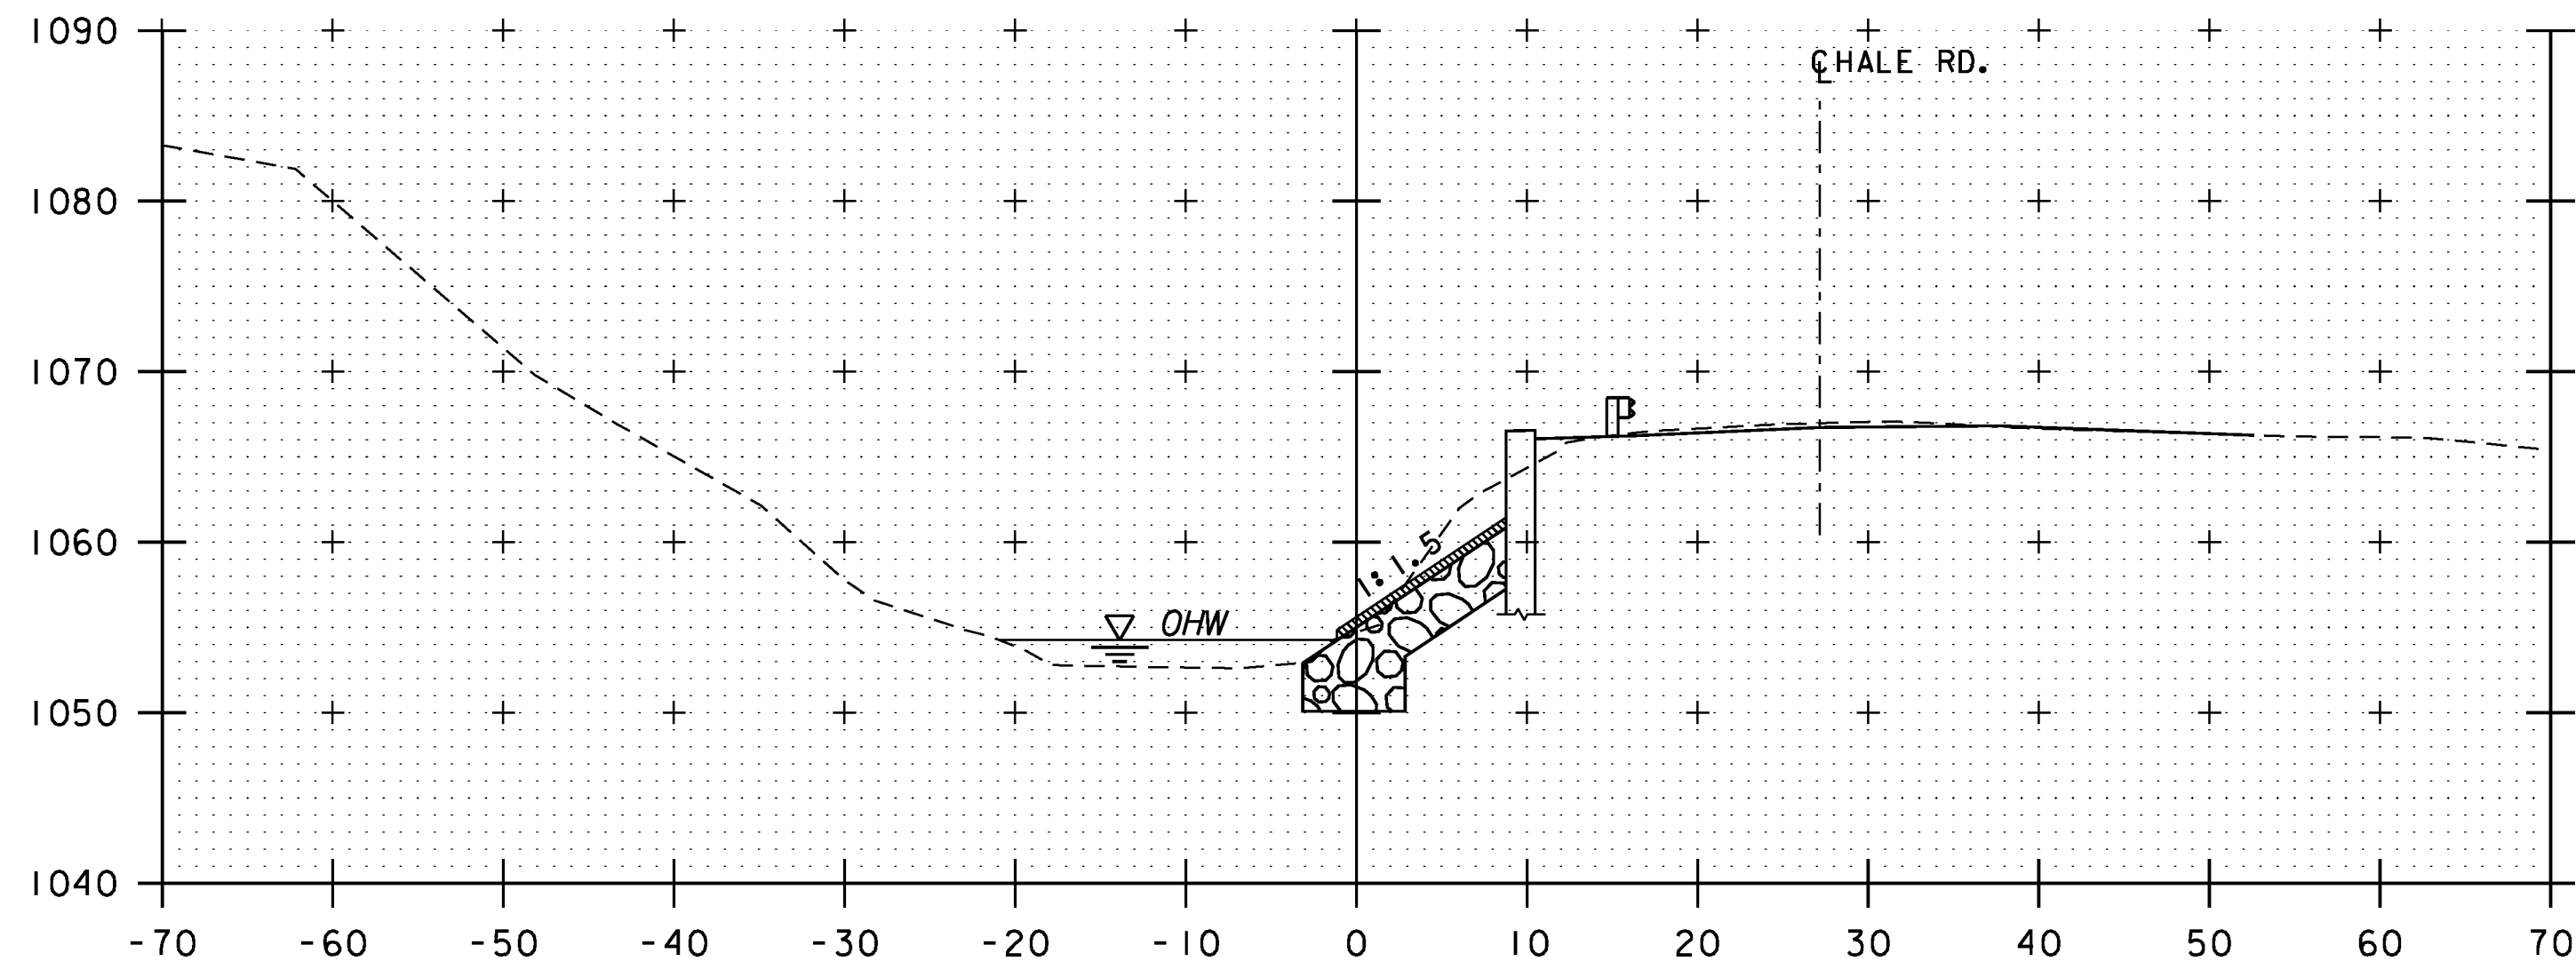

11+25

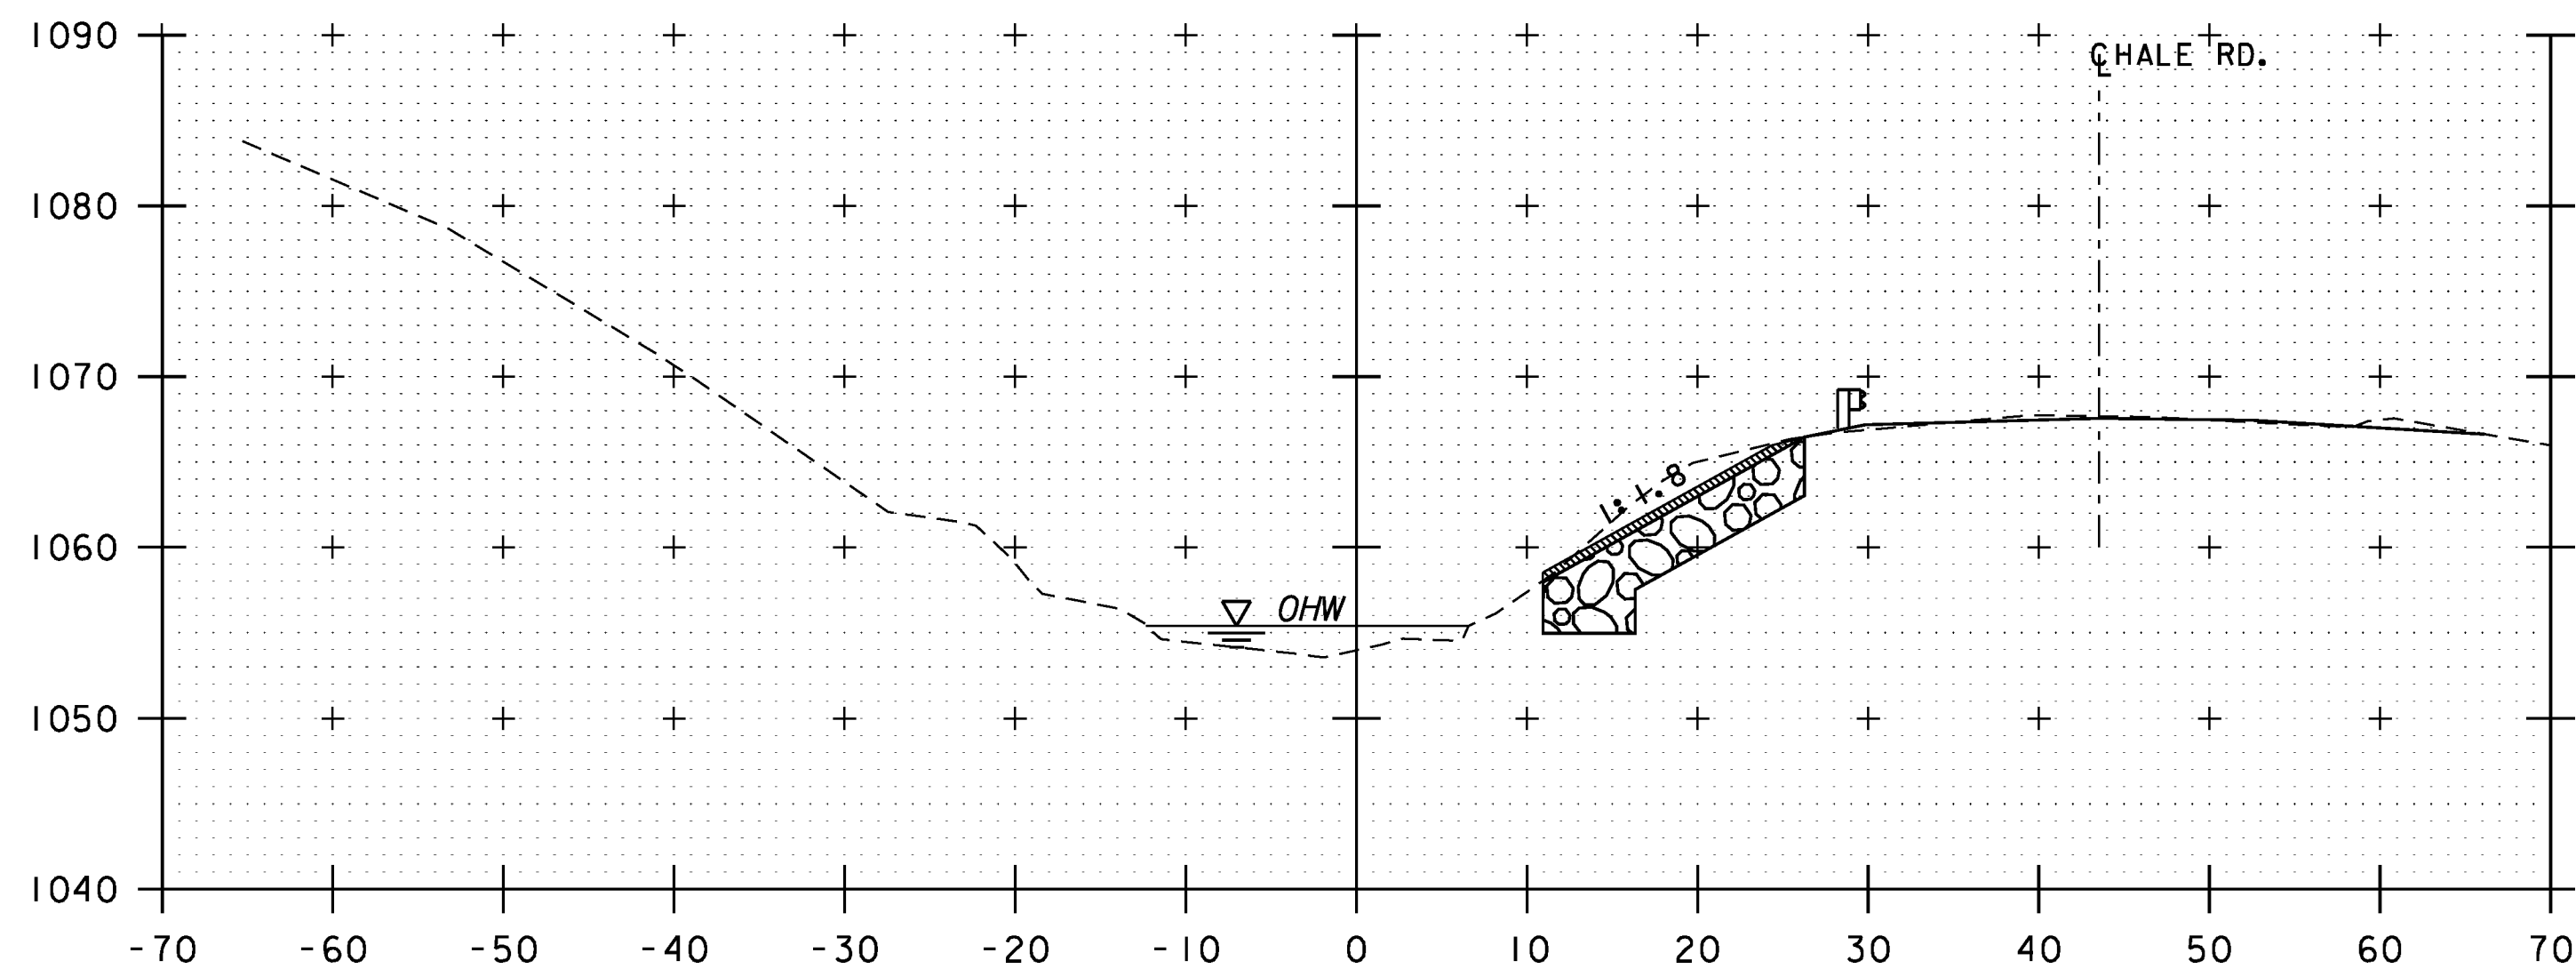


11+00

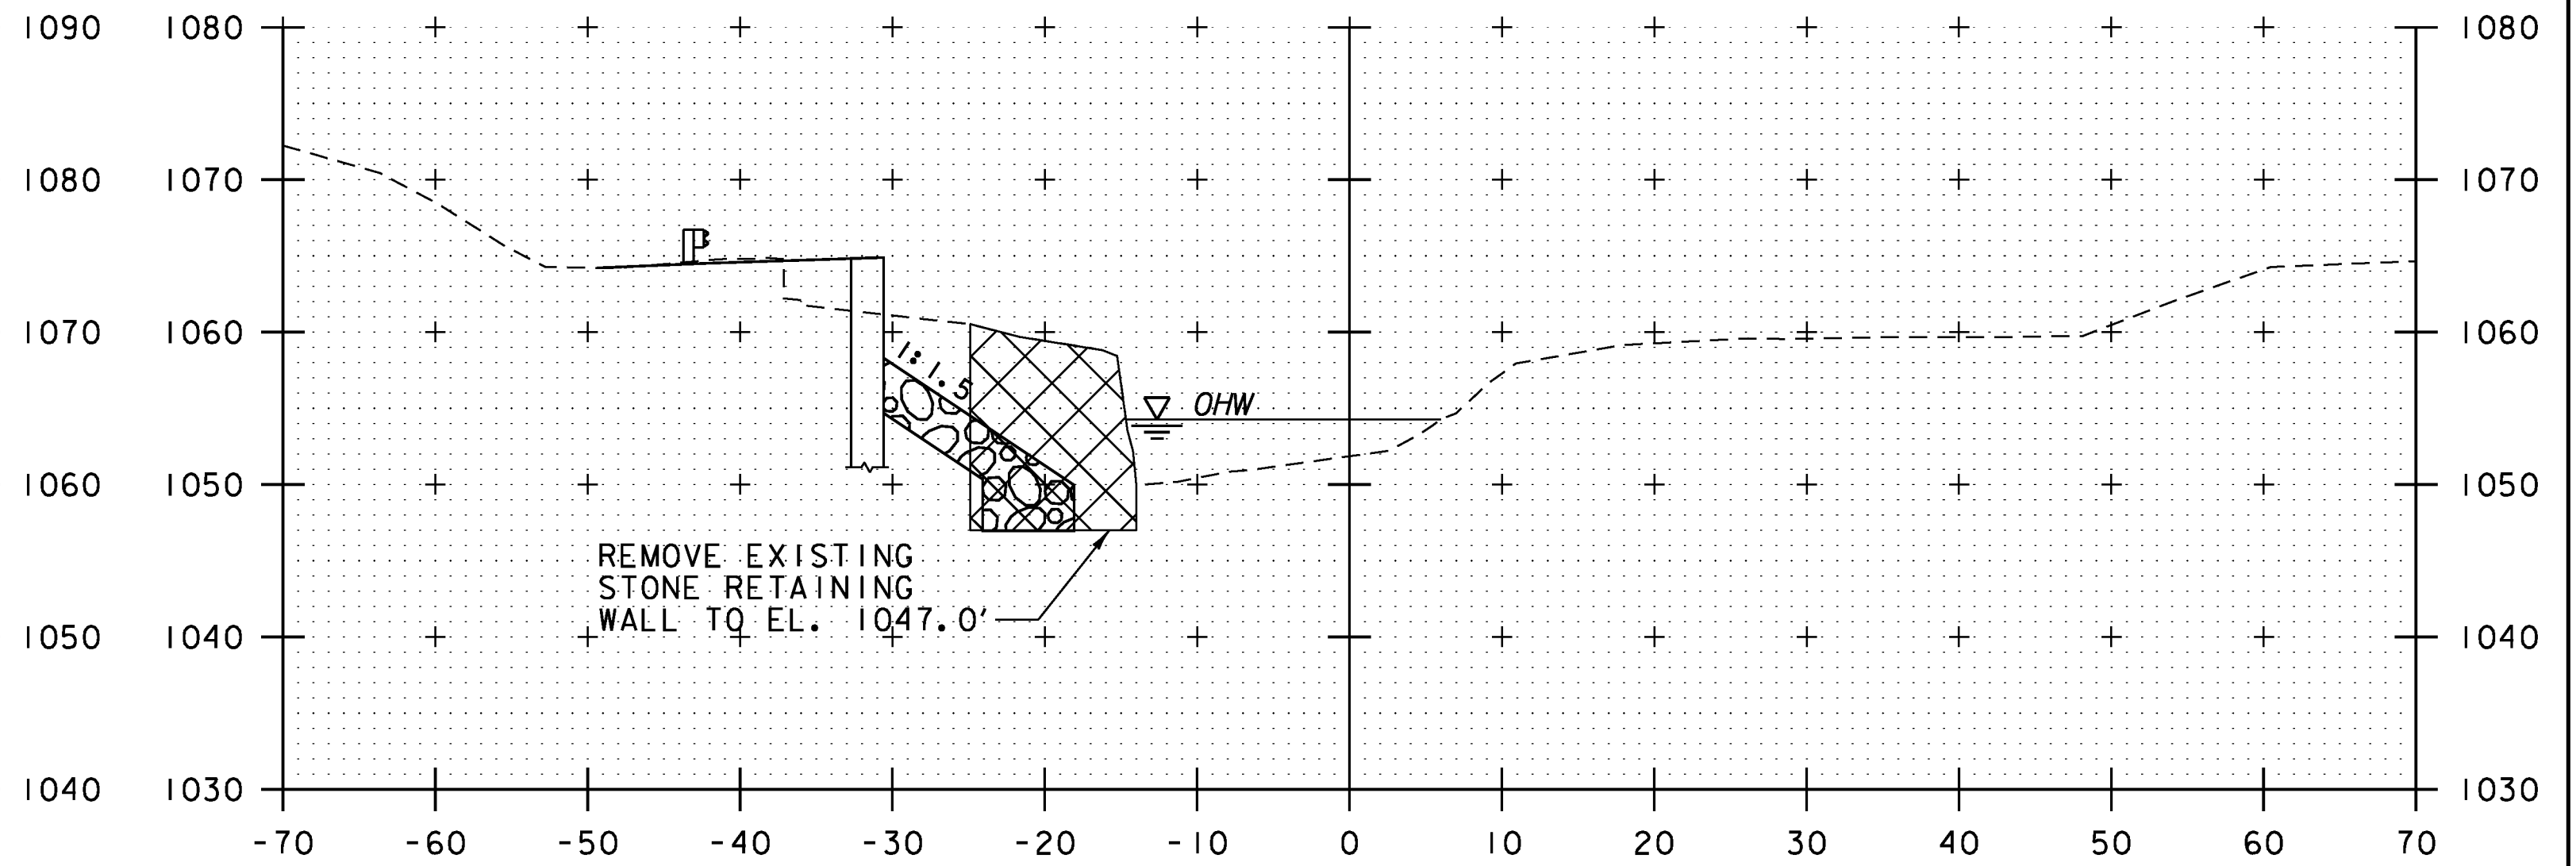

STA. 11+56, LT  
END GRUBBING MATERIAL

11+75

STA. 11+63, RT  
BEGIN GRUBBING MATERIAL

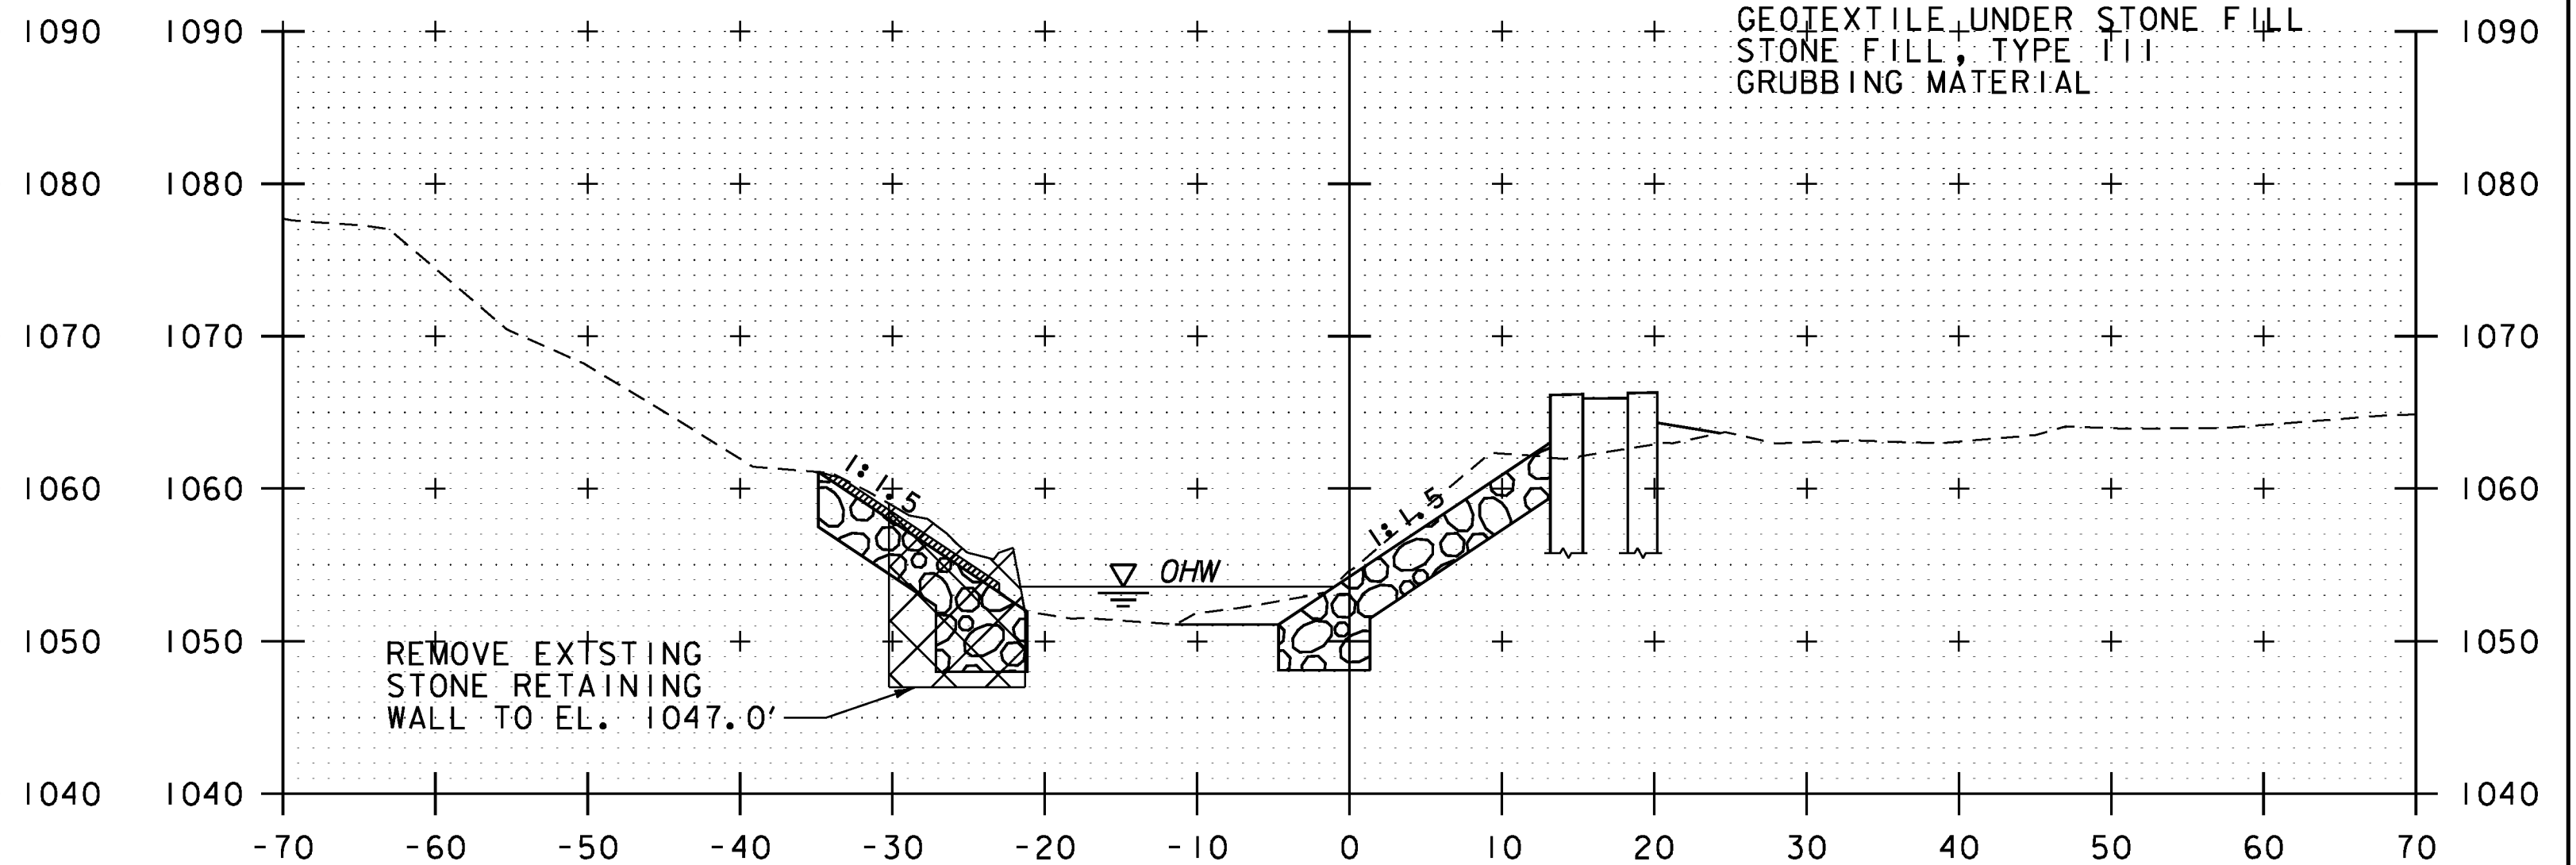

STA. 11+40, LT  
BEGIN UNCLASSIFIED CHANNEL EXCAVATION  
GEOTEXTILE UNDER STONE FILL  
STONE FILL, TYPE III  
GRUBBING MATERIAL

11+50

STA. 11+33, RT  
END GRUBBING MATERIAL

CHANNEL CROSS SECTIONS  
STA. 11+00 - STA. 11+75





SCALE 1" = 10'-0"  
10 0 10



PROJECT NAME: GUILFORD  
PROJECT NUMBER: BRO 1442(36)

FILE NAME: z10j064xsl.dgn  
PROJECT LEADER: S.E. BURBANK  
DESIGNED BY: E.A. FIALA  
CHANNEL CROSS SECTIONS (2 OF 4)

PLOT DATE: 10/2/2013  
DRAWN BY: E.A. FIALA  
CHECKED BY: S.E. BURBANK  
SHEET 34 OF 42

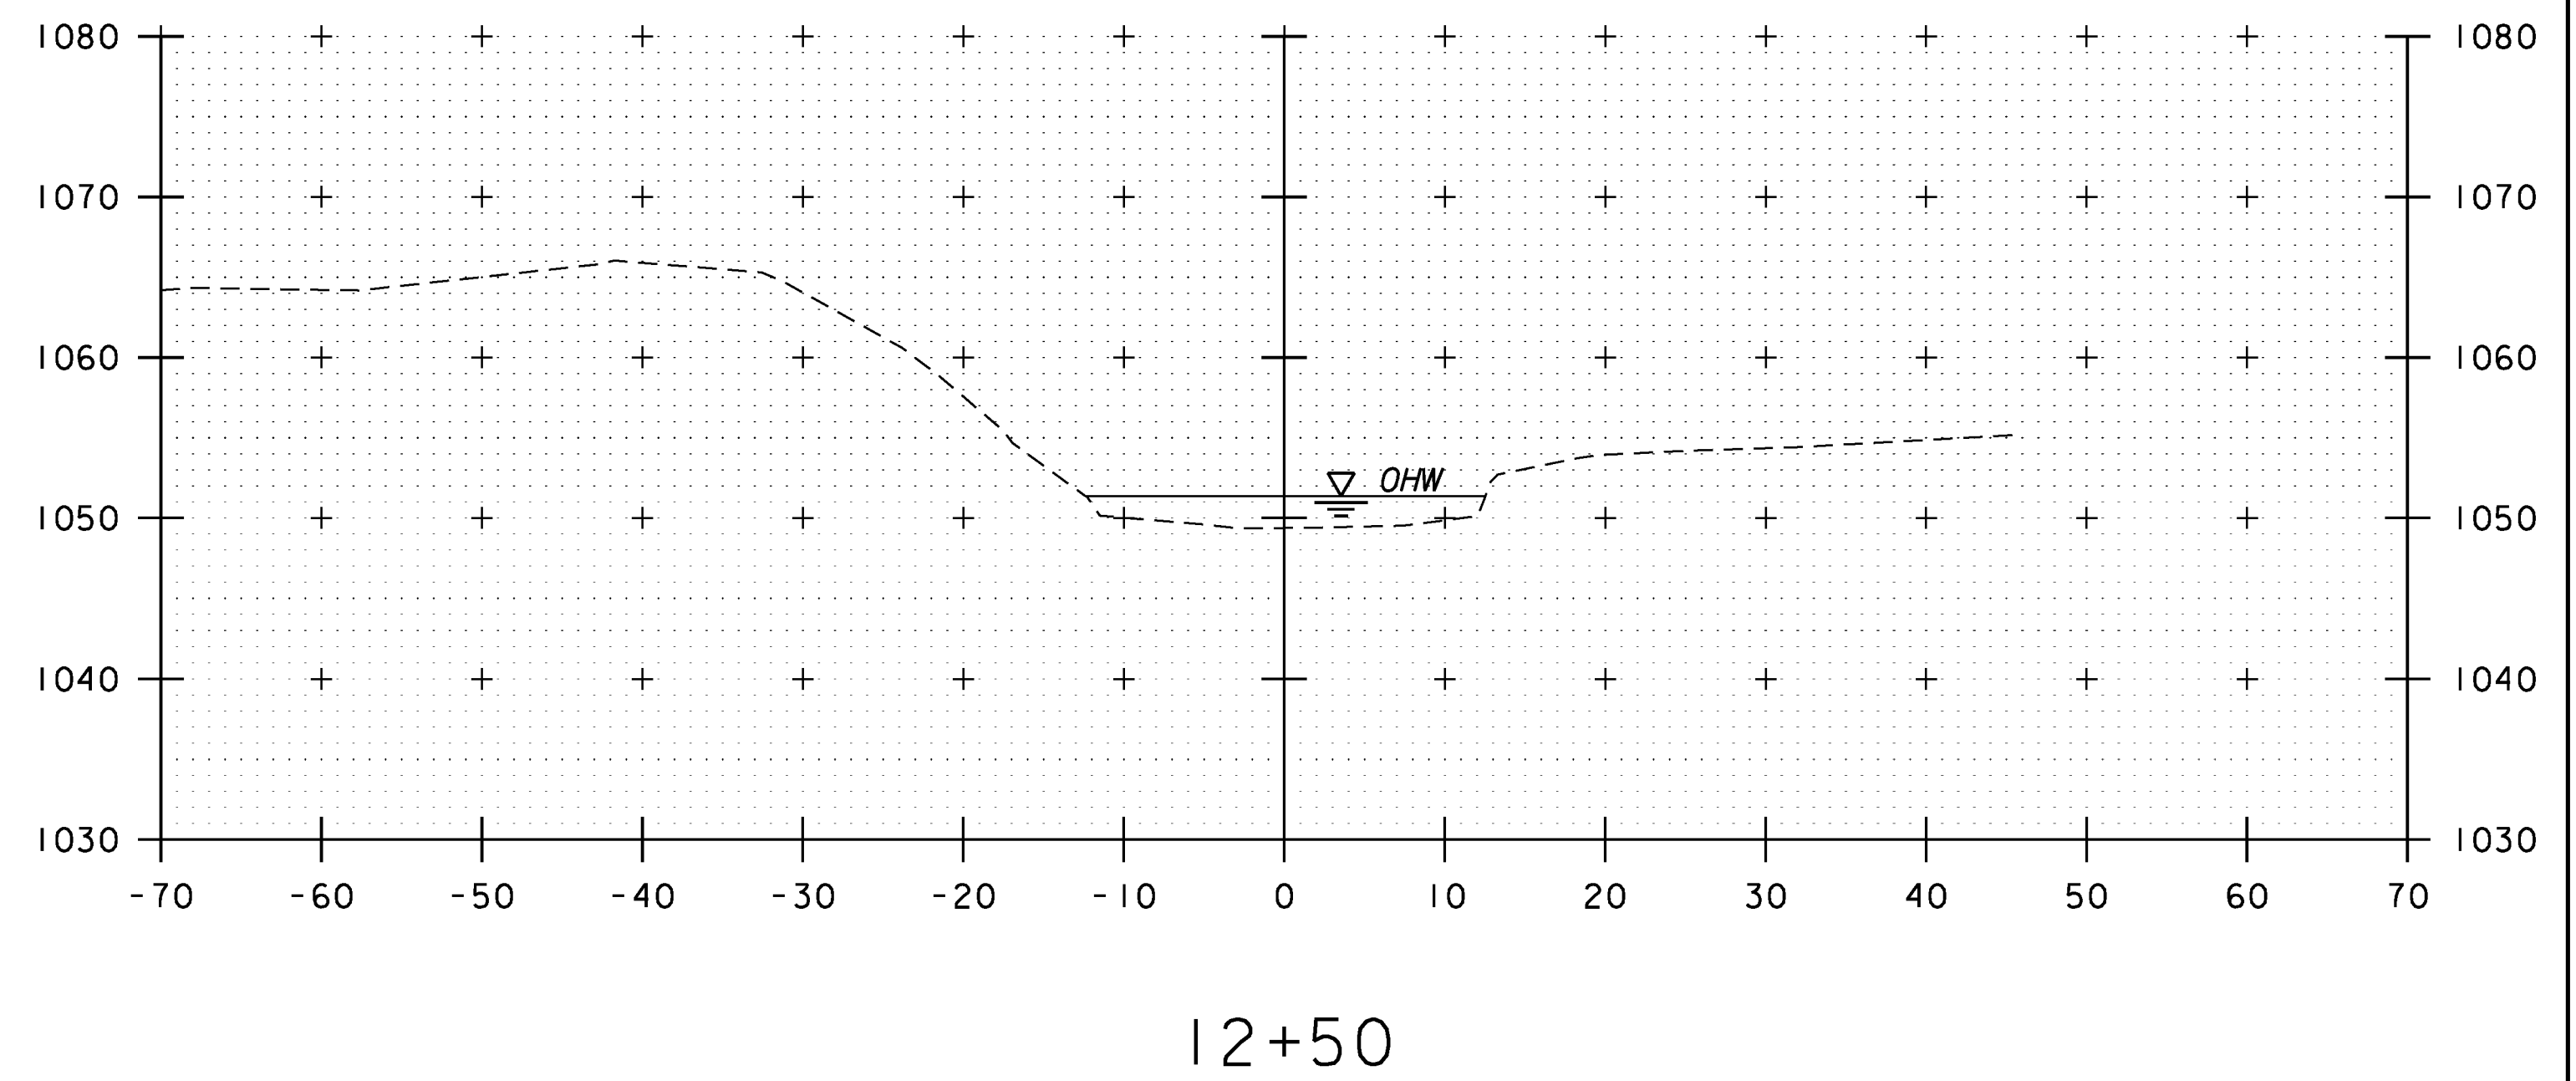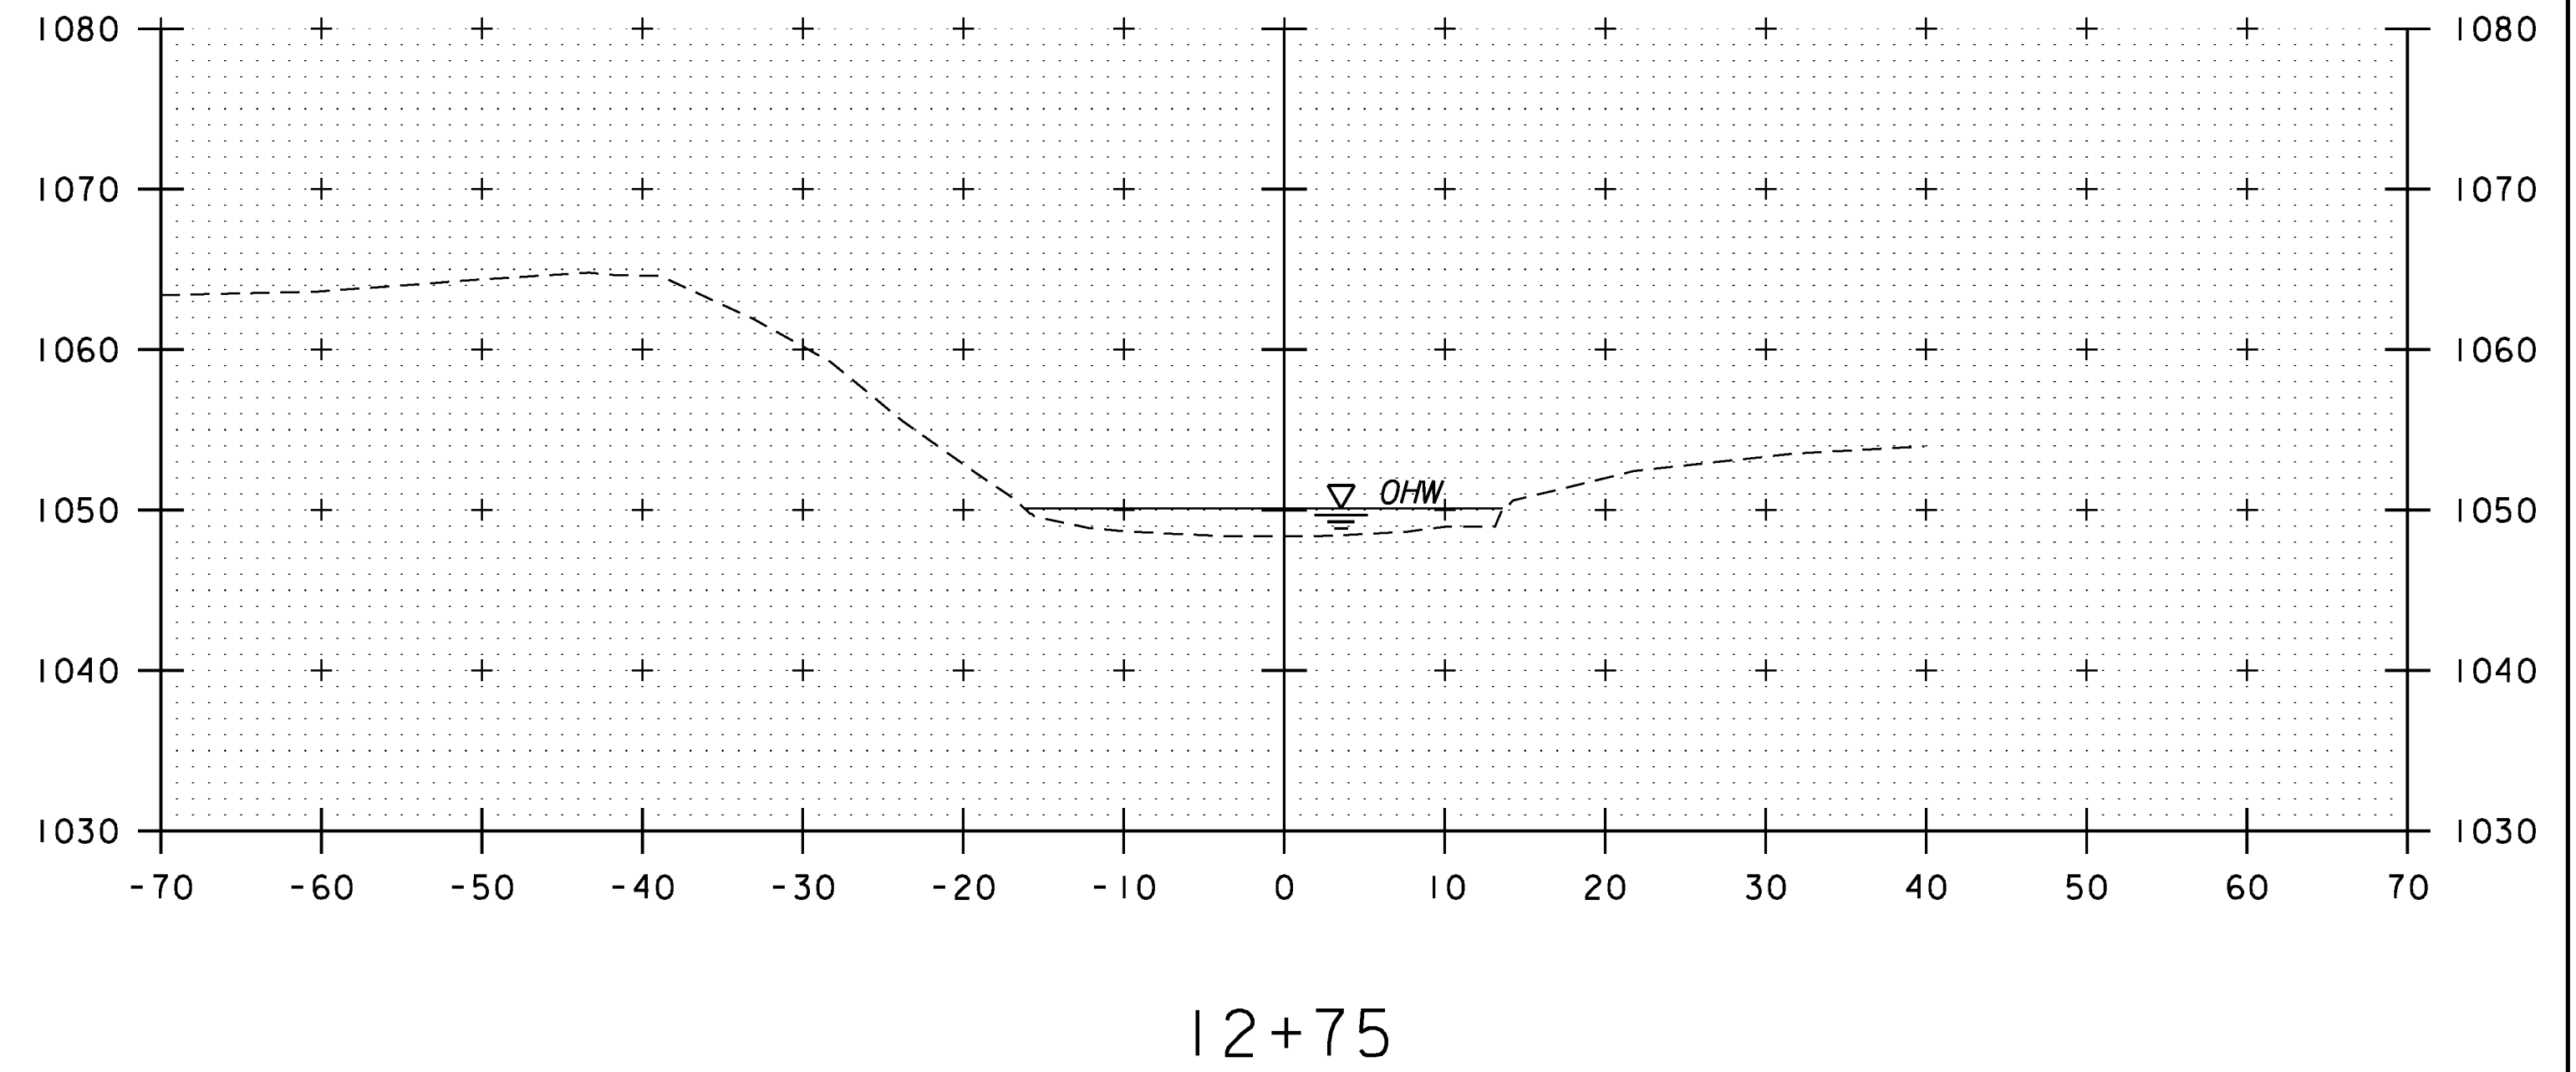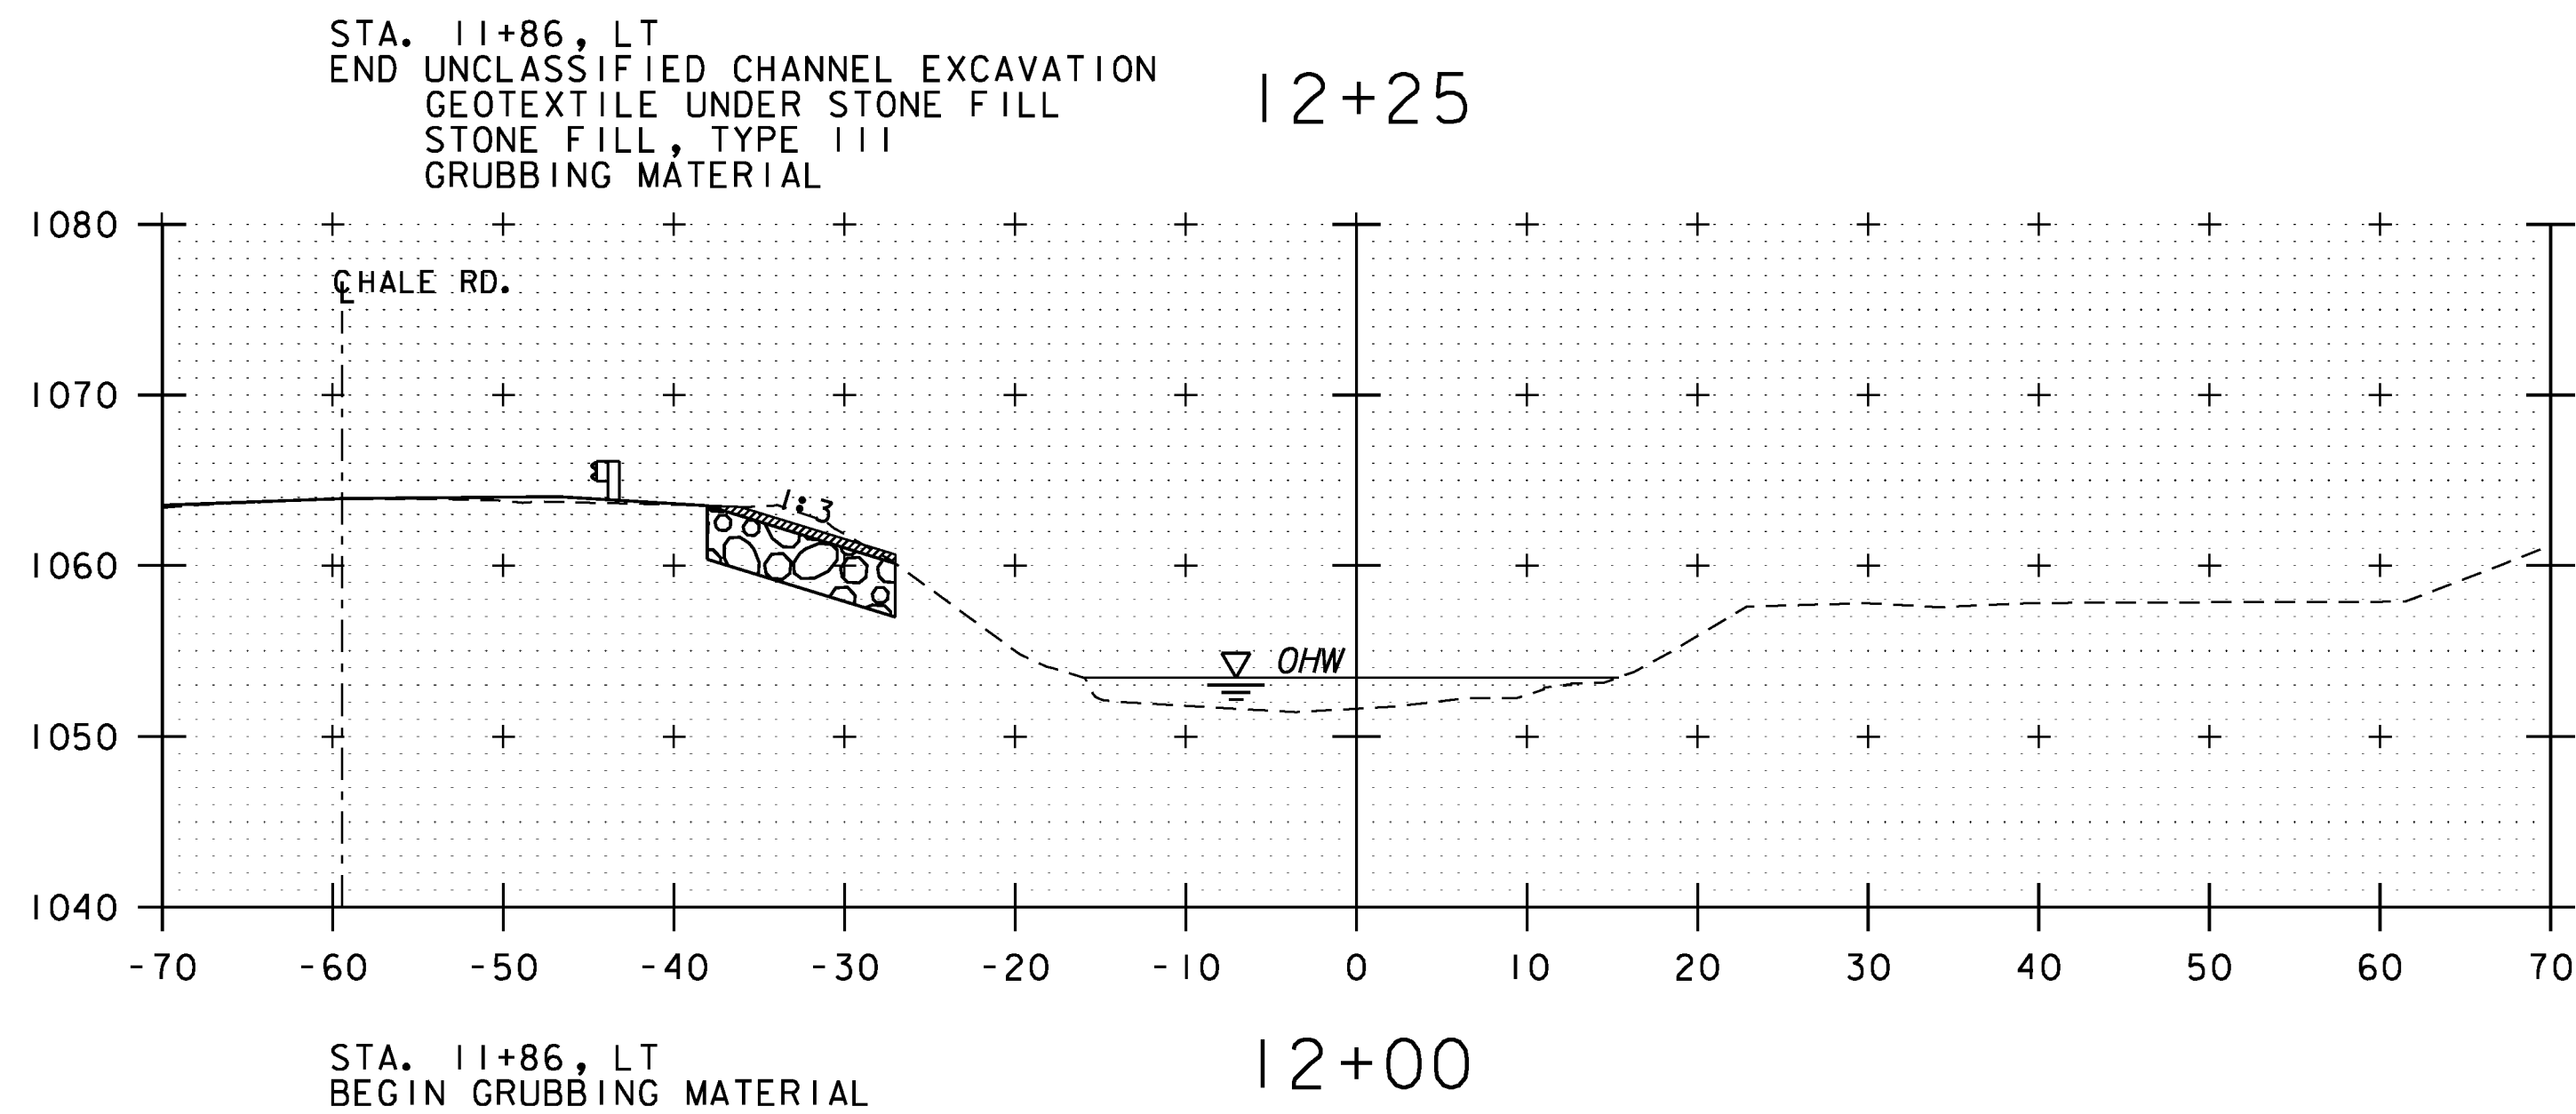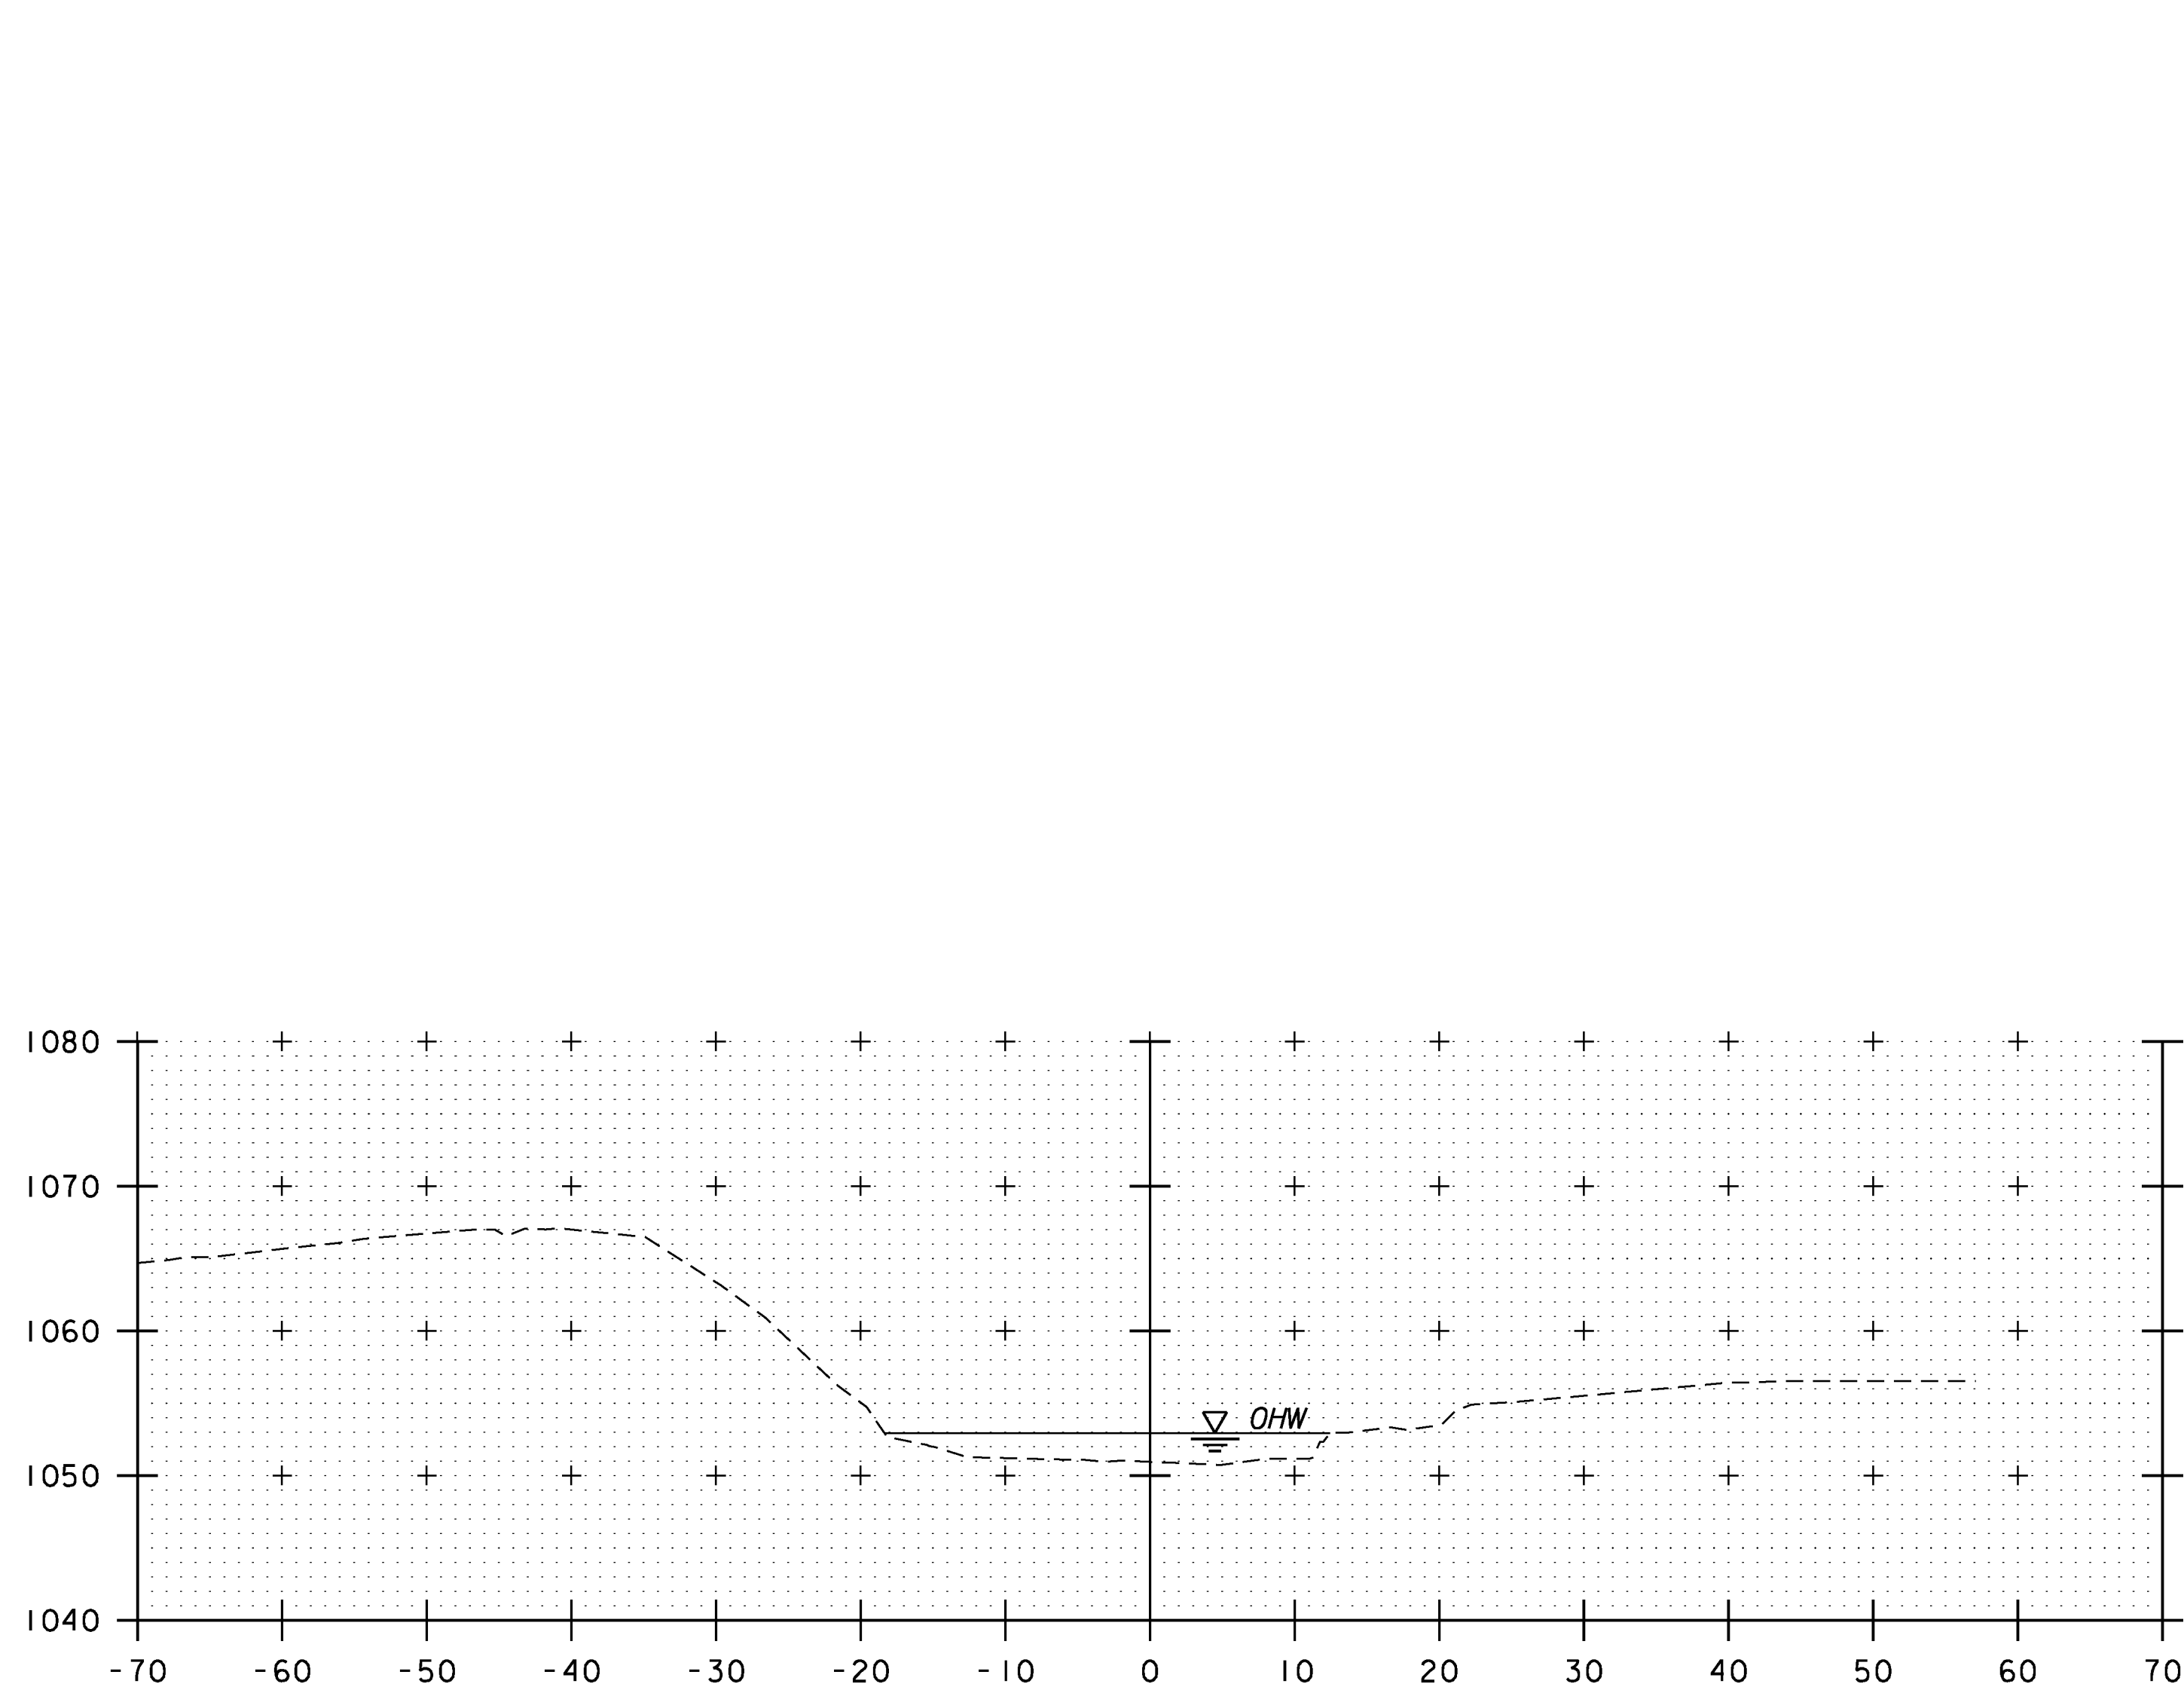


CHANNEL CROSS SECTIONS  
 STA. 12+00 - STA. 12+75

SCALE 1" = 10'-0"  
 10 0 10



PROJECT NAME: GUILFORD	PLOT DATE: 10/2/2013
PROJECT NUMBER: BRO 1442(36)	DRAWN BY: E.A. FIALA
FILE NAME: z10j064xsl.dgn	CHECKED BY: S.E. BURBANK
PROJECT LEADER: S.E. BURBANK	SHEET 35 OF 42
DESIGNED BY: E.A. FIALA	
CHANNEL CROSS SECTIONS (3 OF 4)	

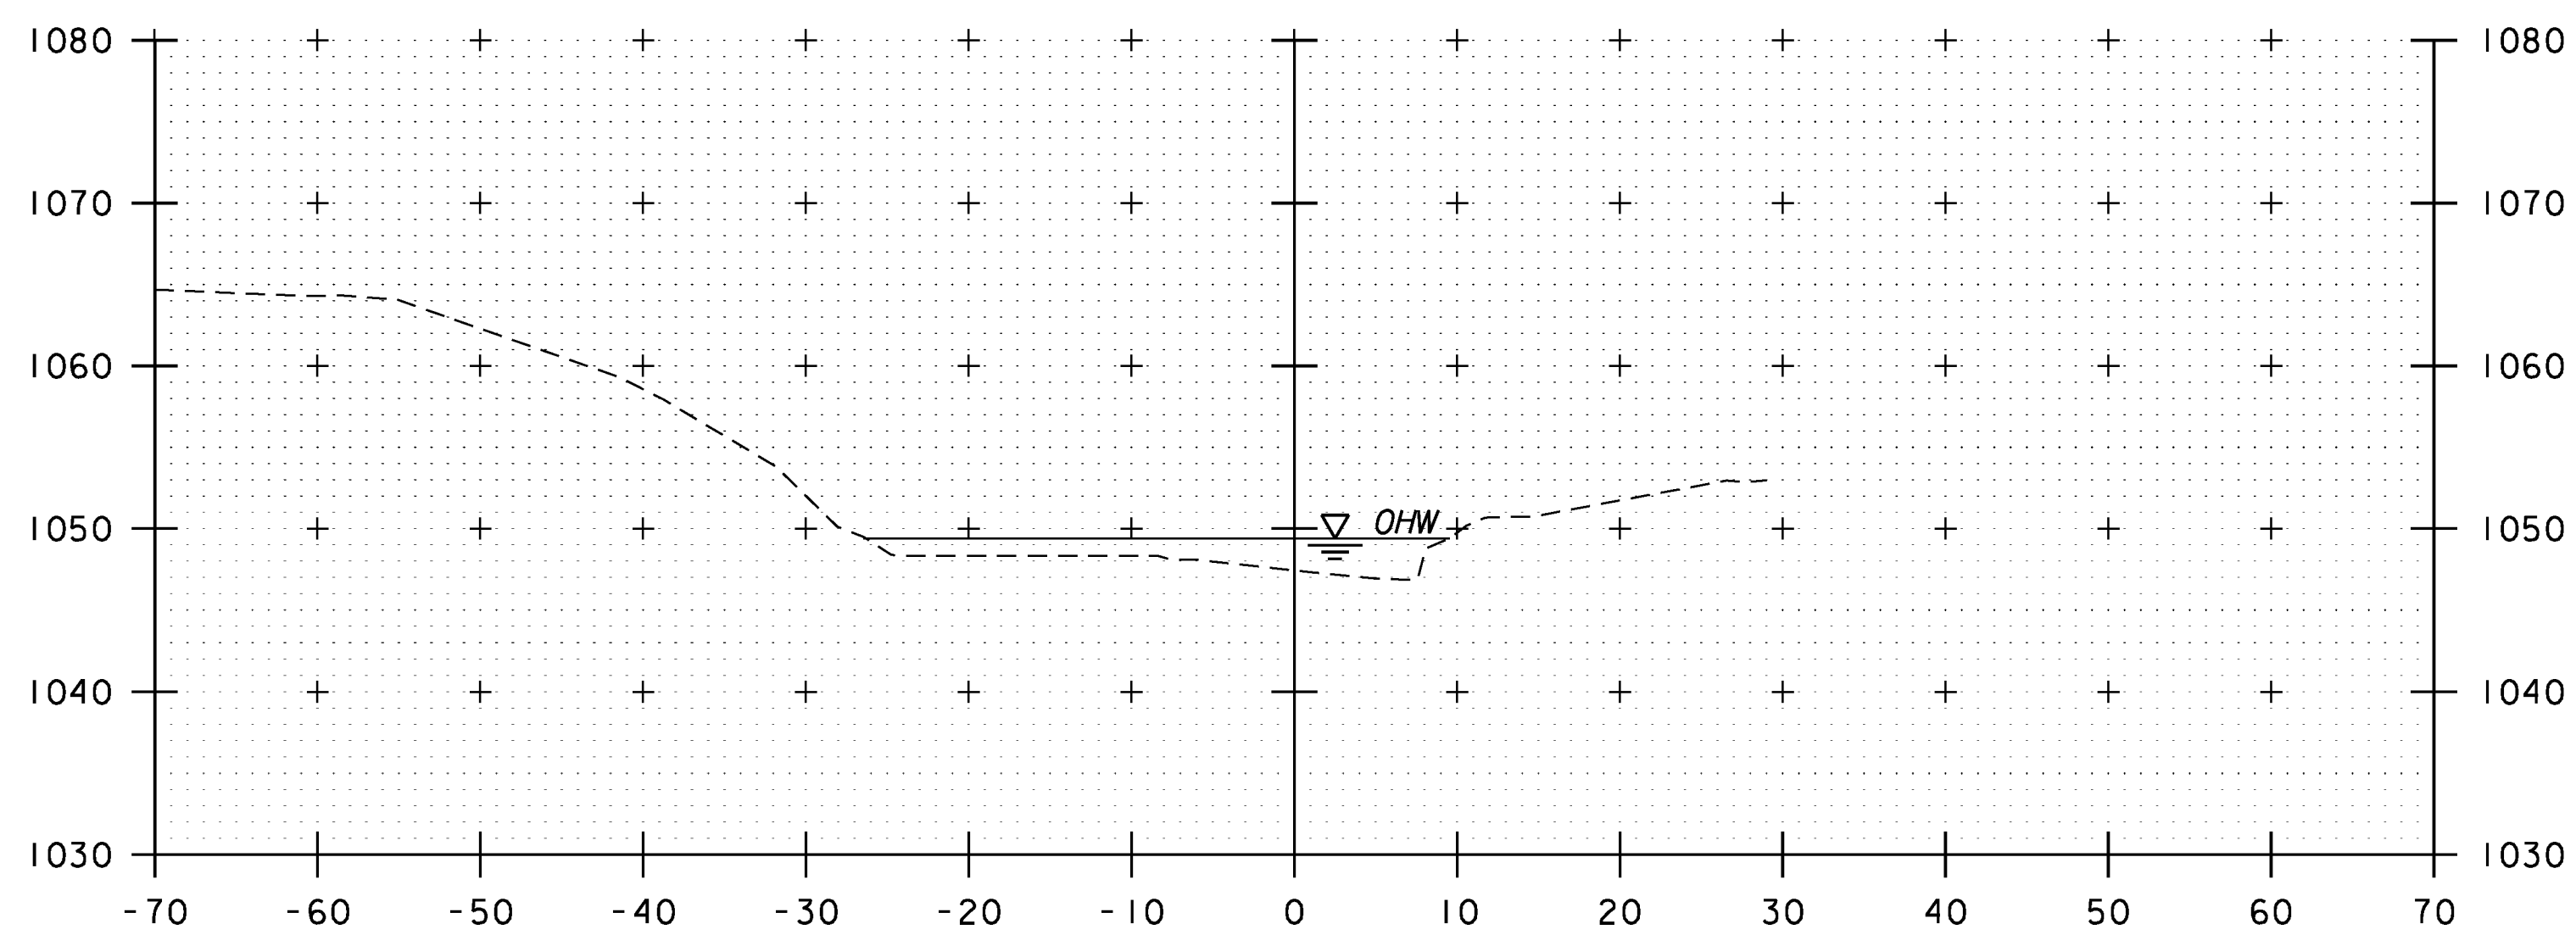

13+00

CHANNEL CROSS SECTIONS  
 STA. 13+00 - STA. 13+00

SCALE 1" = 10'-0"  
 10 0 10



PROJECT NAME: GUILFORD	PLOT DATE: 10/2/2013
PROJECT NUMBER: BRO 1442(36)	DRAWN BY: E.A. FIALA
FILE NAME: z10j064xsl.dgn	CHECKED BY: S.E. BURBANK
PROJECT LEADER: S.E. BURBANK	SHEET 36 OF 42
DESIGNED BY: E.A. FIALA	
CHANNEL CROSS SECTIONS (4 OF 4)	

# EPSC PLAN NARRATIVE

## 1.1 PROJECT DESCRIPTION

THIS PROJECT INVOLVES THE REMOVAL AND REPLACEMENT OF THE EXISTING STEEL SUPERSTRUCTURE AND CONCRETE ABUTMENTS, AND A STONE RETAINING WALL WITH RELATED APPROACH AND CHANNEL WORK. DURING CONSTRUCTION, THE BRIDGE WILL BE CLOSED AND TRAFFIC WILL BE DETOURED ON LOCAL ROADS. THIS PROJECT IS LOCATED ON HALE ROAD, A LOCAL ROAD LOCATED WEST OF HINESBURG ROAD OVER HINESBURG BROOK IN THE TOWN OF GUILFORD. THE EXISTING BRIDGE IS APPROXIMATELY 63 FEET LONG AND HAS A 10 FOOT WIDE DECK. THE EXISTING SUBSTRUCTURE CONSISTS OF CONCRETE STUB ABUTMENTS AND WINGWALLS AND A STONE RETAINING WALL.

THE BRIDGE REPLACEMENT INCLUDES THE REMOVAL OF THE EXISTING STRUCTURE IN ITS ENTIRETY AND THE CONSTRUCTION OF A NEW 58 FOOT SINGLE SPAN BRIDGE WITH PRECAST CONCRETE BOX BEAMS TO CREATE A NEW BRIDGE WIDTH OF 18 FEET. NEW CONCRETE ABUTMENTS AND WINGWALLS WILL BE CONSTRUCTED ALONG WITH ASSOCIATED APPROACH WORK AND NEW GUARDRAIL.

NOTE: AREA OF DISTURBANCE INCLUDES LIMITS OF EARTH DISTURBANCE WITHIN THE PROJECT AREA, AS WELL AS WASTE, BORROW AND STAGING AREAS, AND OTHER EARTH DISTURBING ACTIVITIES WITHIN OR DIRECTLY ADJACENT TO THE PROJECT LIMITS AS SHOWN ON THE ATTACHED EPSC PLAN.

TOTAL AREA OF DISTURBANCE AS SHOWN ON THE ATTACHED EPSC PLAN IS APPROXIMATELY 0.20 ACRES.

IT IS ANTICIPATED THAT THIS PROJECT WILL LAST ONE CONSTRUCTION SEASON.

## 1.2 SITE INVENTORY

### 1.2.1 TOPOGRAPHY

THE ROAD IN THIS PROJECT AREA IS LOCATED IN AN AREA WITH STEEP BANKS TRANSITIONING INTO A FLAT RESIDENTIAL PARCEL, WITH A LOW POINT WHERE THE BRIDGE IS LOCATED. THERE IS LIMITED RESIDENTIAL DEVELOPMENT LOCATED IN THIS RURAL AREA. HAYES ROAD IS LOCATED NORTHWEST OF THE BRIDGE LOCATION.

### 1.2.2 DRAINAGE, WATERWAYS, BODIES OF WATER, AND PROXIMITY TO NATURAL OR MAN-MADE WATER FEATURES

THE SITE OF THE BRIDGE IS LOCATED IN THE LOWER CONNECTICUT WATERSHED BASIN AND WATERS IN THE AREA DRAIN INTO THE CONNECTICUT RIVER. HINESBURG BROOK IS ONE PERENNIAL STREAM DELINEATED IN THE PROJECT AREA THAT RUNS NORTH TO SOUTH AND PASSES UNDER HALE ROAD. HINESBURG BROOK IS CONSIDERED CLASS B WATER UNDER THE VERMONT WATER QUALITY STANDARDS. THERE IS A WETLAND LOCATED ON THE SOUTH SIDE OF HALE ROAD AND WEST OF HINESBURG BROOK THAT RECEIVES HYDROLOGY FROM UPGRADIENT SLOPES LOCATED TO THE WEST. THIS WETLAND IS CONSIDERED A CLASS II WETLAND, WITH WOODY VEGETATION PRESENT, AND IS LOCATED ADJACENT TO AN INTERMITTENT STREAM THAT DRAINS TO HINESBURG BROOK AND IS POSSIBLY GREATER THAN 0.5 ACRES. THE WETLAND IS OUTSIDE OF THE PROJECT LIMITS.

### 1.2.3 VEGETATION

SOUTH OF BRIDGE NO. 65, THE WESTERN BANK IS DENSELY FORESTED AND GENTLY SLOPING AND THE EASTERN BANK IS STEEP BEFORE TRANSITIONING INTO A FLAT RESIDENTIAL PARCEL. NORTH OF HALE ROAD, THE WESTERN BANK IS DENSELY VEGETATED AND FLAT BEFORE TRANSITIONING TO A STEEP SLOPE THAT EXTENDS UPWARD TO HALE ROAD. THE EASTERN BANK IS UNDEVELOPED AND STEEP. THE AREA'S VEGETATION GENERALLY CONSISTS OF HEMLOCK NORTHERN HARDWOOD FOREST. UPON PROJECT COMPLETION, THE CHANNEL WILL BE ARMORED WITH STONE FILL TYPE III AS SPECIFIED ON THE PLANS. DISTURBED VEGETATION WILL BE REESTABLISHED WITH STANDARD SEED AND MULCH PRACTICES.

### 1.2.4 SOILS

ALL SOIL DATA CAME FROM THE U.S. DEPARTMENT OF AGRICULTURE SOIL CONSERVATION SERVICE FOR THE TOWN OF GUILFORD, VERMONT. SOILS ON THE PROJECT SITE ARE BERKSHIRE AND MONADNOCK, FINE SANDY LOAMS, VERY STONY, 8% TO 15% SLOPES, "K FACTOR" = 0.24. THE SOIL IS MODERATELY ERODIBLE.

NOTE: K-VALUES GENERALLY INDICATE THE FOLLOWING:

0.0-0.23 = LOW EROSION POTENTIAL  
0.24-0.36 = MODERATE EROSION POTENTIAL  
0.37 AND HIGHER = HIGH EROSION POTENTIAL

### 1.2.5 SENSITIVE RESOURCE AREAS

CRITICAL HABITATS: NO  
HISTORICAL OR ARCHEOLOGICAL AREAS: YES  
PRIME AGRICULTURAL LAND: NO  
THREATENED AND ENDANGERED SPECIES: NO  
WATER RESOURCE: HINESBURG BROOK  
WETLANDS: THERE IS ONE WETLAND LOCATED ON THE SOUTH SIDE OF HALE ROAD AND WEST OF HINESBURG BROOK, THE WETLAND RECEIVES HYDROLOGY FROM UPGRADIENT SLOPES LOCATED TO THE WEST. IT IS CONSIDERED A CLASS II WETLAND AND DRAINS INTO HINESBURG BROOK.

## 1.3 RISK EVALUATION

THIS PROJECT DOES NOT FALL UNDER THE JURISDICTION OF GENERAL PERMIT 3-9020 FOR STORMWATER RUNOFF FROM CONSTRUCTION SITES. SHOULD CHANGES PRIOR TO OR DURING CONSTRUCTION RESULT IN ONE OR MORE ACRES OF EARTH DISTURBANCE OR SHOULD THE PROJECT BECOME PART OF A LARGER PLAN OF DEVELOPMENT, THE CONTRACTOR WILL BE RESPONSIBLE FOR ANY ADDITIONAL PERMITTING.

## 1.4 EROSION PREVENTION AND SEDIMENT CONTROL

THE EROSION CONTROL PLANS ARE MEANT AS A GUIDELINE FOR PREVENTING EROSION AND CONTROLLING SEDIMENT TRANSPORT. THE PRINCIPLES OUTLINED IN THIS NARRATIVE CONSIST OF APPLYING MEASURES THROUGHOUT CONSTRUCTION OF THE PROJECT IN ORDER TO MINIMIZE SEDIMENT TRANSPORT TO THE RECEIVING WATERS. THE MEASURES INCLUDE STABILIZATION AND STRUCTURAL PRACTICES, STORM WATER CONTROLS AND OTHER POLLUTION PREVENTION PRACTICES. THEY HAVE BEEN PROPOSED BY THE DESIGNER AS A BASIS FOR PROTECTING RESOURCES AND WILL NEED TO BE BUILT UPON BASED ON THE SPECIFIC MEANS AND METHODS OF THE CONTRACTOR. REFER TO THE LOW RISK SITE HANDBOOK AND APPROPRIATE DETAIL SHEETS FOR SPECIFIC GUIDANCE AND CONSTRUCTION DETAILING.

ALL MEASURES SHALL BE REGULARLY MAINTAINED AND SHALL BE CHECKED FOR SEDIMENT BUILD-UP. SEDIMENT SHALL BE DISPOSED OF AT AN APPROVED SITE WHERE IT WILL NOT BE SUBJECT TO EROSION.

### 1.4.1 MARK SITE BOUNDARIES

SITE BOUNDARIES AND AREAS CONSTRUCTION EQUIPMENT CAN ACCESS SHALL BE DELINEATED.

PROJECT DEMARCATION FENCING (PDF) SHALL BE USED TO PHYSICALLY MARK SITE BOUNDARIES.

BARRIER FENCE (BF) SHALL BE USED TO PHYSICALLY MARK ARCHEOLOGICAL AREAS.

### 1.4.2 LIMIT DISTURBANCE AREA

PREVENTING INITIAL SOIL EROSION BY MINIMIZING THE EXPOSED AREA IS MUCH MORE EFFECTIVE THAN TREATING ERODED SEDIMENT. EARTH DISTURBANCE CAN BE MINIMIZED THROUGH CONSTRUCTION PHASING BY ONLY OPENING UP EARTH AS NECESSARY. THIS CAN LIMIT THE AREA THAT WILL BE DISTURBED AND EXPOSED TO EROSION. EMPLOY TEMPORARY CONSTRUCTION STABILIZATION PRACTICES IN INCREMENTAL STAGES AS PHASES CHANGE. FOR PROJECTS WHICH FALL UNDER THE CONSTRUCTION GENERAL PERMIT, ONLY THE ACREAGE LISTED ON THE PERMIT AUTHORIZATION MAY BE EXPOSED AT ANY GIVEN TIME.

MAINTAINING VEGETATED BUFFERS ALONG STREAM BANKS, WETLANDS OR OTHER SENSITIVE AREAS IS A CRUCIAL EROSION AND SEDIMENT CONTROL MEASURE THAT SHOULD BE ESTABLISHED WHEREVER POSSIBLE.

### 1.4.3 SITE ENTRANCE/EXIT STABILIZATION

TRACKING OF SEDIMENT ONTO PUBLIC HIGHWAYS SHALL BE MINIMIZED TO REDUCE THE POTENTIAL FOR RUNOFF ENTERING RECEIVING WATERS. INSTALLATION SHALL COINCIDE WITH THE CONTRACTOR'S PROGRESS SCHEDULE.

STABILIZED CONSTRUCTION ENTRANCES SHALL BE INSTALLED AS PROPOSED ON THE EPSC PLAN AND ANYWHERE EQUIPMENT WILL BE GOING FROM AREAS OF EXPOSED SOILS TO PAVED SURFACES.

### 1.4.4 INSTALL SEDIMENT BARRIERS

SEDIMENT BARRIERS SHALL BE UTILIZED TO INTERCEPT RUNOFF AND ALLOW SUSPENDED SEDIMENT TO SETTLE OUT. THEY SHALL BE INSTALLED PRIOR TO ANY UP SLOPE WORK.

SILT FENCE WILL BE INSTALLED AS PROPOSED ON THE EPSC PLAN.

FILTER CURTAIN SHALL BE INSTALLED WHERE WORK MUST TAKE PLACE WITHIN THE LIMITS OF HINESBURG BROOK AS PROPOSED ON THE EPSC PLAN.

### 1.4.5 DIVERT UPLAND RUNOFF

DIVERSIONARY MEASURES SHALL BE USED TO INTERCEPT RUNOFF FROM ABOVE THE CONSTRUCTION AND DIRECT IT AROUND THE DISTURBED AREA SO THAT CLEAN WATER DOES NOT BECOME MUDDIED WHILE TRAVELING OVER EXPOSED SOILS ON THE CONSTRUCTION SITE.

### 1.4.6 SLOW DOWN CHANNELIZED RUNOFF

CHECK STRUCTURES SHALL BE UTILIZED TO REDUCE THE VELOCITY, AND THUS THE EROSION POTENTIAL, OF CONCENTRATED FLOW IN CHANNELS.

CHECK STRUCTURES ARE NOT ANTICIPATED FOR THIS PROJECT.

### 1.4.7 CONSTRUCT PERMANENT CONTROLS

PERMANENT STORMWATER TREATMENT DEVICES SHALL BE INSTALLED AS SHOWN ON THE PLANS AND IN ACCORDANCE WITH PERMIT CONDITIONS.

PERMANENT EROSION CONTROL STRUCTURES ARE NOT ANTICIPATED FOR THIS PROJECT.

### 1.4.8 STABILIZE EXPOSED SOILS DURING CONSTRUCTION

ALL AREAS OF DISTURBANCE MUST HAVE TEMPORARY STABILIZATION IN PLACE WITHIN 48 HOURS OF DISTURBANCE OR IN ACCORDANCE WITH THE CONSTRUCTION GENERAL PERMIT 3-9020 AUTHORIZATION.

SURFACE ROUGHENING OF ALL EXPOSED SLOPES, COMBINED WITH TEMPORARY MULCHING, SHALL BE UTILIZED ON A REGULAR BASIS. BIODEGRADABLE EROSION CONTROL MATTING OR AN EQUIVALENT SHALL BE USED TO STABILIZE ALL SLOPES STEEPER THAN 1:3.

THE FORECAST OF RAINFALL EVENTS SHALL TRIGGER IMMEDIATE PROTECTION OF EXPOSED SOILS.

### 1.4.9 WINTER STABILIZATION

VARIOUS MEASURES SPECIFIC TO WINTER MAY BE NECESSARY SHOULD THE PROJECT EXTEND INTO WINTER (OCTOBER 15 THROUGH APRIL 15). REFER TO THE LOW RISK SITE HANDBOOK FOR GUIDANCE.

### 1.4.10 STABILIZE SOIL AT FINAL GRADE

EXPOSED SOIL MUST BE STABILIZED WITHIN 48 HOURS OF REACHING FINAL GRADE.

SEED, MULCH, FERTILIZER AND LIME SHALL BE USED TO ESTABLISH PERMANENT VEGETATION. FOR SLOPES STEEPER THAN 1:3, BIODEGRADABLE EROSION CONTROL MATTING OR AN EQUIVALENT SHALL BE USED INSTEAD OF MULCH.

### 1.4.11 DE-WATERING ACTIVITIES

DISCHARGE FROM DEWATERING ACTIVITIES THAT FLOWS OFF OF THE CONSTRUCTION SITE MUST NOT CAUSE OR CONTRIBUTE TO A VIOLATION OF THE VERMONT WATER QUALITY STANDARDS.

TREATMENT OF DEWATERING ACTIVITIES ARE NOT ANTICIPATED FOR THIS PROJECT.

### 1.4.12 INSPECT YOUR SITE

INSPECT THE PROJECT SITE BASED ON SPECIAL PROVISION REQUIREMENTS OR CONSTRUCTION GENERAL PERMIT AUTHORIZATION STIPULATIONS.

## 1.5 SEQUENCE AND STAGING

THIS SECTION WILL BE DEVELOPED BY THE CONTRACTOR USING THE GUIDANCE OUTLINED IN THE VTRANS EPSC PLAN CONTRACTOR CHECKLIST.


### 1.5.1 CONSTRUCTION SEQUENCE

### 1.5.2 OFF-SITE ACTIVITIES

IN ADDITION TO THE CONTRACTOR CHECKLIST ANY ACTIVITIES OUTSIDE THE CONSTRUCTION LIMITS SHALL FOLLOW SUBSECTIONS 105.25- 105.29 OF THE STANDARD SPECIFICATIONS FOR CONSTRUCTION.

PROJECT NAME: GUILFORD  
PROJECT NUMBER: BRO 1442(36)

FILE NAME: z10j064ero_Narrative.dgn PLOT DATE: 10/2/2013  
PROJECT LEADER: S.E. BURBANK DRAWN BY: E.A. FIALA  
DESIGNED BY: E.A. FIALA CHECKED BY: S.E. BURBANK  
EPSC NARRATIVE SHEET 37 OF 42

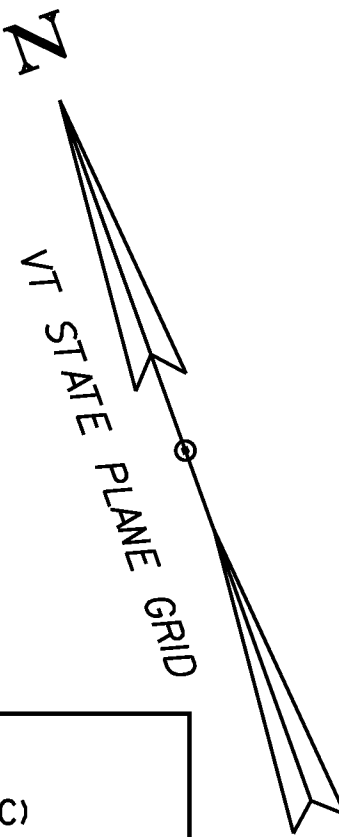

**SOIL CLASSIFICATION**  
 BERKSHIRE AND MANADNOCK FINE SANDY LOAM (IIC)  
 8% TO 15% SLOPES  
 *K FACTOR* 0.24  
 CLASSIFIED MODERATE EROSION POTENTIAL

**MCMILLEN, JOHN R.  
 & LOTZ, KAREN E.**

**BALSLEY, TANYA L.**

**HAYES, JOY**

**ROSSI, ELIZABETH M.  
 & ROSSI, PAUL J.  
 & ROSSI, PETER J.**

2 STY  
 WF  
 HOUSE

**SOIL CLASSIFICATION**  
 BERKSHIRE AND MANADNOCK FINE SANDY LOAM (IIC)  
 8% TO 15% SLOPES  
 *K FACTOR* 0.24  
 CLASSIFIED MODERATE EROSION POTENTIAL

**BEGIN BRIDGE**  
 STA. 102+57.00  
 F.G. = 1066.20

**ROADWAY POT STA. 102+72.83  
 CHANNEL POT STA. 11+50.00**

**END BRIDGE**  
 STA. 103+15.19  
 F.G. = 1064.83



**END PROJECT**  
 STA. 103+65.19

**END APPROACH**  
 STA. 103+90.00

**BEGIN APPROACH**  
 STA. 101+00.00

**BEGIN PROJECT**  
 STA. 101+25.00


**PROJECT NAME:** GUILFORD  
**PROJECT NUMBER:** BRO 1442(36)  
**FILE NAME:** z10j064bdr_ero.dgn  
**PROJECT LEADER:** S.E. BURBANK  
**DESIGNED BY:** S.E. BURBANK  
**EPSC EXISTING CONDITIONS PLAN**  
**PLOT DATE:** 10/2/2013  
**DRAWN BY:** E.A. FIALA  
**CHECKED BY:** S.E. BURBANK  
**SHEET 38 OF 42**

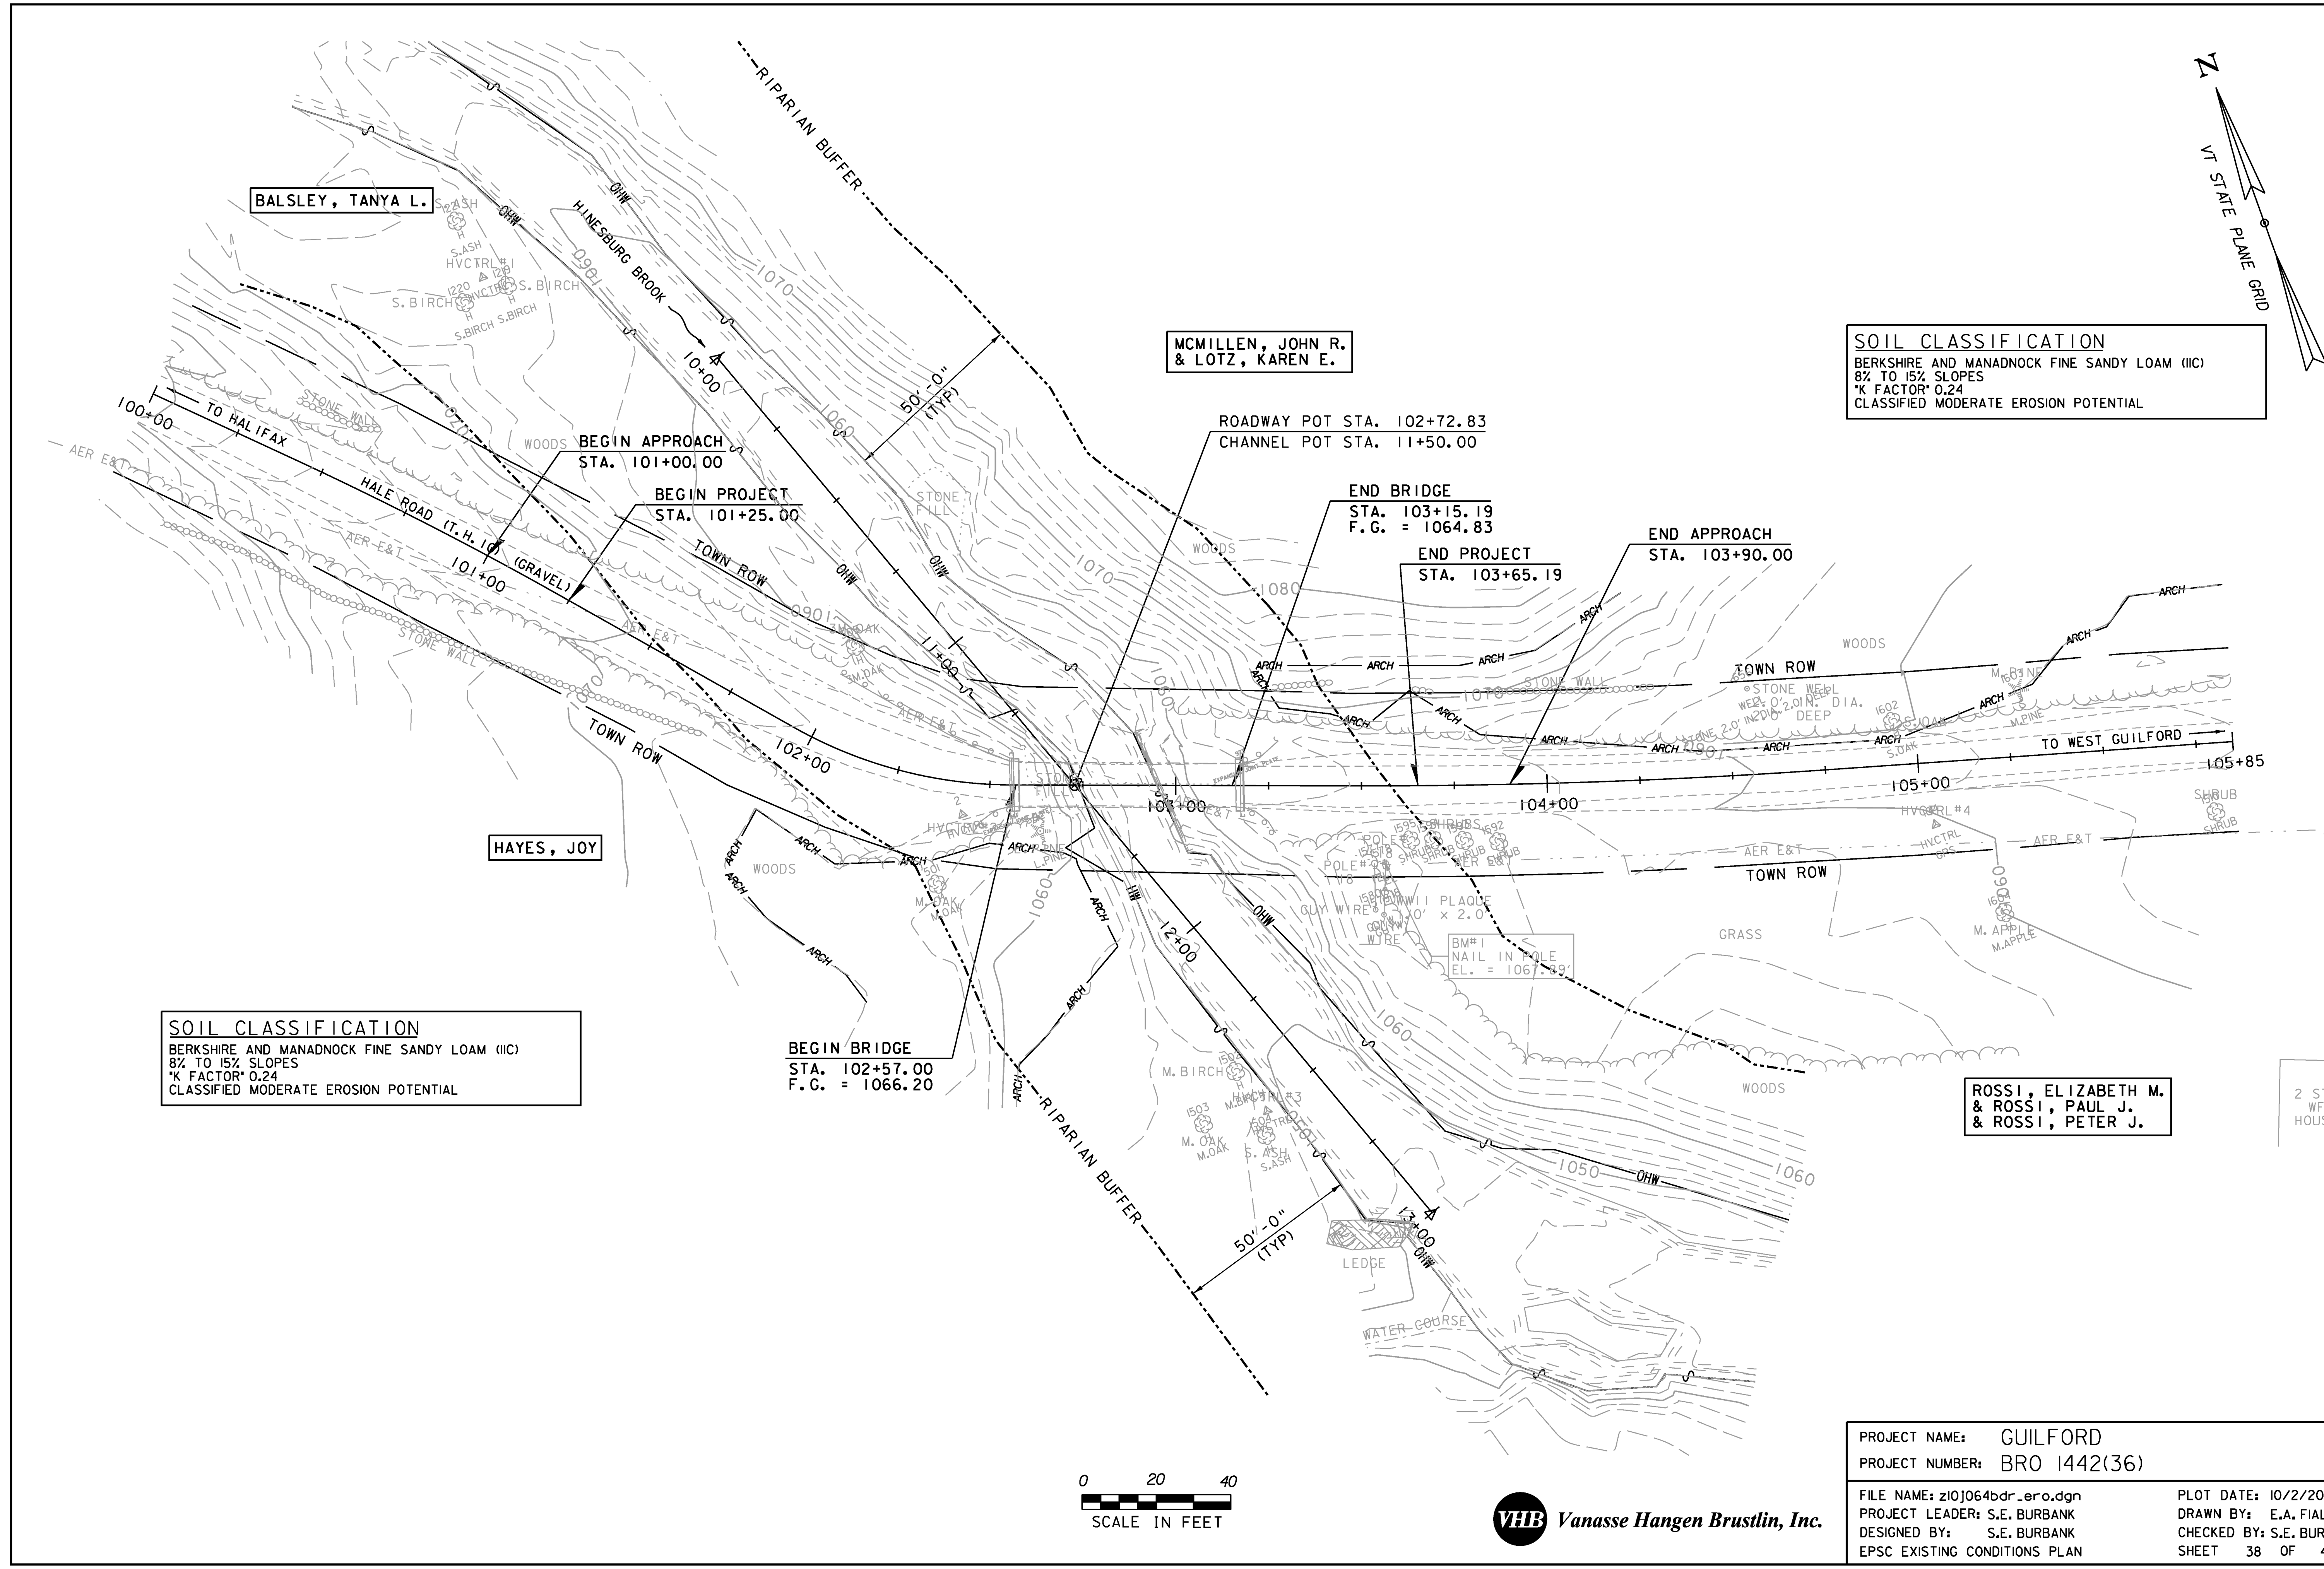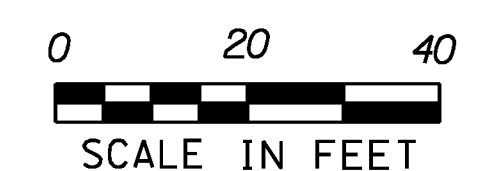

**NOTES:**

1. THESE PLANS SHOW A CONCEPTUAL EROSION CONTROL PLAN, THE CONTRACTOR MUST SUBMIT A TEMPORARY EROSION CONTROL PLAN FOR APPROVAL. THE CONTRACTOR MAY RELOCATE TEMPORARY MEASURES TO IMPROVE EROSION CONTROL WITH APPROVAL OF THE RESIDENT ENGINEER.
2. SILT FENCE SHALL NOT BE INSTALLED ACROSS CONTOURS.
3. THE CONTRACTOR SHALL USE OTHER TEMPORARY EROSION CONTROL MEASURES AS NECESSITATED BY THE SEQUENCE OF CONSTRUCTION OR AS DIRECTED BY THE RESIDENT ENGINEER.
4. REFER TO TEMPORARY EROSION CONTROL DETAIL SHEETS FOR ADDITIONAL DETAILS.

5. WHERE LEDGE IS EXPOSED, GRAVEL BAGS MAY BE USED INSTEAD OF FILTER CURTAIN. PAYMENT FOR GRAVEL BAGS WOULD BE INCLUDED FOR PAYMENT UNDER THE UNIT PRICE BID FOR ITEM 649.61 "GEOTEXTILE FOR FILTER CURTAIN".

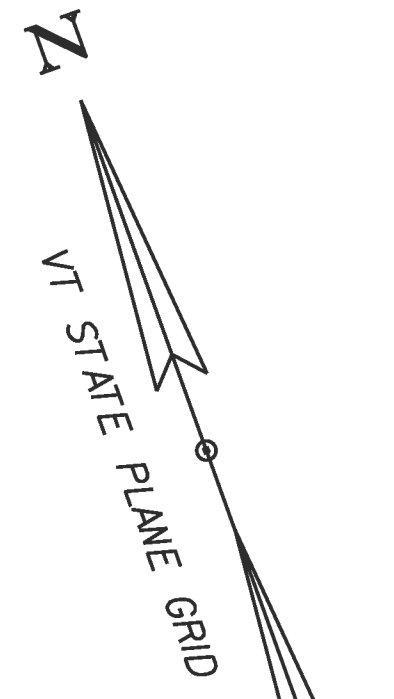

**SOIL CLASSIFICATION**  
 BERKSHIRE AND MANADNOCK FINE SANDY LOAM (IIC)  
 8% TO 15% SLOPES  
 *K FACTOR* 0.24  
 CLASSIFIED MODERATE EROSION POTENTIAL

**SOIL CLASSIFICATION**  
 BERKSHIRE AND MANADNOCK FINE SANDY LOAM (IIC)  
 8% TO 15% SLOPES  
 *K FACTOR* 0.24  
 CLASSIFIED MODERATE EROSION POTENTIAL

**BEGIN BRIDGE**  
 STA. 102+57.00  
 F.G. = 1066.20  
 STONE FILL, TYPE III (TYP)

**ROADWAY POT STA. 102+72.83**  
**CHANNEL POT STA. 11+50.00**  
 STONE FILL, TYPE III (TYP)  
**END BRIDGE**  
 STA. 103+15.19  
 F.G. = 1064.83

**END APPROACH**  
 STA. 103+90.00

**END PROJECT**  
 STA. 103+65.19

**BEGIN APPROACH**  
 STA. 101+00.00

**BEGIN PROJECT**  
 STA. 101+25.00

100+00 TO HALIFAX

HALE ROAD (T.H. 10)

WOODS

STONE FILL

WOODS

WOODS

WOODS

ARCH

WOODS

ARCH

ARCH

WOODS

ARCH


ARCH

2 STY WF HOUSE



**NOTE:** SEE EROSION CONTROL DETAILS FOR SYMBOLOGY.

PROJECT NAME: GUILFORD	
PROJECT NUMBER: BRO 1442(36)	
FILE NAME: z10j064bdr_ero.dgn	PLOT DATE: 10/2/2013
PROJECT LEADER: S.E. BURBANK	DRAWN BY: E.A. FIALA
DESIGNED BY: S.E. BURBANK	CHECKED BY: S.E. BURBANK
EPSC CONSTRUCTION CONDITIONS PLAN	SHEET 39 OF 42

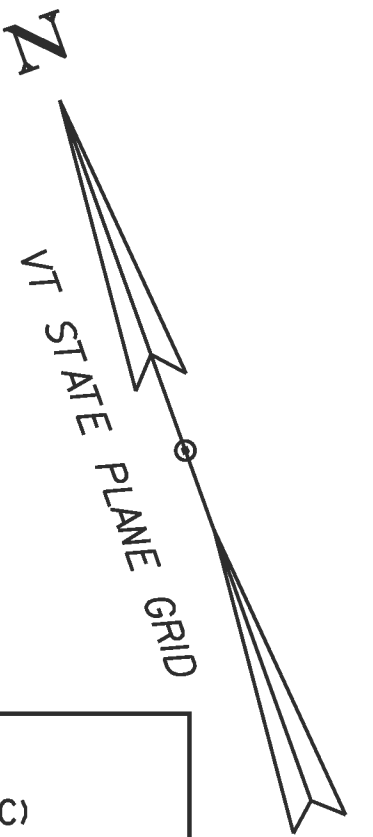

**SOIL CLASSIFICATION**  
 BERKSHIRE AND MANADNOCK FINE SANDY LOAM (IIC)  
 8% TO 15% SLOPES  
 *K FACTOR* 0.24  
 CLASSIFIED MODERATE EROSION POTENTIAL

**SOIL CLASSIFICATION**  
 BERKSHIRE AND MANADNOCK FINE SANDY LOAM (IIC)  
 8% TO 15% SLOPES  
 *K FACTOR* 0.24  
 CLASSIFIED MODERATE EROSION POTENTIAL

**BEGIN BRIDGE**  
 STA. 102+57.00  
 F.G. = 1066.20  
 STONE FILL, TYPE III (TYP)


**ROADWAY POT STA. 102+72.83**  
**CHANNEL POT STA. 11+50.00**  
 STONE FILL, TYPE III (TYP)  
**END BRIDGE**  
 STA. 103+15.19  
 F.G. = 1064.83

**END APPROACH**  
 STA. 103+90.00

**END PROJECT**  
 STA. 103+65.19

**BEGIN APPROACH**  
 STA. 101+00.00

**BEGIN PROJECT**  
 STA. 101+25.00

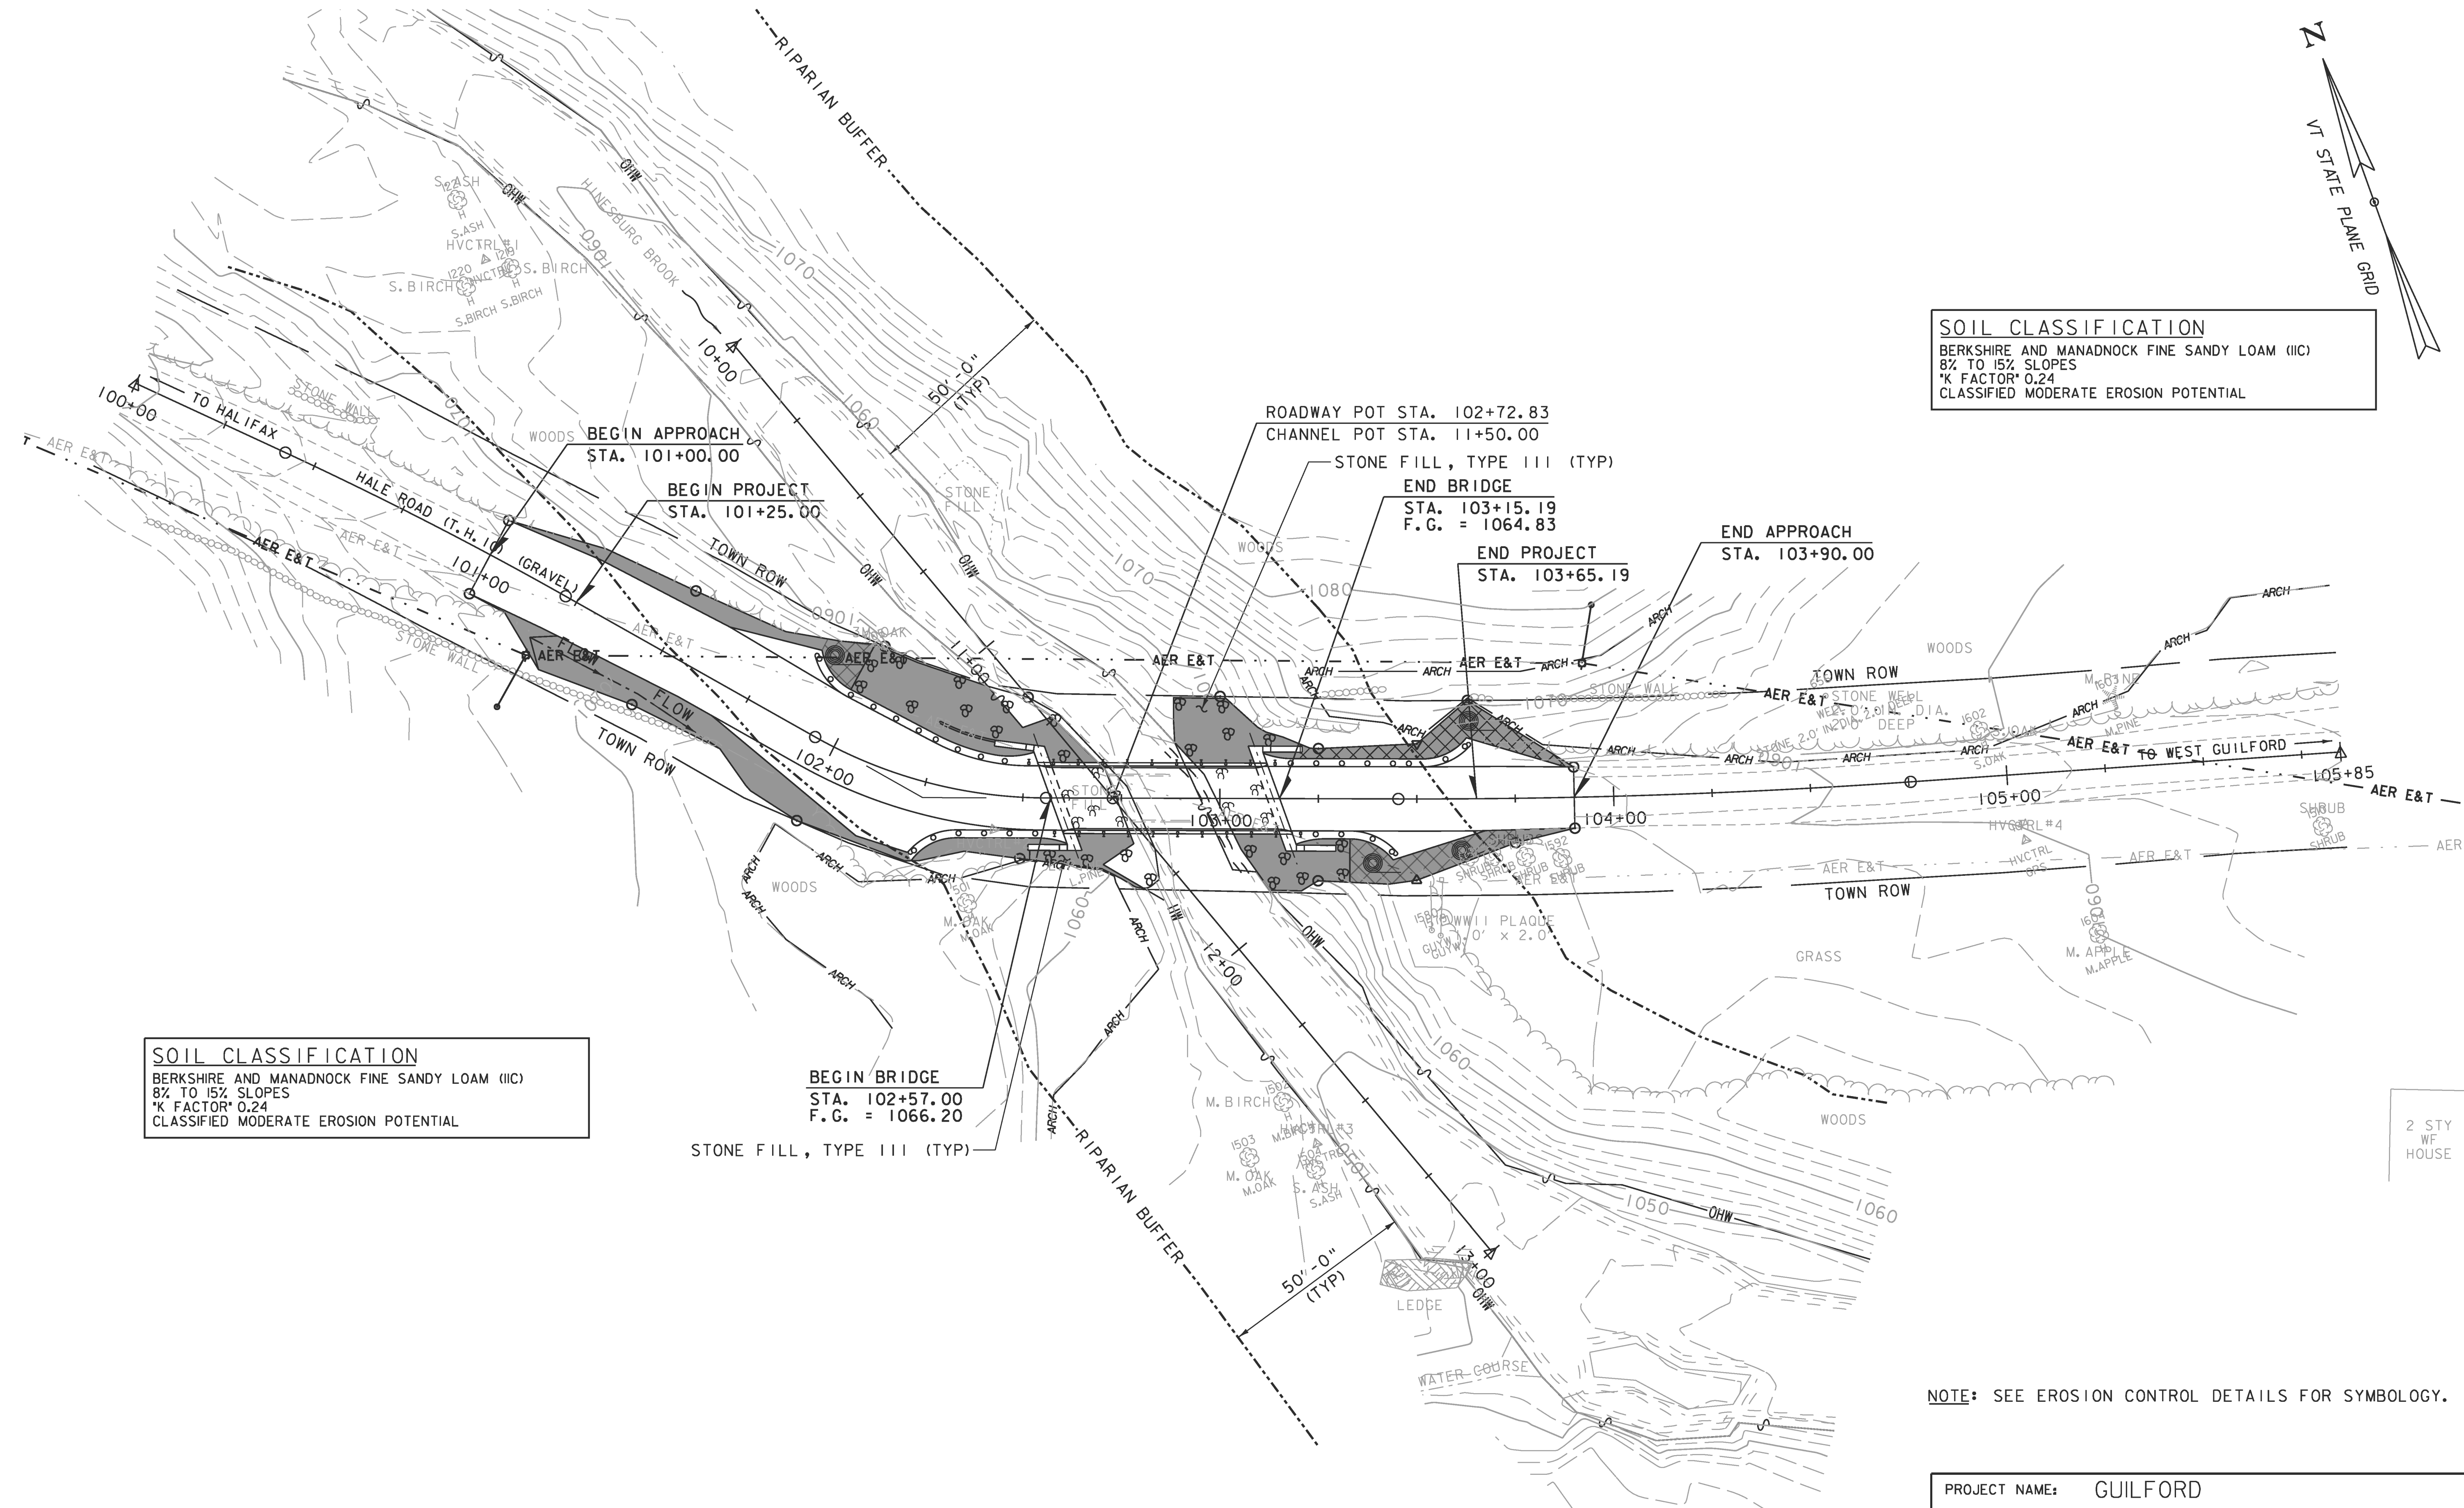


2 STY  
 WF  
 HOUSE

**NOTE:** SEE EROSION CONTROL DETAILS FOR SYMBOLOLOGY.



PROJECT NAME: GUILFORD	PLOT DATE: 10/2/2013
PROJECT NUMBER: BRO 1442(36)	DRAWN BY: E.A. FIALA
FILE NAME: z10j064bdr_ero.dgn	CHECKED BY: S.E. BURBANK
PROJECT LEADER: S.E. BURBANK	SHEET 40 OF 42
DESIGNED BY: S.E. BURBANK	
EPSC FINAL CONDITIONS PLAN	

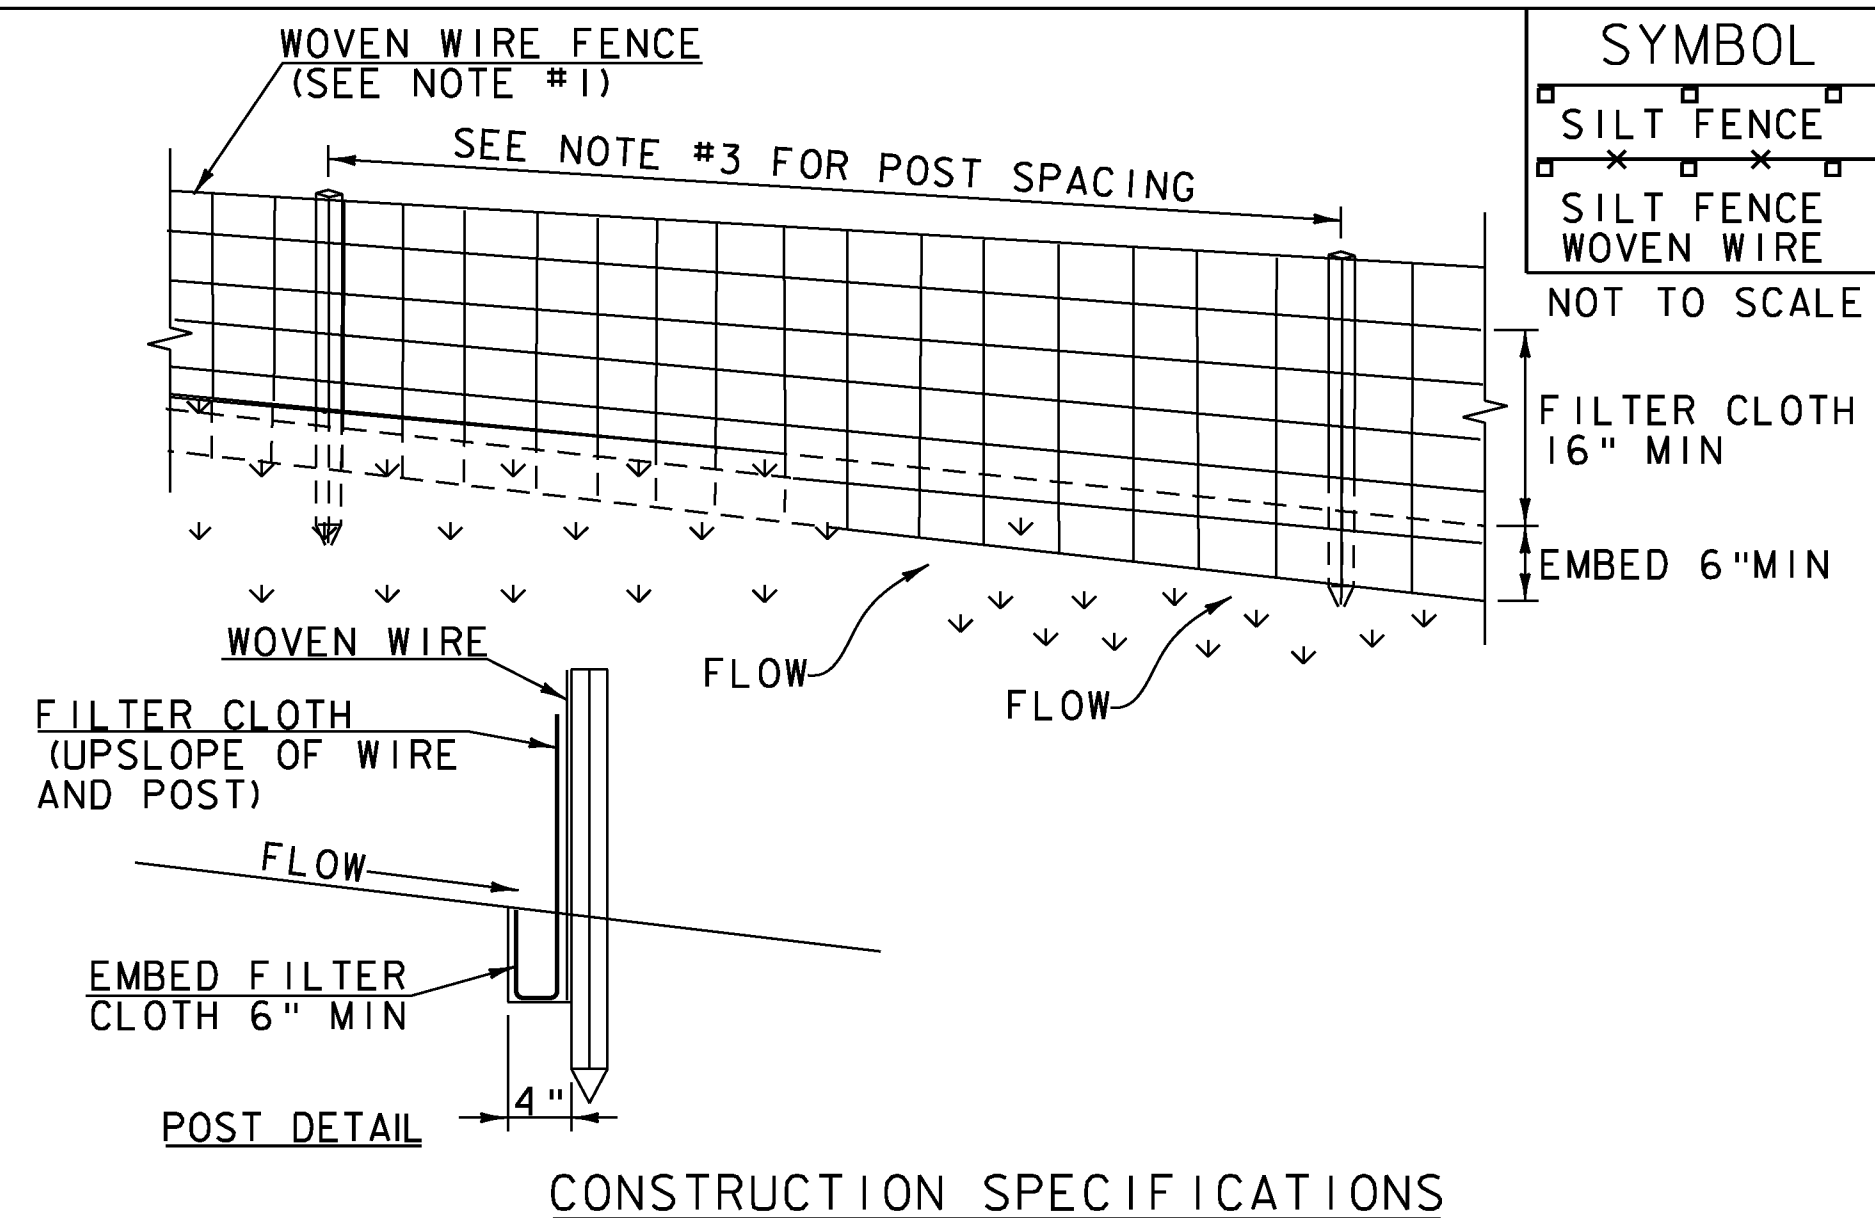

SYMBOL	
	SILT FENCE
	SILT FENCE WOVEN WIRE

- CONSTRUCTION SPECIFICATIONS**
- WOVEN WIRE REINFORCED FENCE IS REQUIRED WITHIN 100' UPSLOPE OF RECEIVING WATERS WHEN THE PROJECT FALLS UNDER A CONSTRUCTION STORMWATER PERMIT. WOVEN WIRE SHALL BE A MIN. 14 GAUGE WITH A 6" MAX. MESH OPENING.
  - FILTER CLOTH SHALL BE EITHER FILTER X, MIRAF1100X, STABILINKA T140N OR APPROVED EQUIVALENT.
  - POST SPACING FOR WIRE-BACKED FENCE SHALL BE 10' MAXIMUM. FOR FILTER-CLOTH FENCE, WHEN ELONGATION IS >50%, POST SPACING SHALL NOT EXCEED 4' AND WHEN ELONGATION IS <50%, POST SPACING SHALL NOT EXCEED 6'.
  - WOVEN WIRE FENCE IS TO BE FASTENED SECURELY TO FENCE POSTS WITH WIRE TIES. FILTER CLOTH IS TO BE FASTENED SECURELY TO WOVEN WIRE FENCE WITH TIES SPACED EVERY 24" AT TOP AND MID SECTION.
  - WHEN TWO SECTIONS OF FILTER CLOTH ADJOIN EACH OTHER THEY SHALL BE OVER-LAPPED BY 6" AND FOLDED.
  - MAINTENANCE SHALL BE PERFORMED AS NEEDED AND MATERIAL REMOVED WHEN SEDIMENT REACHES HALF OF FABRIC HEIGHT.

ADAPTED FROM DETAILS PROVIDED BY: NEW YORK STATE DEC  
ORIGINALLY DEVELOPED BY USDA-NRCS  
VERMONT DEPARTMENT OF ENVIRONMENTAL CONSERVATION

**SILT FENCE**

NOTES:  
REFER TO "THE VERMONT STANDARDS & SPECIFICATIONS FOR EROSION PREVENTION & SEDIMENT CONTROL -2006-" FROM THE VT AGENCY OF NATURAL RESOURCES FOR ADDITIONAL GUIDANCE.

THIS WORK SHALL BE PERFORMED IN ACCORDANCE WITH SECTION 649 AND AS SHOWN IN THE PLANS FOR GEOTEXTILE FOR SILT FENCE (PAY ITEM 649.51) OR GEOTEXTILE FOR SILT FENCE, WOVEN WIRE REINFORCED (PAY ITEM 649.515).

REVISIONS	
MARCH 21, 2008	WHF
DECEMBER 11, 2008	WHF
JANUARY 13, 2009	WHF

VAOT RURAL AREA MIX					
% WEIGHT	LBS/AC		NAME	GERM %	PURITY %
	BROADCAST	HYDROSEED			
37.5%	22.5	45	CREeping RED FESCUE	85%	98%
37.5%	22.5	45	TALL FESCUE	90%	95%
5.0%	3	6	RED TOP	90%	95%
15.0%	9	18	BIRDSFOOT TREFOIL	85%	98%
5.0%	3	6	ANNUAL RYE GRASS	85%	95%
100%	60	120			

VAOT URBAN AREA MIX					
% WEIGHT	LBS/AC		NAME	GERM %	PURITY %
	BROADCAST	HYDROSEED			
42.5%	34	68	CREeping RED FESCUE	85%	98%
10.0%	8	16	PERENNIAL RYE GRASS	90%	95%
42.5%	34	68	KENTUCKY BLUE GRASS	85%	85%
5.0%	4	8	ANNUAL RYE GRASS	85%	95%
100%	80	160			


SOIL AMENDMENT GUIDANCE			
FERTILIZER		LIME	
BROADCAST	HYDROSEED	BROADCAST	HYDROSEED
10-20-10	FOLLOW	PELLETIZED	FOLLOW
600 LBS/AC	MANUFACTURER	2 TONS/AC	MANUFACTURER

- CONSTRUCTION GUIDANCE**
- RURAL SEED MIX: USE AS INDICATED IN THE PLANS AND/OR FOR ALL ESTABLISHED UPLAND (NON WETLAND) AREAS DISTURBED BY THE CONTRACTOR.
  - URBAN SEED MIX: USE AS INDICATED IN THE PLANS AND/OR FOR ALL ESTABLISHED LAWN AREAS DISTURBED BY THE CONTRACTOR.
  - ALL SEED MIXTURES: SHALL NOT HAVE A WEED CONTENT EXCEEDING 0.40% BY WEIGHT AND SHALL BE FREE OF ALL NOXIOUS SEED.
  - FERTILIZER AND LIMESTONE: SHALL FOLLOW RATES SHOWN ON PLAN OR AS DIRECTED BY THE ENGINEER
  - HAY MULCH: TO BE PLACED ON EARTH SLOPES AT THE RATE OF 2 TONS/ACRE, ACHIEVE 90% GROUND COVER OR AS DIRECTED BY THE ENGINEER.
  - TOPSOIL: TO BE USED WITH SEED AS INDICATED ON THE PLANS, OR AS DIRECTED BY THE ENGINEER.
  - HYDROSEEDING: ALTHOUGH GUIDANCE IS GIVEN ABOVE THE SITE CONDITIONS AND THE TYPE OF HYDROSEED WILL ULTIMATELY DICTATE THE AMOUNTS AND TYPES OF SOIL AMENDMENTS TO BE APPLIED
  - TURF ESTABLISHMENT: PLACING SEED, FERTILIZER, LIME AND MULCH PRIOR TO SEPTEMBER 15 AND AFTER APRIL 15 CAN BETTER ENSURE A VIGOROUS GROWTH OF GRASS.

ADAPTED FROM VTRANS TECHNICAL LANDSCAPE MANUAL FOR ROADWAYS AND TRANSPORTATION FACILITIES

**TURF ESTABLISHMENT**

REVISIONS	
JUNE 23, 2009	WHF
JANUARY 15, 2010	WHF
FEBRUARY 16, 2011	WHF

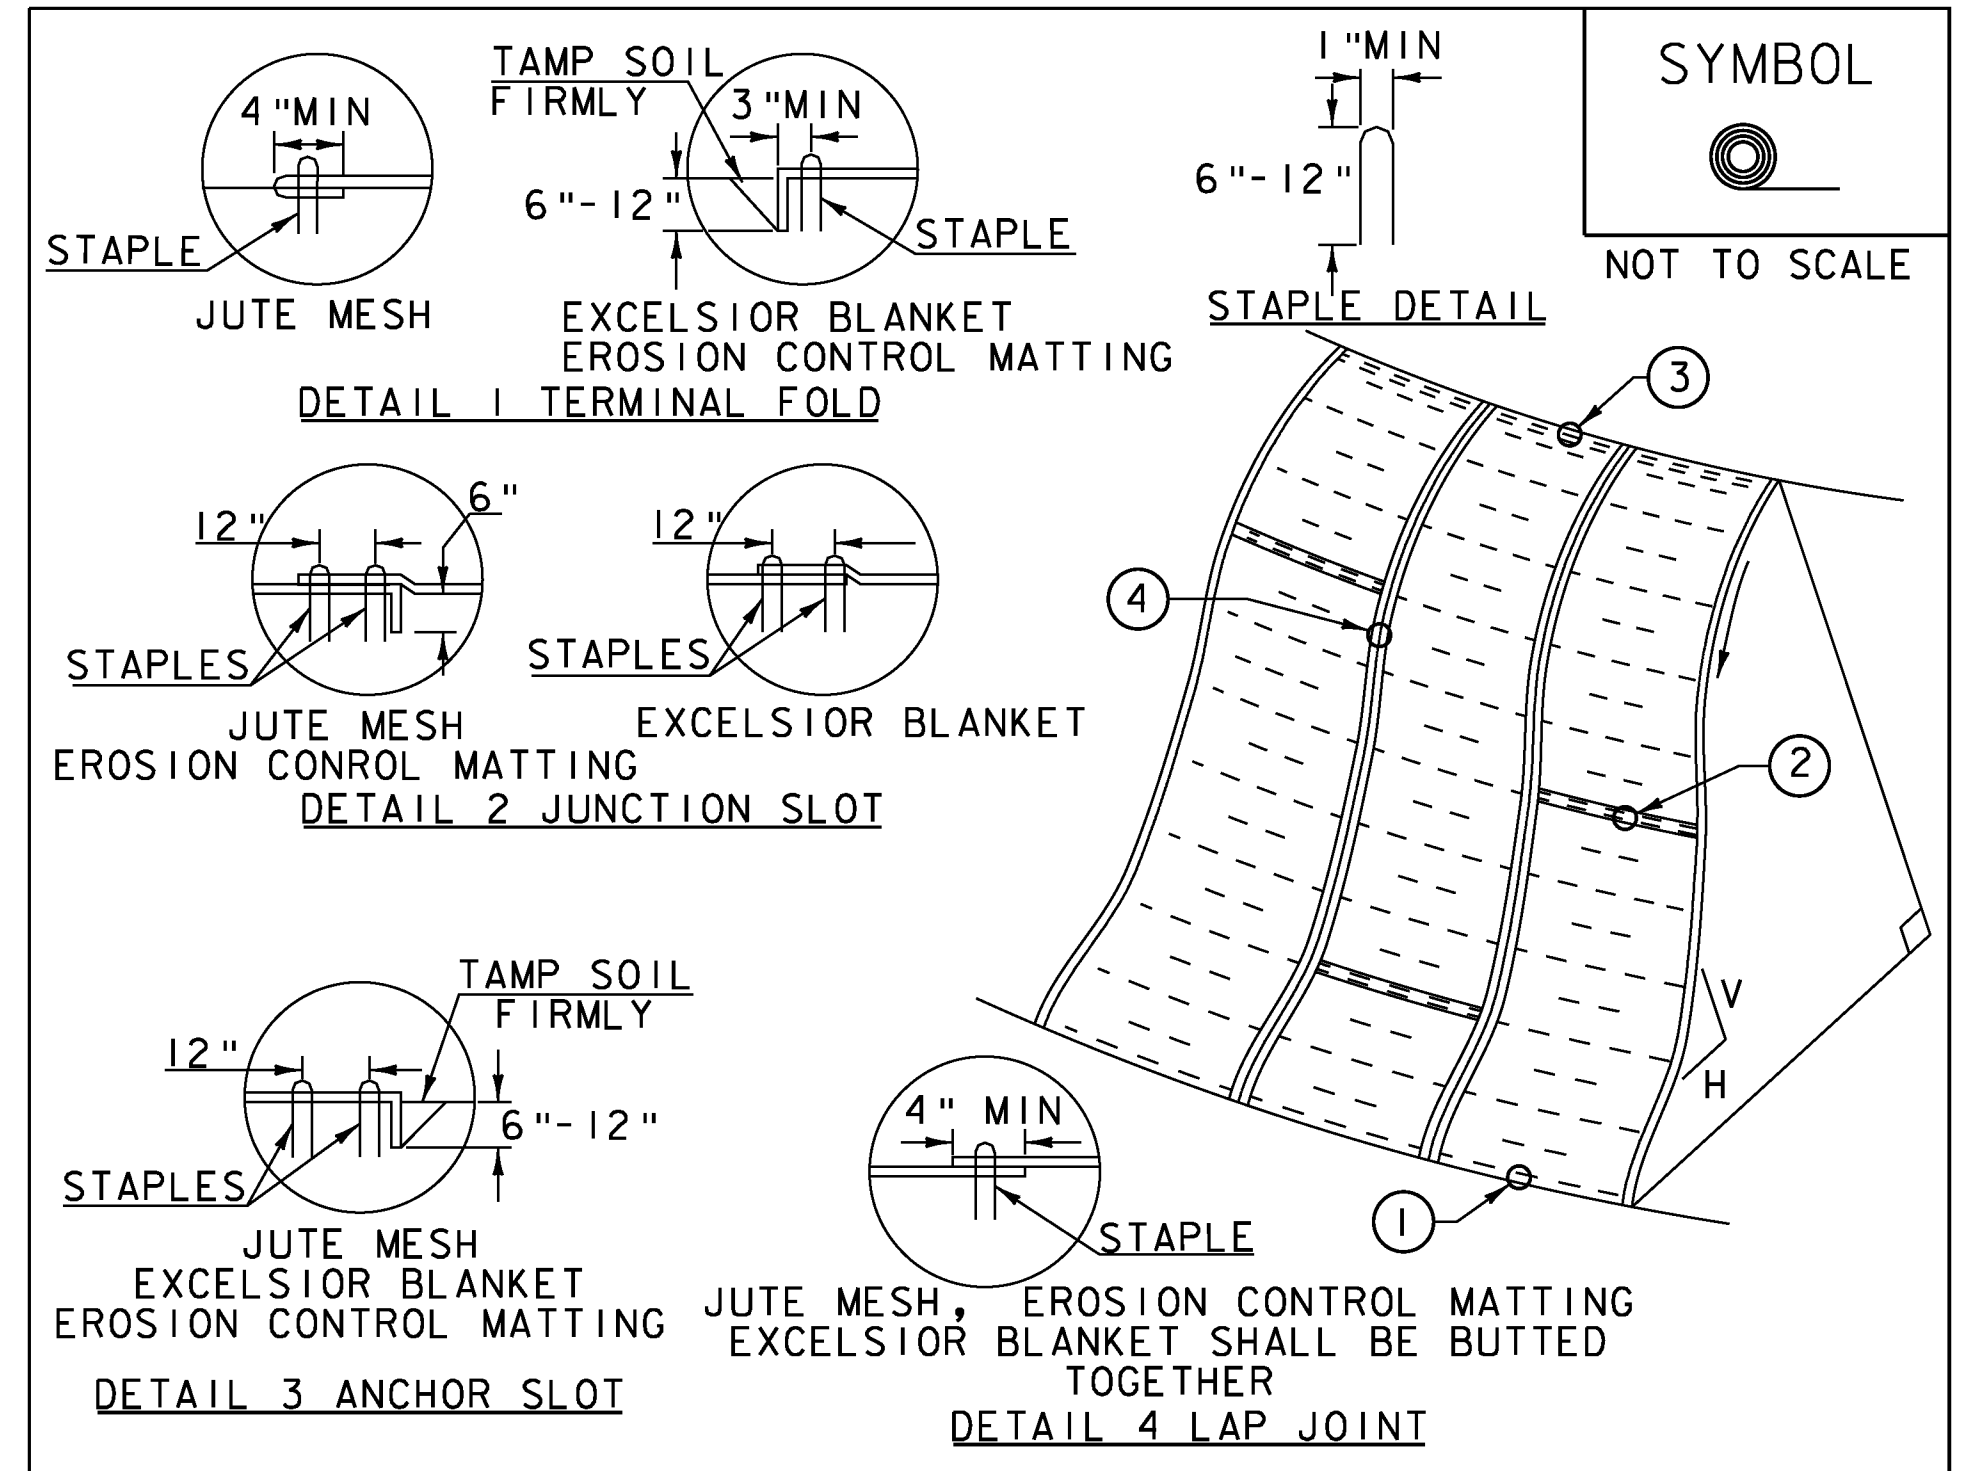

SYMBOL	
	NOT TO SCALE

- CONSTRUCTION SPECIFICATIONS**
- APPLY TO SLOPES GREATER THAN 3H:1V OR WHERE NECESSARY TO AID IN ESTABLISHING VEGETATION.
  - APPLY FERTILIZER, LIME SEED PRIOR TO PLACING MATTING.
  - STAPLES ARE TO BE PLACED ALTERNATELY, IN COLUMNS APPROXIMATELY 2' APART AND IN ROWS APPROXIMATELY 3' APART. APPROXIMATELY 175 STAPLES ARE REQUIRED PER 4'X225' ROLL OF MATERIAL AND 125 STAPLES ARE REQUIRED PER 4'X150' ROLL OF MATERIAL.
  - DISTURBED AREAS SHALL BE SMOOTHLY GRADED. EROSION CONTROL MATERIAL SHALL BE PLACED LOOSELY OVER GROUND SURFACE. DO NOT STRETCH.
  - ALL TERMINAL ENDS AND TRANSVERSE LAPS SHALL BE STAPLED AT APPROXIMATELY 12" INTERVALS.

ADAPTED FROM DETAILS PROVIDED BY: NEW YORK STATE DEC  
ORIGINALLY DEVELOPED BY USDA-NRCS  
VERMONT DEPARTMENT OF ENVIRONMENTAL CONSERVATION


**ROLLED EROSION CONTROL PRODUCT (RECP) SIDE SLOPE**

NOTES:  
REFER TO "THE VERMONT STANDARDS & SPECIFICATIONS FOR EROSION PREVENTION & SEDIMENT CONTROL -2006-" FROM THE VT AGENCY OF NATURAL RESOURCES FOR ADDITIONAL GUIDANCE.  
THIS WORK SHALL BE PERFORMED IN ACCORDANCE WITH SECTION 653 AND AS SHOWN IN THE PLANS FOR TEMPORARY EROSION MATTING (PAY ITEM 653.20) OR PERMANENT EROSION MATTING (PAY ITEM 653.21).

REVISIONS	
APRIL 16, 2007	JMF
JANUARY 13, 2009	WHF

PROJECT NAME:	GUILFORD	PLOT DATE:	10/2/2013	
PROJECT NUMBER:	BRO 1442(36)	DRAWN BY:	K.D. WENTWORTH	
FILE NAME:	z10j064details_ero.dgn	DESIGNED BY:	VTRANS	
PROJECT LEADER:	S.E. BURBANK	EROSION CONTROL DETAILS (1 OF 2)	CHECKED BY:	S.E. BURBANK
			SHEET	41 OF 42



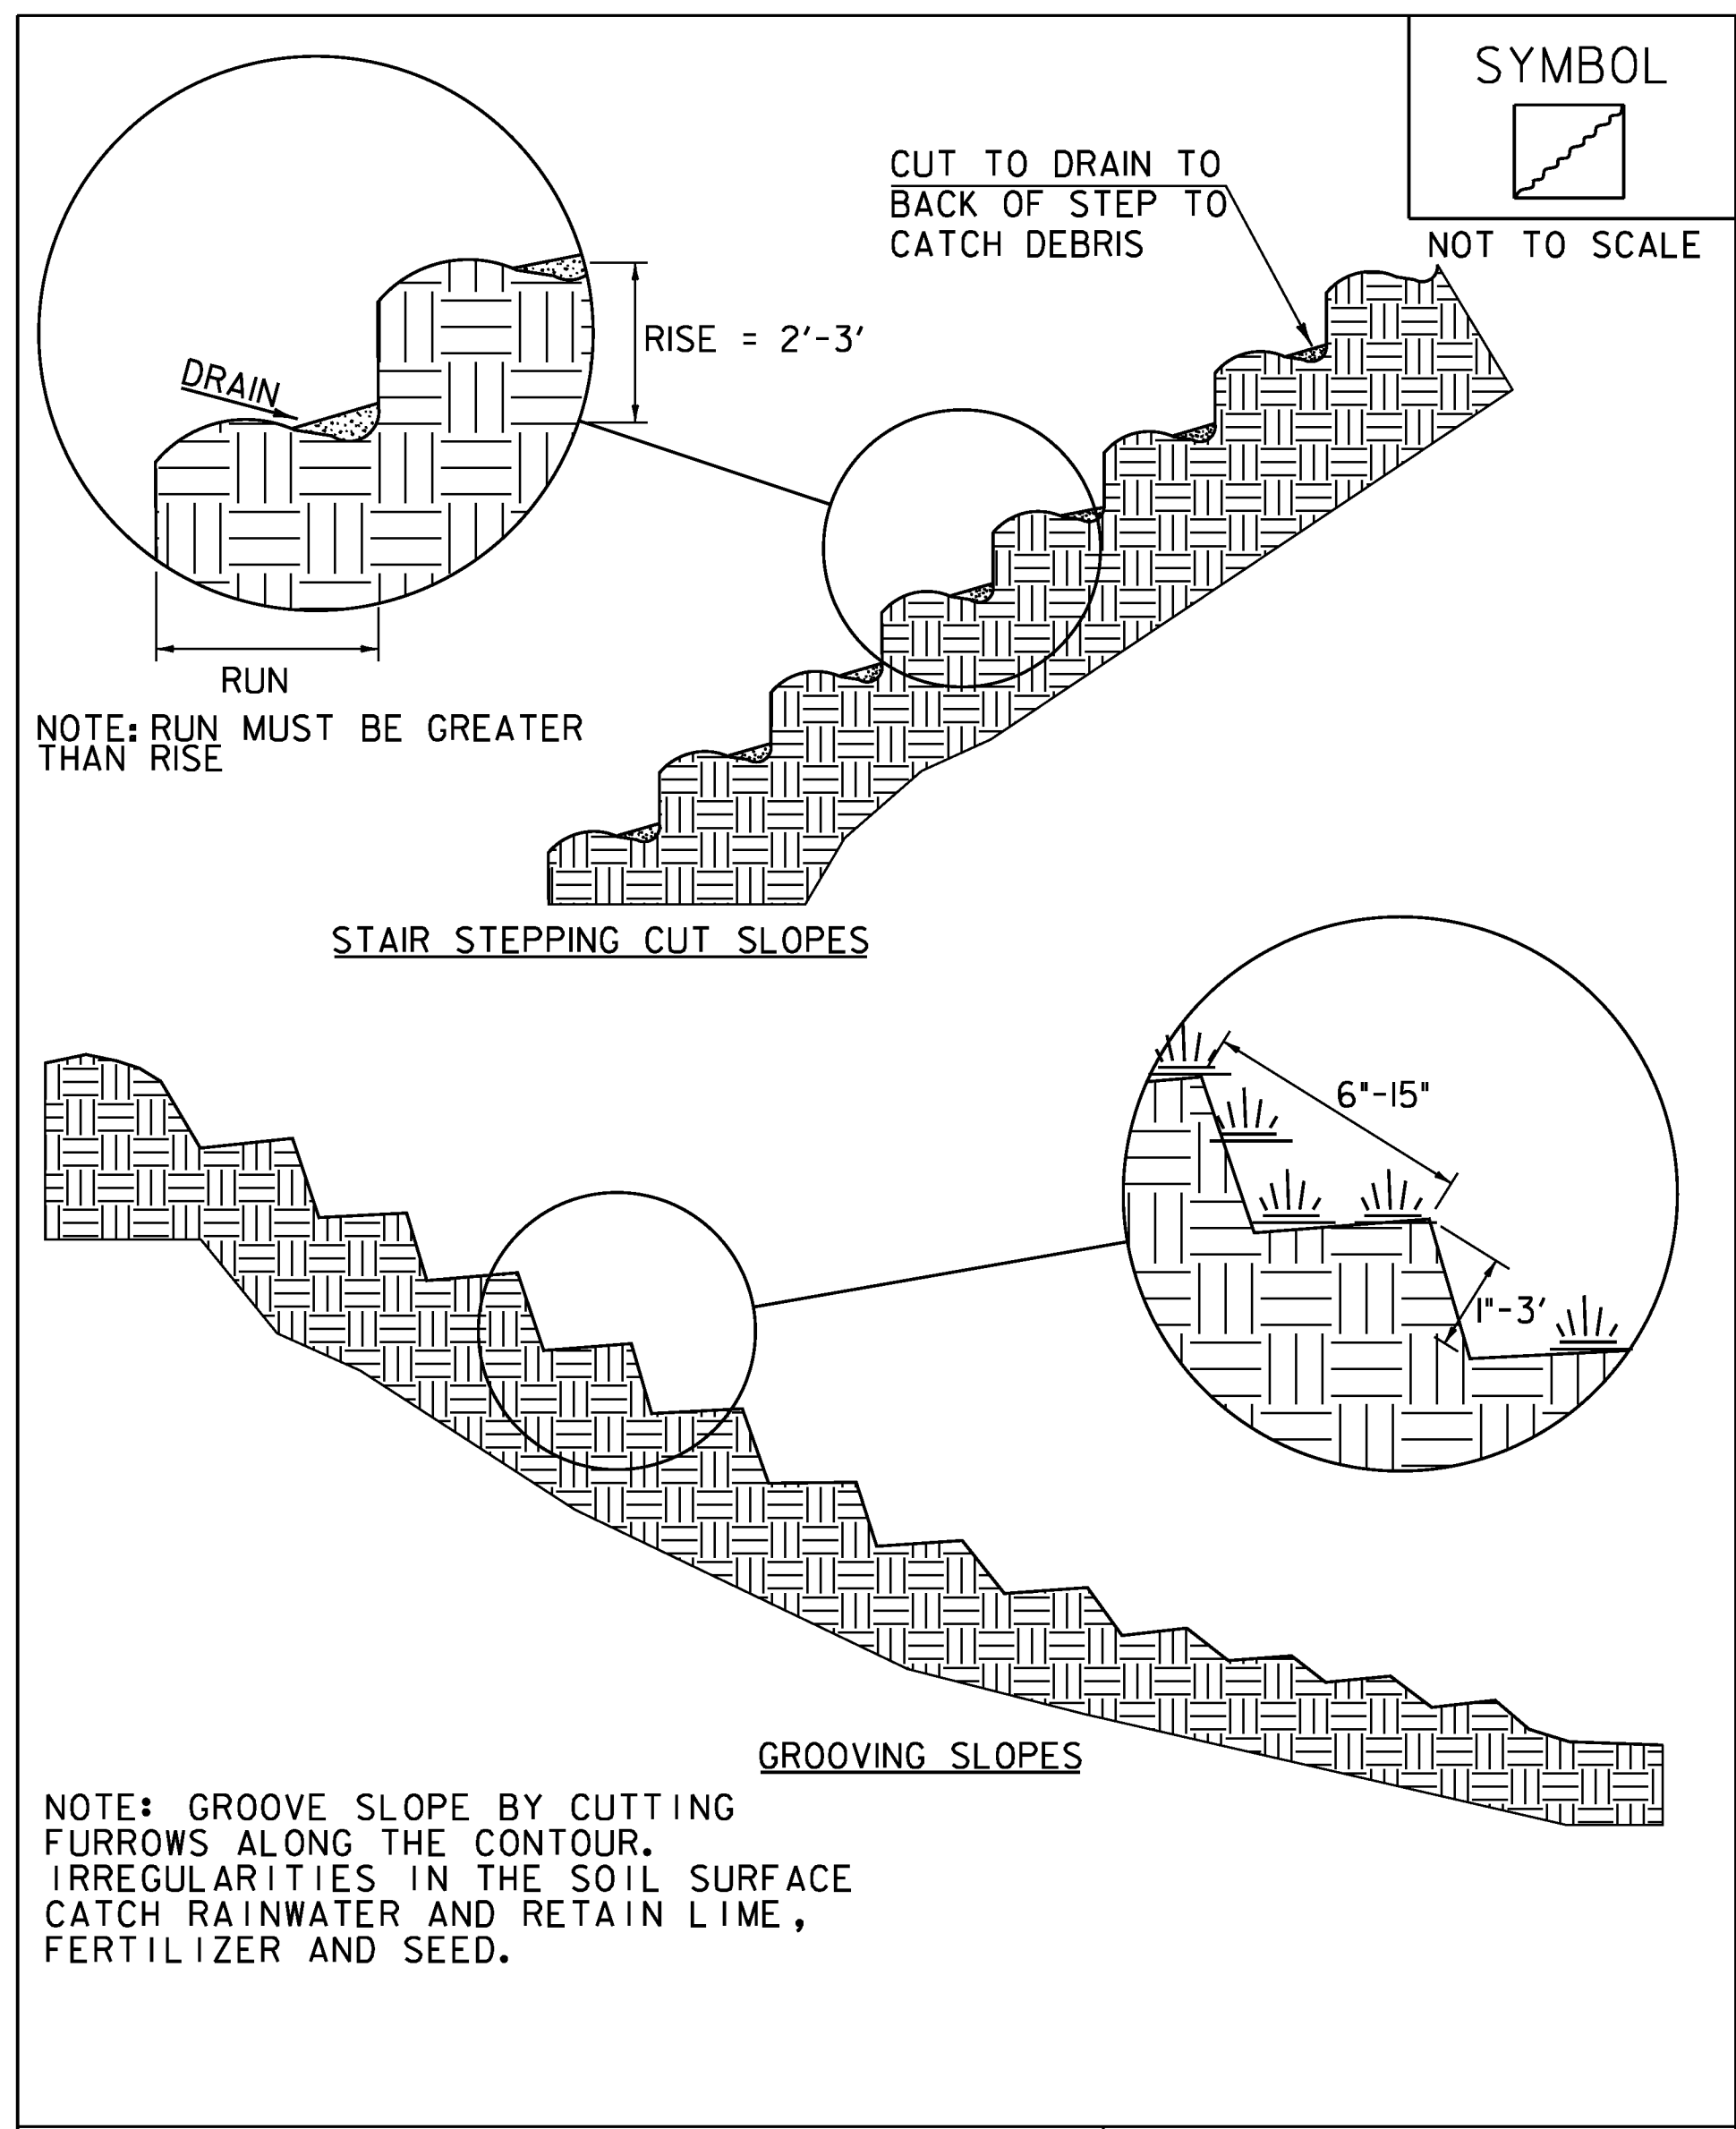


ADAPTED FROM DETAILS PROVIDED BY: NEW YORK STATE DEC  
ORIGINALLY DEVELOPED BY USDA-NRCS  
VERMONT DEPARTMENT OF ENVIRONMENTAL CONSERVATION

NOTES:  
REFER TO "THE VERMONT STANDARDS & SPECIFICATIONS FOR  
EROSION PREVENTION & SEDIMENT CONTROL -2006- "FROM  
THE VT AGENCY OF NATURAL RESOURCES FOR ADDITIONAL  
GUIDANCE.

THIS WORK SHALL BE CONSIDERED INCIDENTAL TO THE  
CONTRACT

**SURFACE ROUGHENING**

REVISIONS	
APRIL 1, 2008	WHF
JANUARY 13, 2009	WHF

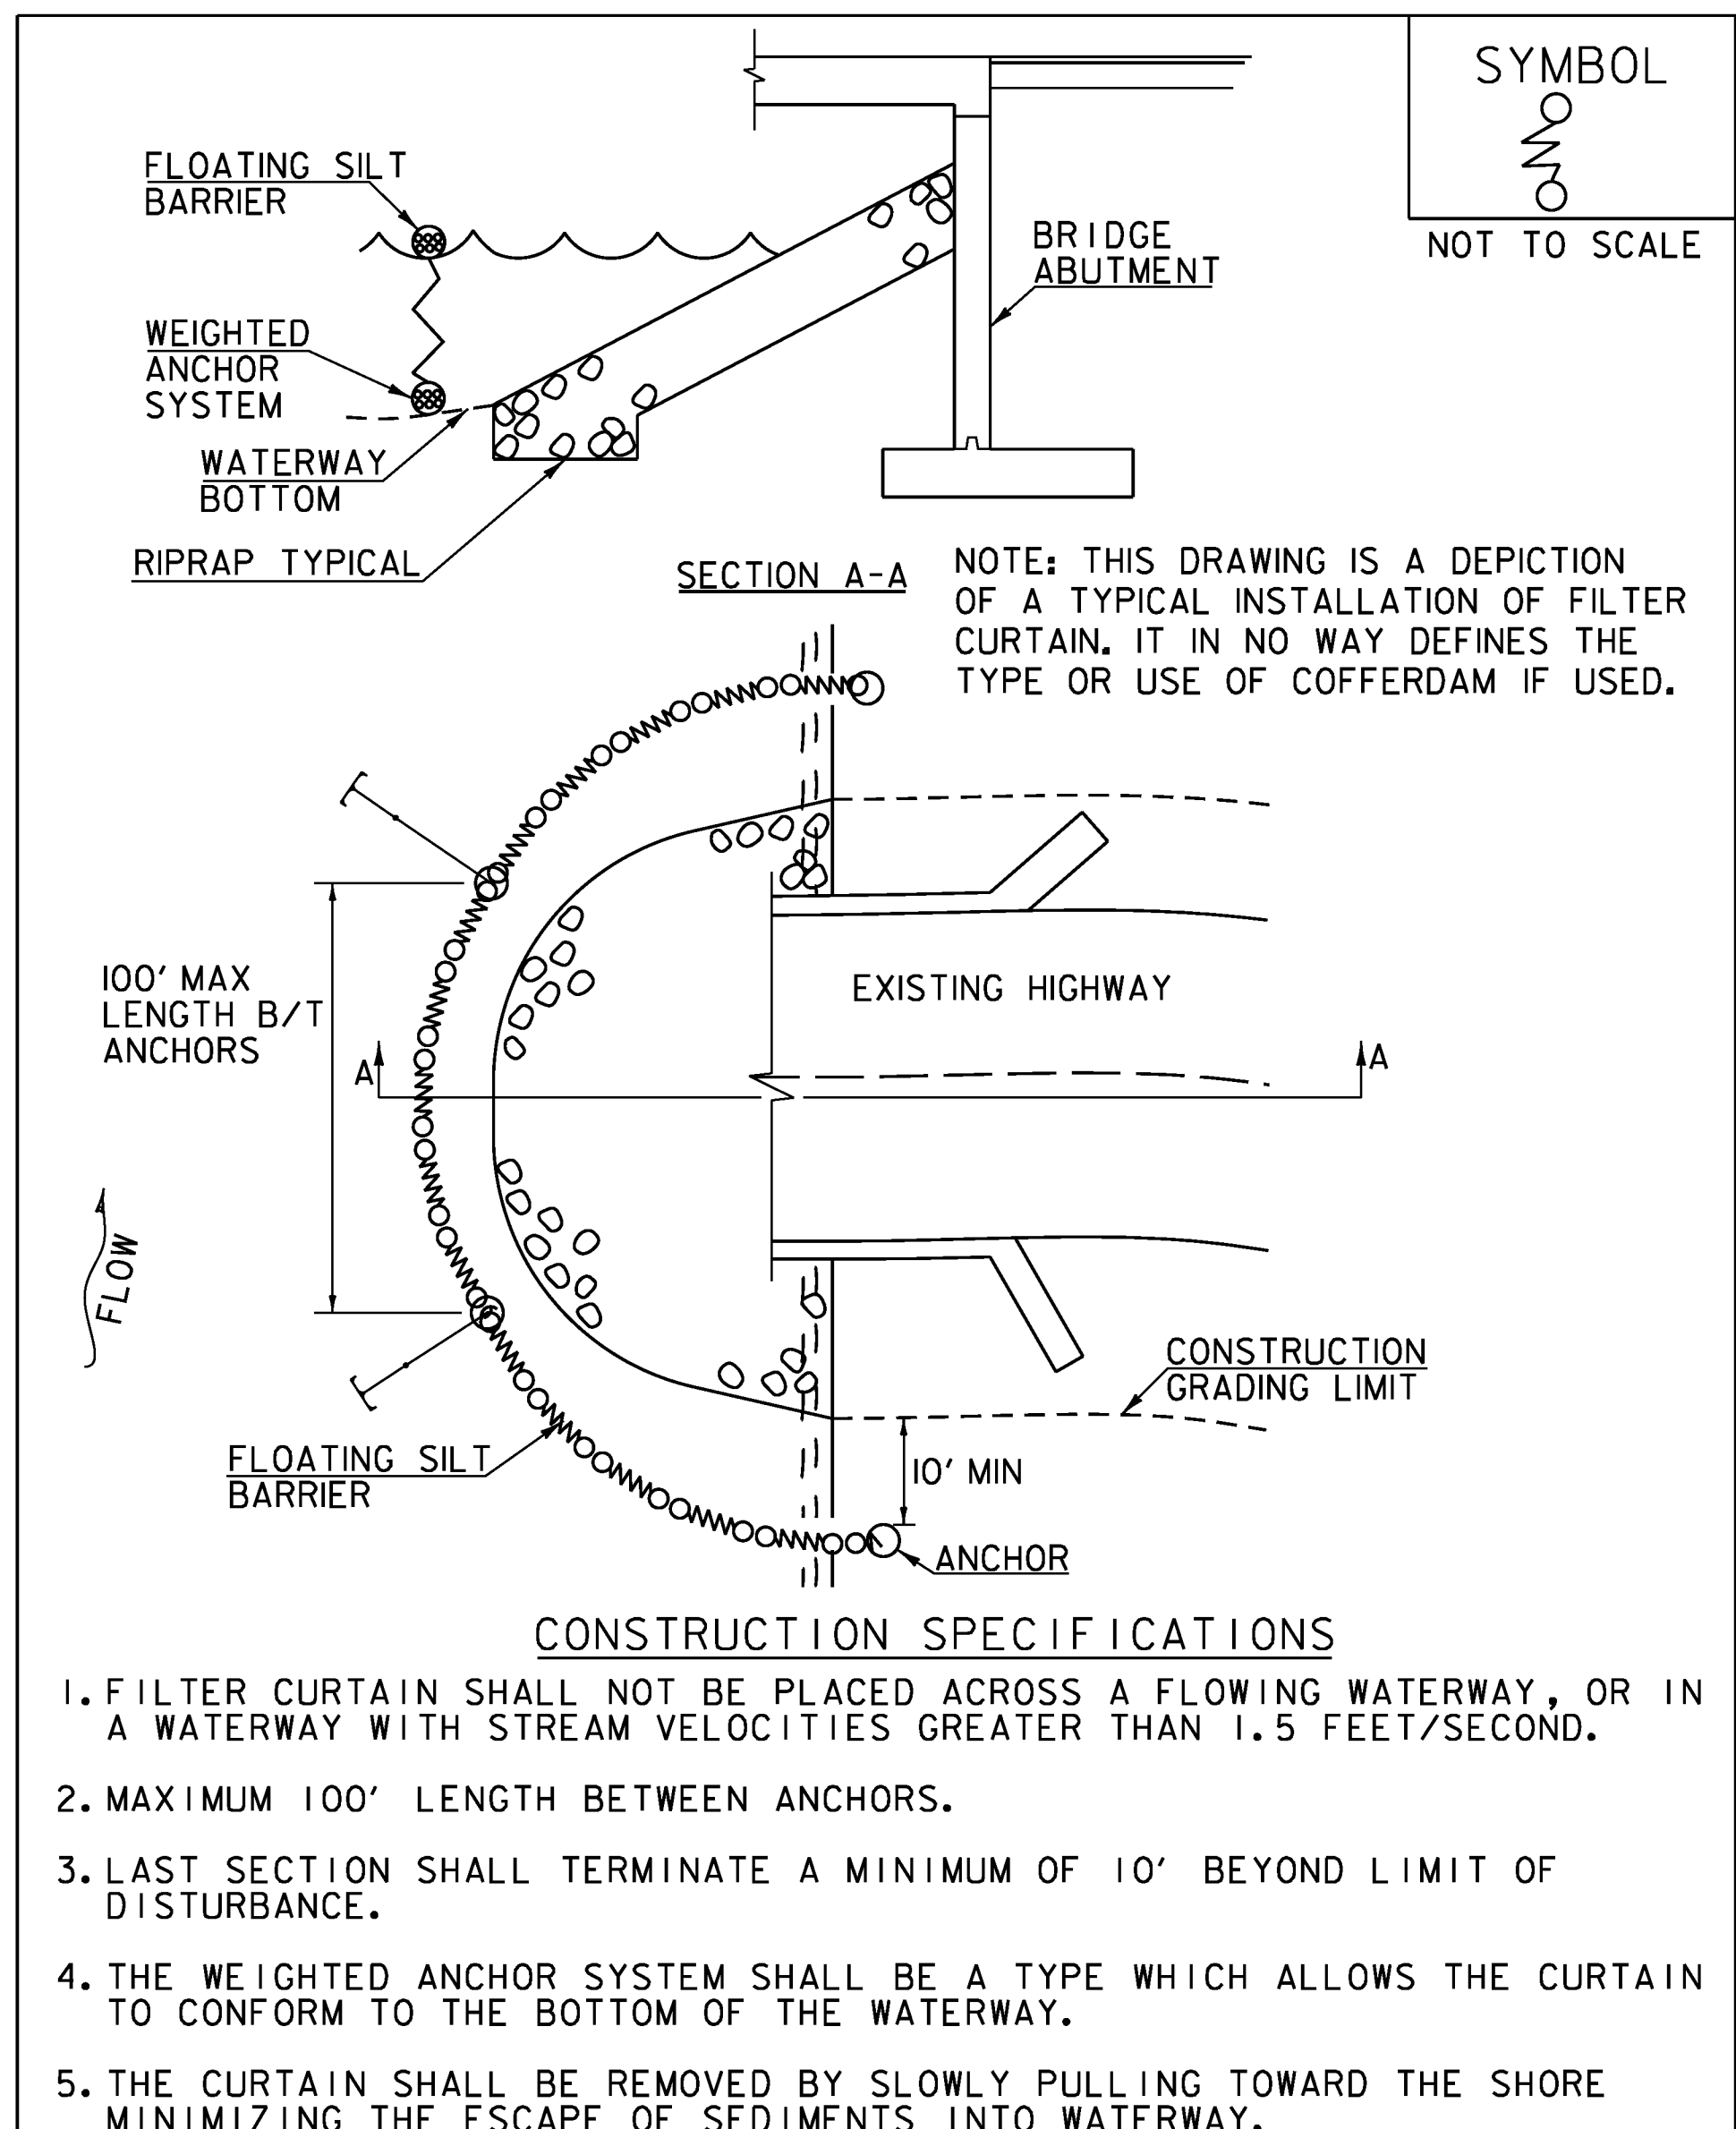


ADAPTED FROM DETAILS PROVIDED BY: NEW YORK STATE DEC  
ORIGINALLY DEVELOPED BY USDA-NRCS  
VERMONT DEPARTMENT OF ENVIRONMENTAL CONSERVATION

NOTES:  
REFER TO "THE VERMONT STANDARDS & SPECIFICATIONS FOR  
EROSION PREVENTION & SEDIMENT CONTROL -2006- "FROM  
THE VT AGENCY OF NATURAL RESOURCES FOR ADDITIONAL  
GUIDANCE.

THIS WORK SHALL BE PERFORMED IN ACCORDANCE WITH  
SECTION 649 FOR GEOTEXTILE FOR FILTER CURTAIN (PAY  
ITEM 649.6).

**FILTER CURTAIN**

REVISIONS	
APRIL 1, 2008	WHF
JANUARY 13, 2009	WHF
SEPTEMBER 4, 2009	WHF

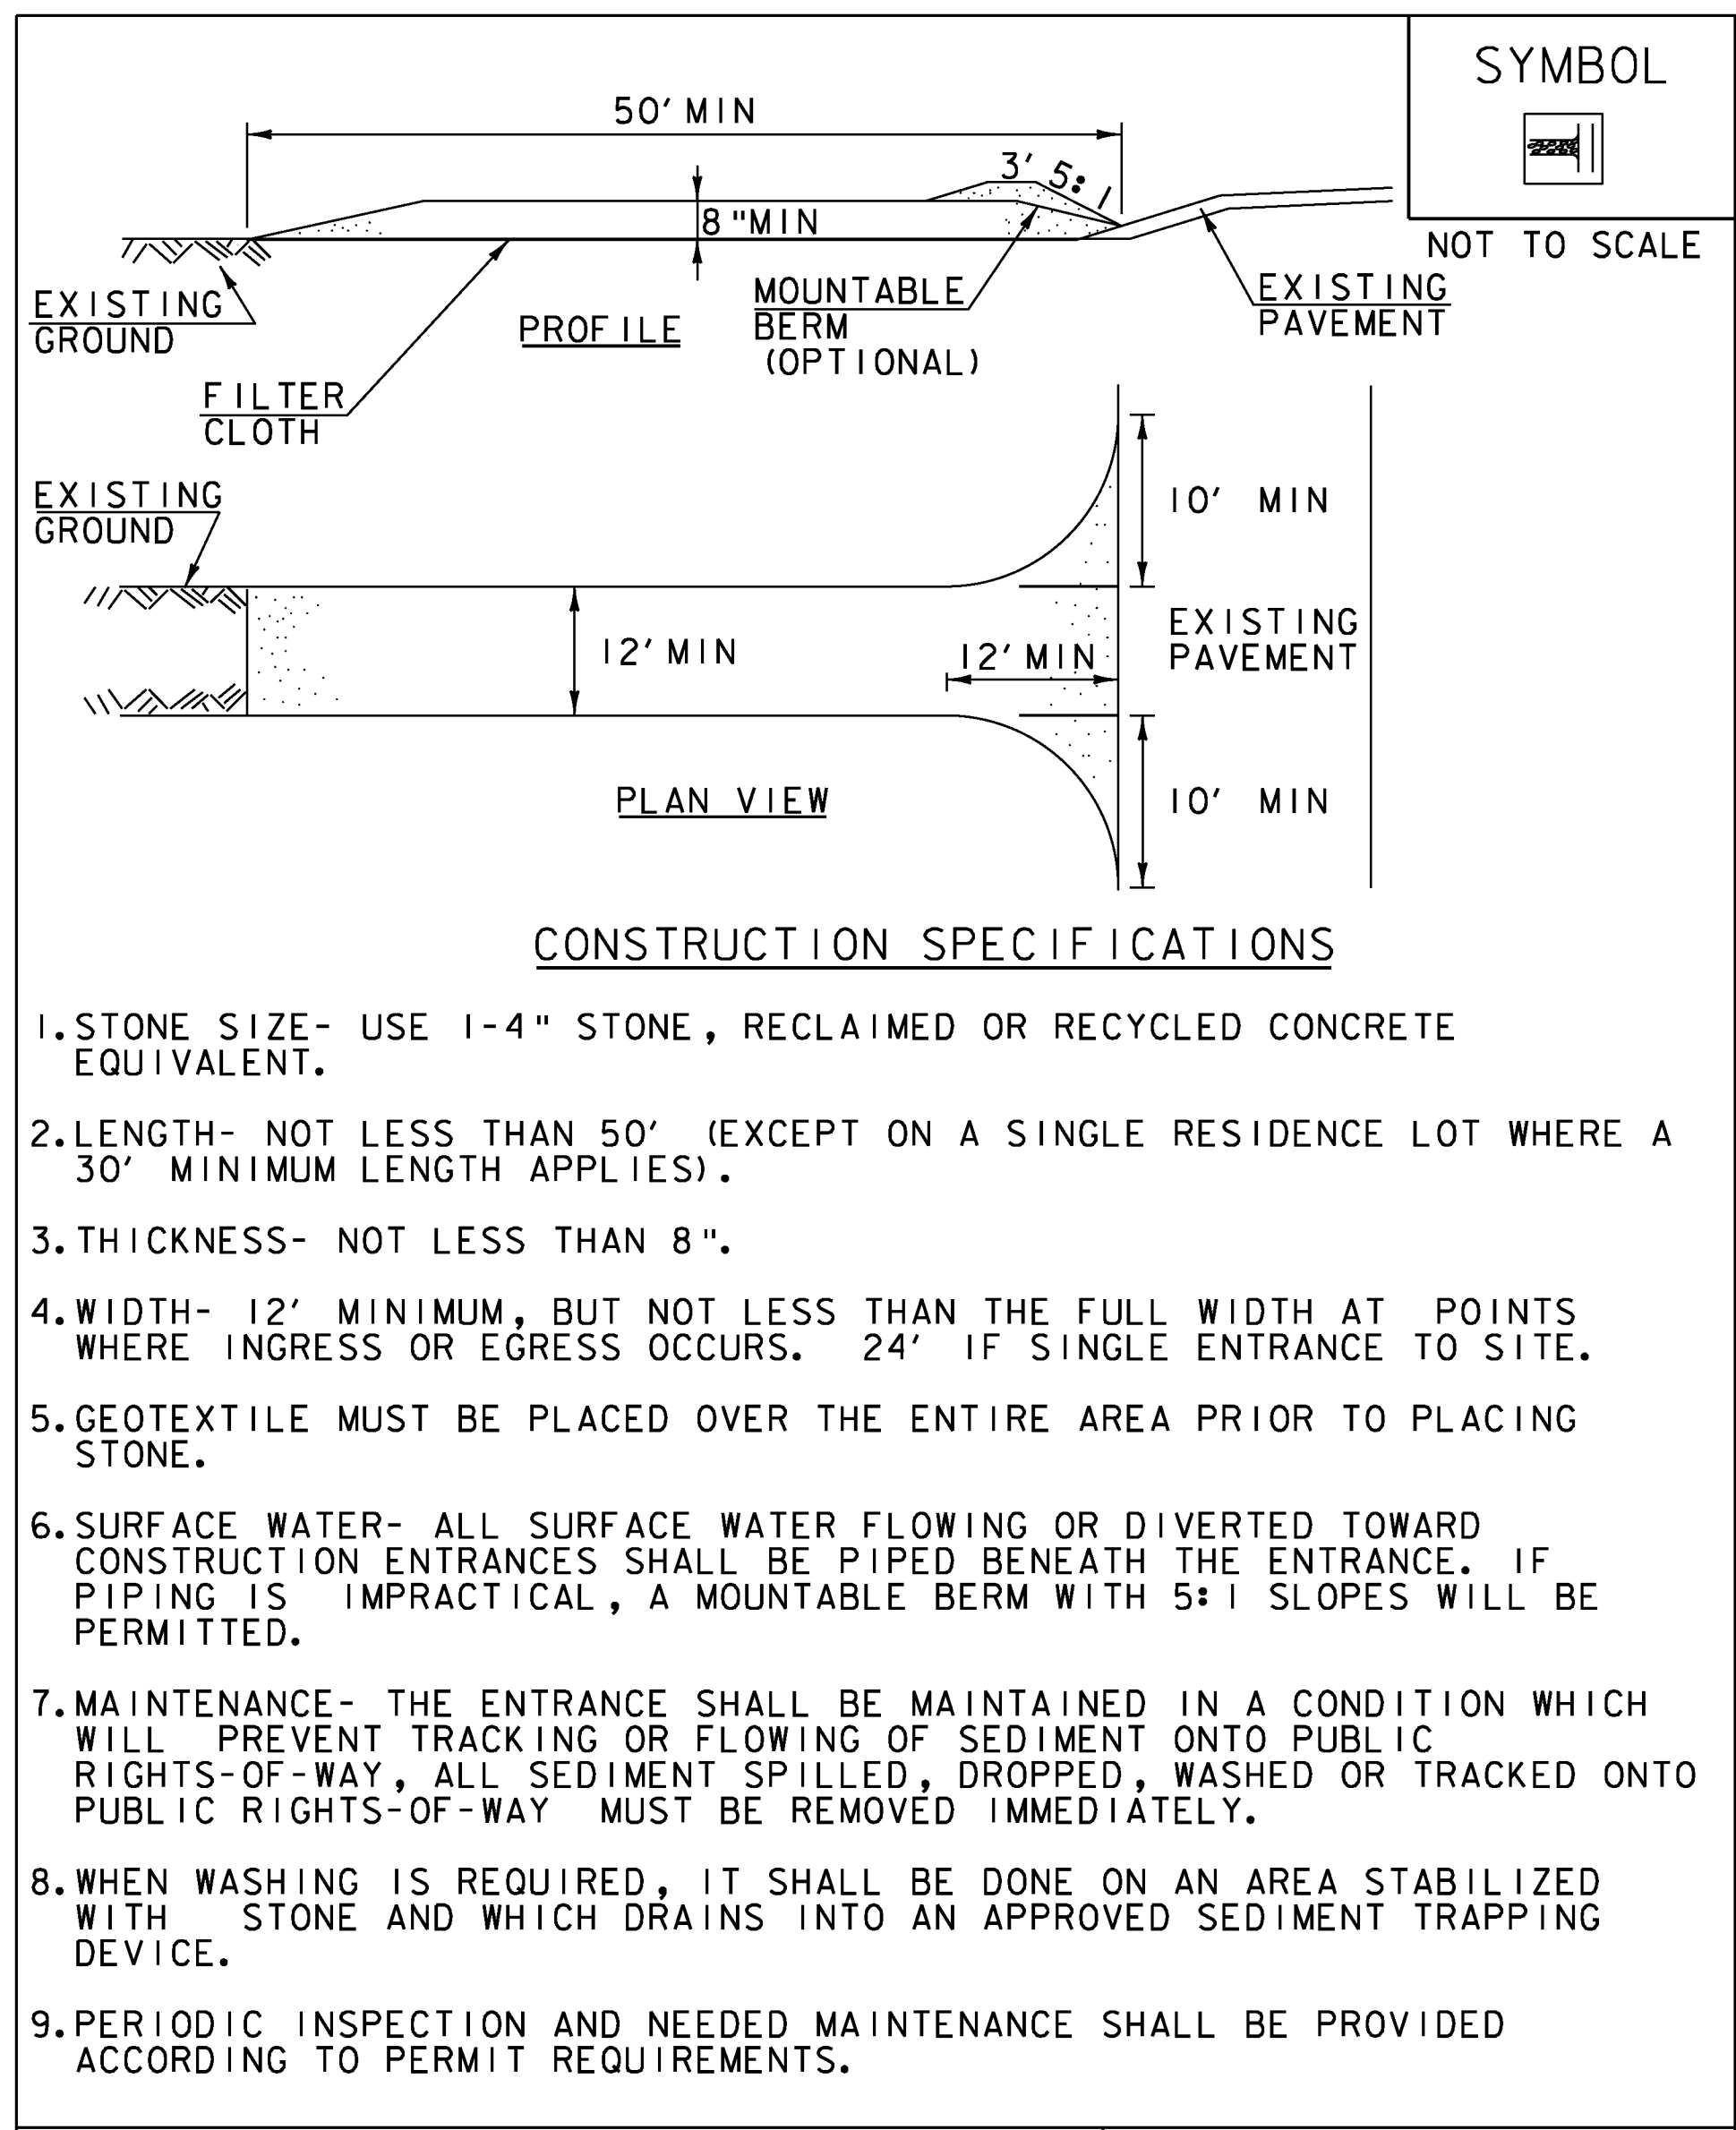

ADAPTED FROM DETAILS PROVIDED BY: NEW YORK STATE DEC  
ORIGINALLY DEVELOPED BY USDA-NRCS  
VERMONT DEPARTMENT OF ENVIRONMENTAL CONSERVATION

NOTES:  
REFER TO "THE VERMONT STANDARDS & SPECIFICATIONS FOR  
EROSION PREVENTION & SEDIMENT CONTROL -2006- "FROM  
THE VT AGENCY OF NATURAL RESOURCES FOR ADDITIONAL  
GUIDANCE.

THIS WORK SHALL BE PERFORMED IN ACCORDANCE WITH  
SECTION 653 FOR VEHICLE TRACKING PAD (PAY ITEM 653.35)  
OR AS SPECIFIED IN THE CONTRACT.

**STABILIZED  
CONSTRUCTION  
ENTRANCE**


REVISIONS	
MARCH 24, 2008	WHF
JANUARY 13, 2009	WHF

PROJECT NAME:	GUILFORD	PLOT DATE:	10/2/2013	
PROJECT NUMBER:	BRO 1442(36)	DRAWN BY:	K.D. WENTWORTH	
FILE NAME:	z10j064details_ero.dgn	DESIGNED BY:	VTRANS	
PROJECT LEADER:	S.E. BURBANK	EROSION CONTROL DETAILS (2 OF 2)	CHECKED BY:	S.E. BURBANK
			SHEET	42 OF 42




**CONCRETE GENERAL NOTES**

- ALL EXPOSED EDGES OF CONCRETE SHALL BE CHAMFERED 1" x 1"

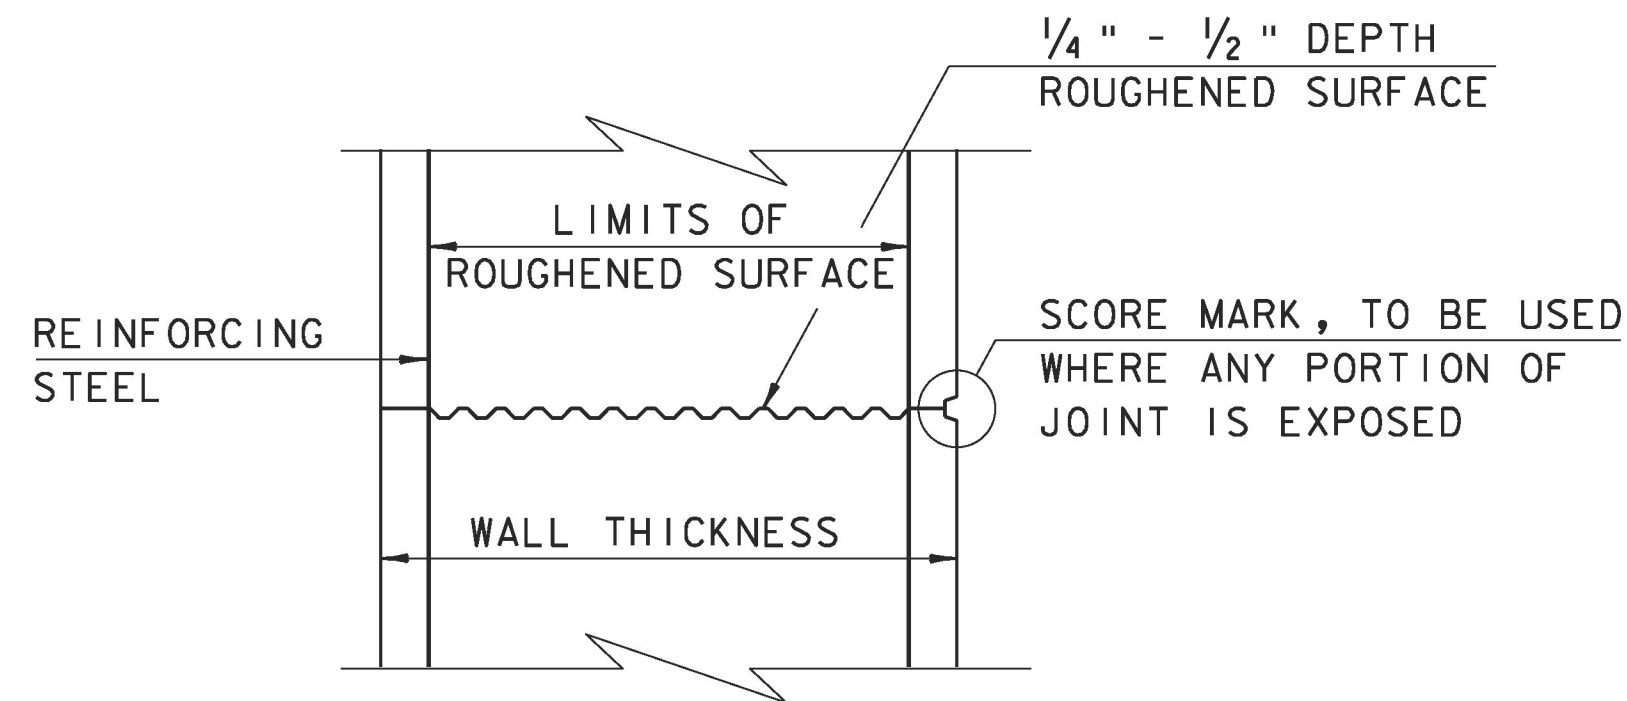


**TYPICAL HORIZONTAL CONSTRUCTION JOINT**  
(NOT TO SCALE)


- THE SURFACE OF THE CONCRETE CONSTRUCTION JOINTS SHALL BE CLEANED AND FREE OF LAITANCE.
- IMMEDIATELY BEFORE NEW CONCRETE IS PLACED, ALL CONSTRUCTION JOINTS SHALL BE WETTED AND STANDING WATER REMOVED.

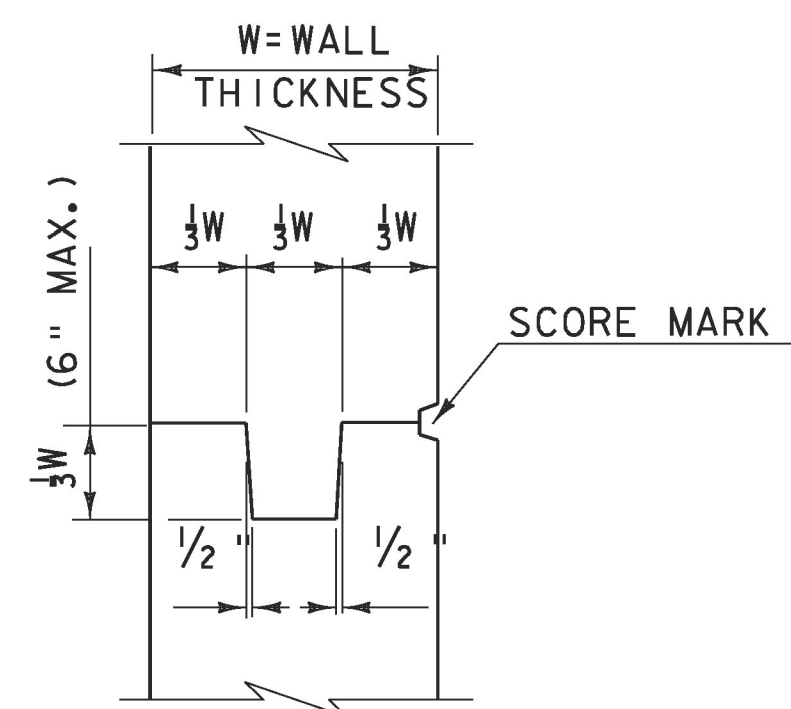


**TYPICAL CONCRETE CONSTRUCTION JOINT**  
(NOT TO SCALE)

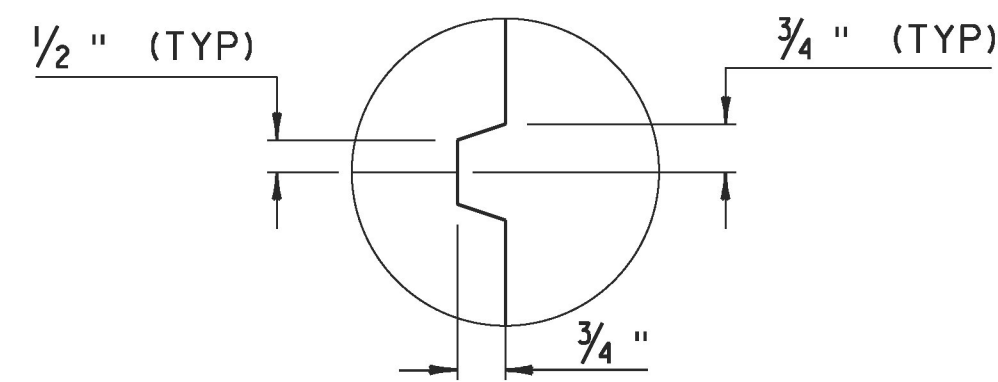


**SCORE MARK DETAIL**  
(NOT TO SCALE)

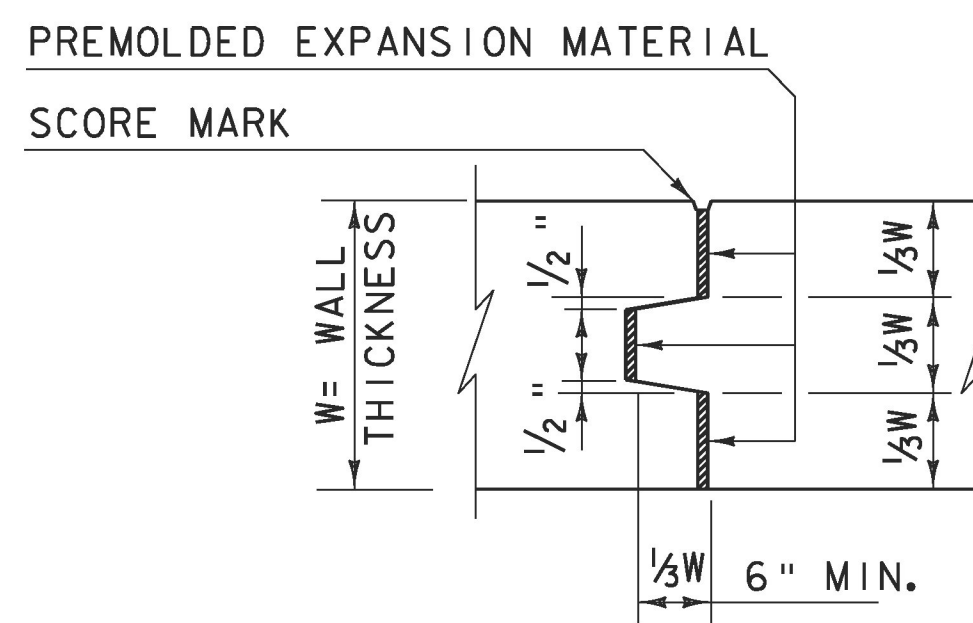

**TYPICAL CONCRETE EXPANSION JOINT**  
(NOT TO SCALE)

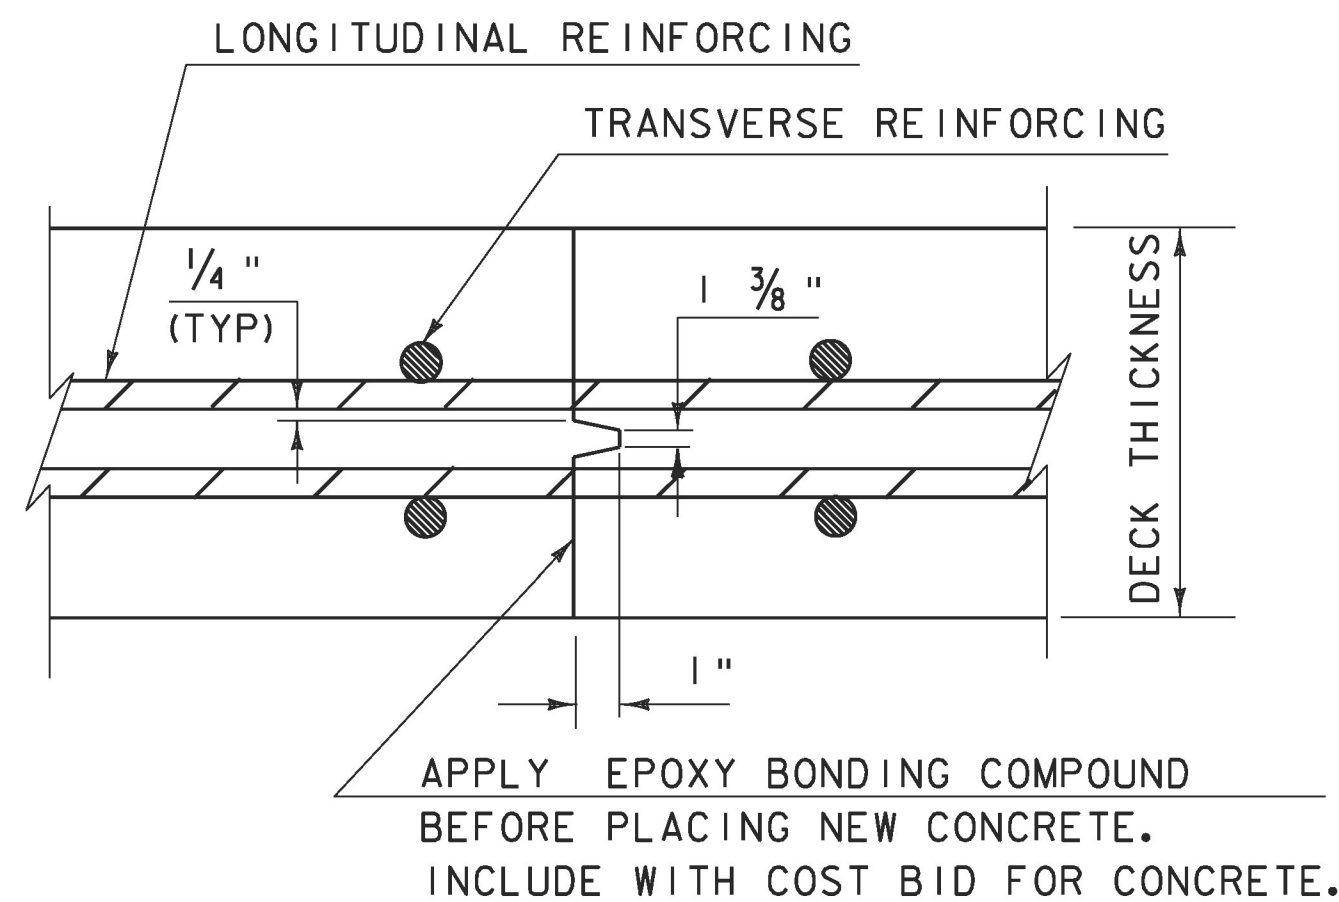


**TRANSVERSE BRIDGE SLAB CONSTRUCTION JOINT DETAILS**  
(NOT TO SCALE)

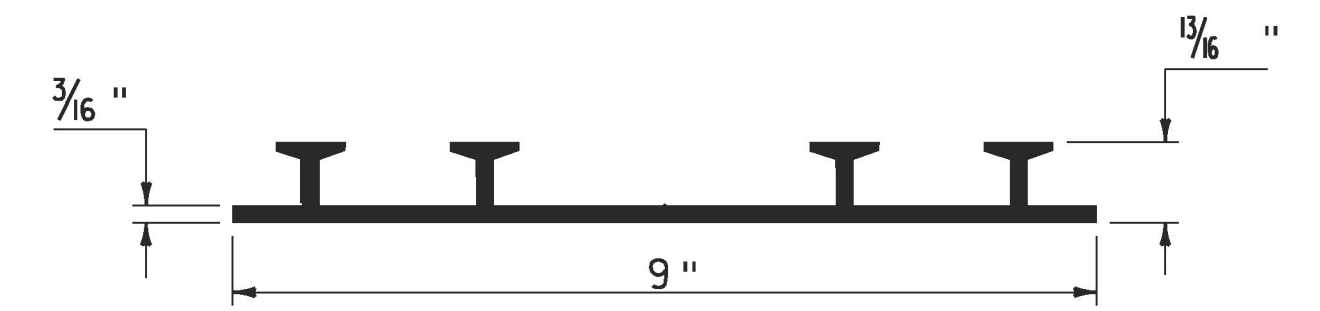

**P.V.C. WATERSTOP FOR CONSTRUCTION JOINTS**  
(NOT TO SCALE)

PAYMENT FOR THE P.V.C. WATERSTOP SHALL BE INCIDENTAL TO THE UNIT BID PRICE FOR THE ADJACENT CONCRETE.


OTHER CONFIGURATIONS OF WATERSTOP MAY BE USED UPON APPROVAL OF THE ENGINEER.

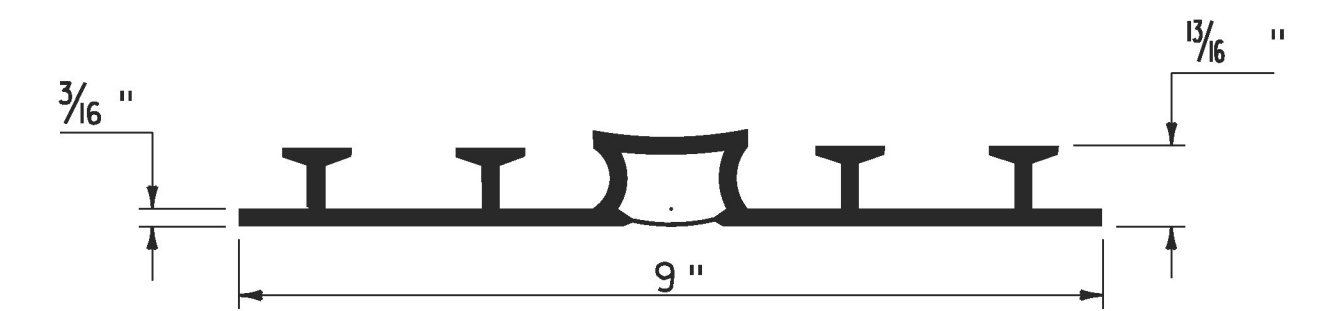

**P.V.C. WATERSTOP FOR EXPANSION JOINTS**  
(NOT TO SCALE)

PAYMENT FOR THE P.V.C. WATERSTOP SHALL BE INCIDENTAL TO THE UNIT BID PRICE FOR THE ADJACENT CONCRETE.


OTHER CONFIGURATIONS OF WATERSTOP MAY BE USED UPON APPROVAL OF THE ENGINEER.

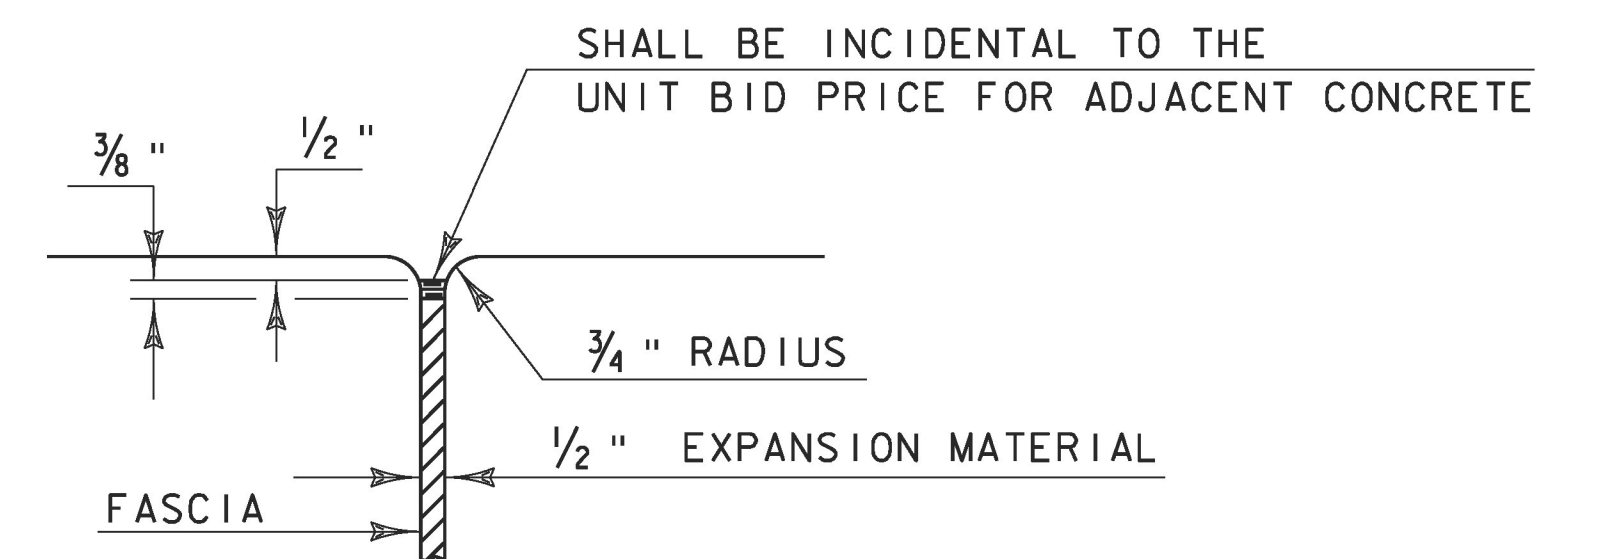


**JOINT BETWEEN FASCIA AND WINGWALL**  
(NOT TO SCALE)

REVISIONS	
MAY 7, 2010	APPROVED FOR USE BY VAOT STRUCTURES SECTION


**CONCRETE  
DETAILS AND NOTES**

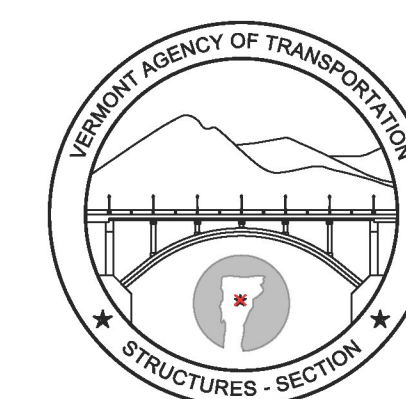


**STRUCTURES  
DETAIL  
SD-5 01.00**

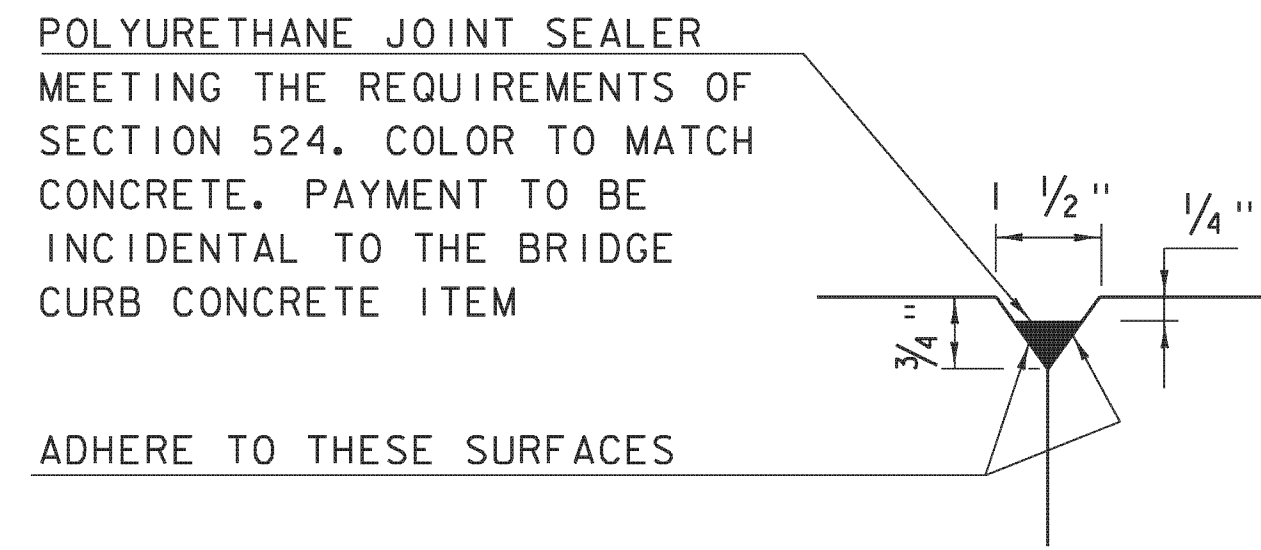


DETAIL "B"  
(NOT TO SCALE)

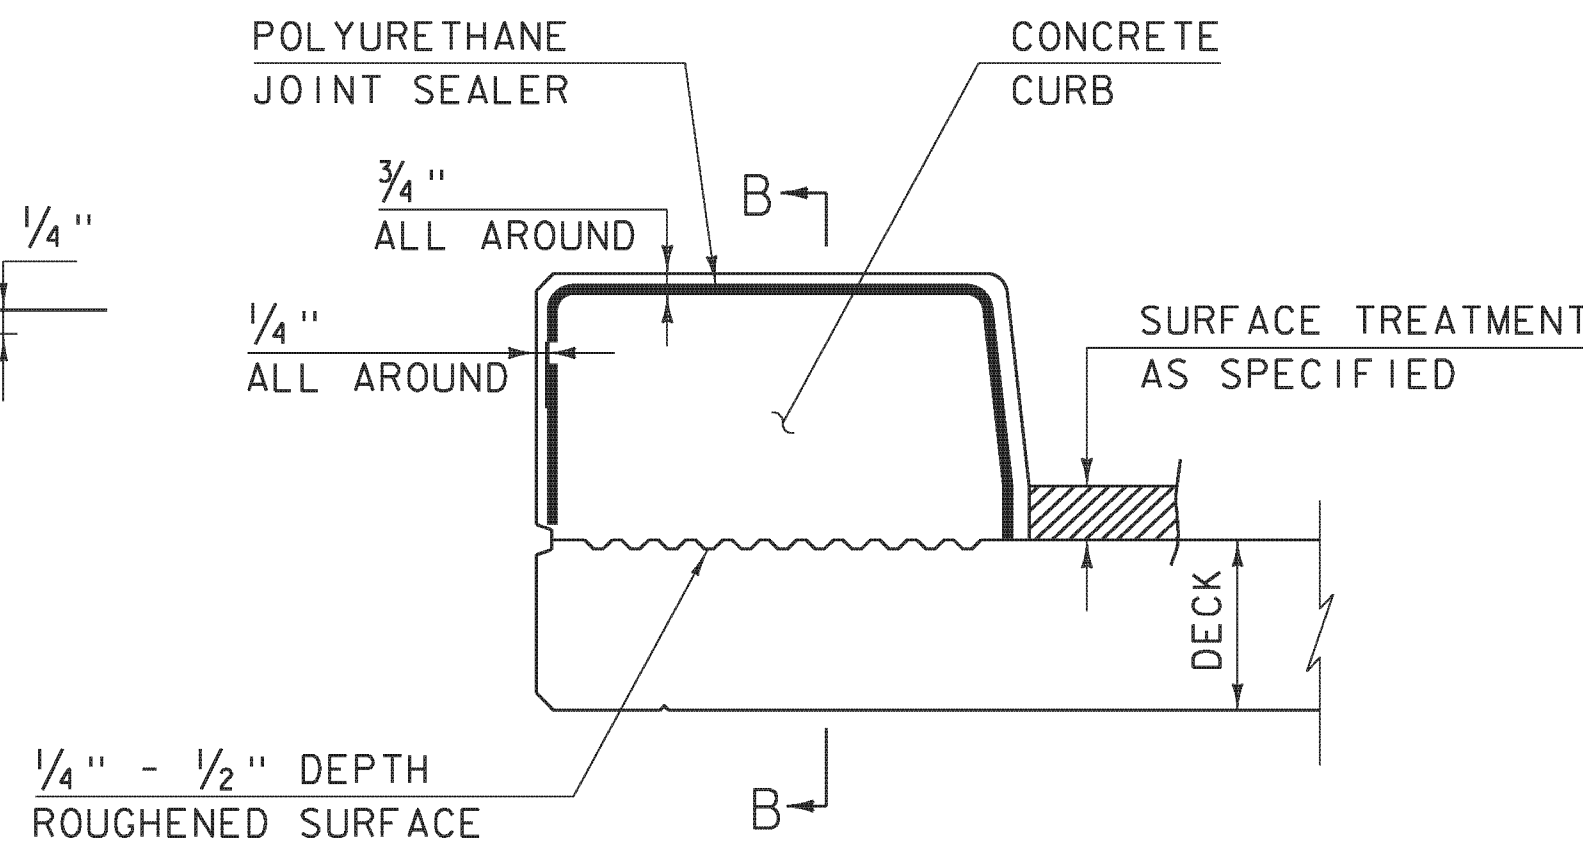

CONCRETE CURB JOINT SECTION  
(NOT TO SCALE)

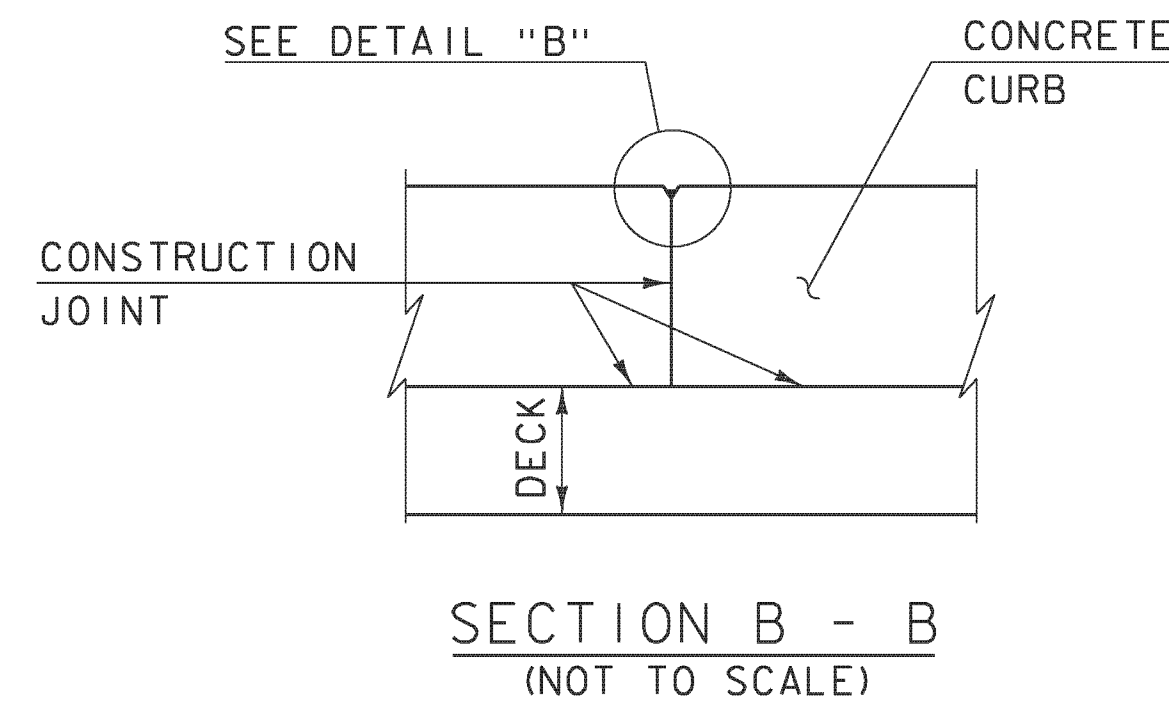

SECTION B - B  
(NOT TO SCALE)

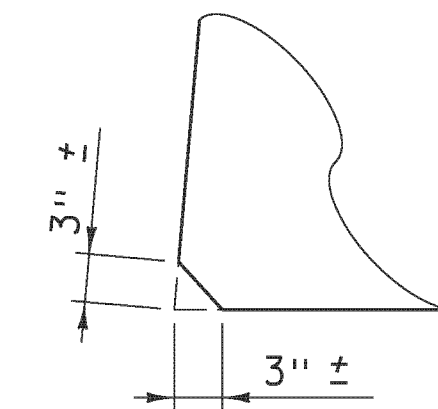


ACUTE ANGLE  
CLIP DETAIL  
(NOT TO SCALE)


1. SEE TYPICAL HORIZONTAL CONSTRUCTION JOINT DETAIL FOR ADDITIONAL INFORMATION

CONCRETE CURB JOINT NOTES


1. CONCRETE CURBS MAY BE PLACED IN ONE CONTINUOUS OPERATION IF AN APPROVED SHRINKAGE REDUCING ADMIXTURE LISTED IN THE SPECIAL PROVISIONS IS USED WITH THE CONCRETE MIX DESIGN. PAYMENT FOR THE SHRINKAGE REDUCING ADMIXTURE WILL BE INCIDENTAL TO THE BRIDGE CURB CONCRETE ITEM.
2. IF THE CONTRACTOR CHOOSES NOT TO USE AN APPROVED SHRINKAGE REDUCING ADMIXTURE, THE CURBS SHALL BE CONSTRUCTED WITH CONSTRUCTION JOINTS SPACED AT A MAXIMUM OF 15'-0" CENTER TO CENTER AND 2'-0" MINIMUM FROM THE CENTER OF NEAREST BRIDGE RAILING POST.
3. ON MULTI-SPAN CONTINUOUS SUPERSTRUCTURES, REGARDLESS OF WHETHER APPROVED SHRINKAGE REDUCING ADMIXTURE IS USED, CURB JOINTS SHALL BE LOCATED OVER THE CENTERLINE OF PIERS AND 7'-0" EACH SIDE OF THE CENTERLINE OF EACH PIER.
4. WHEN CURB JOINTS ARE USED THE CURBS SHALL BE PLACED IN ALTERNATE SECTIONS WITH A MINIMUM OF 48 HOUR DELAY BETWEEN ADJACENT PLACEMENTS.
5. LONGITUDINAL REINFORCING SHALL BE CONTINUOUS THROUGH CURB CONSTRUCTION JOINTS. CURB STIRRUP BARS SHALL BE TURNED AS NECESSARY TO MAINTAIN COVER IN THE FLARED CURB ENDS.
6. THE JOINT SPACING AND DETAILS SHOWN SHALL APPLY TO SIDEWALKS WHEN SHOWN IN THE PLANS.

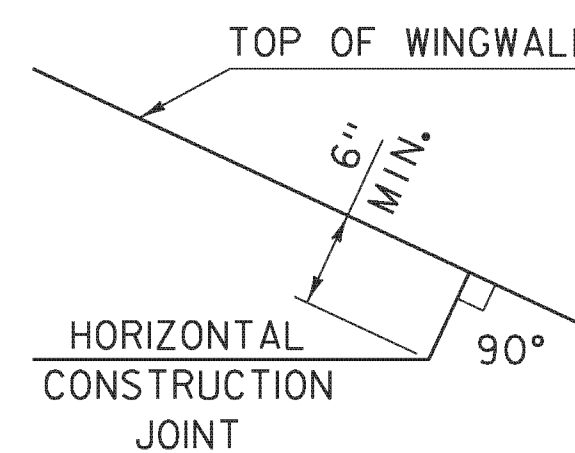


HORIZONTAL WINGWALL  
CONSTRUCTION JOINT  
(NOT TO SCALE)

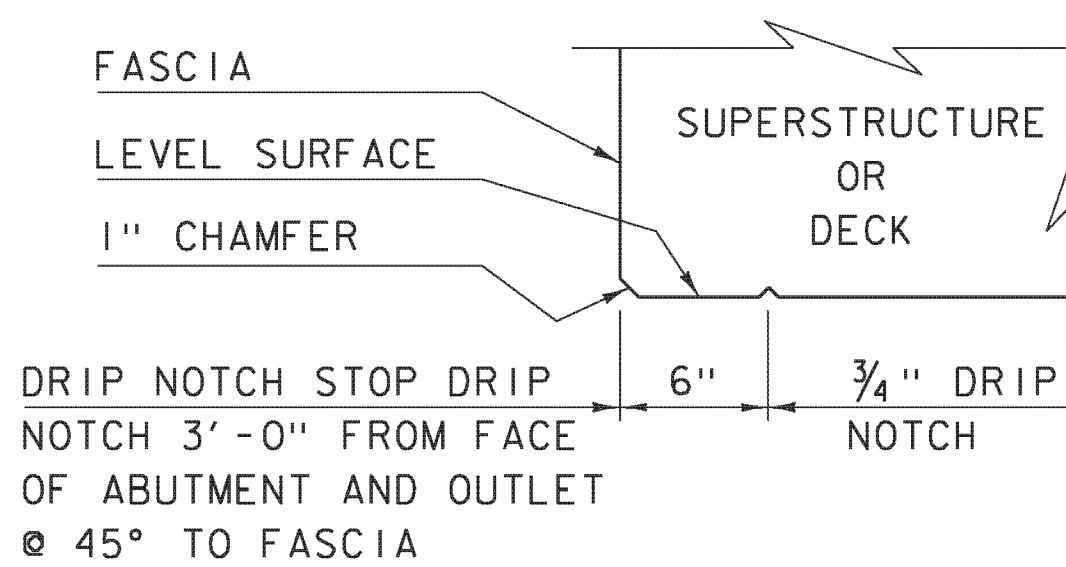

DRIP NOTCH DETAIL  
(NOT TO SCALE)

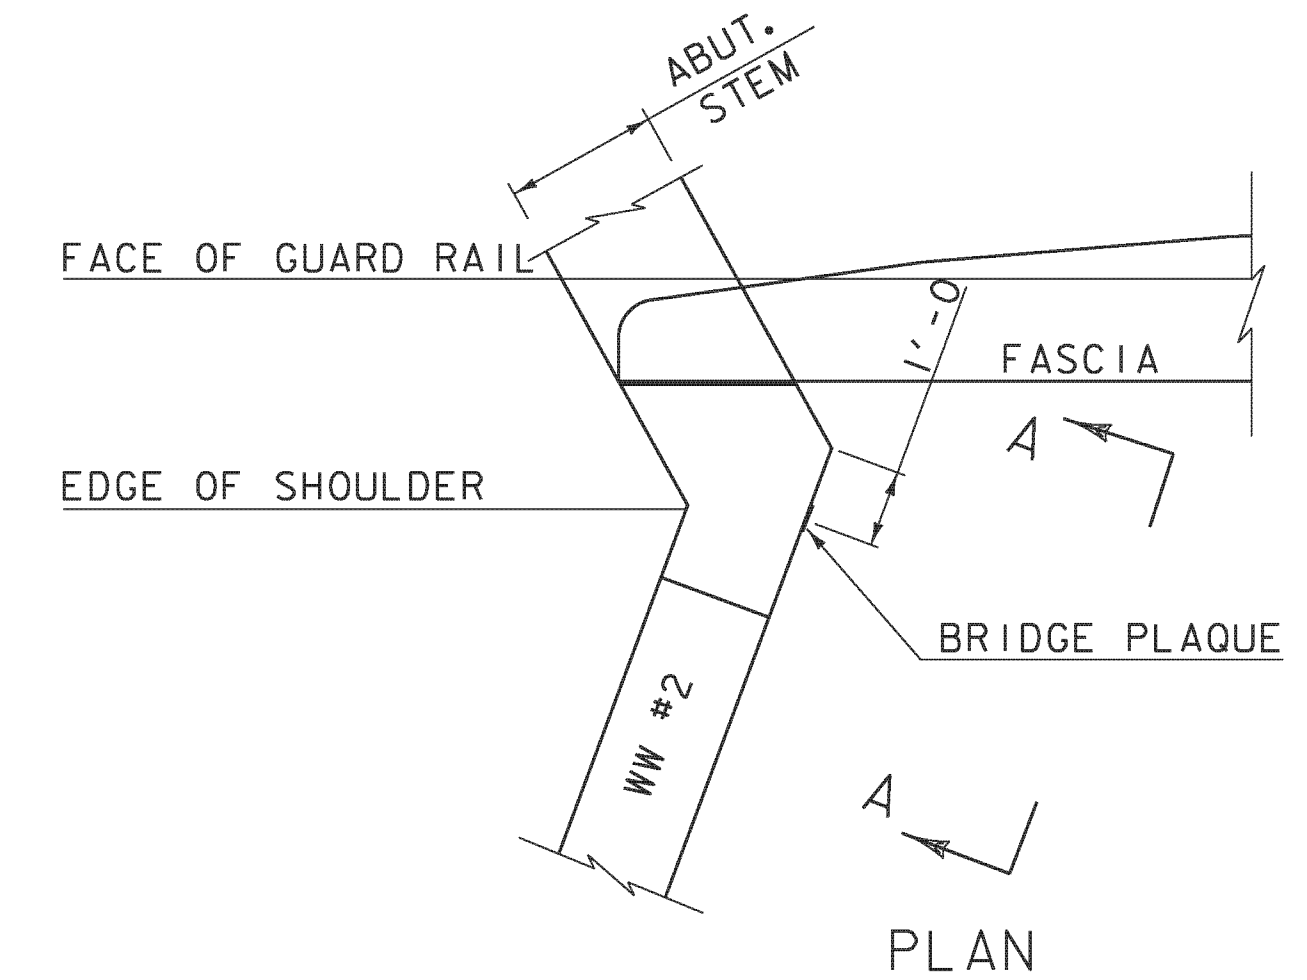

PLAN

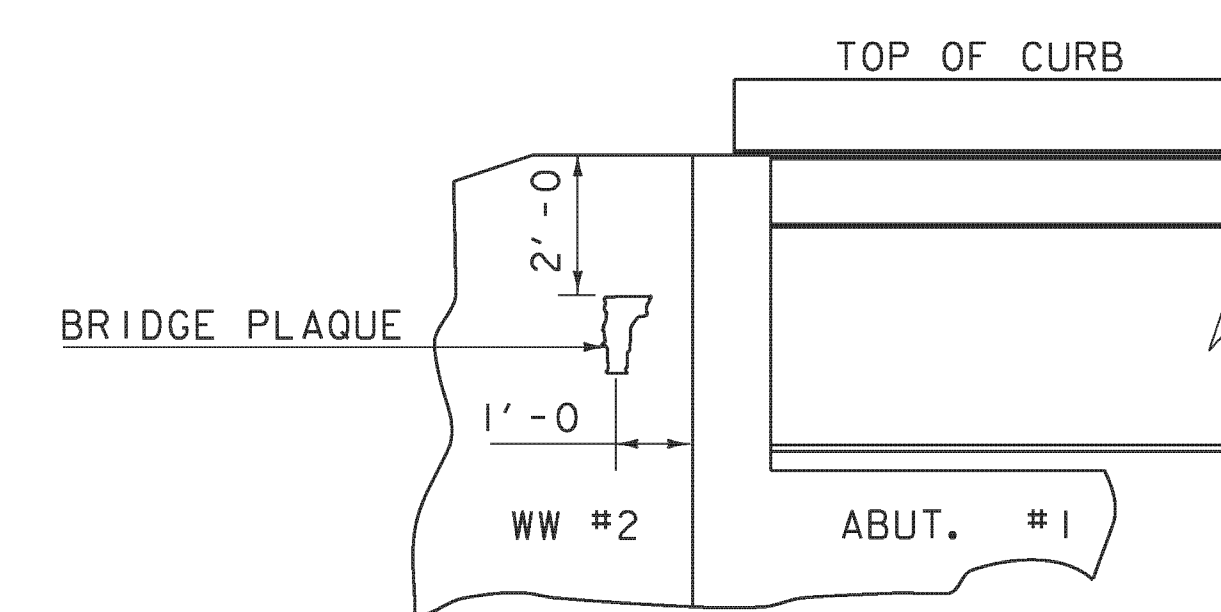

VIEW "A - A"


BRIDGE PLAQUE  
(NOT TO SCALE)

THE BRIDGE PLAQUE WILL BE SUPPLIED BY THE AGENCY OF TRANSPORTATION AND SHALL BE INSTALLED BY THE CONTRACTOR AT ABUTMENT #1 ON THE RIGHT SIDE AS SHOWN OR AS DIRECTED BY THE ENGINEER.

PAYMENT FOR INSTALLATION OF THE BRIDGE PLAQUE SHALL BE INCIDENTAL TO THE ADJACENT CONCRETE.

REVISIONS	
MAY 7, 2010	APPROVED FOR USE BY VAOT STRUCTURES SECTION
JUNE 4, 2010	MODIFIED AND ADDED TWO DETAILS
OCTOBER 10, 2012	MODIFIED HORZ. JOINT WINGWALL ADD 6" MIN. DIMENSION

CONCRETE  
DETAILS AND NOTES

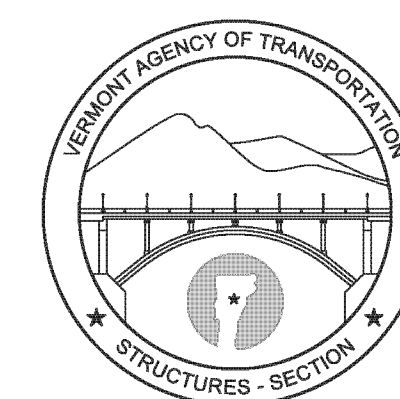


STRUCTURES  
DETAIL  
SD-502.00

IN ACCORDANCE WITH CONTRACT PLAN SHEET 23 OF 42, 10/2013.

REVISIONS		
REV.	DESCRIPTION	DATE
A	SUBMITTAL	3/25/14

**GENERAL NOTES**


- ALL BEARINGS SHALL CONFORM TO THE STATE OF VERMONT AGENCY OF TRANSPORTATION STANDARD SPECIFICATIONS, SECTIONS 531 AND 731, UNLESS NOTED OTHERWISE.
- MATERIALS:**  
 ELASTOMER.....50 ± 5 DURO NATURAL, GRADE 4  
  
 CARBON STEEL SHIMS.....ASTM A 1011, GR. 40  
 (10 GA. IN LIEU OF 1/8" DUE TO AVAILABILITY)
- TOLERANCES:**  
**LAMINATED PADS:**  
 VERTICAL.....-0, +1/4"  
 HORIZONTAL.....-0, +1/4"  
 THICKNESS OF LAYERS.....±1/8"  
 PARALLELISM TOP.....0.005 rad  
 PARALLELISM SIDES.....1/4"  
 EDGE COVER.....-0, +1/8"
- MARKINGS:**  
 EACH BEARING SHALL BE PERMANENTLY MARKED IN A LOCATION THAT IS VISIBLE WHEN THE DEVICE IS INSTALLED IN THE COMPLETED STRUCTURE. MARKING SHALL BE SEP STANDARD:  
 CONTRACT/ORDER #  
 LOT#  
 BEARING ID # (MK. #)  
 LOCATION/BRIDGE #  
 ELASTOMER TYPE AND GRADE  
 ORIENTATION (WHERE APPLICABLE)
- TESTING:** IN ACCORDANCE WITH THE VERMONT AOT SPECIFICATIONS. DESIGN METHOD A
- REPRESENTATIVE**  
 CUSTOMER SERVICE: STEVE BOWMAN.....903-677-4318  
 TECHNICAL: MIKE SPELLMAN.....903-677-4342

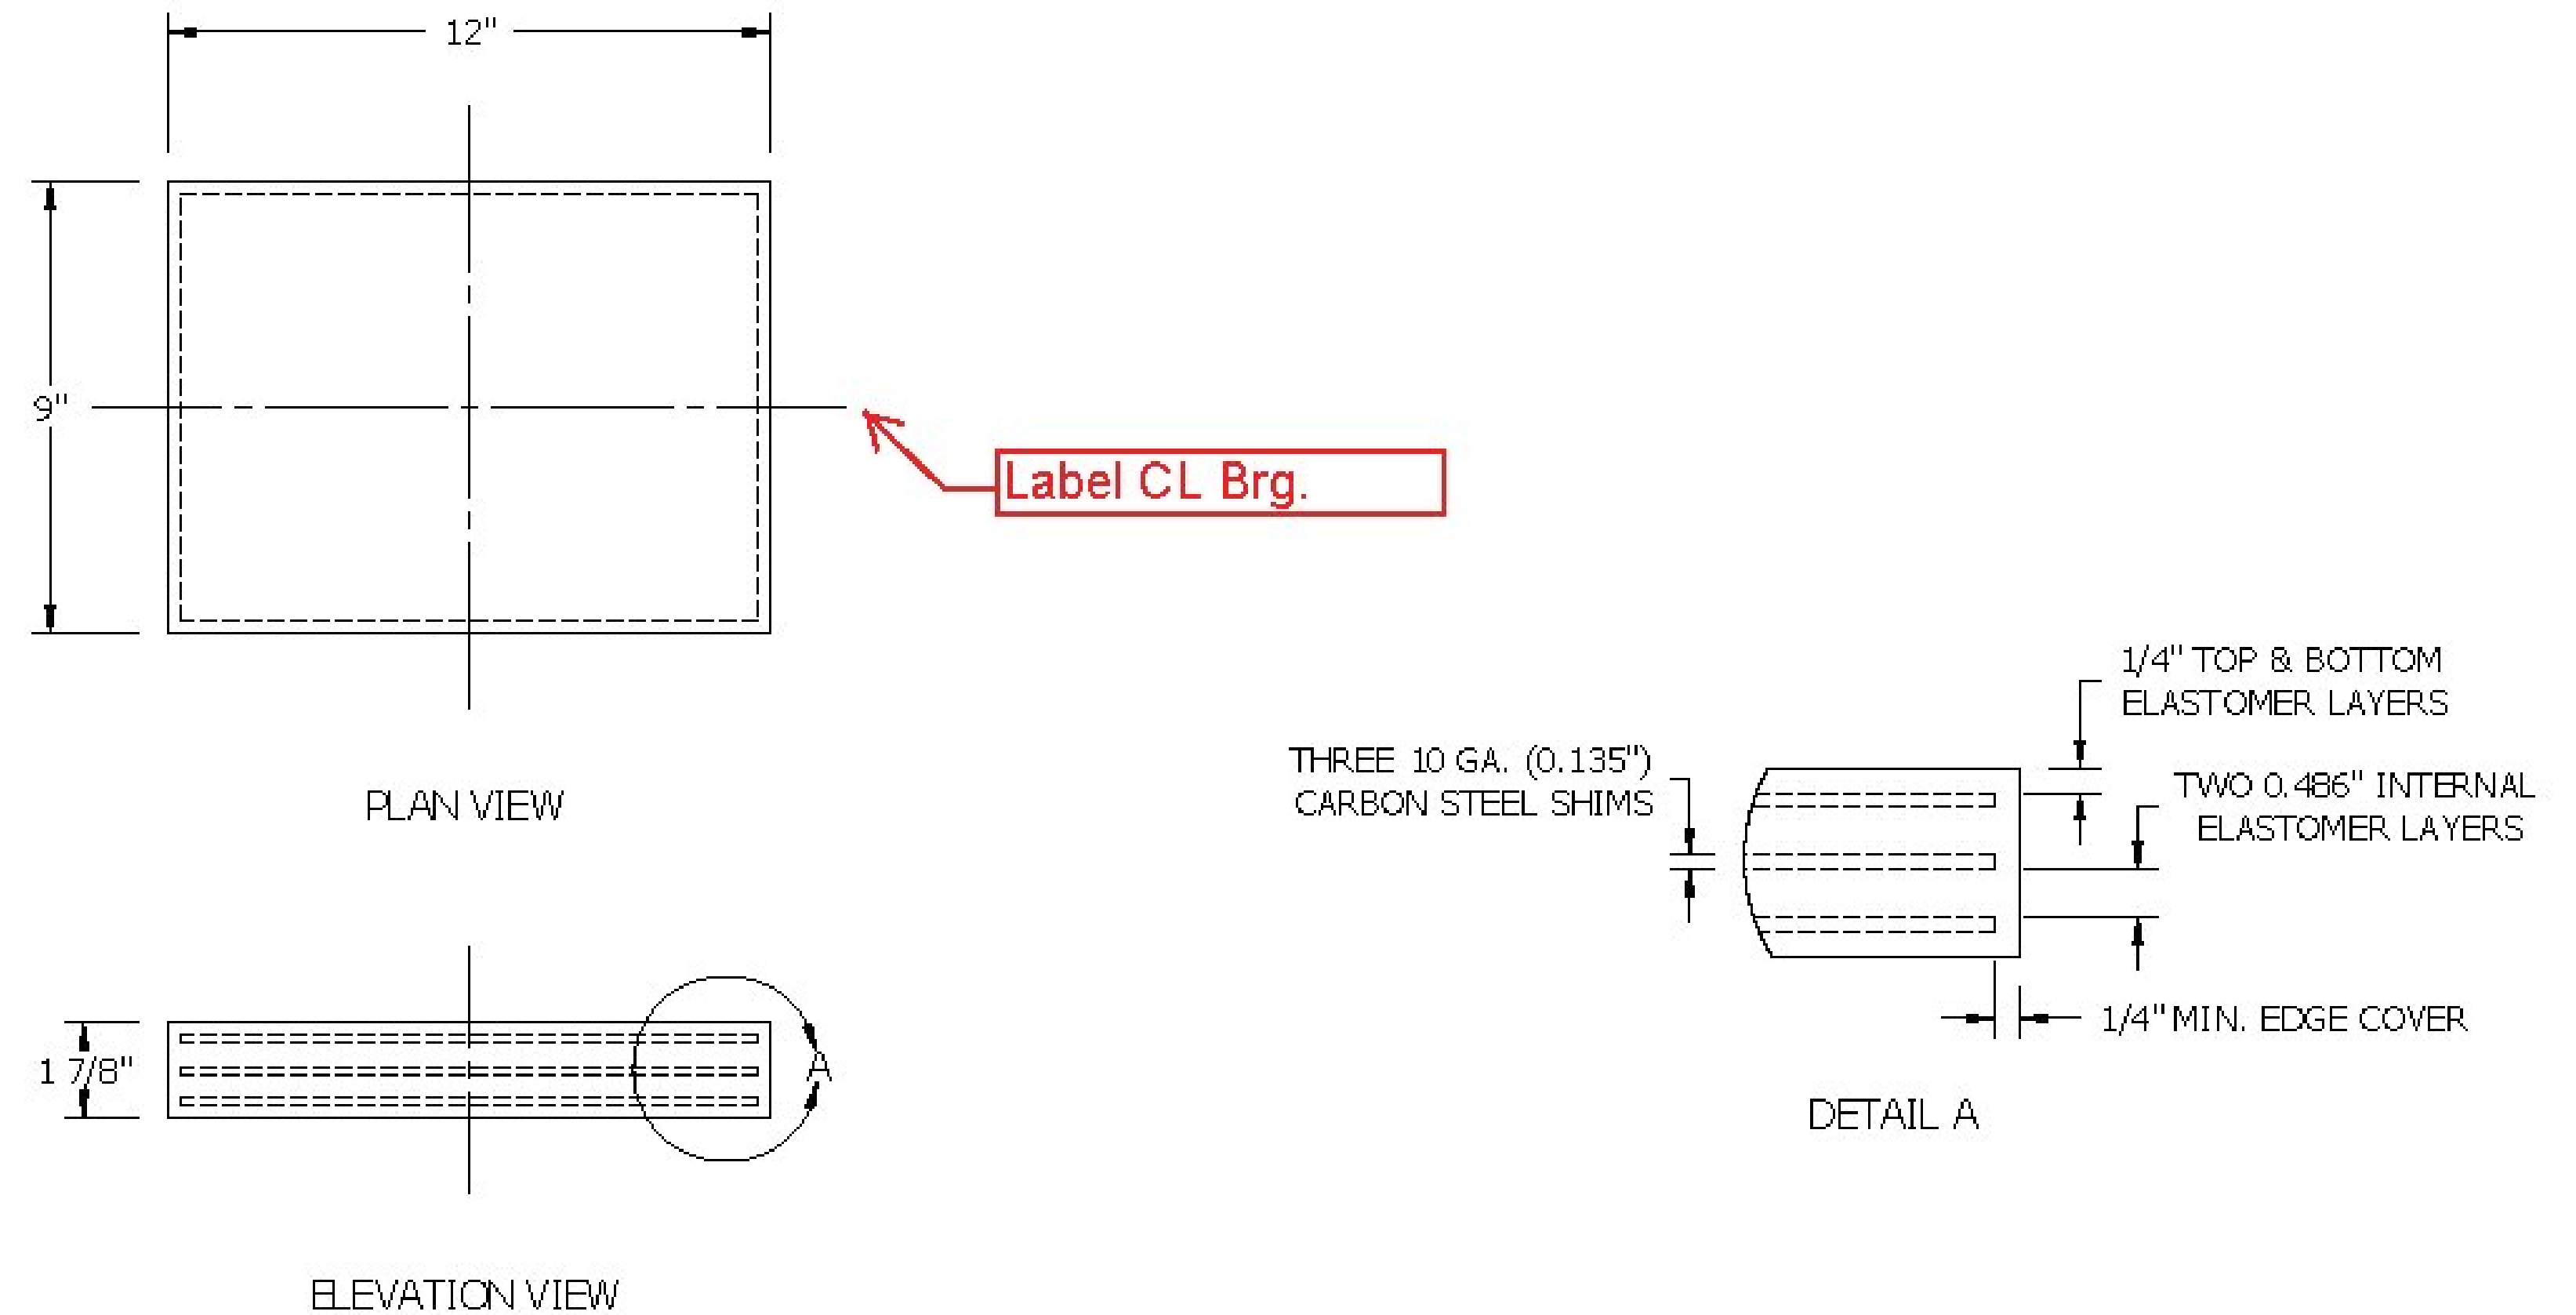

**MK.02**  
**LAMINATED BEARING PADS**  
 ITEM 531.17  
 @ GUILFORD, BRO 1442(36)  
  
**(20) REQ'D**  
  
 DL: 20.3 kips  
 LL: 22.9 kips (WITH IMPACT)

<b>SHOP DRAWING REVIEW</b>	
<input type="checkbox"/>	REVIEWED AS REQUIRED BY THE CONSTRUCTION CONTRACT DOCUMENTS AND APPROVED, BUT ONLY FOR CONFORMANCE TO THE DESIGN CONCEPT OF THE WORK, AND SUBJECT TO FURTHER LIMITATIONS AND REQUIREMENTS CONTAINED IN THE CONSTRUCTION CONTRACT DOCUMENTS.
<input type="checkbox"/>	REJECTED
<input type="checkbox"/>	REVISE AND RESUBMIT
<input checked="" type="checkbox"/>	FURNISH AS CORRECTED
CORRECTIONS OR COMMENTS MADE ON THE SHOP DRAWINGS DURING THIS REVIEW DO NOT RELIEVE CONTRACTOR FROM COMPLIANCE WITH REQUIREMENTS OF THE DRAWINGS AND SPECIFICATIONS. THIS CHECK IS ONLY FOR REVIEW OF GENERAL CONFORMANCE WITH THE DESIGN CONCEPT OF THE PROJECT AND GENERAL COMPLIANCE WITH THE INFORMATION GIVEN IN THE CONTRACT DOCUMENTS. THE CONTRACTOR IS RESPONSIBLE FOR: CONFIRMING AND CORRELATING ALL QUANTITIES AND DIMENSIONS; SELECTING FABRICATION PROCESSES AND TECHNIQUES OF CONSTRUCTION; COORDINATING HIS WORK WITH THAT OF ALL OTHER TRADES; AND PERFORMING HIS WORK IN A SAFE AND SATISFACTORY MANNER.	
 <b>Vanasse Hangen Brustlin, Inc.</b> 7056 US Route 7 North Ferrisburgh, VT 05473 802.425.7788	Job Number: <u>57427.06</u> Reviewed By: <u>E.A. FIALA</u> Date: <u>04-15-2014</u>

<b>Seismic Energy Products, Inc.</b>		
<small>STRUCTURAL BEARINGS FOR BRIDGES &amp; BUILDINGS ATHENS, TX      PHONE: 903-675-8571</small>		
<b>BEARING ASSY FOR:</b> STATE OF VERMONT AGENCY OF TRANSPORTATION		
PROJECT NAME: GUILFORD PROJECT NO.: BRO 1442(36)		
CONTRACTOR: RENAUD BROS		
DRAWN CWILLIAMS	DATE 2/11/13	PO # S. QTE
CHECKED	DATE	SO NO. & ST. <b>58878 VT</b>
REVIEWED MSPELLMAN	DATE 3/25/14	SHEET 1 OF 1

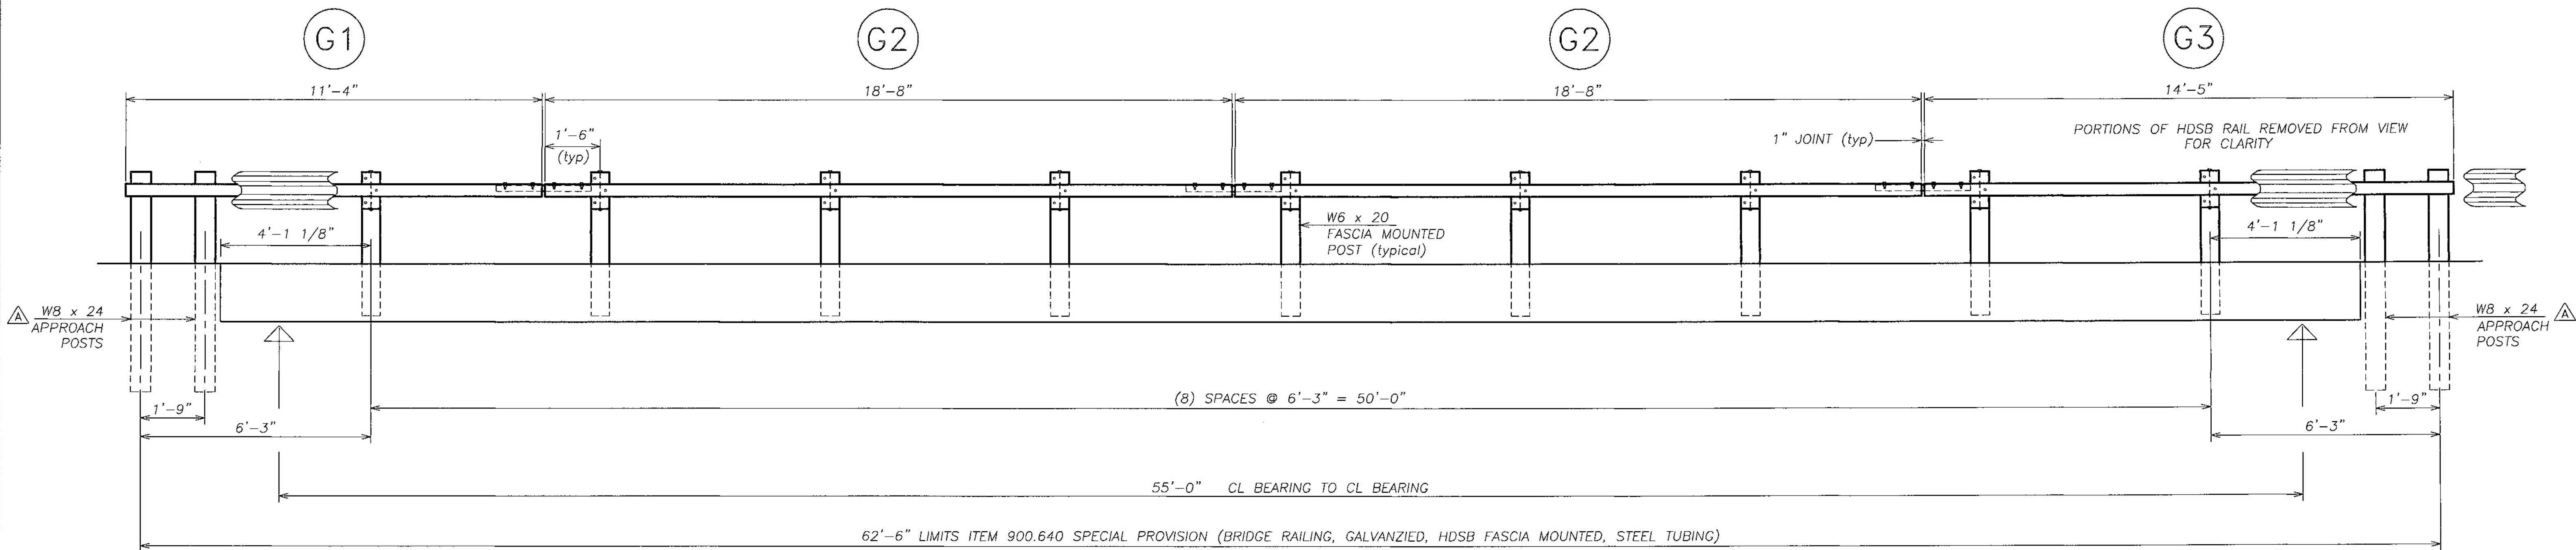

TYPICAL ELEVATION - LOOKING AT FACE OF RAIL FROM CENTERLINE OF ROADWAY  
BOTH SIDES TYPICAL

Vermont Agency of Transportation

**RECEIVED**

CK'D BY MJC OK'D BY TAS

April 14, 2014

RESUBMIT No Approved

BY M. J. Chenette DATE 04/24/2014

△ BILL OF MATERIAL

Qty	mk	Description	Spec.
18		W6x20 FASCIA MOUNTED POST 3'-1.000" OAL (GLV)	A572 gr 50
8		W8x24 TRANSITION POST x 6 FT LONG (GLV)	A572 gr 50
52		TUBE BLOCK HSS 8 x 4 x 3/16 x 6.000" LG (GLV)	A500 gr B
10		HDSB W-BEAM PANEL 10 GA 12'-6" LG X 6'-3" SP (GALV)	M180 B2
6		SPLICE CHANNEL C7 X 12.25 x 2'-7.000" w/ (4) TACKWELDED HEX NUTS (GALV)	A572 gr 50
2	G1	TUBULAR STEEL RAIL (GLV) HSS 8 x 4 x 3/16 x 11'-4.000" OAL	A500 gr B
4	G2	TUBULAR STEEL RAIL (GLV) HSS 8 x 4 x 3/16 x 18'-8.000" OAL	A500 gr B
2	G3	TUBULAR STEEL RAIL (GLV) HSS 8 x 4 x 3/16 x 14'-5.000" OAL	A500 gr B
26		RECTANGULAR WASHER 0.1875" x 1.75" x 3.00" (GLV)	A572 GR 50
36		U-SHAPED ANCHOR STUD 1" DIA 10" x 12"	A449
72		PLATE WASHER 0.25" x 2" x 5" w/ 1.25" DIA CENTER HOLE	A572 GR 50
144		HEX NUT (HI STR) 1"	A563 DH
72		ROUND WASHER (SAE) 1"	F436
26		HEX HEAD BOLT 5/8" DIA x 13" LG HDG	A325
26		HEX HEAD BOLT 5/8" DIA x 10" LG HDG	A325
76		HEX HEAD BOLT 5/8" DIA x 2" LG HDG	A325
104		HEX NUT 5/8" HDG	A563 DH
206		ROUND WASHER SMALL FLAT 5/8" HDG	F436
80		PANEL SPLICE BOLT 5/8" x 1.25" HDG	A307
80		DOUBLE RECESS. NUT 5/8" HDG	A563 A

### SHOP DRAWING REVIEW

REVIEWED AS REQUIRED BY THE CONSTRUCTION CONTRACT DOCUMENTS AND APPROVED, BUT ONLY FOR CONFORMANCE TO THE DESIGN CONCEPT OF THE WORK, AND SUBJECT TO FURTHER LIMITATIONS AND REQUIREMENTS CONTAINED IN THE CONSTRUCTION CONTRACT DOCUMENTS.

REJECTED  REVISE AND RESUBMIT  FURNISH AS CORRECTED

CORRECTIONS OR COMMENTS MADE ON THE SHOP DRAWINGS DURING THIS REVIEW DO NOT RELIEVE CONTRACTOR FROM COMPLIANCE WITH REQUIREMENTS OF THE DRAWINGS AND SPECIFICATIONS. THIS CHECK IS ONLY FOR REVIEW OF GENERAL CONFORMANCE WITH THE DESIGN CONCEPT OF THE PROJECT AND GENERAL COMPLIANCE WITH THE INFORMATION GIVEN IN THE CONTRACT DOCUMENTS. THE CONTRACTOR IS RESPONSIBLE FOR: CONFIRMING AND CORRELATING ALL QUANTITIES AND DIMENSIONS; SELECTING FABRICATION PROCESSES AND TECHNIQUES OF CONSTRUCTION; COORDINATING HIS WORK WITH THAT OF ALL OTHER TRADES; AND PERFORMING HIS WORK IN A SAFE AND SATISFACTORY MANNER.

**Vanasse Hangen Brustlin, Inc.**  
7056 US Route 7  
North Ferrisburgh, VT 05473  
802.425.7788

Job Number: 57427.00  
Reviewed By: E.A.FIALA  
Date: 04-22-2014

No.	Remarks	Date
A	CORRECTED TRANSITION POSTS / GEN NOTES	4/10/14
0	Initial submittal	03-03-14

REVISIONS

**HIGHWAY SAFETY CORP**  
GLASTONBURY, CT  
860-633-9445

900.640 SPECIAL PROVISION (BRIDGE RAILING GALVANIZED, HDSB FASCIA MOUNTED/STEEL TUBING)

TOWN OF GUILFORD, VT - WINDHAM COUNTY  
RT TH10 BRIDGE 65 - BRO 1442(36)

AS 9003 CERTIFIED FABRICATOR


HSC JOB NO. 1977

SHEET NO. 1 of 2


GENERAL CONTRACTOR

SUB CONTRACTOR LAFAYETTE

DRAWN PAR CHECKED fil DATE 03-03-14 SCALE NONE SIZE D

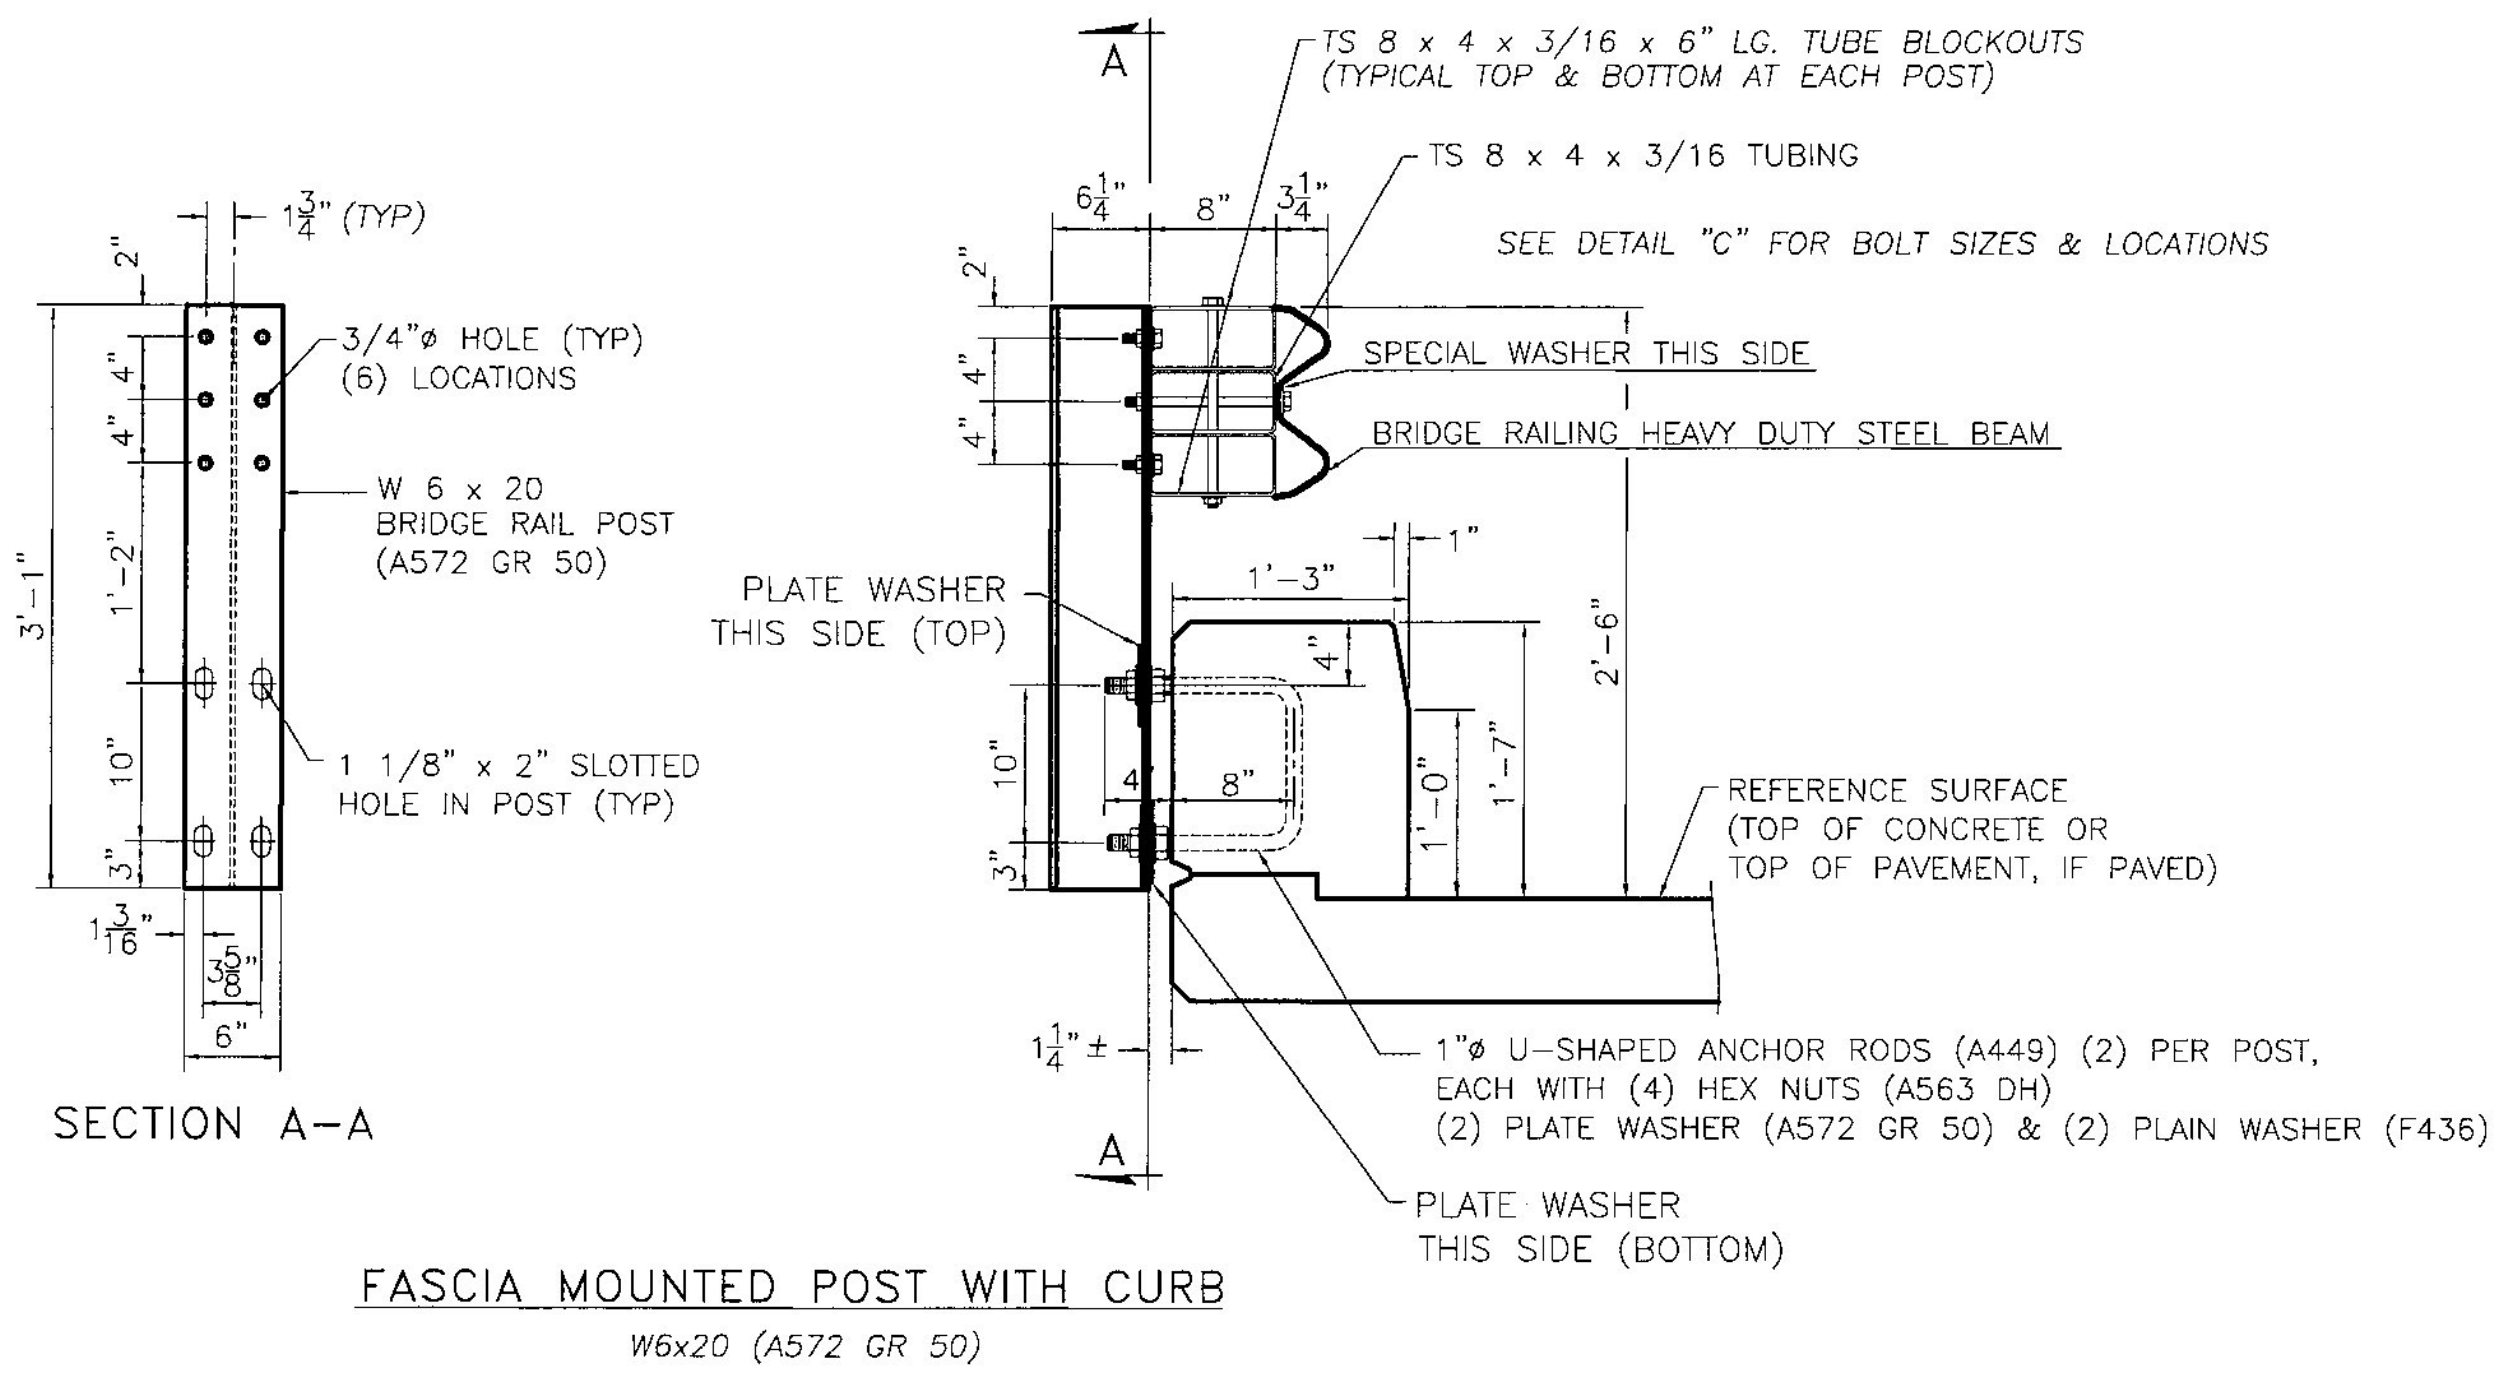


FASCIA MOUNTED POST WITH CURB  
W6x20 (A572 GR 50)

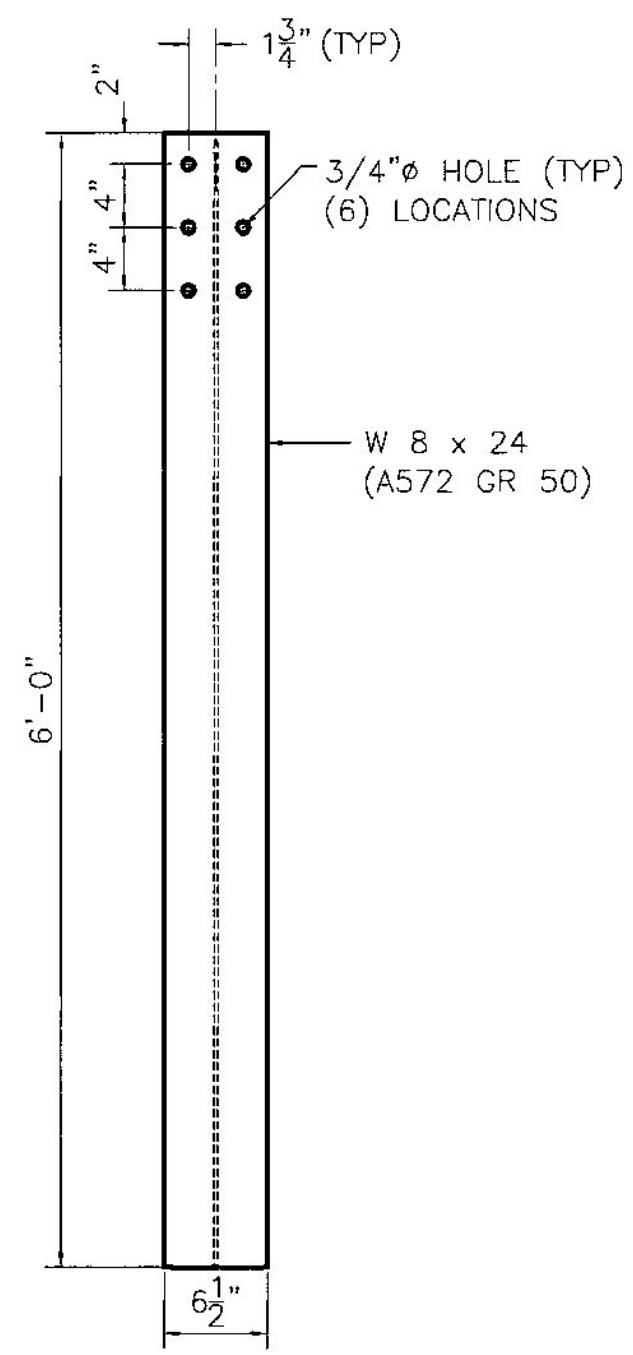


TRANSITION POST  
W8x24 (A572 GR 50)

NOTES

- ALL WORK AND MATERIALS SHALL CONFORM TO SECTION 525
- PRIOR TO GALVANIZING THE ASSEMBLED POST, GRIND ALL EDGES TO A MINIMUM 1/16" RADIUS
- ALL POSTS SHALL BE SET NORMAL TO GRADE
- SPLICES FOR THE STEEL BEAM GUARDRAIL SHALL LAP IN THE DIRECTION OF TRAFFIC
- A RAILING JOINT SPLICE SHALL BE PROVIDED IN ANY RAIL BAY SPANNING THE END OF AN INTEGRAL ABUTMENT BRIDGE AND AT ALL SUPERSTRUCTURE EXPANSION JOINTS
- SEE VAOT STANDARD DRAWING G-1 FOR DETAILS OF DELINEATORS. A DELINEATOR SHALL BE INSTALLED AT 30 FT SPACING OR THE NEAREST POST. WHITE IS TO BE INSTALLED ON THE DRIVERS RIGHT. FOR THIS ONE WAY BRIDGE, YELLOW IS TO BE INSTALLED ON THE DRIVERS LEFT
- FOR RADII LESS THAN 950 FEET, HSS 8 X 4 TUBES SHALL BE SHOP BENT TO FIT THE APPLICABLE CURVE
- HOLES IN THE RAIL FOR TUBE ATTACHEMENT MAY BE FIELD DRILLED. FIELD DRILLED HOLES SHALL BE COATED WITH IN APPROVED ZINC RICH PAINT PRIOR TO INSTALLATION
- SEE STANDARD G-1 AND G-1d FOR ADDITIONAL DETAILS CONCERNING GUARDRAIL.

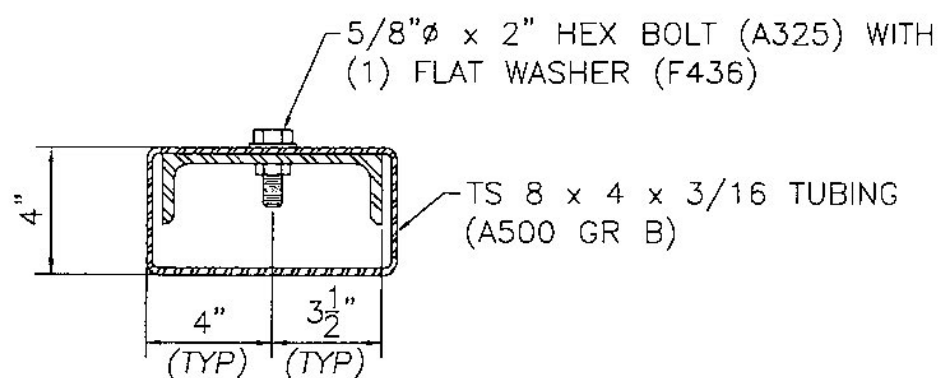

PARTIAL SECTION B-B  
SHOWING TUBE & SPLICE ONLY

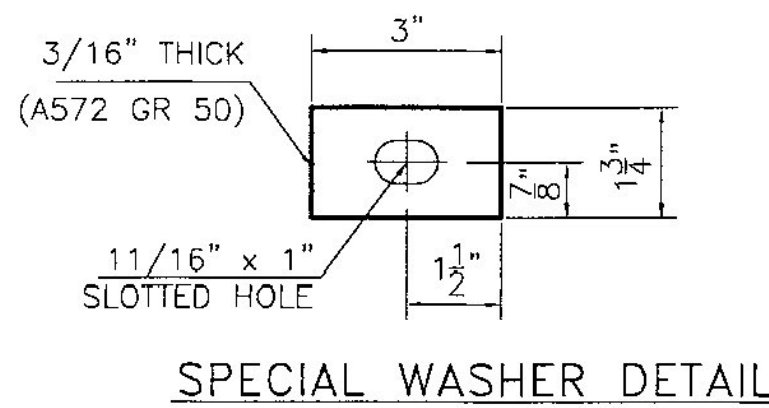

SPECIAL WASHER DETAIL



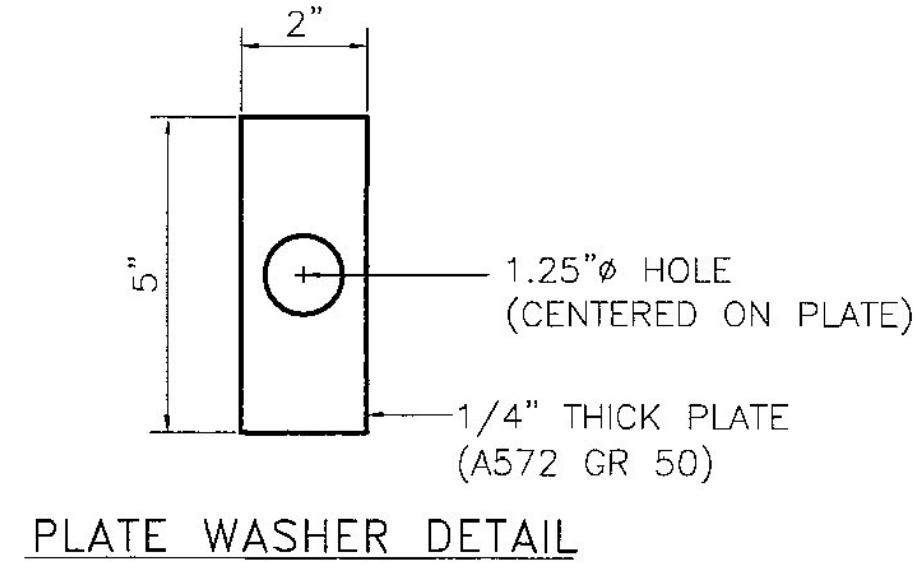


PLATE WASHER DETAIL

CK'D BY MJC OK'D BY TAS  
 April 14, 2014  
 RESUBMIT No Approved  
 BY M. J. Chenette DATE 04/24/2014

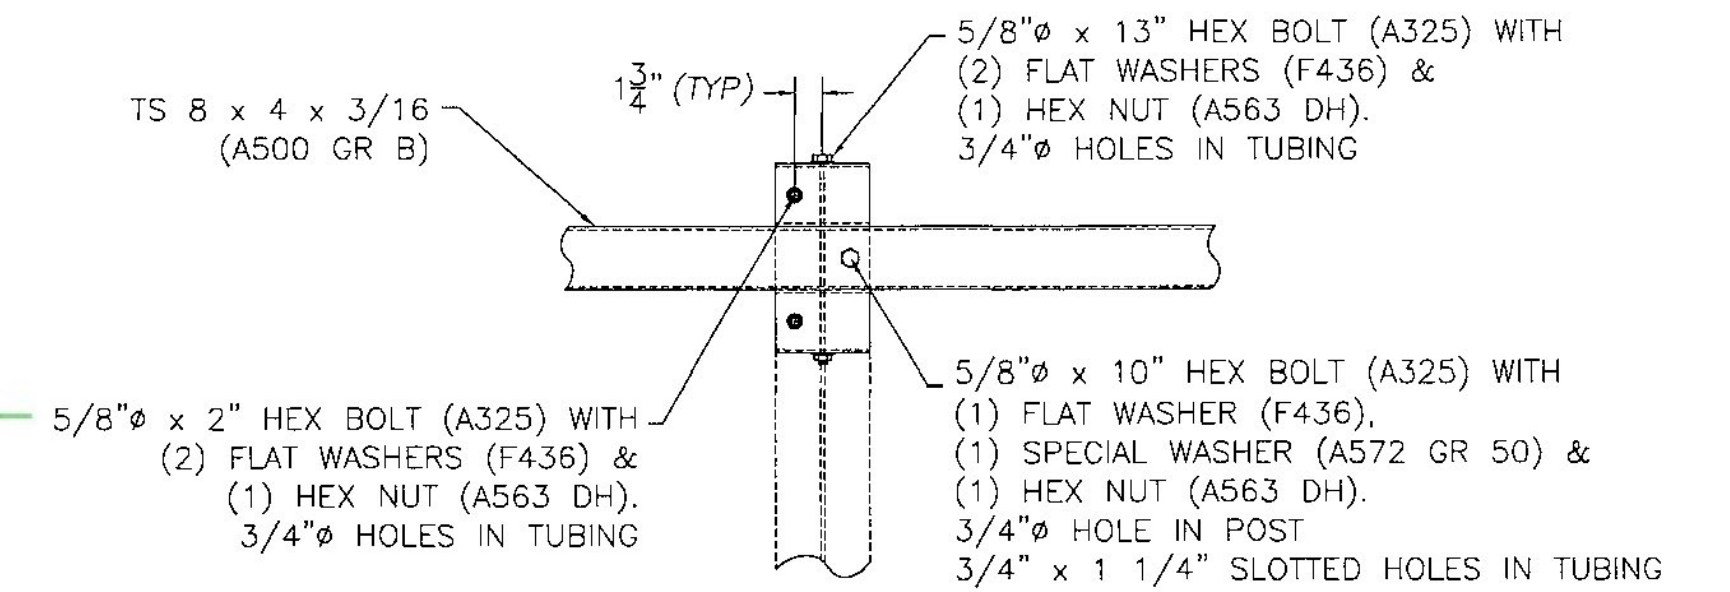

DETAIL "C"  
STEEL BEAM GUARD RAIL NOT SHOWN

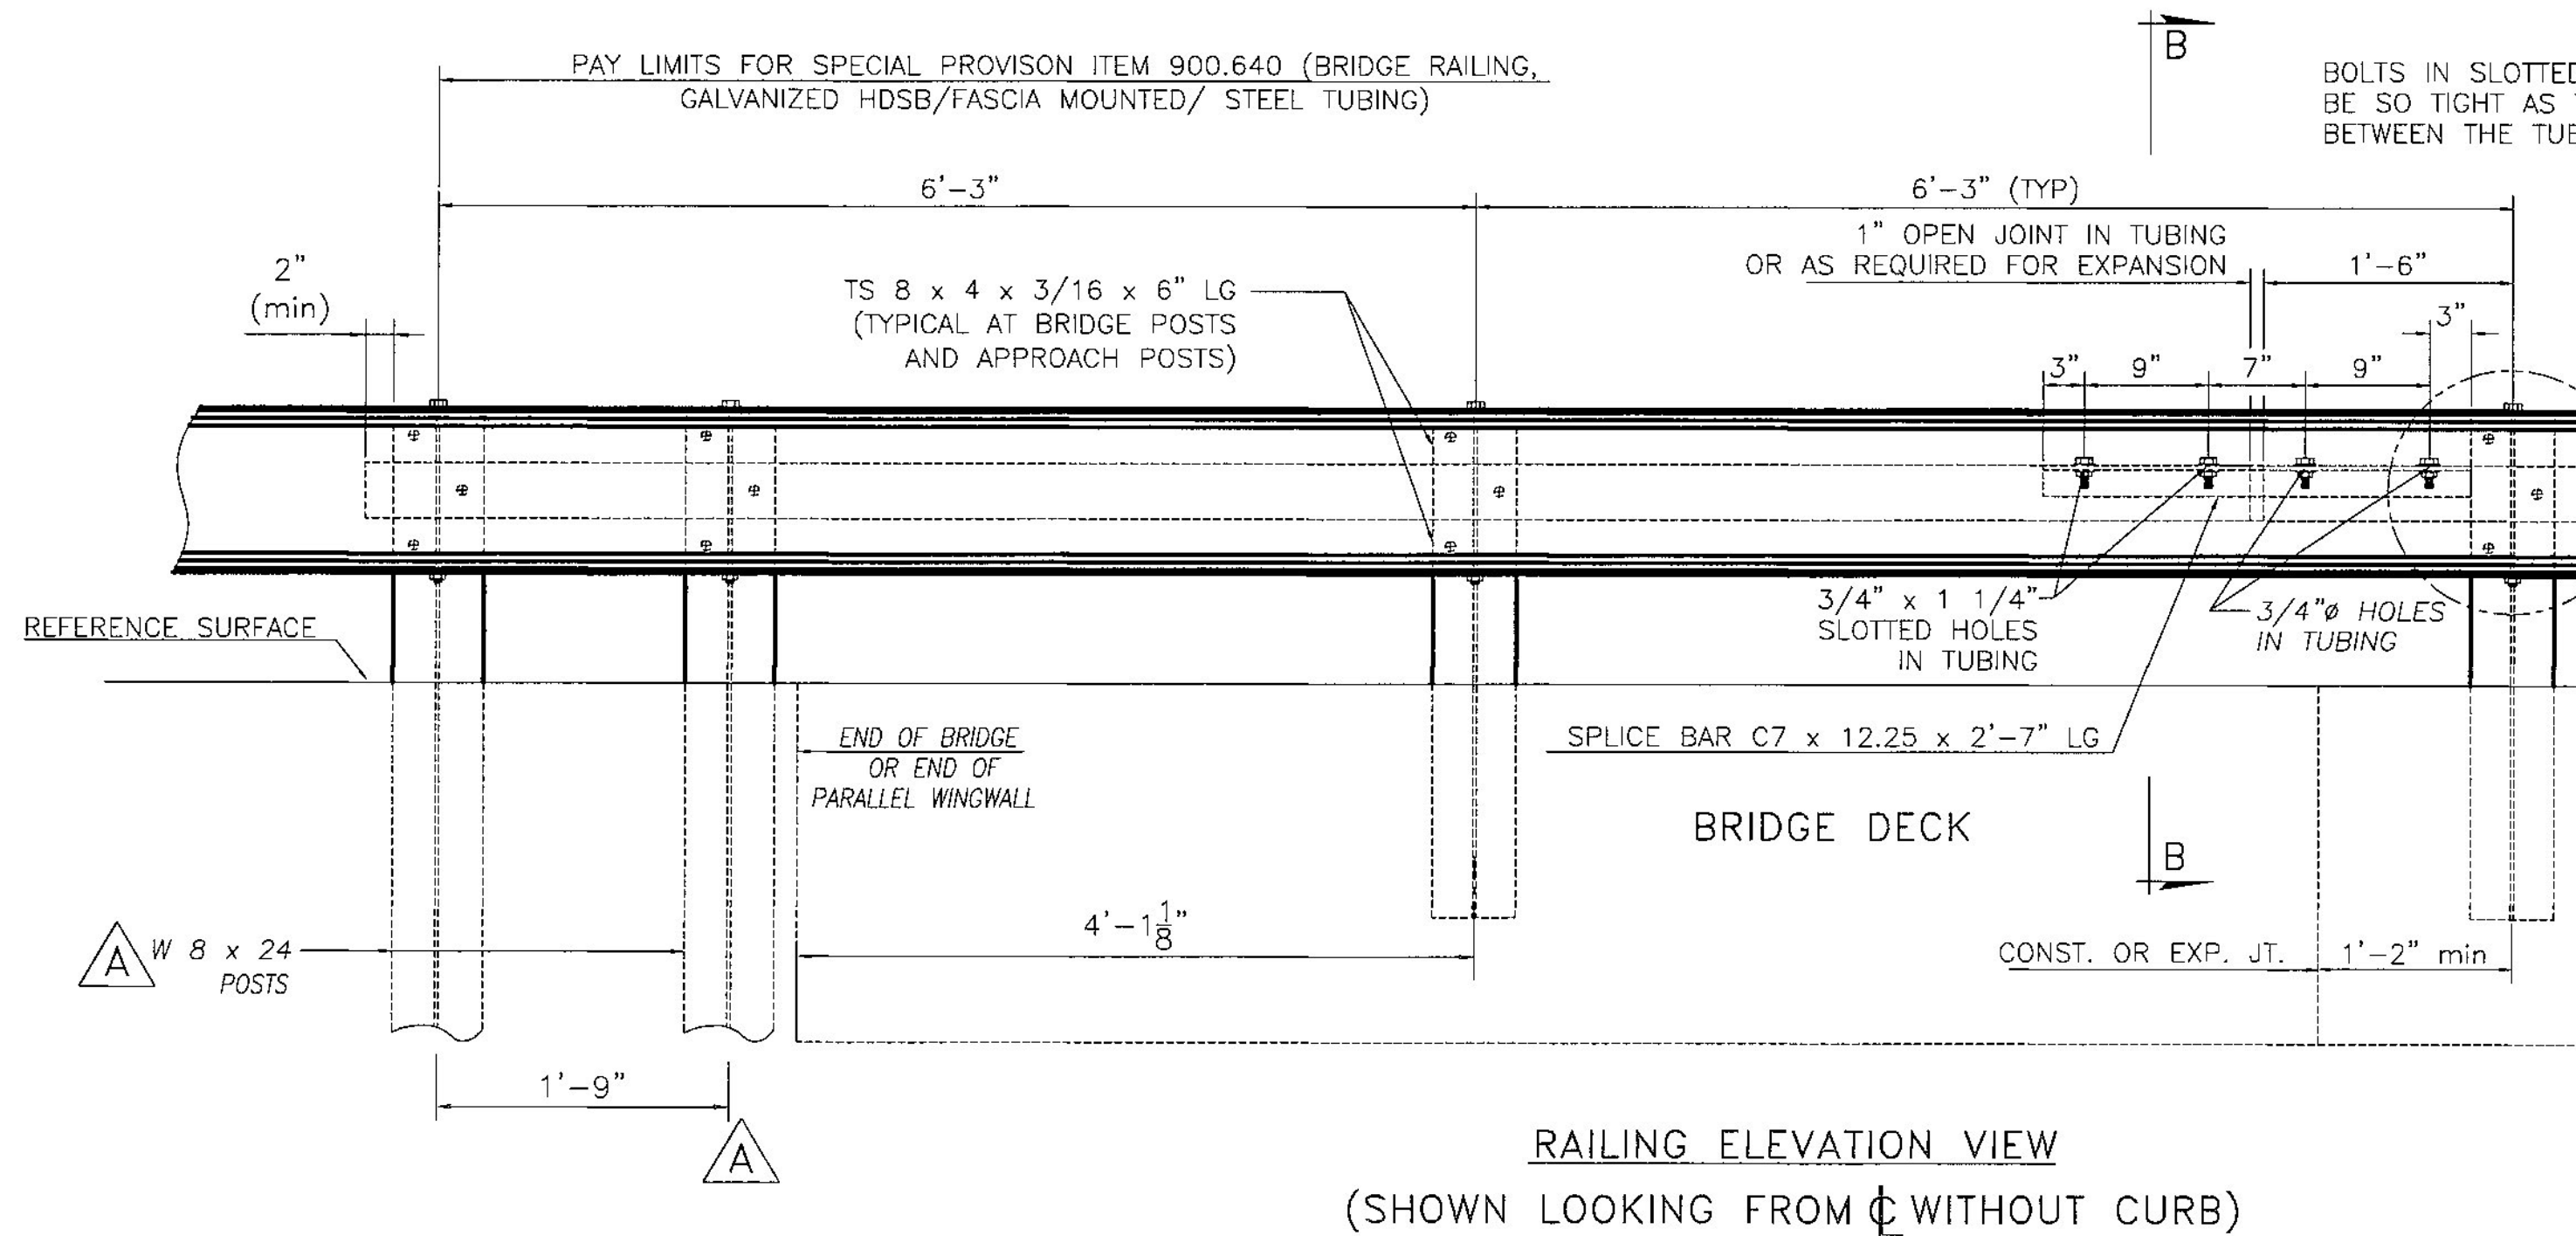

RAILING ELEVATION VIEW  
(SHOWN LOOKING FROM CL WITHOUT CURB)

SHOP DRAWING REVIEW


REVIEWED AS REQUIRED BY THE CONSTRUCTION CONTRACT DOCUMENTS AND APPROVED, BUT ONLY FOR CONFORMANCE TO THE DESIGN CONCEPT OF THE WORK, AND SUBJECT TO FURTHER LIMITATIONS AND REQUIREMENTS CONTAINED IN THE CONSTRUCTION CONTRACT DOCUMENTS.

REJECTED  REVISE AND RESUBMIT  FURNISH AS CORRECTED

CORRECTIONS OR COMMENTS MADE ON THE SHOP DRAWINGS DURING THIS REVIEW DO NOT RELIEVE CONTRACTOR FROM COMPLIANCE WITH REQUIREMENTS OF THE DRAWINGS AND SPECIFICATIONS. THIS CHECK IS ONLY FOR REVIEW OF GENERAL CONFORMANCE WITH THE DESIGN CONCEPT OF THE PROJECT AND GENERAL COMPLIANCE WITH THE INFORMATION GIVEN IN THE CONTRACT DOCUMENTS. THE CONTRACTOR IS RESPONSIBLE FOR: CONFIRMING AND CORRELATING ALL QUANTITIES AND DIMENSIONS; SELECTING FABRICATION PROCESSES AND TECHNIQUES OF CONSTRUCTION; COORDINATING HIS WORK WITH THAT OF ALL OTHER TRADES; AND PERFORMING HIS WORK IN A SAFE AND SATISFACTORY MANNER.


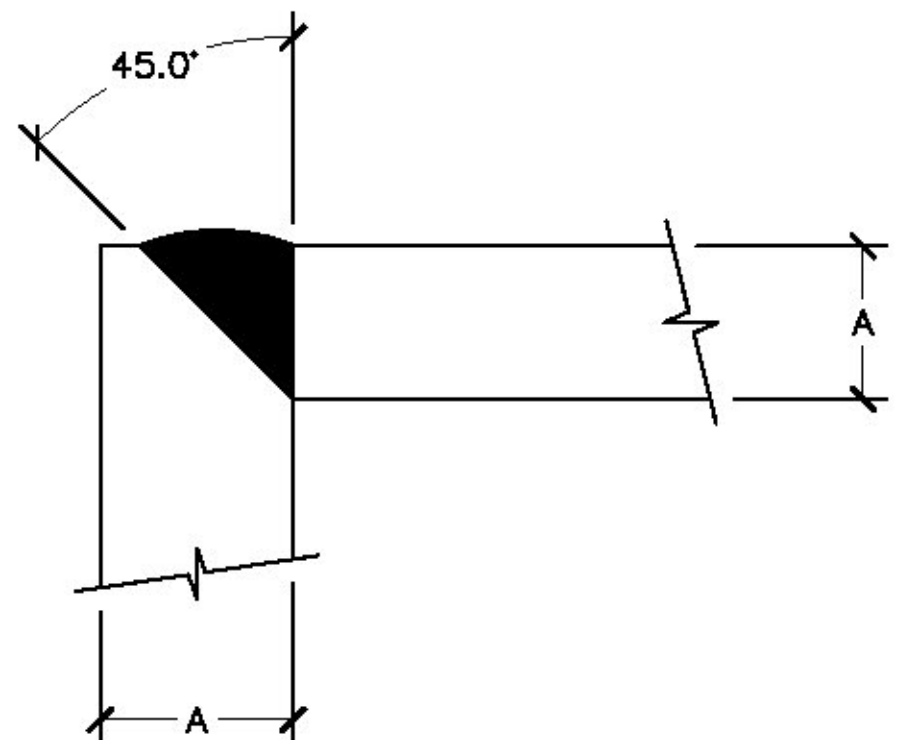
**Vanasse Hangen Brustlin, Inc.**  
 7058 US Route 7  
 North Ferrisburgh, VT 05473  
 802.425.7788

Job Number: **57427.00**  
 Reviewed By: **E.A.FIALA**  
 Date: **04-22-2014**

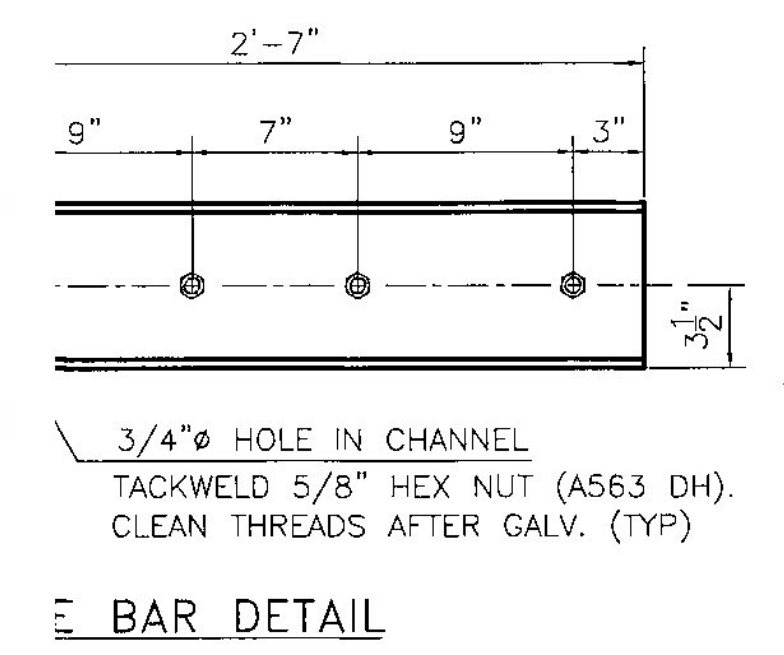




BAR DETAIL

<b>HIGHWAY SAFETY CORP</b>	
GLASTONBURY, CT 860-633-9445	
900.640 SPECIAL PROVISION (BRIDGE RAILING GALVANIZED, HDSB FASCIA MOUNTED/STEEL TUBING)	
TOWN OF GUILFORD, VT - WINDHAM COUNTY RT TH10 BRIDGE 65 - BRO 1442(36)	HSSC JOB NO. <b>1977</b>
GENERAL CONTRACTOR	SHEET NO. <b>2 of 2</b>
SUB CONTRACTOR LAFAYETTE	
DRAWN PAR	CHECKED DATE 03-03-14 SCALE NONE SIZE D

 <b>B. RENAUD BROS. INC.</b> STEEL SALES & FABRICATION VERNON VT. USA	<b>WELDING PROCEDURE</b>		NO. RB-GW-001	SHEET: 1 OF 4
	DATE: 4/8/2014	PROJECT NAME: GUILFORD		
	BY: A. DUNKLEE	PROJECT NO. BRO 1442(36)		
283 FT. BRIDGMAN RD. VERNON VT., 05354 PH. (802)257-7383 FAX (802)257-7308	AWS CODE:	PQR REF. NO: N/A		
MATERIAL SPECIFICATION:	ASTM 709 GR. 36-50			
WELDING PROCESS:	SMAW			
MANUAL, SEMI-AUTOMATIC OR AUTOMATIC:	MANUAL			
WELDING POSITION:	1G			
FILLER METAL SPECIFICATION:	ANSI/AWS A5.1-A5.5			
FILLER METAL CLASSIFICATION:	E7018			
FLUX:	N/A			
SHIELDING GAS:	N/A	FLOW RATE:	N/A	
SINGLE OR MULTIPLE PASS:	MULTIPLE			
SINGLE OR MULTIPLE ARC:	SINGLE			
WELDING CURRENT:	DC			APPROVAL STAMP
WELDING POLARITY:	ELECTRODE POSITIVE			
WELDING PROGRESSION:	N/A			
ROOT TREATMENT:	REMOVE ALL IMPURITIES & GALV.			
PREHEAT & INTERPASS TEMPERATURE:	≥1½"=70°F 1½"-2½"=150°F OVER 2½"=225°F			
POSTHEAT TREATMENT:	N/A			
HEAT INPUT:	MIN:	N/A	MAX:	
ELECTRODE STICKOUT:	N/A			
PASS NO.	ELECTRODE SIZE:	WELDING CURRENT AMPS	WELDING CURRENT VOLTS	TRAVEL SPEED
AS REQ.	3/32"	70-110		ADJUST AS REQ.
	1/8"	70-170		
<b>JOINT DETAIL:</b> HP14X89 PILE POINT 				
<b>NOTES:</b> MIN. WELD SIZE- 5/16" GRIND ALL BURRS, ENSURE FLUSH POINT FIT. PILE GRADE: A572-50 A- VARIES (ADJUST PREHEAT TEMP AS REQ.)				

Vermont Agency of Transportation  
**RECEIVED**  
 CK'D BY MJC OK'D BY JWC  
 May 30, 2014  
 RESUBMIT No Approved  
 BY M. J. Chenette DATE 06/05/2014

C:\Users\ADu... \Documents\WorkDocuments\WELDING PROCEDURES\RB-FW-001.dwg, 4/8/2014 10:37:14 AM

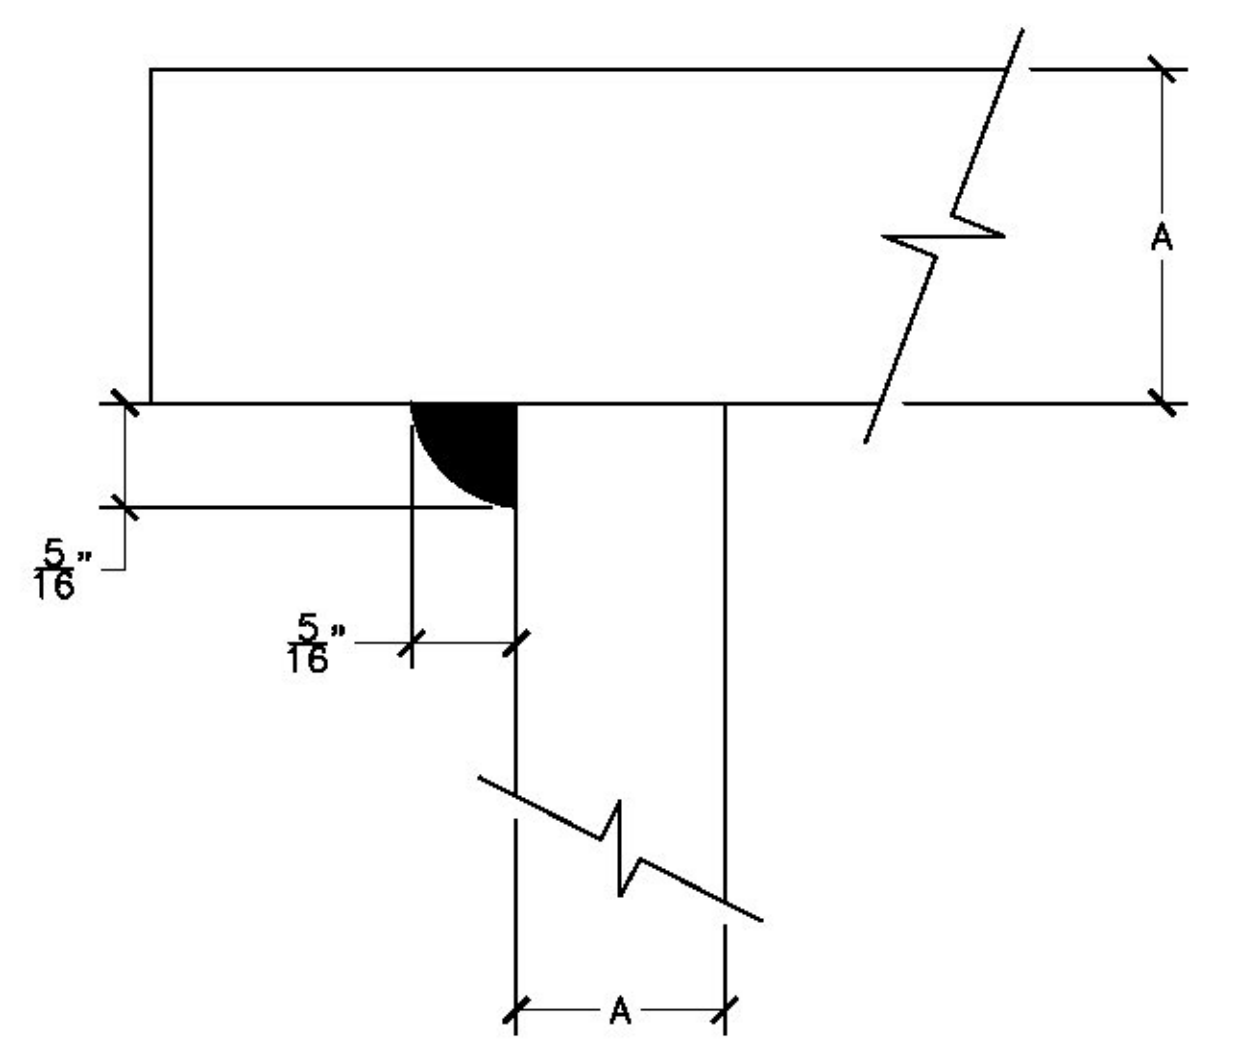	<b>WELDING PROCEDURE</b>		NO. RB-FW-001	SHEET: 2 OF 4	
	DATE: 4/8/2014	PROJECT NAME: GUILFORD			
BY: A. DUNKLEE	PROJECT NO. BRO 1442(36)				
283 FT. BRIDGMAN RD. VERNON VT., 05354 PH. (802)257-7383 FAX (802)257-7308	AWS CODE:	PQR REF. NO: N/A			
MATERIAL SPECIFICATION:	ASTM 572 GR. 50				
WELDING PROCESS:	SMAW				
MANUAL, SEMI-AUTOMATIC OR AUTOMATIC:	MANUAL				
WELDING POSITION:	ALL				
FILLER METAL SPECIFICATION:	ANSI/AWS A5.1-A5.5				
FILLER METAL CLASSIFICATION:	E7018				
FLUX:	N/A				
SHIELDING GAS:	N/A				
SINGLE OR MULTIPLE PASS:	MULTIPLE				
SINGLE OR MULTIPLE ARC:	SINGLE				
WELDING CURRENT:	DC			APPROVAL STAMP  	
WELDING POLARITY:	ELECTRODE POSITIVE				
WELDING PROGRESSION:	N/A				
ROOT TREATMENT:	REMOVE ALL IMPURITIES & GALV.				
PREHEAT & INTERPASS TEMPERATURE:	≥1½"=70°F 1½"-2½"=150°F OVER 2½"=225°F				
POSTHEAT TREATMENT:	N/A				
HEAT INPUT:	MIN:	N/A	MAX:		N/A
ELECTRODE STICKOUT:	N/A				
PASS NO.	ELECTRODE SIZE:	WELDING CURRENT AMPS	WELDING CURRENT VOLTS	TRAVEL SPEED	
AS REQ.	3/32"	70-110		ADJUST AS REQ.	
	1/8"	70-170			
<b>JOINT DETAIL: HP 14X89 PILE CAP</b> 					
NOTES: ALL MATERIAL TO BE A572 GR. 50 PILE CAP SIZE: 1"X14"X14" GRIND SURFACES FLAT AND SMOOTH PRIOR TO WELDING A- VARIES (ADJUST PREHEAT TEMP AS REQ.)					




# WELDING PROCEDURE

NO. SPLICE DETAIL  
 SHEET: 3 OF 4

283 FT. BRIDGMAN RD. VERNON VT., 05354  
 PH. (802)257-7383 FAX (802)257-7308

DATE: 4/8/2014	PROJECT NAME: GUILFORD
BY: A. DUNKLEE	PROJECT NO. BRO 1442(36)
AWS CODE:	PQR REF. NO: N/A

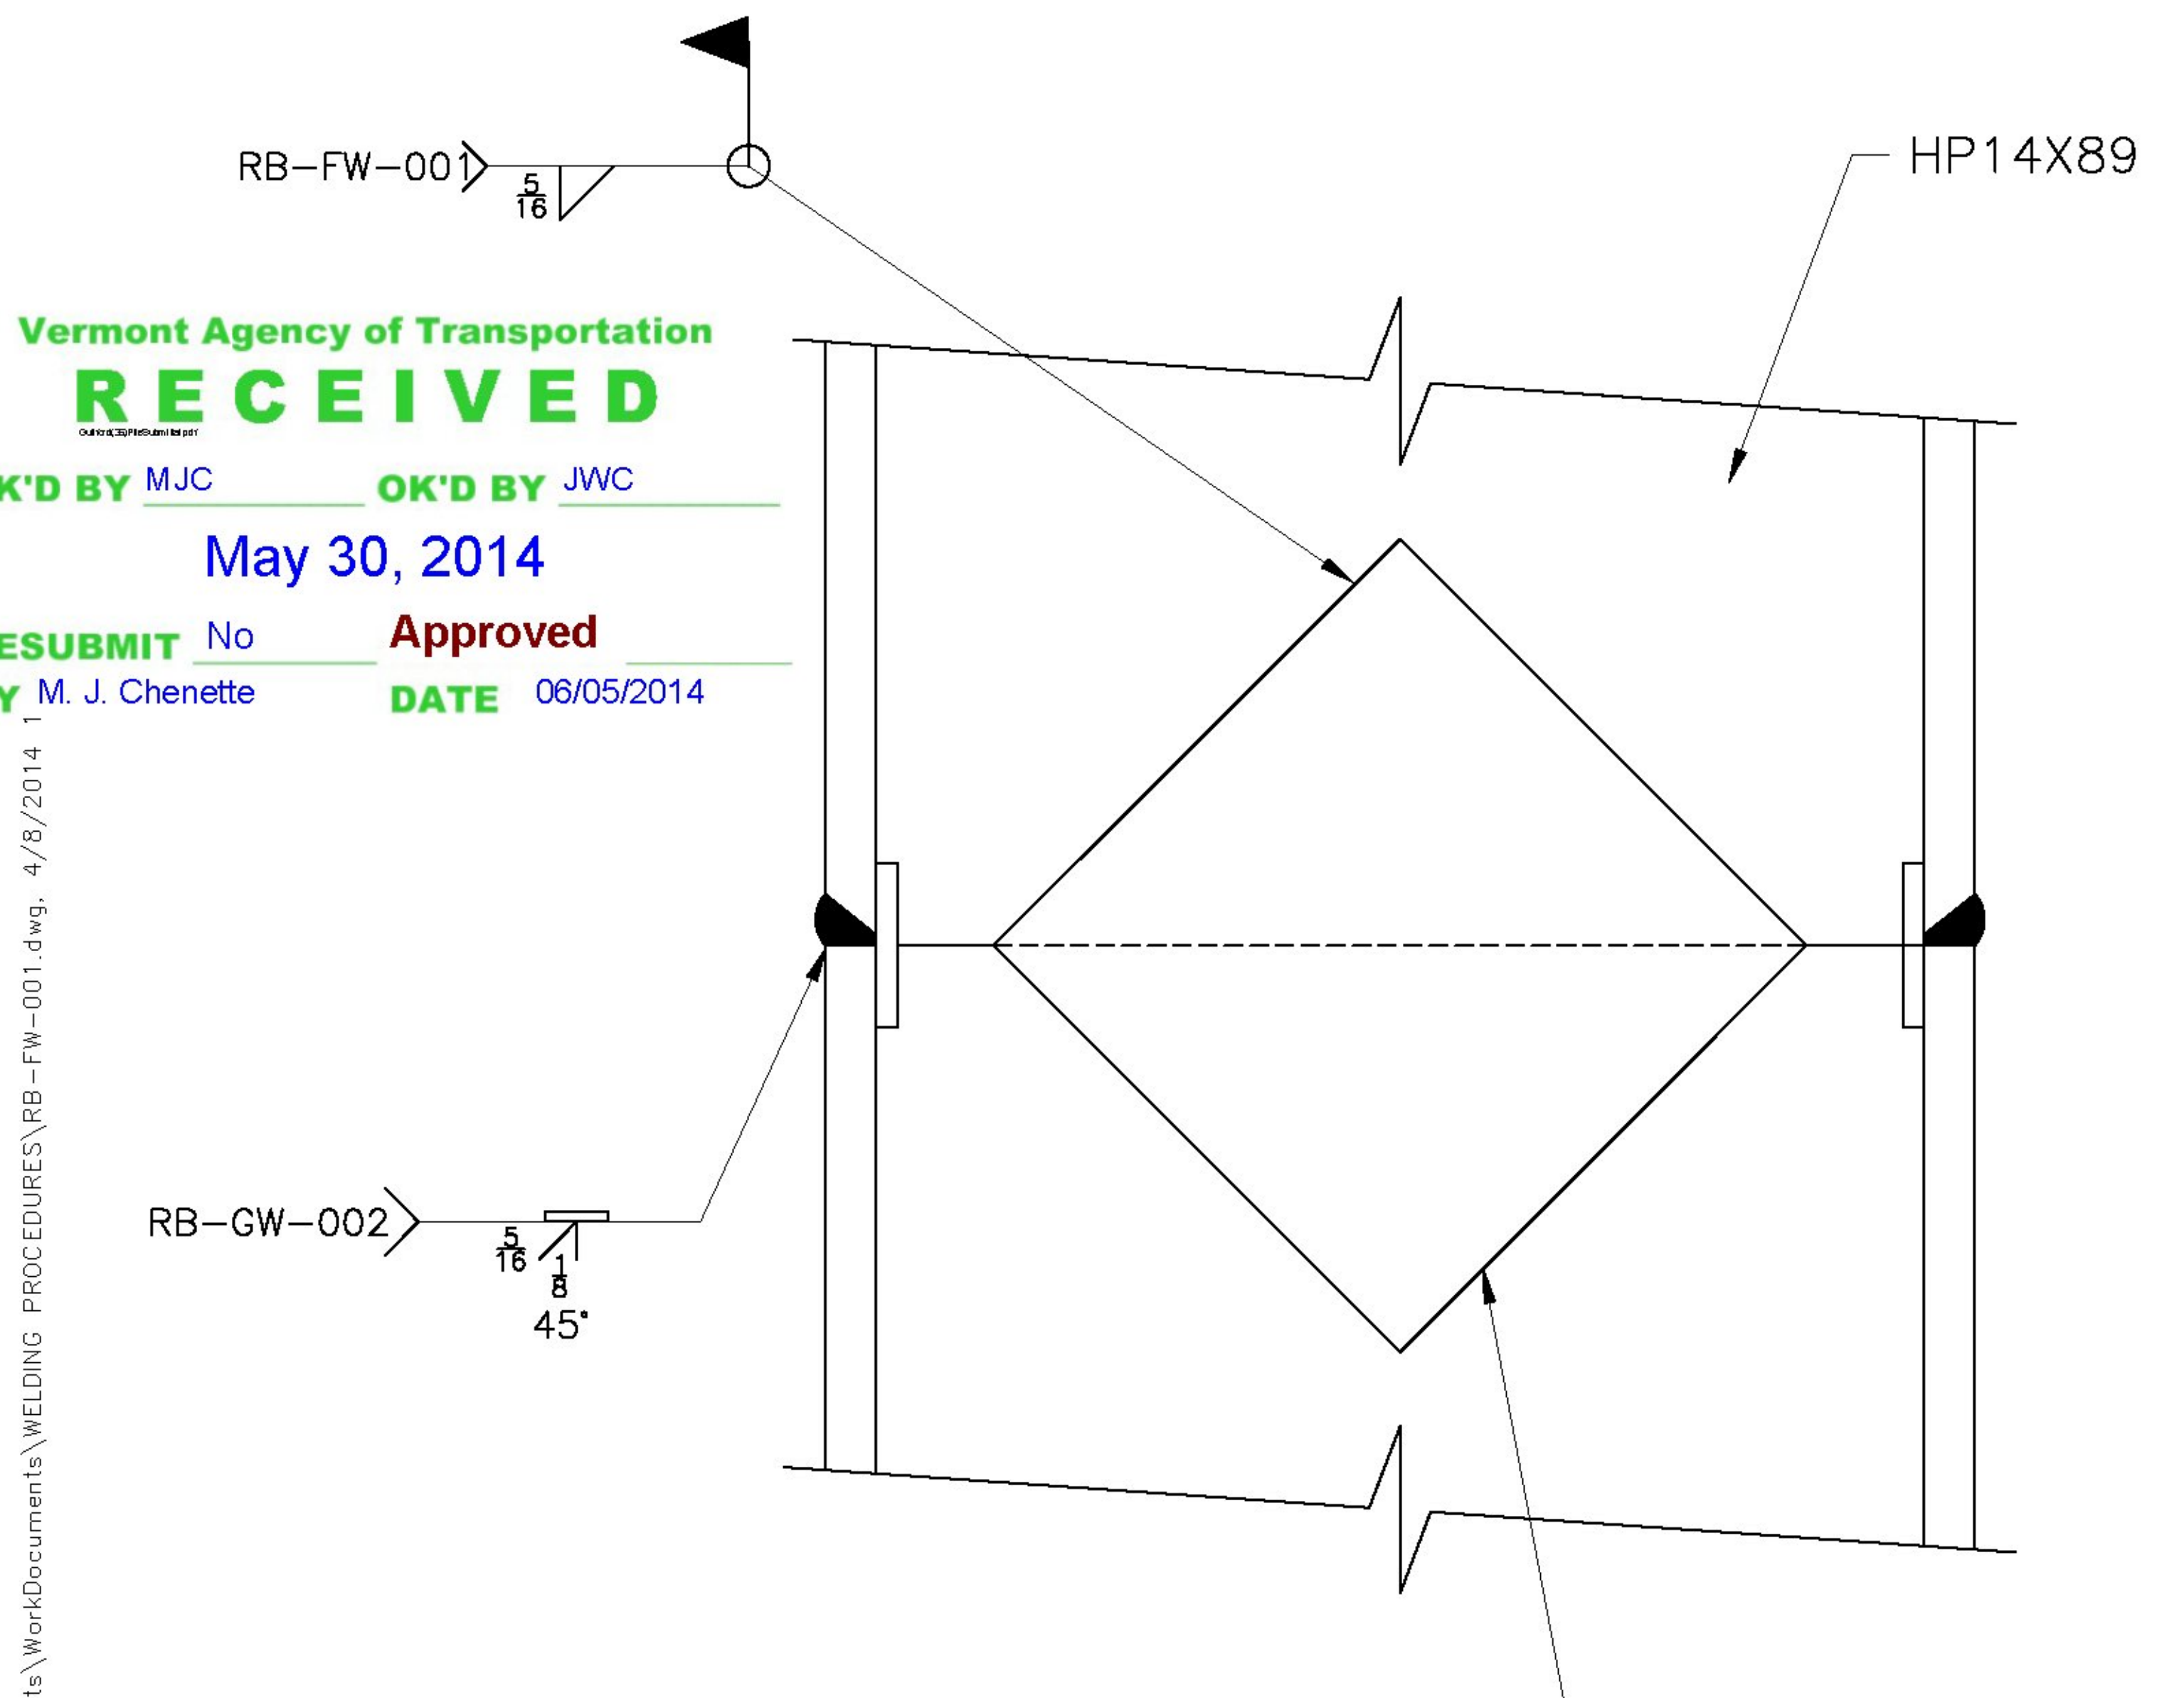

Vermont Agency of Transportation  
**RECEIVED**  
 CK'D BY MJC OK'D BY JWC  
 May 30, 2014  
 RESUBMIT No Approved  
 BY M. J. Chenette DATE 06/05/2014

C:\Users\ADunklee\Documents\WorkDocuments\Welding Procedures\RB-FW-001.dwg, 4/8/2014

NOTES:  
 SPLICE CONFIGURATION TO CONFORM TO; SECTION 505.05

3/4" PLATE  
 7"X7" GR. 50  
 BOTH SIDES



**WELDING PROCEDURE** NO. RB-GW-002 SHEET: 4 OF 4

DATE: 4/8/2014 PROJECT NAME: GUILFORD  
 BY: A. DUNKLEE PROJECT NO. BRO 1442(36)

283 FT. BRIDGMAN RD. VERNON VT., 05354 PH. (802)257-7383 FAX (802)257-7308  
 AWS CODE: PQR REF. NO: N/A

MATERIAL SPECIFICATION: ASTM 572 GR. 50  
 WELDING PROCESS: SMAW  
 MANUAL, SEMI-AUTOMATIC OR AUTOMATIC: MANUAL  
 WELDING POSITION: 2G  
 FILLER METAL SPECIFICATION: ANSI/AWS A5.1-A5.5  
 FILLER METAL CLASSIFICATION: E7018  
 FLUX: N/A  
 SHIELDING GAS: N/A FLOW RATE: N/A  
 SINGLE OR MULTIPLE PASS: MULTIPLE  
 SINGLE OR MULTIPLE ARC: SINGLE


Vermont Agency of Transportation  
**RECEIVED**  
 CK'D BY MJC OK'D BY JWC  
 May 30, 2014  
 RESUBMIT No Approved  
 BY M. J. Chenette DATE 06/05/2014

WELDING CURRENT: DC  
 WELDING POLARITY: ELECTRODE POSITIVE  
 WELDING PROGRESSION: N/A  
 ROOT TREATMENT: REMOVE ALL IMPURITIES & GALV.  
 PREHEAT & INTERPASS TEMPERATURE:  $\geq 1\frac{1}{2}'' = 70^{\circ}\text{F}$   $1\frac{1}{2}'' - 2\frac{1}{2}'' = 150^{\circ}\text{F}$  OVER  $2\frac{1}{2}'' = 225^{\circ}\text{F}$   
 POSTHEAT TREATMENT: N/A  
 HEAT INPUT: MIN: N/A MAX: N/A  
 ELECTRODE STICKOUT: N/A

APPROVAL STAMP

PASS NO.	ELECTRODE SIZE:	WELDING CURRENT		TRAVEL SPEED
		AMPS	VOLTS	
AS REQ.	3/32"	70-110		ADJUST AS REQ.
	1/8"	70-170		

JOINT DETAIL: HP 14X89 PILE SPLICE

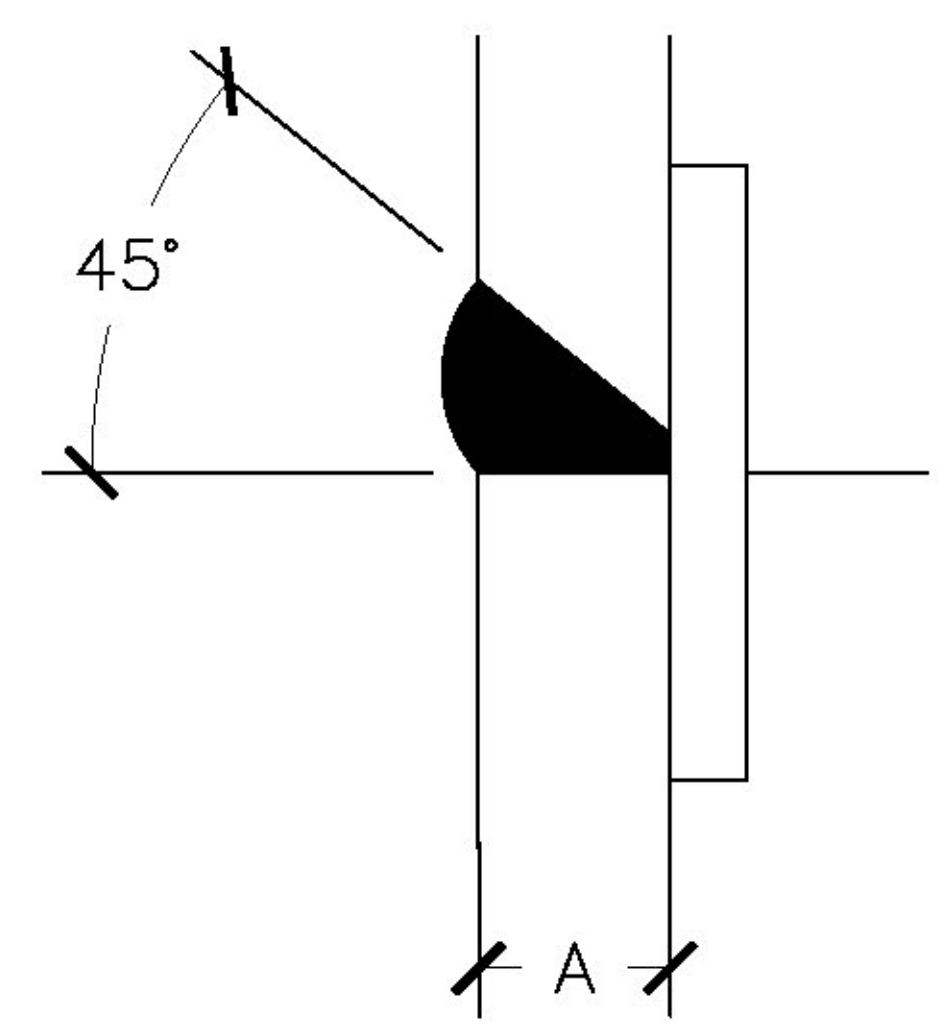


NOTES:  
 ALL MATERIAL TO BE A572 GR. 50  
 ROOT OPENING- 1/8" MIN.  
 1/4"X2" BACKING STRIP

A- VARIES (ADJUST PREHEAT TEMP AS REQ.)


C:\Users\du\Documents\WorkDocuments\WELDING PROCEDURES\RB-GW-001.dwg, 4/8/2014 10:37:15 AM

S:\Engineering Services\Carrara\14001 - Guilford Bridge 65\Production Drawings\AutoCAD Files\144236-F1.dwg, 5/6/2014 4:44:15 PM, DWG To PDF.pc3

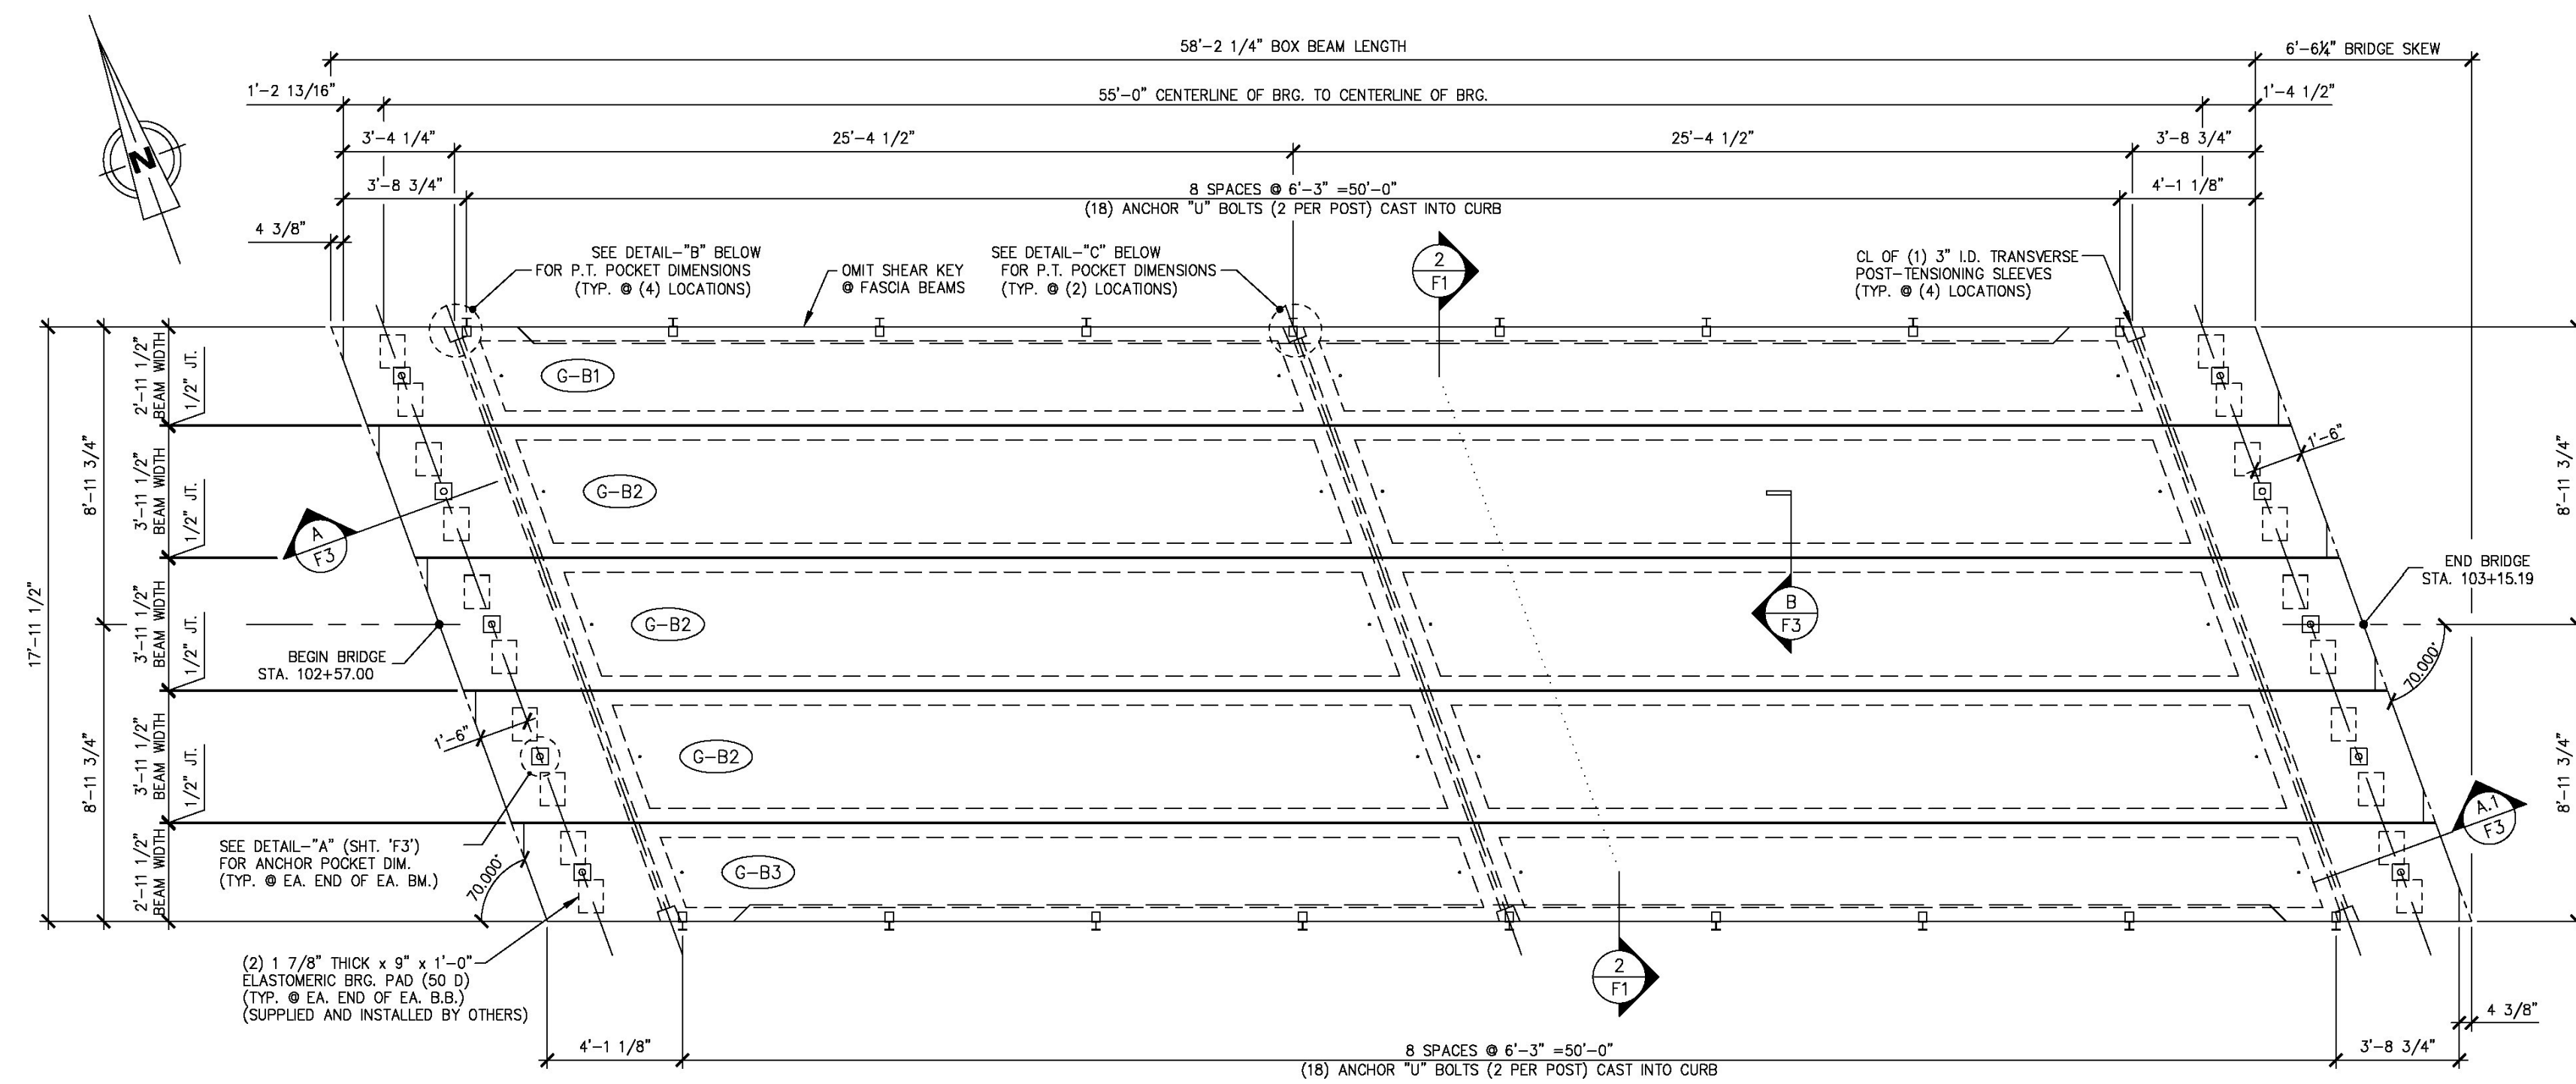


**1 PRESTRESSED BOX BEAM LAYOUT**  
1/4" = 1'-0"




DESIGN LIVE LOAD: HL-93

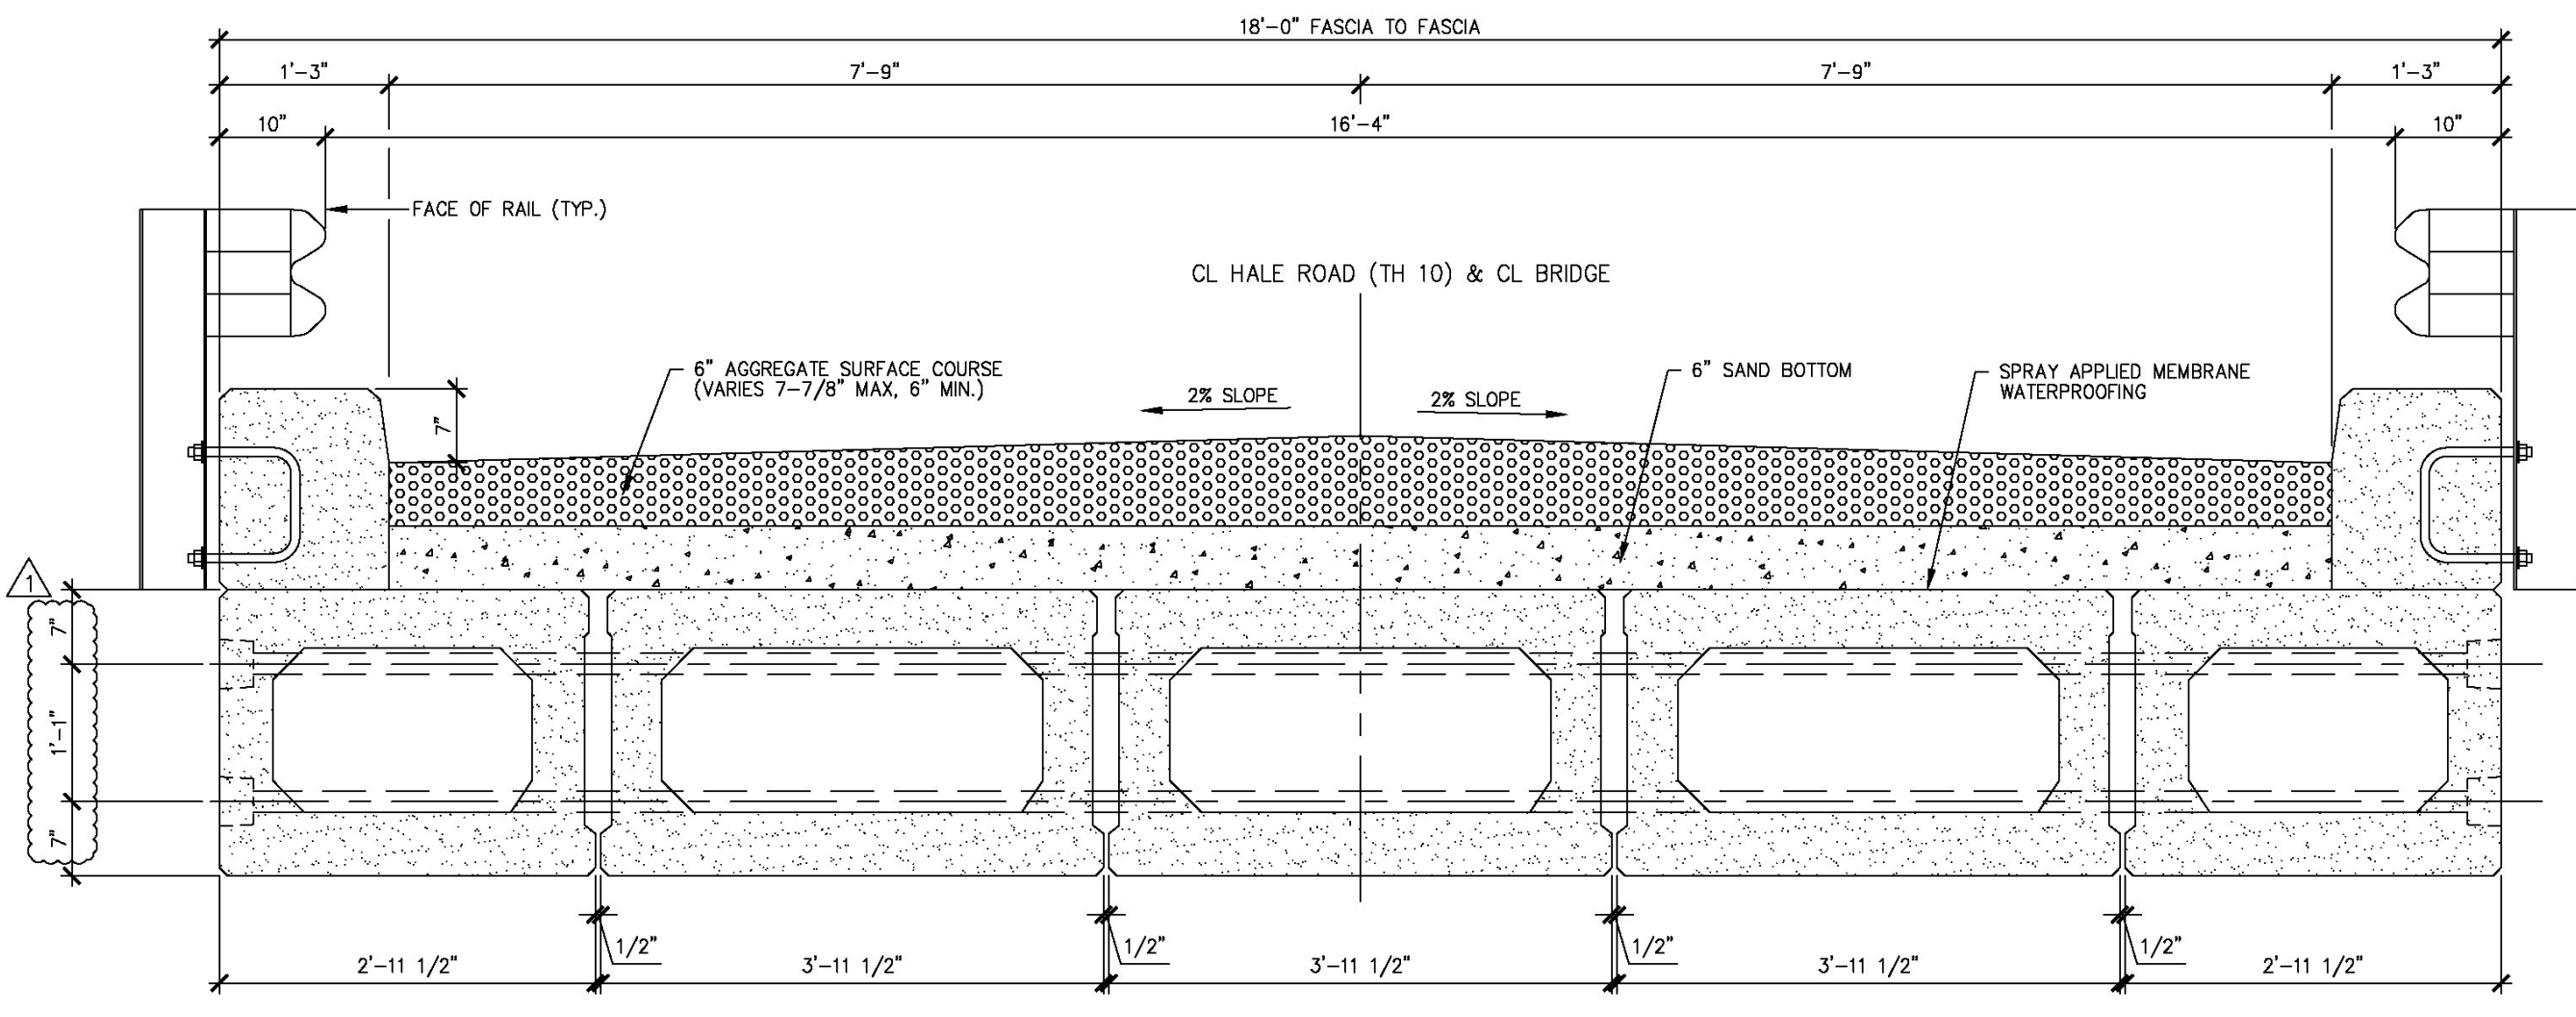



**2 APPROACH SLAB TRANSVERSE SECTION**  
3/4" = 1'-0"

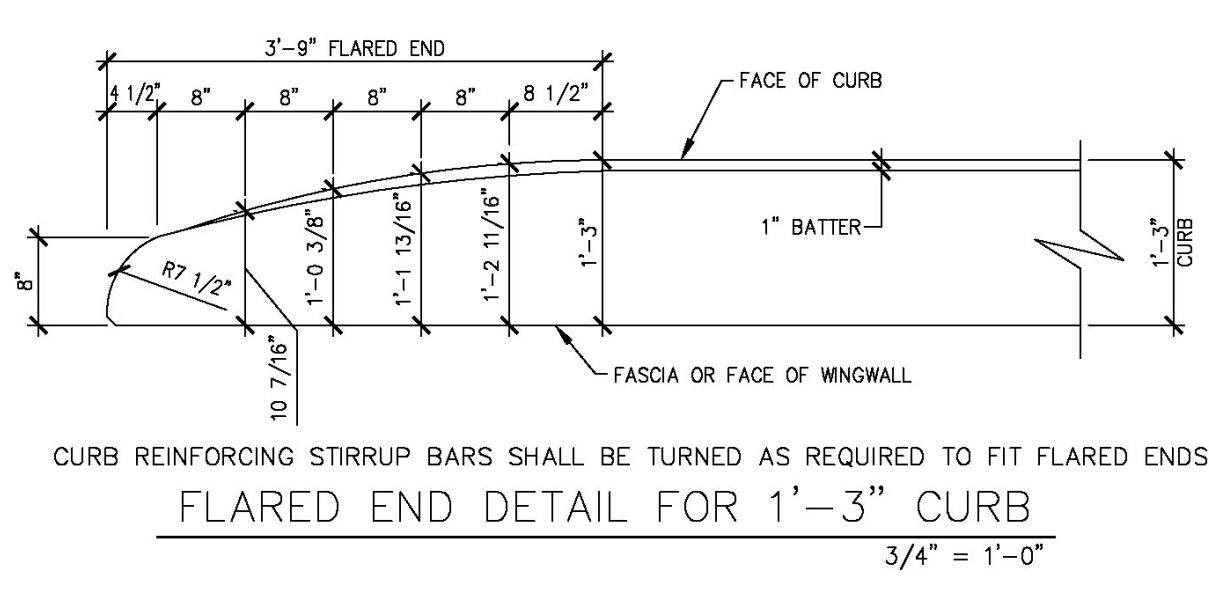

CURB REINFORCING STIRRUP BARS SHALL BE TURNED AS REQUIRED TO FIT FLARED ENDS  
**FLARED END DETAIL FOR 1'-3" CURB**  
3/4" = 1'-0"

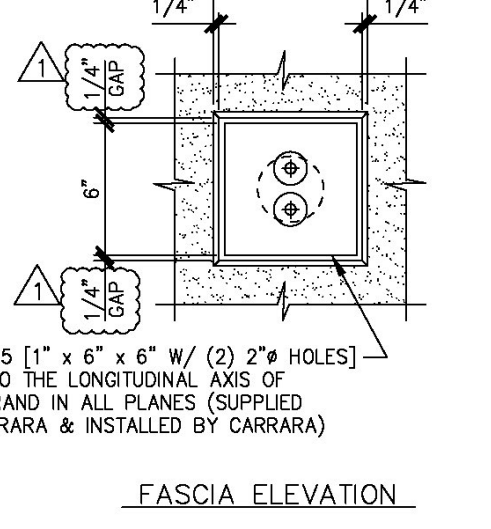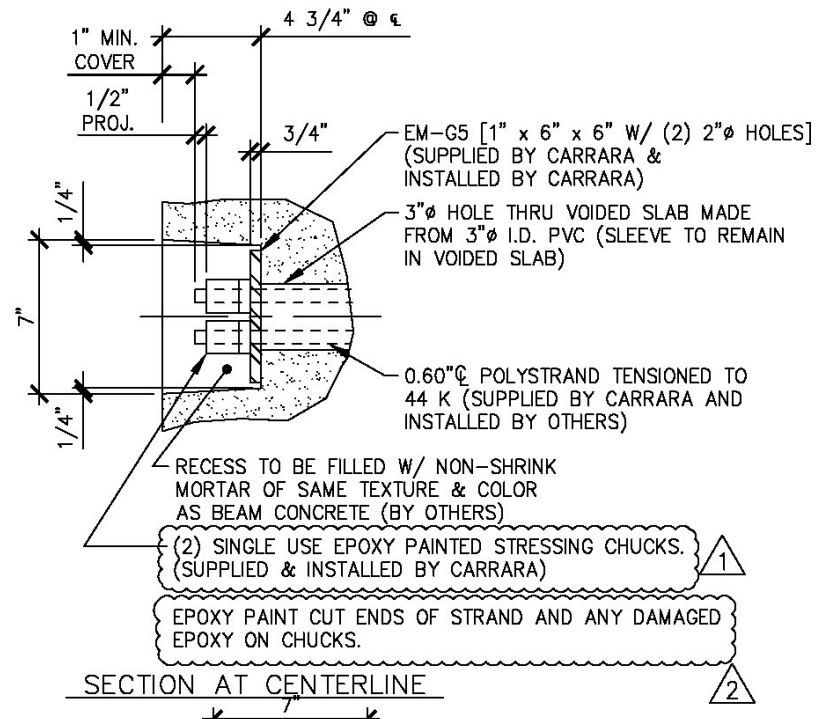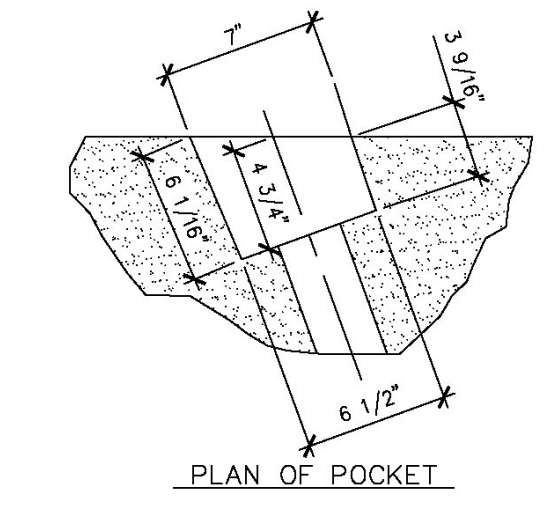

**DETAIL - "C"**  
1 1/2" = 1'-0"

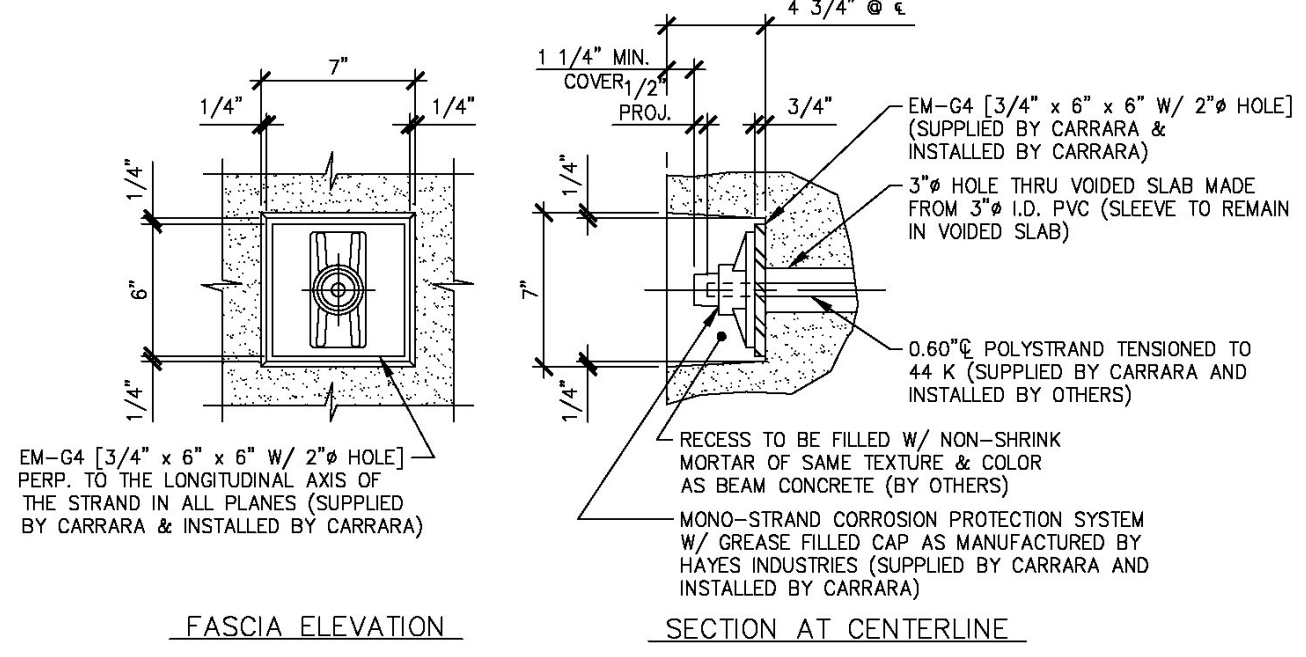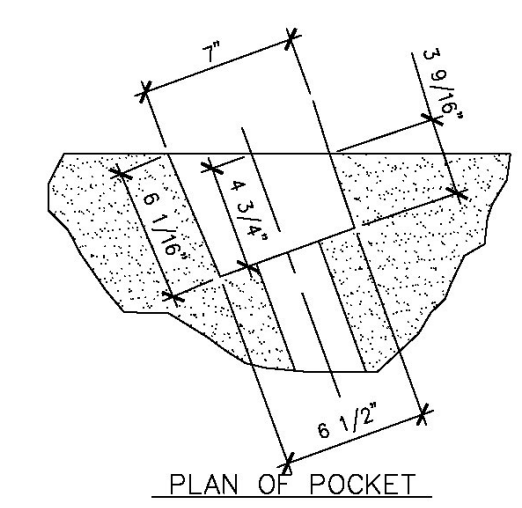

**DETAIL - "B"**  
1 1/2" = 1'-0"

- GENERAL NOTES**
- MIN. CONCRETE STRENGTH AT 28 DAYS SHALL BE 6,000 PSI.
  - MIN. CONCRETE STRENGTH AT STRESS TRANSFER SHALL BE 4,800 PSI.
  - REINFORCING STEEL SHALL BE GR-60, ASTM A-615 (AASHTO M31) AND SHALL BE BLACK BAR WITH THE EXCEPTION OF REINFORCEMENT IN BOX BEAMS AND CURBS WHICH SHALL BE LEVEL II - DUAL COATED.
  - PRESTRESSING STRANDS SHALL CONFORM TO ASTM A-416 (AASHTO M203) AND SHALL CONSIST OF 0.60" x 270 KSI 7-WIRE LOW RELAXATION STRANDS.
  - PRESTRESSING STRANDS SHALL EACH BE PULLED TO HAVE A NET TENSION OF 44.0 K AFTER ACCOUNTING FOR CHUCK SLIPPAGE. TENSION SHALL BE VERIFIED BY MEASURING STRAND ELONGATION. (SEE EXAMPLE ELONGATION CALCULATION AND TENSIONING PROCEDURE, THIS SHEET.)
  - ENDS OF PRESTRESSING STRANDS SHALL BE RECESSED 3/4" AND PATCHED WITH AN APPROVED GROUT.
  - ALL EXPOSED CORNERS SHALL BE CHAMFERED 3/4".
  - THE TOP OF BEAMS SHALL RECEIVE A SMOOTH FLOAT FINISH, U.N.O.
  - SHEAR KEY SURFACES SHALL BE SAND BLASTED CLEAN.
  - BEAMS SHALL BE HANDLED AND ERECTED USING THE LIFTING LOOPS ONLY. THE PINS OF THE SHACKLES SHALL BE PLACED THROUGH THE LIFTING LOOPS. SEE DETAIL, SHEET F-3. BEAMS SHALL BE STORED AND TRANSPORTED WITH TIMBER SUPPORTS WITHIN 2'-0" OF THE BEAM ENDS, UNLESS APPROVED BY J.P. CARRARA & SONS, INC.
  - MATERIAL SPECIFICATION AND MIX DESIGN SHALL CONFORM TO VERMONT SPEC. PS-40.05  
DESIGN MIX: J.P.C. BRIDGE MIX #425M (NO DC)
  - QUALITY CONTROL PROCEDURES ARE IN ACCORDANCE WITH PCI REQUIREMENTS. J.P. CARRARA & SONS, INC. IS A PCI CERTIFIED PLANT.
  - CURING METHOD: AS SOON AS THE TOP OF BEAM IS FINISHED, A COVER OF POLY AND A LAYER OF HOMOSOL (OR BLUE BOARD) WILL BE PLACED OVER THE BEAM. THE DESIRED CURING TEMPERATURE RANGE SHALL NOT DROP BELOW 70°. THE TEMPERATURE SHALL BE RECORDED BY AUTOMATIC SENSOR INSTRUMENTS ON GRAPH CHARTS, SPACED NOT MORE THAN 100' APART AND WILL CONTINUE UNTIL RELEASE STRENGTH IS ACHIEVED. (NATURAL CURE WITH NO EXTERNAL HEAT APPLIED). EACH CHART SHALL BE MARKED.
  - TRANSVERSE POST-TENSIONING SEQUENCE:
    - ERECT BOX BEAMS, AND POST-TENSION TENDONS TO APPROXIMATELY 5,000 LBS.
    - GROUT SHEAR KEYS.
    - ONCE SHEAR KEY GROUT HAS ATTAINED A MINIMUM COMPRESSIVE STRENGTH OF 1,500 PSI; POST-TENSION TENDONS TO 44,000 LBS. FOR EACH 0.60" STRAND.

**EXAMPLE PRESTRESSING STRAND ELONGATION CALC. AND TENSIONING**  
(NOT TO BE USED FOR CONSTRUCTION)

SIZE & GRADE: 0.60" DIA. x 270 KSI  
AREA: 0.217 IN²  
TENSION: 44,000 LB. EACH STRANDS  
GRIP-TO-GRIP: 192'-9 3/4" = 192.813'  
E_s = 28,600,000 PSI (ASSUMED FOR THESE CALCULATIONS; VALUE TO BE OBTAINED FOR STRAND SPOOL ACTUALLY USED)

EXAMPLE:  
 $\Delta L = \frac{PL}{AE} = \frac{(44,000 \times 3,000) \times 192.813 \times 12}{28,600,000} = 15.29'$

THEREFORE (TOLERANCES  $\pm 5\%$ )  
 $\Delta$  UPPER LIMIT =  $1.05 \times 15.29' = 16.05' = 16 \text{ 1/16}"$   
 $\Delta$  LOWER LIMIT =  $0.95 \times 15.29' = 14.53' = 14 \text{ 1/2}"$

EXTRA FORCE REQUIRED TO COMPENSATE FOR 1/2" CHUCK SLIPPAGE:  
 $\Delta P = \frac{0.5 \times 41,000}{15.29} = 1,340 \text{ LBS.}$

TOTAL TENSIONING FORCE = 44,000 + 1,340 = 45,340 LBS.

- STRAND TENSIONING PROCEDURE:**
- PULL EACH STRAND INITIALLY TO 3,000* LBS. AND MARK STRAND.
  - THEN PULL EACH STRAND TO A TOTAL TENSION OF 45,340* LBS. AND MEASURE ELONGATION AFTER SEATING. IT MUST BE BETWEEN 14 1/2" & 16 1/16".
- * NOTE: FORCES READ ON STRESSING JACK GAUGES MUST BE MADE TO CORRESPOND TO ABOVE VALUES BASED ON CALIBRATION DATA FOR SPECIFIC JACK USED.

**SHOP DRAWING REVIEW**

REVIEWED AS REQUIRED BY THE CONSTRUCTION CONTRACT DOCUMENTS AND APPROVED, BUT ONLY FOR CONFORMANCE TO THE DESIGN CONCEPT OF THE WORK, AND SUBJECT TO FURTHER LIMITATIONS AND REQUIREMENTS CONTAINED IN THE CONSTRUCTION CONTRACT DOCUMENTS.

REJECTED  REVISE AND RESUBMIT  FURNISH AS CORRECTED

CORRECTIONS OR COMMENTS MADE ON THE SHOP DRAWINGS DURING THIS REVIEW DO NOT RELIEVE CONTRACTOR FROM COMPLIANCE WITH REQUIREMENTS OF THE DRAWINGS AND SPECIFICATIONS. THIS CHECK IS ONLY FOR REVIEW OF GENERAL CONFORMANCE WITH THE DESIGN CONCEPT OF THE PROJECT AND GENERAL COMPLIANCE WITH THE INFORMATION GIVEN IN THE CONTRACT DOCUMENTS. THE CONTRACTOR IS RESPONSIBLE FOR CONFIRMING AND CORRELATING ALL QUANTITIES AND DIMENSIONS, SELECTING FABRICATION PROCESSES AND TECHNIQUES OF CONSTRUCTION, COORDINATING HIS WORK WITH THAT OF ALL OTHER TRADES; AND PERFORMING HIS WORK IN A SAFE AND SATISFACTORY MANNER.

**Vanasse Hangen Brustlin, Inc.**  
7056 US Route 7  
North Ferrisburgh, VT 05473  
802-425-7789

Job Number: 57427.00  
Reviewed By: S.E. Burbank  
Date: 06/19/2014

**Vermont Agency of Transportation**

**RECEIVED**

CK'D BY MJC OK'D BY TAS

June 18, 2014

RESUBMIT No Approved

BY M. J. Chenette DATE 06/19/2014

**Eriksson technologies**  
813.989.3317  
TAMPA, FL LRF.D.COM  
© 2014 ERIKSSON TECHNOLOGIES, INC. ALL RIGHTS RESERVED

4-7-14 REVISED AS NOTED  
5-6-14 REVISED AS NOTED

APPROVAL STAMP:

**J.P. CARRARA & SONS INC.**  
Precast & Prestress Manufacturer N.T.S.  
244 CASE ST., MIDDLEBURY, VERMONT 05753 Phone: (802)388-6361 Fax: (802)388-9010


STATE OF VERMONT AGENCY OF TRANSPORTATION  
COUNTY OF WINDHAM

TOWN OF GUILFORD  
ROUTE NO. T.H.10, CLASS III (LOCAL ROAD)  
BRIDGE NO.: 65 PROJECT NO.: BRO 1442 (36)

SUPERSTRUCTURE PLANS

DATE: MAR. 04, 2014  
SCALE: NOTED  
CHKD: JJ/KLT DFTM:AA1/RWS  
JOB NO: 23420-014  
DWG. NO: F1

S:\Engineering Services\Carrara\14001 - Guilford Bridge 65\Production Drawings\AutoCAD Files\144236-F1.dwg, 5/9/2014 4:44:16 PM, DWG To PDF.pc3

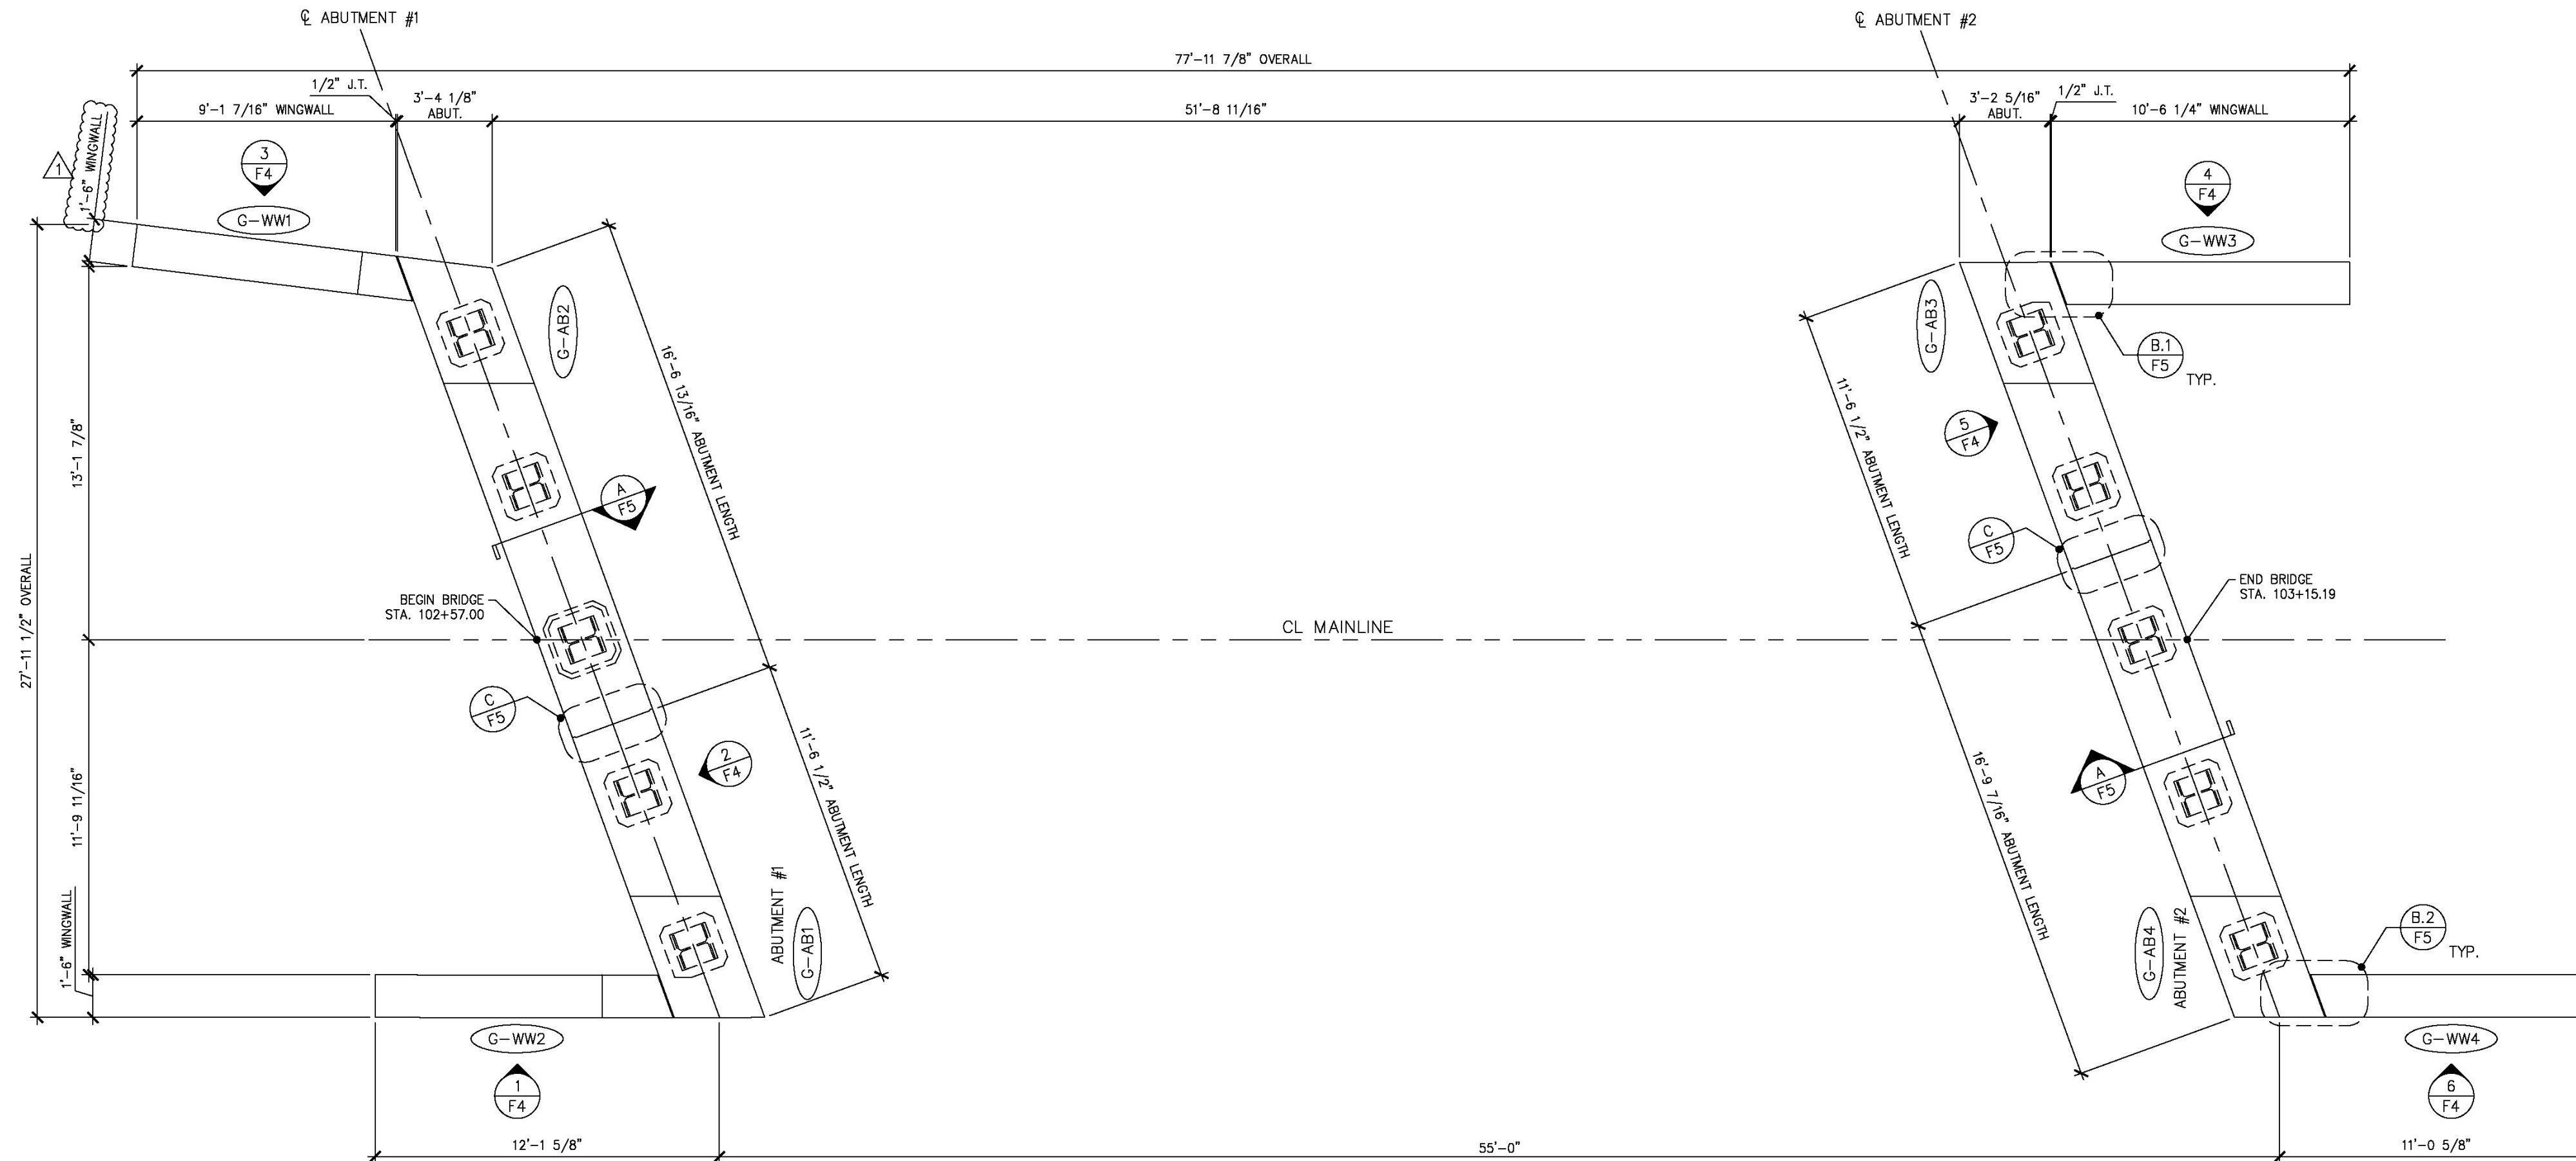

1 PRECAST CONCRETE ABUTMENT & WING WALL LAYOUT  
 F2 1/4" = 1'-0"



- ABUTMENT & WING WALL GENERAL NOTES**
- MIN. CONCRETE STRENGTH AT 28 DAYS SHALL BE 5,000 PSI.
  - MIN. CONCRETE STRENGTH AT STRESS TRANSFER SHALL BE 3,500 PSI.
  - REINFORCING STEEL SHALL BE GR-60, ASTM A-615 (AASHTO M31).
  - THE TOP OF ABUTMENTS SHALL RECEIVE A SMOOTH FLOAT FINISH.
  - ALL EDGES OF ABUTMENT SHALL RECEIVE A 1" CHAMFER (U.N.O.).
  - THE TOP OF WING WALLS SHALL RECEIVE A SMOOTH FLOAT FINISH (UNLESS NOTED OTHERWISE).
  - SHEAR KEY SURFACES SHALL BE BLASTED CLEAN.
  - PRECAST CONCRETE UNITS SHALL BE HANDLED AND ERECTED USING THE LIFTING INSERTS ONLY. THE MINIMUM SLING ANGLE FROM THE HORIZONTAL SHALL BE 60°. NON-PRESTRESSED UNITS SHALL BE STORED & TRANSPORTED WITH TIMBER SUPPORTS AT 5th POINTS, UNLESS APPROVED BY J.P. CARRARA & SONS, INC.
  - MATERIAL SPECIFICATION AND MIX DESIGN SHALL CONFORM TO VERMONT SPEC. P540.05.
- DESIGN MIX:**  
 WING WALLS: J.P.C. BRIDGE MIX #445M5CC  
 ABUTMENTS: J.P.C. BRIDGE MIX #445M5CC
- QUALITY CONTROL PROCEDURES ARE IN ACCORDANCE WITH PCI REQUIREMENTS. J.P. CARRARA & SONS, INC. IS A PCI CERTIFIED PLANT.
  - CURING METHOD: AS SOON AS THE TOP OF PRECAST CONCRETE UNITS ARE FINISHED, A COVER OF RIGID INSULATION AND POLY WILL BE PLACED OVER THE UNIT. NATURAL CURE WITH NO EXTERNAL HEAT APPLIED.
  - ABUTMENT POST-TENSIONING SEQUENCE:
    - ERECT PRECAST CONCRETE ABUTMENTS, AND POST-TENSION CENTER TENDON TO APPROXIMATELY 3,000 LBS.
    - GROUT SHEAR KEY.
    - ONCE SHEAR KEY GROUT HAS ATTAINED A MINIMUM COMPRESSIVE STRENGTH OF 1,500 PSI, POST-TENSION TENDONS TO 32,000 LBS.

Vermont Agency of Transportation  
**RECEIVED**  
 CK'D BY MJC OK'D BY TAS  
**June 18, 2014**  
 RESUBMIT No Approved  
 BY M. J. Chenette DATE 06/19/2014

**SHOP DRAWING REVIEW**

REVIEWED AS REQUIRED BY THE CONSTRUCTION CONTRACT DOCUMENTS AND APPROVED, BUT ONLY FOR CONFORMANCE TO THE DESIGN CONCEPT OF THE WORK, AND SUBJECT TO FURTHER LIMITATIONS AND REQUIREMENTS CONTAINED IN THE CONSTRUCTION CONTRACT DOCUMENTS

REJECTED  REVISE AND RESUBMIT  FURNISH AS CORRECTED

CORRECTIONS OR COMMENTS MADE ON THE SHOP DRAWINGS DURING THIS REVIEW DO NOT RELIEVE CONTRACTOR FROM COMPLIANCE WITH REQUIREMENTS OF THE DRAWINGS AND SPECIFICATIONS. THIS CHECK IS ONLY FOR REVIEW OF GENERAL CONFORMANCE WITH THE DESIGN CONCEPT OF THE PROJECT AND GENERAL COMPLIANCE WITH THE INFORMATION GIVEN IN THE CONTRACT DOCUMENTS. THE CONTRACTOR IS RESPONSIBLE FOR CONFIRMING AND CORRELATING ALL QUANTITIES AND DIMENSIONS, SELECTING FABRICATION PROCESSES AND TECHNIQUES OF CONSTRUCTION, COORDINATING HIS WORK WITH THAT OF ALL OTHER TRADES, AND PERFORMING HIS WORK IN A SAFE AND SATISFACTORY MANNER.


**VHB Vanasse Hangen Brustlin, Inc.** Job Number: 57427.00  
 7030 US Route 7 North Ferrisburgh, VT 05473 Reviewed By: S.E. Burbank  
 802.425.7788 Date: 06/19/2014

4-7-14 REVISED AS NOTED  
 5-6-14 REVISED AS NOTED


APPROVAL STAMP:	<b>J.P. CARRARA &amp; SONS INC.</b> Precast & Prestress Manufacturer N.T.S. 244 OAK ST., MIDDLEBURY, VERMONT 05753 Phone:(802)388-6361 Fax:(802)388-9010	
	STATE OF VERMONT AGENCY OF TRANSPORTATION COUNTY OF WINDHAM	DATE: MAR. 04, 2014 SCALE: NOTED
	TOWN OF GUILFORD ROUTE NO. T.H.10, CLASS III (LOCAL ROAD) BRIDGE NO.: 65 PROJECT NO.: BRO 1442 (36)	CHKD: JJ/KLT DFTM:AA1/RWS JOB NO: 23420-014
	SUBSTRUCTURE PLANS	
		DWG. NO: F2

**Eriksson technologies** 813.989.3317  
 TAMPA, FL LRFD.COM  
© 2014 ERIKSSON TECHNOLOGIES, INC. ALL RIGHTS RESERVED


S:\Engineering Services\Carrara\116001 - Guilford Bridge 651\Production Drawings\AutoCAD Files\1441236-F1.dwg, 5/6/2014 4:44:16 PM, DWG To PDF.pc3

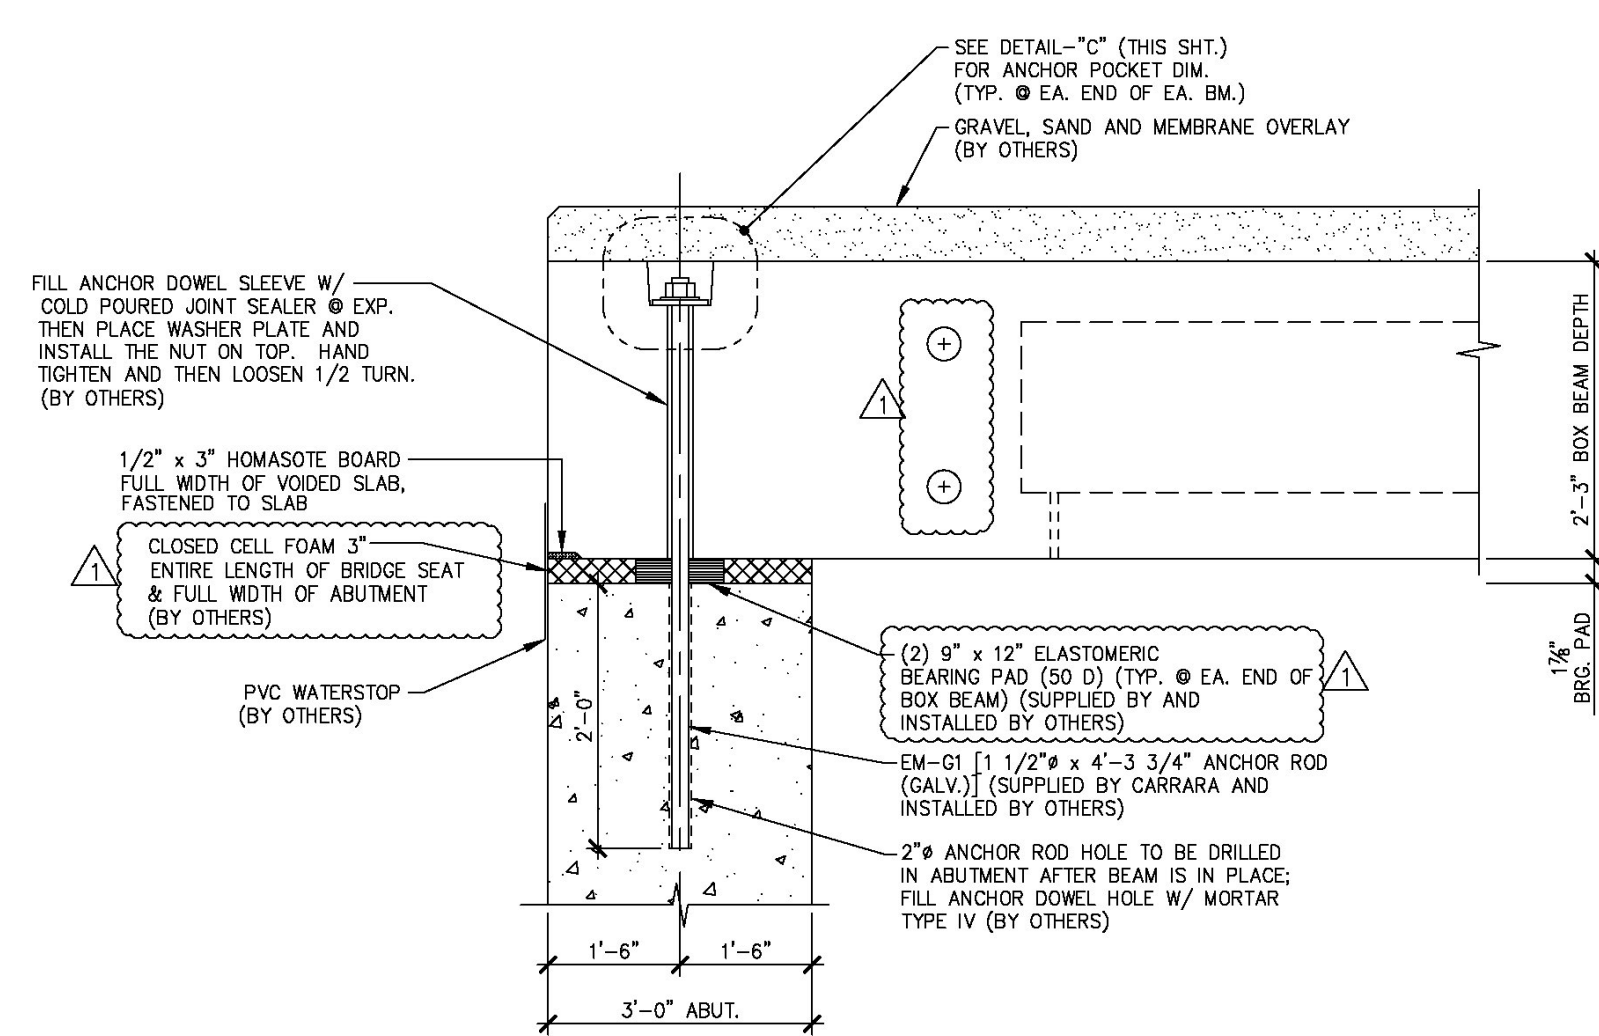


**A** BEARING SECTION  
F2 (EXP. END) 3/4" = 1'-0"

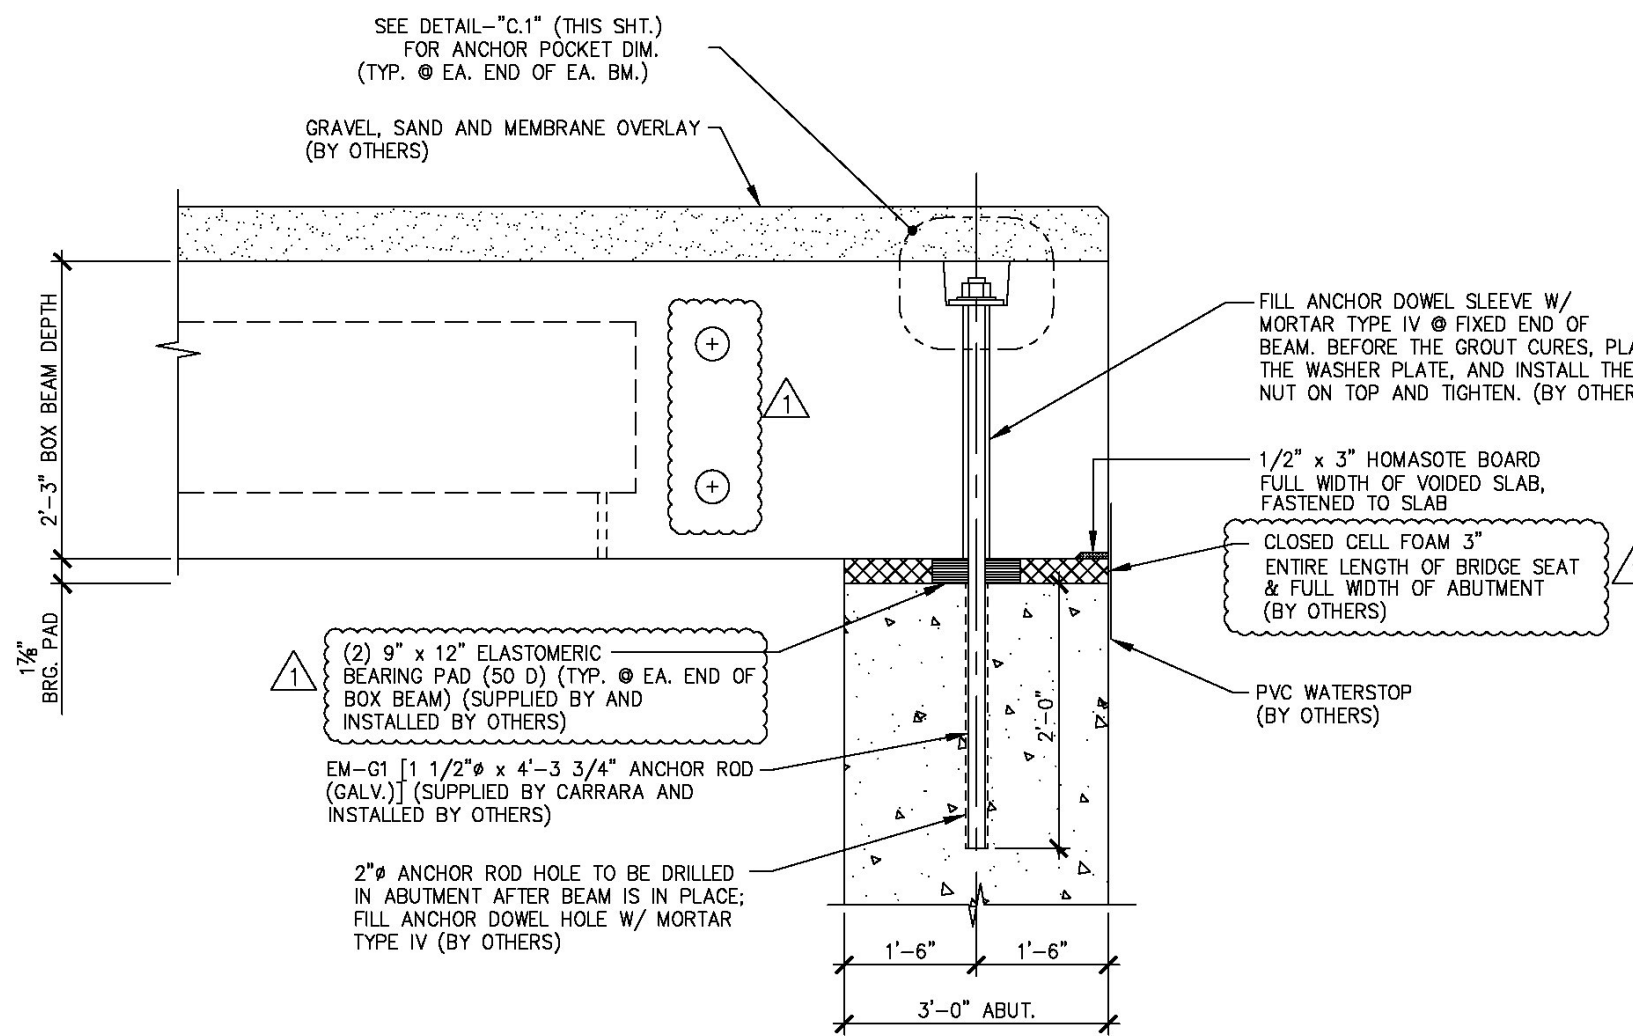


**A.1** BEARING SECTION  
F2 (FIXED END) 3/4" = 1'-0"

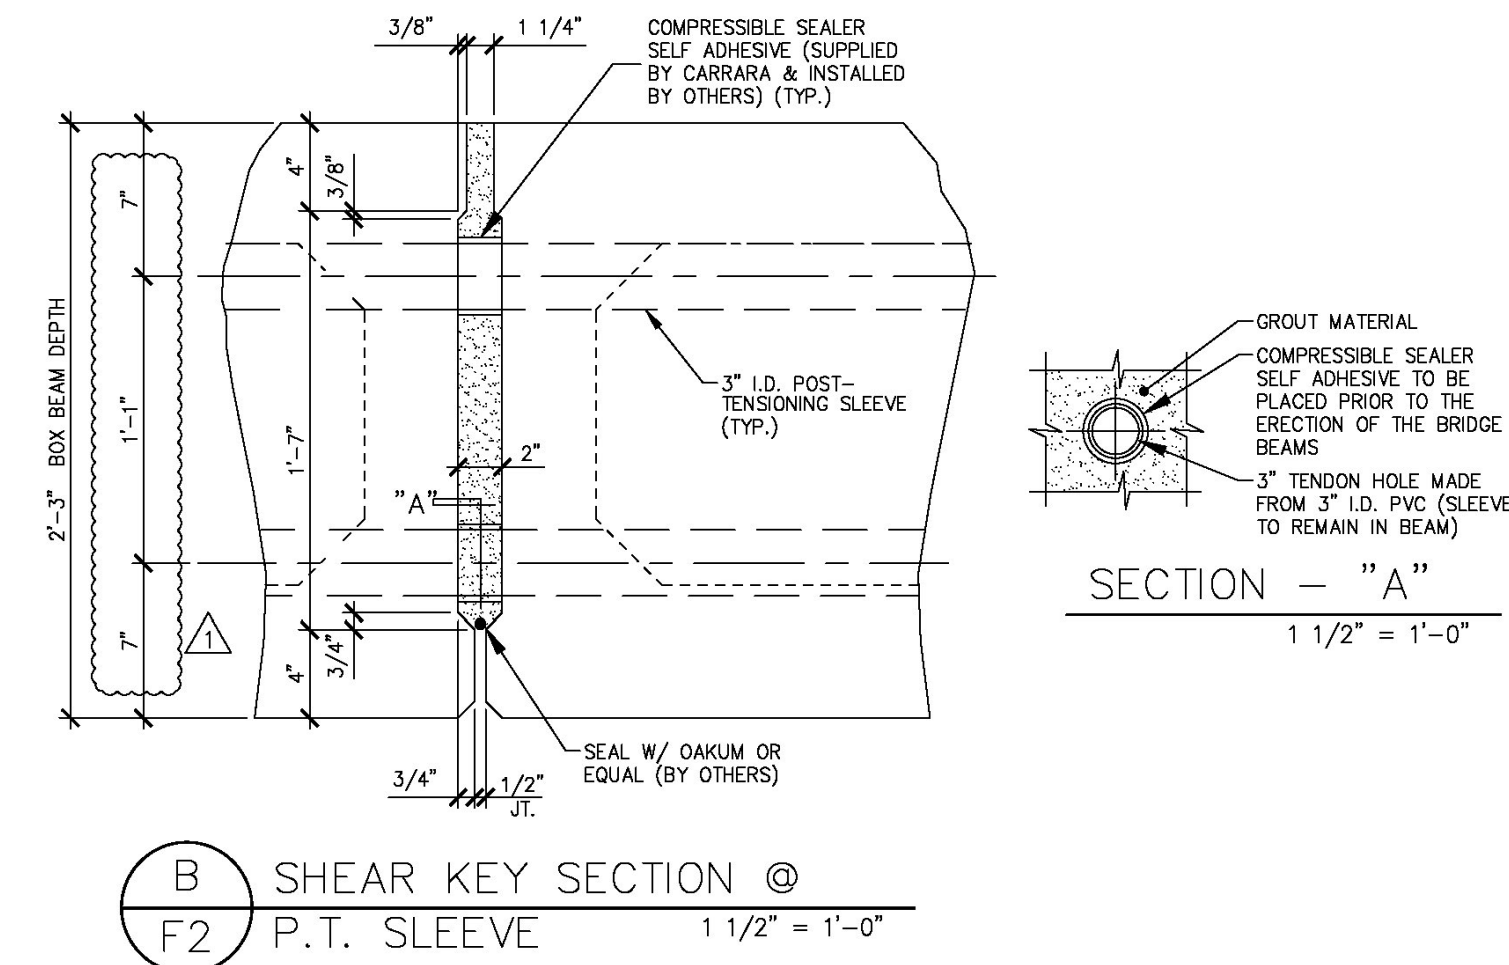


**B** SHEAR KEY SECTION @  
F2 P.T. SLEEVE 1 1/2" = 1'-0"

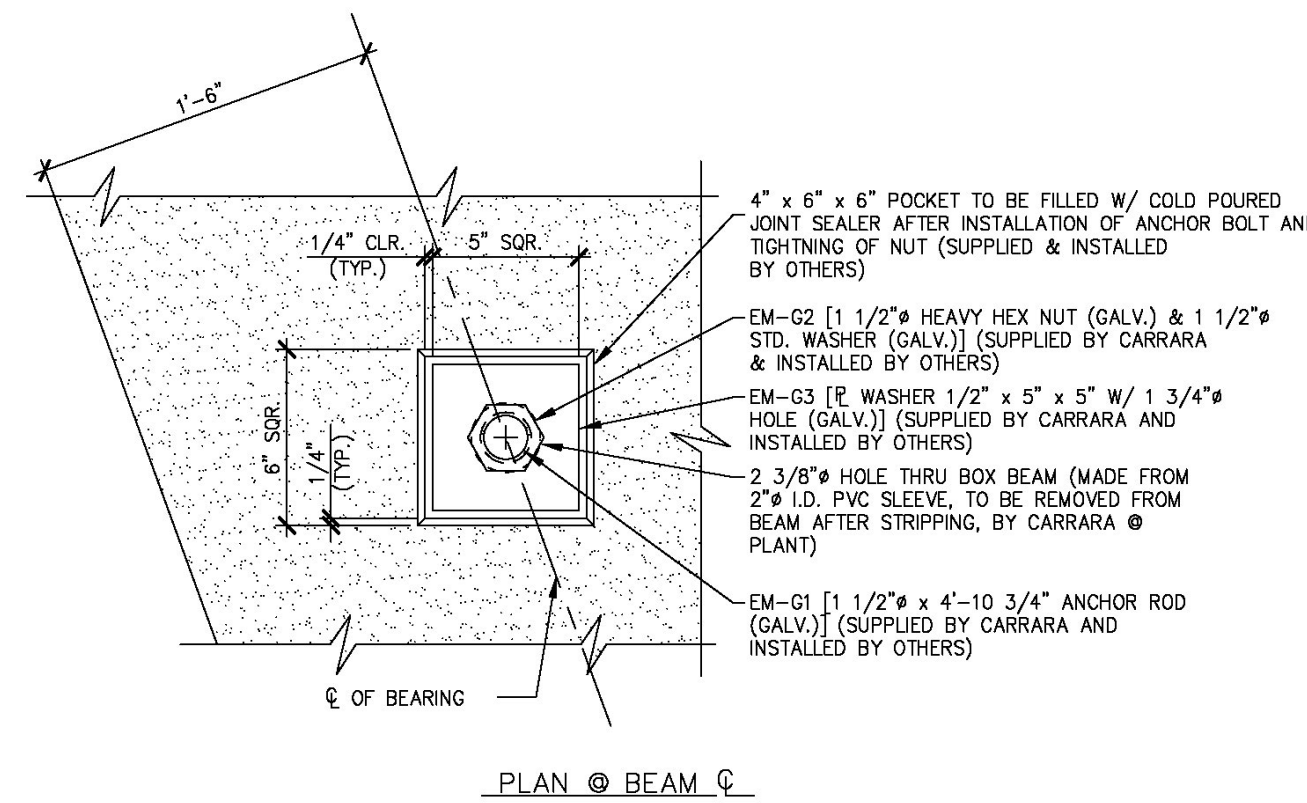


PLAN @ BEAM C

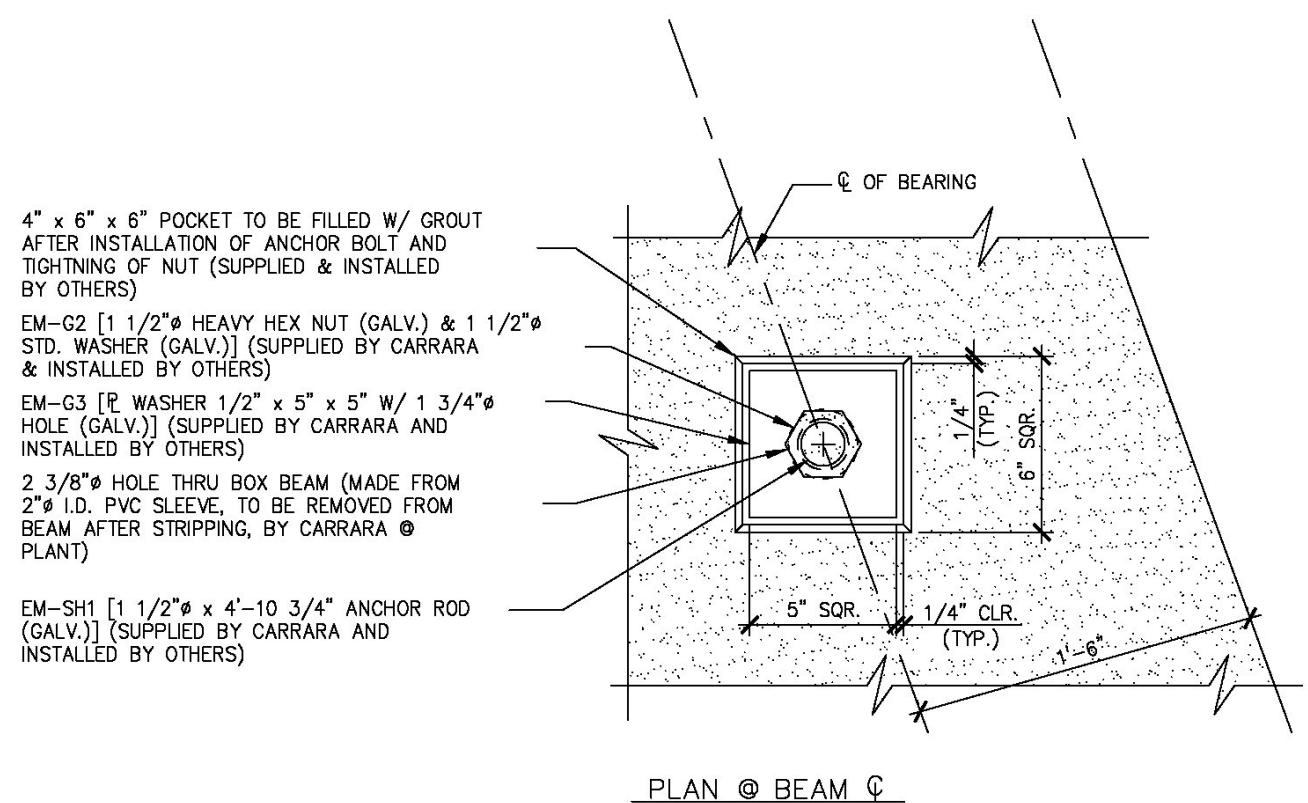

PLAN @ BEAM C

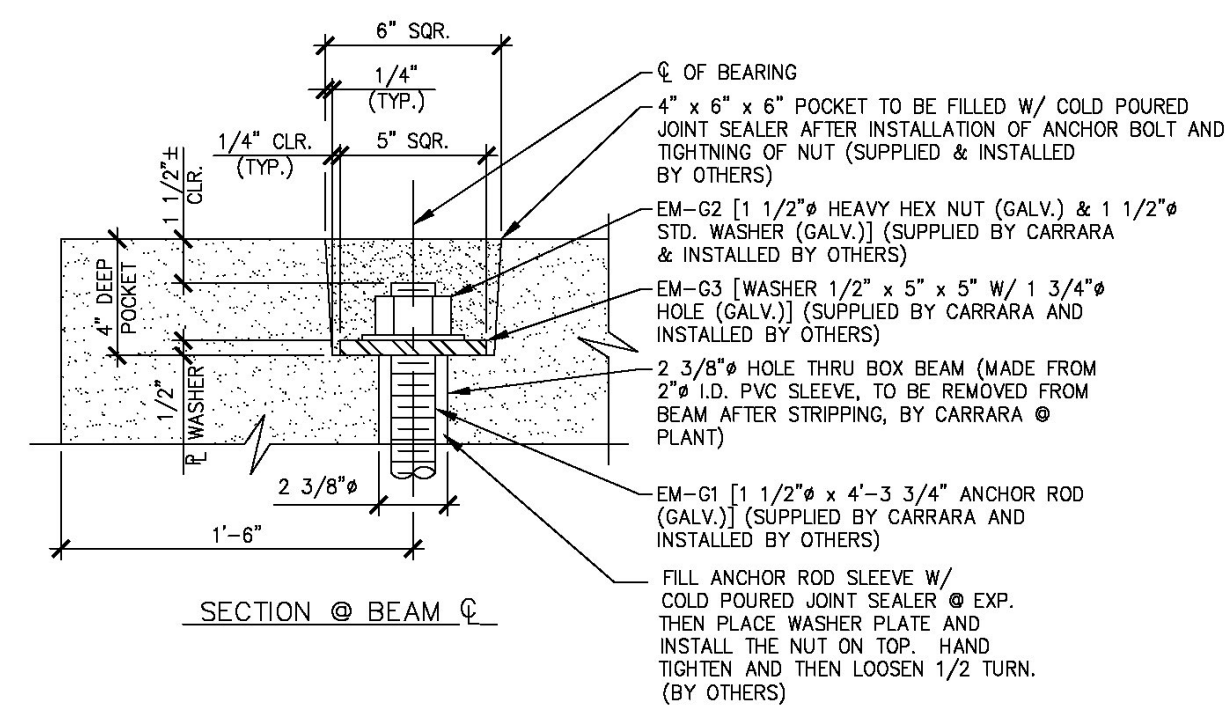


DETAIL - "C"  
2" = 1'-0"

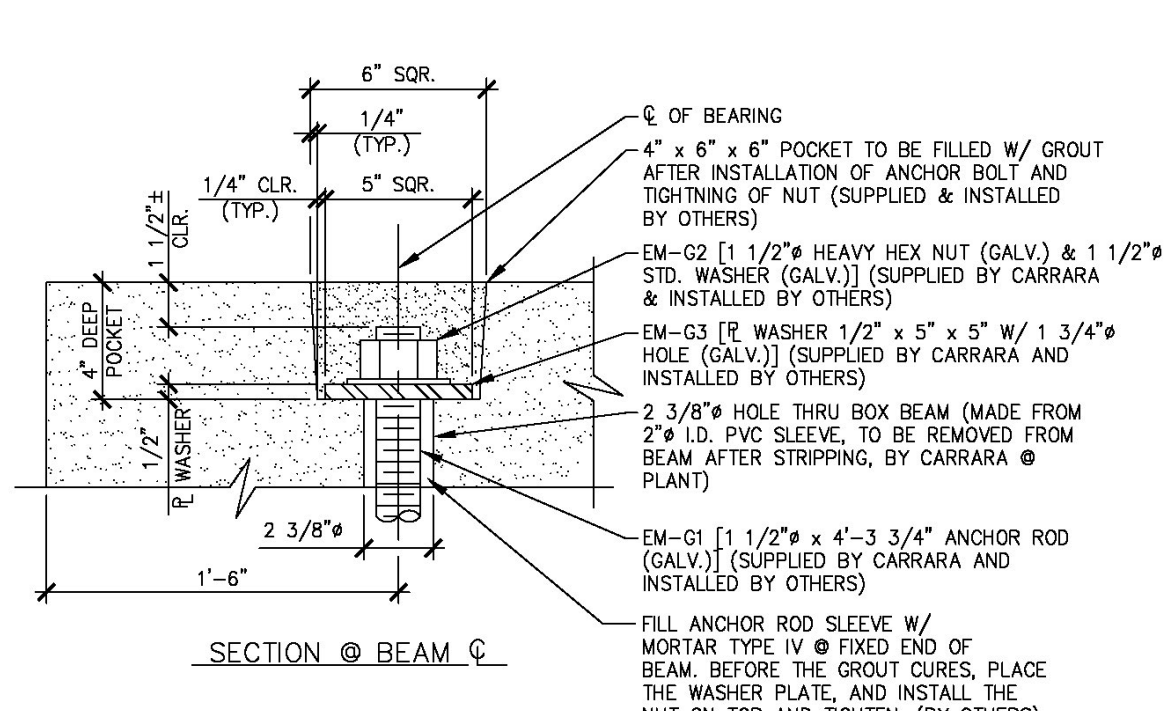

DETAIL - "C.1"  
2" = 1'-0"

Vermont Agency of Transportation  
**RECEIVED**  
CK'D BY MJC OK'D BY TAS  
June 18, 2014  
RESUBMIT No Approved  
BY M. J. Chenette DATE 06/19/2014

SHOP DRAWING REVIEW	
<input checked="" type="checkbox"/>	REVIEWED AS REQUIRED BY THE CONSTRUCTION CONTRACT DOCUMENTS AND APPROVED, BUT ONLY FOR CONFORMANCE TO THE DESIGN CONCEPT OF THE WORK, AND SUBJECT TO FURTHER LIMITATIONS AND REQUIREMENTS CONTAINED IN THE CONSTRUCTION CONTRACT DOCUMENTS.
<input type="checkbox"/>	REJECTED
<input type="checkbox"/>	REVISE AND RESUBMIT
<input type="checkbox"/>	FURNISH AS CORRECTED
CORRECTIONS OR COMMENTS MADE ON THE SHOP DRAWINGS DURING THIS REVIEW DO NOT RELIEVE CONTRACTOR FROM COMPLIANCE WITH REQUIREMENTS OF THE DRAWINGS AND SPECIFICATIONS. THIS CHECK IS ONLY FOR REVIEW OF GENERAL CONFORMANCE WITH THE DESIGN CONCEPT OF THE PROJECT AND GENERAL COMPLIANCE WITH THE INFORMATION GIVEN IN THE CONTRACT DOCUMENTS. THE CONTRACTOR IS RESPONSIBLE FOR CONFIRMING AND CORRELATING ALL QUANTITIES AND DIMENSIONS, SELECTING FABRICATION PROCESSES AND TECHNIQUES OF CONSTRUCTION, COORDINATING HIS WORK WITH THAT OF ALL OTHER TRADES, AND PERFORMING HIS WORK IN A SAFE AND SATISFACTORY MANNER.	
<b>Vanasse Hangen Brustlin, Inc.</b> 7056 US Route 7 North Ferrisburgh, VT 05473 802-425-7789	Job Number: 57427.00 Reviewed By: S.E. Burbank Date: 06/19/2014

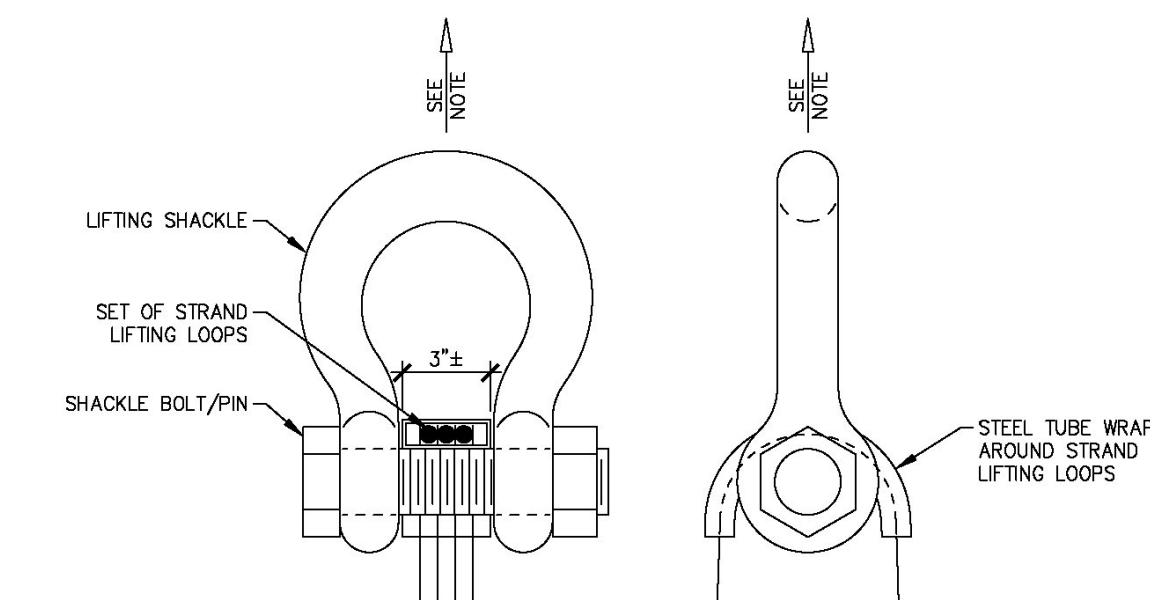

NOTE: BEAM SHALL BE HANDLED AND ERECTED USING THE LIFTING LOOPS ONLY. RIGGING SHALL BE CONFIGURED SUCH THAT EQUAL FORCES ARE APPLIED TO EACH SET OF LIFTING LOOPS AT EACH END OF THE BEAM. SHACKLE BOLT/PIN SHALL BE PLACED UNDER LIFT LOOPS AS SHOWN. DESIGN AND CONFIGURATION OF RIGGING BY PURCHASER.


LIFTING SHACKLE DETAILS

NOTE: DUNNAGE SHALL BE PLACED UNDER BEAMS AT LOCATION OF LIFT LOOPS FOR STORAGE & SHIPPING.


4-7-14 REVISED AS NOTED

APPROVAL STAMP:	<b>J.P. CARRARA &amp; SONS INC.</b> Precast & Prestress Manufacturer N.T.S. 244 OASE STR. MIDDLEBURY, VERMONT 05753 Phone:(802)388-6361 Fax:(802)388-9010
STATE OF VERMONT AGENCY OF TRANSPORTATION COUNTY OF WINDHAM	DATE: MAR. 04, 2014 SCALE: NOTED
TOWN OF GUILFORD ROUTE NO. T.H.10, CLASS III (LOCAL ROAD) BRIDGE NO.: 65 PROJECT NO.: BRO 1442 (36)	CHKD: JJ/KLT DFTM:AA1/RWS JOB NO: 23420-014
SUPERSTRUCTURE PLANS	DWG. NO: F3


**Eriksson technologies**  
813.989.3317  
TAMPA, FL LRF.D.COM  
© 2014 ERIKSSON TECHNOLOGIES, INC. ALL RIGHTS RESERVED

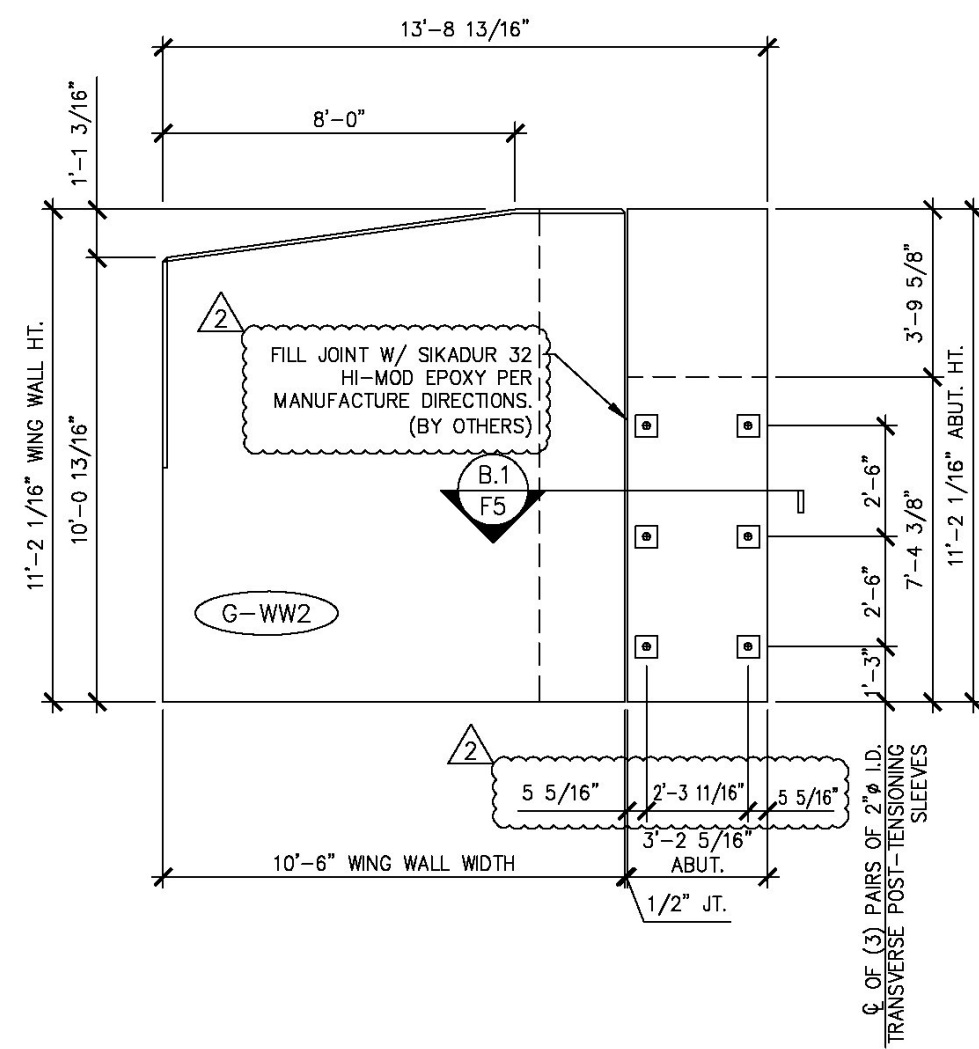


1 WING WALL #2 - SOUTH  
F4 ELEVATION 1/4" = 1'-0"

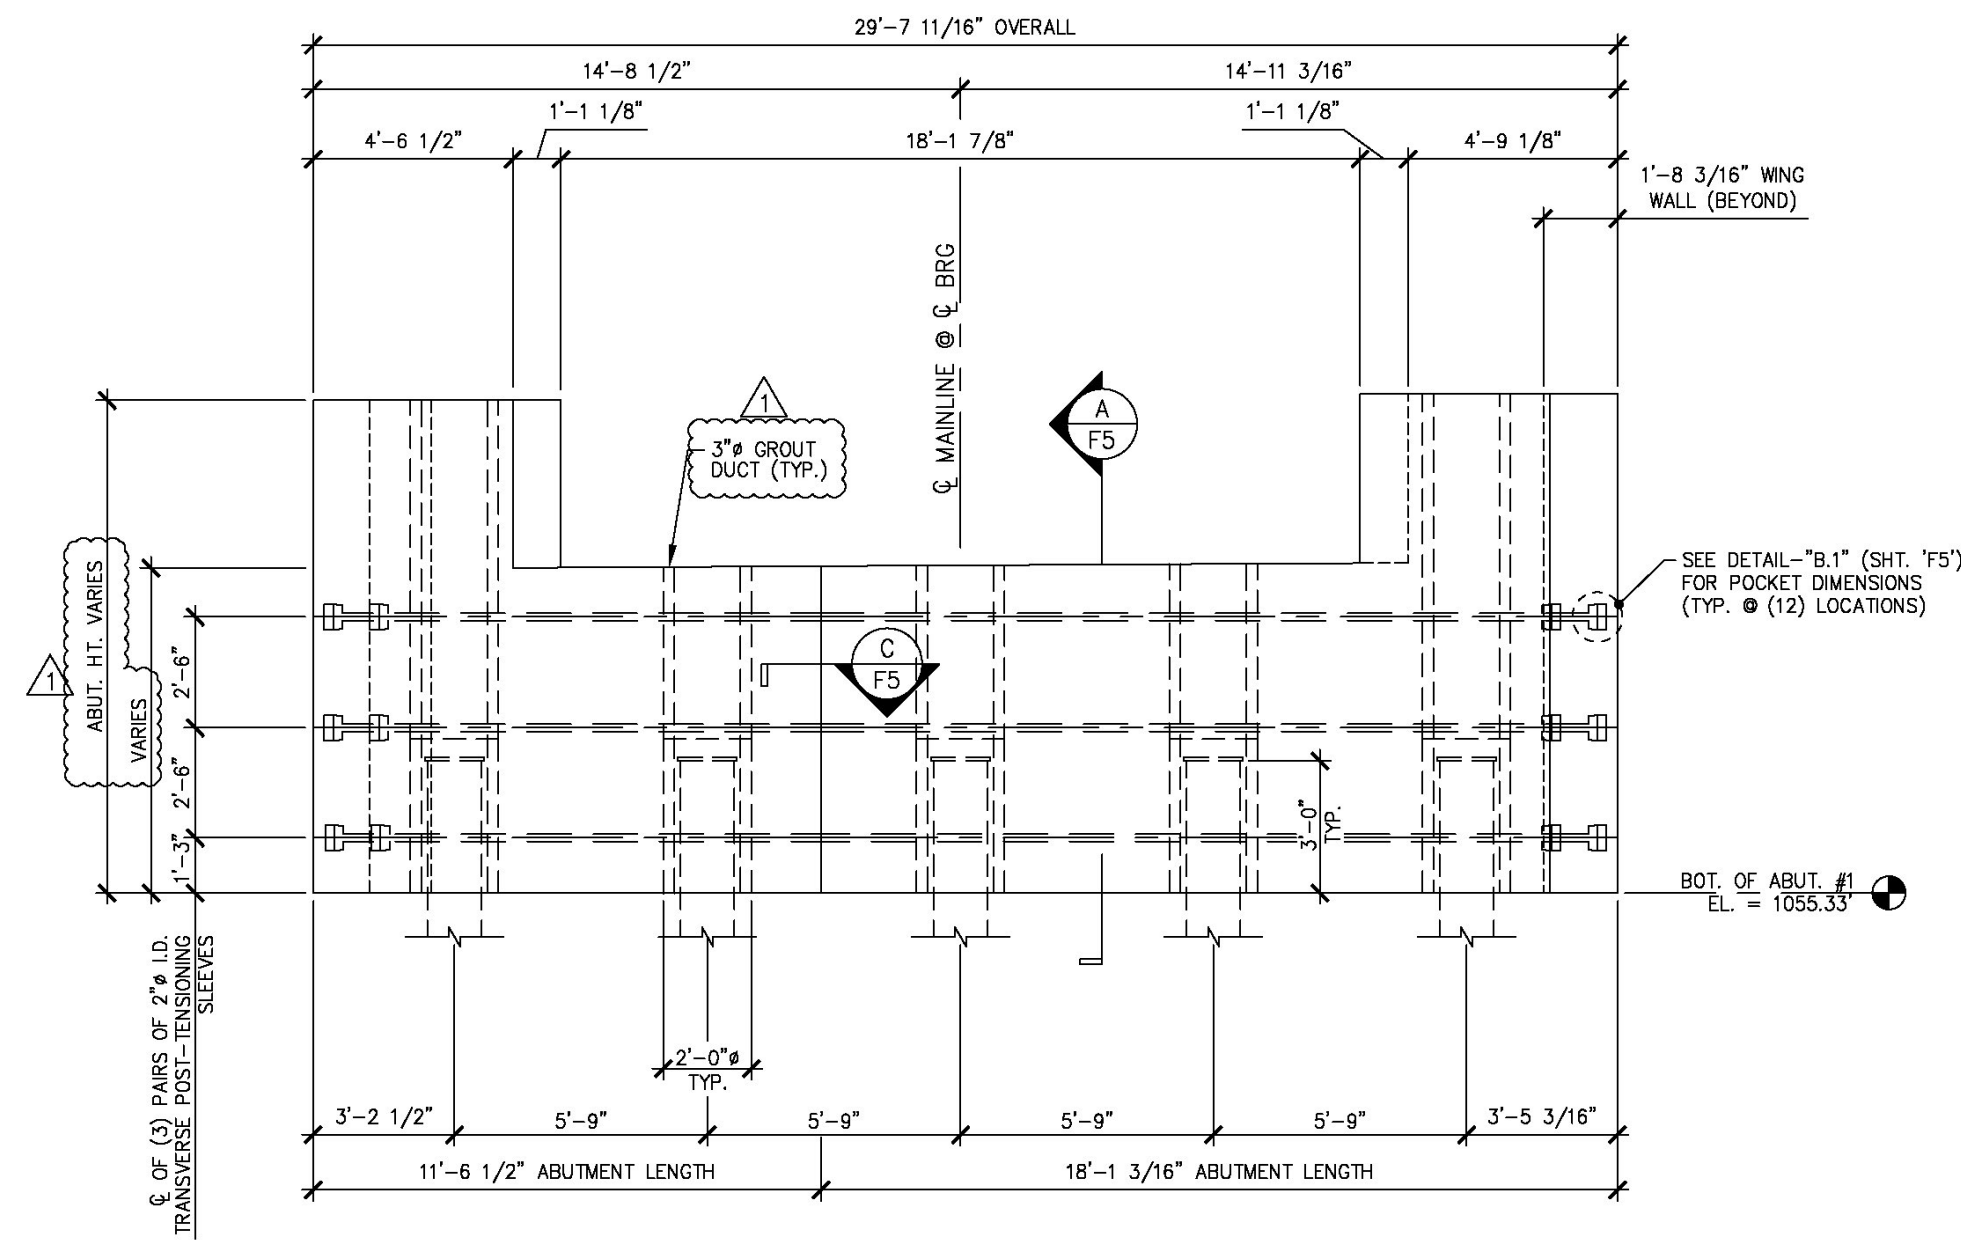


2 ABUTMENT #1 - EAST ELEVATION  
F4 1/4" = 1'-0"

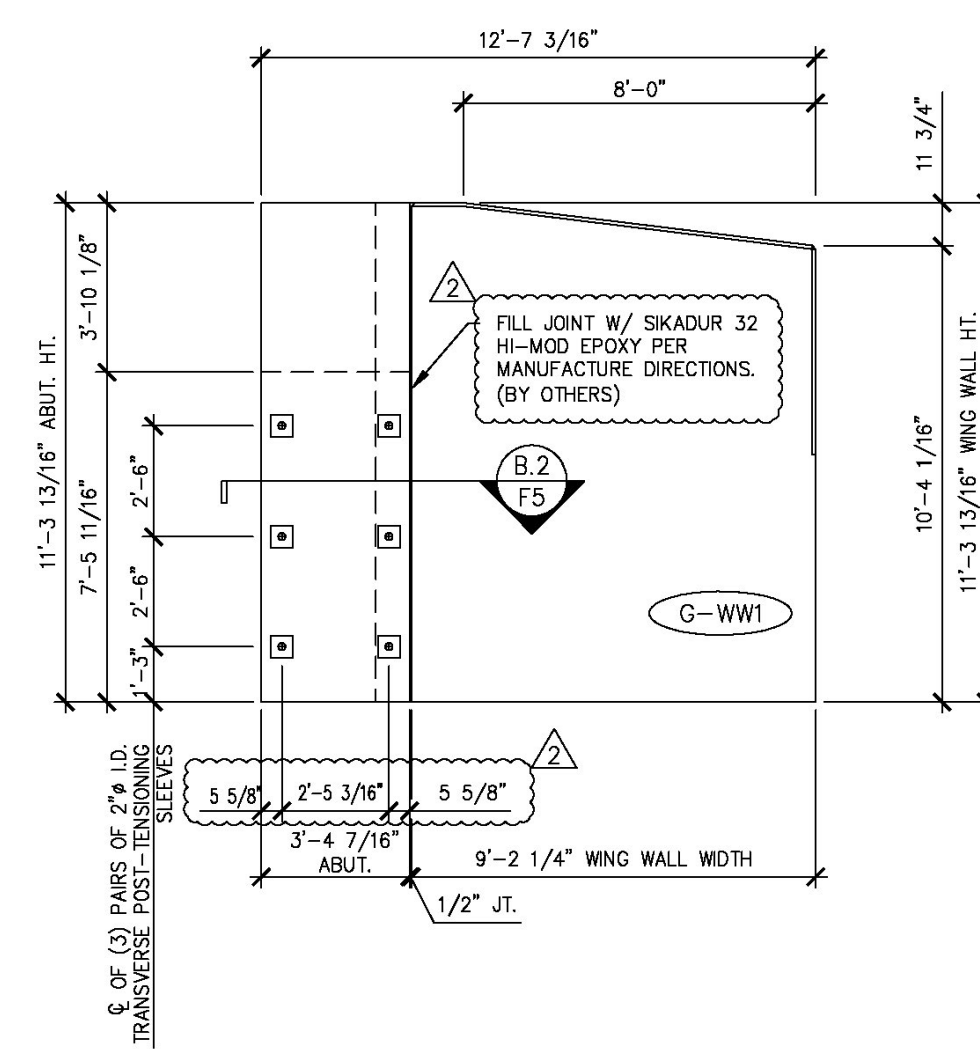


3 WING WALL #1 - NORTH  
F4 ELEVATION 1/4" = 1'-0"

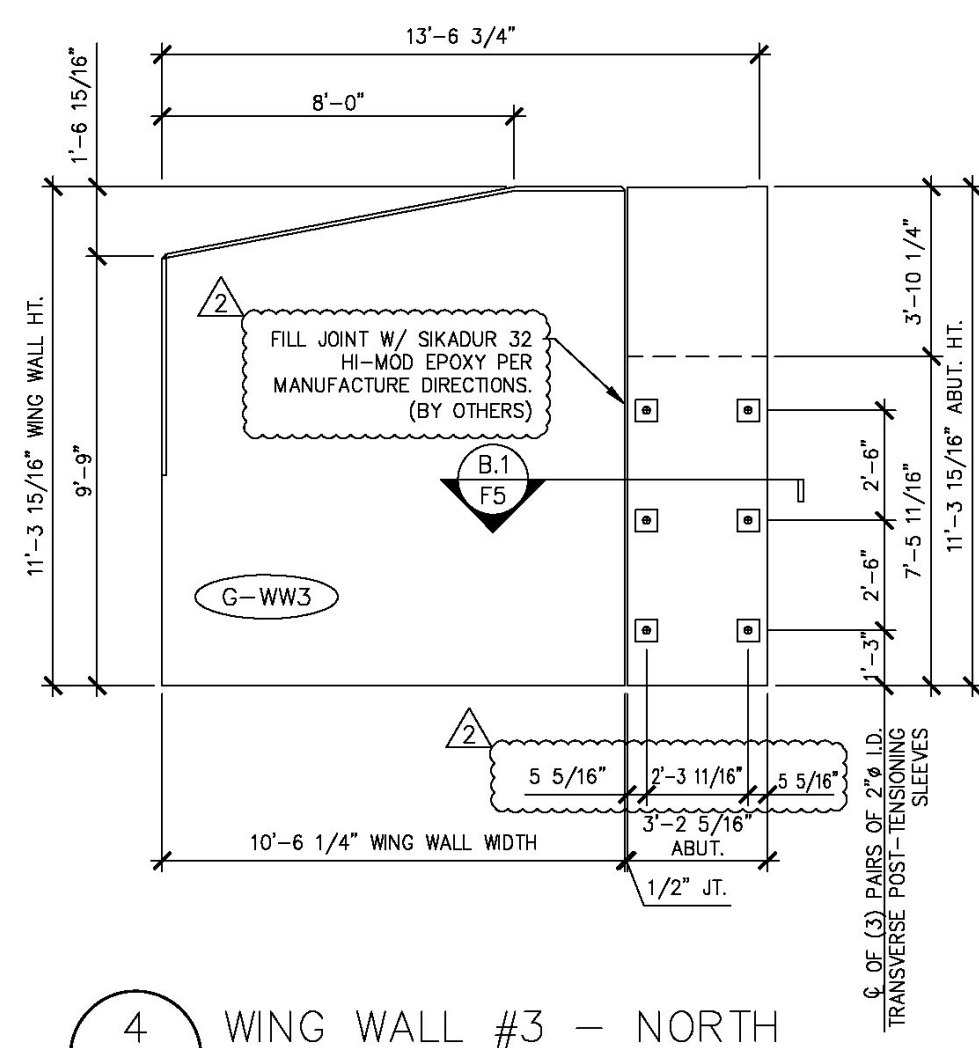

4 WING WALL #3 - NORTH  
F4 ELEVATION 1/4" = 1'-0"

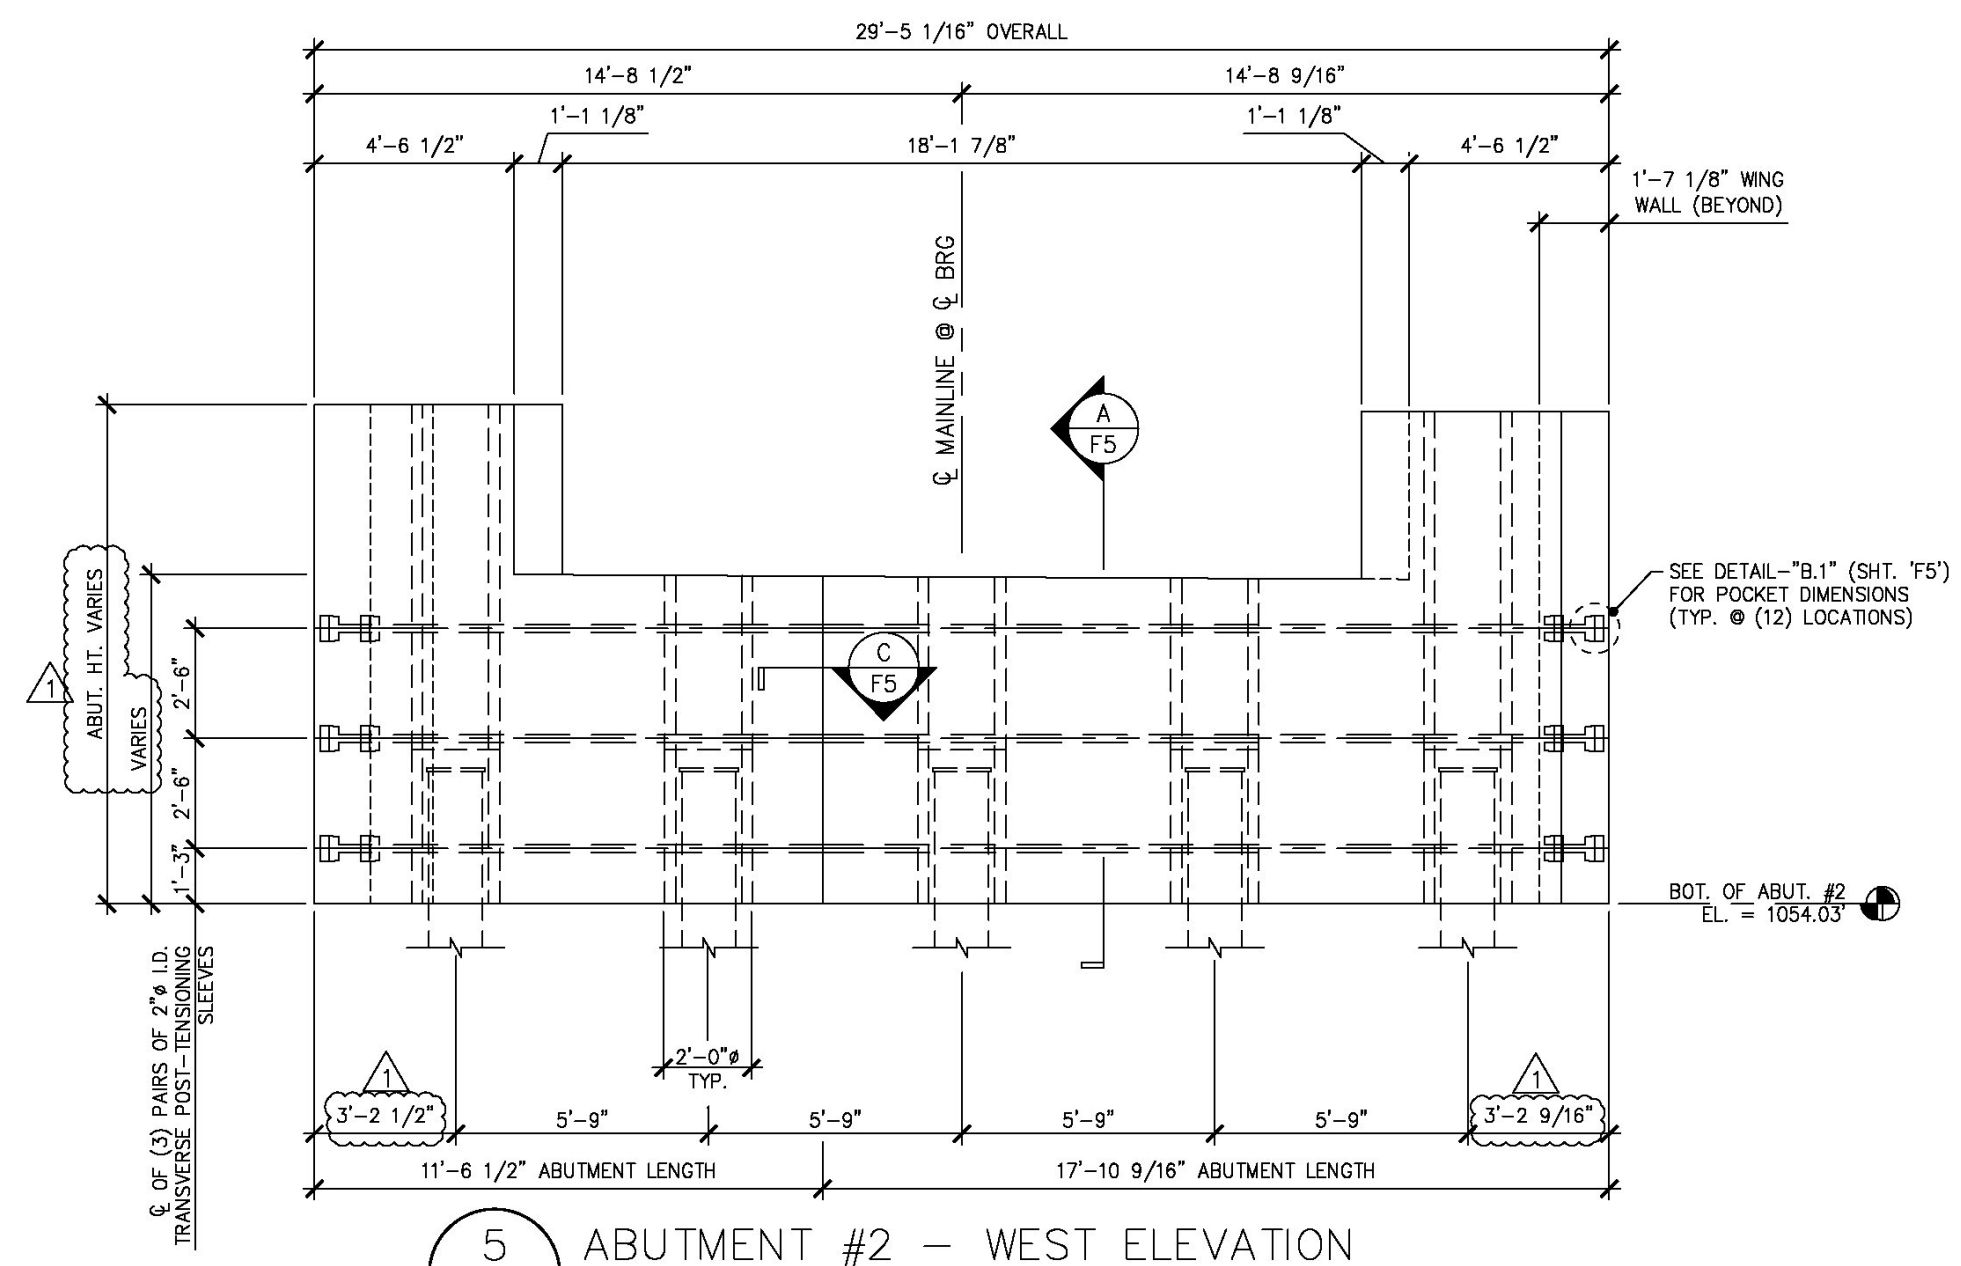

5 ABUTMENT #2 - WEST ELEVATION  
F4 1/4" = 1'-0"

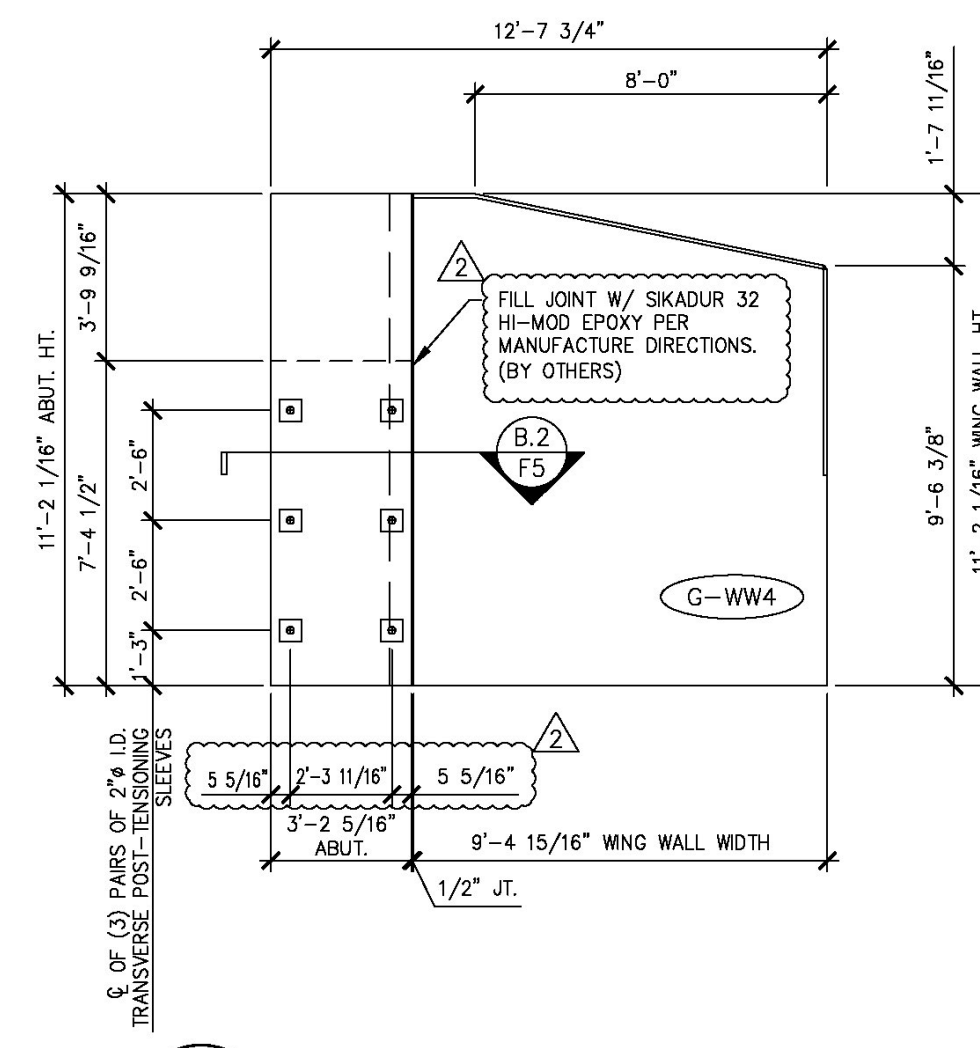

6 WING WALL #4 - SOUTH  
F4 ELEVATION 1/4" = 1'-0"

Vermont Agency of Transportation  
**RECEIVED**

CK'D BY MJC OK'D BY TAS

June 18, 2014

RESUBMIT No Approved  
BY M. J. Chenette DATE 06/19/2014

**SHOP DRAWING REVIEW**

- REVIEWED AS REQUIRED BY THE CONSTRUCTION CONTRACT DOCUMENTS AND APPROVED, BUT ONLY FOR CONFORMANCE TO THE DESIGN CONCEPT OF THE WORK, AND SUBJECT TO FURTHER LIMITATIONS AND REQUIREMENTS CONTAINED IN THE CONSTRUCTION CONTRACT DOCUMENTS.
- REJECTED  REVISE AND RESUBMIT  FURNISH AS CORRECTED

CORRECTIONS OR COMMENTS MADE ON THE SHOP DRAWINGS DURING THIS REVIEW DO NOT RELIEVE CONTRACTOR FROM COMPLIANCE WITH REQUIREMENTS OF THE DRAWINGS AND SPECIFICATIONS. THIS CHECK IS ONLY FOR REVIEW OF GENERAL CONFORMANCE WITH THE DESIGN CONCEPT OF THE PROJECT AND GENERAL COMPLIANCE WITH THE INFORMATION GIVEN IN THE CONTRACT DOCUMENTS. THE CONTRACTOR IS RESPONSIBLE FOR CONFIRMING AND CORRELATING ALL QUANTITIES AND DIMENSIONS, SELECTING FABRICATION PROCESSES AND TECHNIQUES OF CONSTRUCTION, COORDINATING HIS WORK WITH THAT OF ALL OTHER TRADES, AND PERFORMING HIS WORK IN A SAFE AND SATISFACTORY MANNER.

**Vanasse Hangen Brustlin, Inc.**  
7056 US Route 7  
North Ferrisburgh, VT 05473  
802.425.7788


Job Number: 57427.00  
Reviewed By: S.E. Burbank  
Date: 06/19/2014

- △ 4-7-14 REVISED AS NOTED
- △ 5-6-14 REVISED AS NOTED


APPROVAL STAMP:	<b>J.P. CARRARA &amp; SONS INC.</b> Precast & Prestress Manufacturer N.T.S. 244 OAK ST., MIDDLEBURY, VERMONT 05753 Phone:(802)388-6361 Fax:(802)388-9010
STATE OF VERMONT AGENCY OF TRANSPORTATION COUNTY OF WINDHAM	DATE: MAR. 04, 2014 SCALE: NOTED
TOWN OF GUILFORD ROUTE NO. T.H.10, CLASS III (LOCAL ROAD) BRIDGE NO.: 65 PROJECT NO.: BRO 1442 (36)	CHKD: JJ/KLT DFTM:AA1/RWS JOB NO: 23420-014
ABUTMENT ELEVATIONS	DWG. NO: F4

**Eriksson technologies**  
813.989.3317  
TAMPA, FL LRFD.COM  
© 2014 ERIKSSON TECHNOLOGIES, INC. ALL RIGHTS RESERVED



S:\Engineering Services\Carrara\14001 - Guilford Bridge 65\Production Drawings\AutoCAD Files\144236-F1.dwg, 5/6/2014 4:44:17 PM, DWG To PDF.pc3

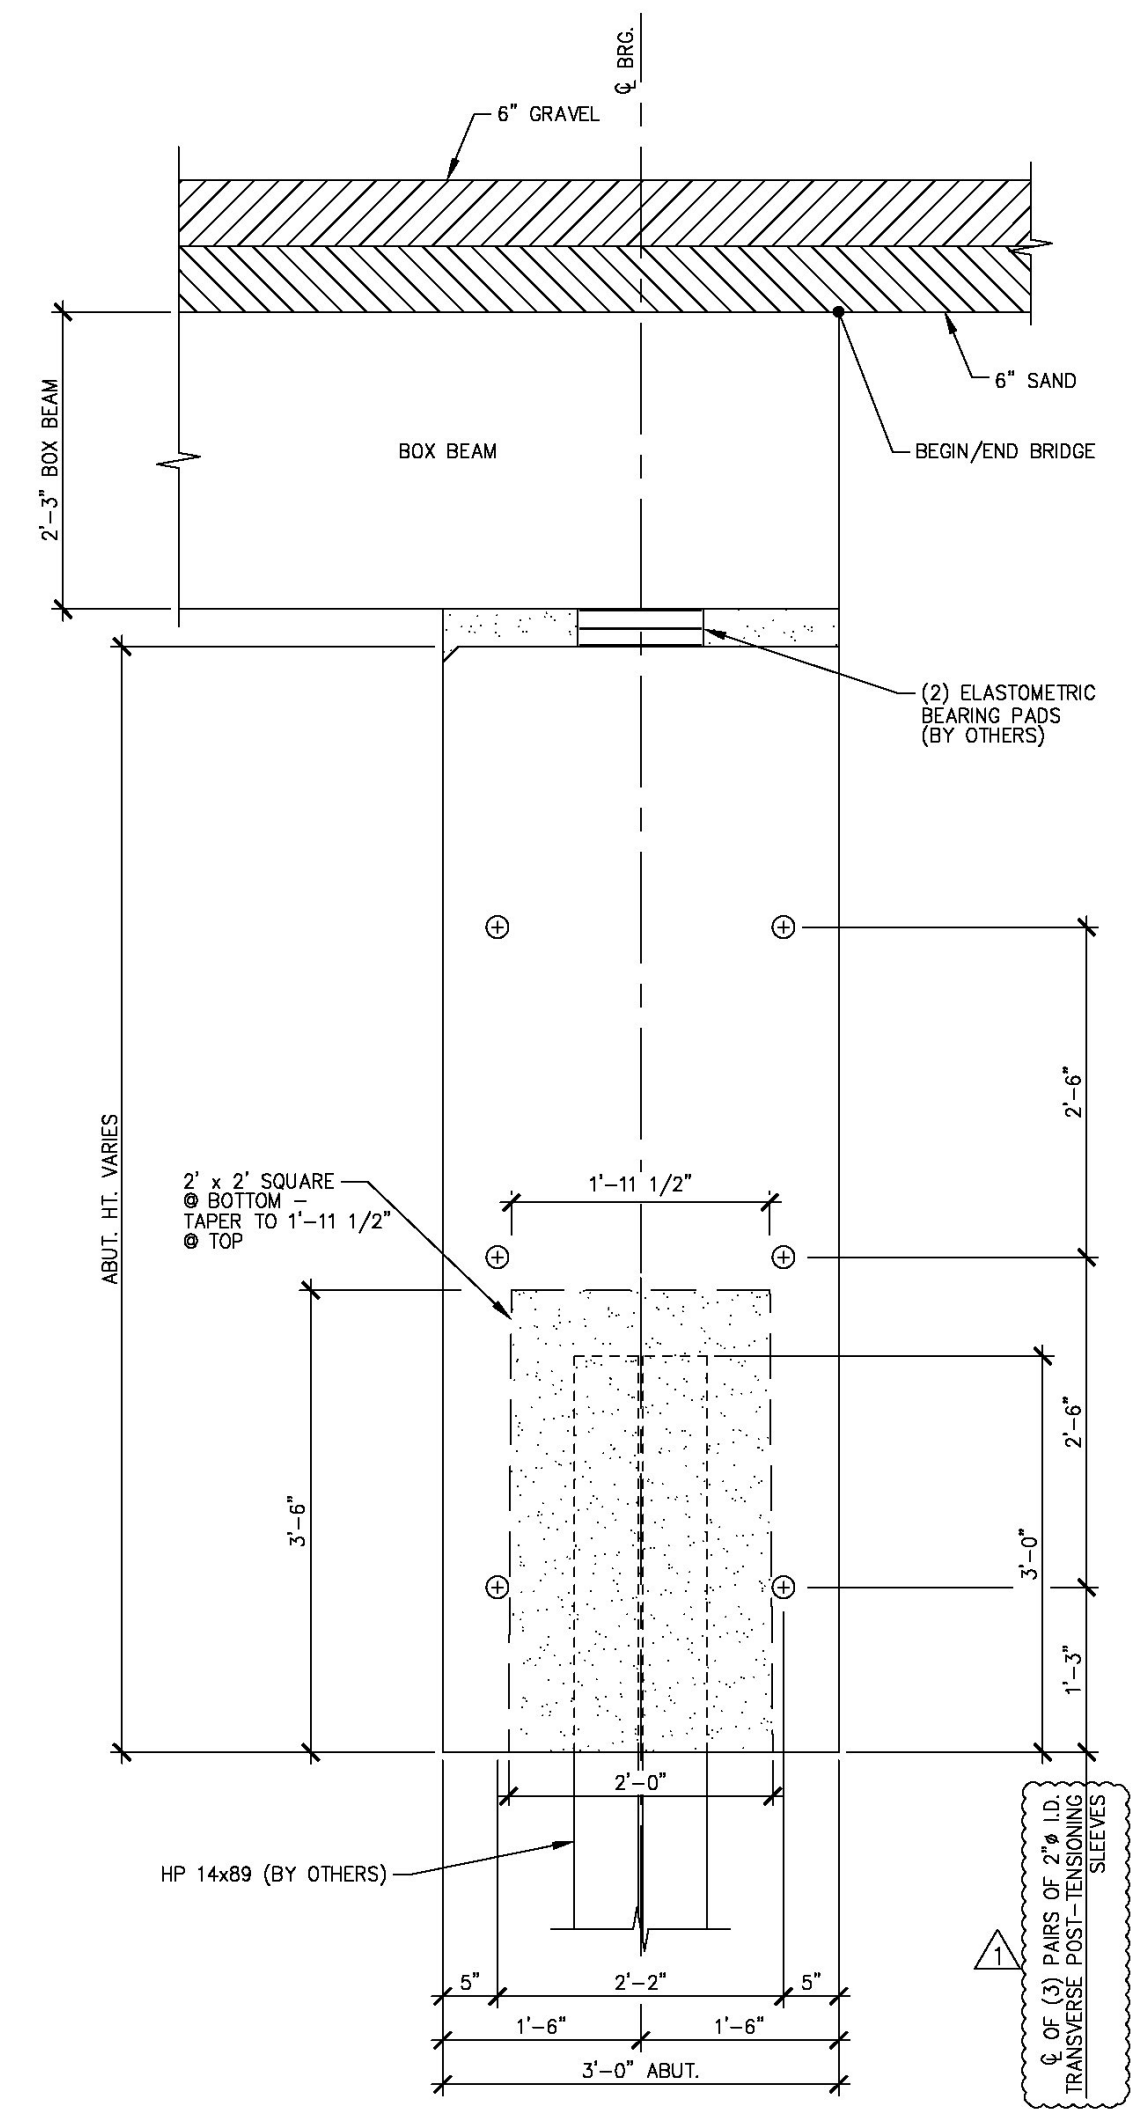

**A BEARING SECTION**  
F5 NEXT BEAM STEM BEARING 3/4" = 1'-0"

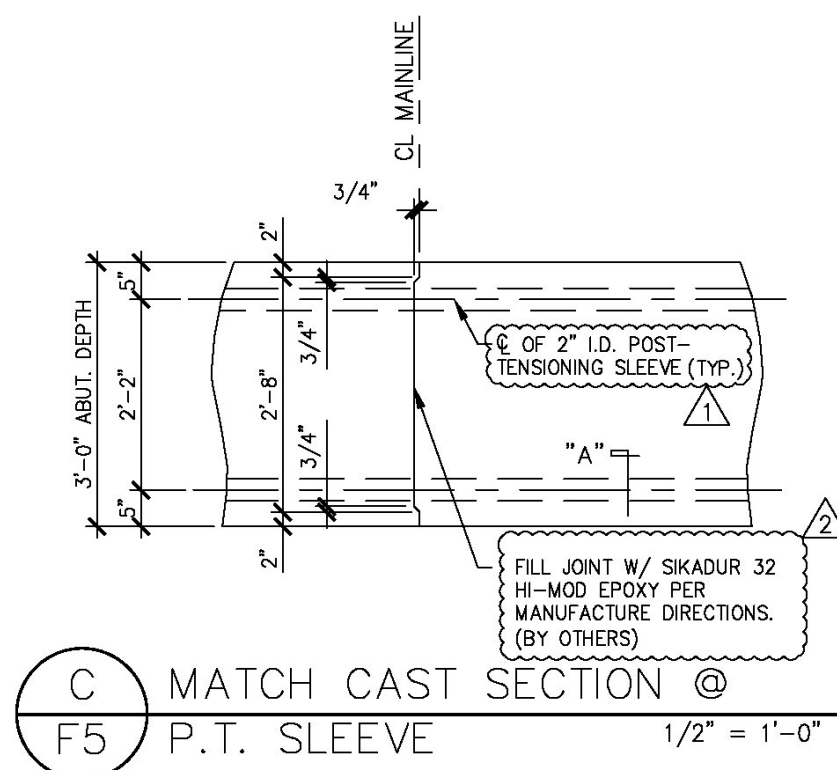

**C MATCH CAST SECTION**  
F5 P.T. SLEEVE 1/2" = 1'-0"

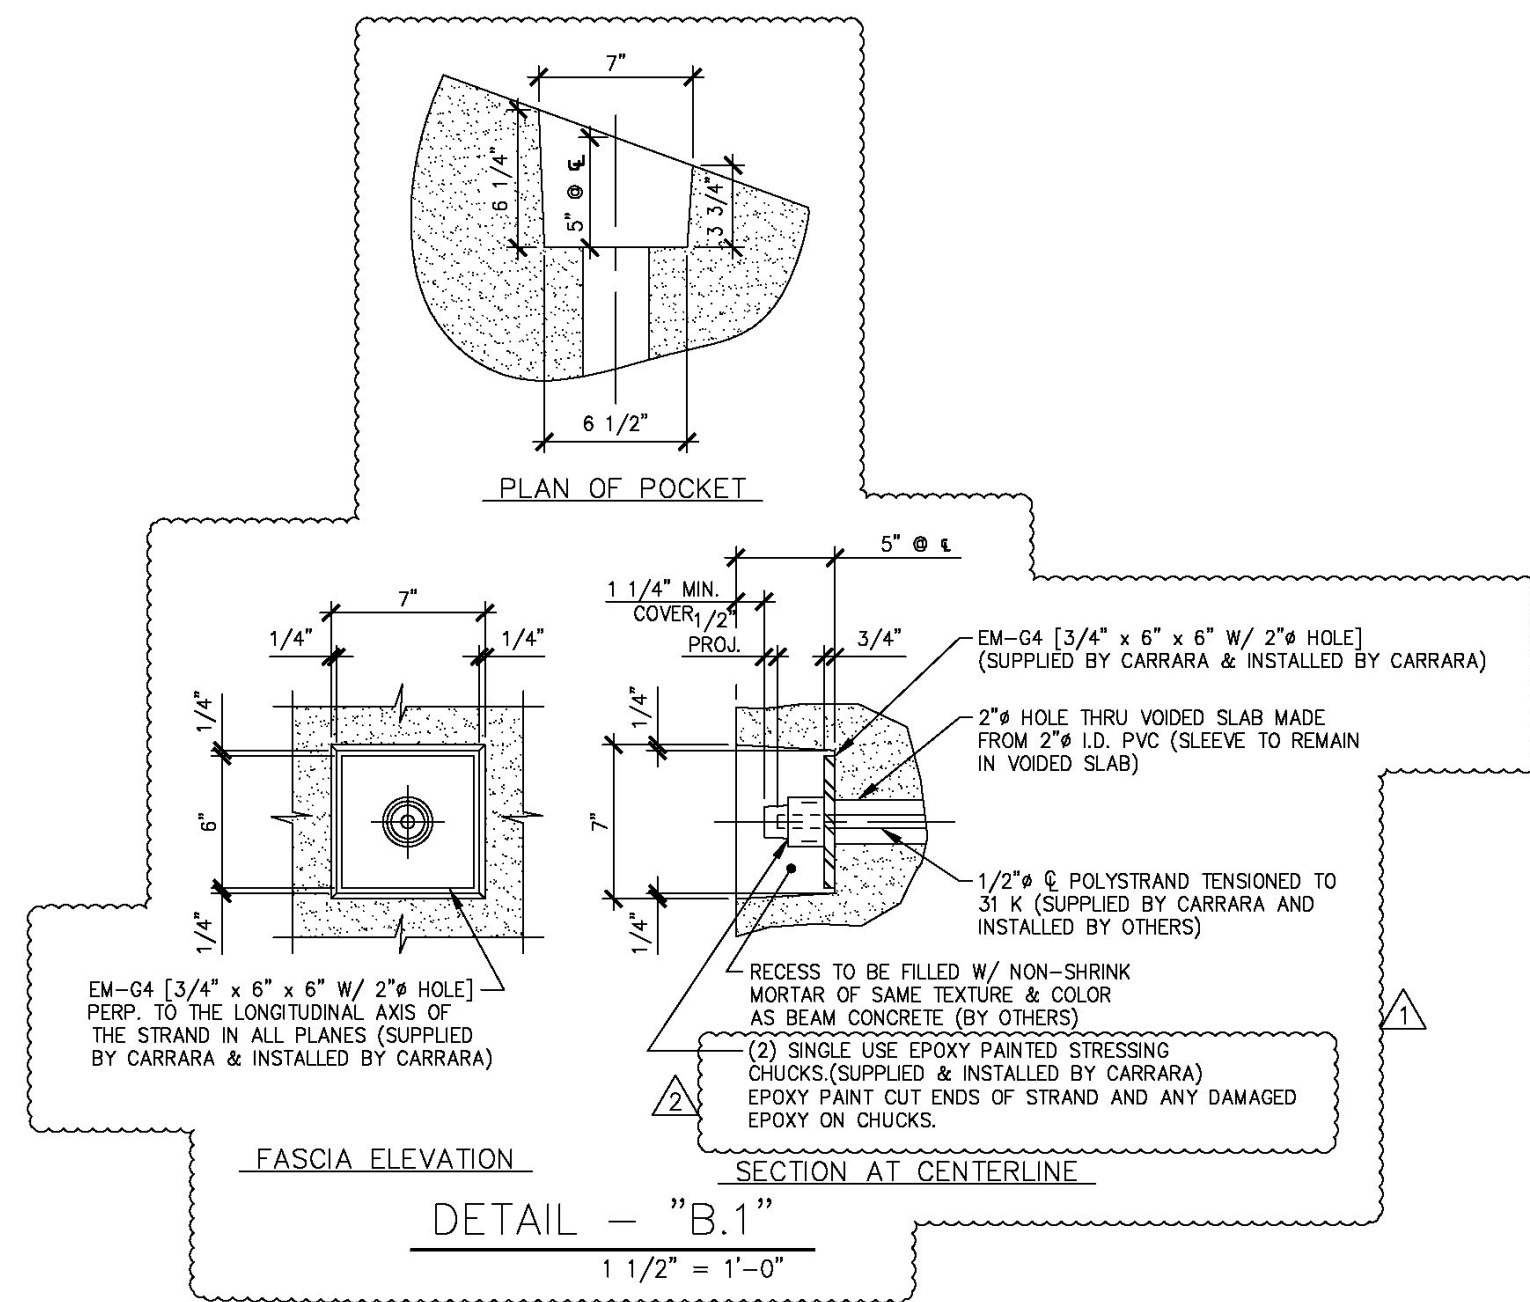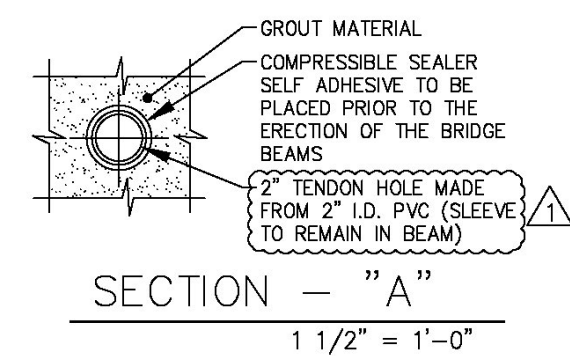

Vermont Agency of Transportation  
**RECEIVED**  
CK'D BY MJC OK'D BY TAS  
June 18, 2014  
RESUBMIT No Approved  
BY M. J. Chenette DATE 06/19/2014

**SHOP DRAWING REVIEW**


REVIEWED AS REQUIRED BY THE CONSTRUCTION CONTRACT DOCUMENTS AND APPROVED, BUT ONLY FOR CONFORMANCE TO THE DESIGN CONCEPT OF THE WORK, AND SUBJECT TO FURTHER LIMITATIONS AND REQUIREMENTS CONTAINED IN THE CONSTRUCTION CONTRACT DOCUMENTS.

REJECTED  REVISE AND RESUBMIT  FURNISH AS CORRECTED


CORRECTIONS OR COMMENTS MADE ON THE SHOP DRAWINGS DURING THIS REVIEW DO NOT RELIEVE CONTRACTOR FROM COMPLIANCE WITH REQUIREMENTS OF THE DRAWINGS AND SPECIFICATIONS. THIS CHECK IS ONLY FOR REVIEW OF GENERAL CONFORMANCE WITH THE DESIGN CONCEPT OF THE PROJECT AND GENERAL COMPLIANCE WITH THE INFORMATION GIVEN IN THE CONTRACT DOCUMENTS. THE CONTRACTOR IS RESPONSIBLE FOR CONFIRMING AND CORRELATING ALL QUANTITIES AND DIMENSIONS, SELECTING FABRICATION PROCESSES AND TECHNIQUES OF CONSTRUCTION, COORDINATING HIS WORK WITH THAT OF ALL OTHER TRADES, AND PERFORMING HIS WORK IN A SAFE AND SATISFACTORY MANNER.

**Vanasse Hangen Brustlin, Inc.**  
7056 US Route 7  
North Ferrisburgh, VT 05473  
802-425-7788

Job Number: 57427.00  
Reviewed By: S.E. Burbank  
Date: 06/19/2014

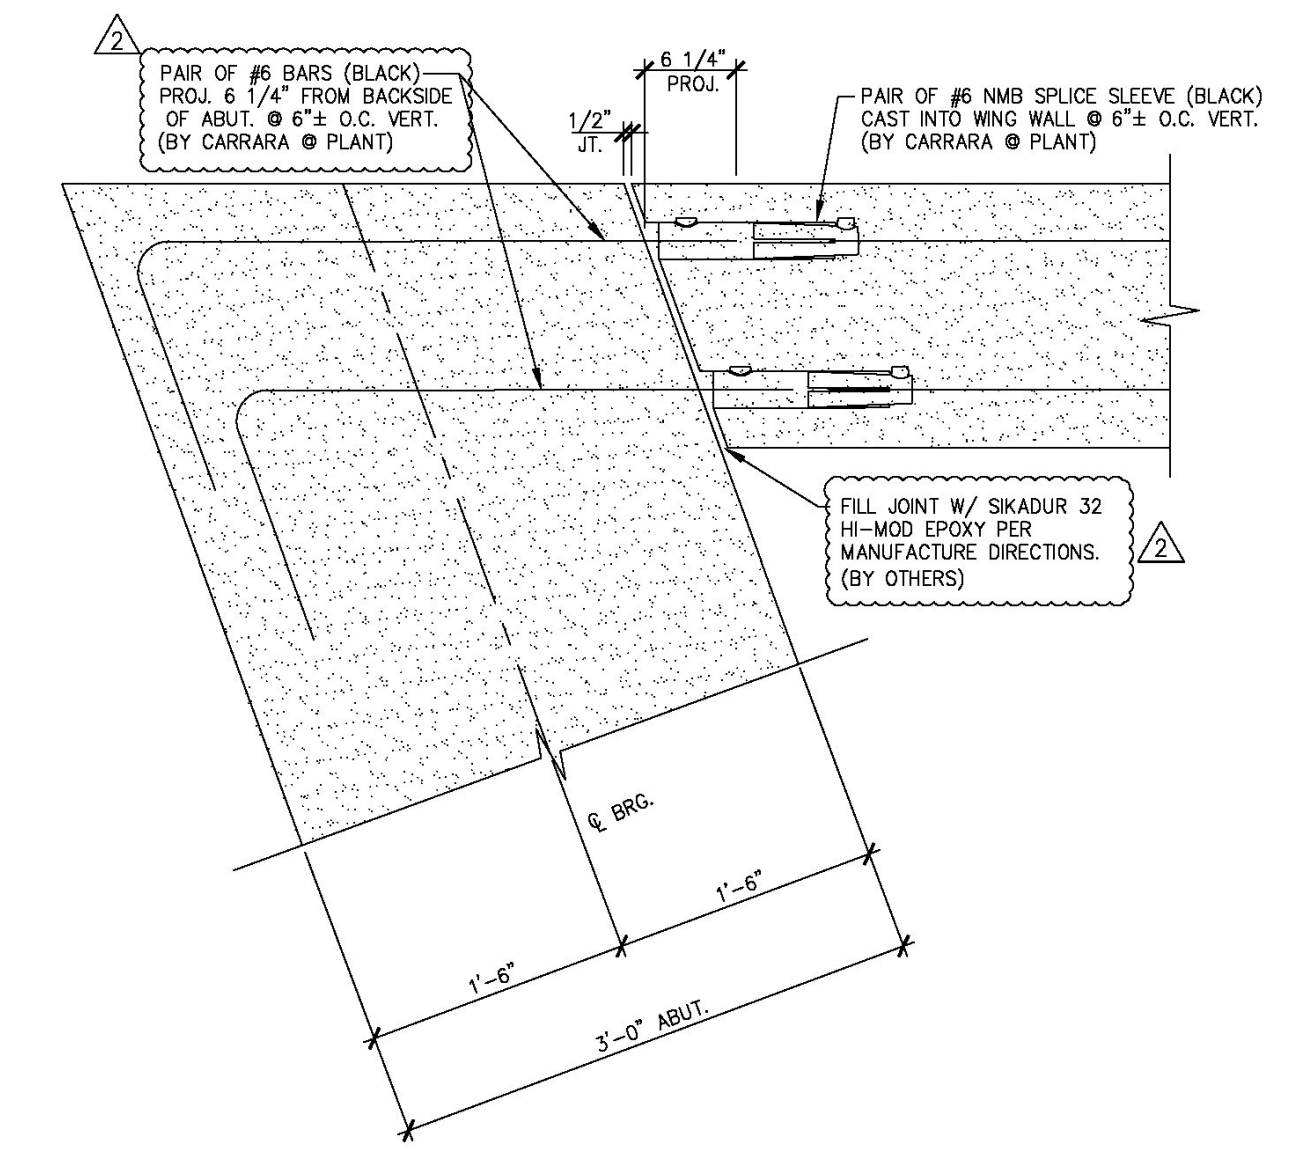

**B.1 WING WALL CONNECTION DETAIL**  
F5 1" = 1'-0"

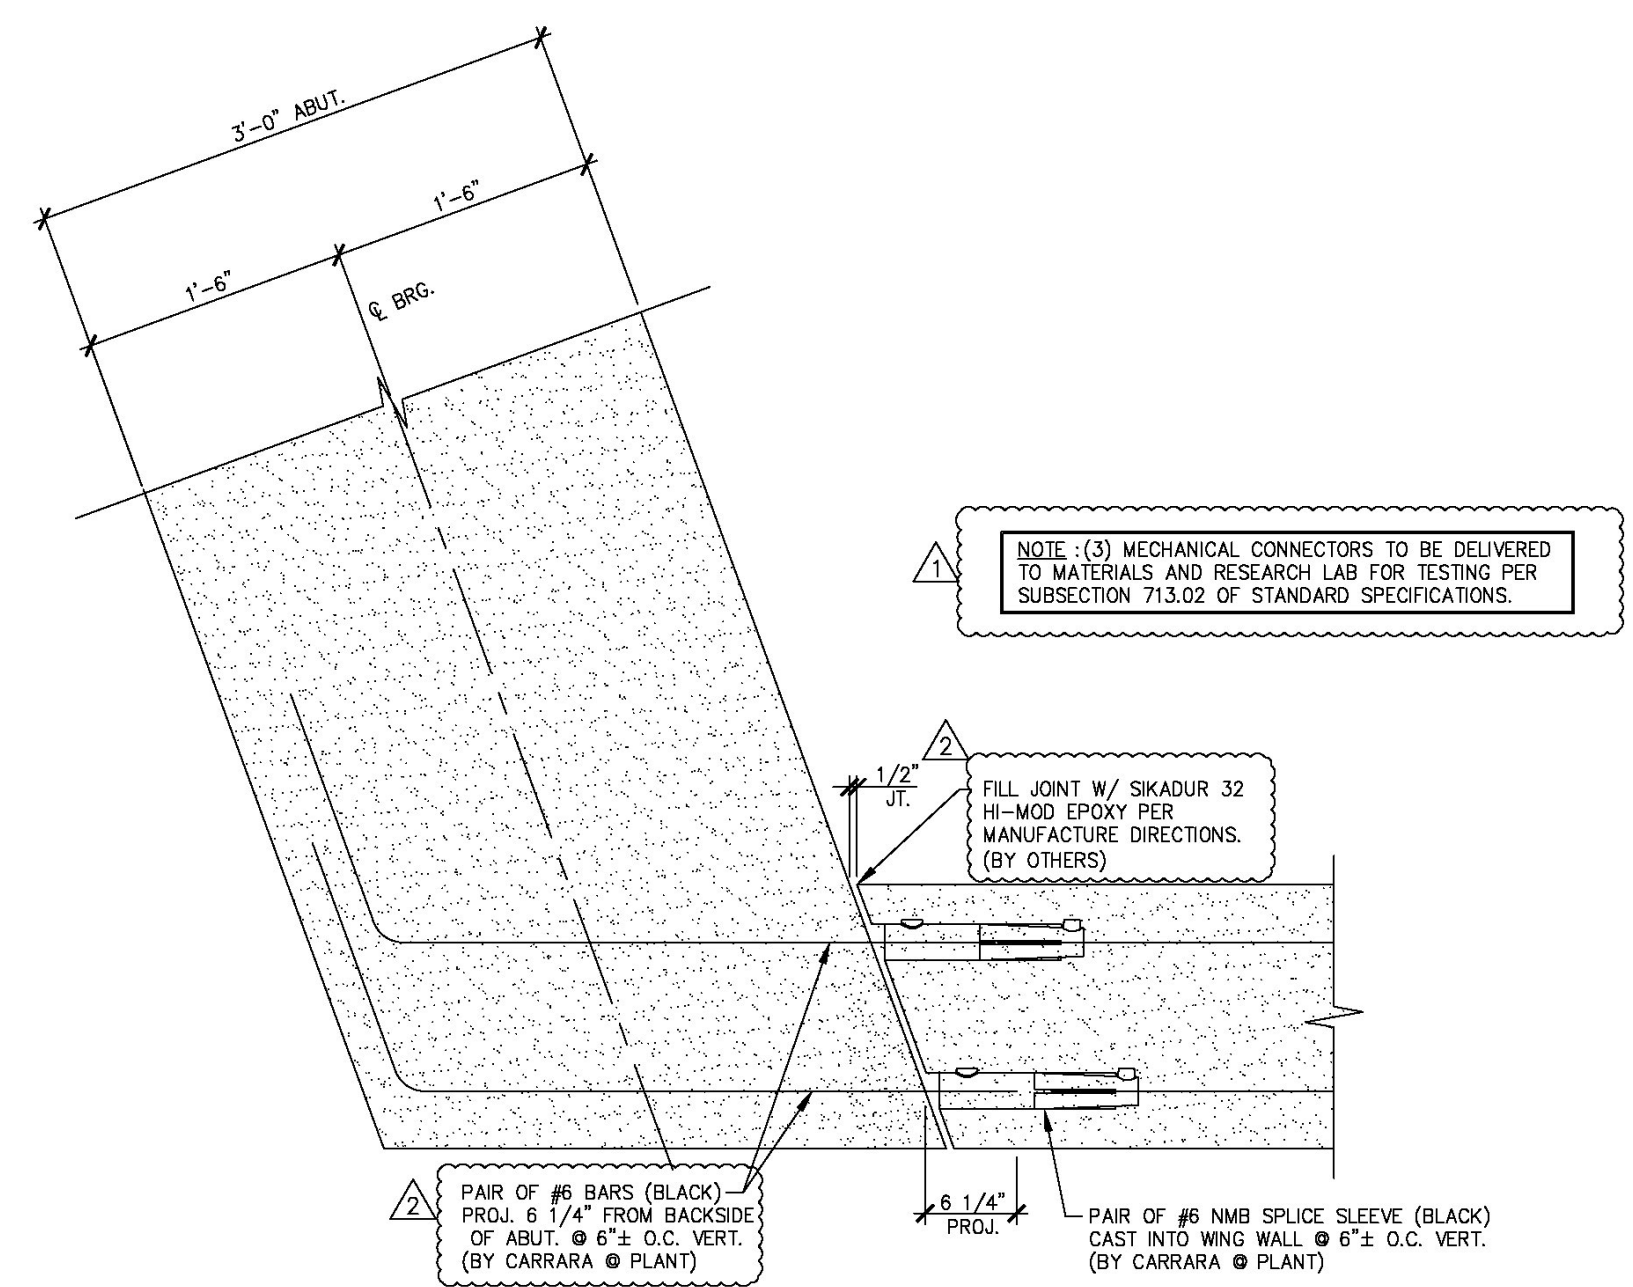


**B.2 WING WALL CONNECTION DETAIL**  
F5 1" = 1'-0"

4-7-14 REVISED AS NOTED  
5-6-14 REVISED AS NOTED





APPROVAL STAMP:		<b>J.P. CARRARA &amp; SONS INC.</b> Precast & Prestress Manufacturer N.T.S. 244 OASE STR. MIDDLEBURY, VERMONT 05753 Phone:(802)388-6361 Fax:(802)388-9010	
STATE OF VERMONT AGENCY OF TRANSPORTATION COUNTY OF WINDHAM		DATE: MAR. 04, 2014	SCALE: NOTED
TOWN OF GUILFORD ROUTE NO. T.H.10, CLASS III (LOCAL ROAD) BRIDGE NO.: 65 PROJECT NO.: BRO 1442 (36)		CHKD: JJ/KLT DFTM:AA1/RWS	JOB NO: 23420-014
ABUTMENT DETAILS		DWG. NO:	F5

**Eriksson technologies**  
813.989.3317  
TAMPA, FL LRFD.COM  
© 2014 ERIKSSON TECHNOLOGIES, INC. ALL RIGHTS RESERVED

S:\Engineering Services\Carrara\14001 - Guilford Bridge 65\Production Drawings\AutoCAD Files\144236-B1.dwg, 5/16/2014 4:44:20 PM, DWG To PDF.pc3

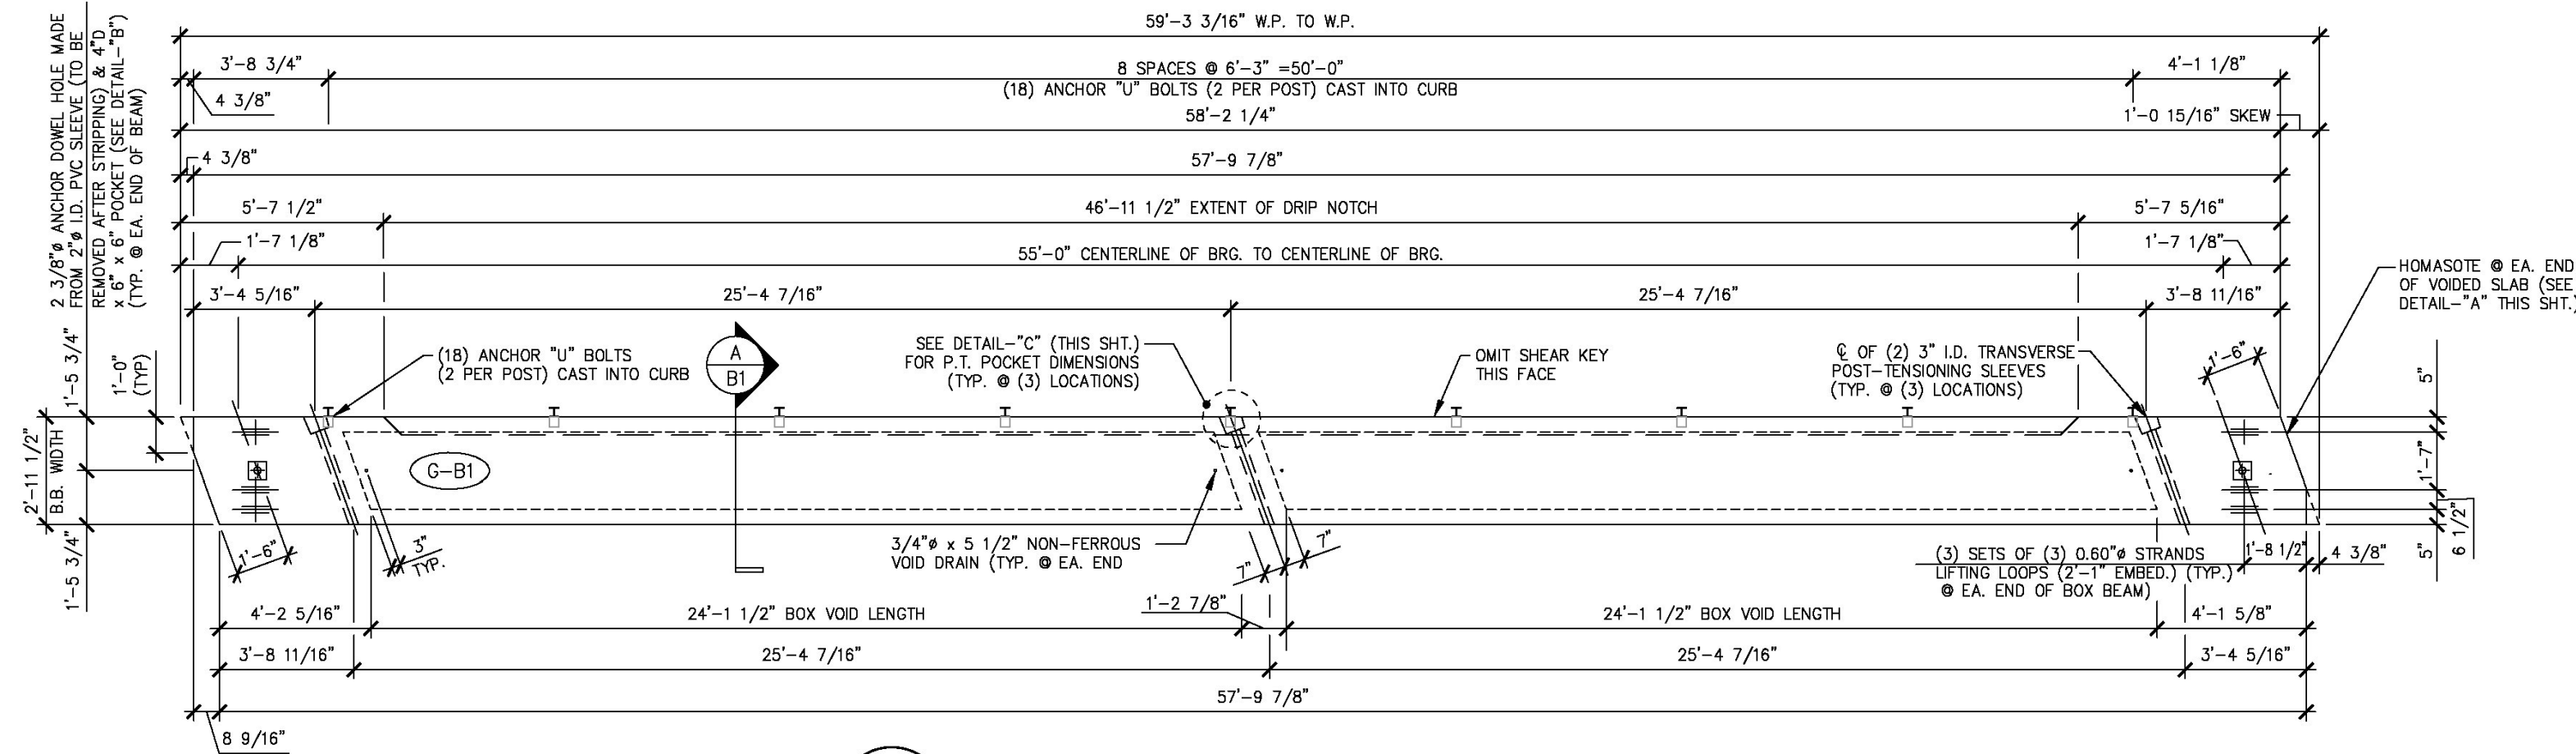

1 DIMENSIONAL PLAN VIEW IN FORM  
B1 1/4" = 1'-0"

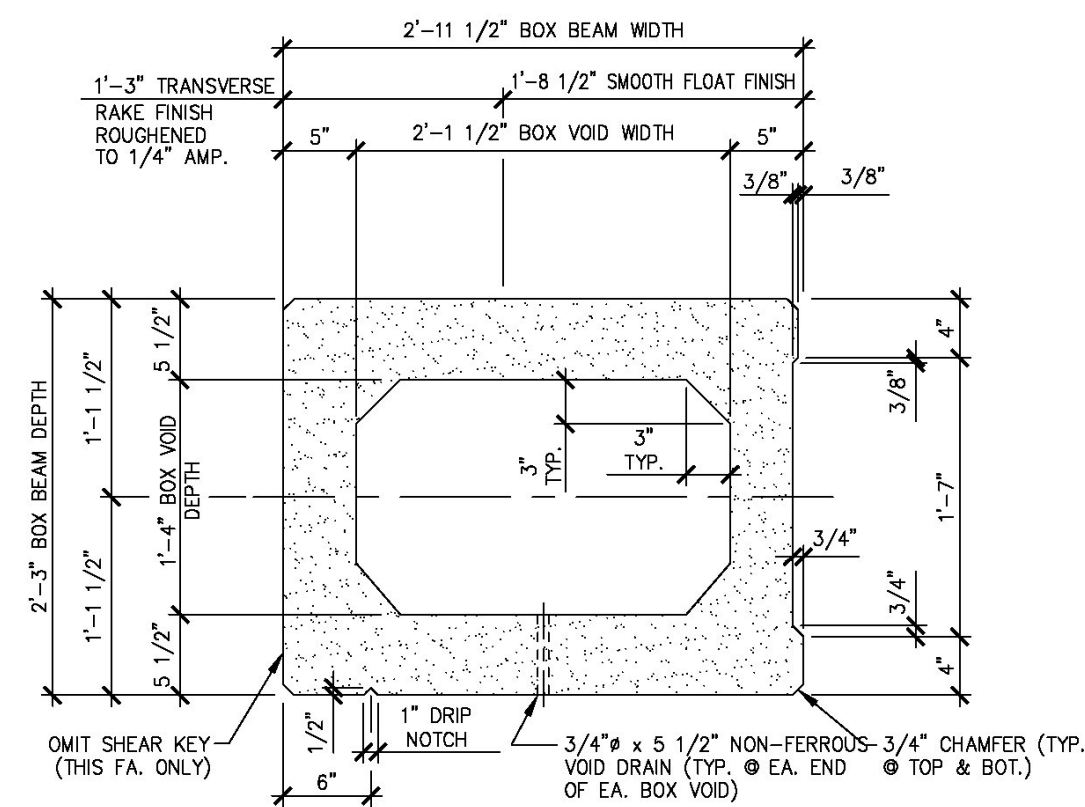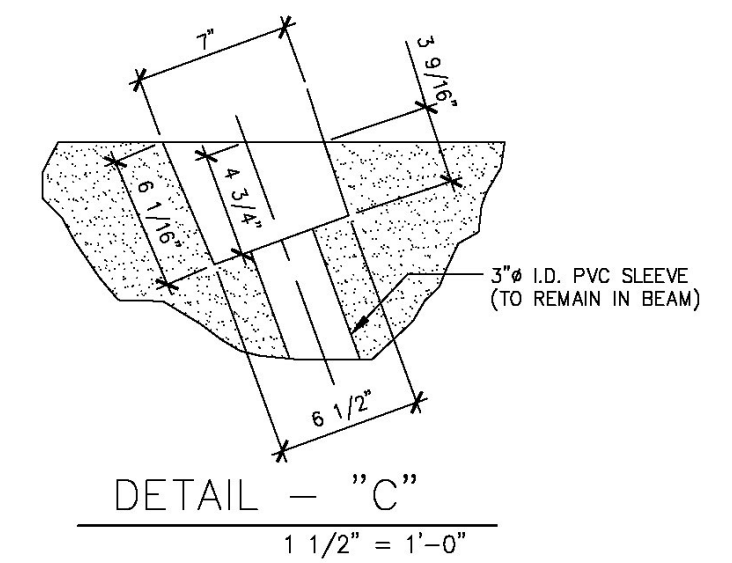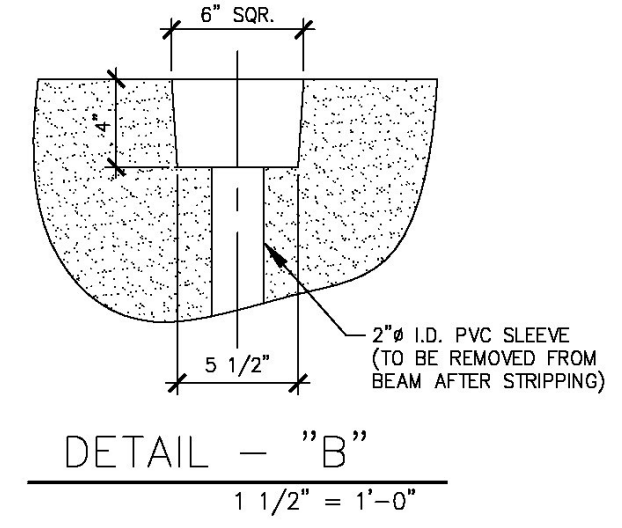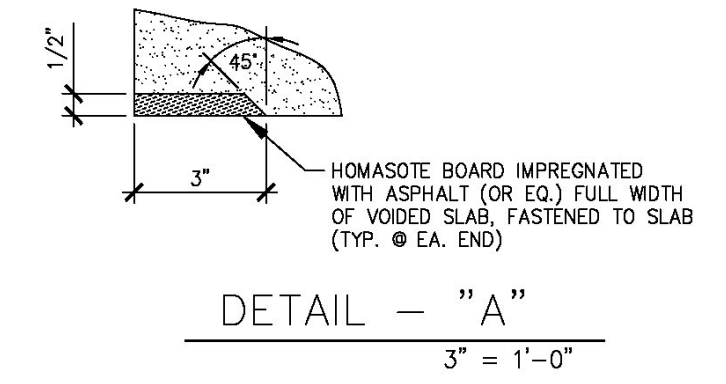

A DIMENSIONAL SECTION  
B1 1" = 1'-0"

Vermont Agency of Transportation  
**RECEIVED**

CK'D BY MJC OK'D BY TAS

June 18, 2014

RESUBMIT No Approved  
BY M. J. Chenette DATE 06/19/2014

SHOP NOTE:  
SEE SHEET "B1A" FOR  
REINFORCING DETAILS.

MARK:	G-B1	QTY.:	1	WT.:	26.71 T	VOL.:	13.19 cy
MATERIAL LIST / BEAM							
ITEM	MARK	DESCRIPTION	QTY./BEAM				
			G-B1				
1							
2							
3							
4							
5							
6							
7		3/4" x 5 1/2" NON-FERROUS VOID DRAIN		4			
8		2'-2" x 1'-4 1/2" x 24'-1 1/2" BOX VOID		2			
9		SET OF (3) 0.60" STRAND LIFTING LOOPS		6			
10							

**SHOP DRAWING REVIEW**

REVIEWED AS REQUIRED BY THE CONSTRUCTION CONTRACT DOCUMENTS AND APPROVED, BUT ONLY FOR CONFORMANCE TO THE DESIGN CONCEPT OF THE WORK, AND SUBJECT TO FURTHER LIMITATIONS AND REQUIREMENTS CONTAINED IN THE CONSTRUCTION CONTRACT DOCUMENTS.

REJECTED  REVISE AND RESUBMIT  FURNISH AS CORRECTED

CORRECTIONS OR COMMENTS MADE ON THE SHOP DRAWINGS DURING THIS REVIEW DO NOT RELIEVE CONTRACTOR FROM COMPLIANCE WITH REQUIREMENTS OF THE DRAWINGS AND SPECIFICATIONS. THIS CHECK IS ONLY FOR REVIEW OF GENERAL CONFORMANCE WITH THE DESIGN CONCEPT OF THE PROJECT AND GENERAL COMPLIANCE WITH THE INFORMATION GIVEN IN THE CONTRACT DOCUMENTS. THE CONTRACTOR IS RESPONSIBLE FOR: CONFIRMING AND CORRELATING ALL QUANTITIES AND DIMENSIONS; SELECTING FABRICATION PROCESSES AND TECHNIQUES OF CONSTRUCTION; COORDINATING HIS WORK WITH THAT OF ALL OTHER TRADES; AND PERFORMING HIS WORK IN A SAFE AND SATISFACTORY MANNER.

**Vanasse Hangen Brustlin, Inc.**  
7056 US Route 7  
North Ferrisburgh, VT 05473  
802-425-7788

Job Number: 57427.00  
Reviewed By: S.E. Burbenk  
Date: 06/19/2014


APPROVAL STAMP:

**J.P. CARRARA & SONS INC.**  
Precast & Prestress Manufacturer N.T.S.  
244 OAK ST. WINDHAM, VERMONT 05751 Phone: (802)388-6361 Fax: (802)388-9010


STATE OF VERMONT AGENCY OF TRANSPORTATION COUNTY OF WINDHAM	DATE: MAR. 04, 2014 SCALE: NOTED
TOWN OF GUILFORD ROUTE NO. T.H.10, CLASS III (LOCAL ROAD) BRIDGE NO.: 65 PROJECT NO.: BRO 1442 (36)	CHKD: JJ/KLT DFTM: AAT/RWS JOB NO: 23420-014
PRESTRESSED BOX BEAM DIMENSIONAL DETAILS	DWG. NO: B1

**Eriksson technologies**  
813.989.3317  
TAMPA, FL LRFD.COM  
© 2014 ERIKSSON TECHNOLOGIES, INC. ALL RIGHTS RESERVED


S:\Engineering Services\Carrara\14001 - Guilford Bridge 651\Production Drawings\AutoCAD Files\144236-B1a(NEW).dwg, 5/6/2014 4:44:22 PM, DWG To PDF.pc3

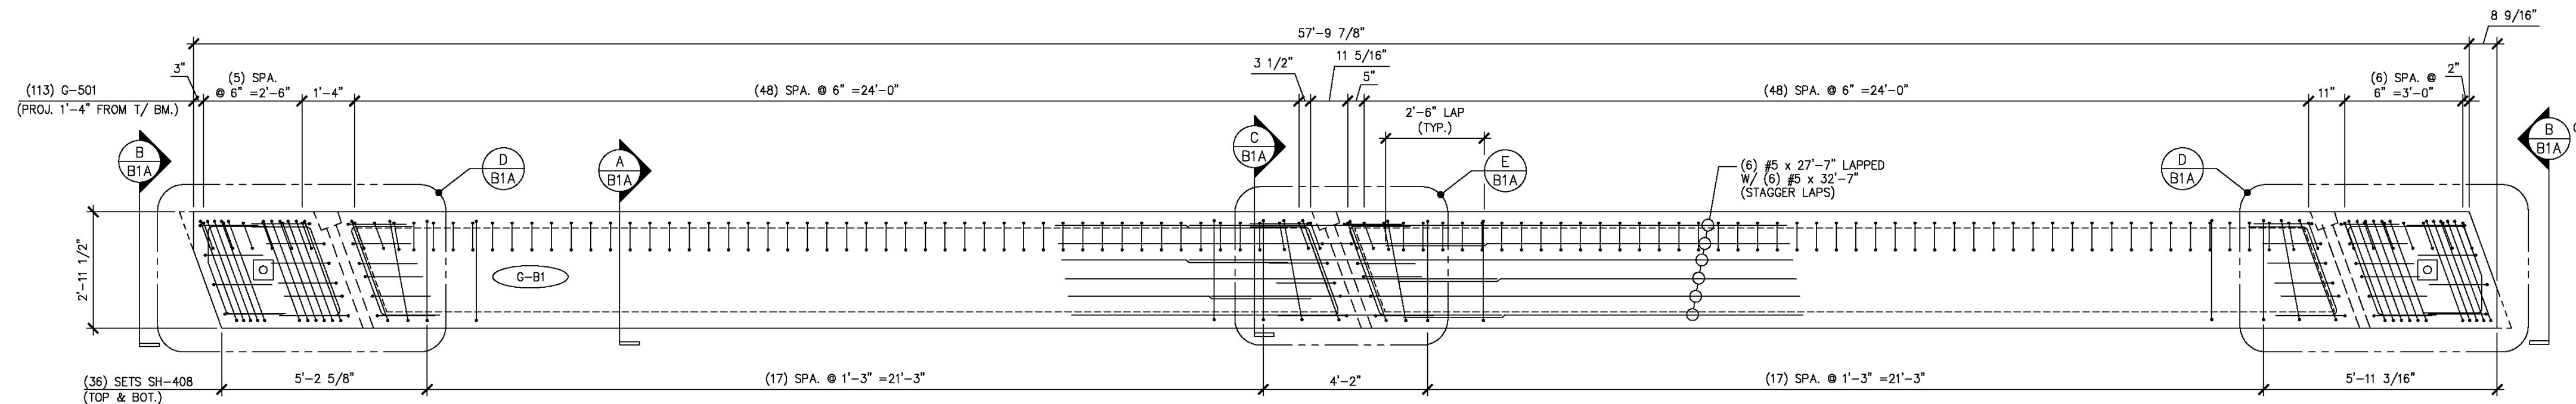


**1** REINFORCING PLAN VIEW IN FORM  
B1A 3/8" = 1'-0"

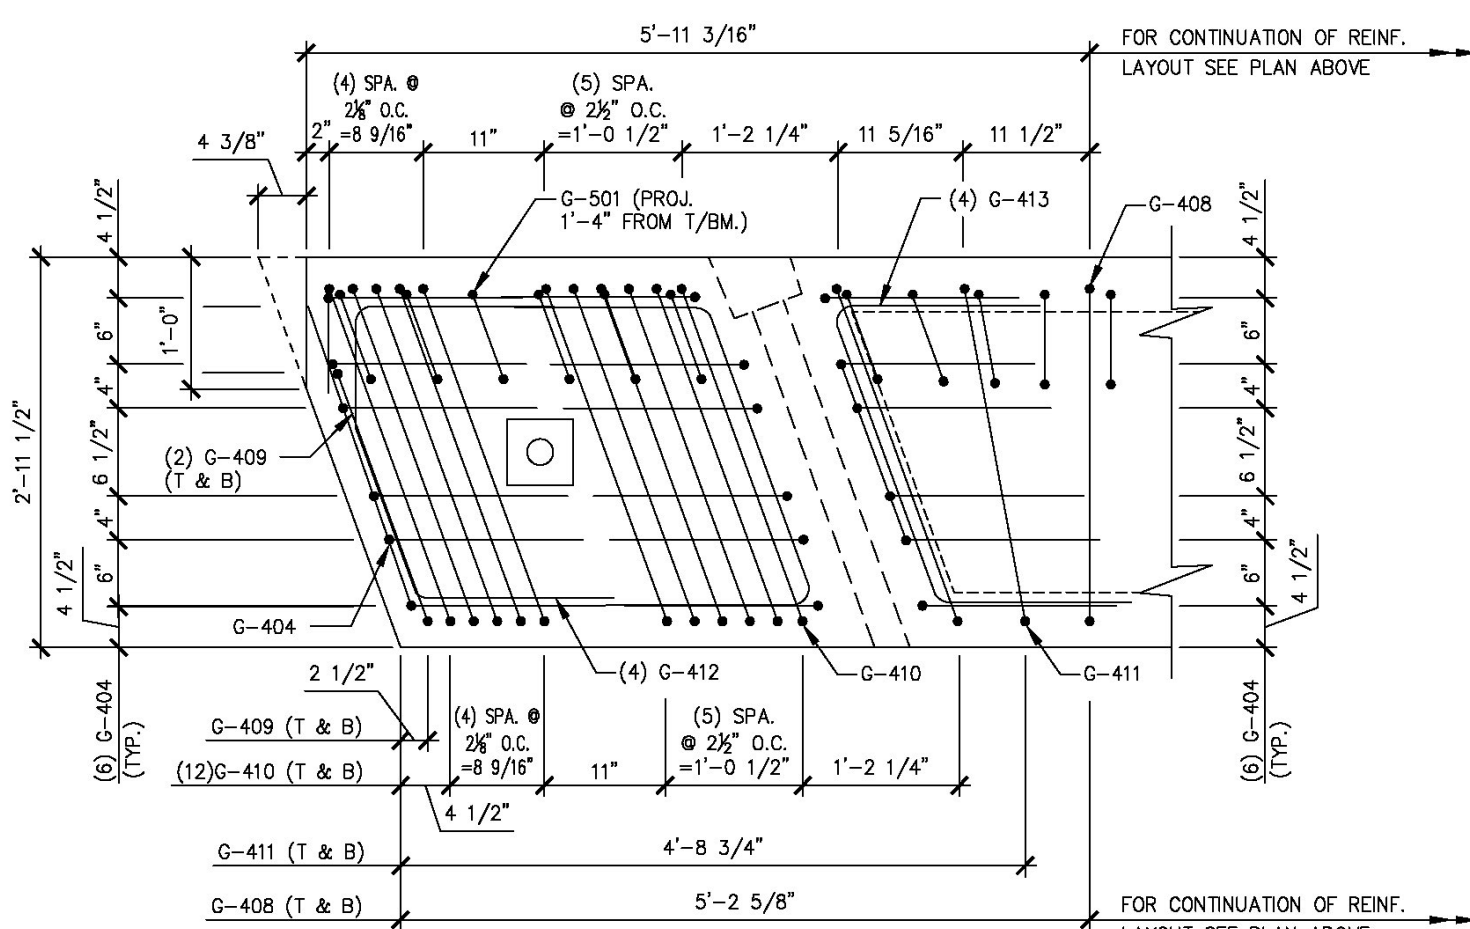


**D** END BLOCK REINFORCING PLAN  
B1A 3/4" = 1'-0"

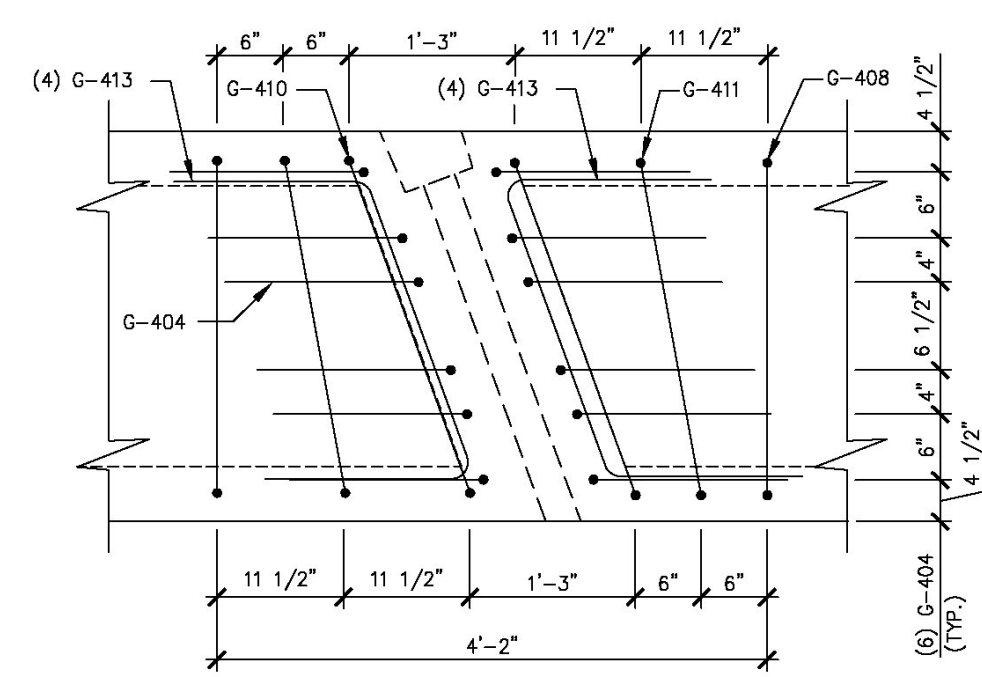

**E** P.T. DIAPHRAGM REINFORCING PLAN  
B1A 3/4" = 1'-0"

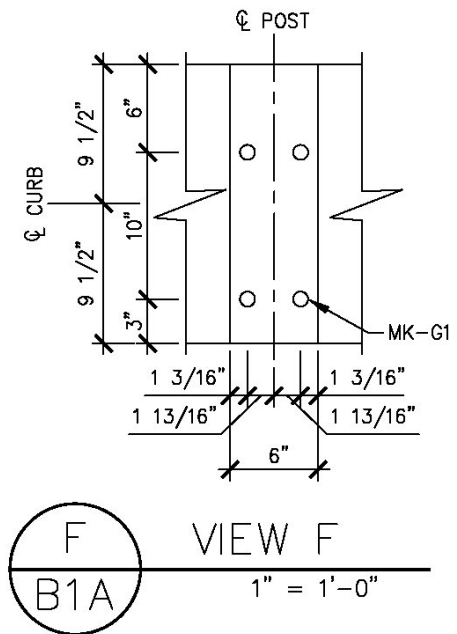

**F** VIEW F  
B1A 1" = 1'-0"

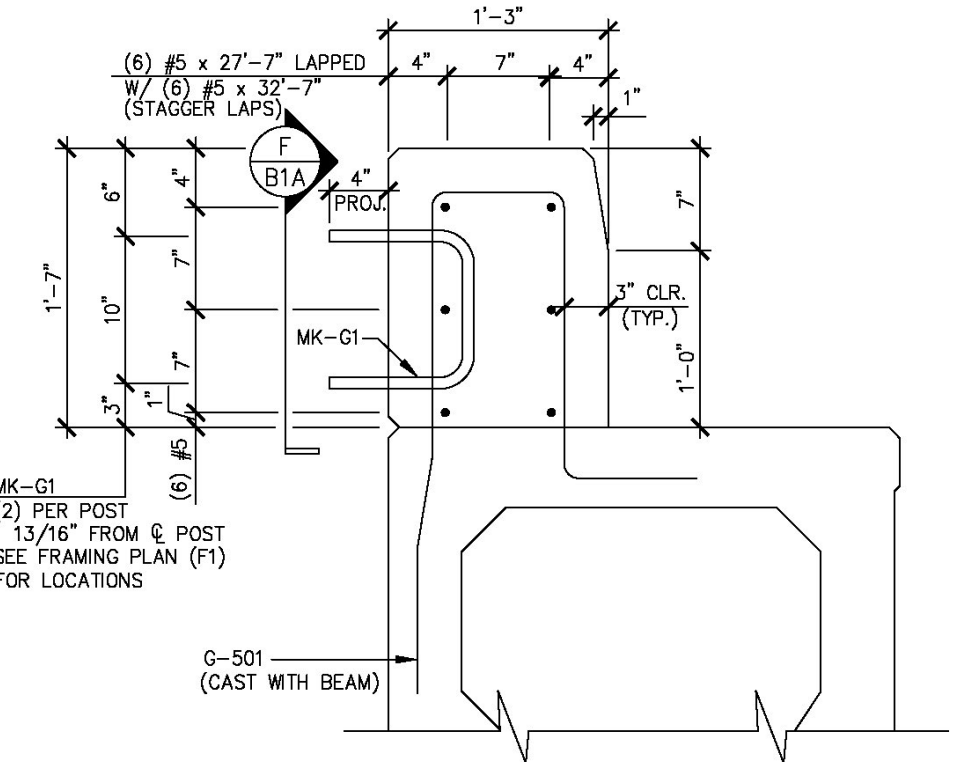

SECONDARY POUR DETAIL  
1" = 1'-0"


Vermont Agency of Transportation  
**RECEIVED**  
CK'D BY MJC OK'D BY TAS  
June 18, 2014

RESUBMIT No Approved  
BY M. J. Chenette DATE 06/19/2014


1 3 5 7 9 11 13 14 12 10 8 6 4 2

DETENSING SCHEDULE  
N.T.S.


MARK: G-B1		QTY.: 1	
MATERIAL LIST / BEAM			
ITEM	MARK	DESCRIPTION	QTY.
1	G-404	#4 BENT BAR (LEVEL II - DUAL COATED)	48
2	G-408	#4 BENT BAR (LEVEL II - DUAL COATED)	72
3	G-409	#4 BENT BAR (LEVEL II - DUAL COATED)	4
4	G-410	#4 BENT BAR (LEVEL II - DUAL COATED)	52
5	G-411	#4 BENT BAR (LEVEL II - DUAL COATED)	8
6	G-412	#4 BENT BAR (LEVEL II - DUAL COATED)	8
7	G-413	#4 BENT BAR (LEVEL II - DUAL COATED)	24
8	G-501	#5 BENT BAR (LEVEL II - DUAL COATED)	113
9			
10			
11			
12			
13			
14			
15			
16		#5 x 27'-7" (LEVEL II - DUAL COATED)	12
17		#5 x 32'-7" (LEVEL II - DUAL COATED)	12
18			
19			
20			
21			
22	MK-G1	1" ANCHOR "U" BOLTS (SUPPLIED BY OTHERS)	18
23			
24			
25			

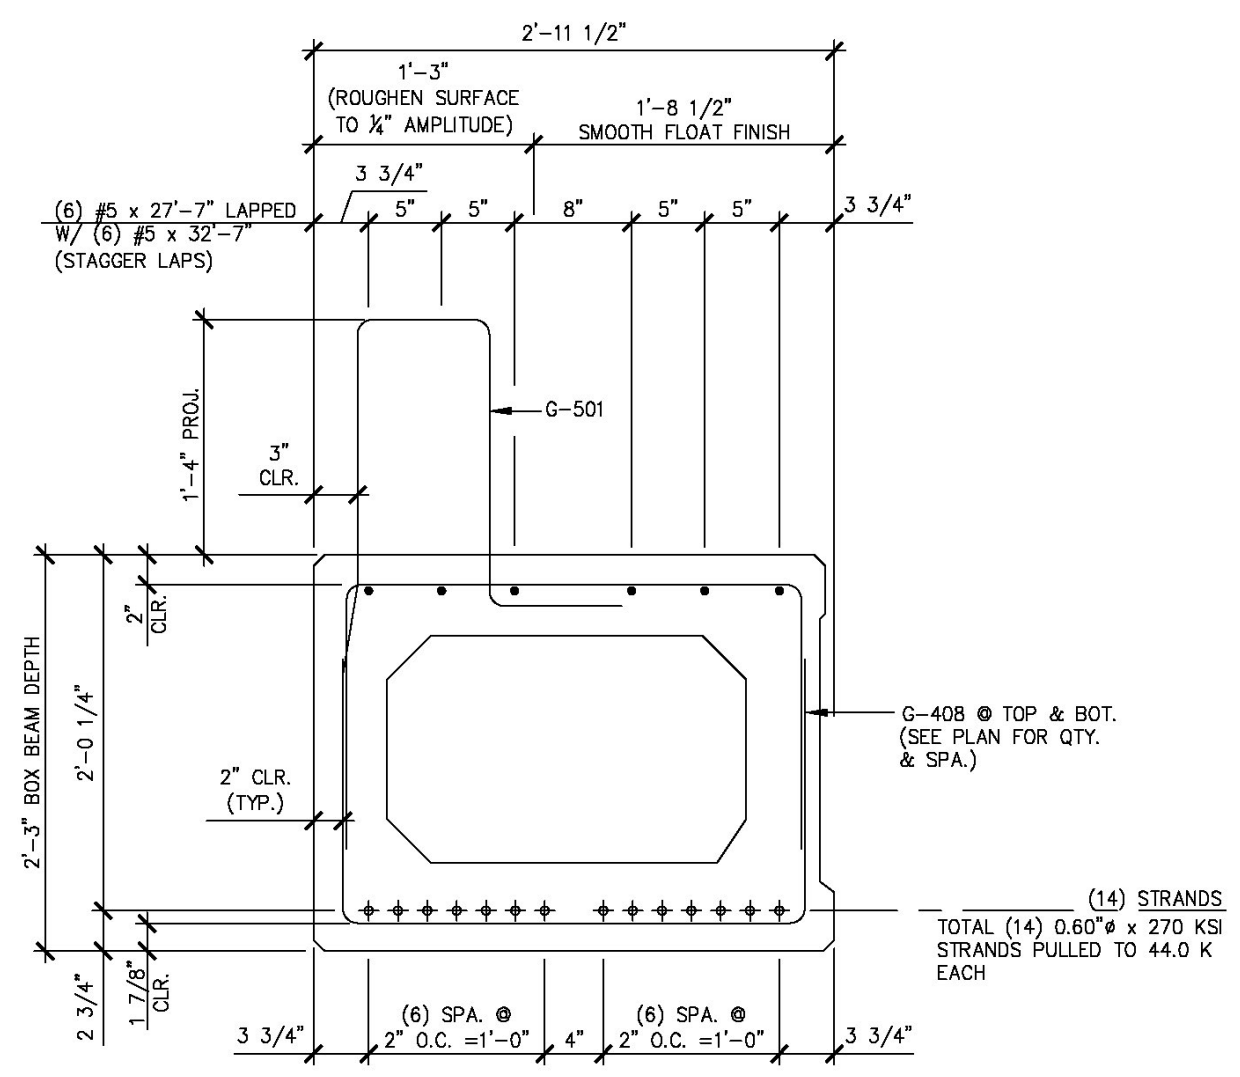

**A** REINFORCING SECTION  
B1A 1" = 1'-0"

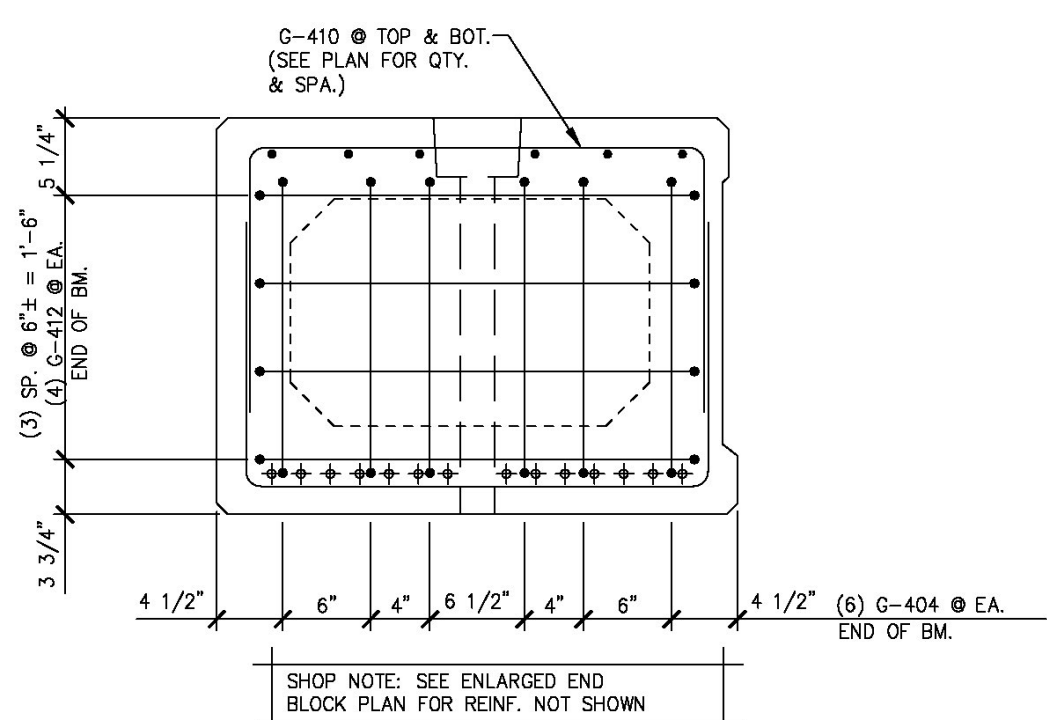

**B** END BLOCK REINF. SECTION  
B1A 1" = 1'-0"

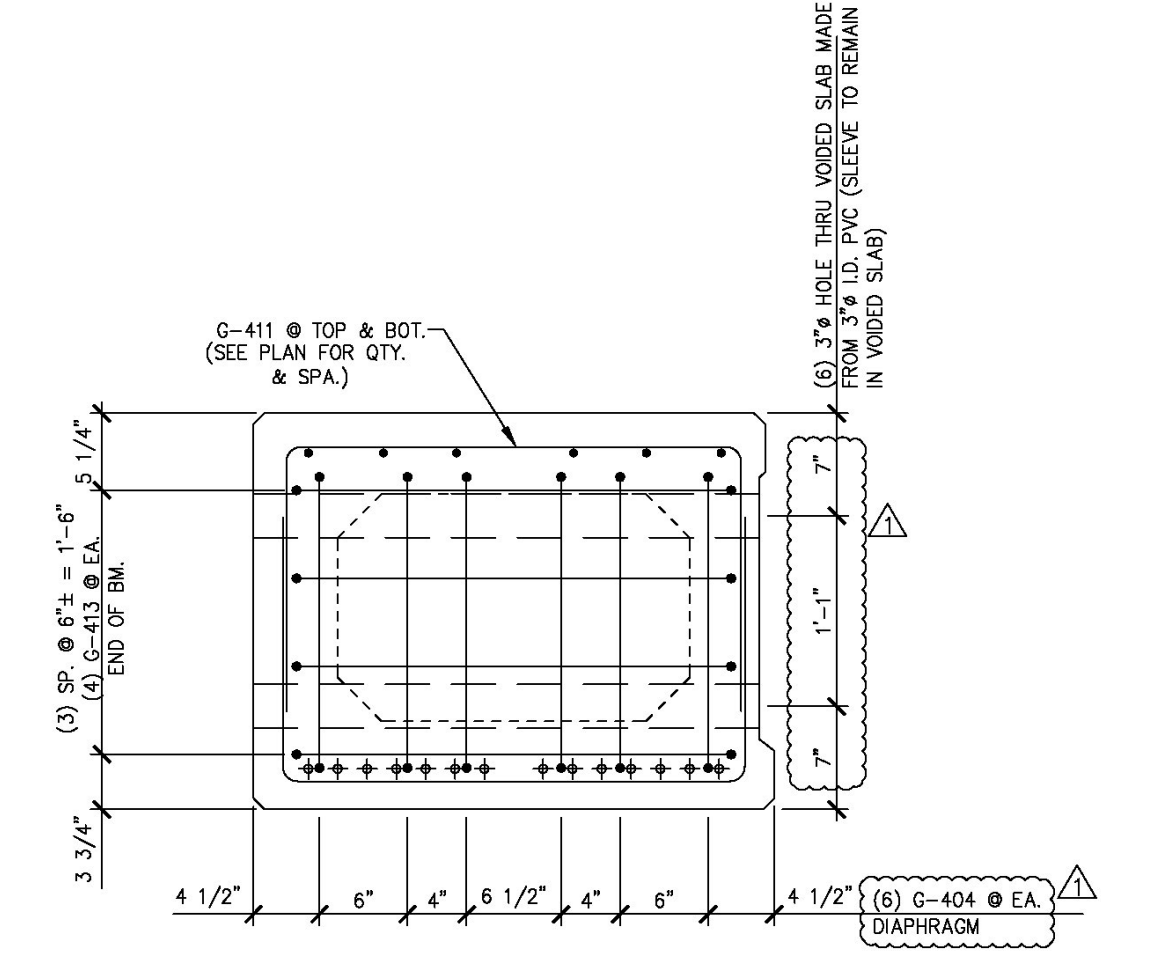

**C** P.T. DIAPHRAGM REINF. SECTION  
B1A 1" = 1'-0"

**SHOP DRAWING REVIEW**

REVIEWED AS REQUIRED BY THE CONSTRUCTION CONTRACT DOCUMENTS AND APPROVED, BUT ONLY FOR CONFORMANCE TO THE DESIGN CONCEPT OF THE WORK, AND SUBJECT TO FURTHER LIMITATIONS AND REQUIREMENTS CONTAINED IN THE CONSTRUCTION CONTRACT DOCUMENTS.

REJECTED       REVISE AND RESUBMIT       FURNISH AS CORRECTED

CORRECTIONS OR COMMENTS MADE ON THE SHOP DRAWINGS DURING THIS REVIEW DO NOT RELIEVE CONTRACTOR FROM COMPLIANCE WITH REQUIREMENTS OF THE DRAWINGS AND SPECIFICATIONS. THIS CHECK IS ONLY FOR REVIEW OF GENERAL CONFORMANCE WITH THE DESIGN CONCEPT OF THE PROJECT AND GENERAL COMPLIANCE WITH THE INFORMATION GIVEN IN THE CONTRACT DOCUMENTS. THE CONTRACTOR IS RESPONSIBLE FOR CONFIRMING AND CORRELATING ALL QUANTITIES AND DIMENSIONS, SELECTING FABRICATION PROCESSES AND TECHNIQUES OF CONSTRUCTION, COORDINATING HIS WORK WITH THAT OF ALL OTHER TRADES, AND PERFORMING HIS WORK IN A SAFE AND SATISFACTORY MANNER.

	<b>Vannesse Hangen Brustlin, Inc.</b> 7056 US Route 7 North Ferrisburgh, VT 05473 802.425.7788	Job Number: 57427 00 Reviewed By: S.E. Burbank Date: 06/19/2014
--	---------------------------------------------------------------------------------------------------------	-----------------------------------------------------------------------




4-7-14 REVISED AS NOTED

APPROVAL STAMP:

**J.P. CARRARA & SONS INC.**  
Precast & Prestress Manufacturer N.T.S.  
244 OASE ST., WINDHAM, VERMONT 05753 Phone: (802)388-6361 Fax: (802)388-9010

STATE OF VERMONT AGENCY OF TRANSPORTATION COUNTY OF WINDHAM	DATE: MAR. 04, 2014 SCALE: NOTED
TOWN OF GUILFORD ROUTE NO. T.H.10, CLASS III (LOCAL ROAD) BRIDGE NO.: 65 PROJECT NO.: BRO 1442 (36)	CHKD: JJ/KLT DFTM: AAT/RWS JOB NO: 23420-014
<b>PRESTRESSED BOX BEAM REINFORCING DETAILS</b>	
DWG. NO: B1A	

**Eriksson technologies**  
813.989.3317  
TAMPA, FL LRFD.COM  
© 2014 ERIKSSON TECHNOLOGIES, INC. ALL RIGHTS RESERVED

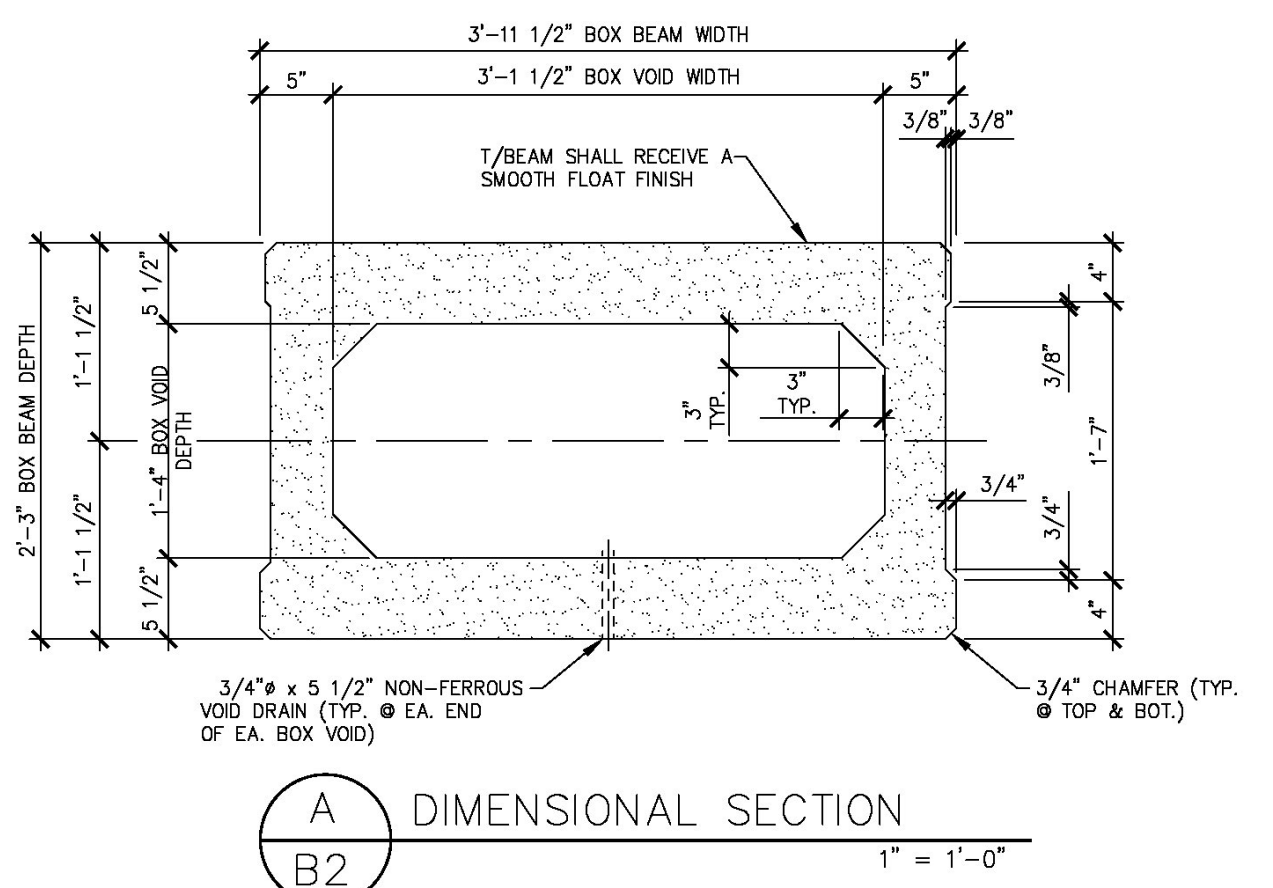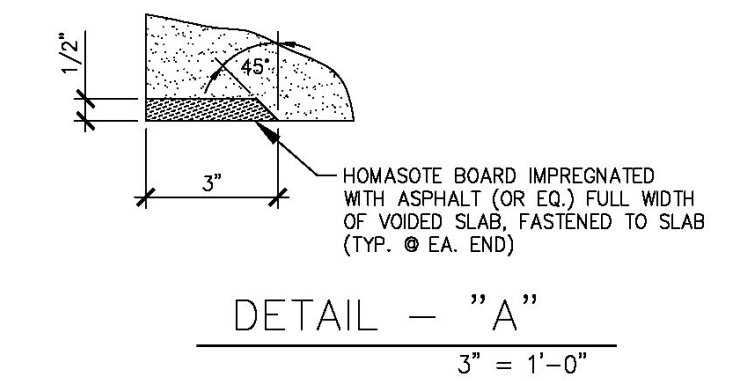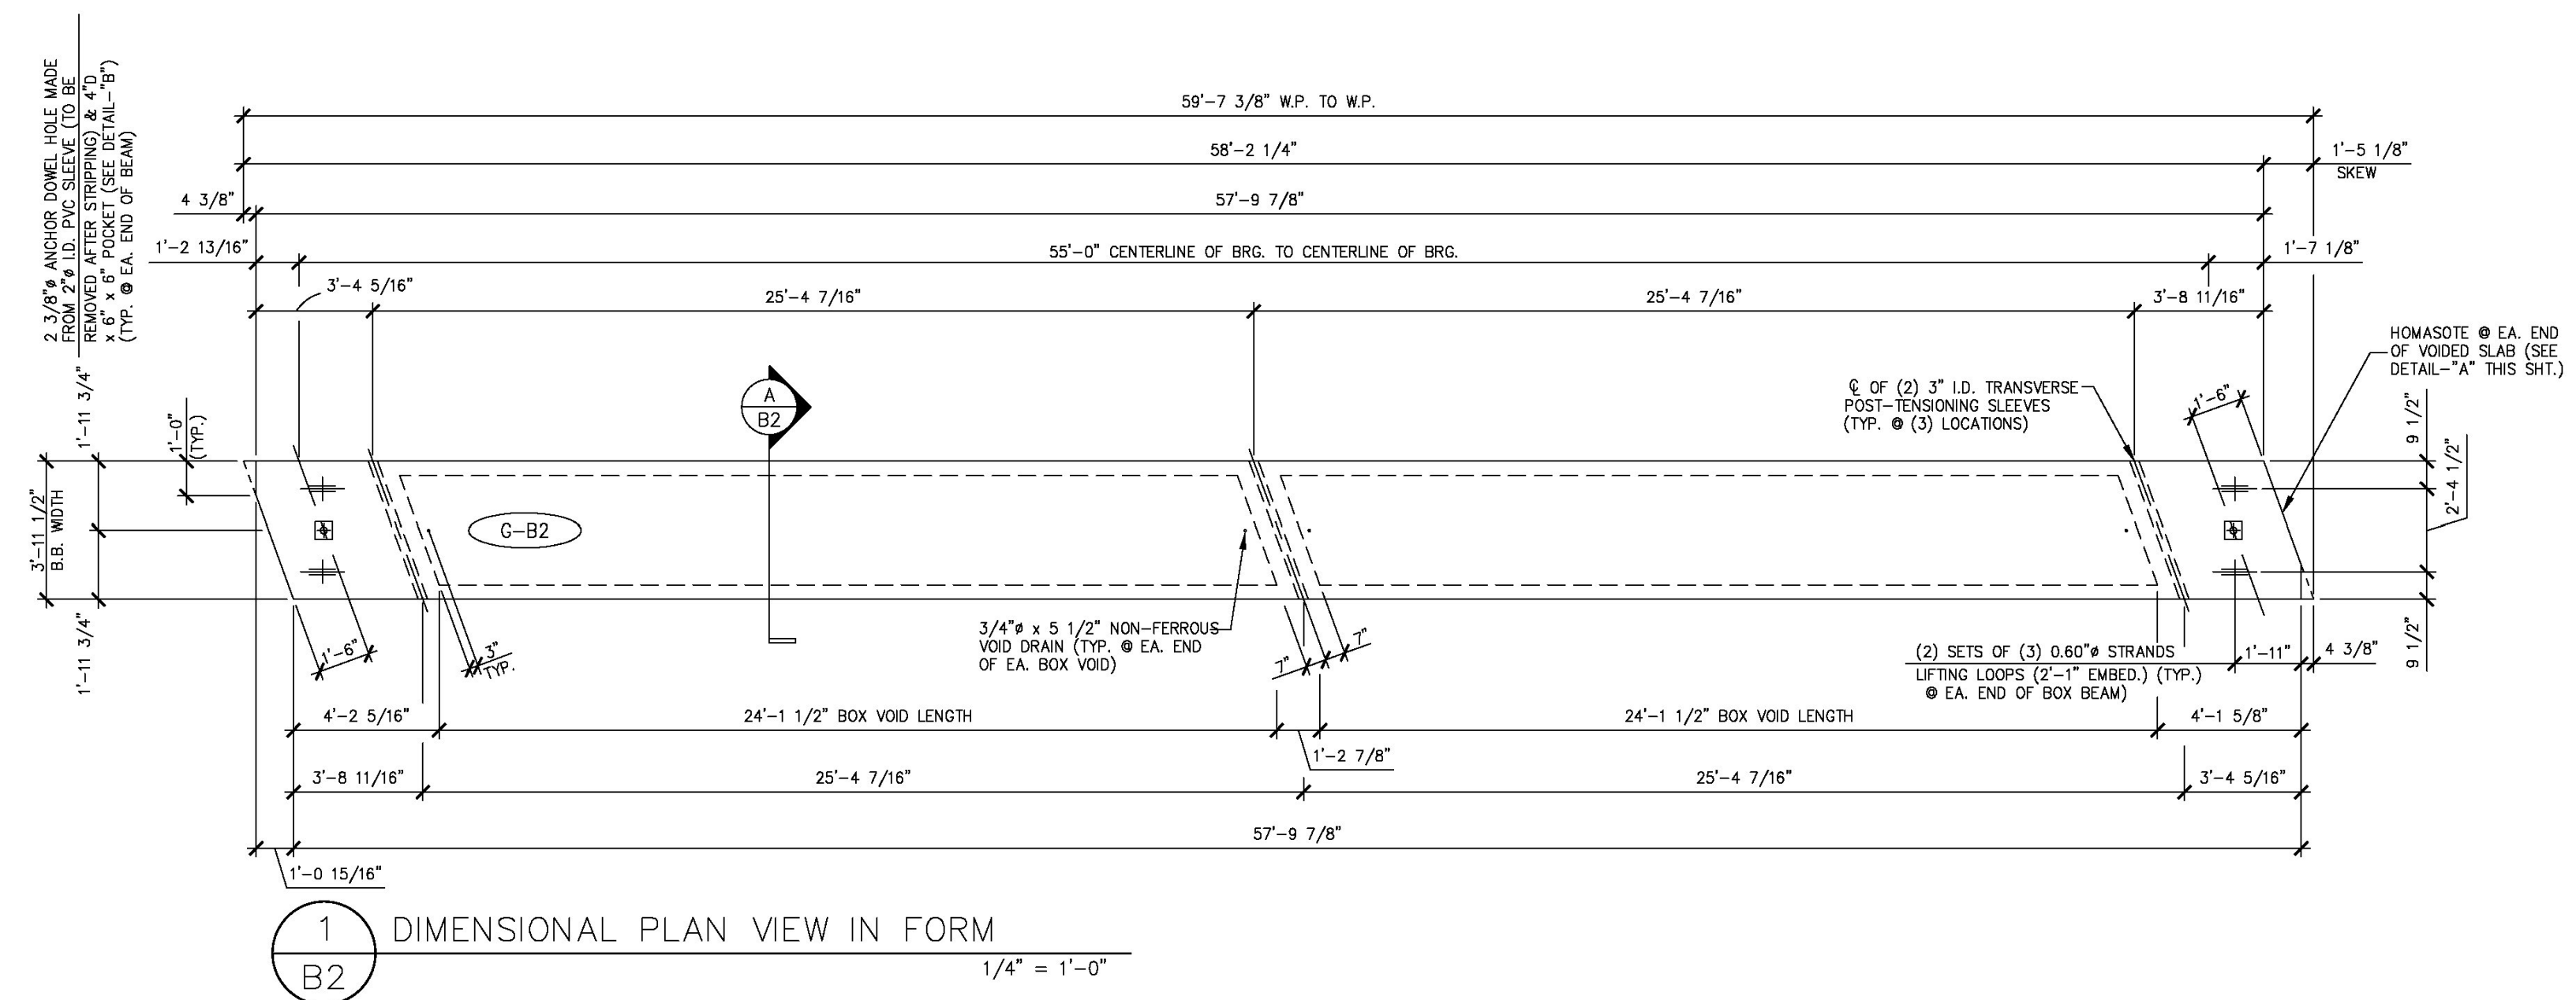

Vermont Agency of Transportation  
**RECEIVED**  
 CK'D BY MJC OK'D BY TAS  
 June 18, 2014  
 RESUBMIT No Approved  
 BY M. J. Chenette DATE 06/19/2014

SHOP NOTE:  
 SEE SHEET "B2A" FOR  
 REINFORCING DETAILS.

MARK:	G-B2	QTY.: 3	WT.: 23.64 T	VOL.: 11.68 cy
MATERIAL LIST / BEAM				
ITEM	MARK	DESCRIPTION	QTY./BEAM	
1			SH-B2	
2				
3				
4				
5				
6				
7		3/4" x 5 1/2" NON-FERROUS VOID DRAIN		4
8		2'-2" x 1'-4 1/2" x 24'-1 1/2" BOX VOID		2
9		SET OF (3) 0.60" STRAND LIFTING LOOPS		4
10				

**SHOP DRAWING REVIEW**

REVIEWED AS REQUIRED BY THE CONSTRUCTION CONTRACT DOCUMENTS AND APPROVED, BUT ONLY FOR CONFORMANCE TO THE DESIGN CONCEPT OF THE WORK, AND SUBJECT TO FURTHER LIMITATIONS AND REQUIREMENTS CONTAINED IN THE CONSTRUCTION CONTRACT DOCUMENTS.

REJECTED     REVISE AND RESUBMIT     FURNISH AS CORRECTED

CORRECTIONS OR COMMENTS MADE ON THE SHOP DRAWINGS DURING THIS REVIEW DO NOT RELIEVE CONTRACTOR FROM COMPLIANCE WITH REQUIREMENTS OF THE DRAWINGS AND SPECIFICATIONS. THIS CHECK IS ONLY FOR REVIEW OF GENERAL CONFORMANCE WITH THE DESIGN CONCEPT OF THE PROJECT AND GENERAL COMPLIANCE WITH THE INFORMATION GIVEN IN THE CONTRACT DOCUMENTS. THE CONTRACTOR IS RESPONSIBLE FOR CONFIRMING AND CORRELATING ALL QUANTITIES AND DIMENSIONS, SELECTING FABRICATION PROCESSES AND TECHNIQUES OF CONSTRUCTION, COORDINATING HIS WORK WITH THAT OF ALL OTHER TRADES, AND PERFORMING HIS WORK IN A SAFE AND SATISFACTORY MANNER.

**VHB Vanasse Hangen Brustlin, Inc.**  
 7056 US Route 7  
 North Ferrisburgh, VT 05473  
 802-425-7788

Job Number: 57427.00  
 Reviewed By: S.E. Burbank  
 Date: 06/19/2014

APPROVAL STAMP:

**J.P. CARRARA & SONS INC.**  
 Precast & Prestress Manufacturer N.T.S.  
 2464 OASE STR., MIDDLEBURY, VERMONT 05753 Phone: (802)388-6361 Fax: (802)388-9010


STATE OF VERMONT AGENCY OF TRANSPORTATION  
 COUNTY OF WINDHAM

TOWN OF GUILFORD  
 ROUTE NO. T.H.10, CLASS III (LOCAL ROAD)  
 BRIDGE NO.: 65 PROJECT NO.: BRO 1442 (36)


PRESTRESSED BOX BEAM  
 DIMENSIONAL DETAILS

DATE: MAR. 04, 2014  
 SCALE: NOTED  
 CHKD: JJ/KLT DFTM:AA1/RWS  
 JOB NO: 23420-014  
 DWG. NO: B2


**Eriksson technologies**  
 813.989.3317  
 TAMPA, FL LRFD.COM  
 © 2014 ERIKSSON TECHNOLOGIES, INC. ALL RIGHTS RESERVED

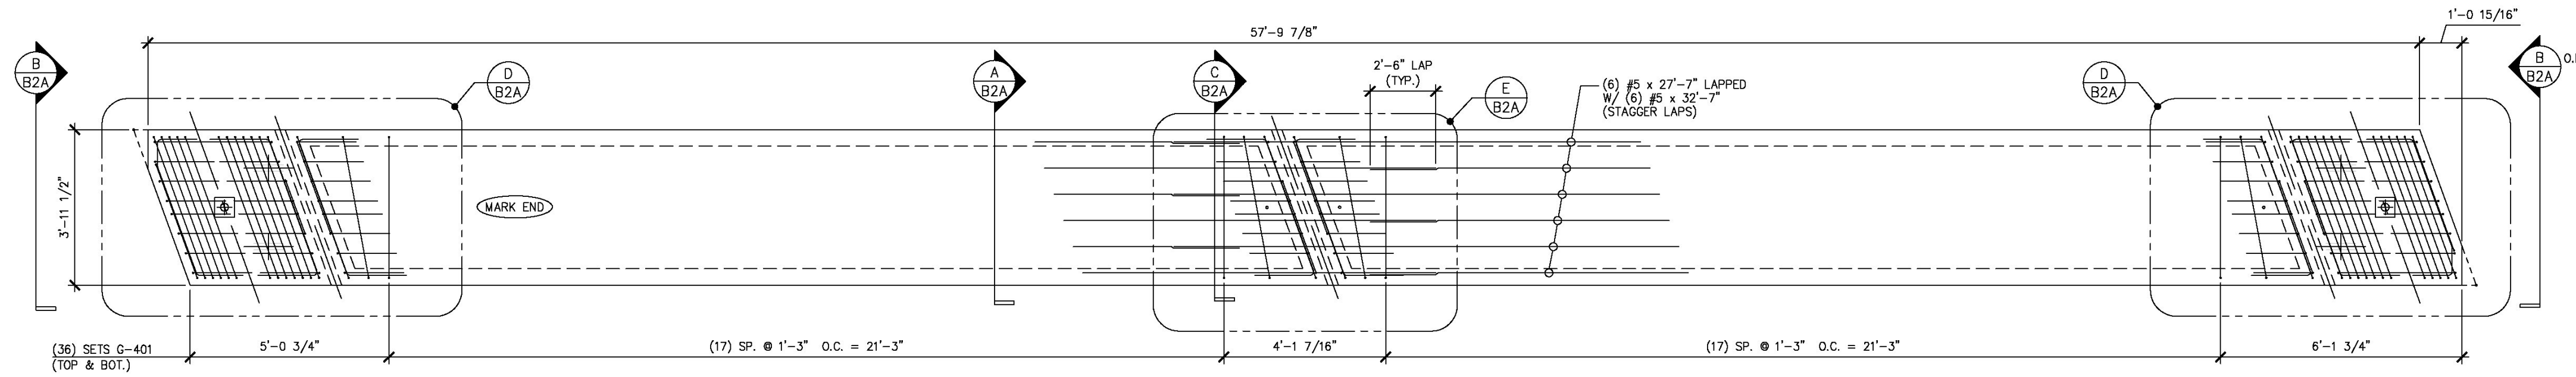

1 REINFORCING PLAN VIEW IN FORM  
B2 1/4" = 1'-0"

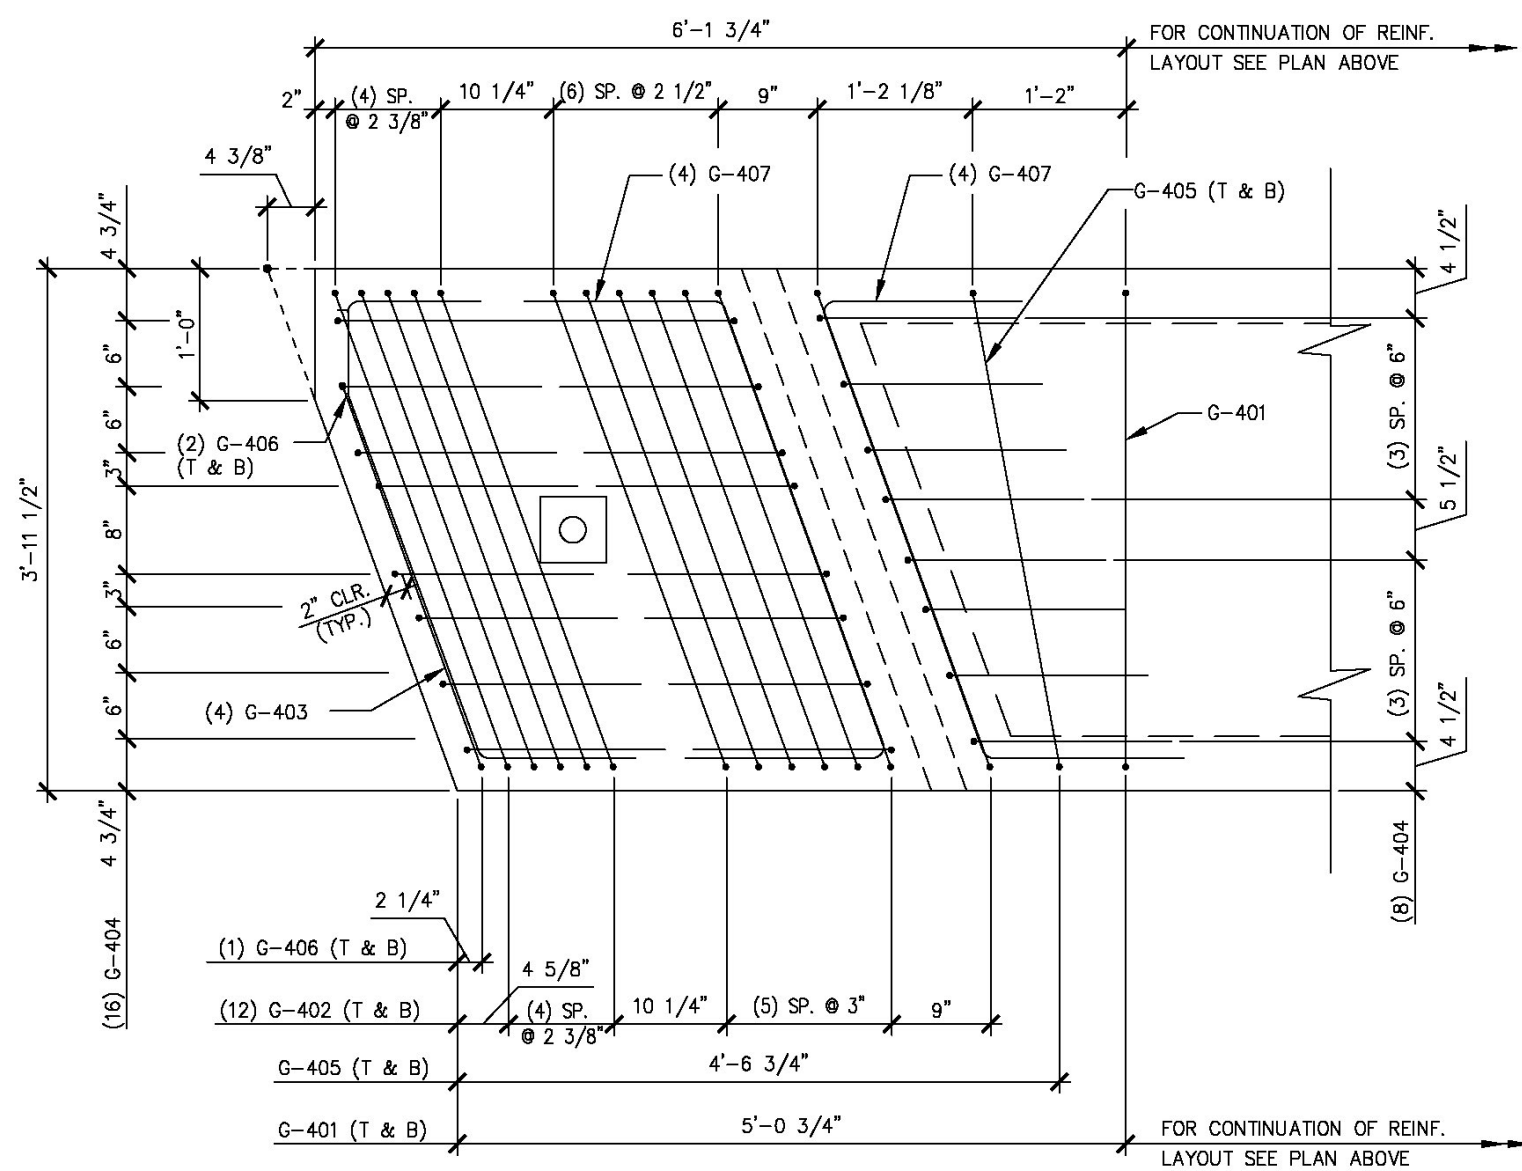


D END BLOCK REINFORCING PLAN  
B2A 3/4" = 1'-0"

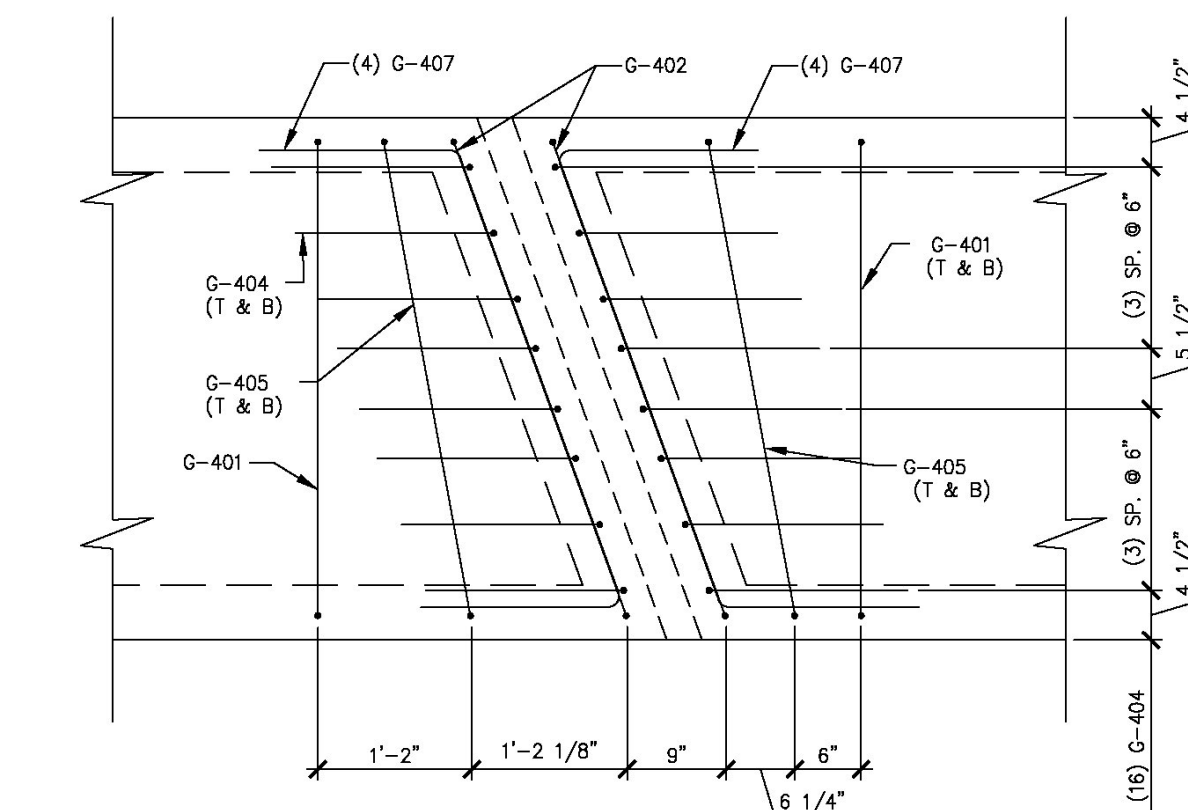


E P.T. DIAPHRAGM REINFORCING PLAN  
B2A 3/4" = 1'-0"

1 3 5 7 9 11 13 14 12 10 8 6 4 2


DETENSIONING SCHEDULE  
N.T.S.

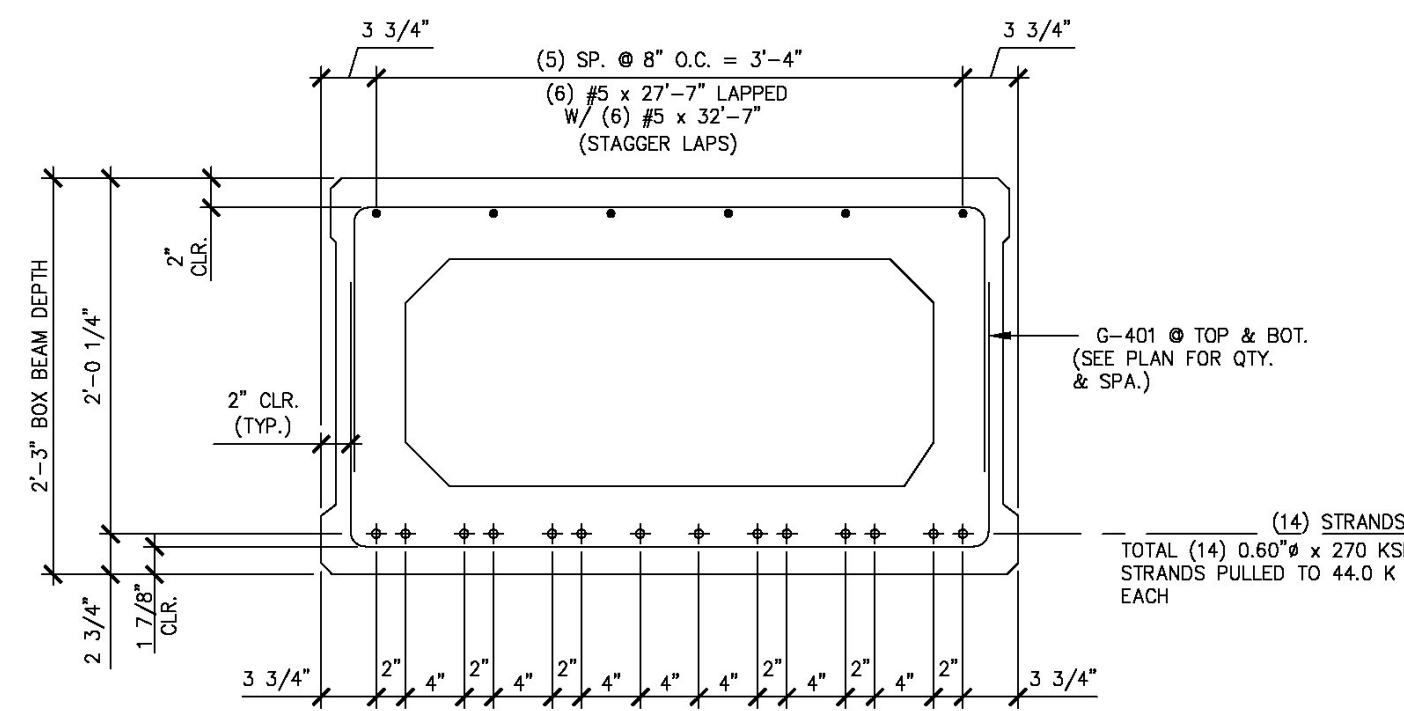

A REINFORCING SECTION  
B2A 1" = 1'-0"

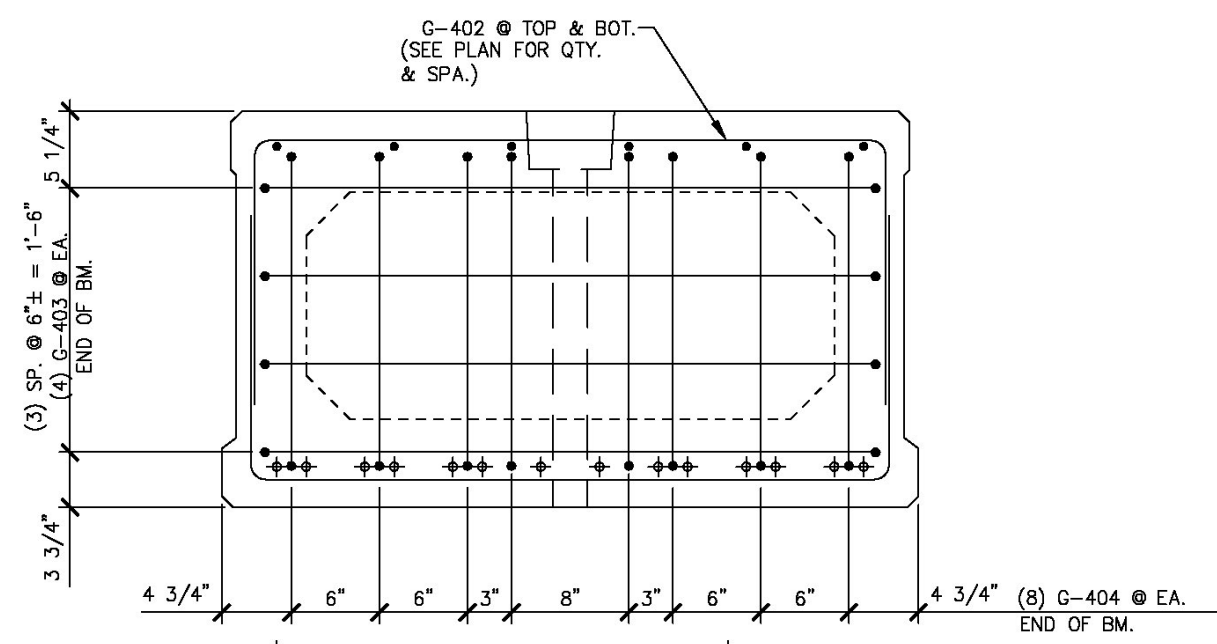

B END BLOCK REINF. SECTION  
B2A 1" = 1'-0"

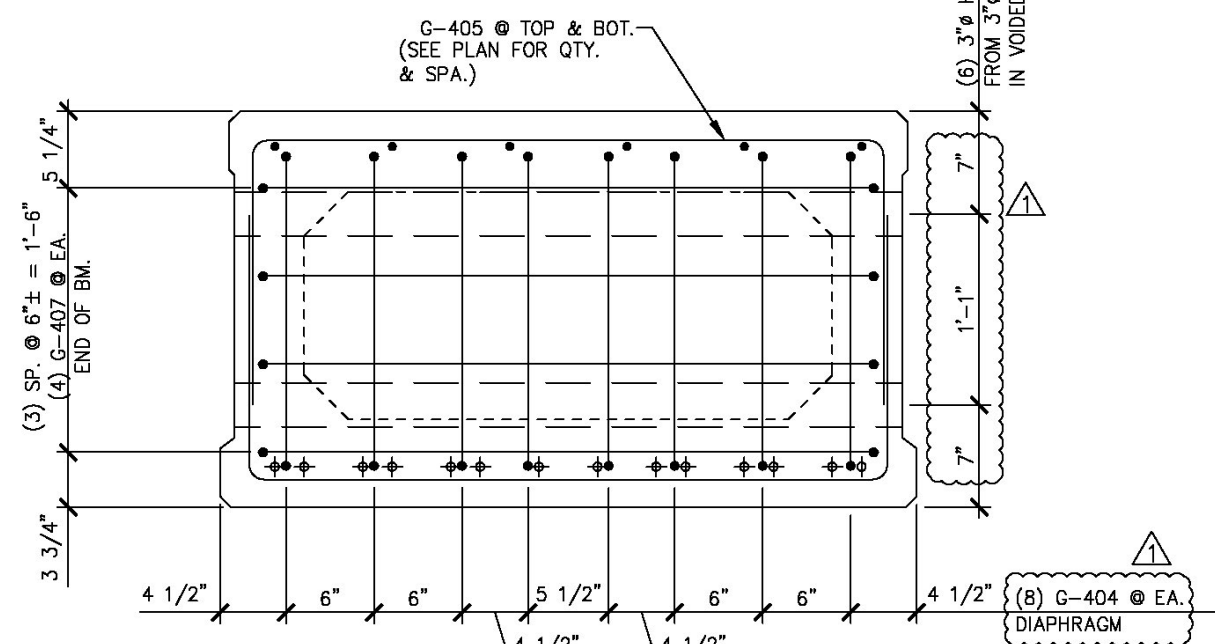

C P.T. DIAPHRAGM REINF. SECTION  
B2A 1" = 1'-0"

Vermont Agency of Transportation  
**RECEIVED**  
CK'D BY MJC OK'D BY TAS  
June 18, 2014  
RESUBMIT No Approved  
BY M. J. Chenette DATE 06/19/2014

**SHOP DRAWING REVIEW**

REVIEWED AS REQUIRED BY THE CONSTRUCTION CONTRACT DOCUMENTS AND APPROVED, BUT ONLY FOR CONFORMANCE TO THE DESIGN CONCEPT OF THE WORK, AND SUBJECT TO FURTHER LIMITATIONS AND REQUIREMENTS CONTAINED IN THE CONSTRUCTION CONTRACT DOCUMENTS.

REJECTED  REVISE AND RESUBMIT  FURNISH AS CORRECTED

CORRECTIONS OR COMMENTS MADE ON THE SHOP DRAWINGS DURING THIS REVIEW DO NOT RELIEVE CONTRACTOR FROM COMPLIANCE WITH REQUIREMENTS OF THE DRAWINGS AND SPECIFICATIONS. THIS CHECK IS ONLY FOR REVIEW OF GENERAL CONFORMANCE WITH THE DESIGN CONCEPT OF THE PROJECT AND GENERAL COMPLIANCE WITH THE INFORMATION GIVEN IN THE CONTRACT DOCUMENTS. THE CONTRACTOR IS RESPONSIBLE FOR CONFIRMING AND CORRELATING ALL QUANTITIES AND DIMENSIONS; SELECTING FABRICATION PROCESSES AND TECHNIQUES OF CONSTRUCTION; COORDINATING HIS WORK WITH THAT OF ALL OTHER TRADES; AND PERFORMING HIS WORK IN A SAFE AND SATISFACTORY MANNER.

**VIII Vanasse Hangen Brustlin, Inc.** Job Number: 57427.00  
7056 US Route 7 North Ferrisburgh, VT 05473 Reviewed By: S.E. Burbank  
802.425.7788 Date: 06/19/2014

MARK: G-B2 QTY.: 3

MATERIAL LIST / BEAM				
ITEM	MARK	DESCRIPTION	QTY.	
1	G-401	#4 BENT BAR (LEVEL II - DUAL COATED)	72	
2	G-402	#4 BENT BAR (LEVEL II - DUAL COATED)	52	
3	G-403	#4 BENT BAR (LEVEL II - DUAL COATED)	8	
4	G-404	#4 BENT BAR (LEVEL II - DUAL COATED)	64	
5	G-405	#4 BENT BAR (LEVEL II - DUAL COATED)	8	
6	G-406	#4 BENT BAR (LEVEL II - DUAL COATED)	4	
7	G-407	#4 BENT BAR (LEVEL II - DUAL COATED)	24	
8				
9				
10				
11				
12				
13				
14				
15				
16		#5 x 27'-7" (LEVEL II - DUAL COATED)	6	
17		#5 x 32'-7" (LEVEL II - DUAL COATED)	6	
18				
19				
20				
21				
22				
23				
24				
25				

APPROVAL STAMP:

**J.P. CARRARA & SONS INC.**  
Precast & Prestress Manufacturer N.T.S.  
244 OASE ST., MIDDLEBURY, VERMONT 05753 Phone:(802)388-6361 Fax:(802)388-9010

STATE OF VERMONT AGENCY OF TRANSPORTATION  
COUNTY OF WINDHAM

TOWN OF GUILFORD  
ROUTE NO. T.H.10, CLASS III (LOCAL ROAD)  
BRIDGE NO.: 65 PROJECT NO.: BRO 1442 (36)


PRESTRESSED BOX BEAM  
REINFORCING DETAILS

DATE: MAR. 04, 2014  
SCALE: NOTED  
CHKD: JJ/KLT DFTM:AA1/RWS  
JOB NO: 23420-014  
DWG. NO: B2A


**Eriksson technologies** 813.989.3317  
TAMPA, FL LRFD.COM  
© 2014 ERIKSSON TECHNOLOGIES, INC. ALL RIGHTS RESERVED

S:\Engineering Services\Carrara\14001 - Guilford Bridge 65\Production Drawings\AutoCAD Files\144236-B2a.dwg, 5/16/2014, 4:44:28 PM, DWG To PDF.pc3


S:\Engineering Services\Carrara\14001 - Guilford Bridge 65\Production Drawings\AutoCAD Files\144236-B3.dwg, 5/6/2014 4:44:31 PM, DWG To PDF.pc3

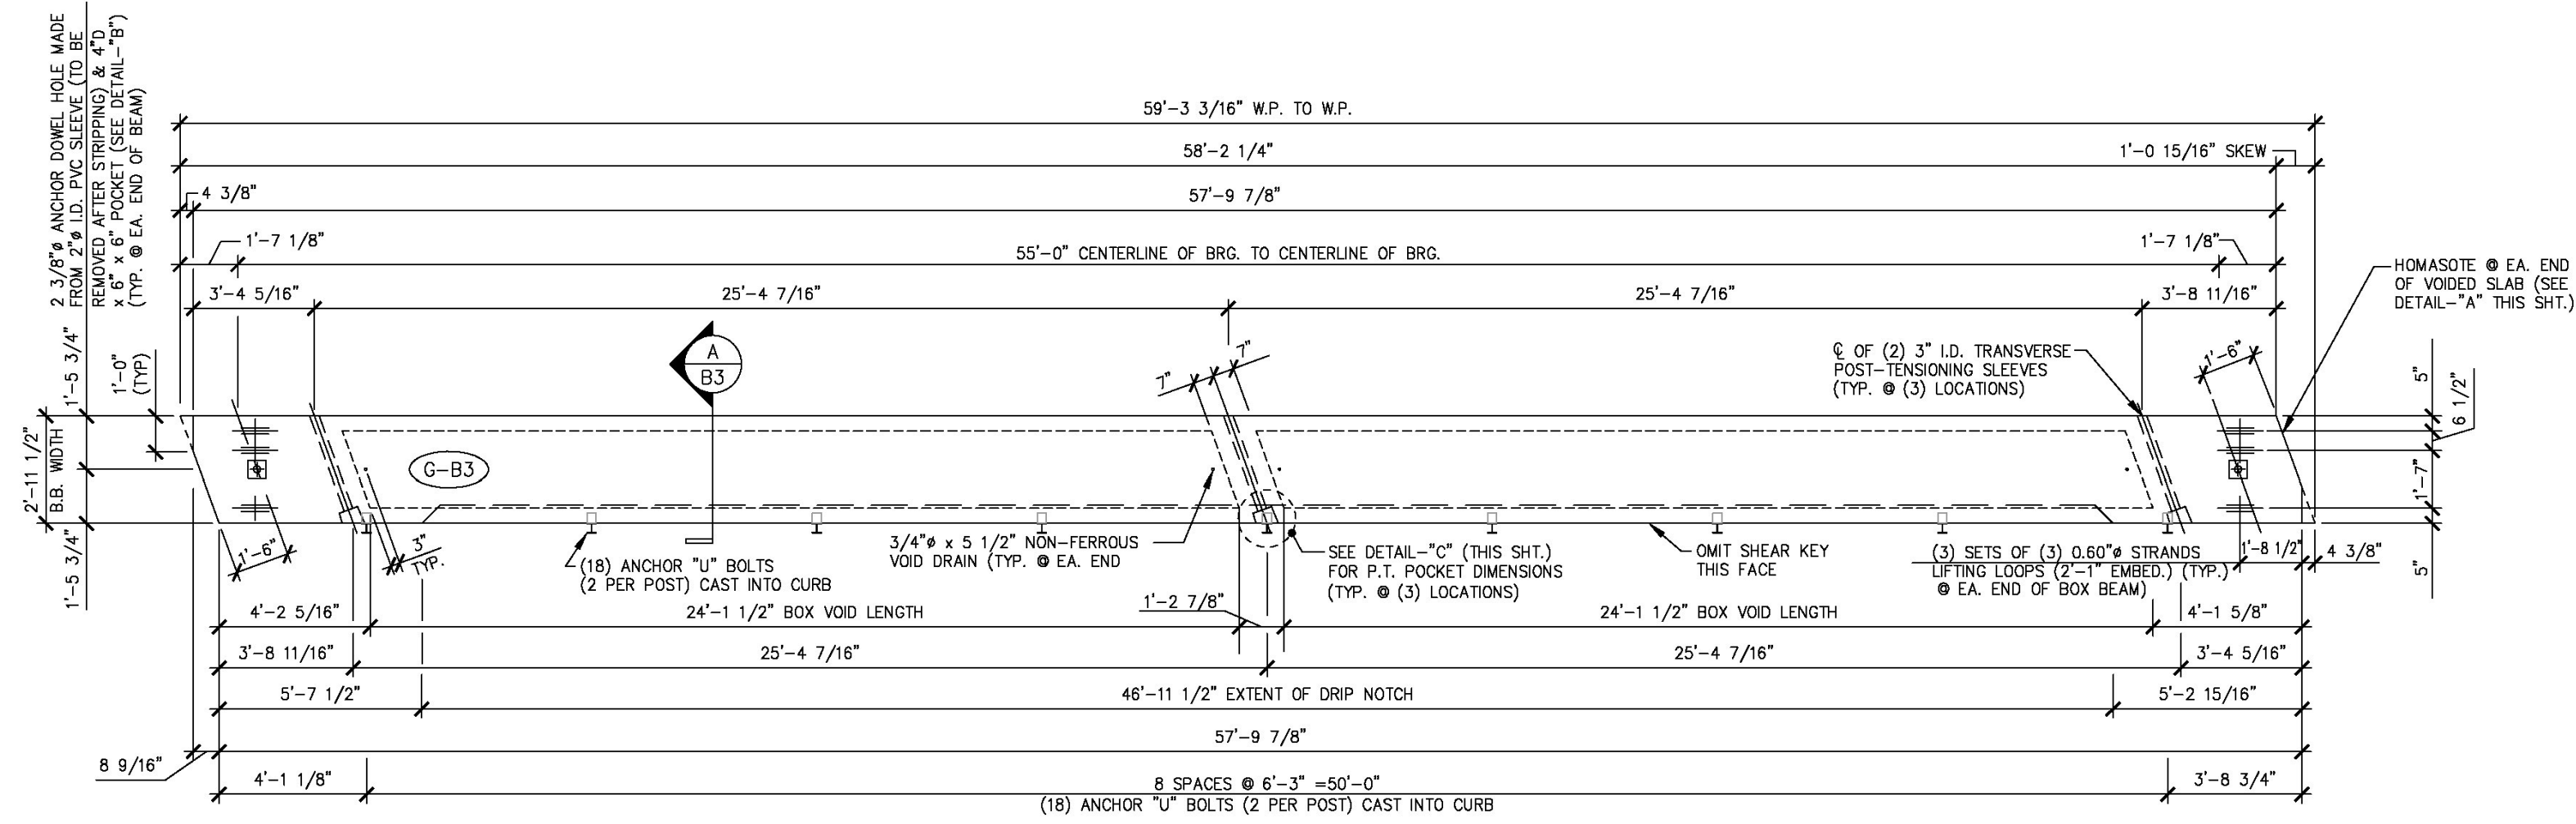


1 DIMENSIONAL PLAN VIEW IN FORM  
B3 1/4" = 1'-0"

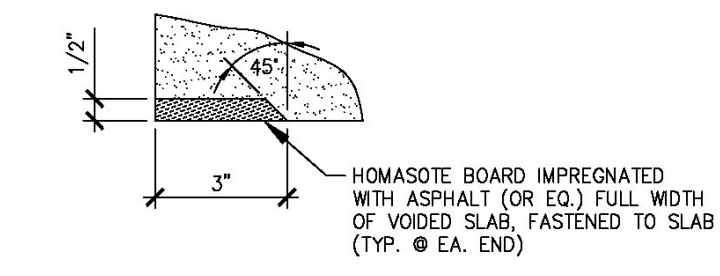


DETAIL - "A"  
3" = 1'-0"

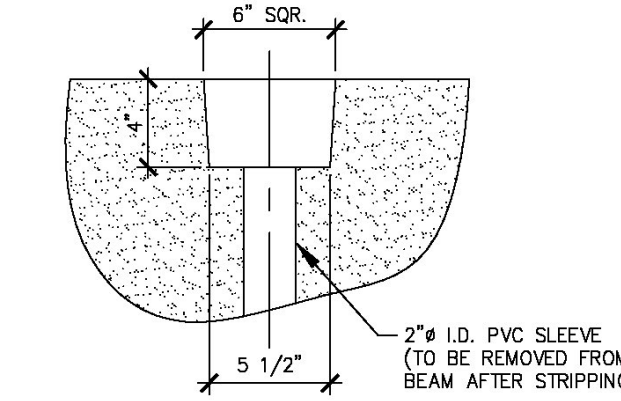

DETAIL - "B"  
1 1/2" = 1'-0"

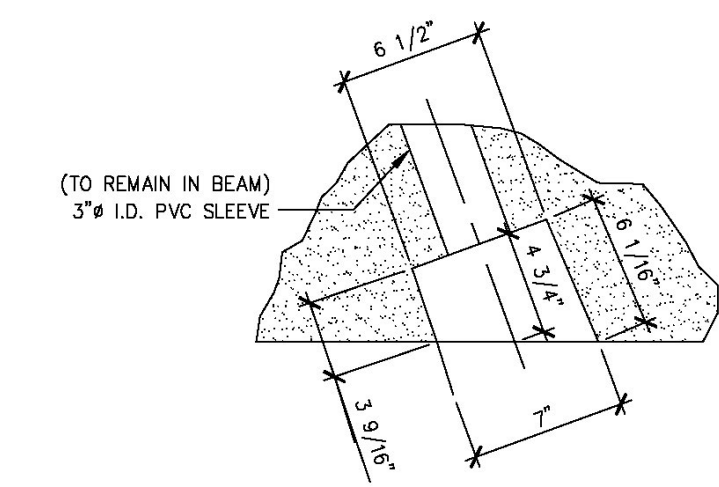

DETAIL - "C"  
1 1/2" = 1'-0"

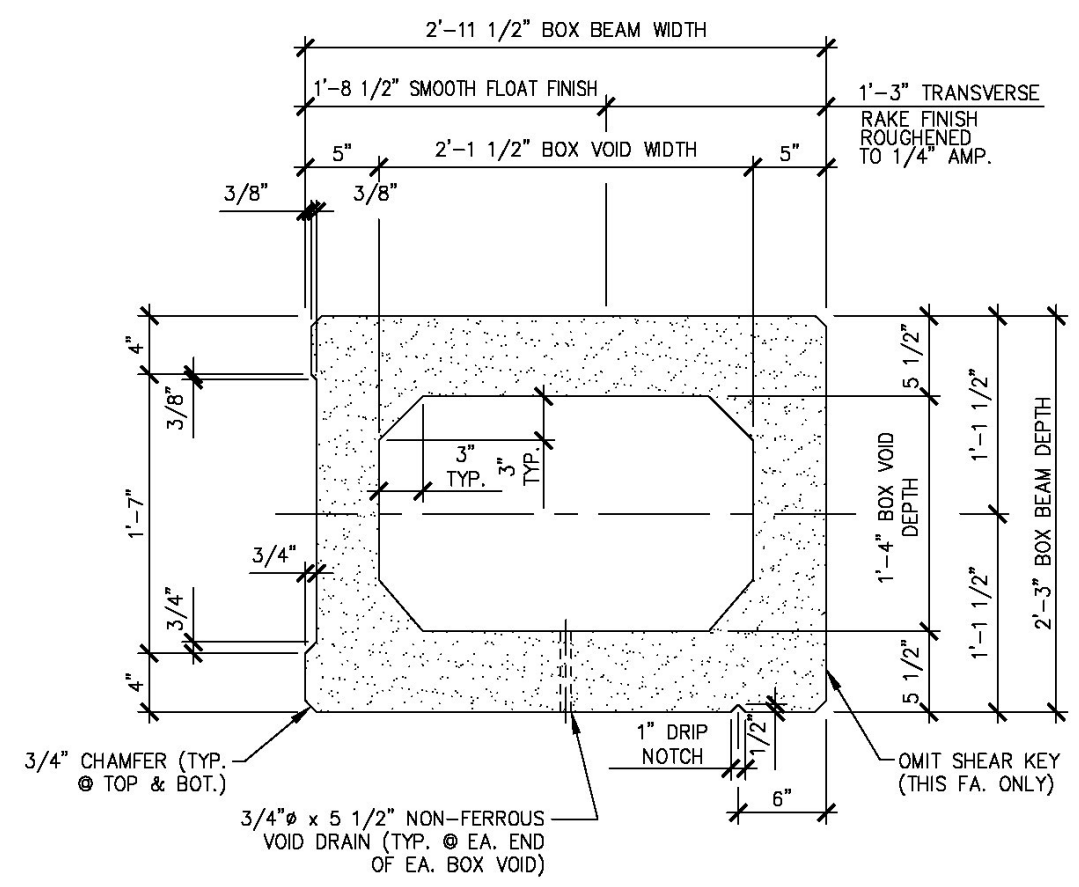

A DIMENSIONAL SECTION  
B3 1" = 1'-0"

SHOP NOTE:  
SEE SHEET "B3A" FOR REINFORCING DETAILS.

MARK:	G-B3	QTY.:	1	WT.:	26.71 T	VOL.:	13.19 cy
MATERIAL LIST / BEAM							
ITEM	MARK	DESCRIPTION	QTY./BEAM				
			G-B1				
1							
2							
3							
4							
5							
6							
7		3/4" x 5 1/2" NON-FERROUS VOID DRAIN		4			
8		2'-2" x 1'-4 1/2" x 24'-1 1/2" BOX VOID		2			
9		SET OF (3) 0.60" STRAND LIFTING LOOPS		6			
10							

Vermont Agency of Transportation  
**RECEIVED**  
CK'D BY MJC OK'D BY TAS  
June 18, 2014  
RESUBMIT No Approved  
BY M. J. Chenette DATE 06/19/2014

**SHOP DRAWING REVIEW**

REVIEWED AS REQUIRED BY THE CONSTRUCTION CONTRACT DOCUMENTS AND APPROVED, BUT ONLY FOR CONFORMANCE TO THE DESIGN CONCEPT OF THE WORK, AND SUBJECT TO FURTHER LIMITATIONS AND REQUIREMENTS CONTAINED IN THE CONSTRUCTION CONTRACT DOCUMENTS.

REJECTED  REVISE AND RESUBMIT  FURNISH AS CORRECTED


CORRECTIONS OR COMMENTS MADE ON THE SHOP DRAWINGS DURING THIS REVIEW DO NOT RELIEVE CONTRACTOR FROM COMPLIANCE WITH REQUIREMENTS OF THE DRAWINGS AND SPECIFICATIONS. THIS CHECK IS ONLY FOR REVIEW OF GENERAL CONFORMANCE WITH THE DESIGN CONCEPT OF THE PROJECT AND GENERAL COMPLIANCE WITH THE INFORMATION GIVEN IN THE CONTRACT DOCUMENTS. THE CONTRACTOR IS RESPONSIBLE FOR CONFIRMING AND CORRECTING ALL QUANTITIES AND DIMENSIONS, SELECTING FABRICATION PROCESSES AND TECHNIQUES OF CONSTRUCTION, COORDINATING HIS WORK WITH THAT OF ALL OTHER TRADES, AND PERFORMING HIS WORK IN A SAFE AND SATISFACTORY MANNER.

**Vanasse Hangen Brustlin, Inc.**  
7056 US Route 7  
North Ferrisburgh, VT 05473  
802.465.7788


Job Number: 57427.00  
Reviewed By: S.E. Burbank  
Date: 06/19/2014

APPROVAL STAMP:	<b>J.P. CARRARA &amp; SONS INC.</b> Precast & Prestress Manufacturer N.T.S. 244 OAK ST., MIDDLEBURY, VERMONT 05753 Phone:(802)388-6361 Fax:(802)388-9010
STATE OF VERMONT AGENCY OF TRANSPORTATION COUNTY OF WINDHAM	DATE: MAR. 04, 2014 SCALE: NOTED
TOWN OF GUILFORD ROUTE NO. T.H.10, CLASS III (LOCAL ROAD) BRIDGE NO.: 65 PROJECT NO.: BRO 1442 (36)	CHKD: JJ/KLT DFTM:AA1/RWS JOB NO: 23420-014
PRESTRESSED BOX BEAM DIMENSIONAL DETAILS	DWG. NO: B3


**Eriksson technologies** 813.989.3317  
TAMPA, FL LRFD.COM  
© 2014 ERIKSSON TECHNOLOGIES, INC. ALL RIGHTS RESERVED

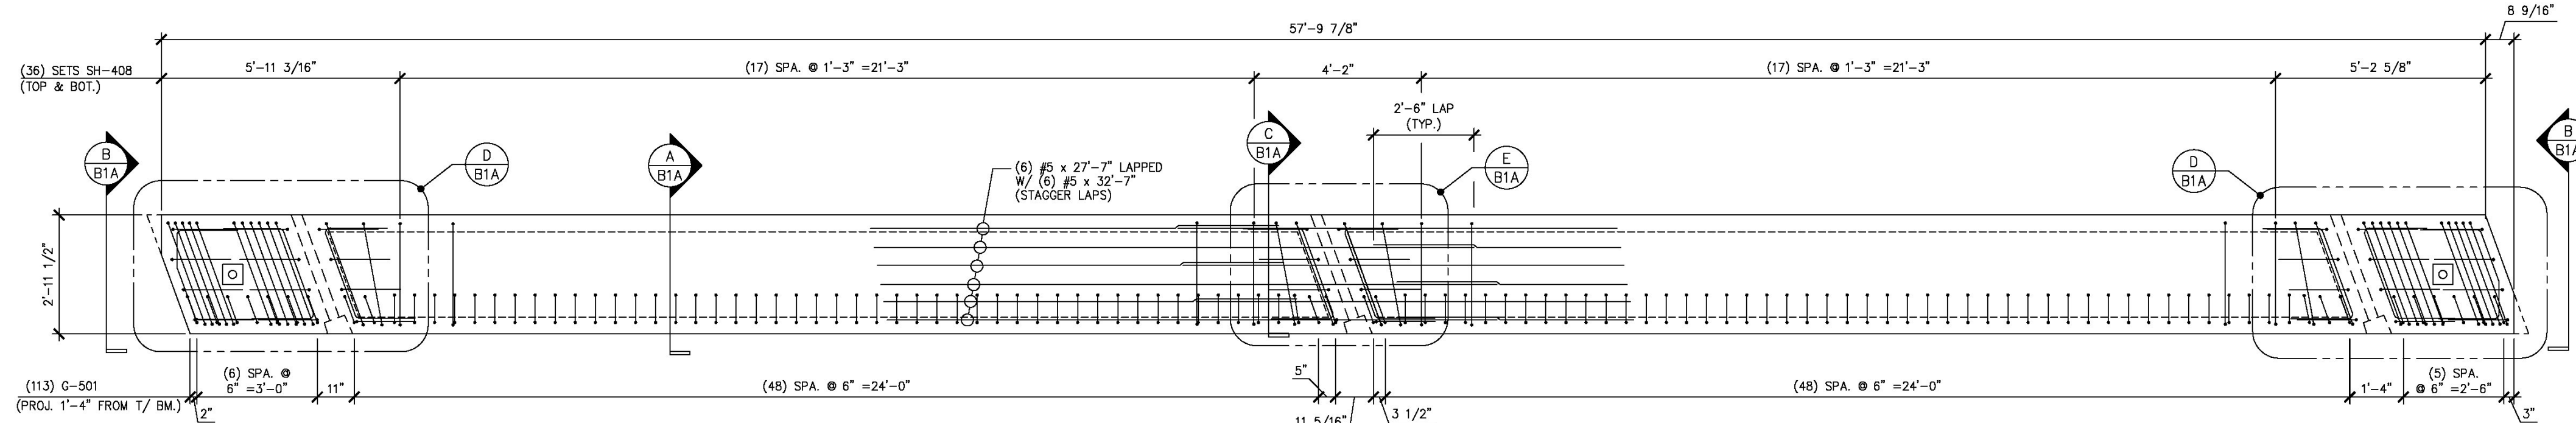


1 REINFORCING PLAN VIEW IN FORM  
B3A 3/8" = 1'-0"

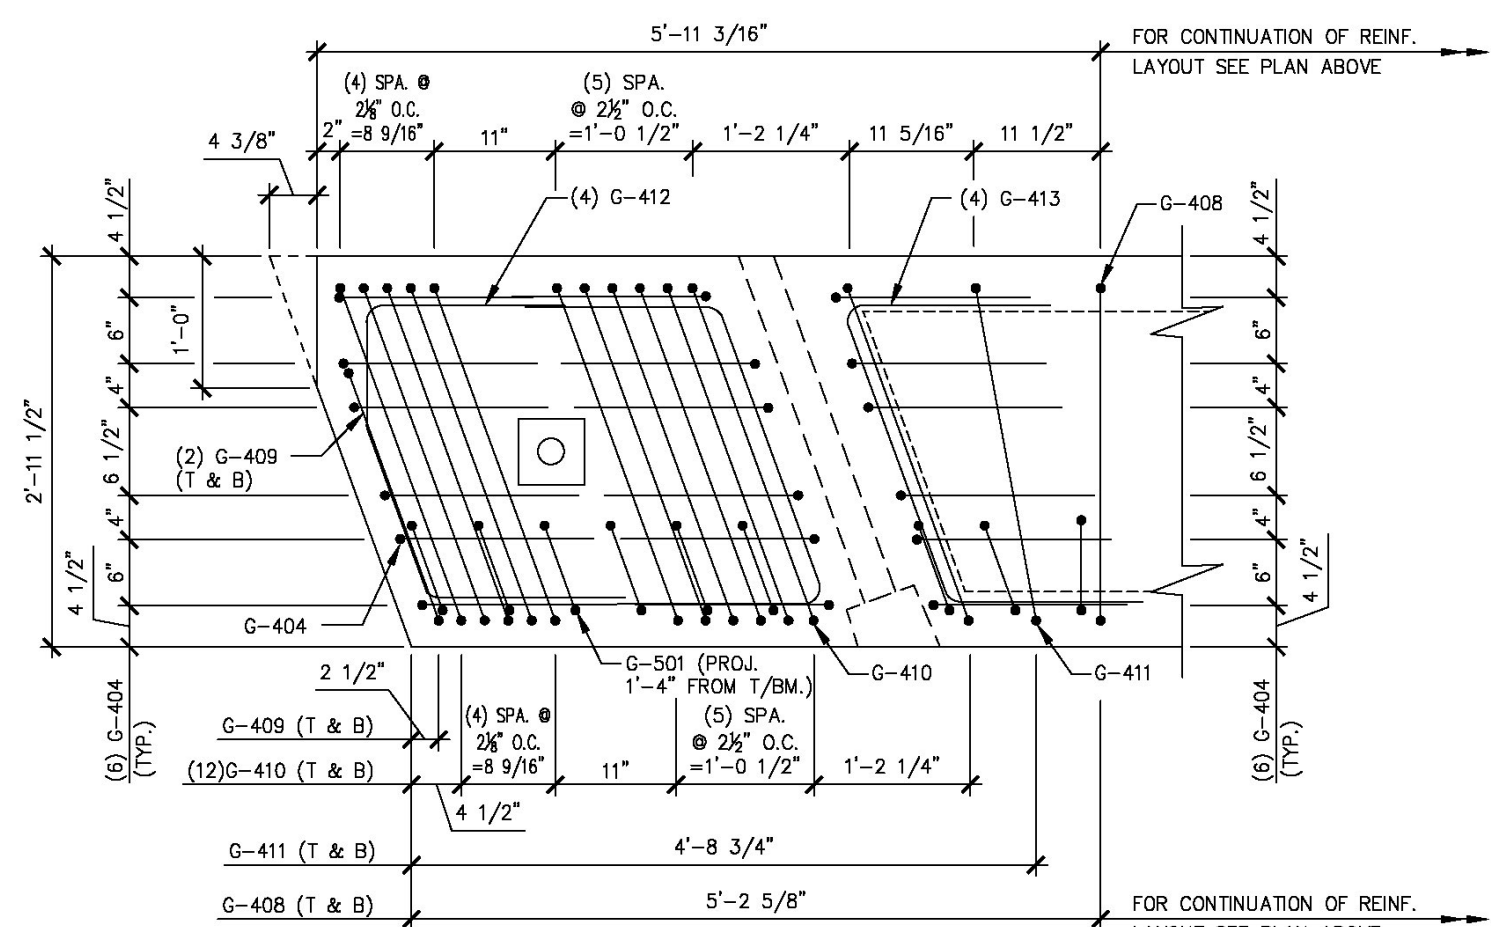

D END BLOCK REINFORCING PLAN  
B3A 3/4" = 1'-0"

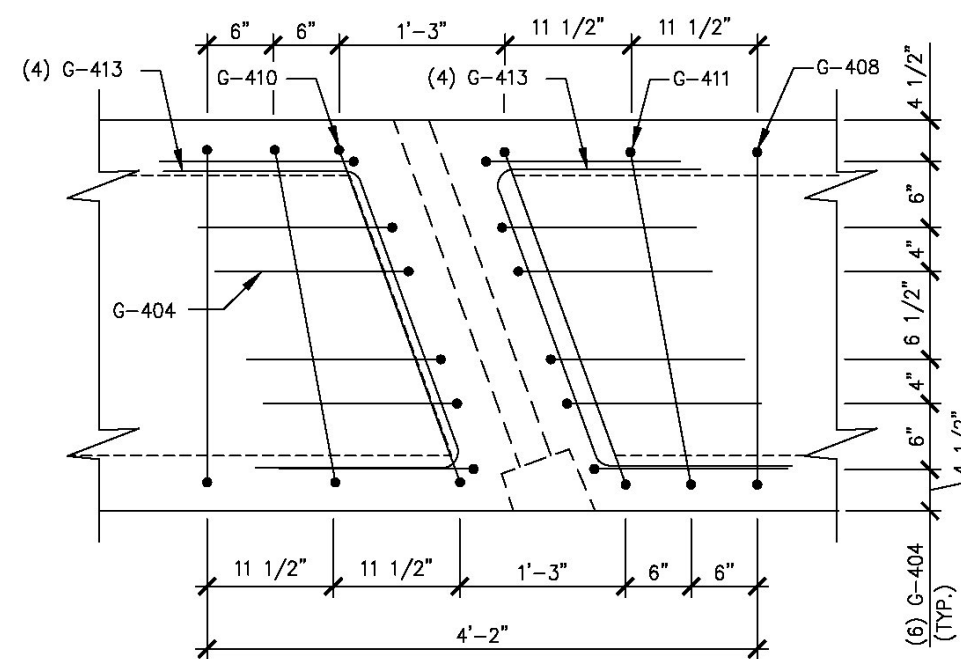

E P.T. DIAPHRAGM REINFORCING PLAN  
B3A 3/4" = 1'-0"

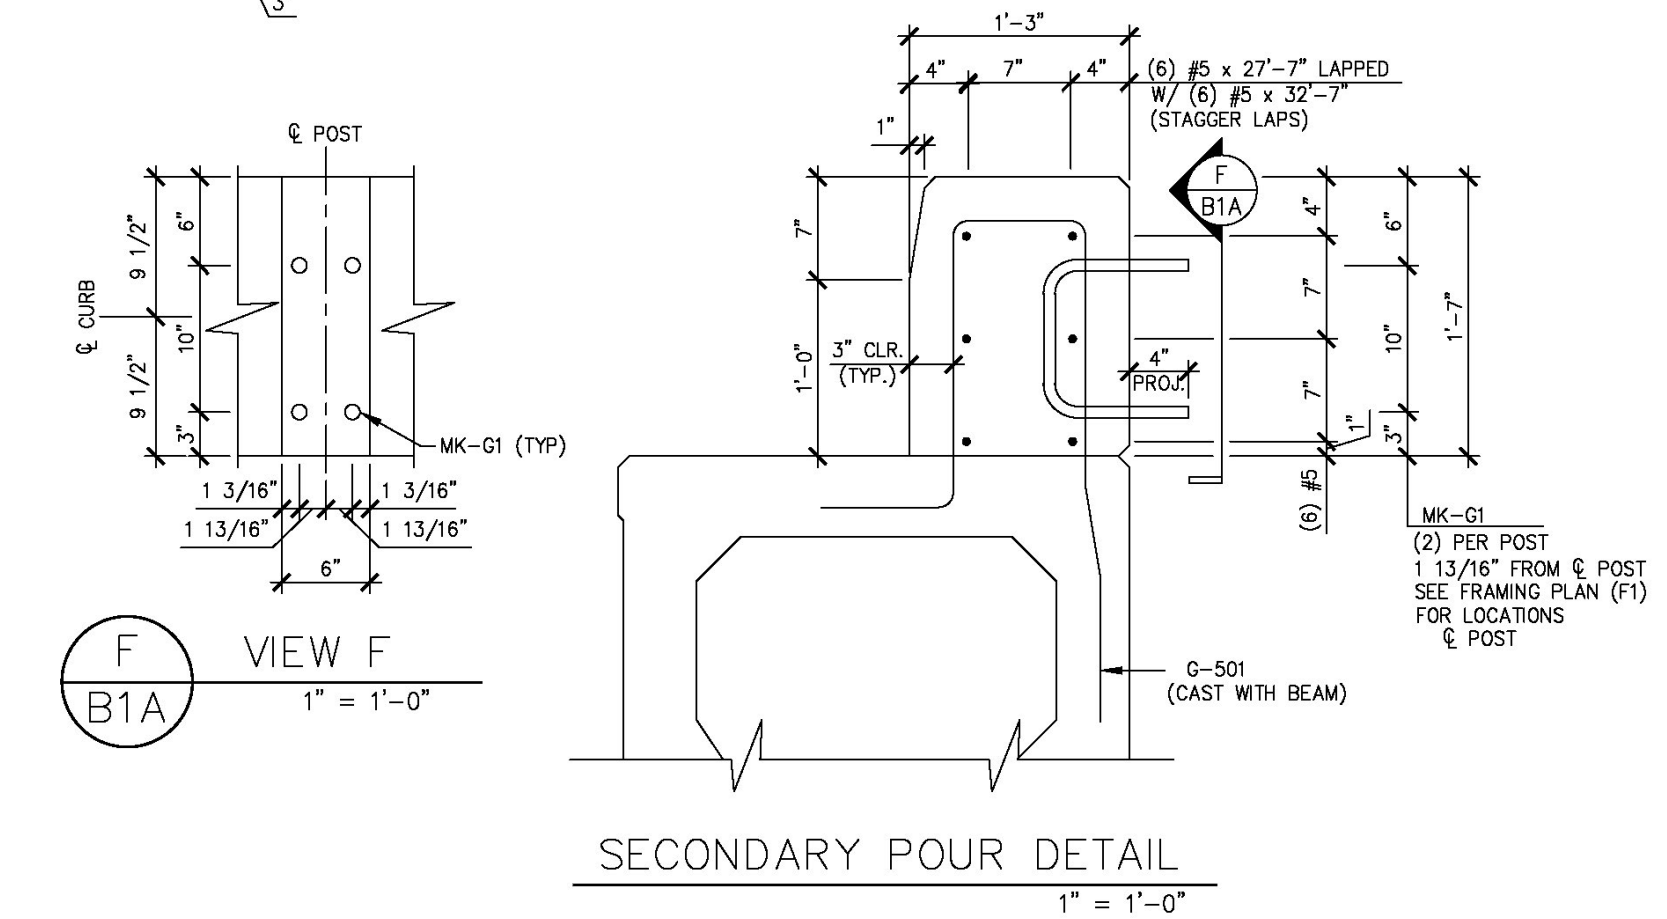

SECONDARY POUR DETAIL  
1" = 1'-0"

1 3 5 7 9 11 13 14 12 10 8 6 4 2

DETENSIONING SCHEDULE

N.T.S.

Vermont Agency of Transportation  
**RECEIVED**  
CK'D BY MJC OK'D BY TAS

June 18, 2014

RESUBMIT No Approved  
BY M. J. Chenette DATE 06/19/2014

**SHOP DRAWING REVIEW**

REVIEWED AS REQUIRED BY THE CONSTRUCTION CONTRACT DOCUMENTS AND APPROVED, BUT ONLY FOR CONFORMANCE TO THE DESIGN CONCEPT OF THE WORK, AND SUBJECT TO FURTHER LIMITATIONS AND REQUIREMENTS CONTAINED IN THE CONSTRUCTION CONTRACT DOCUMENTS

REJECTED  REVISE AND RESUBMIT  FURNISH AS CORRECTED

CORRECTIONS OR COMMENTS MADE ON THE SHOP DRAWINGS DURING THIS REVIEW DO NOT RELIEVE CONTRACTOR FROM COMPLIANCE WITH REQUIREMENTS OF THE DRAWINGS AND SPECIFICATIONS. THIS CHECK IS ONLY FOR REVIEW OF GENERAL CONFORMANCE WITH THE DESIGN CONCEPT OF THE PROJECT AND GENERAL COMPLIANCE WITH THE INFORMATION GIVEN IN THE CONTRACT DOCUMENTS. THE CONTRACTOR IS RESPONSIBLE FOR CONFIRMING AND CORRECTING ALL QUANTITIES AND DIMENSIONS, SELECTING FABRICATION PROCESSES AND TECHNIQUES OF CONSTRUCTION, COORDINATING HIS WORK WITH THAT OF ALL OTHER TRADES, AND PERFORMING HIS WORK IN A SAFE AND SATISFACTORY MANNER.


**Vanasse Hangen Brustlin, Inc.**  
7056 US Route 7  
North Ferrisburgh, VT 05473  
802.425.7788

Job Number: 57427.00  
Reviewed By: S.E. Burbank  
Date: 06/19/2014


MARK: G-B3 QTY.: 1

MATERIAL LIST / BEAM


ITEM	MARK	DESCRIPTION	QTY.
1	G-404	#4 BENT BAR (LEVEL II DUAL COATED)	48
2	G-408	#4 BENT BAR (LEVEL II DUAL COATED)	72
3	G-409	#4 BENT BAR (LEVEL II DUAL COATED)	4
4	G-410	#4 BENT BAR (LEVEL II DUAL COATED)	52
5	G-411	#4 BENT BAR (LEVEL II DUAL COATED)	8
6	G-412	#4 BENT BAR (LEVEL II DUAL COATED)	8
7	G-413	#4 BENT BAR (LEVEL II DUAL COATED)	24
8	G-501	#5 BENT BAR (LEVEL II DUAL COATED)	113
9			
10			
11			
12			
13			
14			
15			
16		#5 x 27'-7" (LEVEL II DUAL COATED)	12
17		#5 x 32'-7" (LEVEL II DUAL COATED)	12
18			
19			
20			
21			
22	MK-G1	1" ANCHOR "U" BOLTS (SUPPLIED BY OTHERS)	18
23			
24			
25			

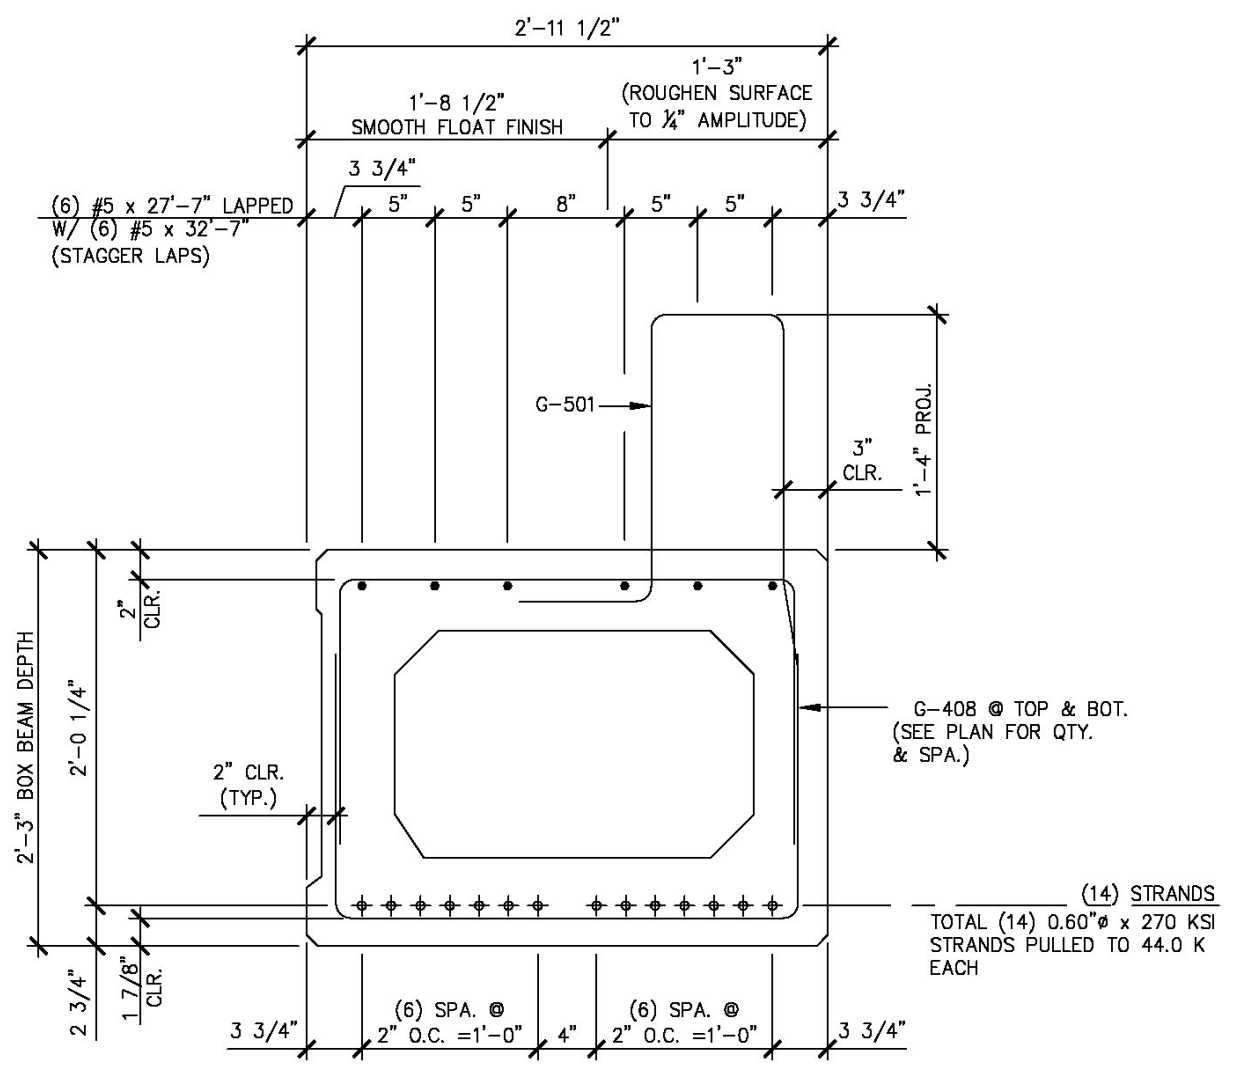

A REINFORCING SECTION  
B3A 1" = 1'-0"

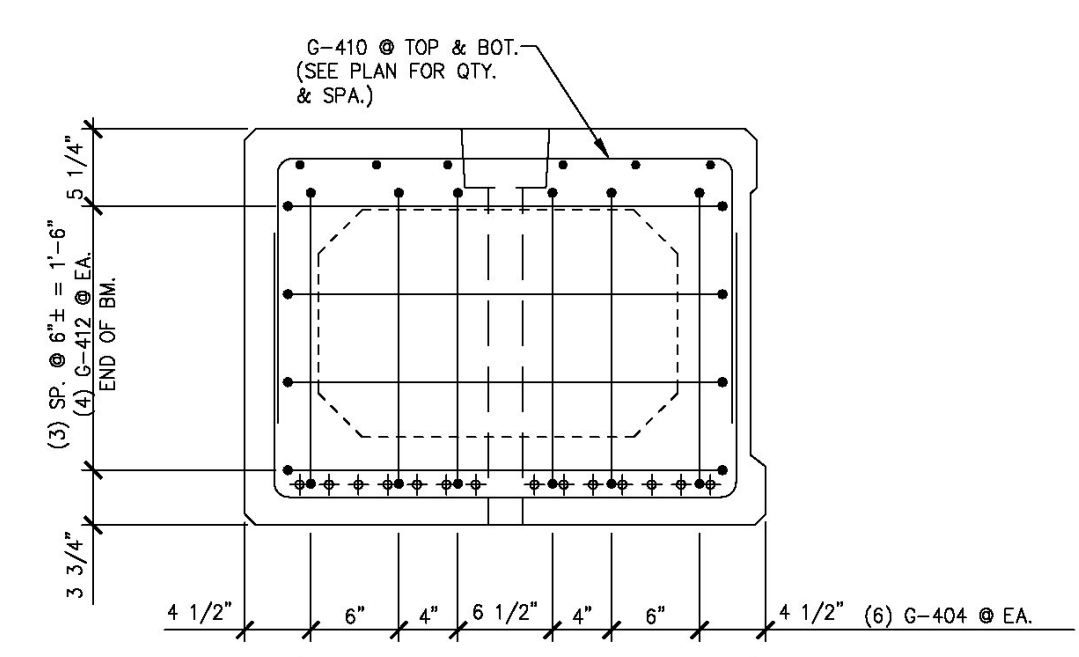

B END BLOCK REINF. SECTION  
B3A 1" = 1'-0"

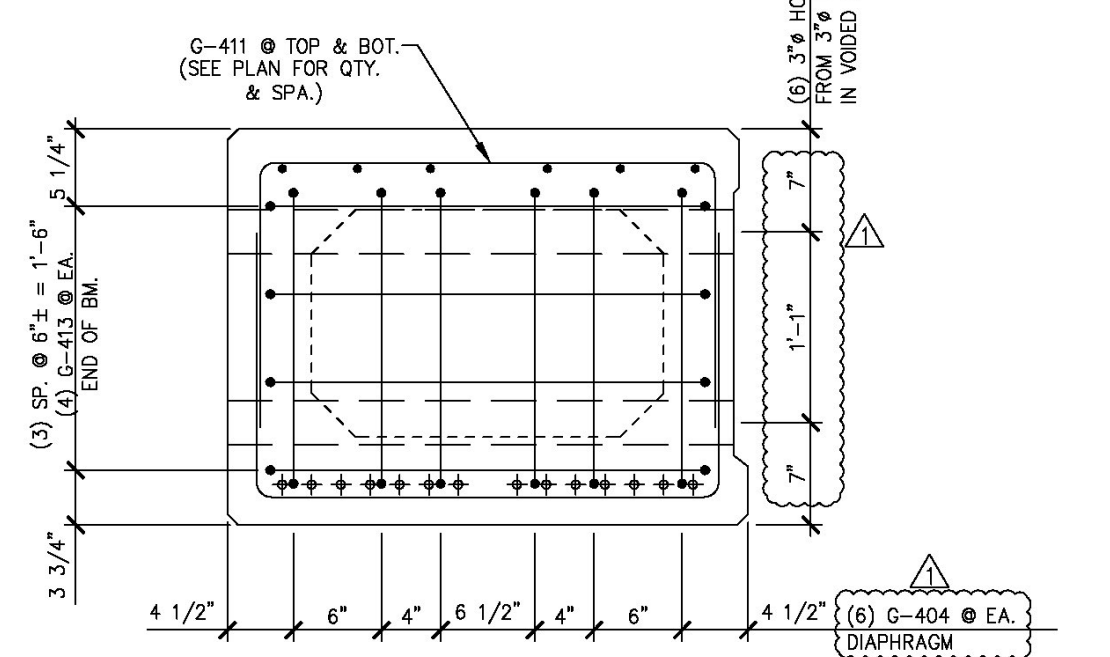

C P.T. DIAPHRAGM REINF. SECTION  
B3A 1" = 1'-0"

4-7-14 REVISED AS NOTED


APPROVAL STAMP:

J.P. CARRARA & SONS INC.  
Precast & Prestress Manufacturer N.T.S.  
244 OASE ST., MIDDLEBURY, VERMONT 05753 Phone:(802)388-6361 Fax:(802)388-9010

STATE OF VERMONT AGENCY OF TRANSPORTATION COUNTY OF WINDHAM	DATE: MAR. 04, 2014 SCALE: NOTED
TOWN OF GUILFORD ROUTE NO. T.H.10, CLASS III (LOCAL ROAD) BRIDGE NO.: 65 PROJECT NO.: BRO 1442 (36)	CHKD: JJ/KLT DFTM:AA1/RWS JOB NO: 23420-014
PRESTRESSED BOX BEAM REINFORCING DETAILS	DWG. NO: B3A

**Eriksson technologies**  
813.989.3317  
TAMPA, FL LRFD.COM  
© 2014 ERIKSSON TECHNOLOGIES, INC. ALL RIGHTS RESERVED

S:\Engineering Services\Carrara\116001 - Guilford Bridge 65\Production Drawings\AutoCAD Files\144236-AB.dwg, 5/16/2014 4:44:37 PM, DWG To PDF.pc3

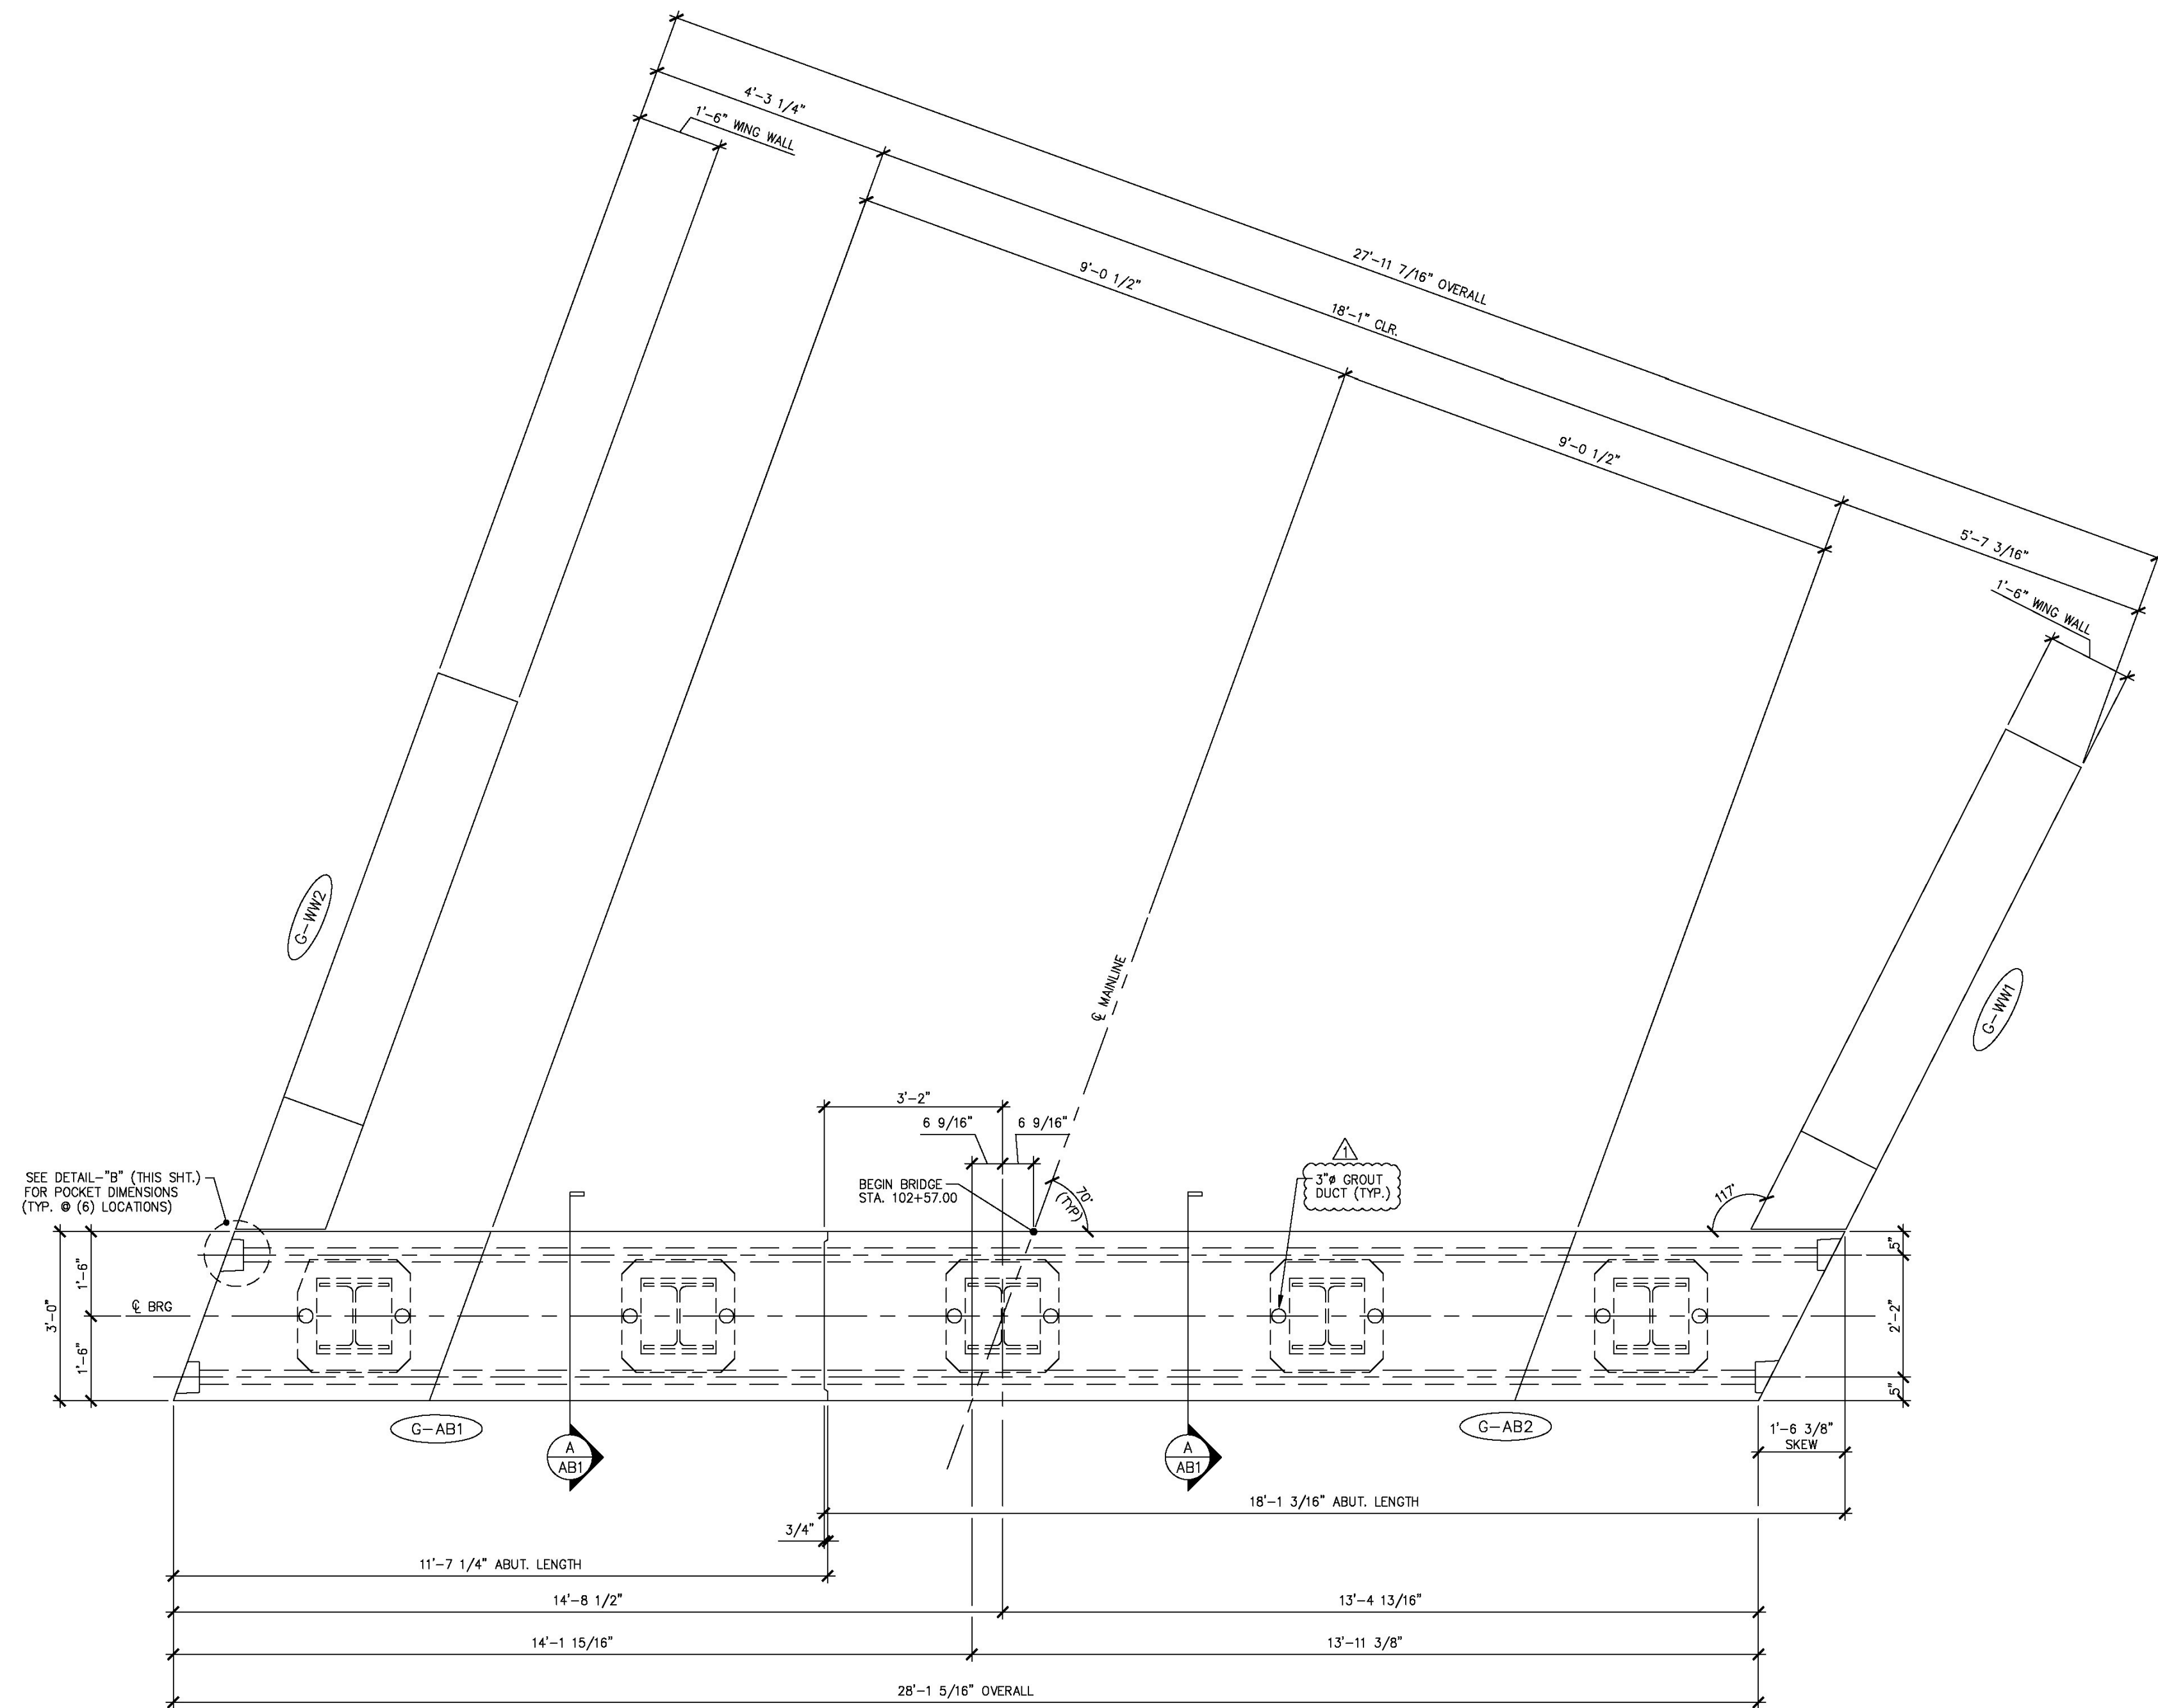

1 ABUTMENT ASSEMBLY PLAN  
1/4" = 1'-0"

Vermont Agency of Transportation  
**RECEIVED**  
Guilford 1442 (36) - Precast Submittal 003.pdf

CK'D BY MJC OK'D BY TAS

June 18, 2014

RESUBMIT No Approved  
BY M. J. Chenette DATE 06/19/2014

**SHOP DRAWING REVIEW**


REVIEWED AS REQUIRED BY THE CONSTRUCTION CONTRACT DOCUMENTS AND APPROVED, BUT ONLY FOR CONFORMANCE TO THE DESIGN CONCEPT OF THE WORK, AND SUBJECT TO FURTHER LIMITATIONS AND REQUIREMENTS CONTAINED IN THE CONSTRUCTION CONTRACT DOCUMENTS

REJECTED  REVISE AND RESUBMIT  FURNISH AS CORRECTED


CORRECTIONS OR COMMENTS MADE ON THE SHOP DRAWINGS DURING THIS REVIEW DO NOT RELIEVE CONTRACTOR FROM COMPLIANCE WITH REQUIREMENTS OF THE DRAWINGS AND SPECIFICATIONS. THIS CHECK IS ONLY FOR REVIEW OF GENERAL CONFORMANCE WITH THE DESIGN CONCEPT OF THE PROJECT AND GENERAL COMPLIANCE WITH THE INFORMATION GIVEN IN THE CONTRACT DOCUMENTS. THE CONTRACTOR IS RESPONSIBLE FOR CONFIRMING AND CORRELATING ALL QUANTITIES AND DIMENSIONS, SELECTING FABRICATION PROCESSES AND TECHNIQUES OF CONSTRUCTION, COORDINATING HIS WORK WITH THAT OF ALL OTHER TRADES, AND PERFORMING HIS WORK IN A SAFE AND SATISFACTORY MANNER.

**Vanasse Hangen Brustlin, Inc.**  
7056 US Route 7  
North Ferrisburgh, VT 05473  
802-425-7789

Job Number: 57427.00  
Reviewed By: S.E. Burbank  
Date: 06/19/2014

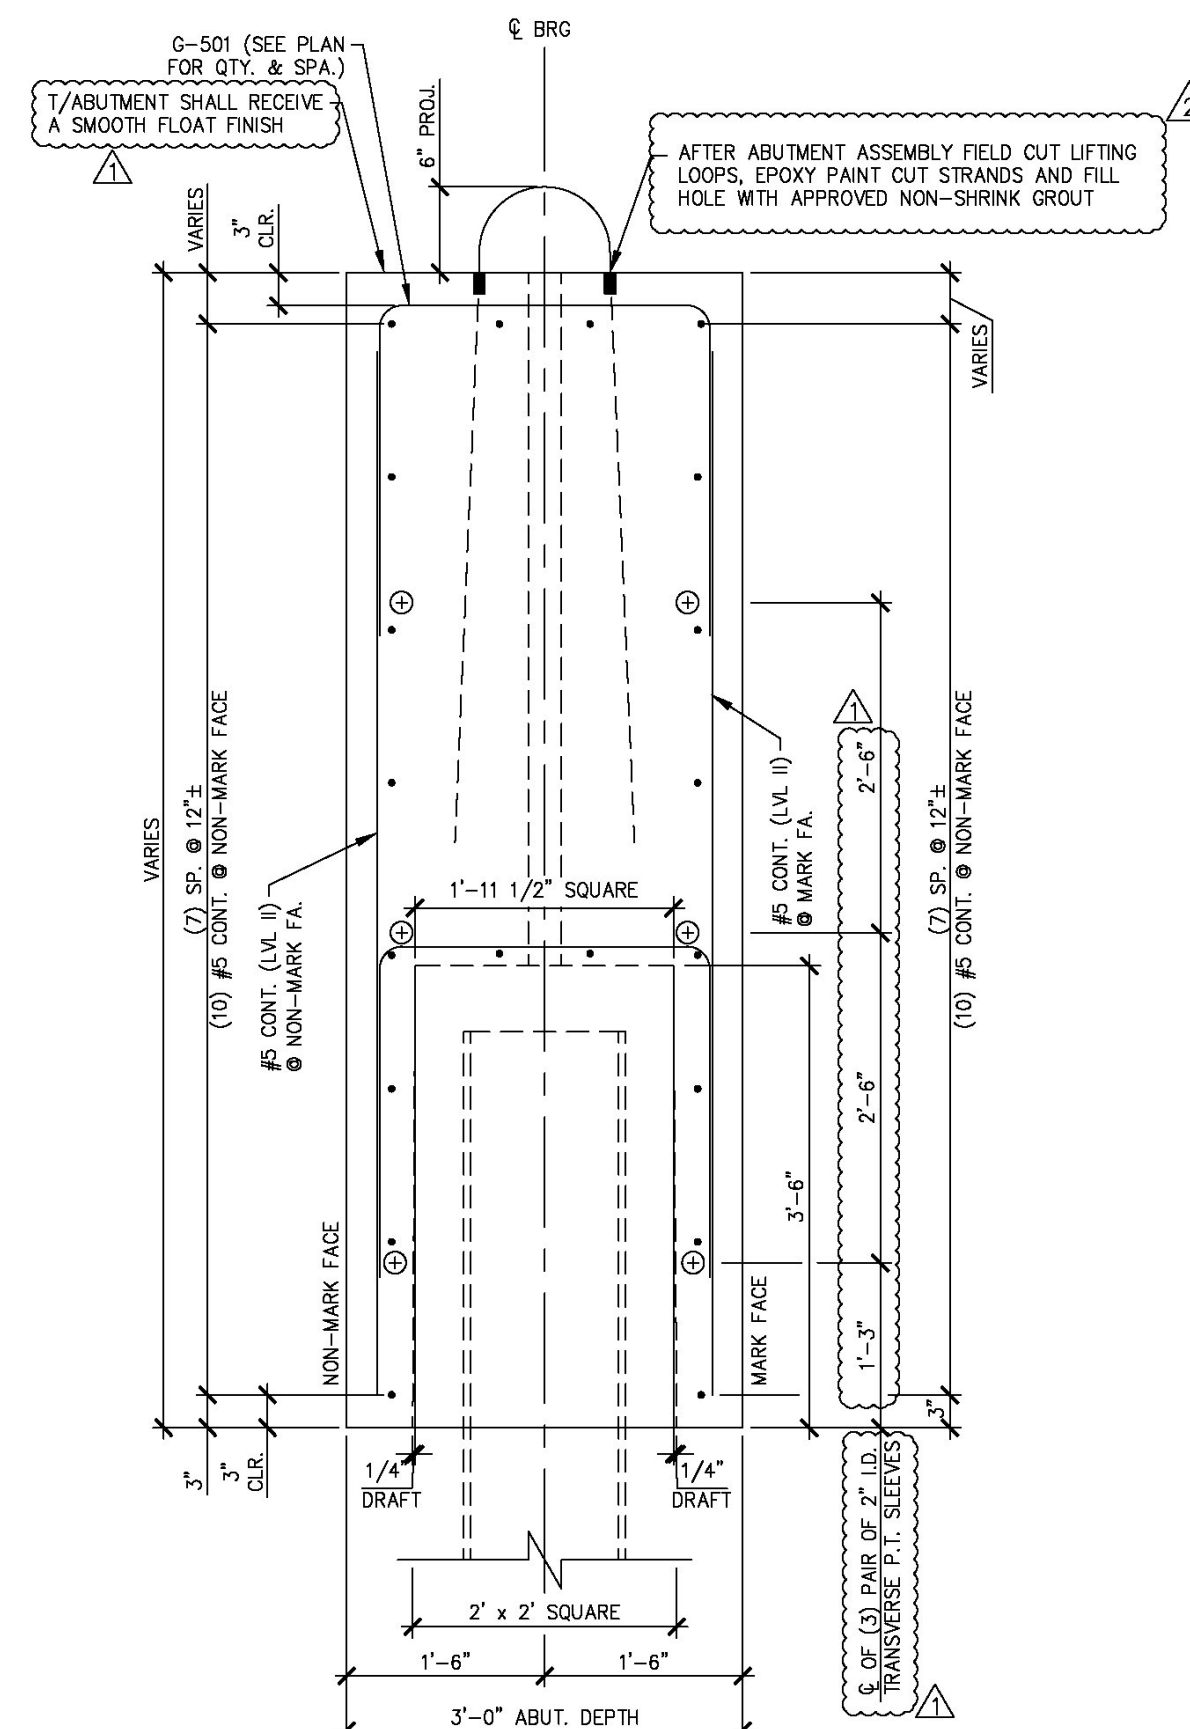

A ABUTMENT SECTION  
1/4" = 1'-0"

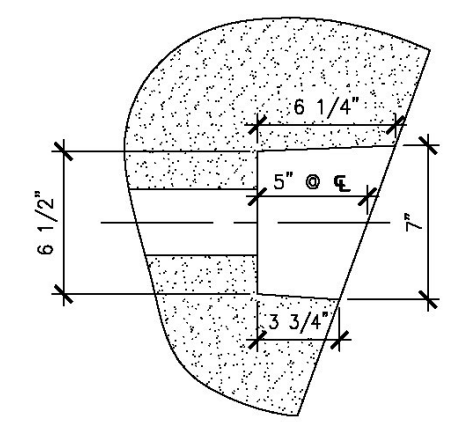

DETAIL - "B"  
1 1/2" = 1'-0"


4-7-14 REVISED AS NOTED  
5-6-14 REVISED AS NOTED

APPROVAL STAMP:		<b>J.P. CARRARA &amp; SONS INC.</b> Precast & Prestress Manufacturer N.T.S. 244 CASE ST., MIDDLEBURY, VERMONT 05753 Phone:(802)388-6361 Fax:(802)388-9010	
STATE OF VERMONT AGENCY OF TRANSPORTATION COUNTY OF WINDHAM		DATE: MAR. 04, 2014	SCALE: NOTED
TOWN OF GUILFORD ROUTE NO. T.H.10, CLASS III (LOCAL ROAD) BRIDGE NO.: 65 PROJECT NO.: BRO 1442 (36)		CHKD: JJ/KLT	DFTM: AAT/RWS
PRECAST ABUTMENT DETAILS		JOB NO: 23420-014	DWG. NO: AB1


**Eriksson technologies**  
813.989.3317  
TAMPA, FL LRFD.COM  
© 2014 ERIKSSON TECHNOLOGIES, INC. ALL RIGHTS RESERVED



S:\Engineering Services\Carrara\14001 - Guilford Bridge 65\Production Drawings\AutoCAD Files\144236-AB.dwg, 5/16/2014 4:44:38 PM, DWG To PDF.pc3

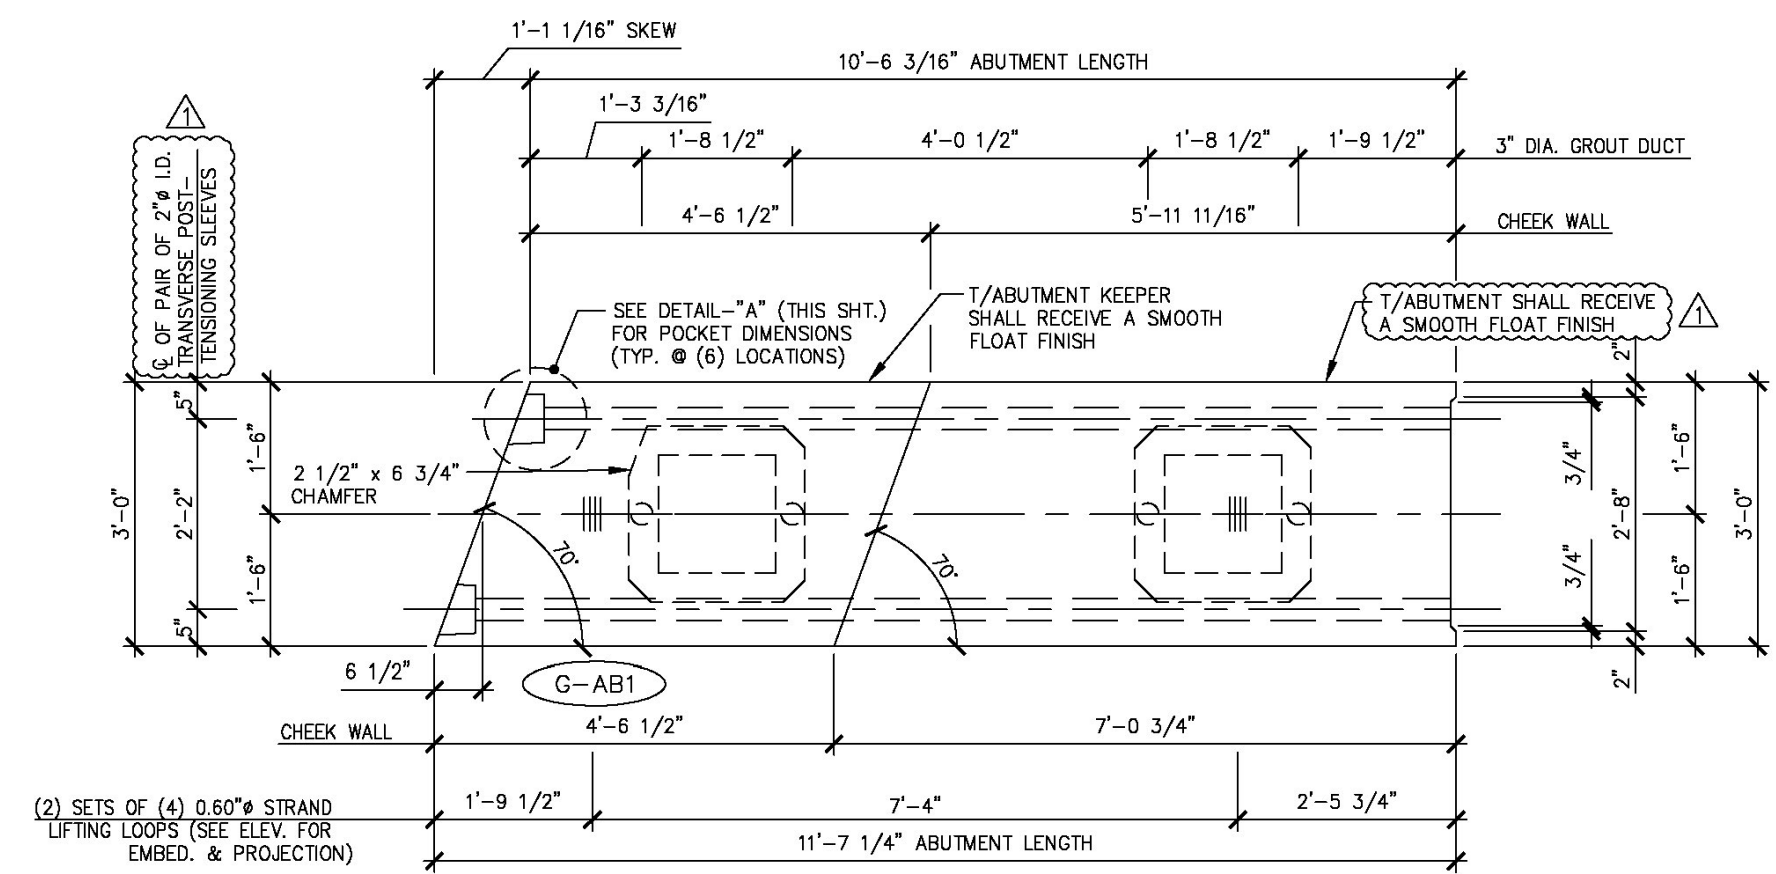


1 ABUTMENT DIMENSIONAL PLAN VIEW IN FORM  
AB3 1/2" = 1'-0"

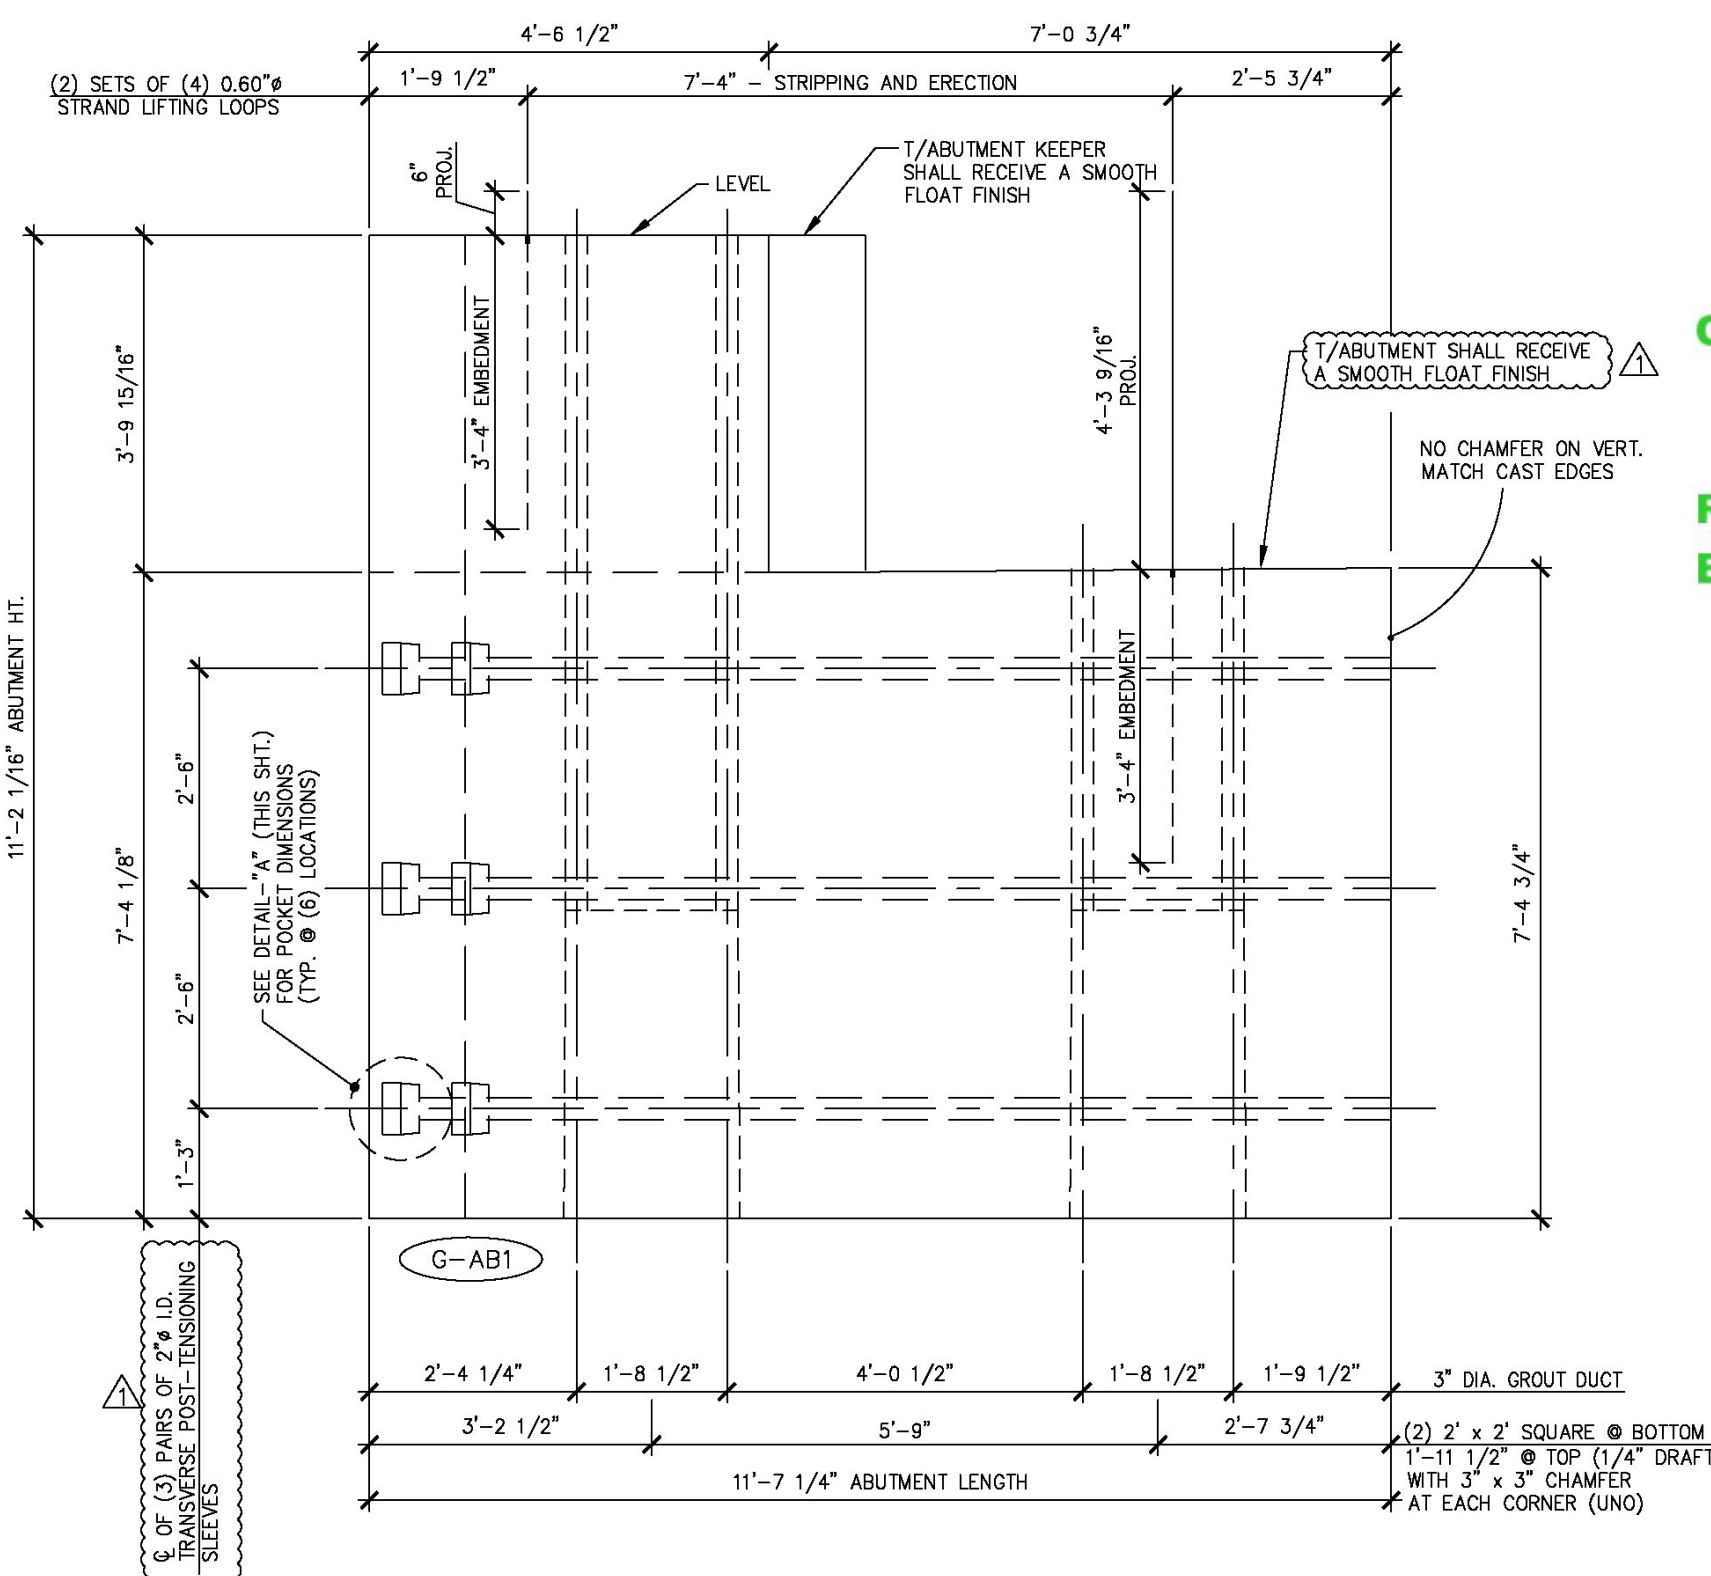

2 ABUTMENT DIMENSIONAL MARK FACE ELEVATION  
AB3 1/2" = 1'-0"

SHOP NOTE:  
ALL EDGES OF ABUTMENT SHALL  
RECEIVE A 1" CHAMFER (U.N.O.)

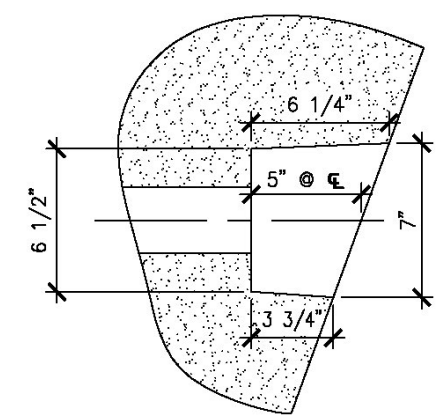

DETAIL - "A"  
1 1/2" = 1'-0"

Vermont Agency of Transportation  
**RECEIVED**

CK'D BY MJC OK'D BY TAS  
June 18, 2014  
RESUBMIT No Approved  
BY M. J. Chenette DATE 06/19/2014

**SHOP DRAWING REVIEW**


REVIEWED AS REQUIRED BY THE CONSTRUCTION CONTRACT DOCUMENTS AND APPROVED, BUT ONLY FOR CONFORMANCE TO THE DESIGN CONCEPT OF THE WORK, AND SUBJECT TO FURTHER LIMITATIONS AND REQUIREMENTS CONTAINED IN THE CONSTRUCTION CONTRACT DOCUMENTS.

REJECTED  REVISE AND RESUBMIT  FURNISH AS CORRECTED


CORRECTIONS OR COMMENTS MADE ON THE SHOP DRAWINGS DURING THIS REVIEW DO NOT RELIEVE CONTRACTOR FROM COMPLIANCE WITH REQUIREMENTS OF THE DRAWINGS AND SPECIFICATIONS. THIS CHECK IS ONLY FOR REVIEW OF GENERAL CONFORMANCE WITH THE DESIGN CONCEPT OF THE PROJECT AND GENERAL COMPLIANCE WITH THE REQUIREMENTS GIVEN IN THE CONTRACT DOCUMENTS. THE CONTRACTOR IS RESPONSIBLE FOR CONFIRMING AND CORRELATING ALL QUANTITIES AND DIMENSIONS, SELECTING FABRICATOR PROCESSES AND TECHNIQUES OF CONSTRUCTION, COORDINATING HIS WORK WITH THAT OF ALL OTHER TRADES, AND PERFORMING HIS WORK IN A SAFE AND SATISFACTORY MANNER.

**VHB Vanasse Hangen Brustlin, Inc.**  
7056 US Route 7  
North Ferrisburgh, VT 05473  
802.425.7788

Job Number: 57427.00  
Reviewed By: S.E. Burbank  
Date: 06/19/2014

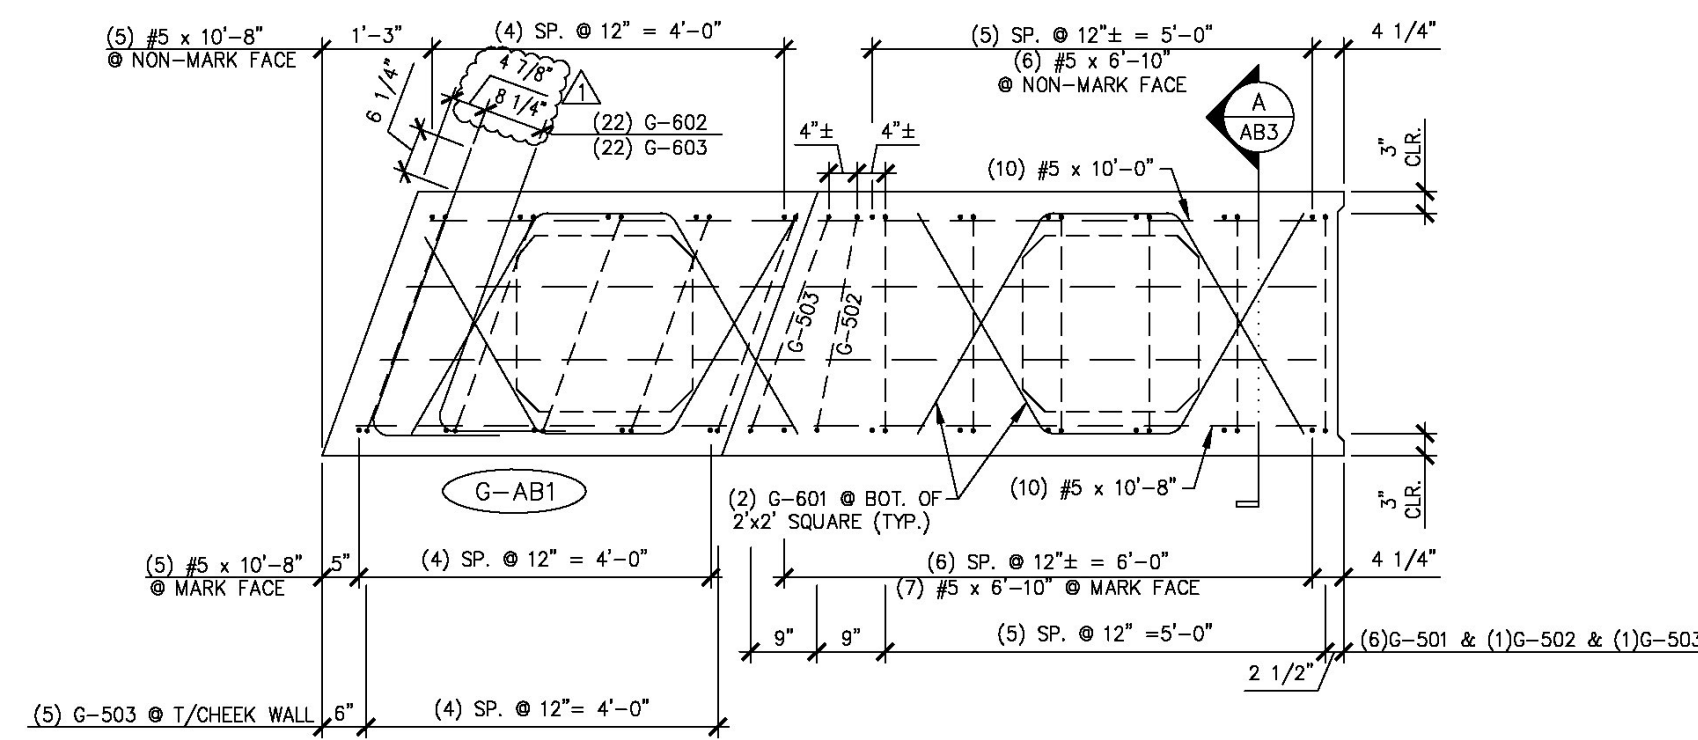

3 ABUTMENT REINFORCING PLAN VIEW IN FORM  
AB3 1/2" = 1'-0"

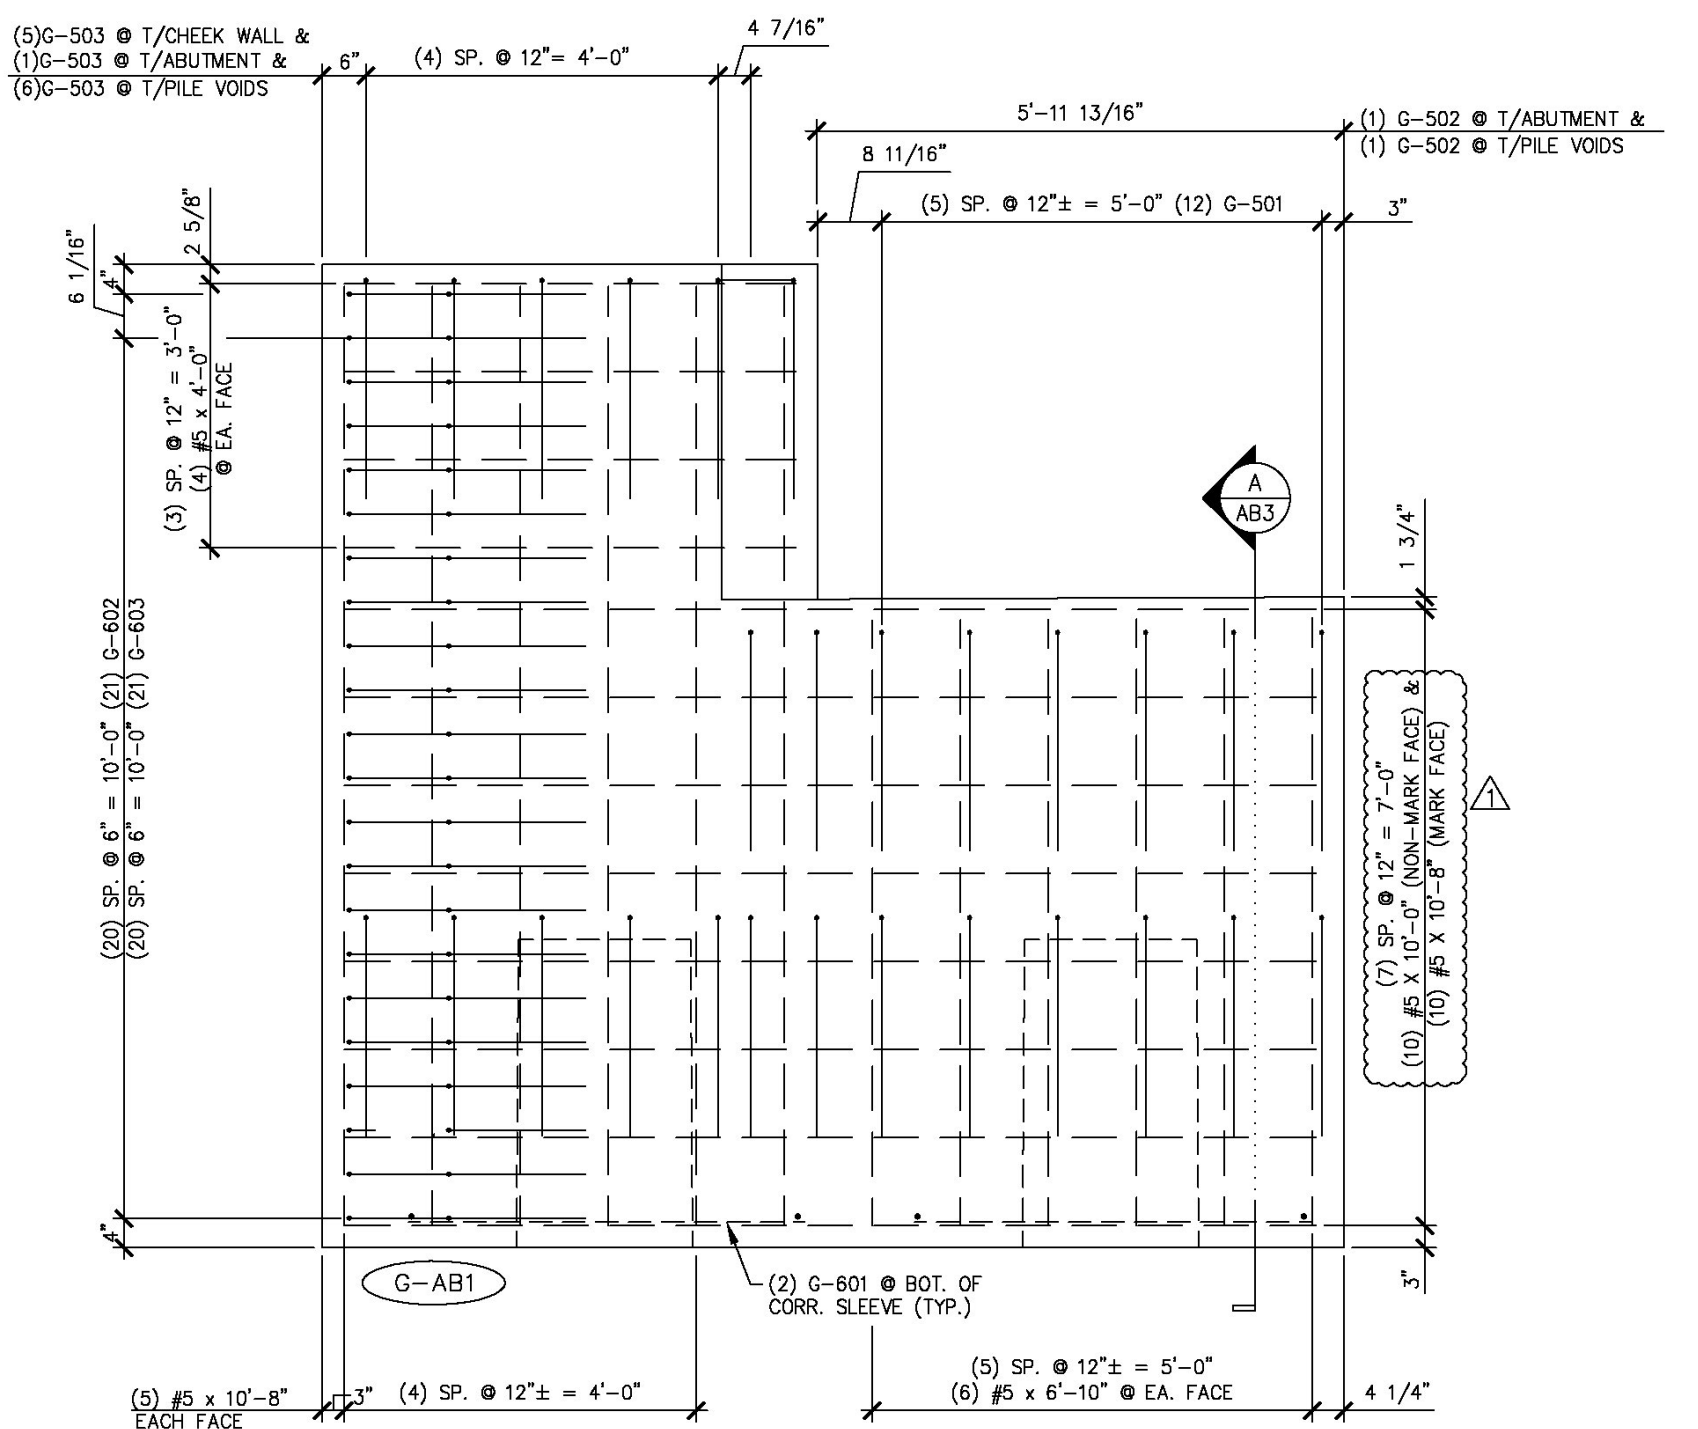

4 ABUTMENT REINFORCING MARK FACE ELEVATION  
AB3 1/2" = 1'-0"

4-7-14 REVISED AS NOTED  
5-6-14 REVISED AS NOTED

APPROVAL STAMP:


**J.P. CARRARA & SONS INC.**  
Precast & Prestress Manufacturer N.T.S.  
244 OASE STR., MIDDLEBURY, VERMONT 05753 Phone:(802)388-6361 Fax:(802)388-9010

STATE OF VERMONT AGENCY OF TRANSPORTATION  
COUNTY OF WINDHAM  
TOWN OF GUILFORD  
ROUTE NO. T.H.10, CLASS III (LOCAL ROAD)  
BRIDGE NO.: 65 PROJECT NO.: BRO 1442 (36)

DATE: MAR. 04, 2014  
SCALE: NOTED  
CHKD: JJ/KLT DFTM:AA1/RWS  
JOB NO: 23420-014


PRECAST ABUTMENT DETAILS  
DWG. NO: AB3

MATERIAL LIST / ABUTMENT				
ITEM	MARK	DESCRIPTION	QTY.	
1	G-501	#5 BENT BAR	12	
2	G-502	#5 BENT BAR	2	
3	G-503	#5 BENT BAR	12	
4		#5 x 4'-0"	10	
5		#5 x 6'-10"	12	
6		#5 x 10'-0"	10	
7		#5 x 10'-8"	20	
8				
9	G-601	#6 BENT BAR	4	
10	G-602	#6 BENT BAR	22	
11	G-603	#6 BENT BAR	22	
12				
13				
14				
15				
16				
17				
18		SET OF (4) 0.60" x 270 KSI STRAND LIFTING LOOPS	2	
19				
20				

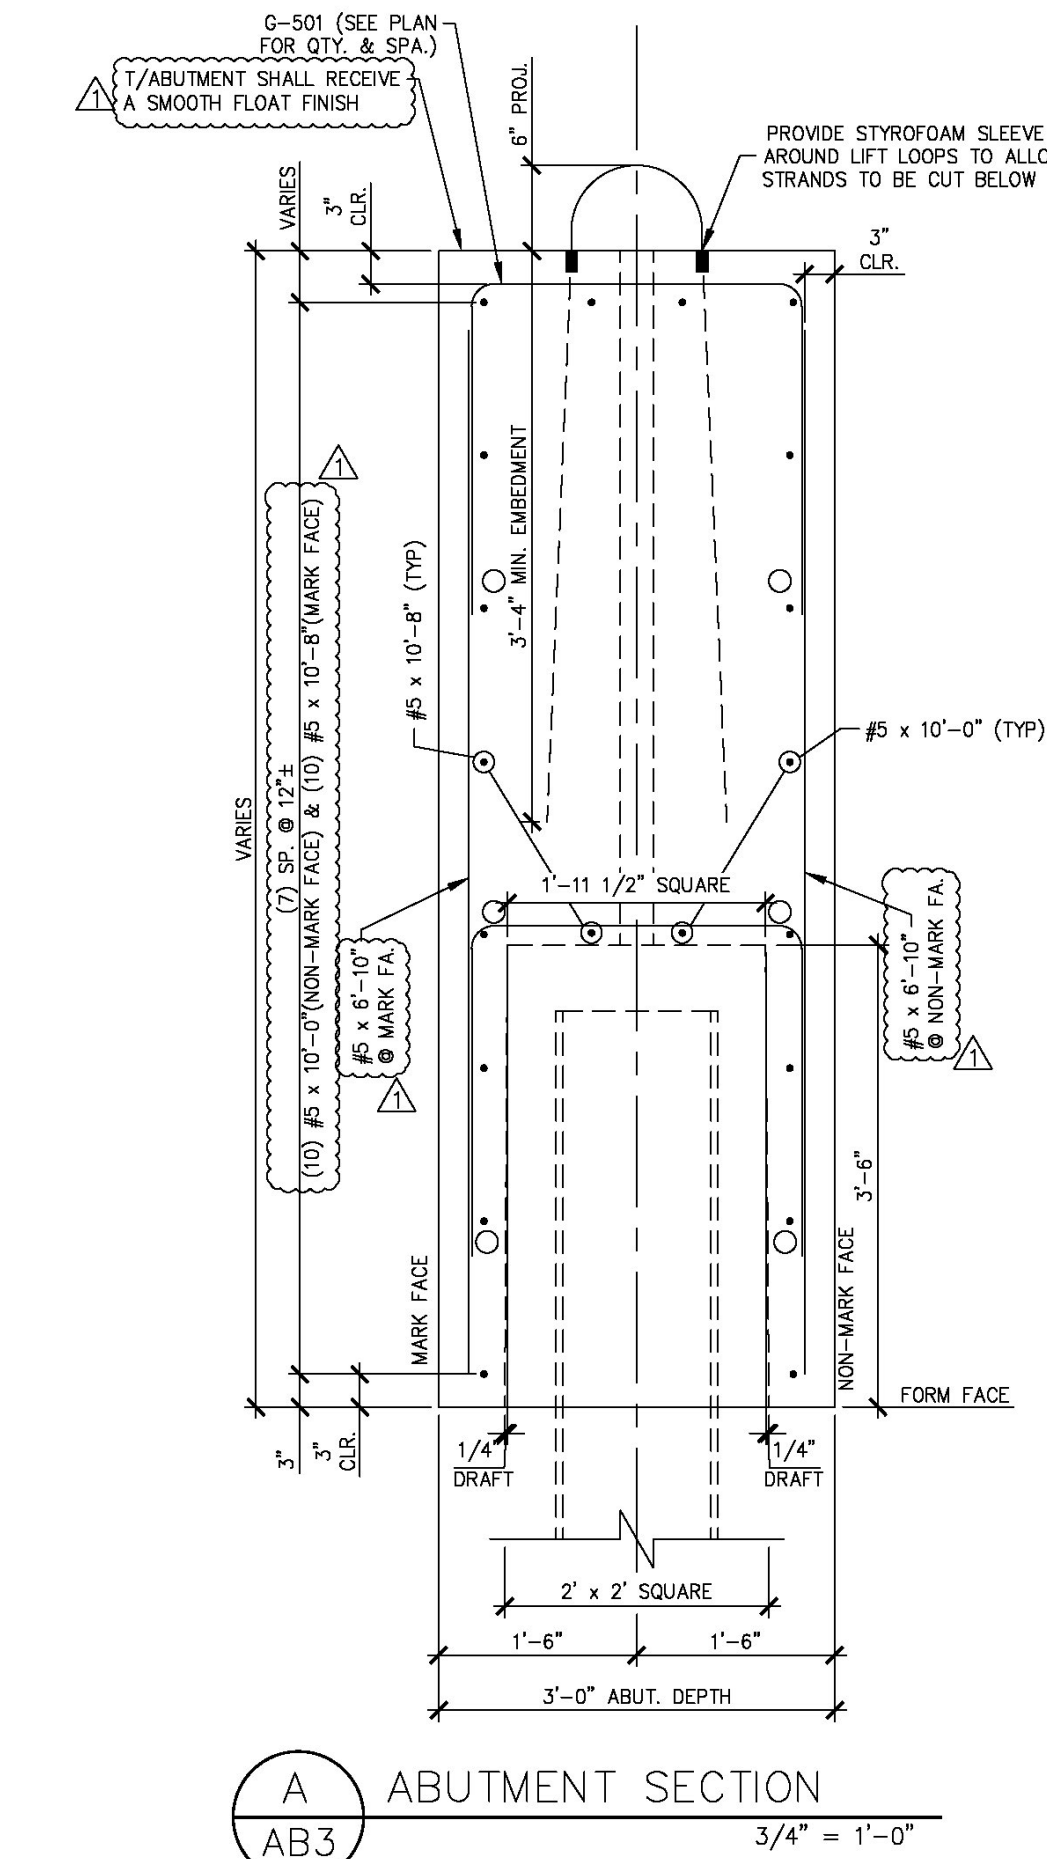


A ABUTMENT SECTION  
AB3 3/4" = 1'-0"

S:\Engineering Services\Carrara\14001 - Guilford Bridge 65\Production Drawings\AutoCAD Files\144236-AB.dwg, 5/16/2014 4:44:38 PM, DWG To PDF.pc3

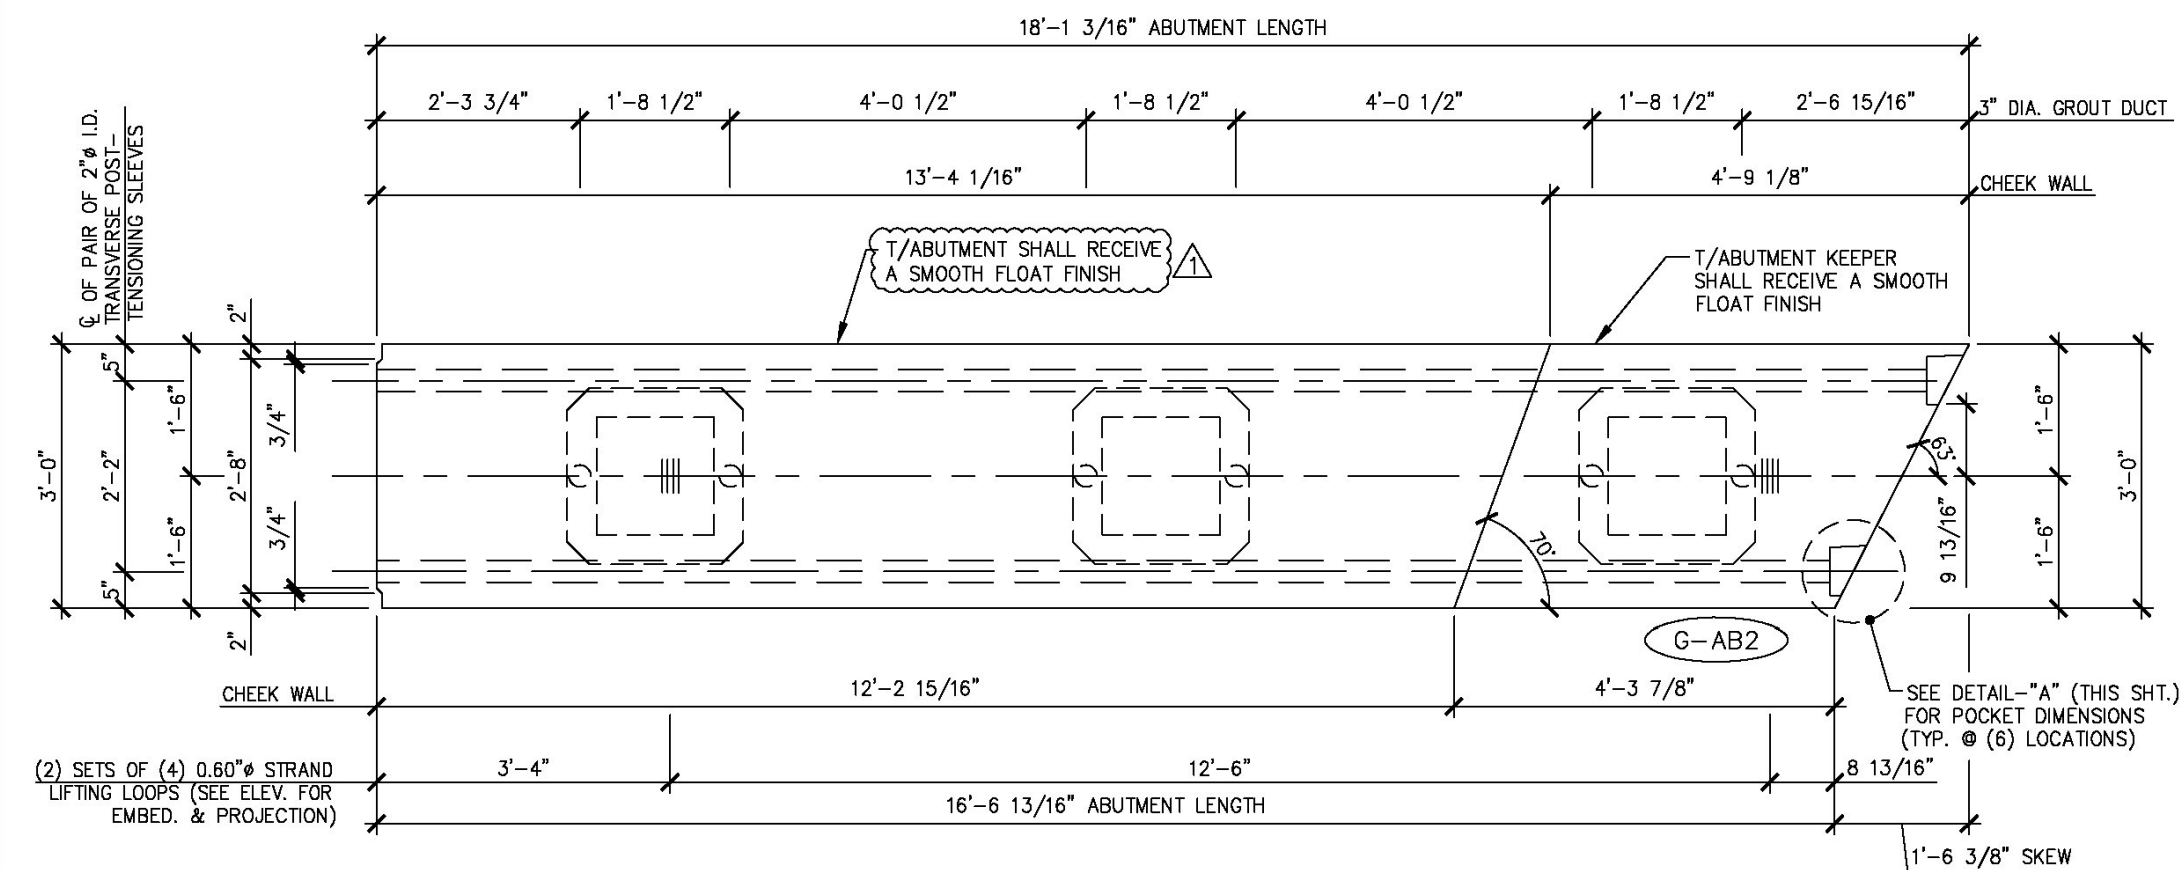


1 ABUTMENT DIMENSIONAL PLAN VIEW IN FORM  
AB4 1/2" = 1'-0"


NOTE: PILE VOIDS TO BE FORMED WITH REMOVABLE FORMWORK.

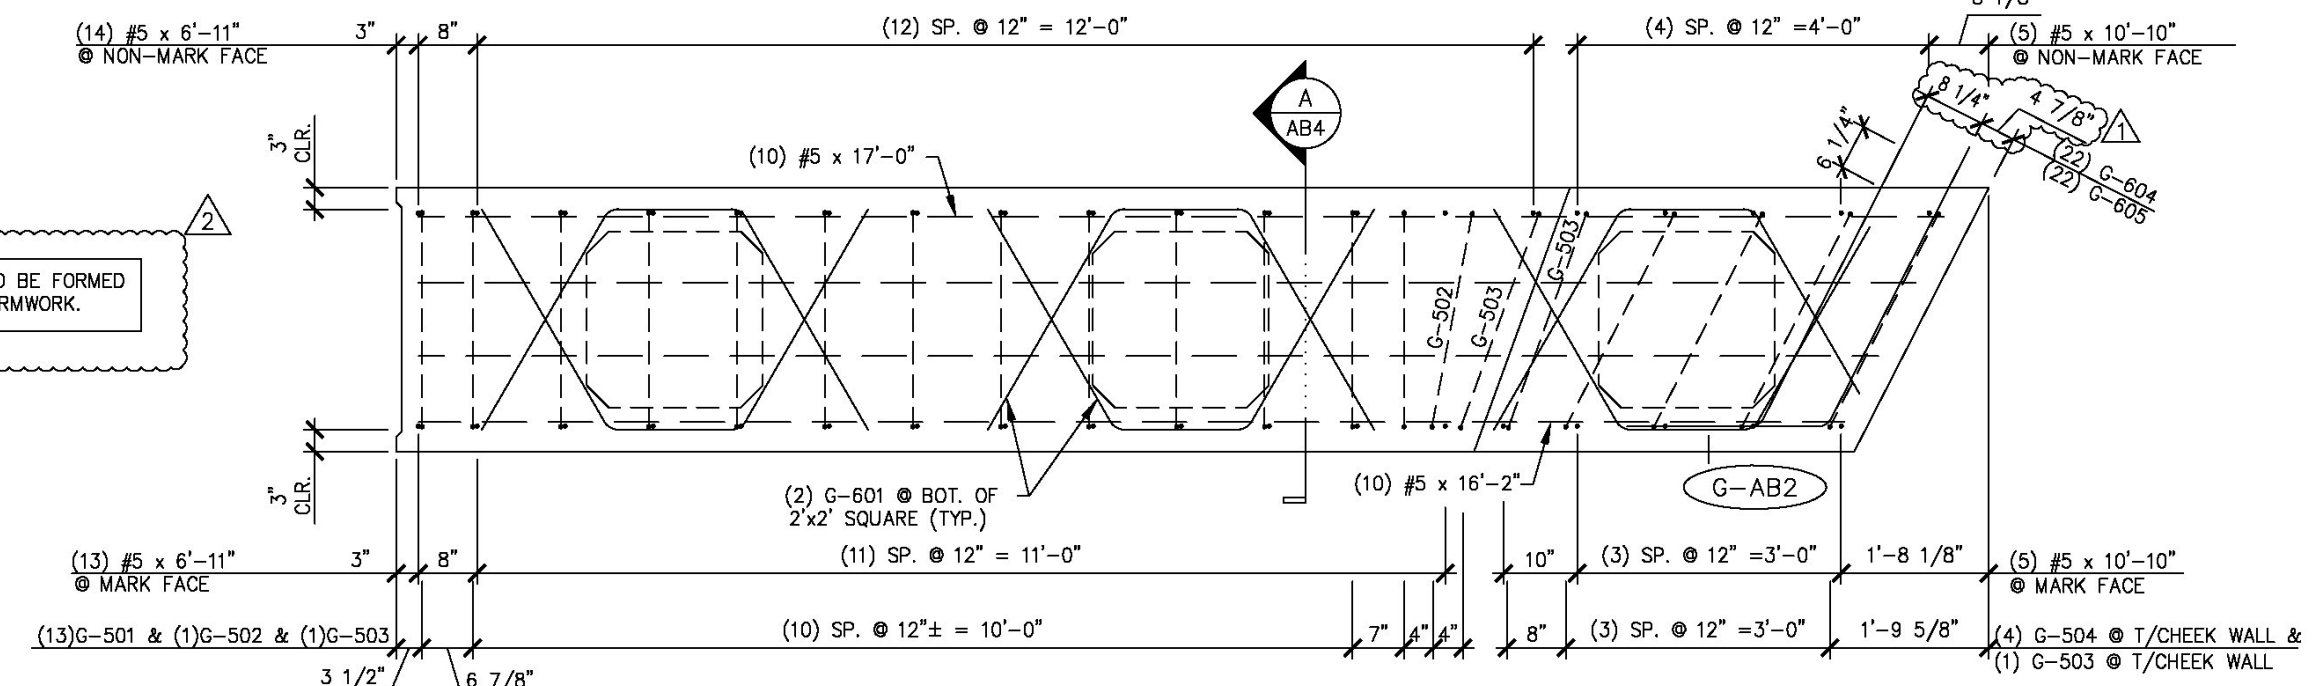


3 ABUTMENT REINFORCING PLAN VIEW IN FORM  
AB4 1/2" = 1'-0"

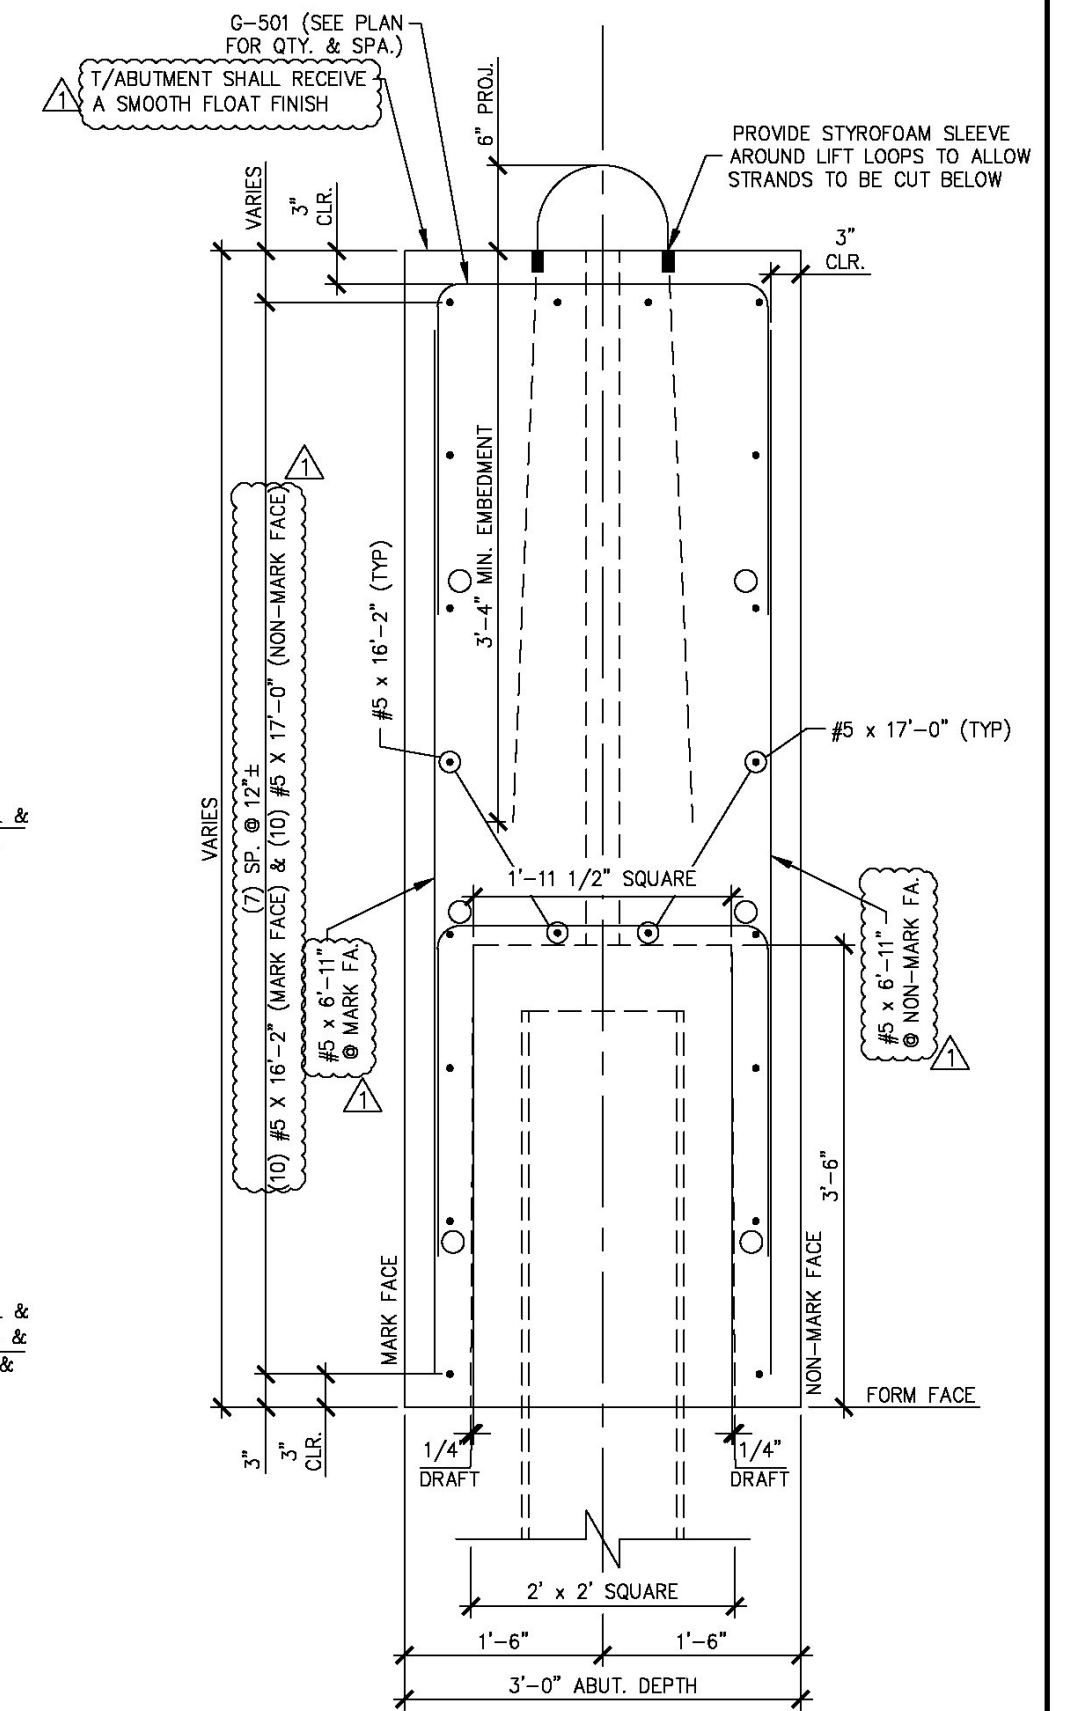

A ABUTMENT SECTION  
AB4 3/4" = 1'-0"

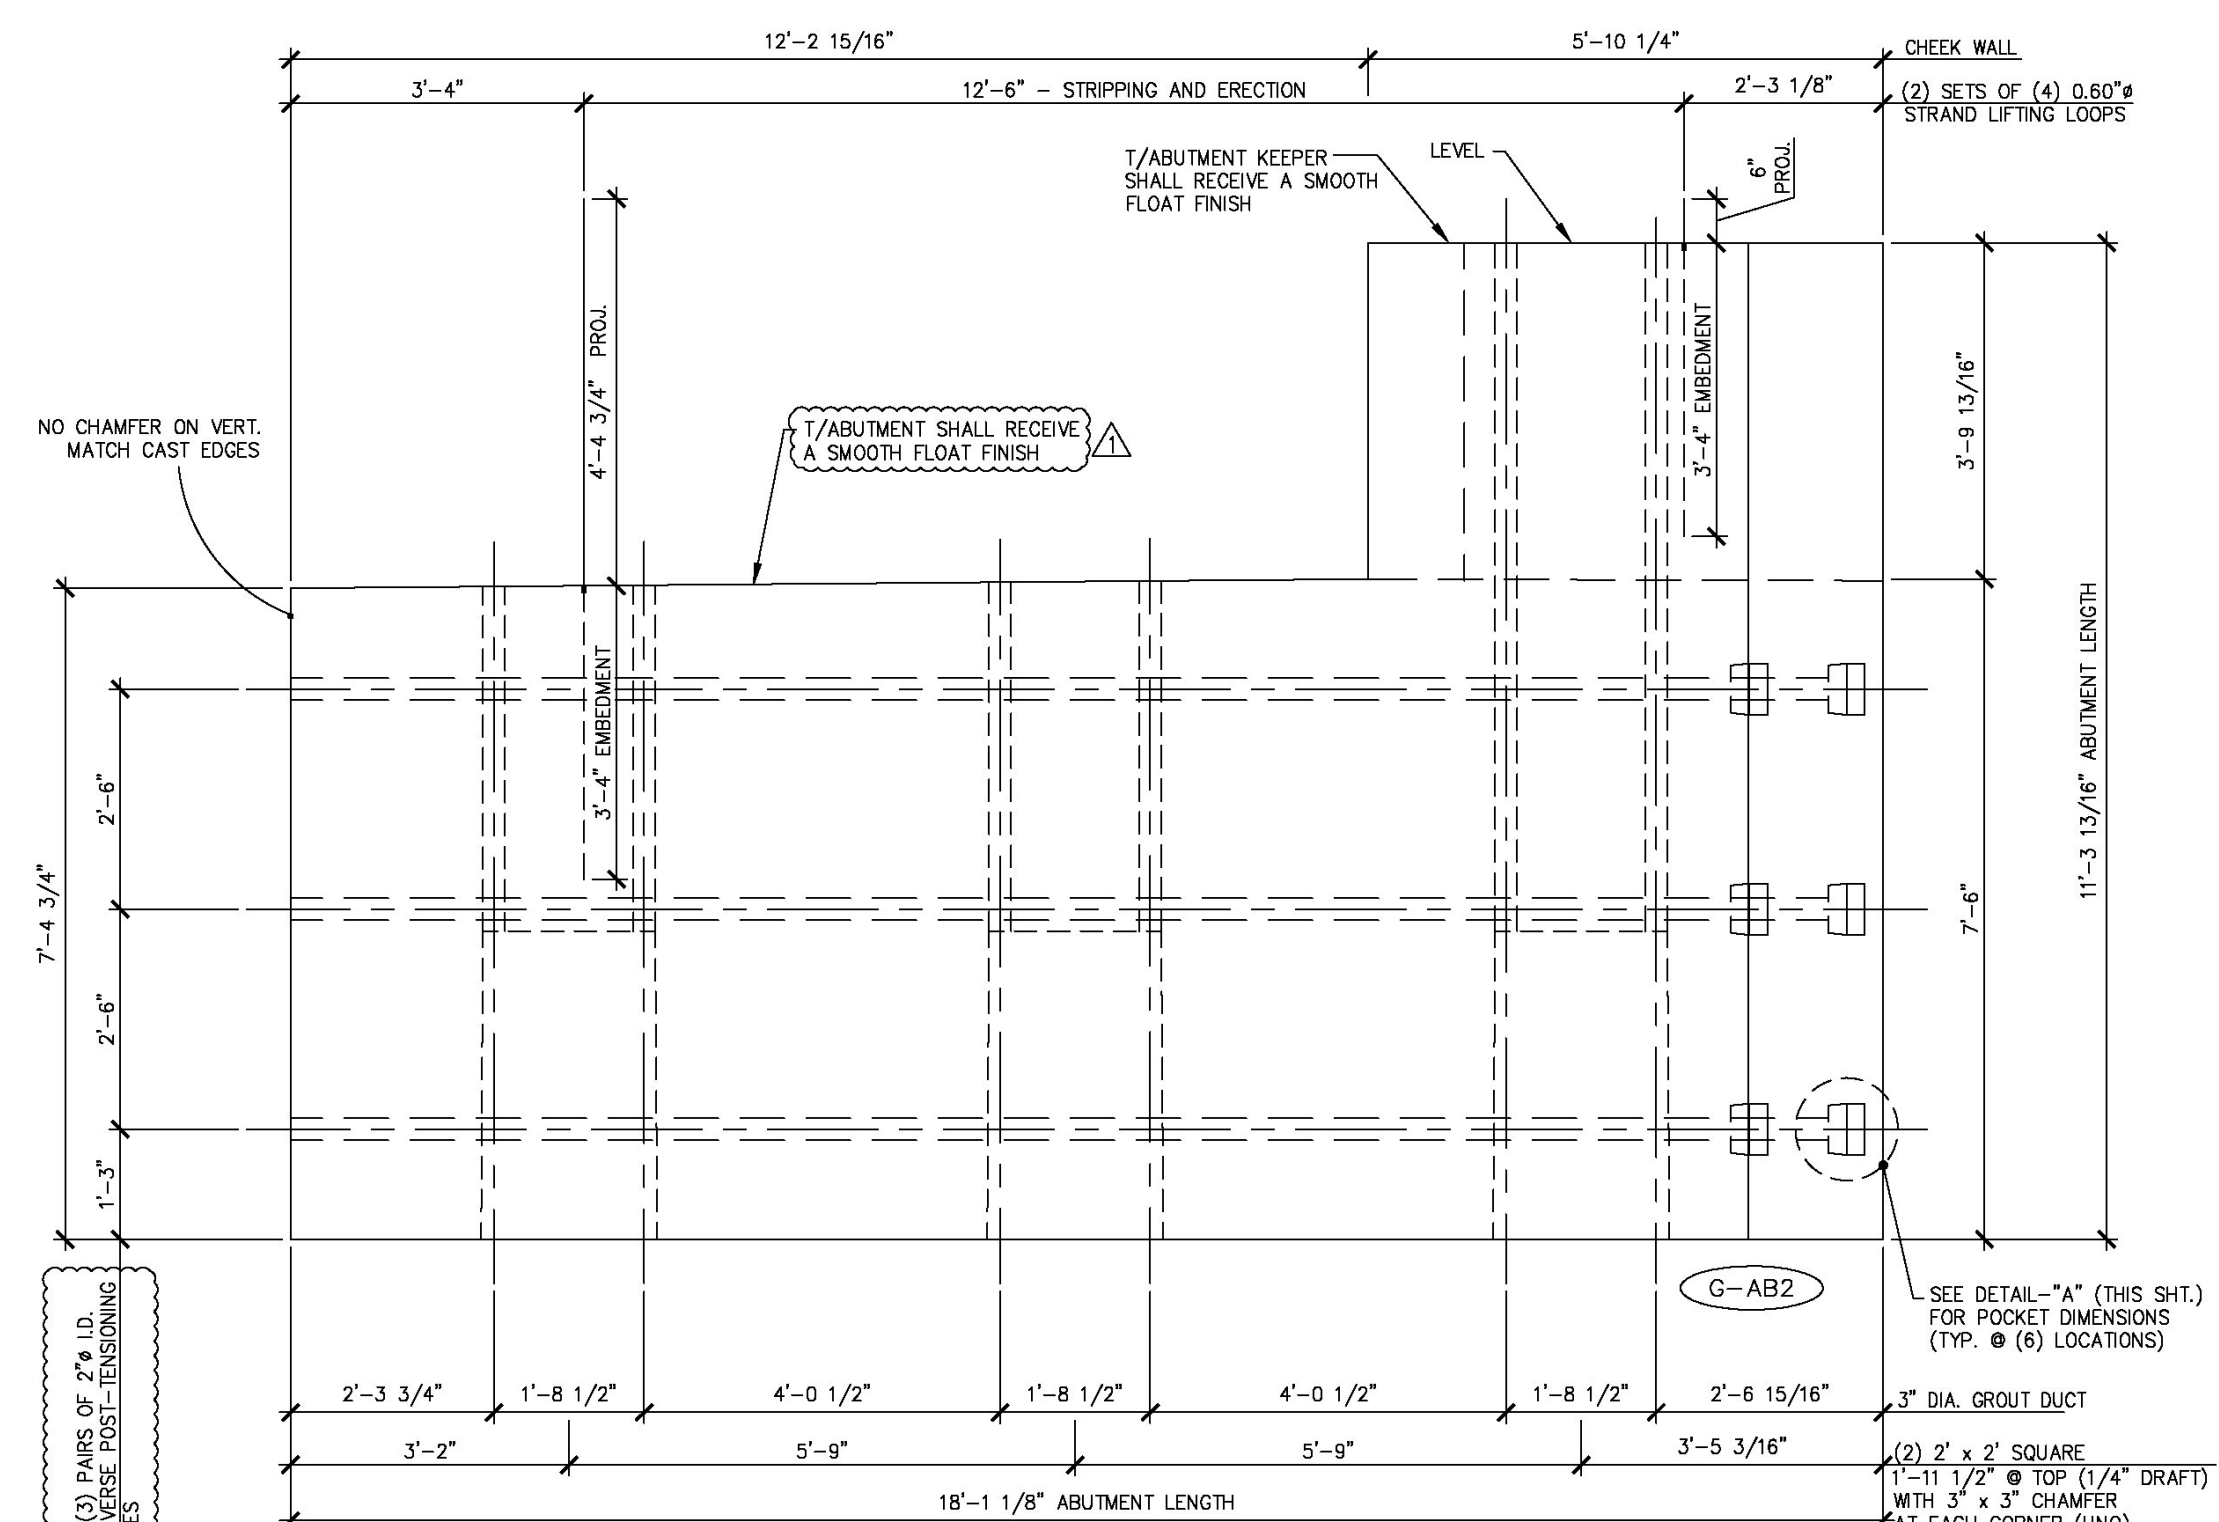

2 ABUTMENT DIMENSIONAL MARK FACE ELEVATION  
AB4 1/2" = 1'-0"

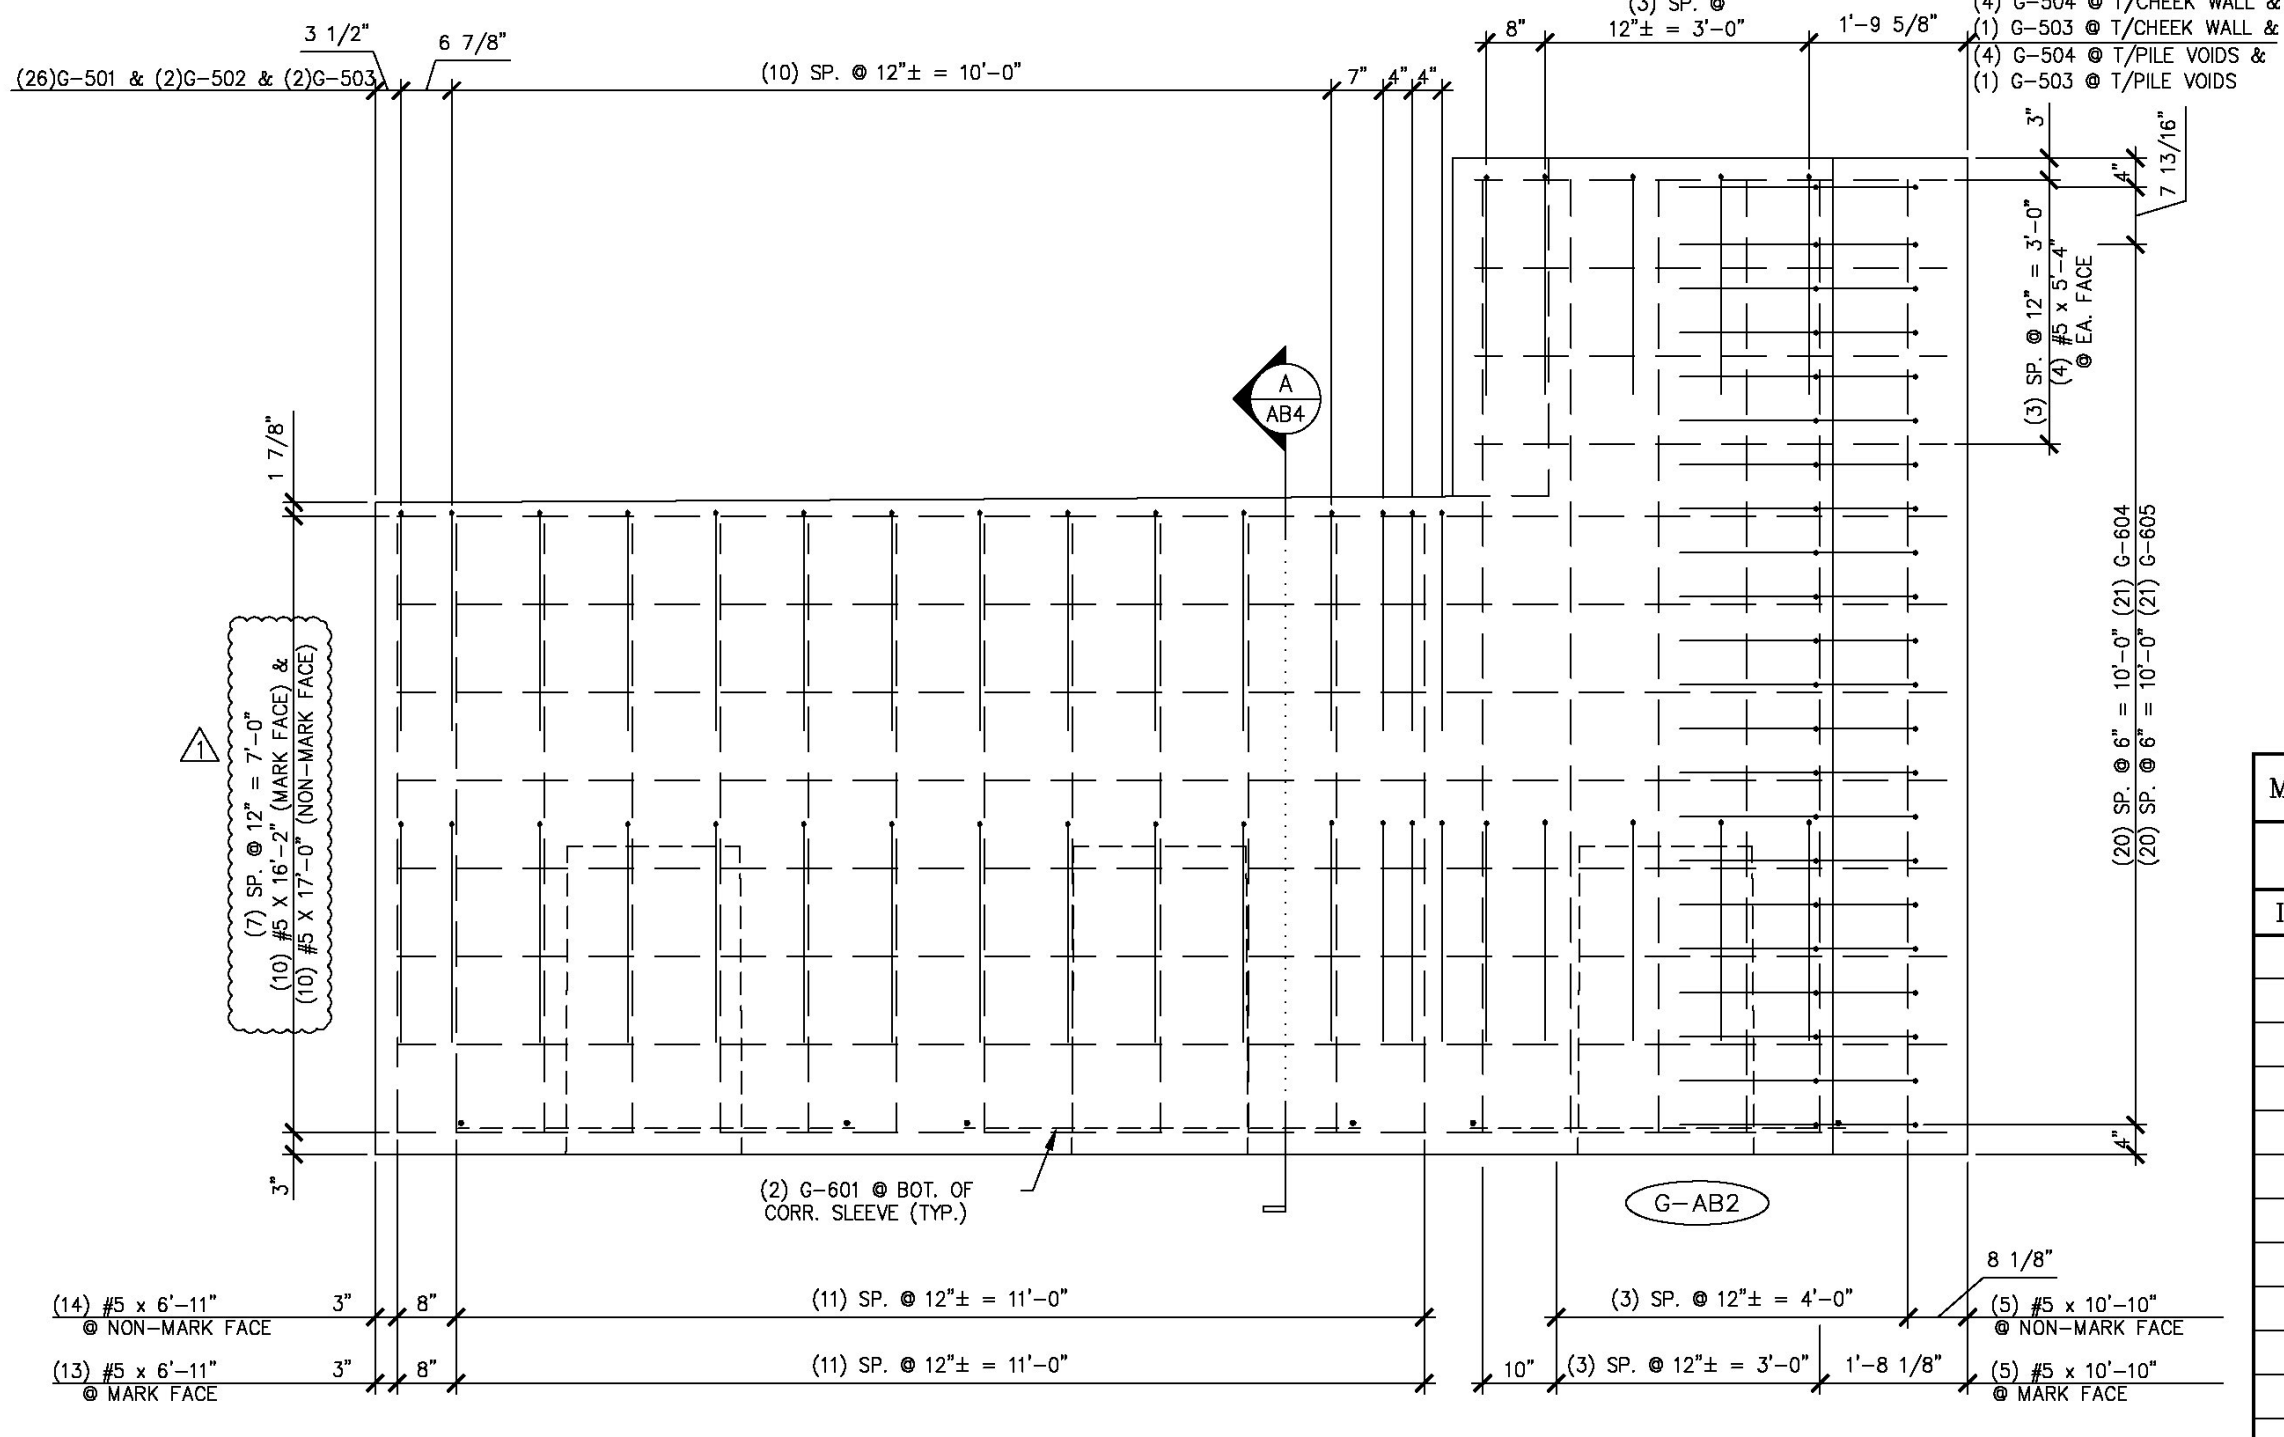

4 ABUTMENT REINFORCING MARK FACE ELEVATION  
AB4 1/2" = 1'-0"

MATERIAL LIST / ABUTMENT			
ITEM	MARK	DESCRIPTION	QTY.
1	G-501	#5 BENT BAR	26
2	G-502	#5 BENT BAR	2
3	G-503	#5 BENT BAR	4
4	G-504	#5 BENT BAR	8
5		#5 x 5'-4"	10
6		#5 x 6'-11"	27
7		#5 x 10'-10"	10
8		#5 x 16'-2"	10
9		#5 x 17'-0"	10
10			
11	G-601	#6 BENT BAR	6
12	G-604	#6 BENT BAR	22
13	G-605	#6 BENT BAR	22
14			
15			
16			
17			
18		SET OF (4) 0.60" x 270 KSI STRAND LIFTING LOOPS	2
19			
20			


SHOP NOTE:  
ALL EDGES OF ABUTMENT SHALL RECEIVE A 1" CHAMFER (U.N.O.)

Vermont Agency of Transportation  
**RECEIVED**

CK'D BY MJC OK'D BY TAS

June 18, 2014

RESUBMIT No Approved  
BY M. J. Chenette DATE 06/19/2014

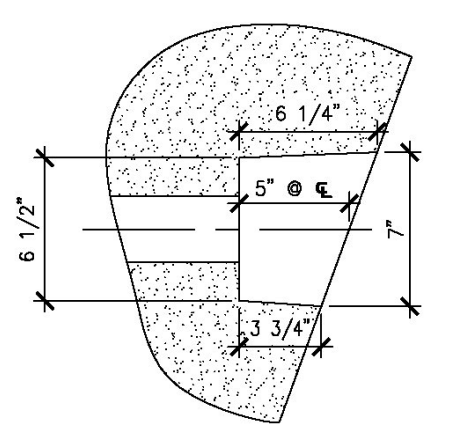

DETAIL - "A"  
1 1/2" = 1'-0"

**SHOP DRAWING REVIEW**

REVIEWED AS REQUIRED BY THE CONSTRUCTION CONTRACT DOCUMENTS AND APPROVED, BUT ONLY FOR CONFORMANCE TO THE DESIGN CONCEPT OF THE WORK, AND SUBJECT TO FURTHER LIMITATIONS AND REQUIREMENTS CONTAINED IN THE CONSTRUCTION CONTRACT DOCUMENTS.

REJECTED  REVISE AND RESUBMIT  FURNISH AS CORRECTED

CORRECTIONS OR COMMENTS MADE ON THE SHOP DRAWINGS DURING THIS REVIEW DO NOT RELIEVE CONTRACTOR FROM COMPLIANCE WITH REQUIREMENTS OF THE DRAWINGS AND SPECIFICATIONS. THIS CHECK IS ONLY FOR REVIEW OF GENERAL CONFORMANCE WITH THE DESIGN CONCEPT OF THE PROJECT AND GENERAL COMPLIANCE WITH THE INFORMATION GIVEN IN THE CONTRACT DOCUMENTS. THE CONTRACTOR IS RESPONSIBLE FOR CONFIRMING AND CORRELATING ALL QUANTITIES AND DIMENSIONS, SELECTING FABRICATION PROCESSES AND TECHNIQUES OF CONSTRUCTION, COORDINATING HIS WORK WITH THAT OF ALL OTHER TRADES AND PERFORMING HIS WORK IN A SAFE AND SATISFACTORY MANNER.

**Vanasse Hangen Brustlin, Inc.**  
7056 US Route 7  
North Ferrisburgh, VT 05473  
802-425-7799

Job Number: 57427.00  
Reviewed By: S E Burbank  
Date: 06/19/2014

4-7-14 REVISED AS NOTED  
5-6-14 REVISED AS NOTED


APPROVAL STAMP:

**J.P. CARRARA & SONS INC.**  
Precast & Prestress Manufacturer N.T.S.  
244 COTE ST. MIDDLEBURY, VERMONT 05753 Phone:(802)388-6361 Fax:(802)388-9010


STATE OF VERMONT AGENCY OF TRANSPORTATION COUNTY OF WINDHAM	DATE: MAR. 04, 2014 SCALE: NOTED
TOWN OF GUILFORD ROUTE NO. T.H.10, CLASS III (LOCAL ROAD) BRIDGE NO.: 65 PROJECT NO.: BRO 1442 (36)	CHKD: JJ/KLT DFTM:AA1/RWS JOB NO: 23420-014
PRECAST ABUTMENT DETAILS	DWG. NO: AB4

**Eriksson technologies**  
813.989.3317  
TAMPA, FL LRFD.COM  
©2014 ERIKSSON TECHNOLOGIES, INC. ALL RIGHTS RESERVED

S:\Engineering Services\Carrara\116001 - Guilford Bridge 65\Production Drawings\AutoCAD Files\144236-AB.dwg, 5/16/2014 4:44:39 PM, DWG To PDF.pc3

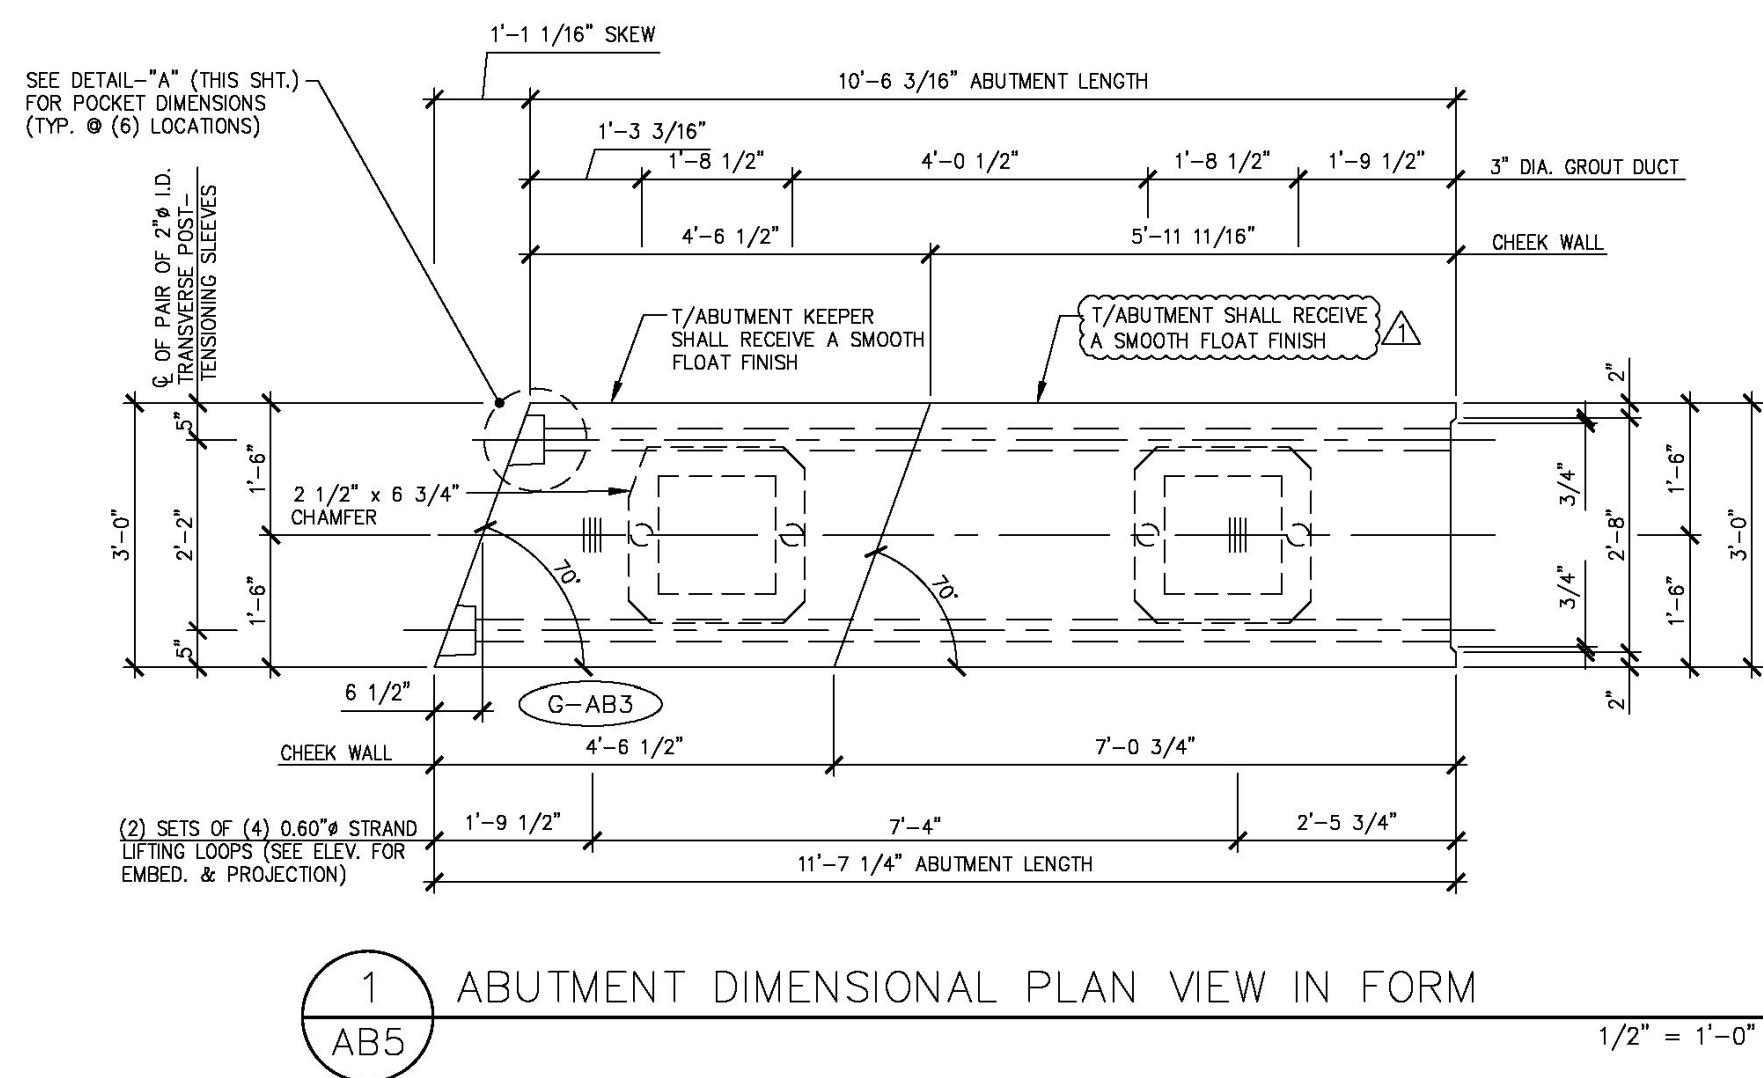


1 ABUTMENT DIMENSIONAL PLAN VIEW IN FORM  
AB5 1/2" = 1'-0"

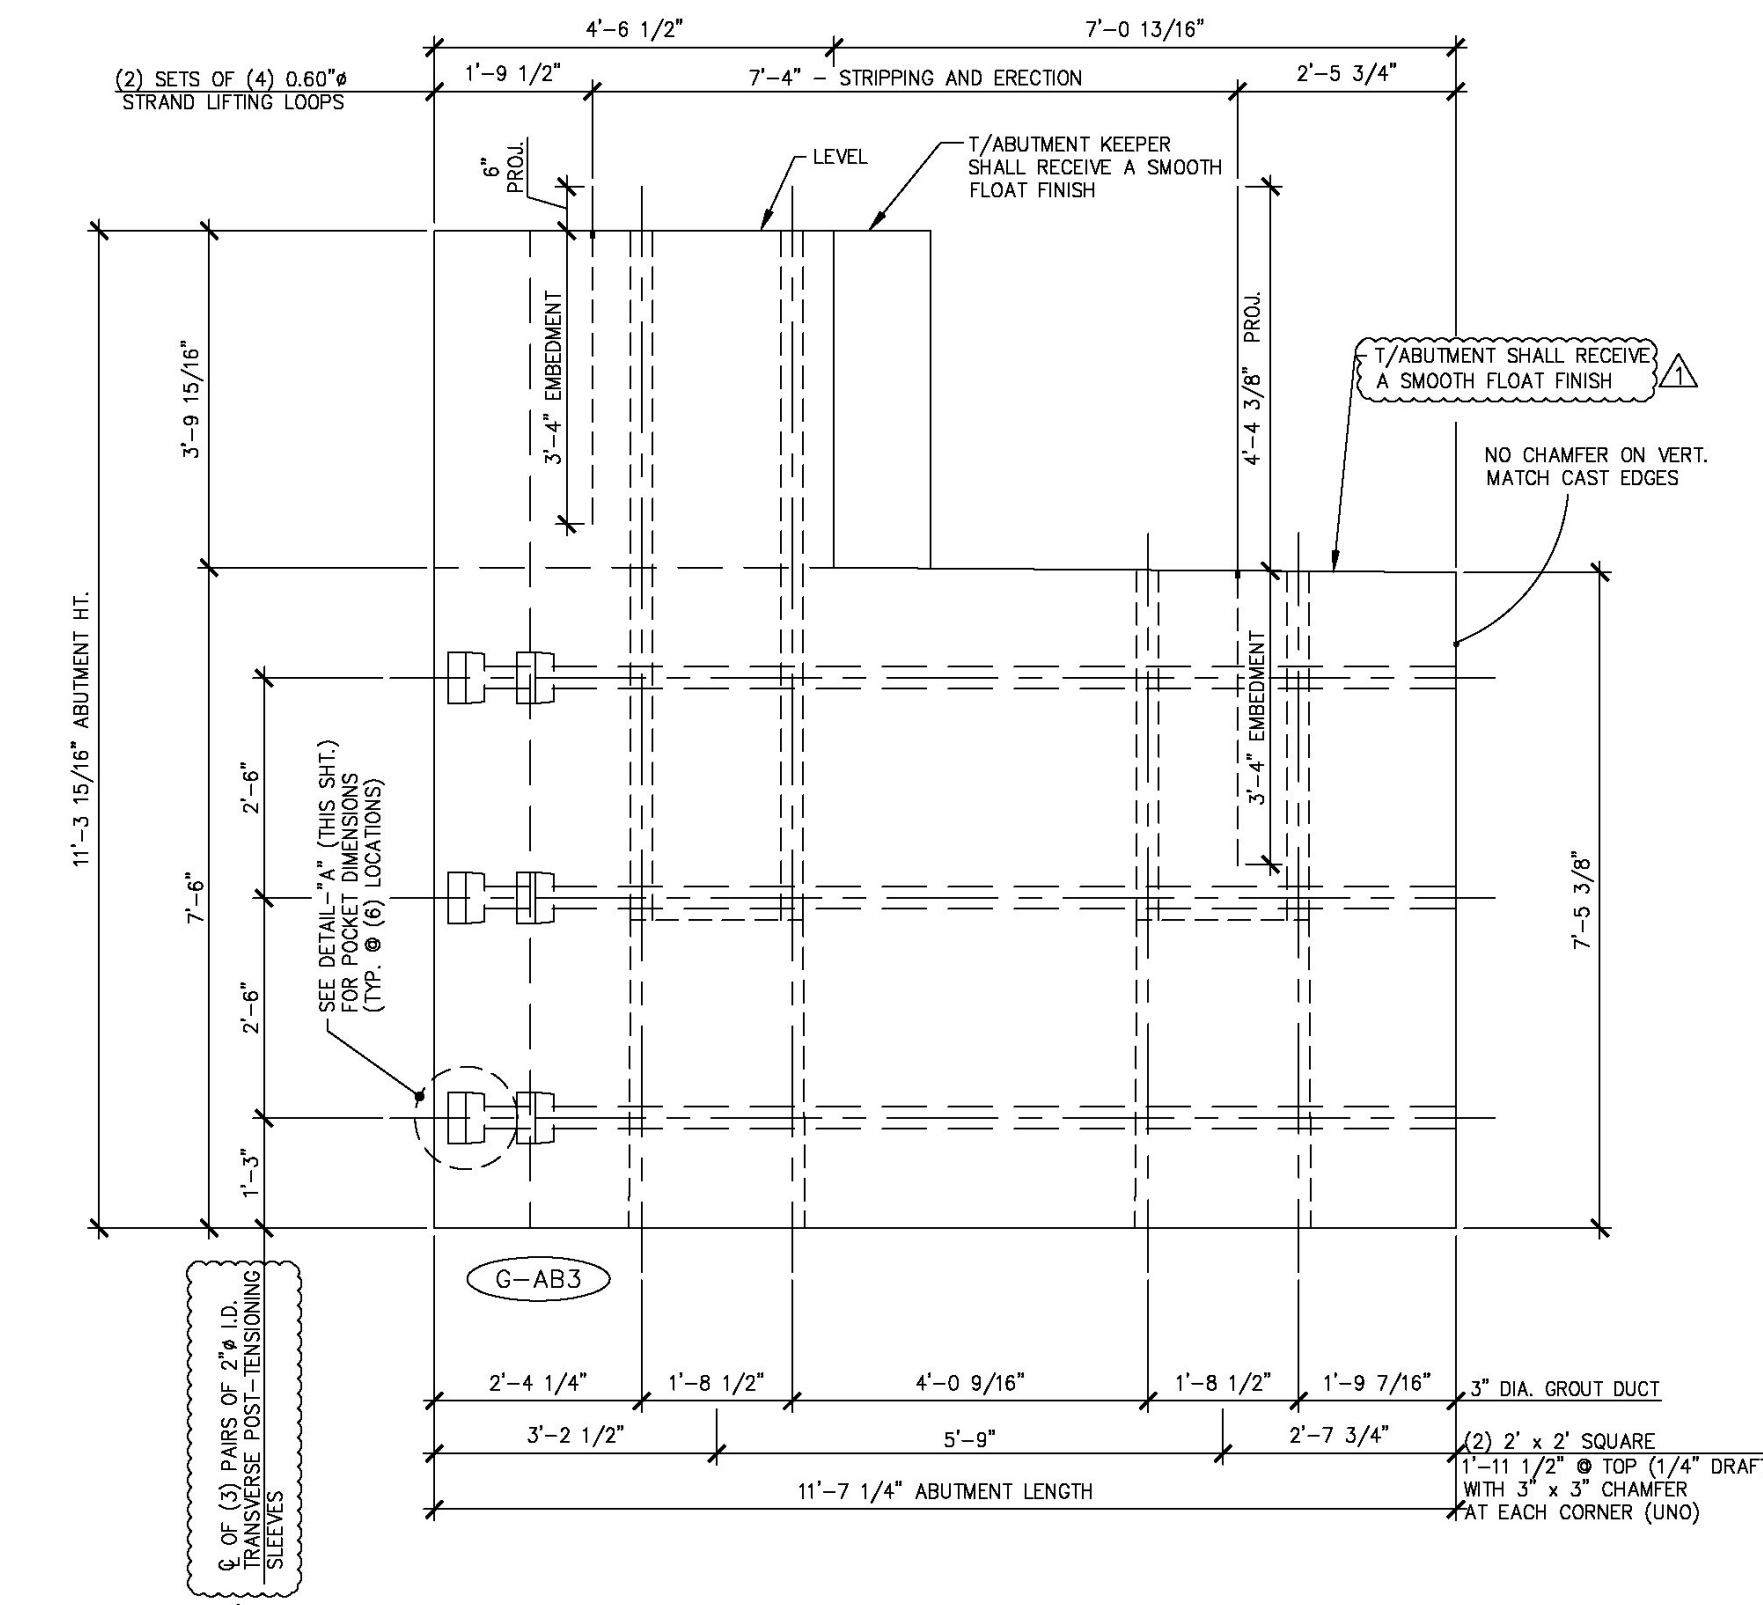

2 ABUTMENT DIMENSIONAL MARK FACE ELEVATION  
AB5 1/2" = 1'-0"

SHOP NOTE:  
ALL EDGES OF ABUTMENT SHALL RECEIVE A 1" CHAMFER (U.N.O.)

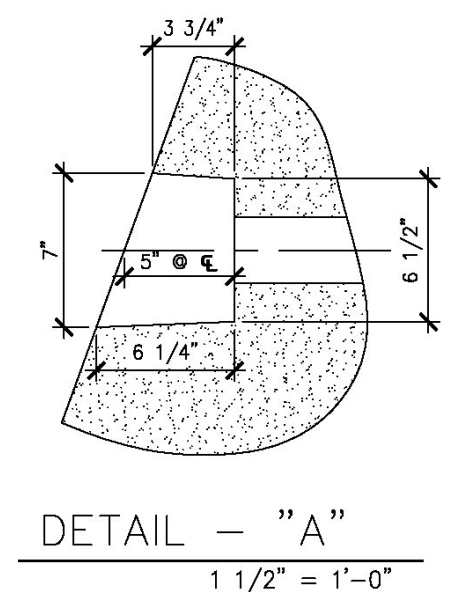

DETAIL - "A"  
1 1/2" = 1'-0"

**Vermont Agency of Transportation**  
**RECEIVED**  
CK'D BY MJC OK'D BY TAS  
June 18, 2014  
RESUBMIT No Approved  
BY M. J. Chenette DATE 06/19/2014

SHOP DRAWING REVIEW


REVIEWED AS REQUIRED BY THE CONSTRUCTION CONTRACT DOCUMENTS AND APPROVED, BUT ONLY FOR CONFORMANCE TO THE DESIGN CONCEPT OF THE WORK, AND SUBJECT TO FURTHER LIMITATIONS AND REQUIREMENTS CONTAINED IN THE CONSTRUCTION CONTRACT DOCUMENTS.

REJECTED     REVISE AND RESUBMIT     FURNISH AS CORRECTED


CORRECTIONS OR COMMENTS MADE ON THE SHOP DRAWINGS DURING THIS REVIEW DO NOT RELIEVE CONTRACTOR FROM COMPLIANCE WITH REQUIREMENTS OF THE DRAWINGS AND SPECIFICATIONS. THIS CHECK IS ONLY FOR REVIEW OF GENERAL CONFORMANCE WITH THE DESIGN CONCEPT OF THE PROJECT AND GENERAL COMPLIANCE WITH THE INFORMATION GIVEN IN THE CONTRACT DOCUMENTS. THE CONTRACTOR IS RESPONSIBLE FOR CONFIRMING AND CORRELATING ALL QUANTITIES AND DIMENSIONS, SELECTING FABRICATION PROCESSES AND TECHNIQUES OF CONSTRUCTION, COORDINATING HIS WORK WITH THAT OF ALL OTHER TRADES, AND PERFORMING HIS WORK IN A SAFE AND SATISFACTORY MANNER.

**VHB Vanasse Hangen Brustlin, Inc.**  
7056 US Route 7  
North Ferrisburgh, VT 05473  
802.425.7788

Job Number: 57427.00  
Reviewed By: S.E. Burbank  
Date: 06/19/2014

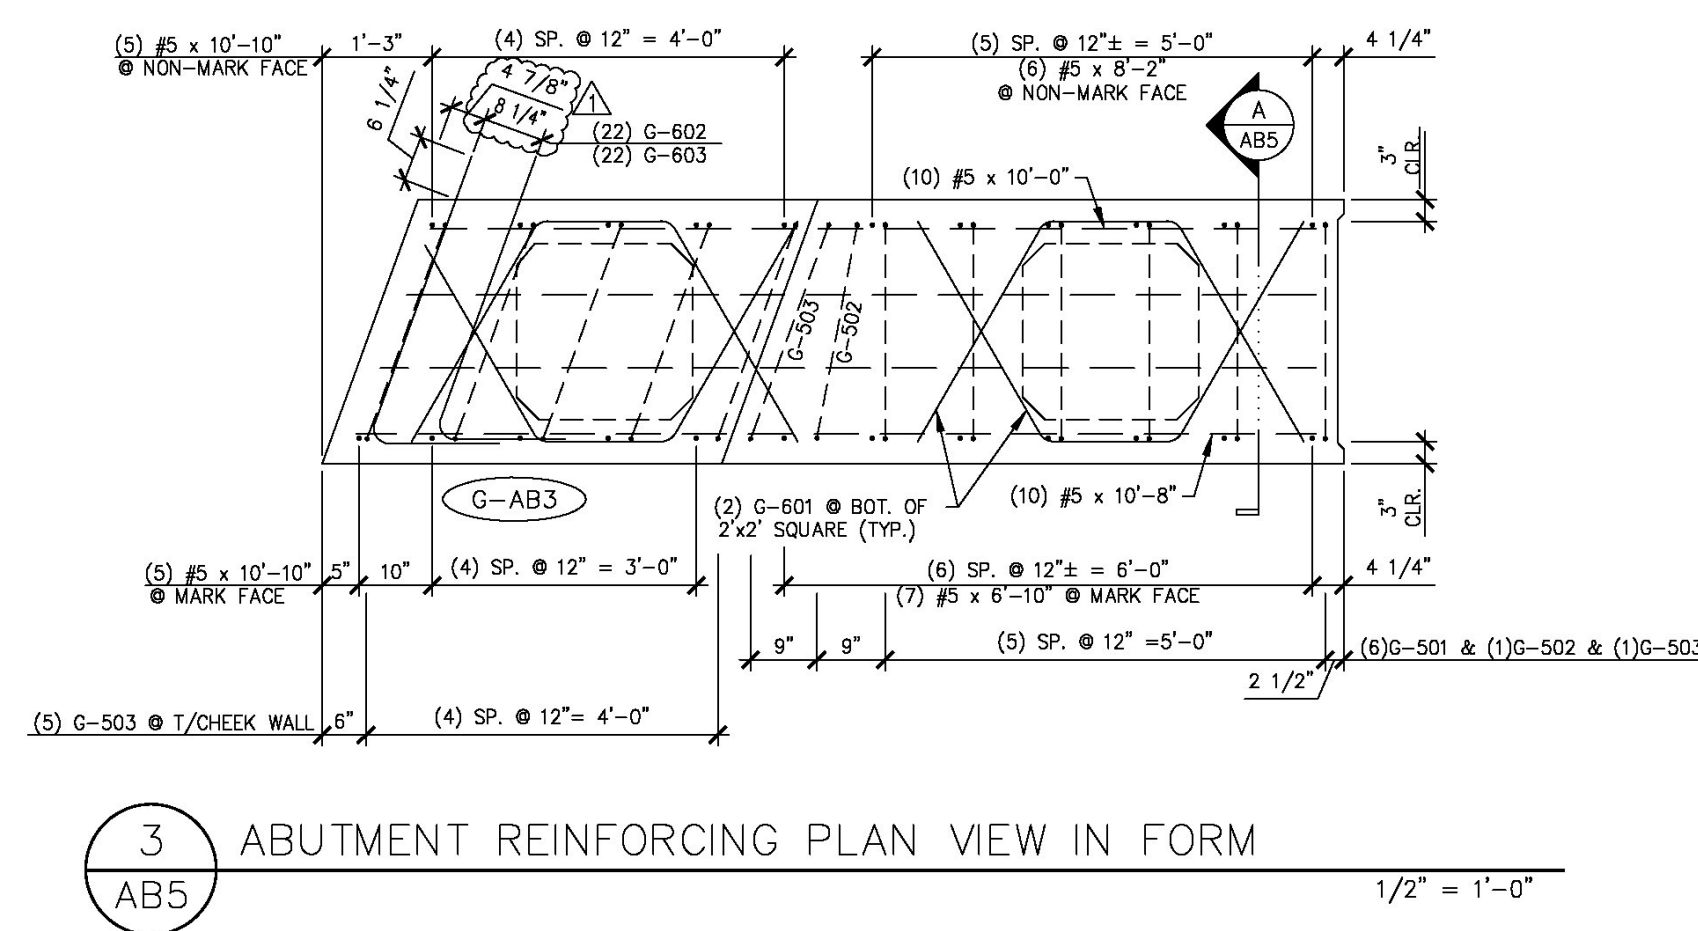


3 ABUTMENT REINFORCING PLAN VIEW IN FORM  
AB5 1/2" = 1'-0"

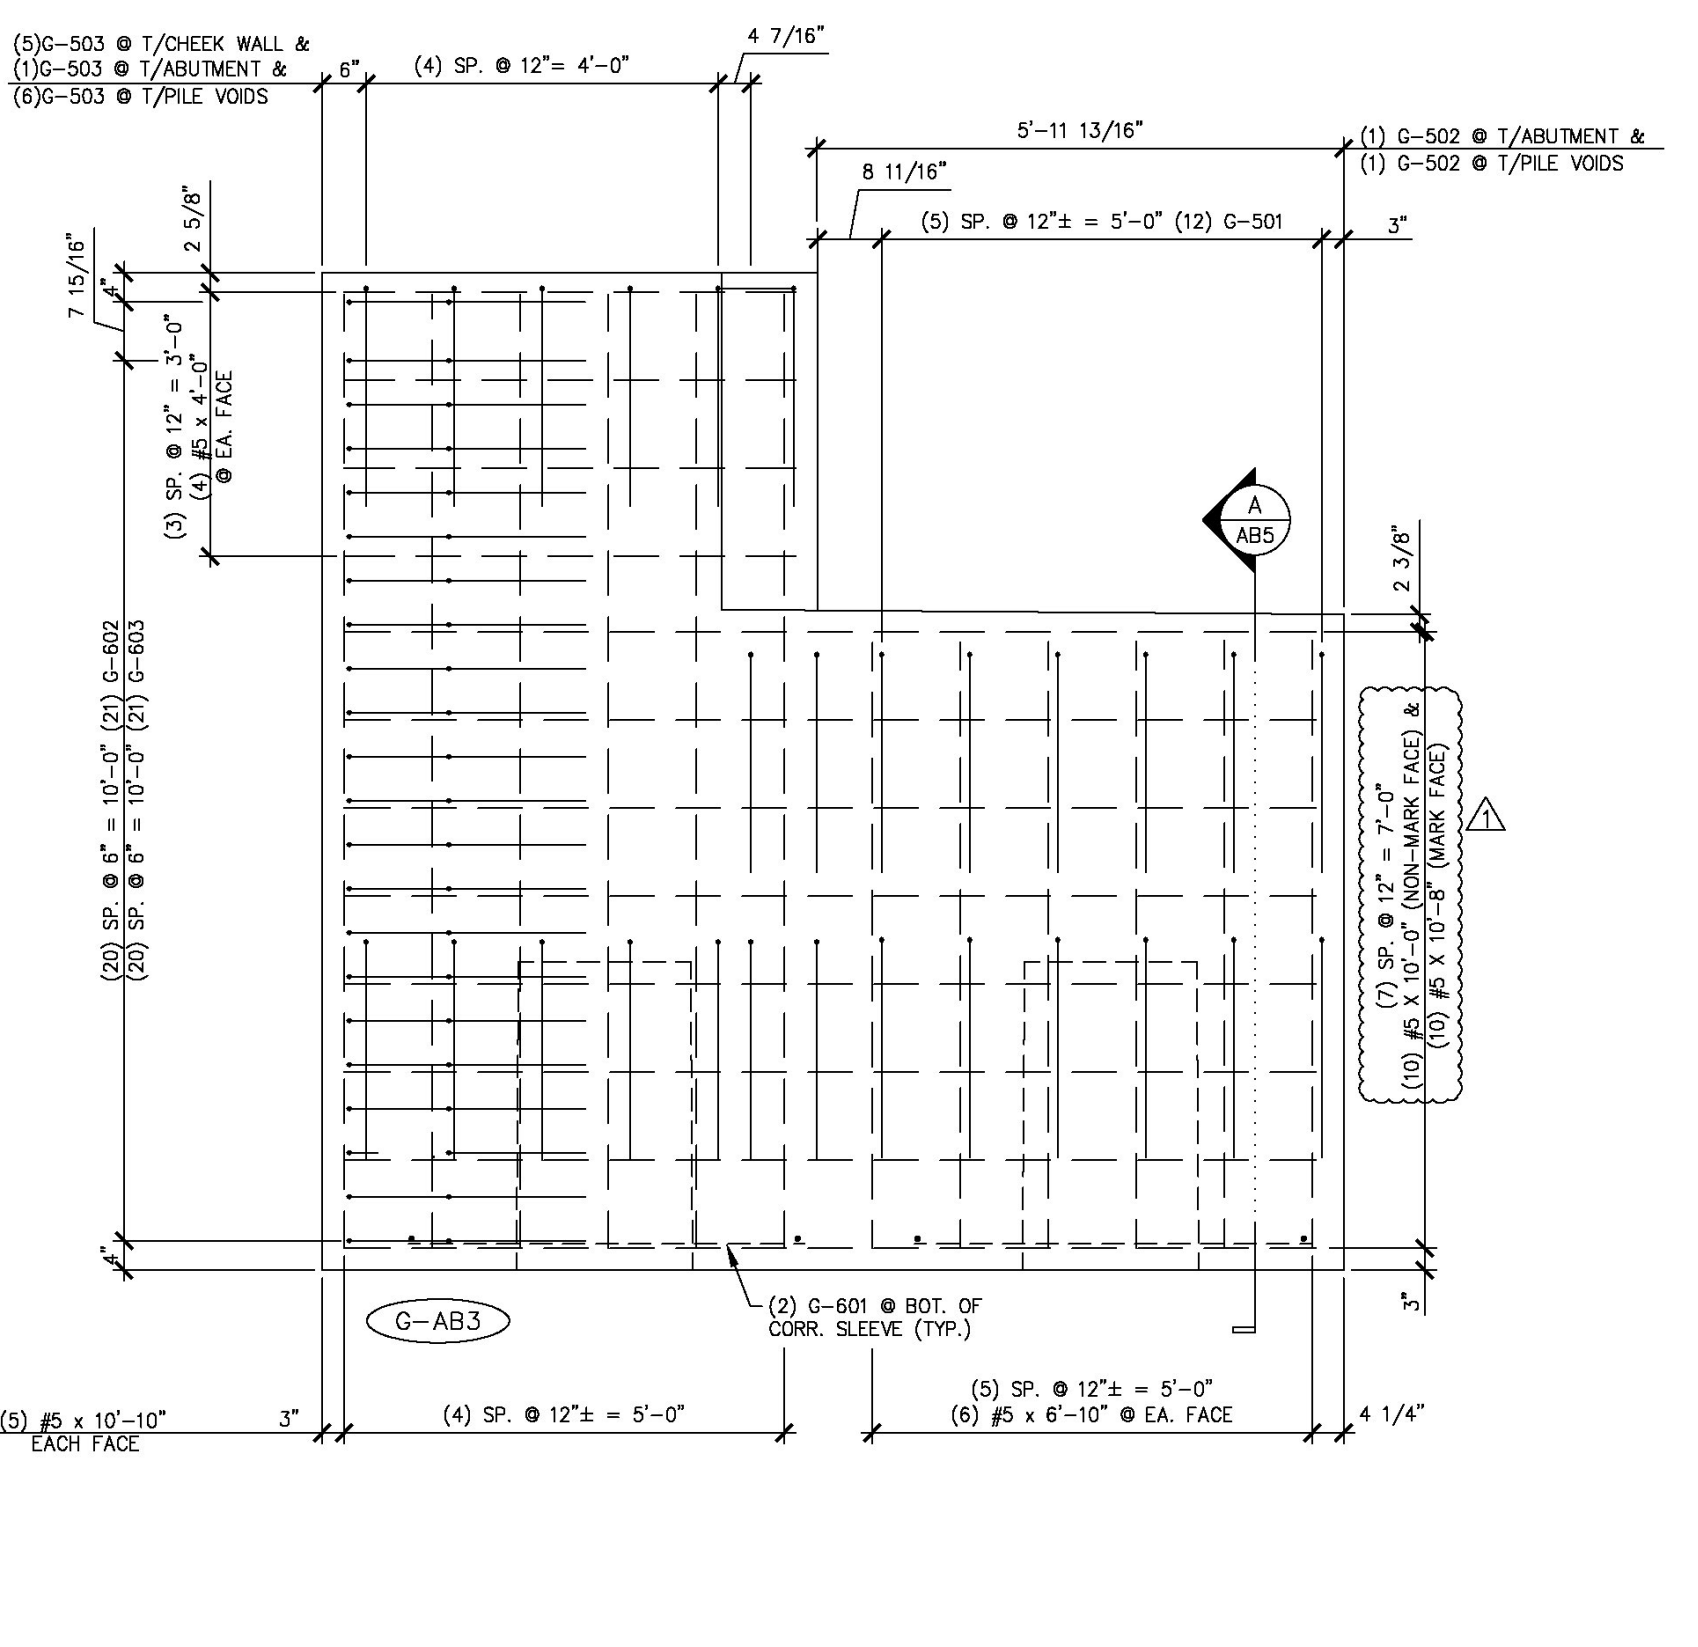

4 ABUTMENT REINFORCING MARK FACE ELEVATION  
AB5 1/2" = 1'-0"

△ 4-7-14 REVISED AS NOTED  
△ 5-6-14 REVISED AS NOTED

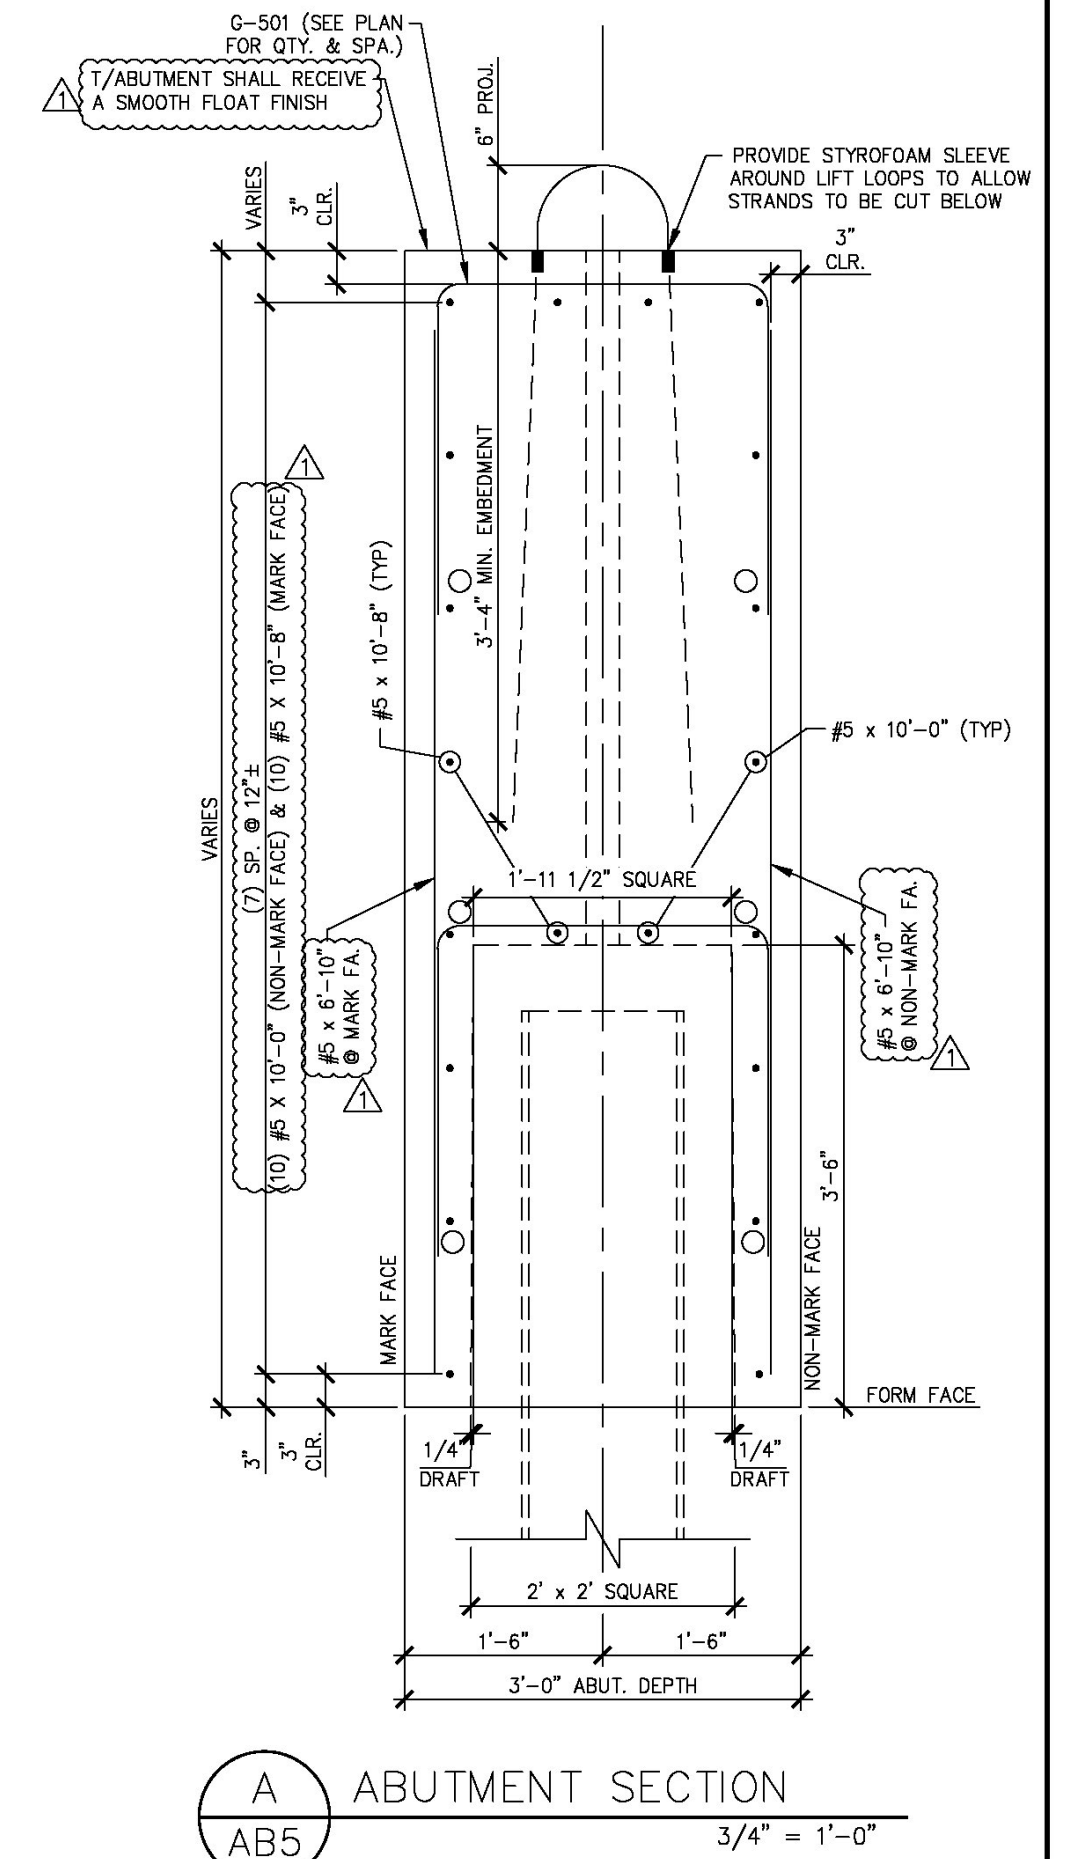

A ABUTMENT SECTION  
AB5 3/4" = 1'-0"

MARK:	G-AB3	QTY.:	1	WT.:	20.35 T	VOL.:	10.05 cy
MATERIAL LIST / ABUTMENT							
ITEM	MARK	DESCRIPTION	QTY.				
1	G-501	#5 BENT BAR	12				
2	G-502	#5 BENT BAR	2				
3	G-503	#5 BENT BAR	12				
4		#5 x 4'-0"	10				
5		#5 x 6'-10"	12				
6		#5 x 10'-0"	10				
7		#5 x 10'-8"	10				
8		#5 x 10'-10"	10				
9							
10	G-601	#6 BENT BAR	4				
11	G-602	#6 BENT BAR	22				
12	G-603	#6 BENT BAR	22				
13							
14							
15							
16							
17							
18		SET OF (4) 0.60" x 270 KSI STRAND LIFTING LOOPS	2				
19							
20							


APPROVAL STAMP:

**J.P. CARRARA & SONS INC.**  
Precast & Prestress Manufacturer N.T.S.  
244 OASE STR. MIDDLEBURY, VERMONT 05753 Phone:(802)388-6361 Fax:(802)388-9010


STATE OF VERMONT AGENCY OF TRANSPORTATION COUNTY OF WINDHAM	DATE: MAR. 04, 2014 SCALE: NOTED
TOWN OF GUILFORD ROUTE NO. T.H.10, CLASS III (LOCAL ROAD) BRIDGE NO.: 65 PROJECT NO.: BRO 1442 (36)	CHKD: JJ/KLT DFTM:AA1/RWS JOB NO: 23420-014
PRECAST ABUTMENT DETAILS	
DWG. NO: AB5	

**Eriksson technologies**  
813.989.3317  
TAMPA, FL LRFD.COM  
© 2014 ERIKSSON TECHNOLOGIES, INC. ALL RIGHTS RESERVED


S:\Engineering Services\Carrara\14001 - Guilford Bridge 65\Production Drawings\AutoCAD Files\144236-AB.dwg, 5/16/2014 4:44:39 PM, DWG To PDF.pc3

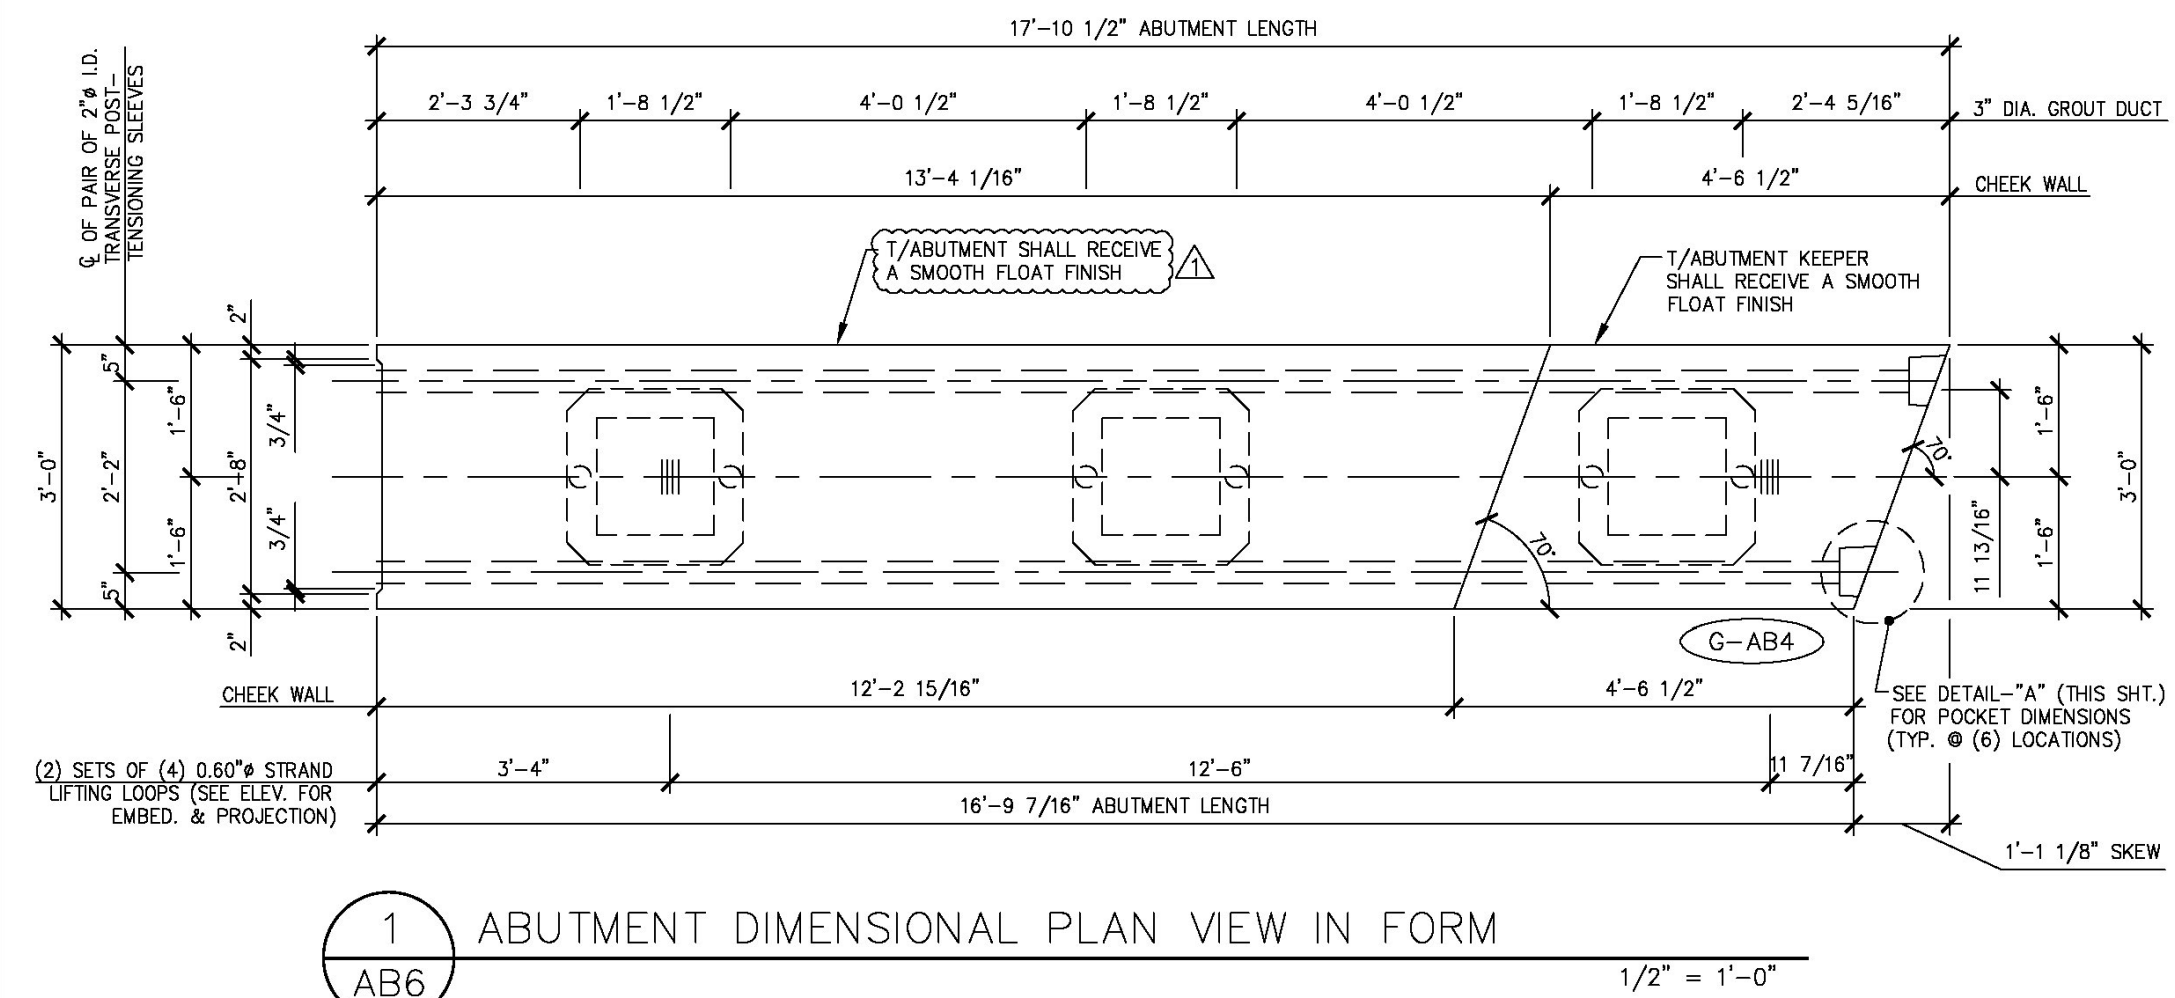


1 ABUTMENT DIMENSIONAL PLAN VIEW IN FORM  
AB6 1/2" = 1'-0"

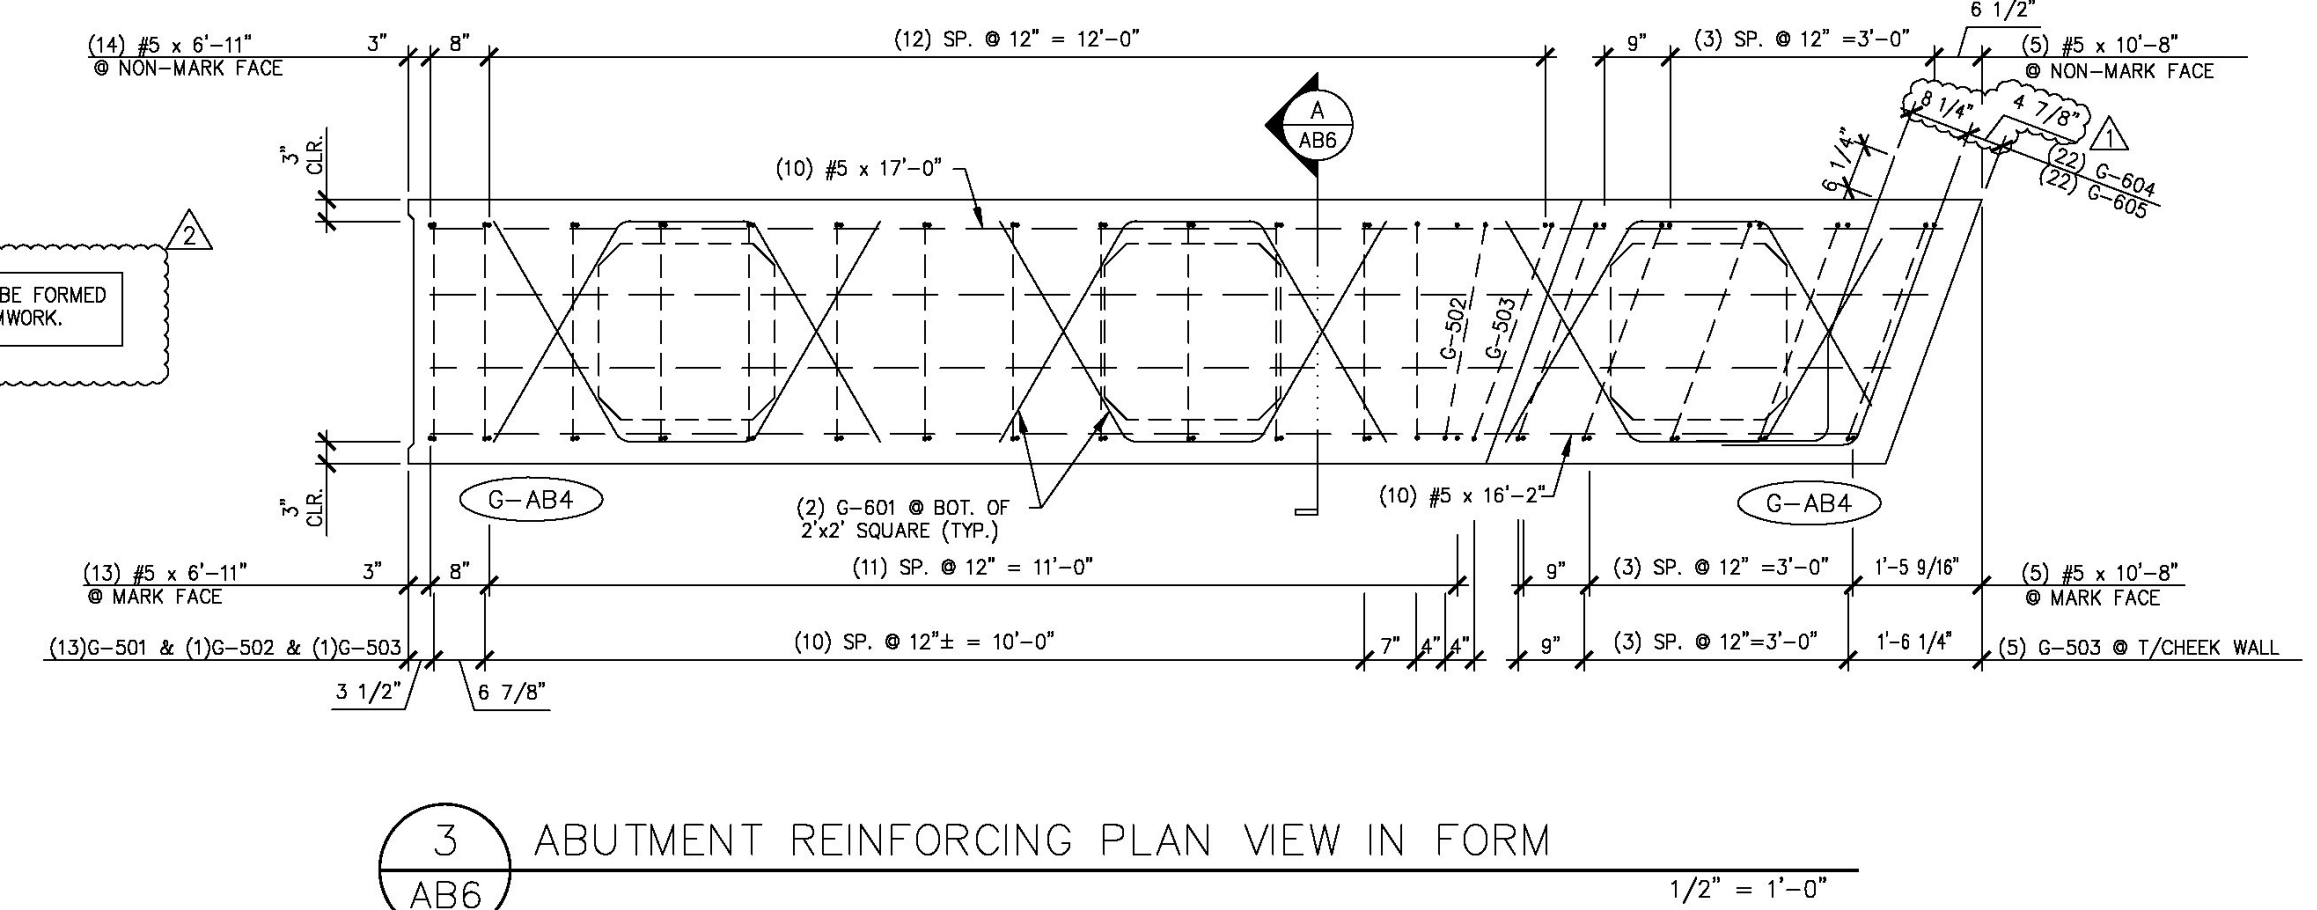


3 ABUTMENT REINFORCING PLAN VIEW IN FORM  
AB6 1/2" = 1'-0"

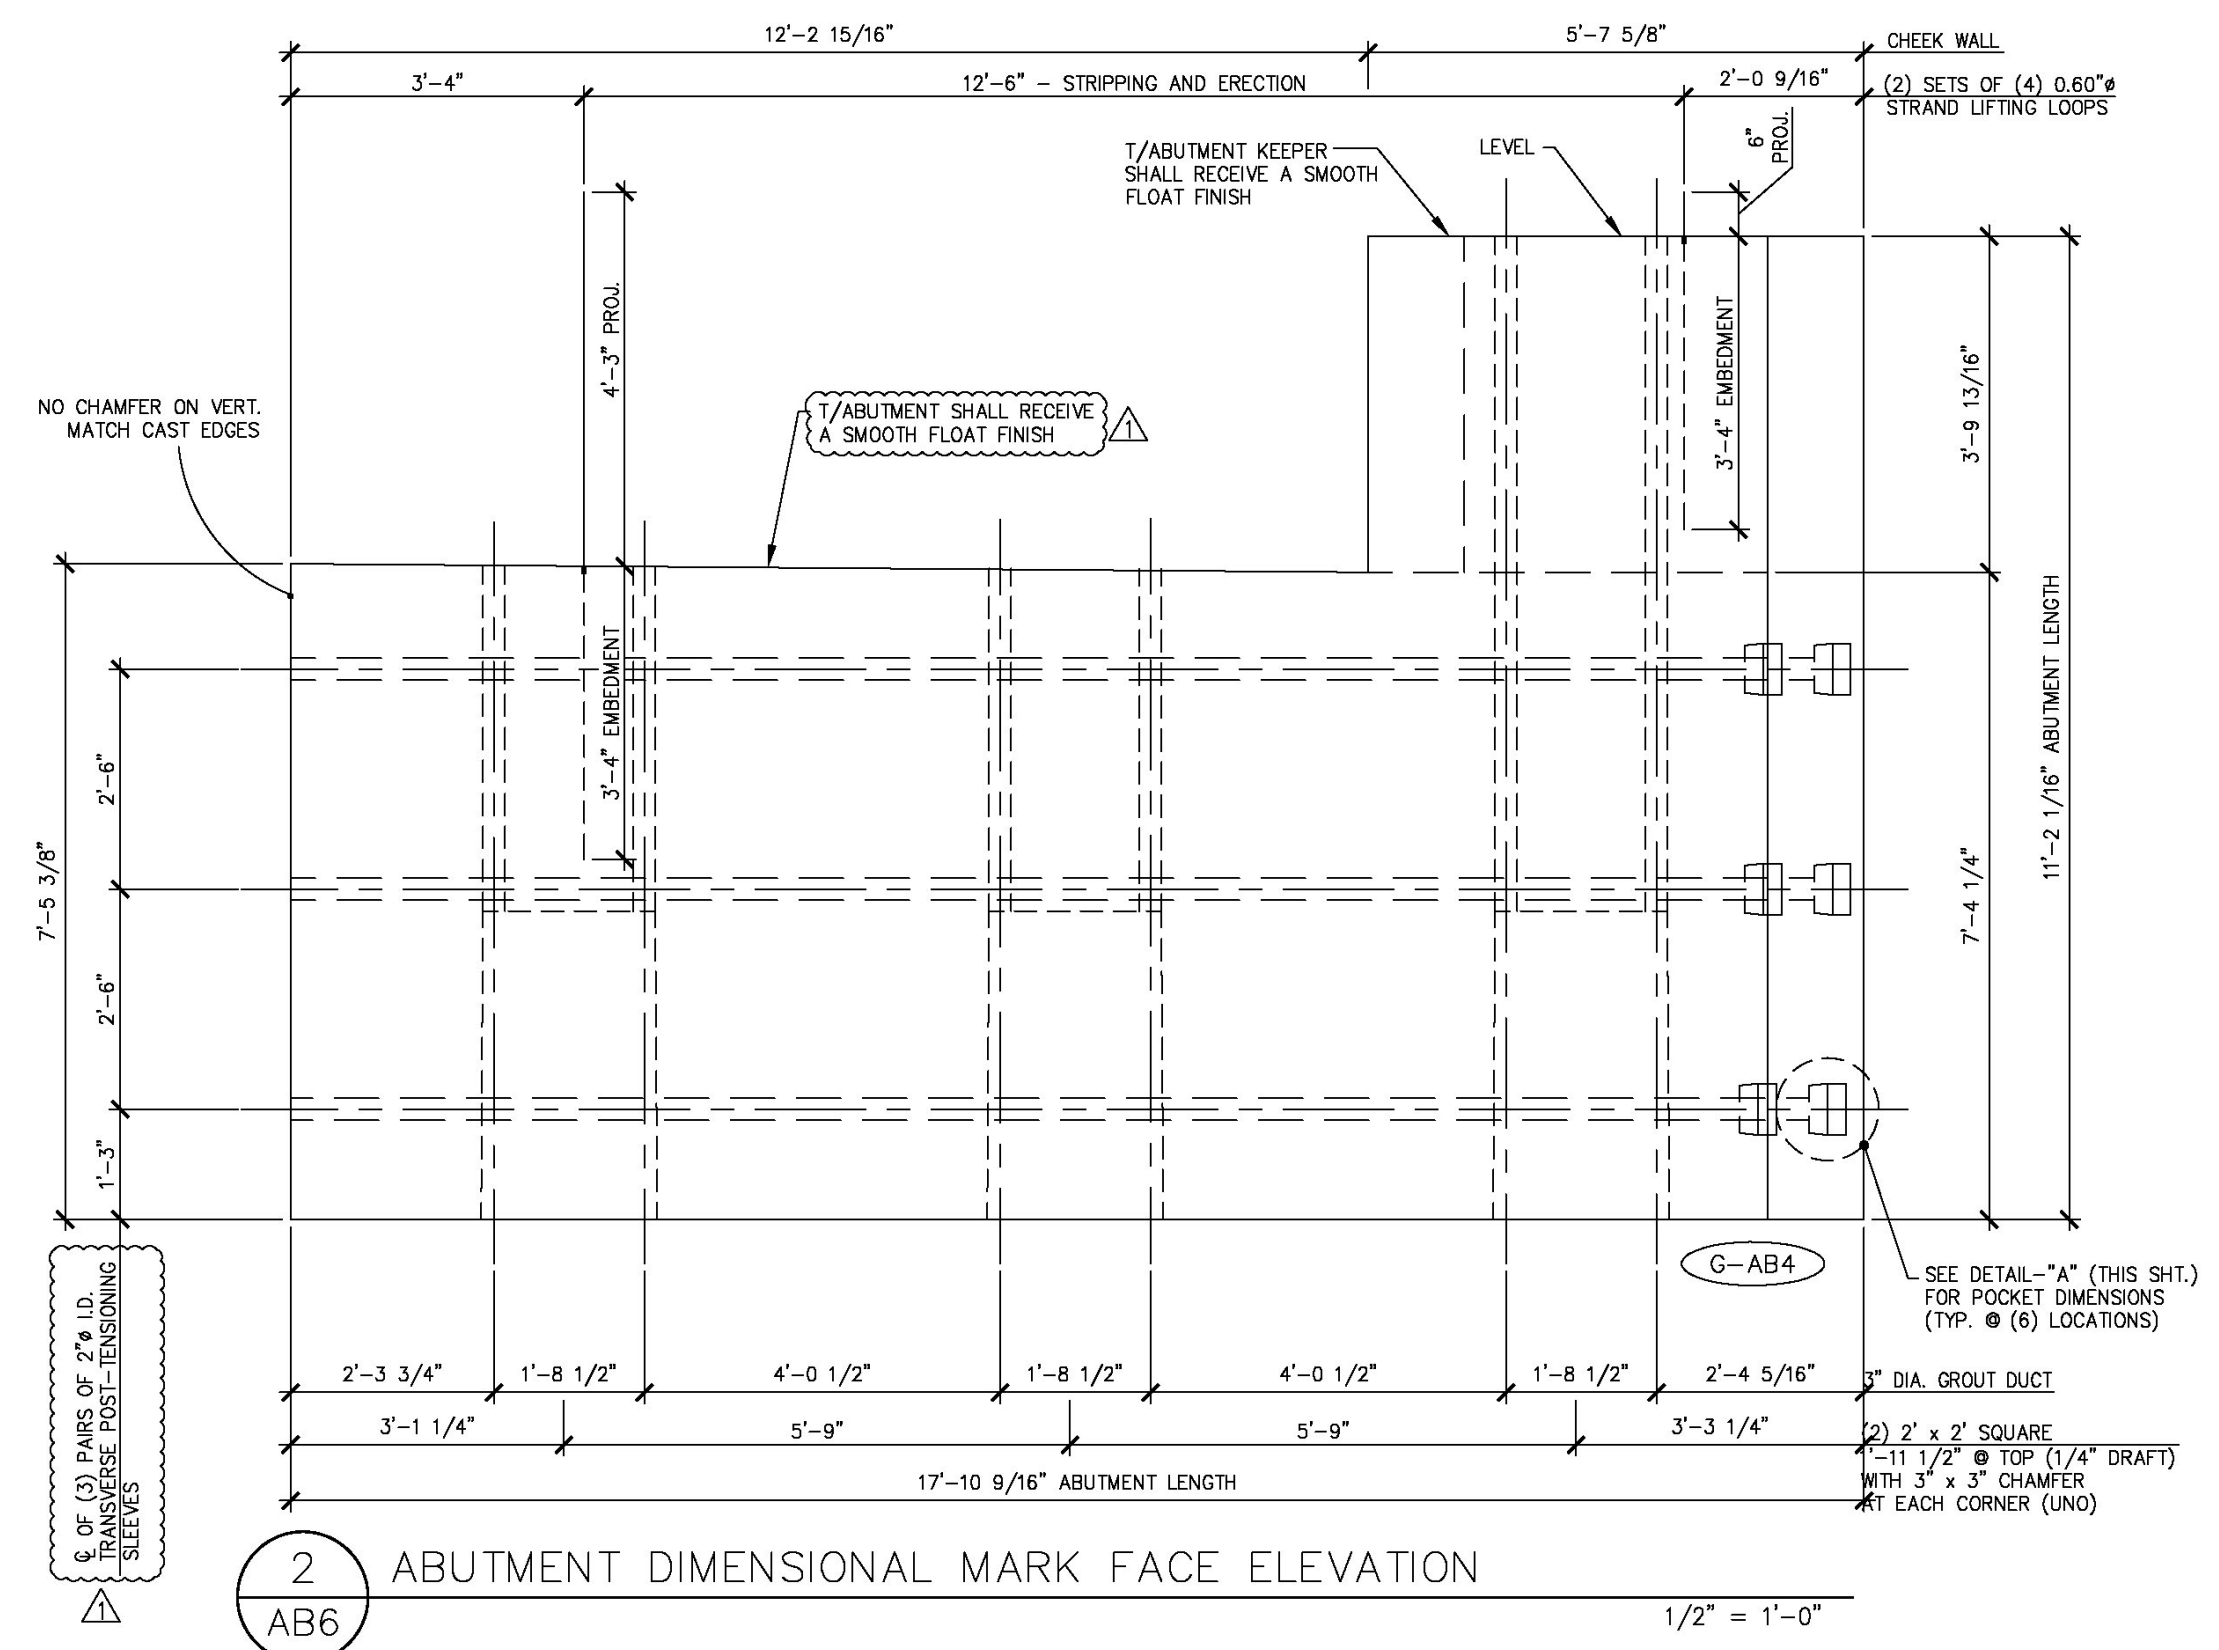

2 ABUTMENT DIMENSIONAL MARK FACE ELEVATION  
AB6 1/2" = 1'-0"

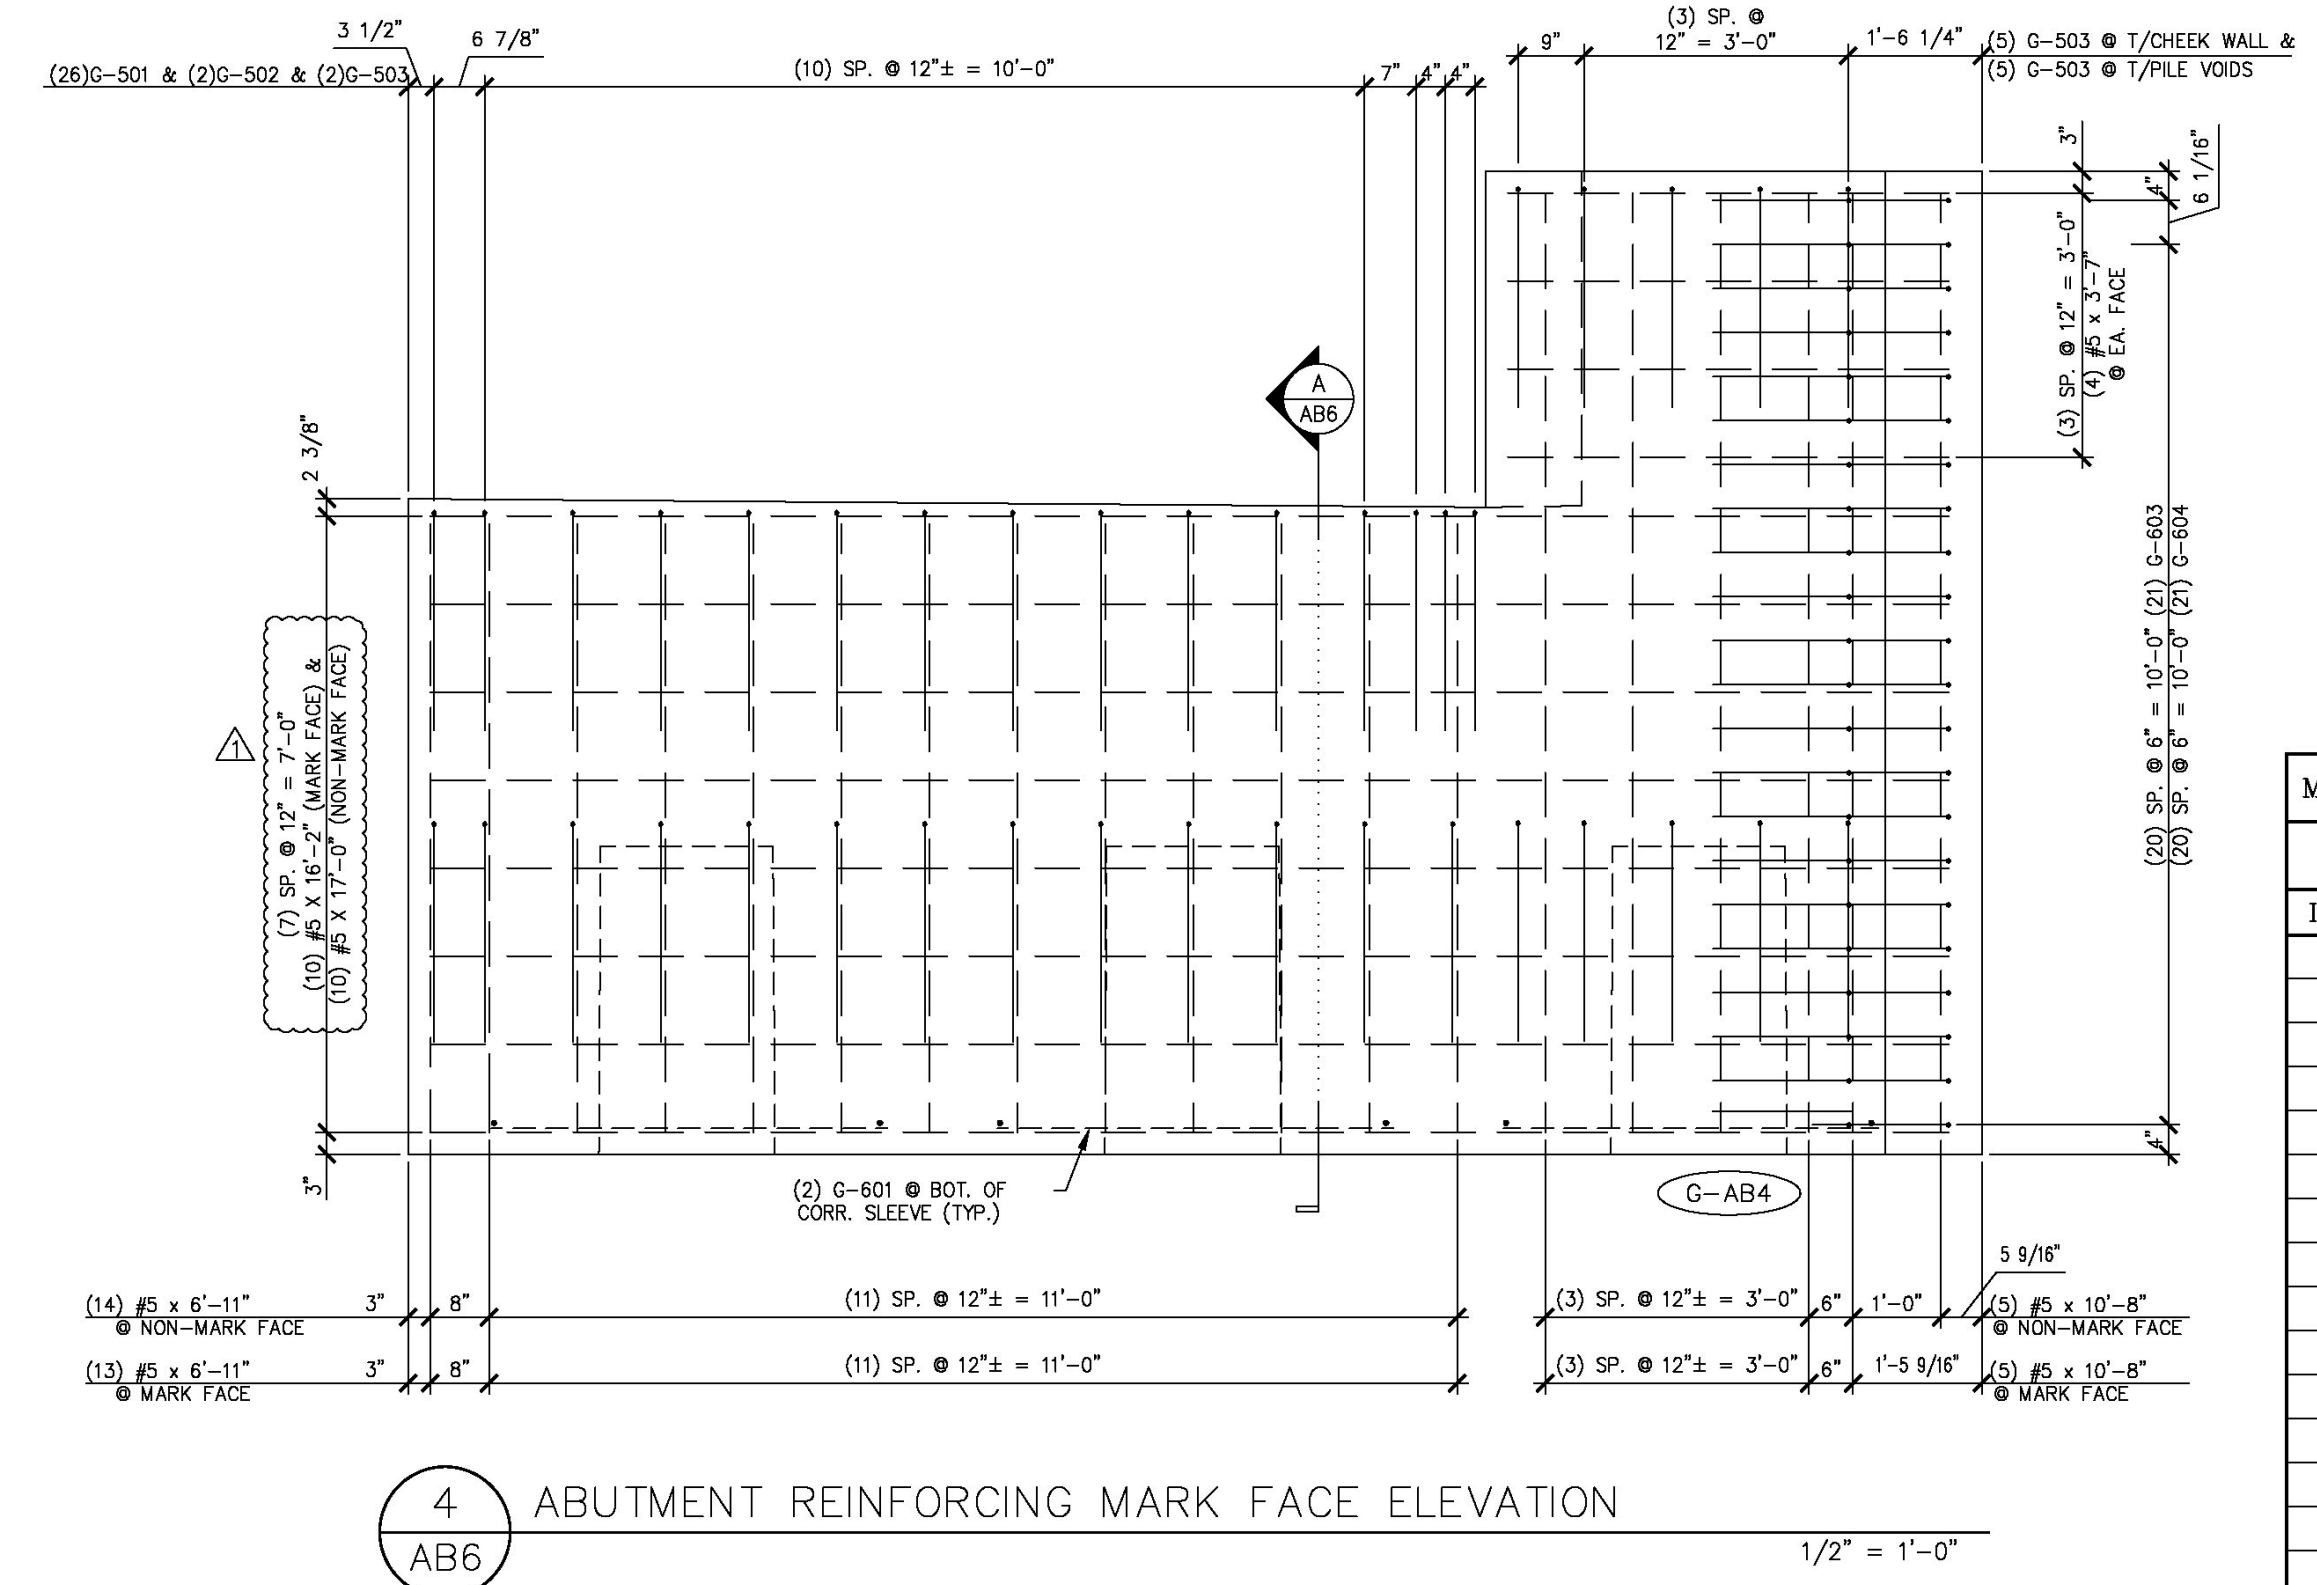

4 ABUTMENT REINFORCING MARK FACE ELEVATION  
AB6 1/2" = 1'-0"

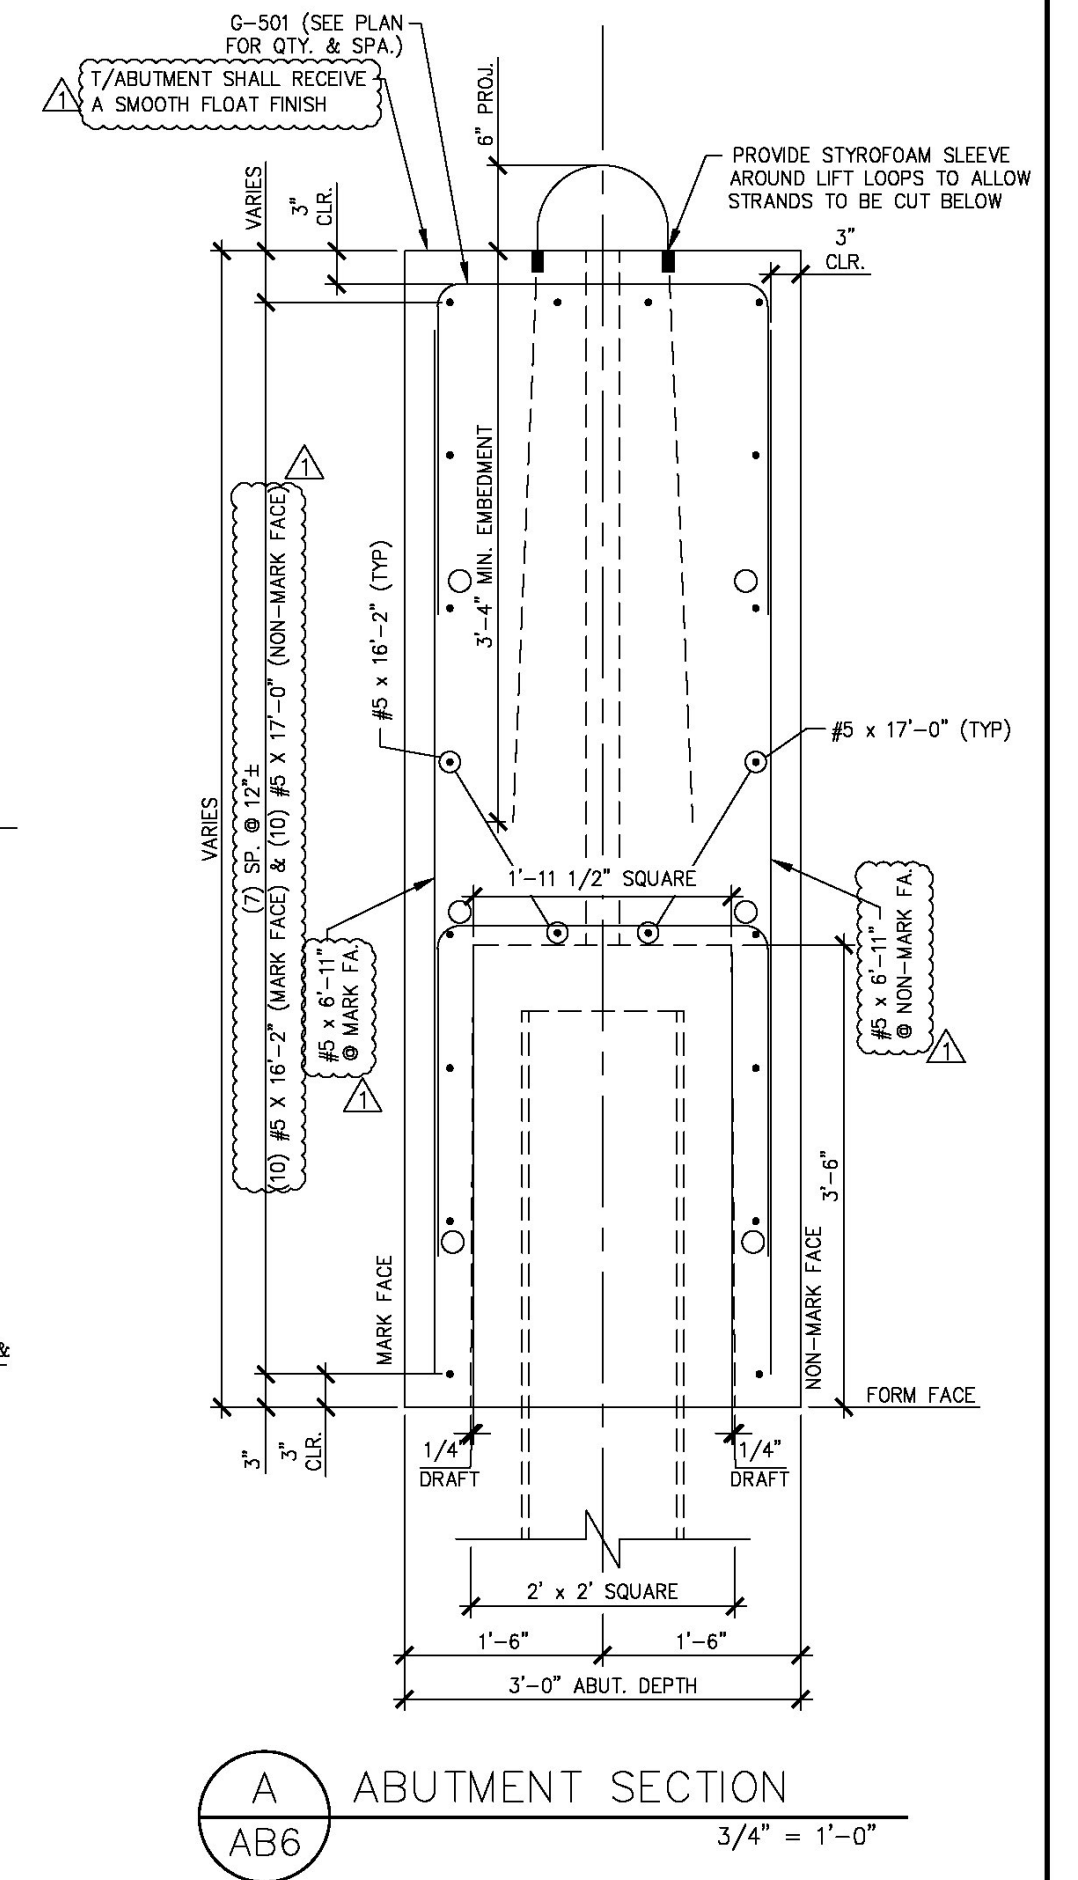

A ABUTMENT SECTION  
AB6 3/4" = 1'-0"

MATERIAL LIST / ABUTMENT			
ITEM	MARK	DESCRIPTION	QTY.
1	G-501	#5 BENT BAR	26
2	G-502	#5 BENT BAR	2
3	G-503	#5 BENT BAR	12
4		#5 x 3'-7"	10
5		#5 x 6'-11"	27
6		#5 x 10'-8"	10
7		#5 x 16'-2"	10
8		#5 x 17'-0"	10
9			
10			
11	G-601	#6 BENT BAR	6
12	G-604	#6 BENT BAR	22
13	G-605	#6 BENT BAR	22
14			
15			
16			
17			
18		SET OF (4) 0.60" x 270 KSI STRAND LIFTING LOOPS	2
19			
20			

SHOP NOTE:  
ALL EDGES OF ABUTMENT SHALL  
RECEIVE A 1" CHAMFER (U.N.O.)

**Vermont Agency of Transportation**  
**RECEIVED**  
CK'D BY MJC OK'D BY TAS  
June 18, 2014  
RESUBMIT No Approved  
BY M. J. Chenette DATE 06/19/2014

**SHOP DRAWING REVIEW**


REVIEWED AS REQUIRED BY THE CONSTRUCTION CONTRACT DOCUMENTS AND APPROVED, BUT ONLY FOR CONFORMANCE TO THE DESIGN CONCEPT OF THE WORK, AND SUBJECT TO FURTHER LIMITATIONS AND REQUIREMENTS CONTAINED IN THE CONSTRUCTION CONTRACT DOCUMENTS.

REJECTED  REVISE AND RESUBMIT  FURNISH AS CORRECTED

CORRECTIONS OR COMMENTS MADE ON THE SHOP DRAWINGS DURING THIS REVIEW DO NOT RELIEVE CONTRACTOR FROM COMPLIANCE WITH REQUIREMENTS OF THE DRAWINGS AND SPECIFICATIONS. THIS CHECK IS ONLY FOR REVIEW OF GENERAL CONFORMANCE WITH THE DESIGN CONCEPT OF THE PROJECT AND GENERAL COMPLIANCE WITH THE INFORMATION GIVEN IN THE CONTRACT DOCUMENTS. THE CONTRACTOR IS RESPONSIBLE FOR CONFIRMING AND CORRELATING ALL QUANTITIES AND DIMENSIONS, SELECTING FABRICATION PROCESSES AND TECHNIQUES OF CONSTRUCTION, COORDINATING HIS WORK WITH THAT OF OTHER TRADES, AND PERFORMING HIS WORK IN A SAFE AND SATISFACTORY MANNER.

**VHB Vanasse Hangen Brustlin, Inc.**  
7035 US Route 7  
North Ferrisburgh, VT 05473  
802.425.7788

Job Number: 57427.00  
Reviewed By: S.E. Burbank  
Date: 06/19/2014

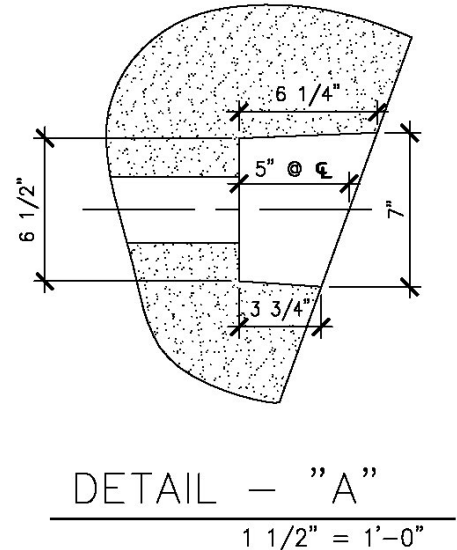

DETAIL - "A"  
1 1/2" = 1'-0"

4-7-14 REVISED AS NOTED  
5-6-14 REVISED AS NOTED

APPROVAL STAMP:

**J.P. CARRARA & SONS INC.**  
Precast & Prestress Manufacturer N.T.S.  
244 OISE STR., MIDDLEBURY, VERMONT 05753 Phone: (802)388-6361 Fax: (802)388-9010

STATE OF VERMONT AGENCY OF TRANSPORTATION  
COUNTY OF WINDHAM









TOWN OF GUILFORD  
ROUTE NO. T.H.10, CLASS III (LOCAL ROAD)  
BRIDGE NO.: 65 PROJECT NO.: BRO 1442 (36)

DATE: MAR. 04, 2014  
SCALE: NOTED  
CHKD: JJ/KLT DFTM:AA1/RWS  
JOB NO: 23420-014  
DWG. NO: AB6

PRECAST ABUTMENT DETAILS

**Eriksson technologies**  
813.989.3317  
TAMPA, FL LRFD.COM  
© 2014 ERIKSSON TECHNOLOGIES, INC. ALL RIGHTS RESERVED

S:\Engineering\Drawings\Production Drawings\AutoCAD Files\144236-WW1.dwg, 5/6/2014 4:44:42 PM, DWG To PDF.pc3

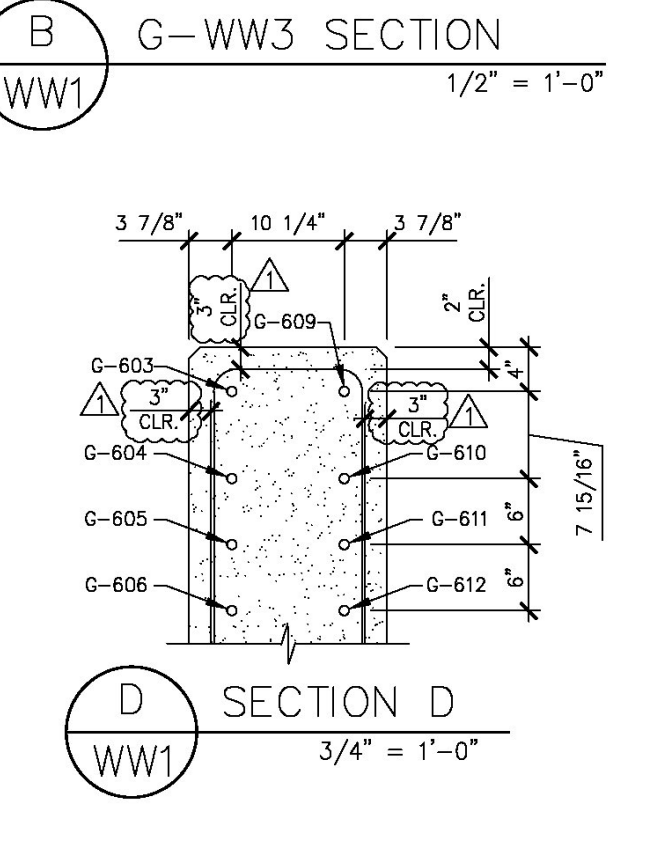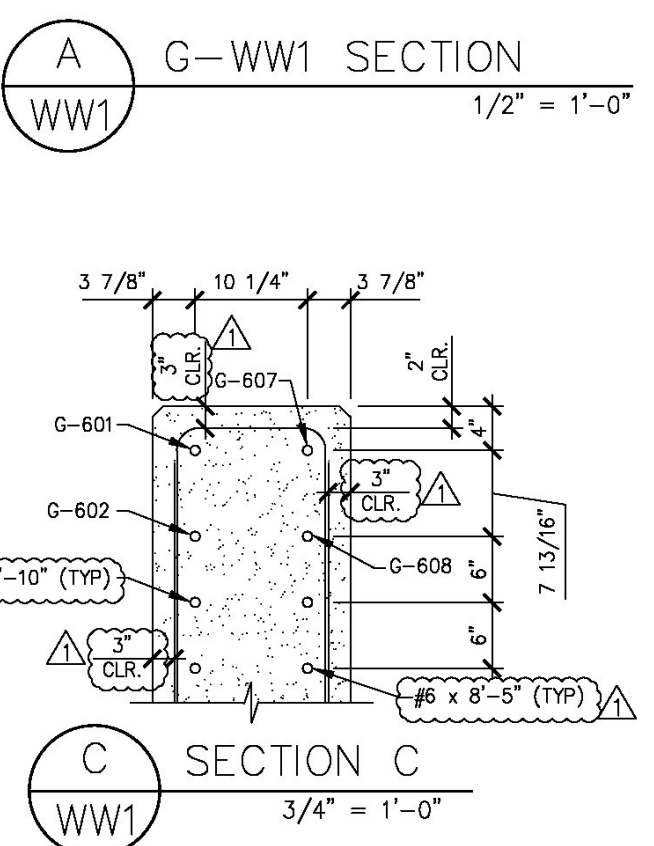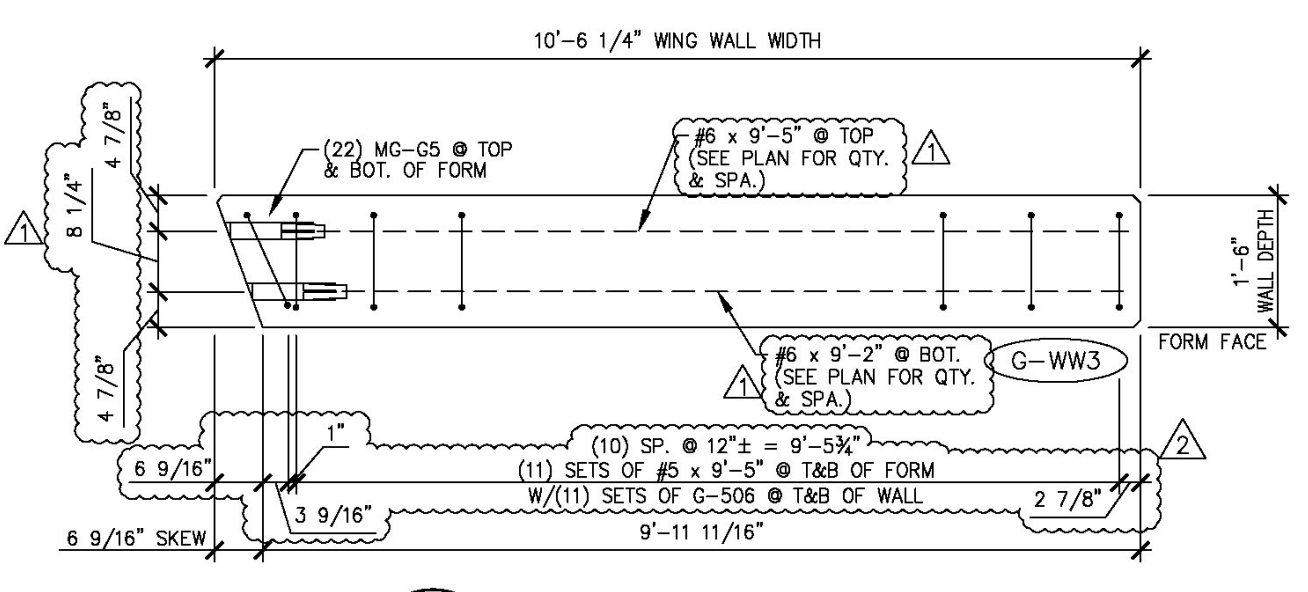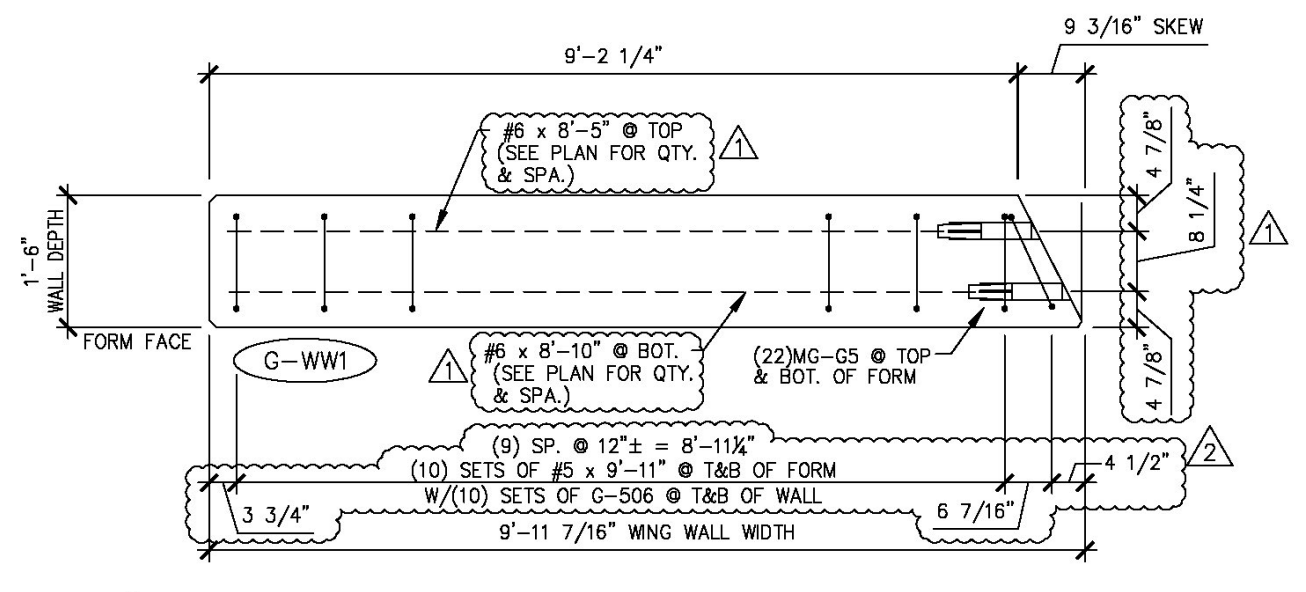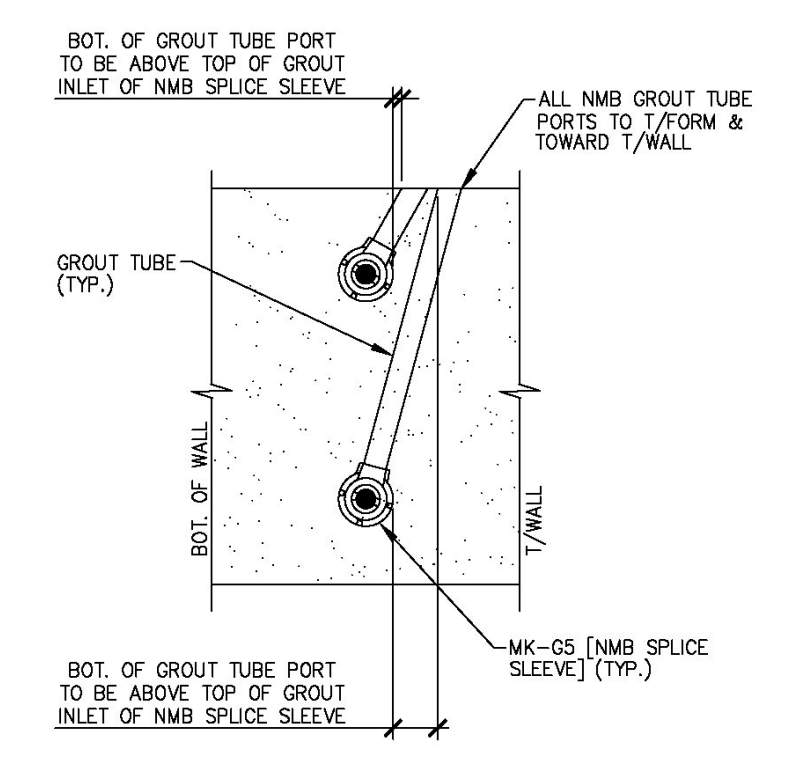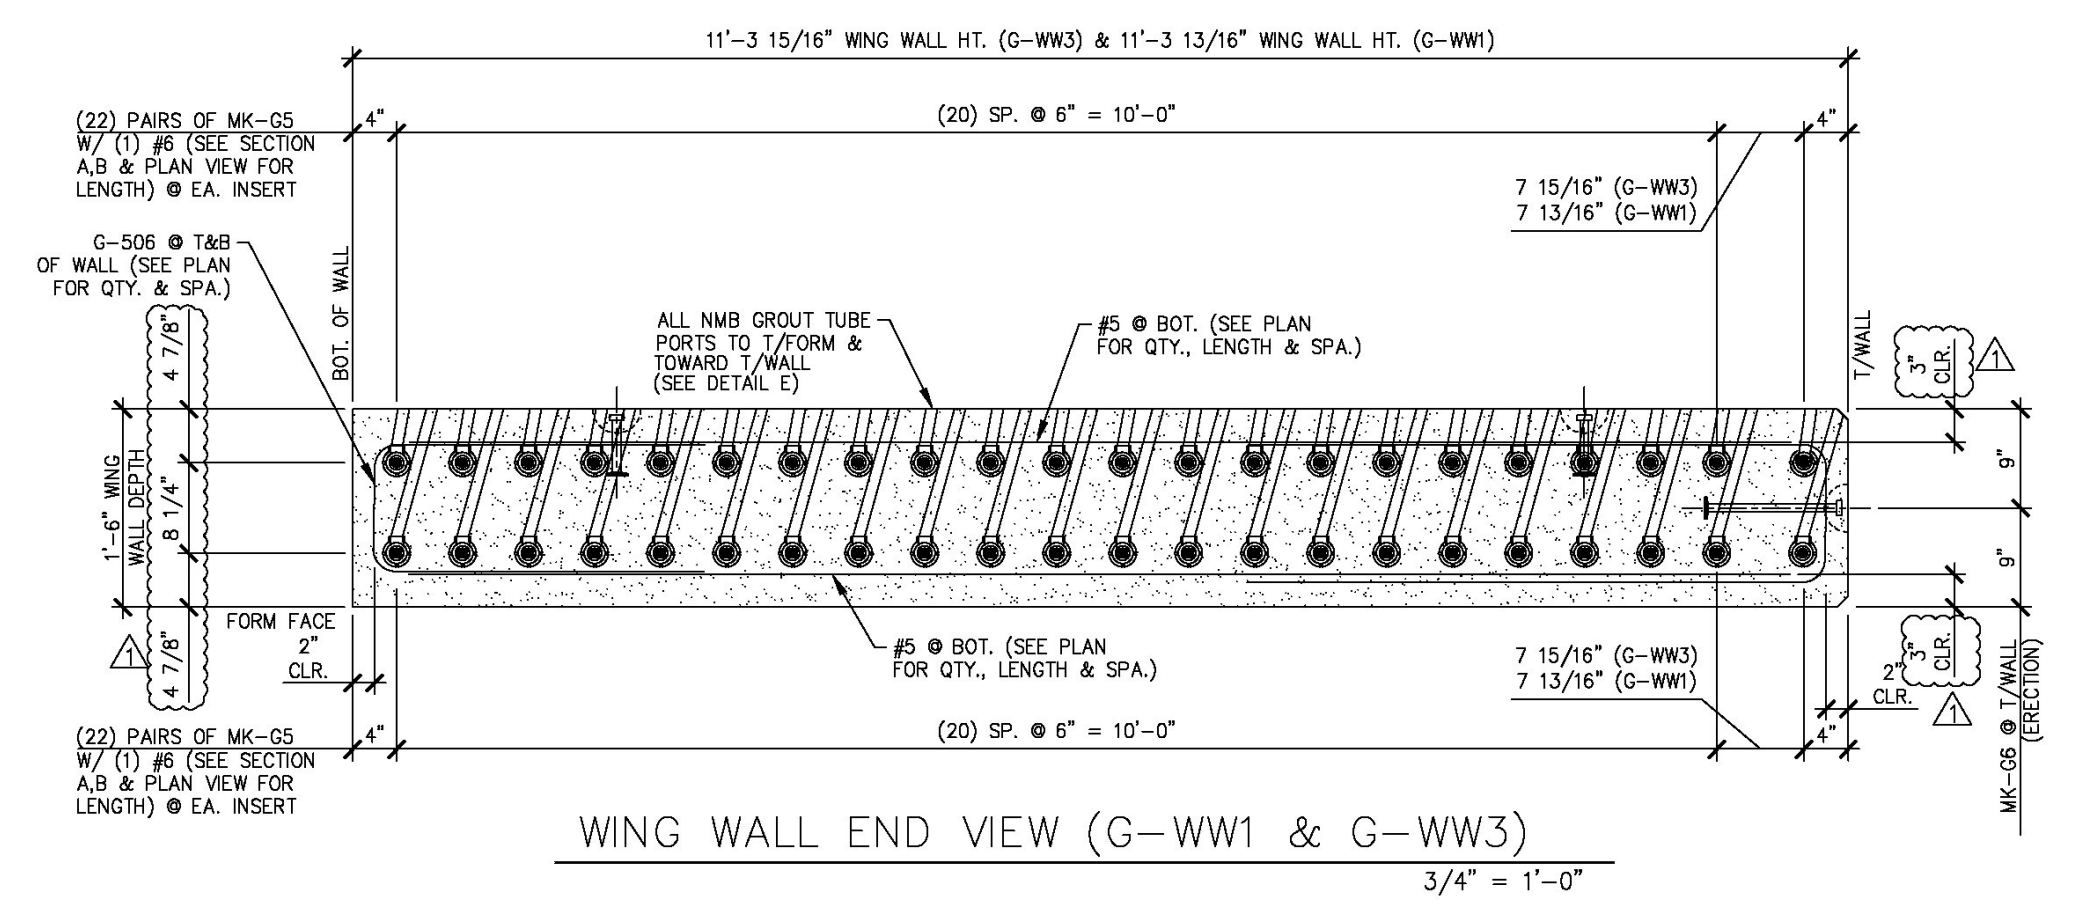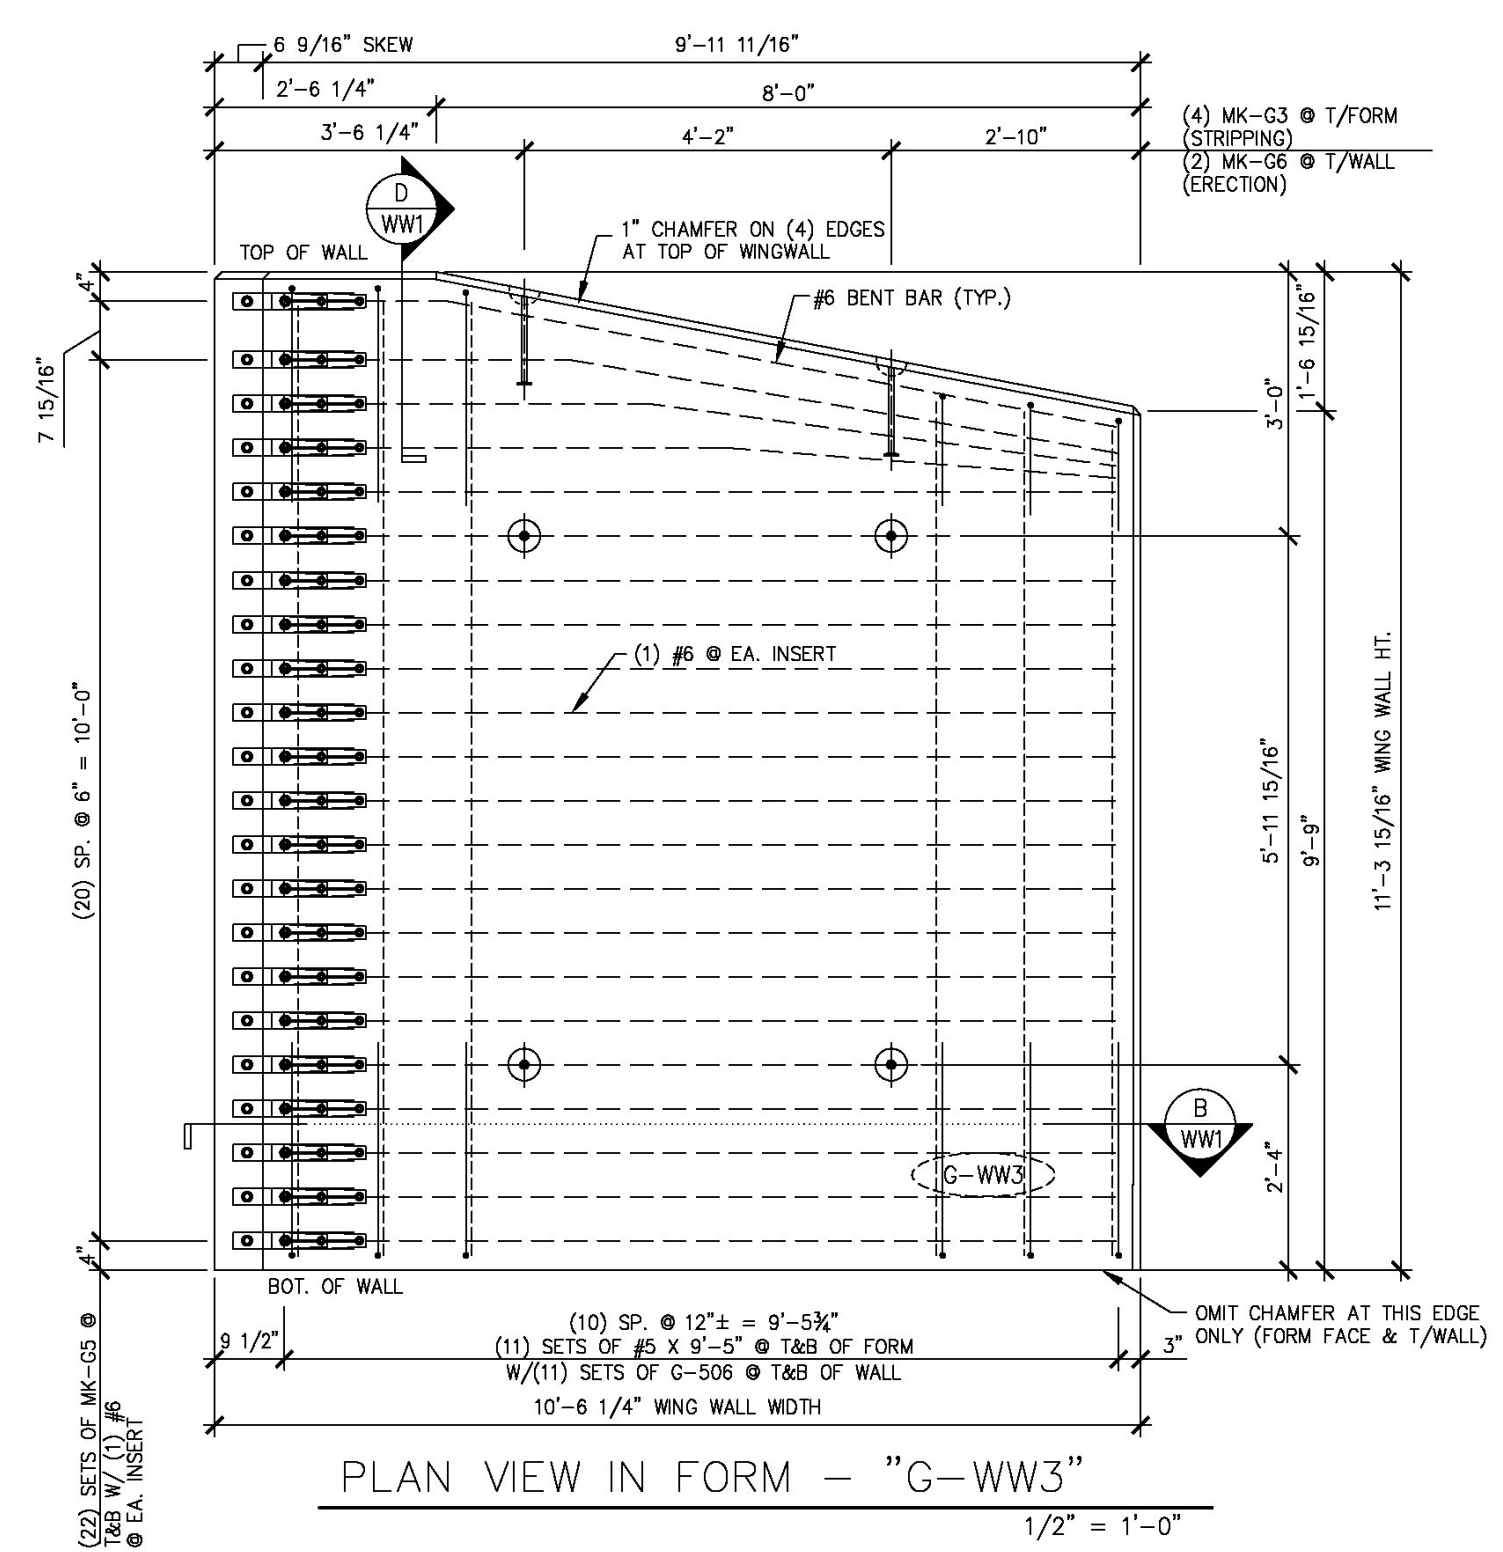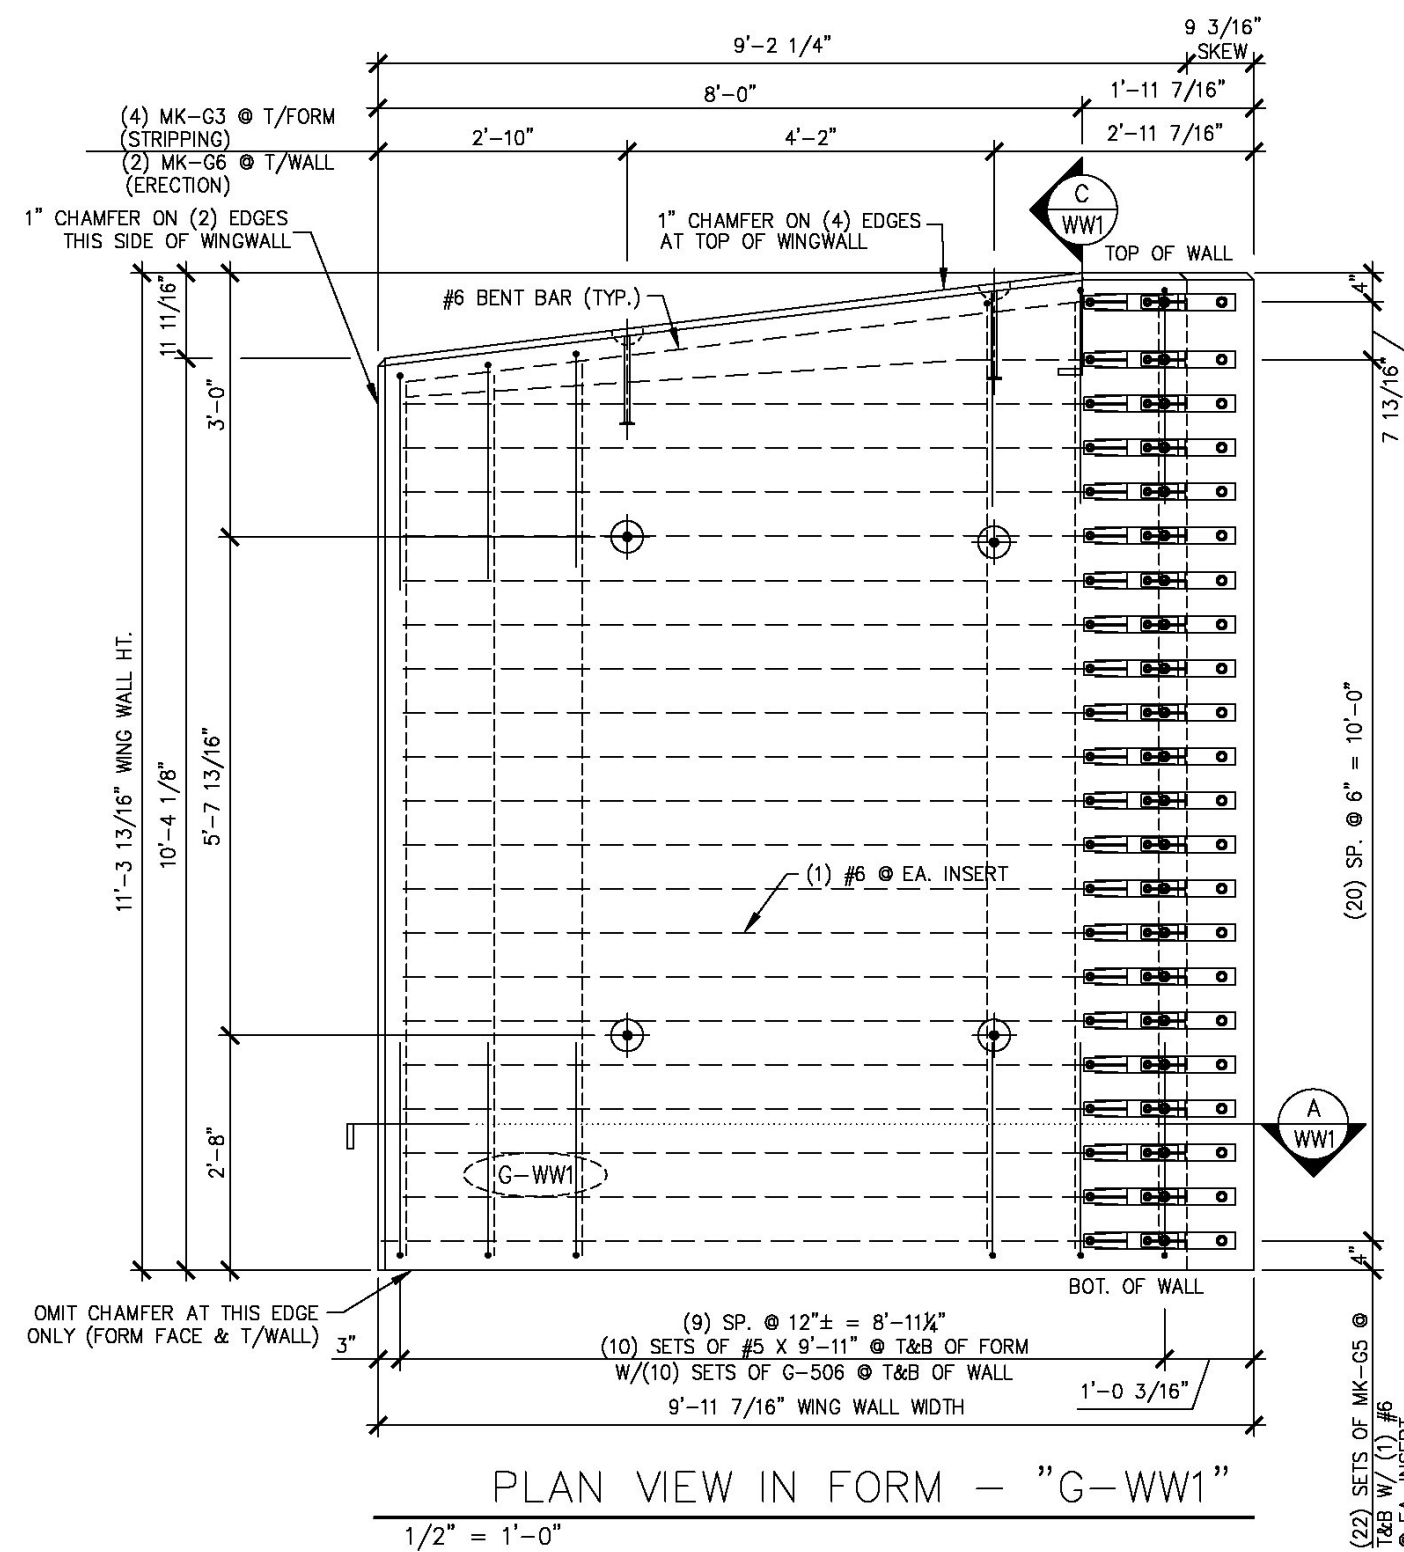

Vermont Agency of Transportation  
**RECEIVED**  
 CK'D BY MJC OK'D BY TAS  
 June 18, 2014  
 RESUBMIT No Approved  
 BY M. J. Chenette DATE 06/19/2014

**SHOP DRAWING REVIEW**  
 REVIEWED AS REQUIRED BY THE CONSTRUCTION CONTRACT DOCUMENTS AND APPROVED, BUT ONLY FOR REVIEW OF THE DESIGN CONCEPT OF THE WORK, AND SUBJECT TO FURTHER LIMITATIONS AND REQUIREMENTS CONTAINED IN THE CONSTRUCTION CONTRACT DOCUMENTS  
 REJECTED  REVISE AND RESUBMIT  FURNISH AS CORRECTED  
 CORRECTIONS OR COMMENTS MADE ON THE SHOP DRAWINGS DURING THIS REVIEW DO NOT RELIEVE CONTRACTOR FROM COMPLIANCE WITH REQUIREMENTS OF THE DRAWINGS AND SPECIFICATIONS. THIS CHECK IS ONLY FOR REVIEW OF GENERAL CONFORMANCE WITH THE DESIGN CONCEPT OF THE PROJECT AND GENERAL COMPLIANCE WITH THE INFORMATION GIVEN IN THE CONTRACT DOCUMENTS. THE CONTRACTOR IS RESPONSIBLE FOR CONFIRMING AND CORRELATING ALL QUANTITIES AND DIMENSIONS, SELECTING FABRICATION PROCESSES AND TECHNIQUES OF CONSTRUCTION, COORDINATING HIS WORK WITH THAT OF ALL OTHER TRADES, AND PERFORMING HIS WORK IN A SAFE AND SATISFACTORY MANNER.  
**Vanasse Hangen Brustlin, Inc.**  
 7056 US Route 7 North Ferrisburgh, VT 05473 802.425.7788  
 Job Number: 57427.00  
 Reviewed By: S.E. Burbank  
 Date: 06/19/2014

MARK:	QTY.:	WT.:	VOL.:
G-WW1	1	11.81 T	5.84 cy
G-WW3	1	12.39 T	6.12 cy

MATERIAL LIST / WING WALL				
ITEM	MARK	DESCRIPTION	QTY./WING WALL	
			G-WW1	G-WW3
1	G-506	#5 BENT BAR	22	24
2	G-601	#6 BENT BAR	1	0
3	G-602	#6 BENT BAR	1	0
4	G-603	#6 BENT BAR	0	1
5	G-604	#6 BENT BAR	0	1
6	G-605	#6 BENT BAR	0	1
7	G-606	#6 BENT BAR	0	1
8	G-607	#6 BENT BAR	1	0
9	G-608	#6 BENT BAR	1	0
10	G-609	#6 BENT BAR	0	1
11	G-610	#6 BENT BAR	0	1
12	G-611	#6 BENT BAR	0	1
13	G-612	#6 BENT BAR	0	1
14				
15		#5 x 9'-5"	0	24
16		#5 x 9'-11"	22	0
17				
18		#6 x 8'-5"	20	0
19		#6 x 8'-10"	20	0
20		#6 x 9'-2"	0	18
21		#6 x 9'-5"	0	18
22				
23				
24	MK-G3	4T x 9 1/2" SWIFT LIFT LIFTER	4	4
26	MK-G5	NMB SPLICE SLEEVE 6U-X(PC)	44	44
27	MK-G6	20T x 19 3/4" SWIFT LIFT LIFTER	2	2









4-7-14 REVISED AS NOTED  
 5-6-14 REVISED AS NOTED

APPROVAL STAMP:

**J.P. CARRARA & SONS INC.**  
 Precast & Prestress Manufacturer N.T.S.  
 244 CASE STR. MIDDLEBURY, VERMONT 05753 Phone:(802)388-6361 Fax:(802)388-9010  
 STATE OF VERMONT AGENCY OF TRANSPORTATION  
 COUNTY OF WINDHAM  
 TOWN OF GUILFORD  
 ROUTE NO. T.H.10, CLASS III (LOCAL ROAD)  
 BRIDGE NO.: 65 PROJECT NO.: BRO 1442 (36)  
 PRECAST WING WALL DETAILS  
 DATE: MAR. 04, 2014  
 SCALE: NOTED  
 CHKD: JJ/KLT DFTM:AA1/RWS  
 JOB NO: 23420-014  
 DWG. NO: WW1

**Eriksson technologies**  
 813.989.3317  
 TAMPA, FL LRFD.COM  
 © 2014 ERIKSSON TECHNOLOGIES, INC. ALL RIGHTS RESERVED

S:\Engineering Services\Carrera\14001 - Guilford Bridge 651\Production Drawings\AutoCAD Files\144236-WW1.dwg, 5/6/2014 4:44:43 PM, DWG To PDF.pc3

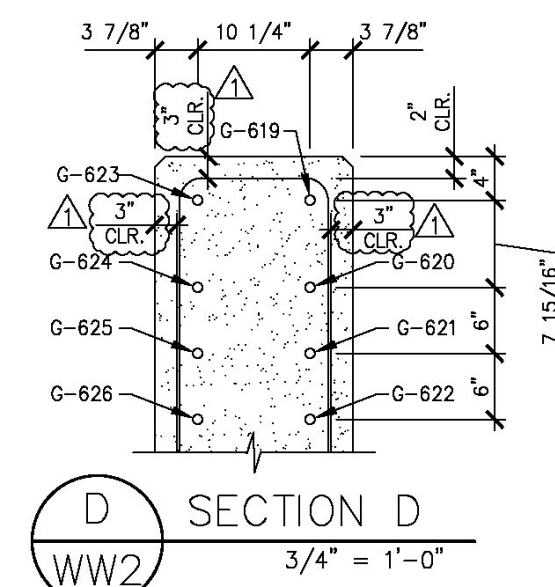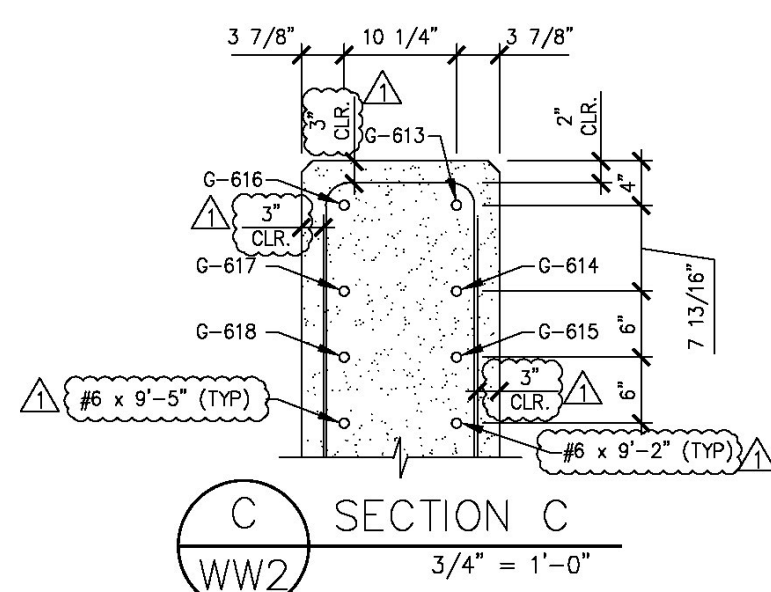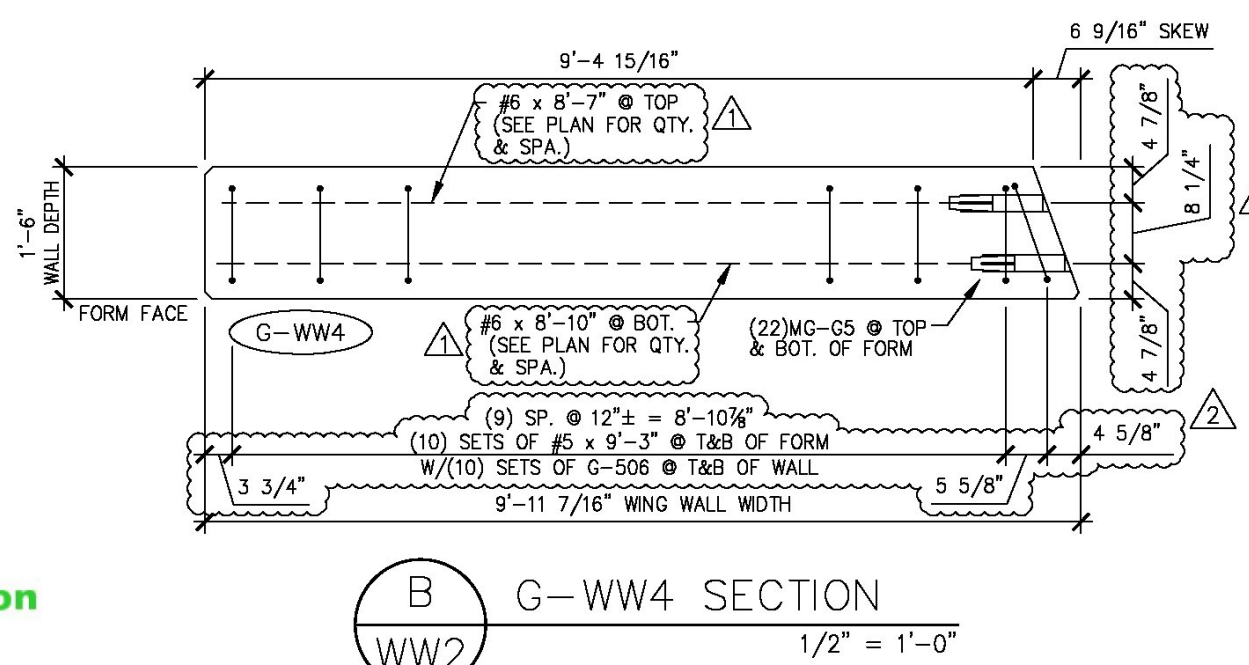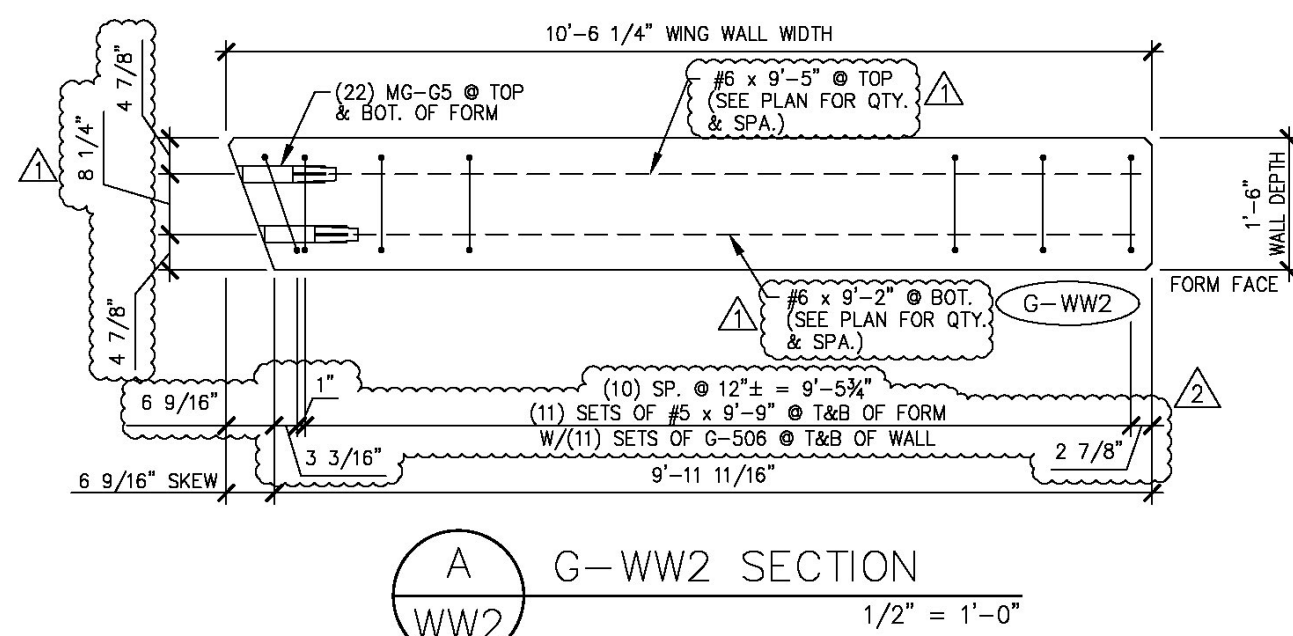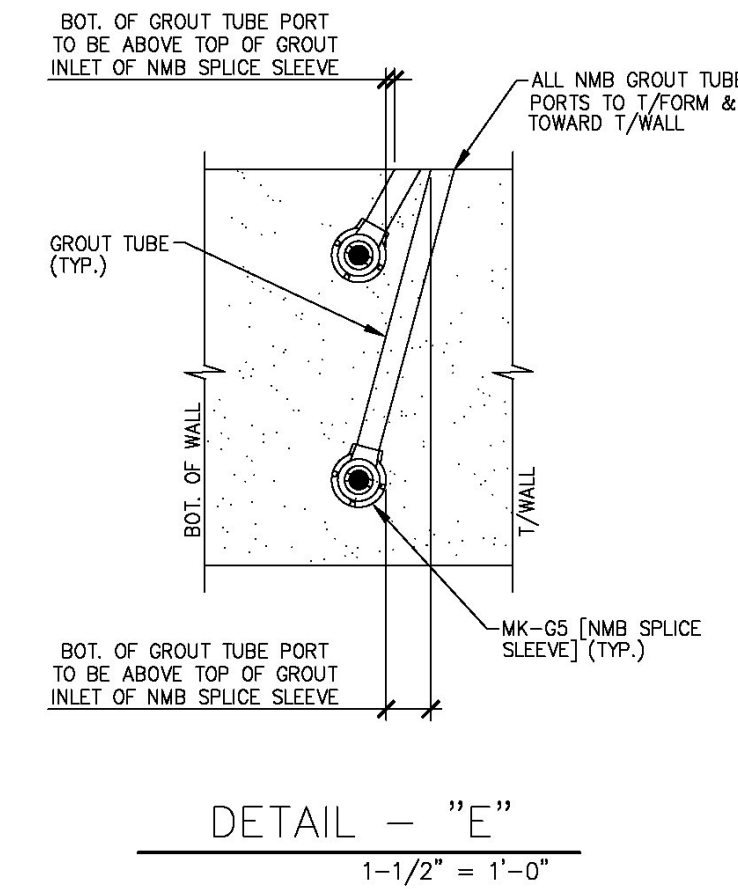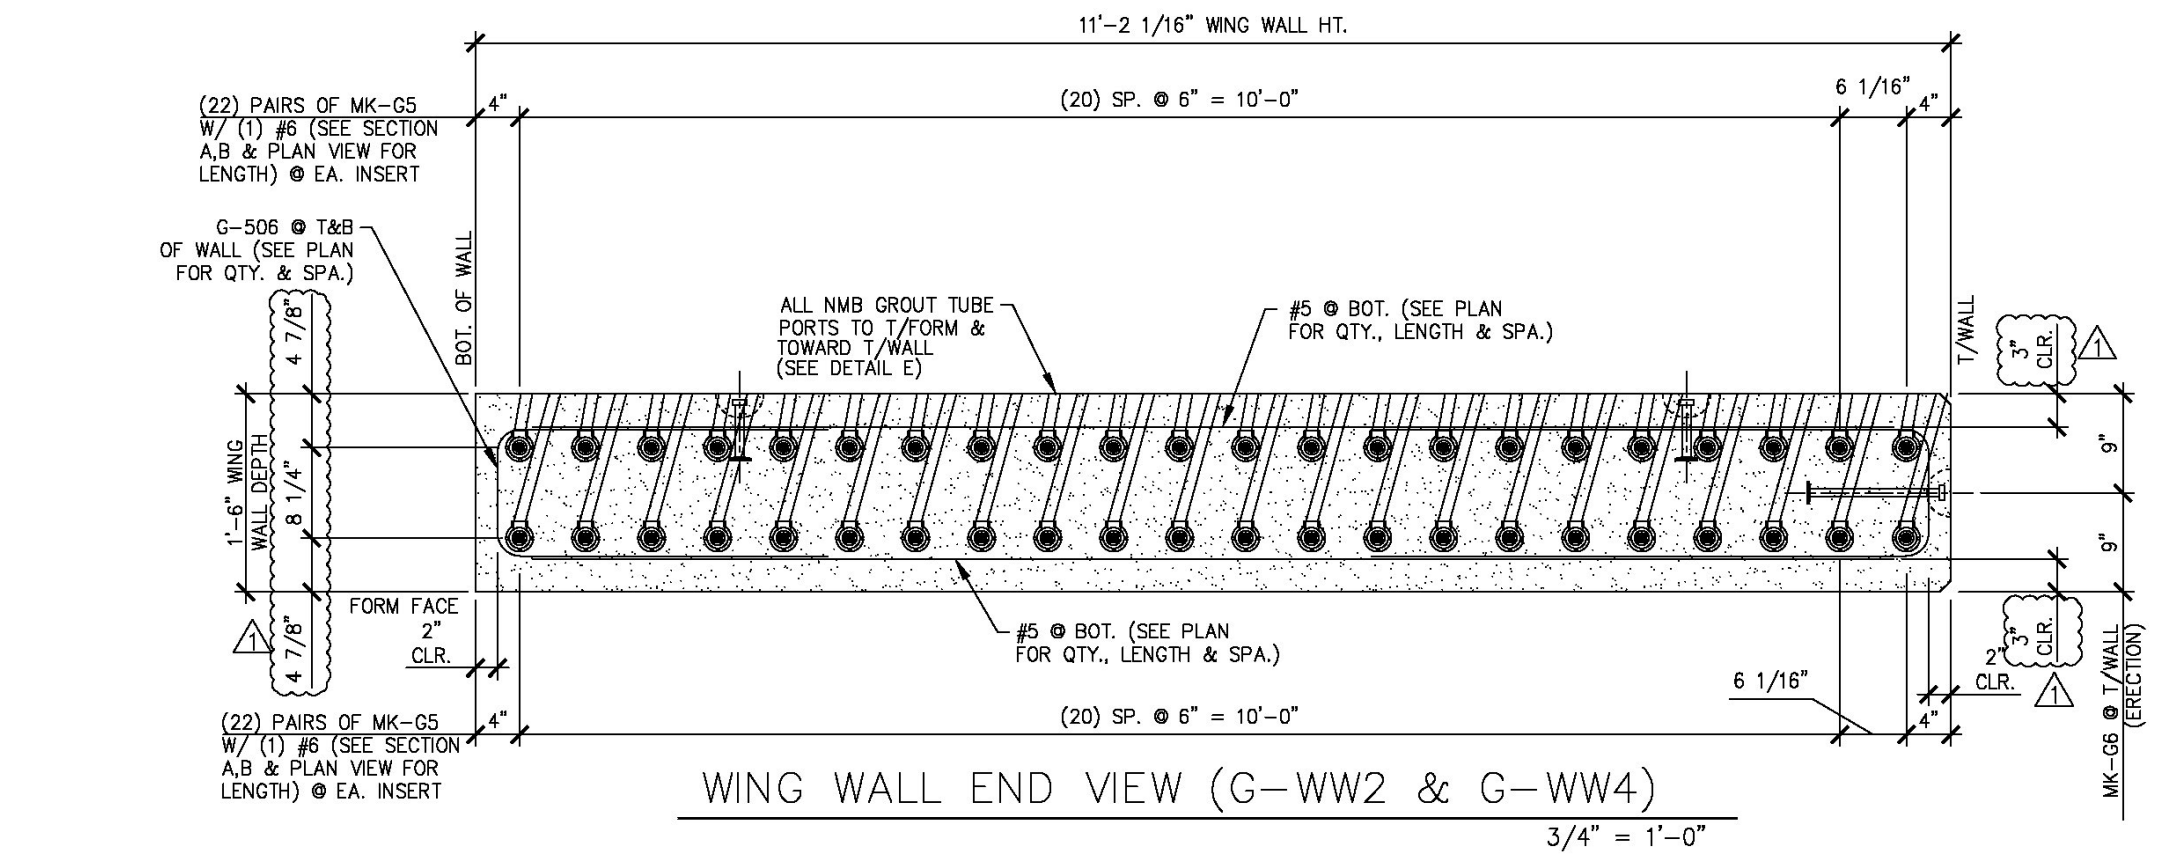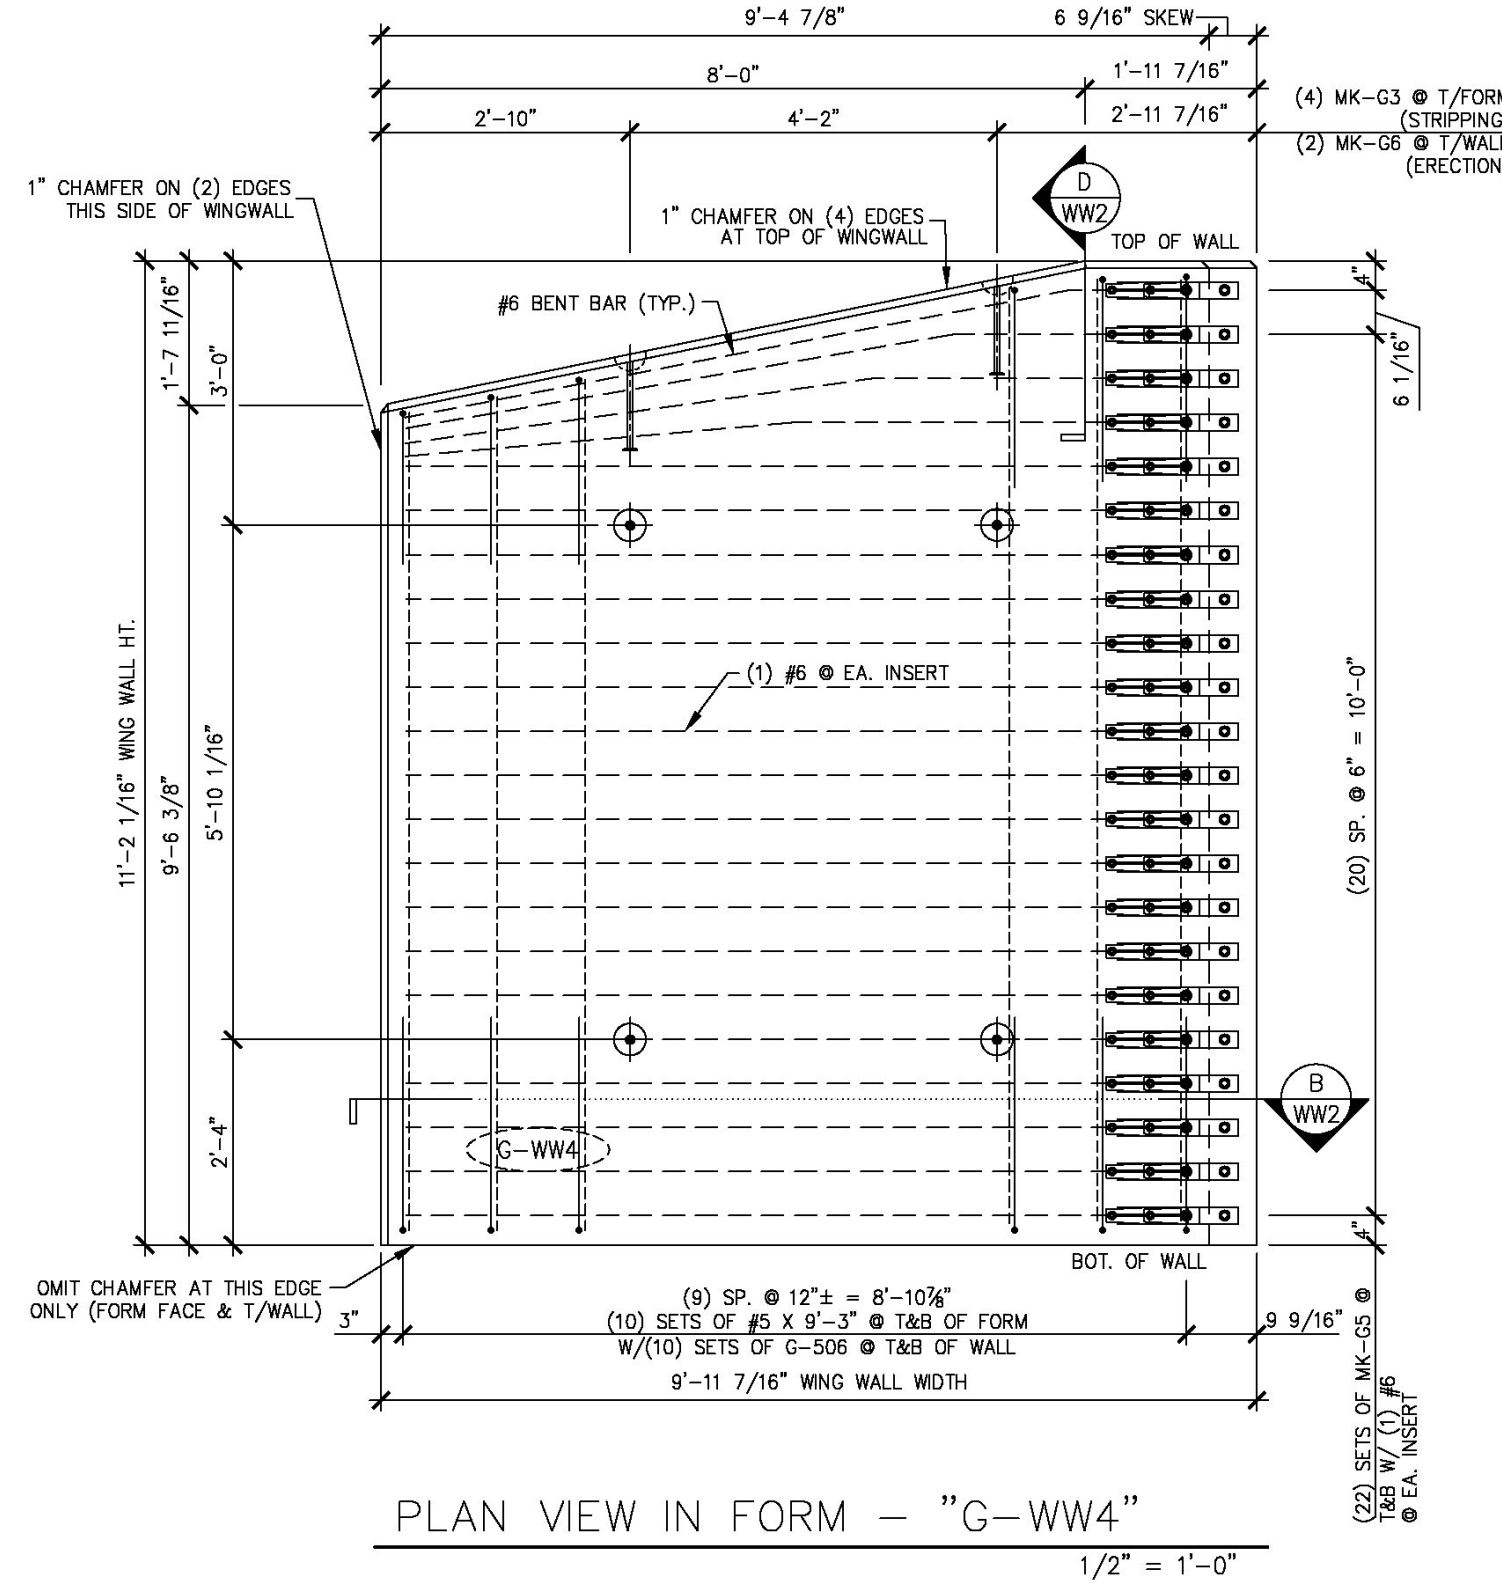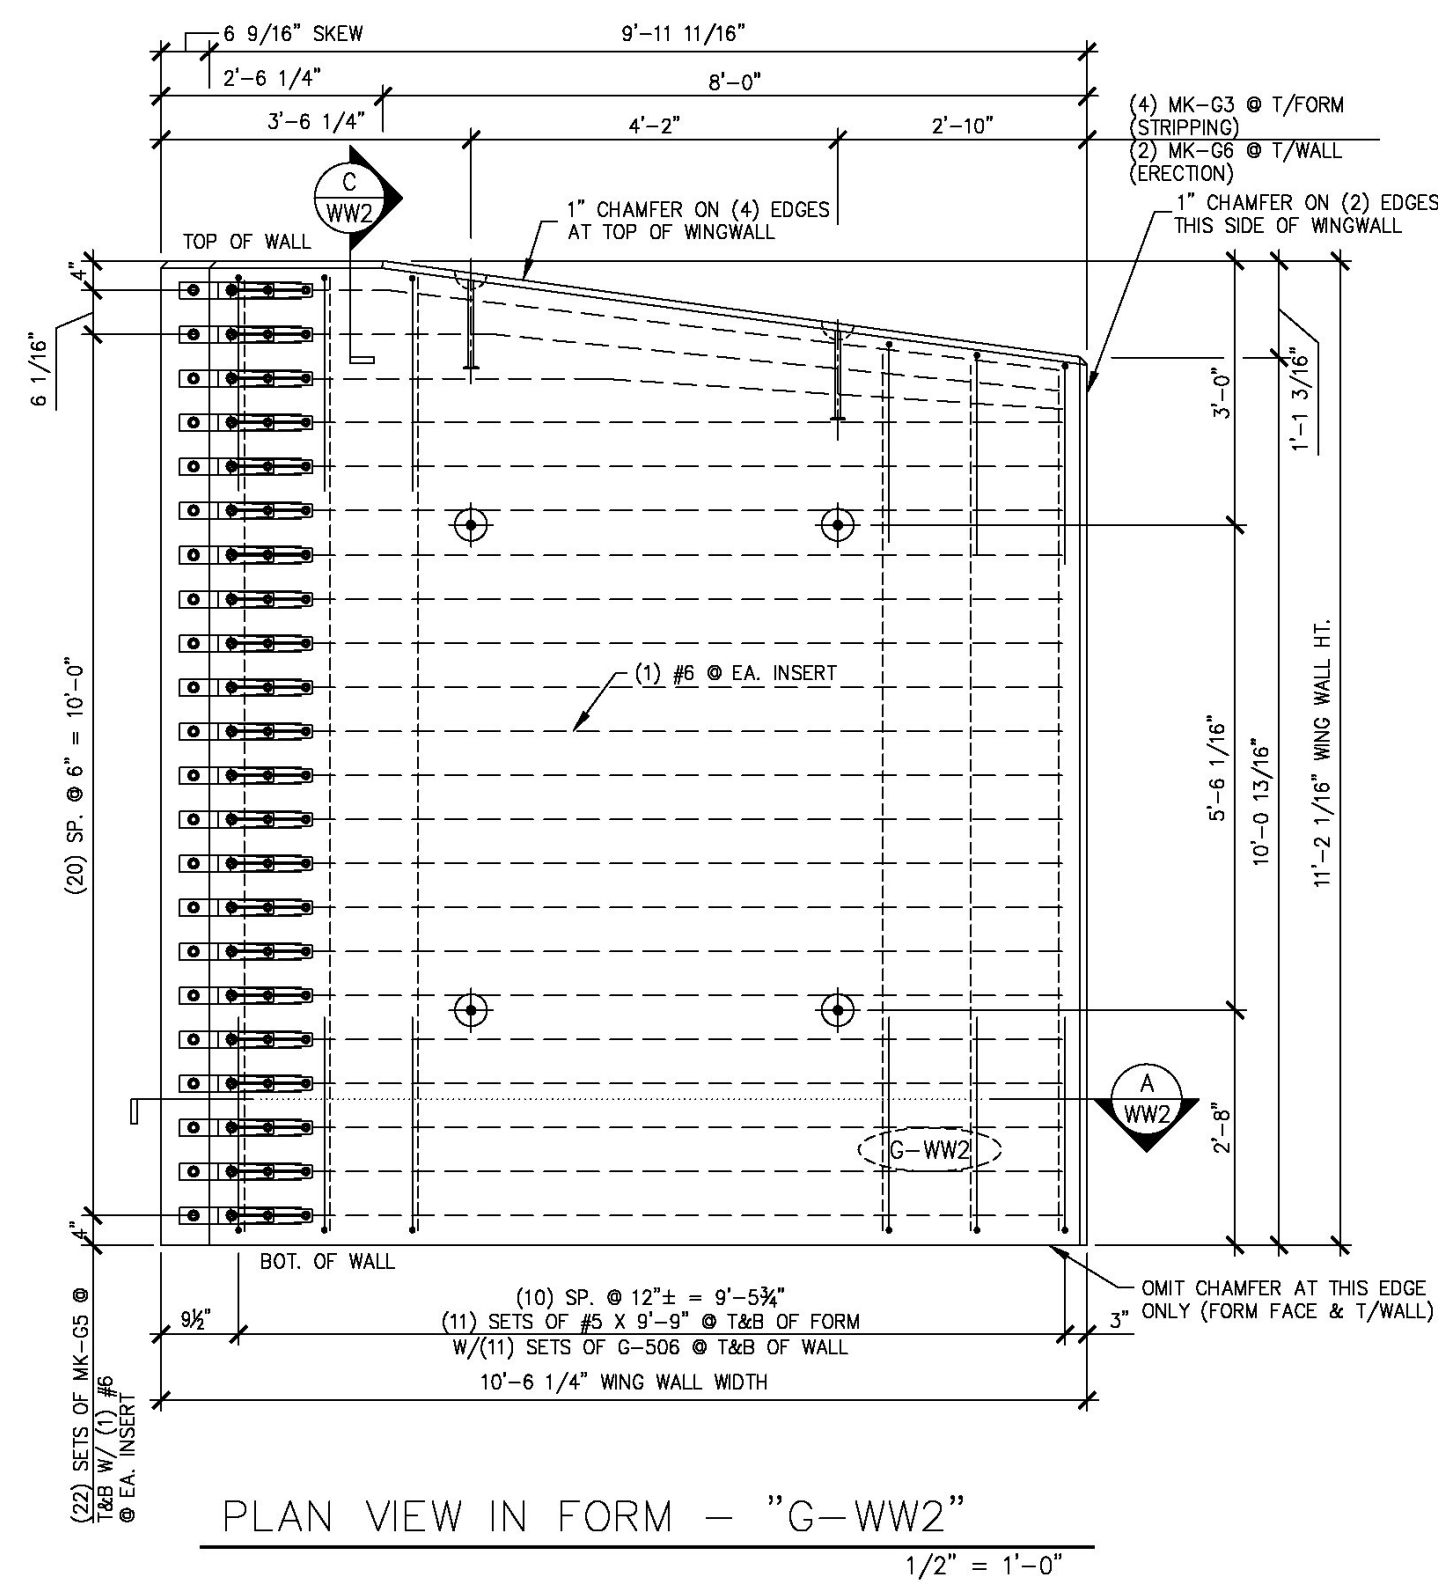

SHOP NOTE:  
ALL EDGES OF WING WALLS,  
FORM FACE & T/WALL FACE,  
SHALL RECEIVE A 1" CHAMFER  
(UNLESS NOTED OTHERWISE)

4-7-14 REVISED AS NOTED  
5-6-14 REVISED AS NOTED

MARK:	G-WW2	QTY.:	1	WT.:	12.42 T	VOL.:	6.13 cy
MARK:	G-WW4	QTY.:	1	WT.:	11.49 T	VOL.:	5.68 cy

MATERIAL LIST / WING WALL							
ITEM	MARK	DESCRIPTION	QTY./WING WALL				
			G-WW2	G-WW4			
1	G-506	#5 BENT BAR	24	22			
2	G-613	#6 BENT BAR	1	0			
3	G-614	#6 BENT BAR	1	0			
4	G-615	#6 BENT BAR	1	0			
5	G-616	#6 BENT BAR	1	0			
6	G-617	#6 BENT BAR	1	0			
7	G-618	#6 BENT BAR	1	0			
8	G-619	#6 BENT BAR	0	1			
9	G-620	#6 BENT BAR	0	1			
10	G-621	#6 BENT BAR	0	1			
11	G-622	#6 BENT BAR	0	1			
12	G-623	#6 BENT BAR	0	1			
13	G-624	#6 BENT BAR	0	1			
14	G-625	#6 BENT BAR	0	1			
15	G-626	#6 BENT BAR	0	1			
16							
17		#5 x 9'-3"	0	22			
18		#5 x 9'-9"	24	0			
19							
20							
21							
22		#6 x 8'-2"	0	18			
23		#6 x 8'-10"	0	18			
24		#6 x 9'-2"	19	0			
25		#6 x 9'-5"	19	0			
26							
27	MK-G3	4T x 9 1/2" SWIFT LIFT LIFTER	4	4			
28	MK-G5	NMB SPLICE SLEEVE 6U-X(PC)	44	44			
29	MK-G6	20T x 19 3/4" SWIFT LIFT LIFTER	2	2			

Vermont Agency of Transportation  
**RECEIVED**  
CK'D BY MJC OK'D BY TAS  
June 18, 2014  
RESUBMIT No Approved  
BY M. J. Chenette DATE 06/19/2014

**SHOP DRAWING REVIEW**

REVIEWED AS REQUIRED BY THE CONSTRUCTION CONTRACT DOCUMENTS AND APPROVED, BUT ONLY FOR CONFORMANCE TO THE DESIGN CONCEPT OF THE WORK, AND SUBJECT TO FURTHER LIMITATIONS AND REQUIREMENTS CONTAINED IN THE CONSTRUCTION CONTRACT DOCUMENTS.

REJECTED  REVISE AND RESUBMIT  FURNISH AS CORRECTED

CORRECTIONS OR COMMENTS MADE ON THE SHOP DRAWINGS DURING THIS REVIEW DO NOT RELIEVE CONTRACTOR FROM COMPLIANCE WITH REQUIREMENTS OF THE DRAWINGS AND SPECIFICATIONS. THIS CHECK IS ONLY FOR REVIEW OF GENERAL CONFORMANCE WITH THE DESIGN CONCEPT OF THE PROJECT AND GENERAL COMPLIANCE WITH THE INFORMATION GIVEN IN THE CONTRACT DOCUMENTS. THE CONTRACTOR IS RESPONSIBLE FOR CONFIRMING AND CORRELATING ALL QUANTITIES AND DIMENSIONS, SELECTING FABRICATION PROCESSES AND TECHNIQUES OF CONSTRUCTION, COORDINATING HIS WORK WITH THAT OF ALL OTHER TRADES, AND PERFORMING HIS WORK IN A SAFE AND SATISFACTORY MANNER.

**Vanasse Hangen Brustlin, Inc.**  
7056 US Route 7  
North Ferrisburgh, VT 05473  
802.425.7788

Job Number: 57427 00  
Reviewed By: S.E. Burbank  
Date: 06/19/2014

**Eriksson technologies**  
813.989.3317  
TAMPA, FL LRF.D.COM  
© 2014 ERIKSSON TECHNOLOGIES, INC. ALL RIGHTS RESERVED

APPROVAL STAMP:

**J.P. CARRARA & SONS INC.**  
Precast & Prestress Manufacturer N.T.S.  
2464 OASE STR, MIDDLEBURY, VERMONT 05753 Phone:(802)388-6361 Fax:(802)388-9010

STATE OF VERMONT AGENCY OF TRANSPORTATION  
COUNTY OF WINDHAM

TOWN OF GUILFORD  
ROUTE NO. T.H.10, CLASS III (LOCAL ROAD)  
BRIDGE NO.: 65 PROJECT NO.: BRO 1442 (36)


PRECAST WING WALL DETAILS

DATE: MAR. 04, 2014  
SCALE: NOTED


CHKD: JJ/KLT DFTM:AA1/RWS  
JOB NO: 23420-014

DWG. NO: WW2




S:\Engineering Services\Carrara\116001 - Guilford Bridge 65\Production Drawings\AutoCAD Files\144236-M.dwg, 5/6/2014 4:44:46 PM, DWG To PDF.pc3

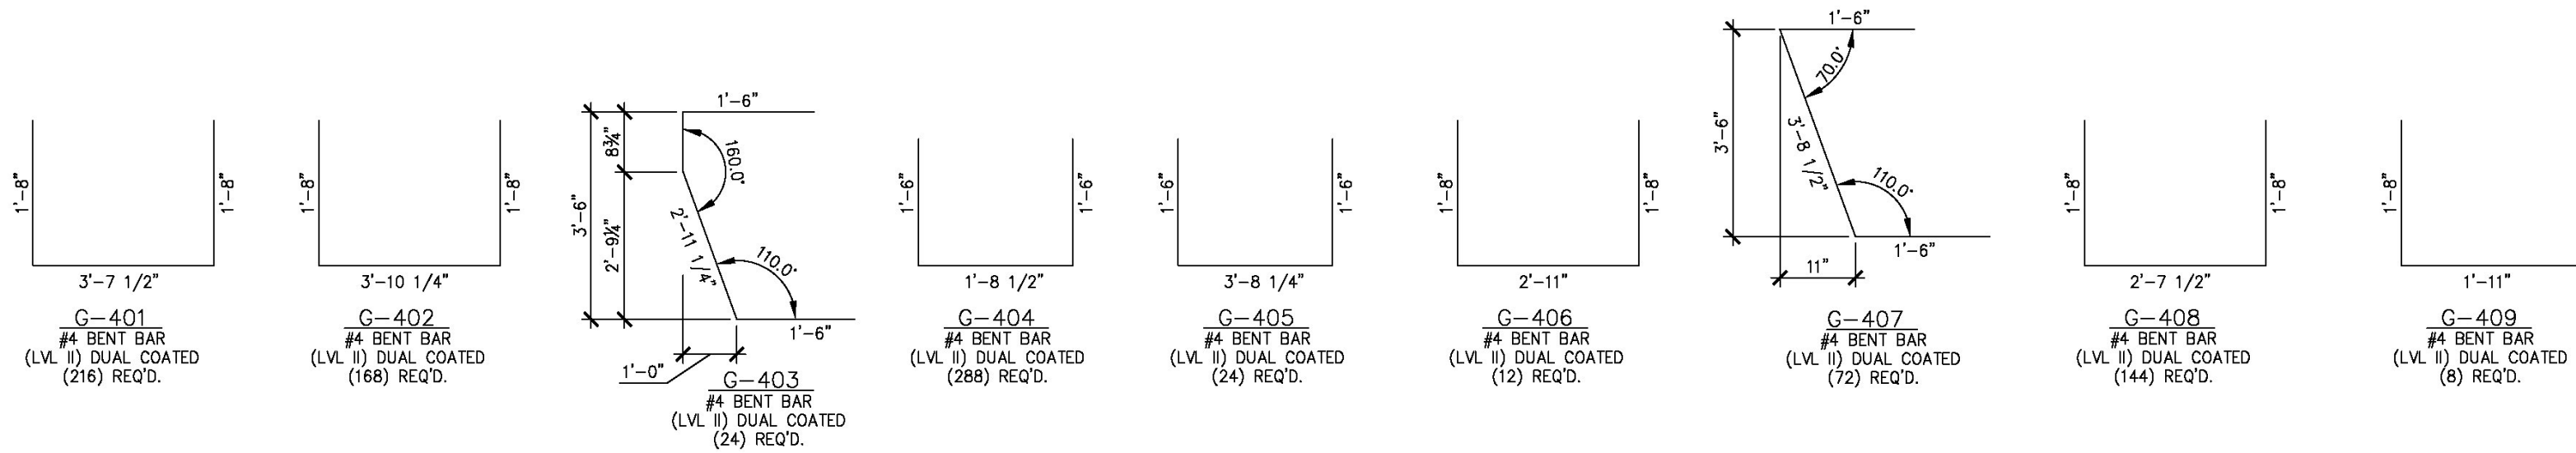

**PRESTRESSED BOX BEAMS**

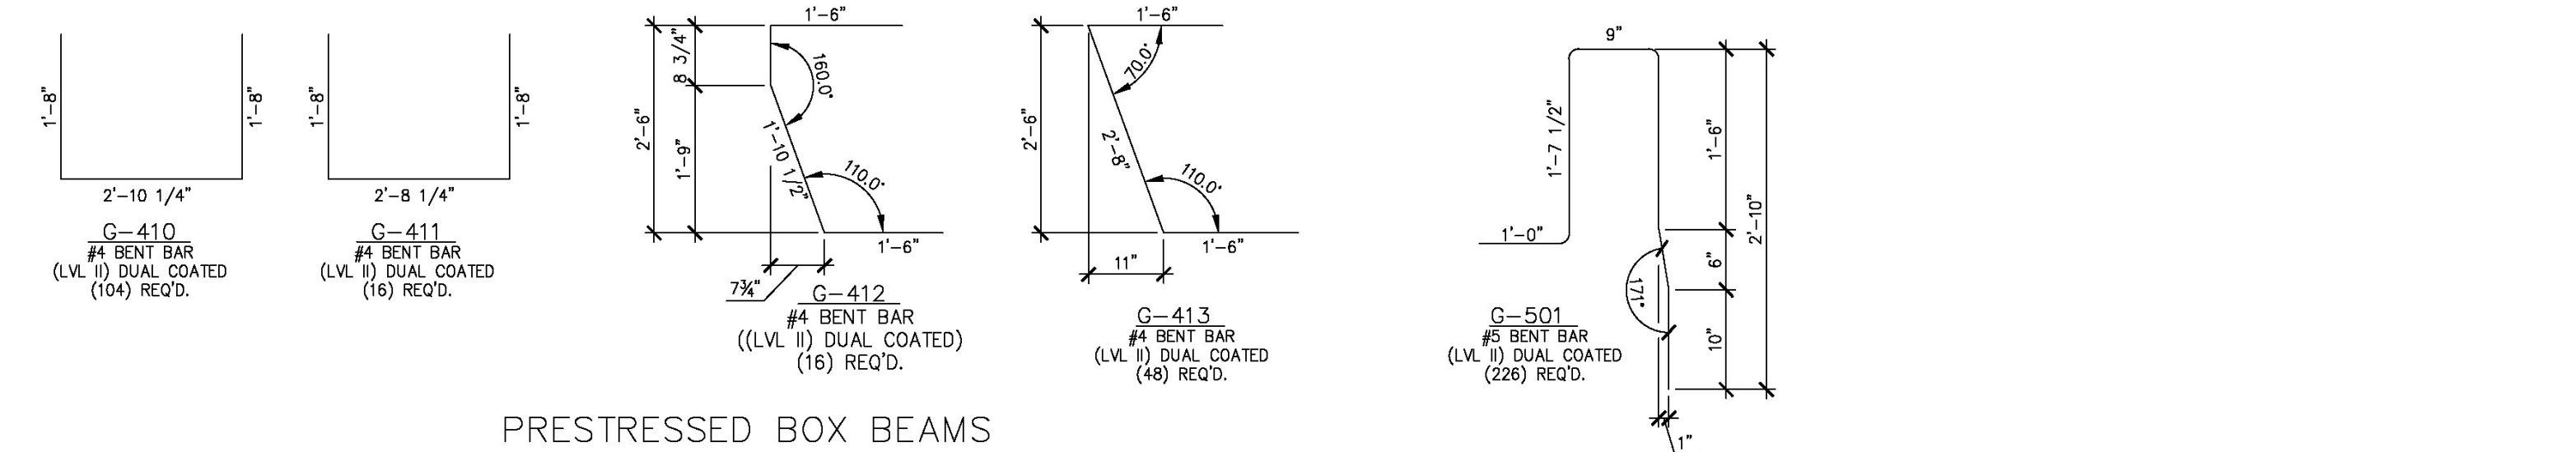

**PRECAST ABUTMENTS**

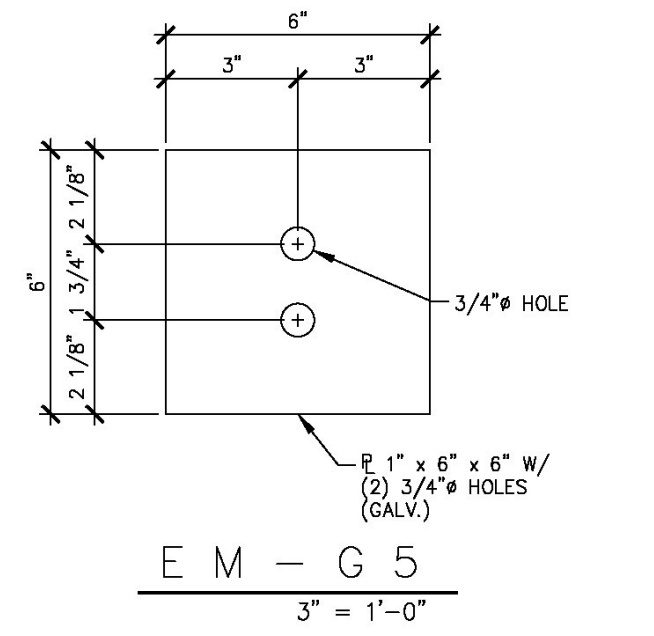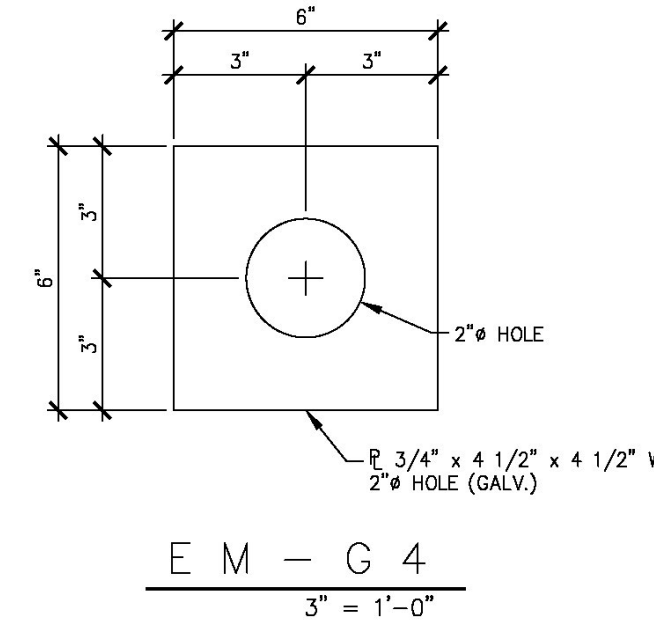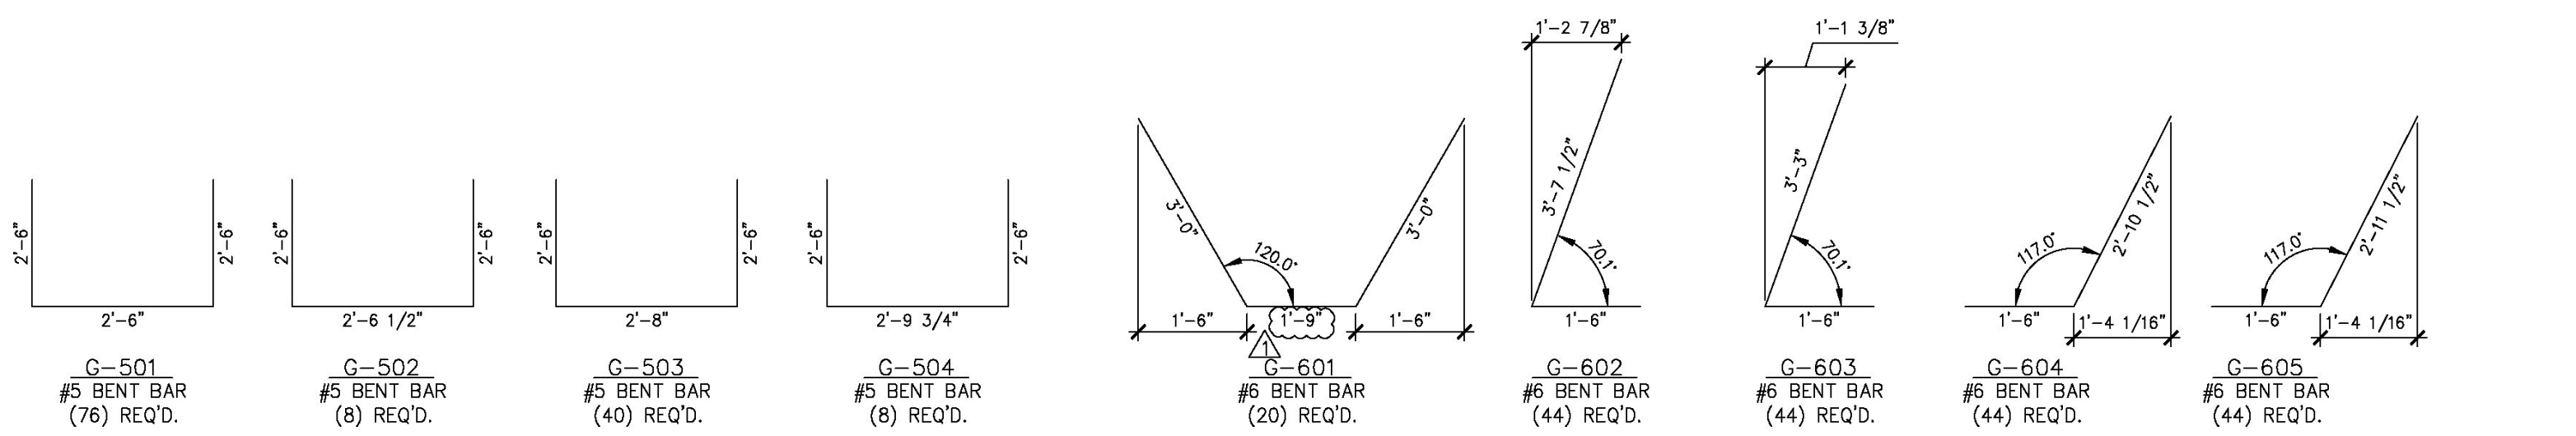

MISCELLANEOUS MATERIALS				
ITEM	MARK	QTY.	DESCRIPTION	REMARKS
1		42	#5 x 27'-7" ((LEVEL II) DUAL COATED)	
2		42	#5 x 32'-7" ((LEVEL II) DUAL COATED)	
3				
4	MK-G1	36	1" # GUARD RAIL ANCHOR "U" BOLTS W/ (4)NUTS, (4)WASHERS (SUPPLIED BY OTHERS)	ASTM A449 OR 4325 (GALV.)
5				
6		20	SET OF (3) 0.60" # x 270 KSI STRAND LIFTING LOOPS	
7				
8				
9	EM-G1	10	1 1/2" # x 4'-10 3/4" ANCHOR ROD (GALV.) & 1 1/2" # STD. WASHER (GALV.)	FOR ERECTION
10	EM-G2	10	1 1/2" # HEAVY HEX NUT (GALV.) & 1 1/2" # STD. WASHER (GALV.)	FOR ERECTION
11	EM-G3	10	1/2" x 5" x 5" W/ 1 3/4" # HOLE (GALV.)	FOR ERECTION
12	EM-G4	8	3/4" x 6" x 6" W/ 2" # HOLE (GALV.)	FOR ERECTION; SEE DETAIL THIS SHEET
13	EM-G5	4	1" x 6" x 6" W/ (2) 3/4" # HOLES (GALV.)	FOR ERECTION; SEE DETAIL THIS SHEET
14		8	0.6" # x 26'-0" POLY-STRAND	FOR ERECTION
15				
16		20	#5 x 3'-7"	
17		20	#5 x 4'-0"	
18		24	#5 x 6'-10"	
19		54	#5 x 6'-11"	
20		20	#5 x 10'-0"	
21		42	#5 x 10'-8"	
22		20	#5 x 10'-10"	
23		20	#5 x 17'-0"	
24				
25		8	SET OF (4) 0.60" # x 270 KSI STRAND LIFTING LOOPS	
26				
27	EM-G4	12	3/4" x 6" x 6" W/ 2" # HOLE (GALV.)	FOR ERECTION; SEE DETAIL THIS SHEET
28		24	0.5" # x 34'-0" POLY-STRAND	FOR ERECTION
29				
30				
31				
32				
33				
34				
35				
36				
37				
38				
39				
40				

PRESTRESSED BOX BEAMS  
PRECAST ABUTMENTS

Vermont Agency of Transportation  
**RECEIVED**  
04/18/2014 10:42:06 - Precast Submittal 001.dwg

CK'D BY MJC OK'D BY TAS

June 18, 2014

RESUBMIT No Approved DATE 06/19/2014  
BY M. J. Chenette

SHOP DRAWING REVIEW

REVIEWED AS REQUIRED BY THE CONSTRUCTION CONTRACT DOCUMENTS AND APPROVED, BUT ONLY FOR CONFORMANCE TO THE DESIGN CONCEPT OF THE WORK, AND SUBJECT TO FURTHER LIMITATIONS AND REQUIREMENTS CONTAINED IN THE CONSTRUCTION CONTRACT DOCUMENTS.

REJECTED       REVISE AND RESUBMIT       FURNISH AS CORRECTED

CORRECTIONS OR COMMENTS MADE ON THE SHOP DRAWINGS DURING THIS REVIEW DO NOT RELIEVE CONTRACTOR FROM COMPLIANCE WITH REQUIREMENTS OF THE DRAWINGS AND SPECIFICATIONS. THIS CHECK IS ONLY FOR REVIEW OF GENERAL CONFORMANCE WITH THE DESIGN CONCEPT OF THE PROJECT AND GENERAL COMPLIANCE WITH THE INFORMATION GIVEN IN THE CONTRACT DOCUMENTS. THE CONTRACTOR IS RESPONSIBLE FOR CONFIRMING AND CORRELATING ALL QUANTITIES AND DIMENSIONS, SELECTING FABRICATION PROCESSES AND TECHNIQUES OF CONSTRUCTION, COORDINATING HIS WORK WITH THAT OF ALL OTHER TRADES, AND PERFORMING HIS WORK IN A SAFE AND SATISFACTORY MANNER.


**VHB Vanasse Hangen Brustlin, Inc.**      Job Number: 57427.00  
7050 US Route 7      Reviewed By: S.E. Burbank  
North Ferrisburgh, VT 05473      Date: 06/19/2014  
802.425.7788

4-7-14 REVISED AS NOTED

APPROVAL STAMP:	<b>J.P. CARRARA &amp; SONS INC.</b> Precast & Prestress Manufacturer N.T.S. <small>244 OASE ST., MIDDLEBURY, VERMONT 05753 Phone:(802)388-6361 Fax:(802)388-9010</small>	
	STATE OF VERMONT AGENCY OF TRANSPORTATION COUNTY OF WINDHAM	DATE: MAR. 04, 2014
	TOWN OF GUILFORD ROUTE NO. T.H.10, CLASS III (LOCAL ROAD) BRIDGE NO.: 65 PROJECT NO.: BRO 1442 (36)	SCALE: NOTED
	MATERIALS LIST	CHKD: JJ/KLT DFTM:AA1/RWS JOB NO: 23420-014 DWG. NO: <b>M1</b>

**Eriksson technologies**  
813.989.3317  
TAMPA, FL LRFD.COM  
© 2014 ERIKSSON TECHNOLOGIES, INC. ALL RIGHTS RESERVED

S:\Engineering Services\Carrera\116001 - Guilford Bridge 65\Production Drawings\AutoCAD Files\144236-M.L.dwg, 5/6/2014 4:44:46 PM, DWG To PDF.pc3

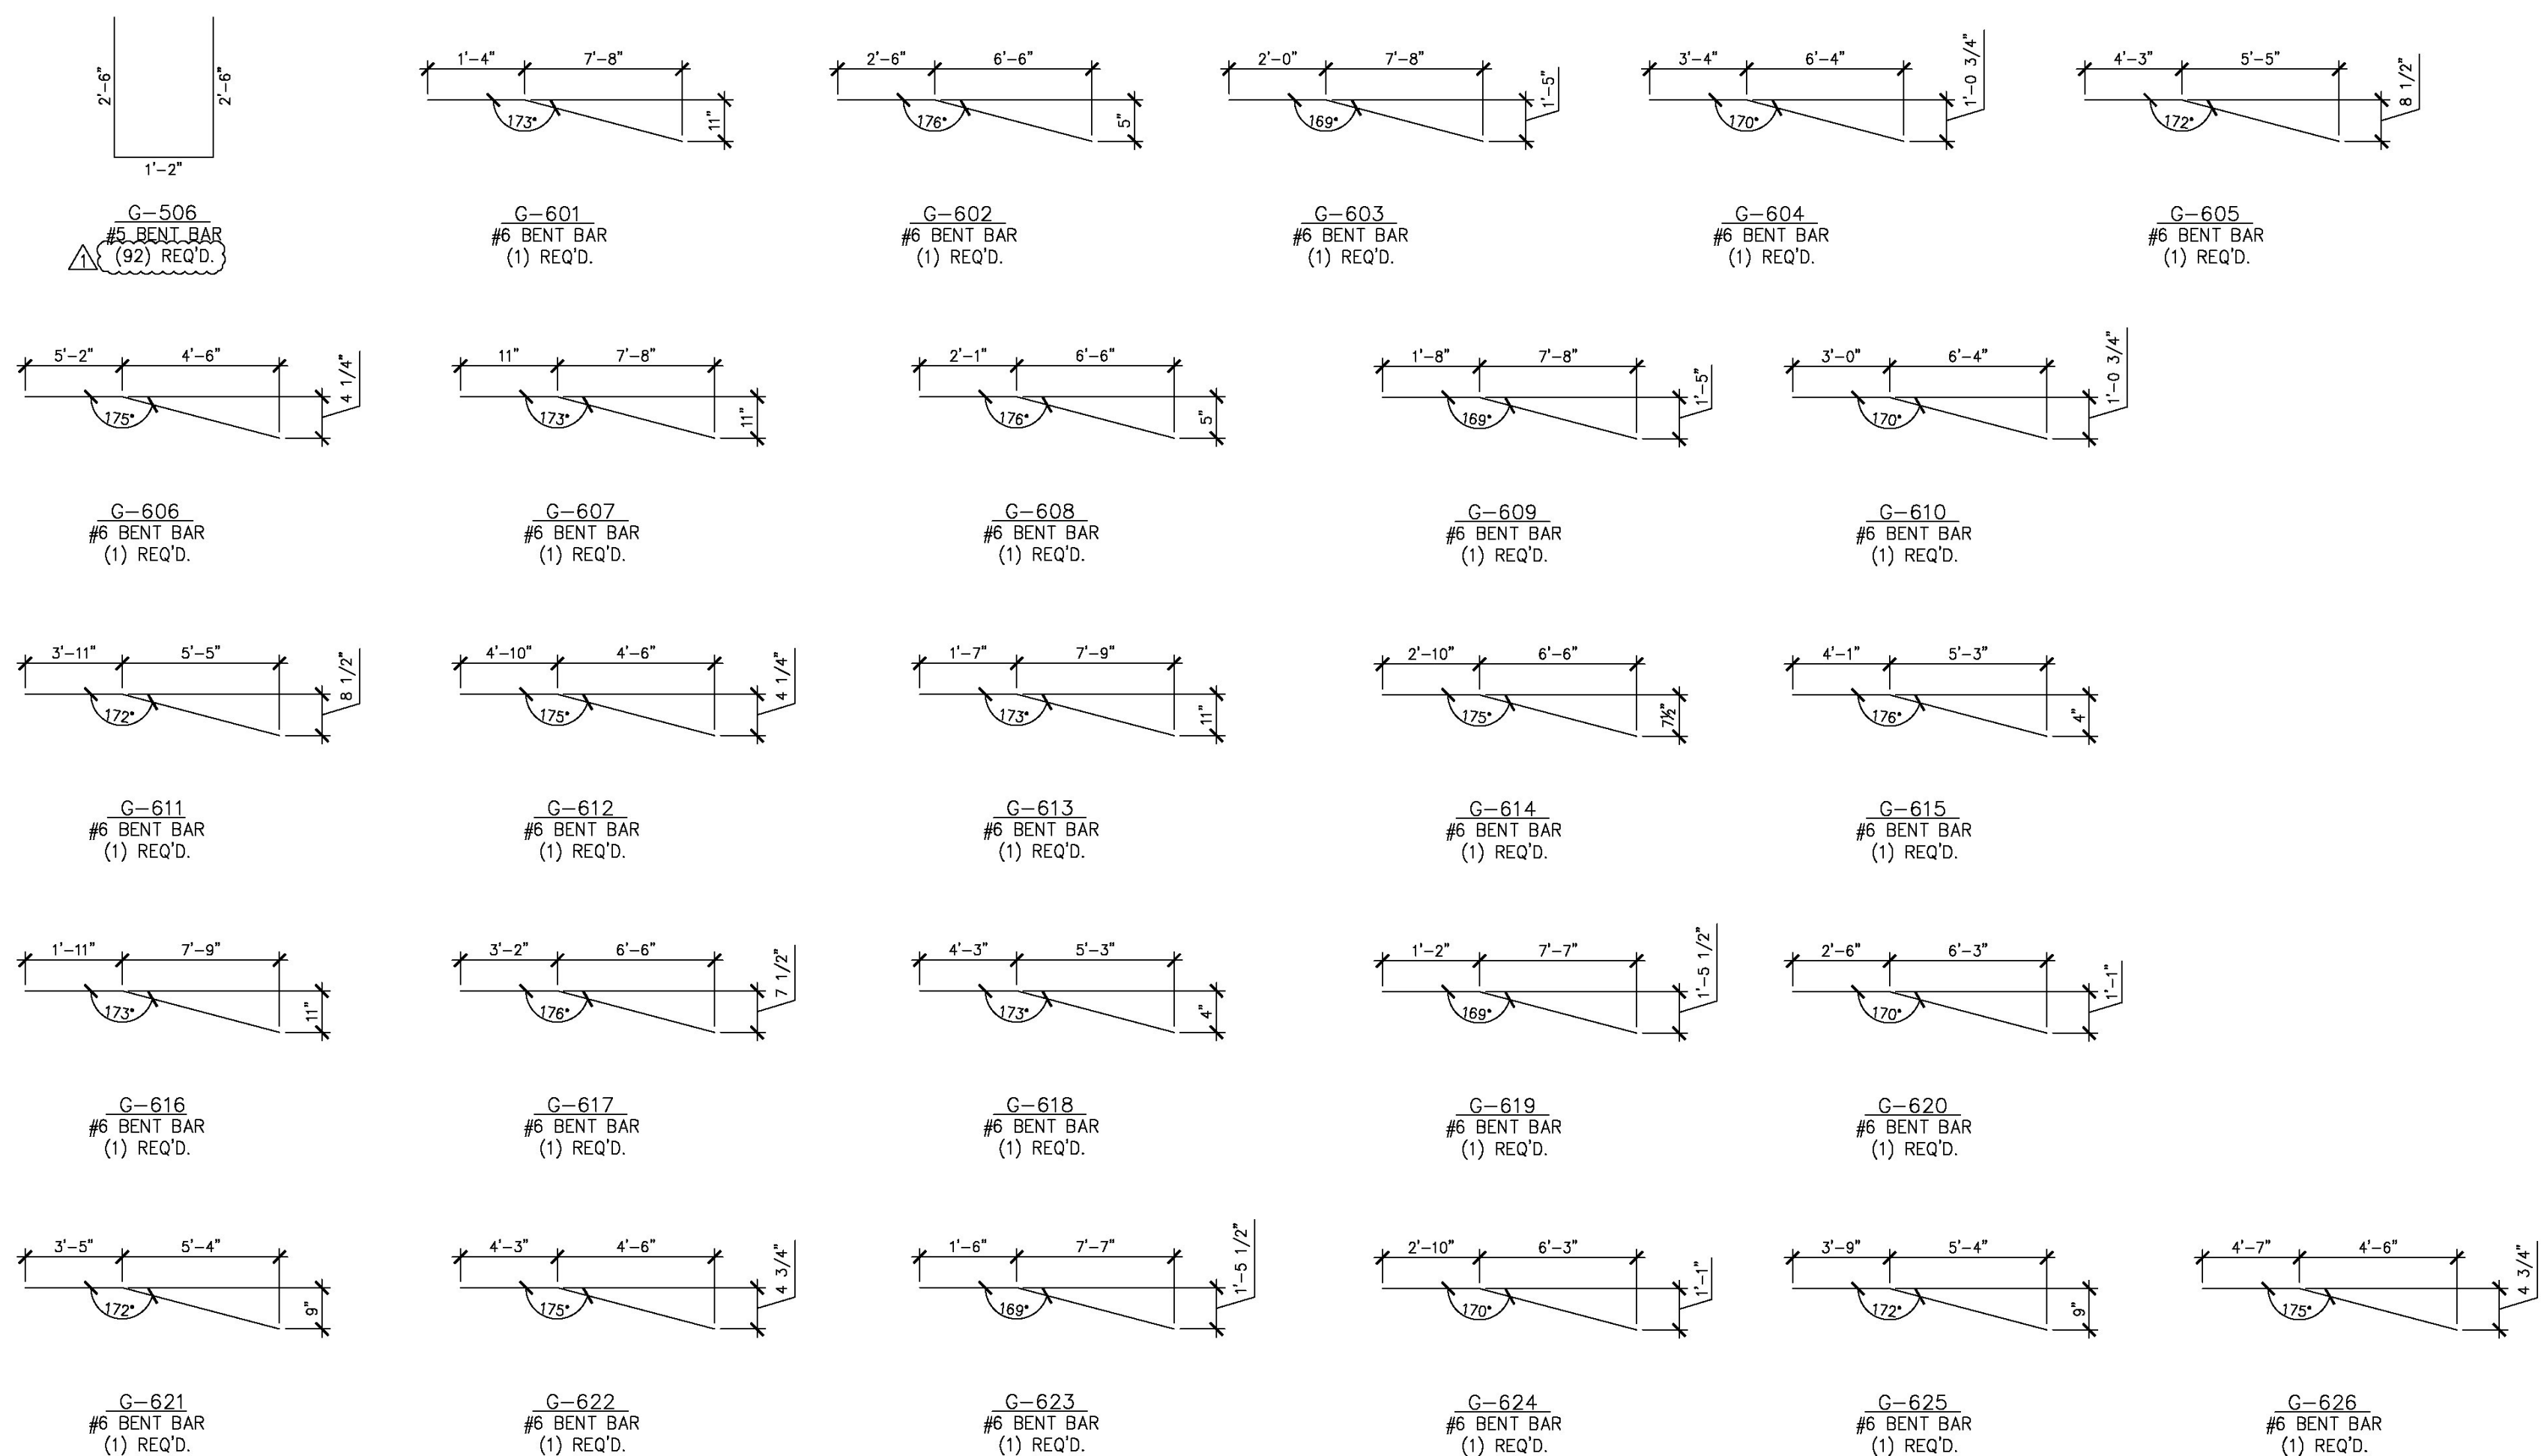

PRECAST WINGWALLS

MISCELLANEOUS MATERIALS				
ITEM	MARK	QTY.	DESCRIPTION	REMARKS
1		22	#5 x 9'-3"	
2		24	#5 x 9'-5"	
3		24	#5 x 9'-9"	
4		22	#5 x 9'-11"	
5				
6				
7		20	#6 x 8'-5"	
8		18	#6 x 8'-7"	
9		38	#6 x 8'-10"	
10		37	#6 x 9'-2"	
11		37	#6 x 9'-5"	
12				
13				
14				
15				
16				
17	MK-G3	16	41 x 9 1/2" SWIFT LIFT LIFTER	
18	MK-G5	176	NMB SPLICE SLEEVE 6U-(PG)	ORDER (3) EXTRA FOR TESTING - TOTAL (179)
19	MK-G6	8	201 x 19 3/4" SWIFT LIFT LIFTER	
20				
21				
22				

PRECAST WING WALLS

Vermont Agency of Transportation  
**RECEIVED**  
 CK'D BY MJC OK'D BY TAS  
 June 18, 2014  
 RESUBMIT No Approved  
 BY M. J. Chenette DATE 06/19/2014

**SHOP DRAWING REVIEW**

REVIEWED AS REQUIRED BY THE CONSTRUCTION CONTRACT DOCUMENTS AND APPROVED, BUT ONLY FOR CONFORMANCE TO THE DESIGN CONCEPT OF THE WORK, AND SUBJECT TO FURTHER LIMITATIONS AND REQUIREMENTS CONTAINED IN THE CONSTRUCTION CONTRACT DOCUMENTS.


REJECTED       REVISE AND RESUBMIT       FURNISH AS CORRECTED

CORRECTIONS OR COMMENTS MADE ON THE SHOP DRAWINGS DURING THIS REVIEW DO NOT RELIEVE CONTRACTOR FROM COMPLIANCE WITH REQUIREMENTS OF THE DRAWINGS AND SPECIFICATIONS. THIS CHECK IS ONLY FOR REVIEW OF GENERAL CONFORMANCE WITH THE DESIGN CONCEPT OF THE PROJECT AND GENERAL COMPLIANCE WITH THE INFORMATION GIVEN IN THE CONTRACT DOCUMENTS. THE CONTRACTOR IS RESPONSIBLE FOR CONFIRMING AND CORRELATING ALL QUANTITIES AND DIMENSIONS, SELECTING FABRICATION PROCESSES AND TECHNIQUES OF CONSTRUCTION, COORDINATING HIS WORK WITH THAT OF ALL OTHER TRADES, AND PERFORMING HIS WORK IN A SAFE AND SATISFACTORY MANNER.

**YHB** **Yanasse Hangen Brustlin, Inc.**      Job Number: 57427.00  
 7055 US Route 7      North Ferrisburgh, VT 05473      Reviewed By: S E Burbank  
 802.425.7798      Date: 06/19/2014

4-7-14 REVISED AS NOTED	
APPROVAL STAMP:	<b>J.P. CARRARA &amp; SONS INC.</b> Precast & Prestress Manufacturer N.T.S. 244 OASE ST., MIDDLEBURY, VERMONT 05753 Phone:(802)388-6361 Fax:(802)388-9010 STATE OF VERMONT AGENCY OF TRANSPORTATION COUNTY OF WINDHAM TOWN OF GUILFORD ROUTE NO. T.H.10, CLASS III (LOCAL ROAD) BRIDGE NO.: 65 PROJECT NO.: BRO 1442 (36) MATERIALS LIST
	DATE: MAR. 04, 2014 SCALE: NOTED CHKD: JJ/KLT DFTM:AA1/RWS JOB NO: 23420-014 DWG. NO: M2

**Eriksson technologies** 813.989.3317  
 TAMPA, FL LRFD.COM  
© 2014 ERIKSSON TECHNOLOGIES, INC. ALL RIGHTS RESERVED

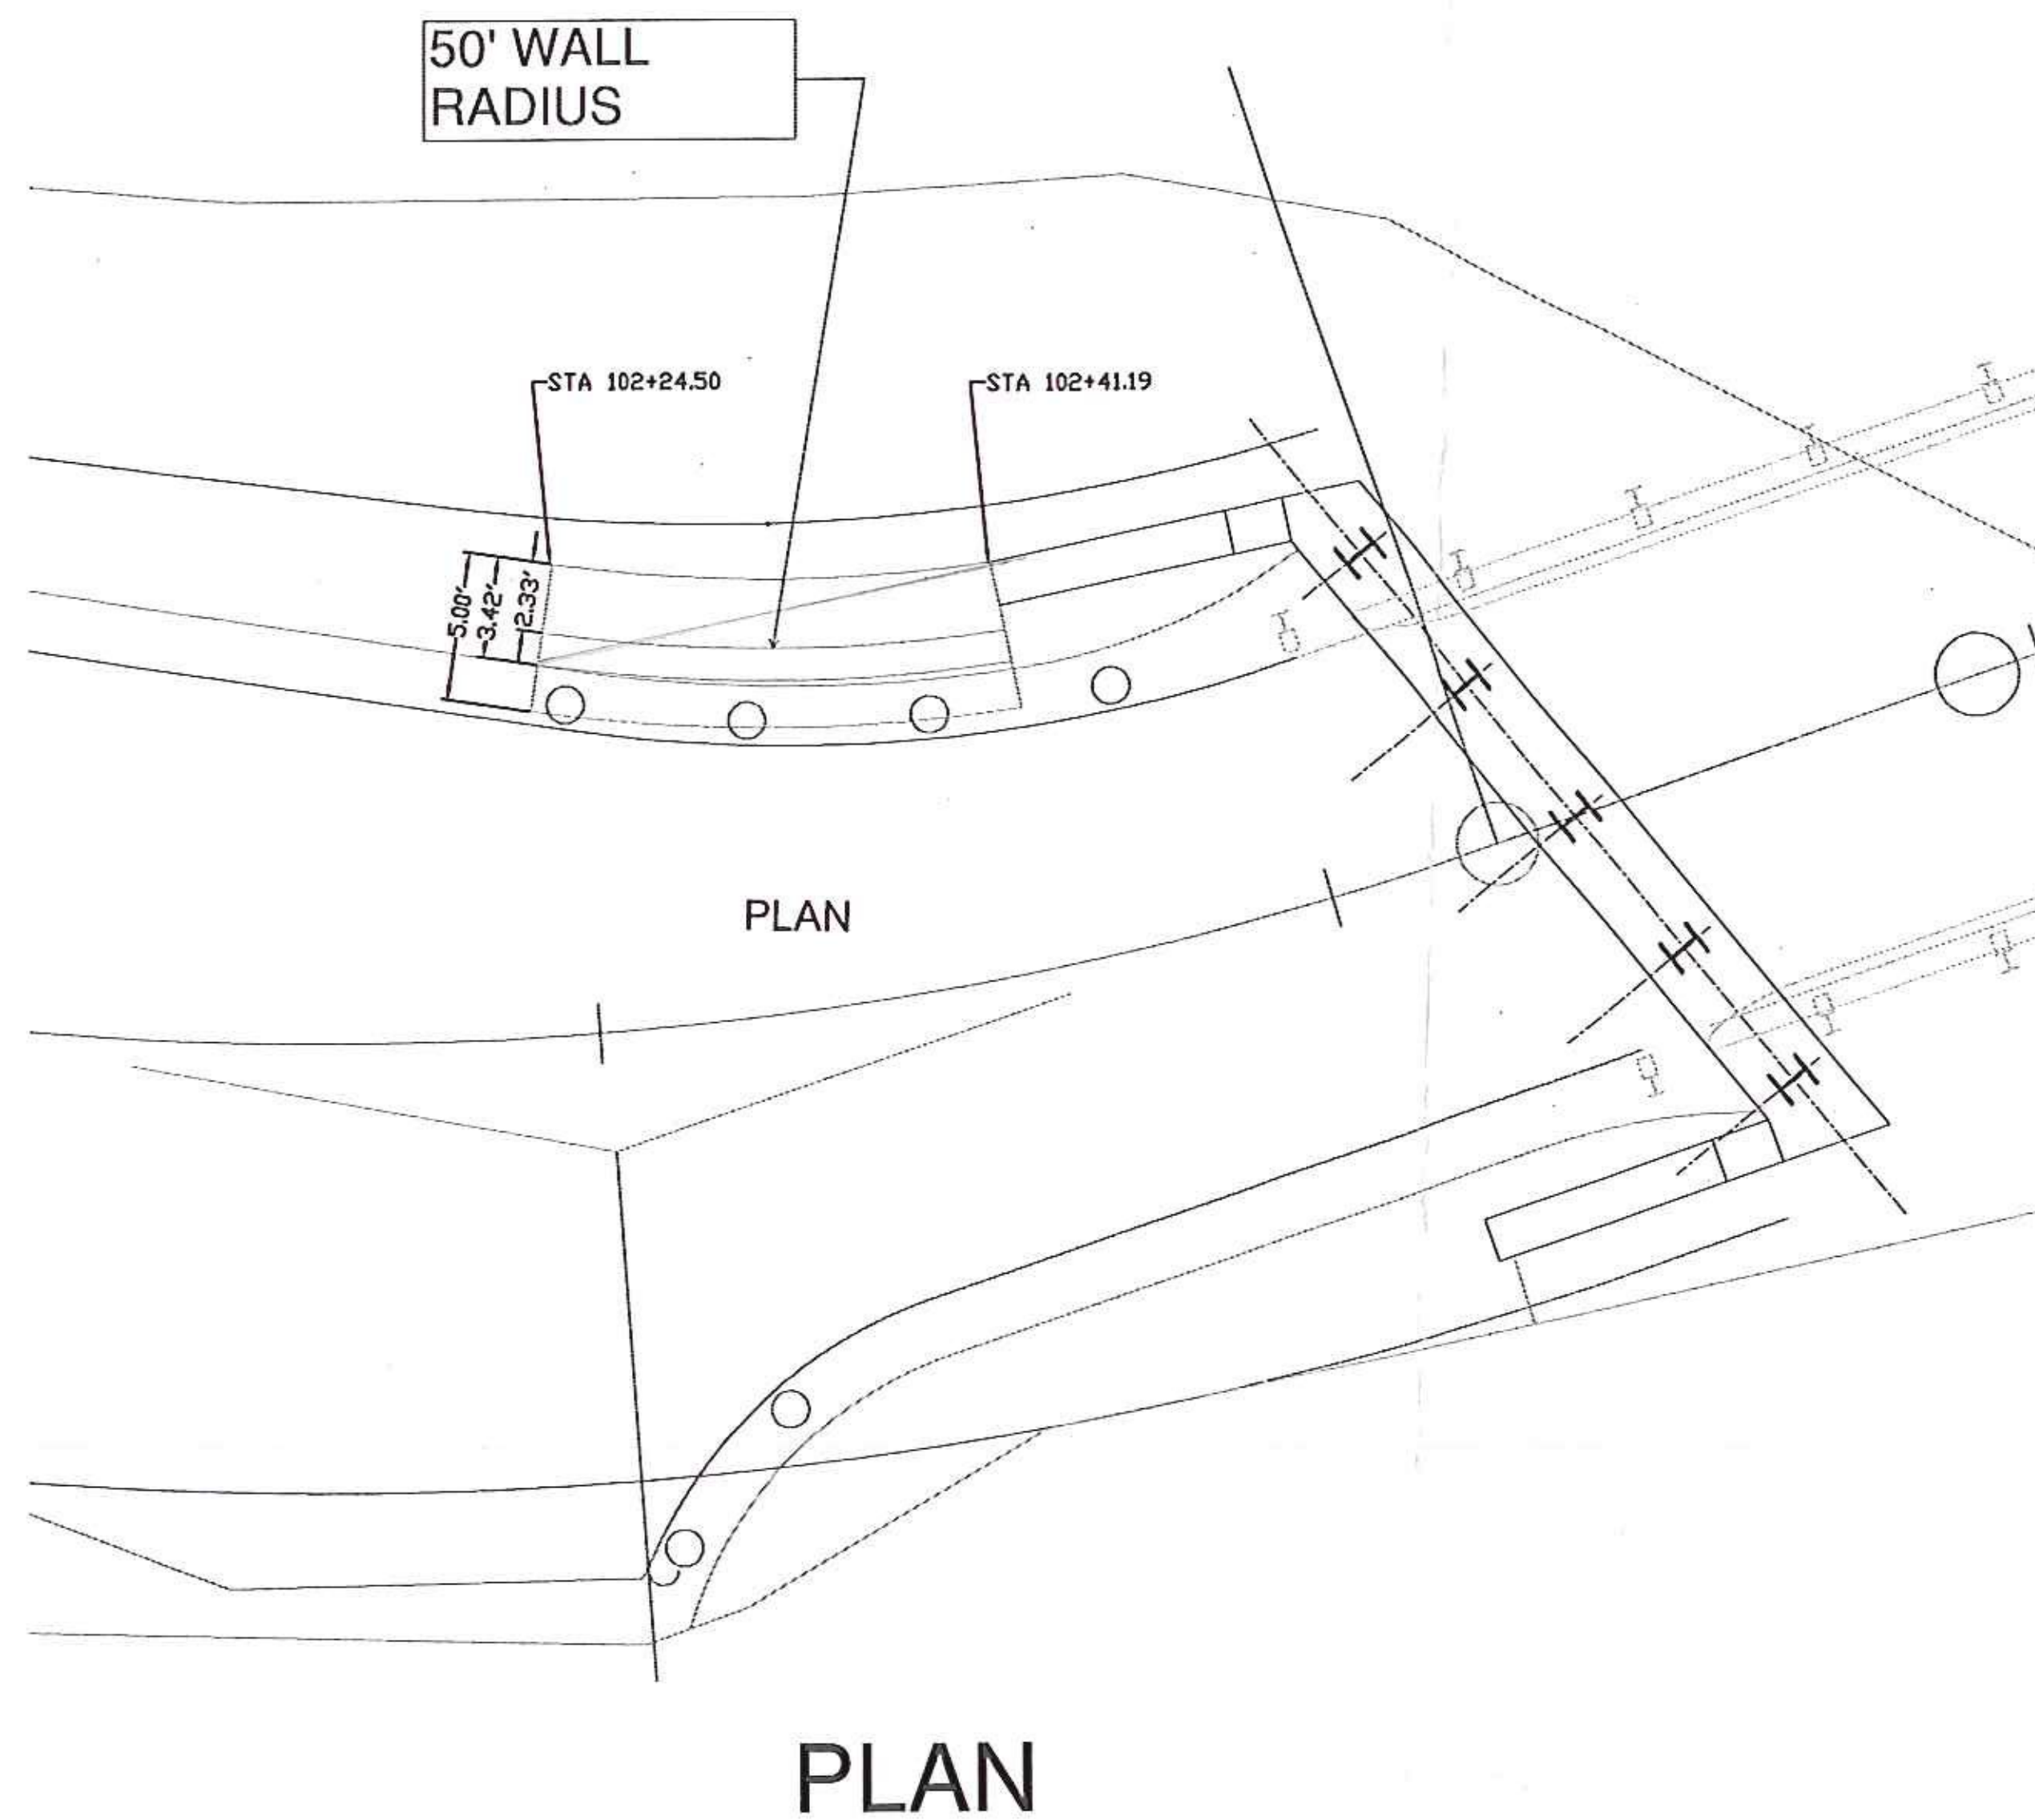

Vermont Agency of Transportation

**RECEIVED**

Retaining Wall 003.pdf

CK'D BY MJC OK'D BY TAS


August 25, 2014

RESUBMIT No Approved  
 BY M. J. Chenette DATE 08/27/2014

REV. NO.		DATE		SHEET NAME: RETAINING WALL PLAN		
1 ?		/??/??		PROJECT NAME: GUILFORD BRO		
				PROJECT NO: 1442 (36)		
				DRAWN BY: CDE		DATE: 07/21/2014
						SHEET NO. 1 OF 8

**R**ENAUD BROS. INC.  
 285 FT. BROADMAN RD. VERNON VT, 05554  
 PH. (802) 251-1585 FAX. (802) 251-1508


*Handwritten initials and a checkmark.*

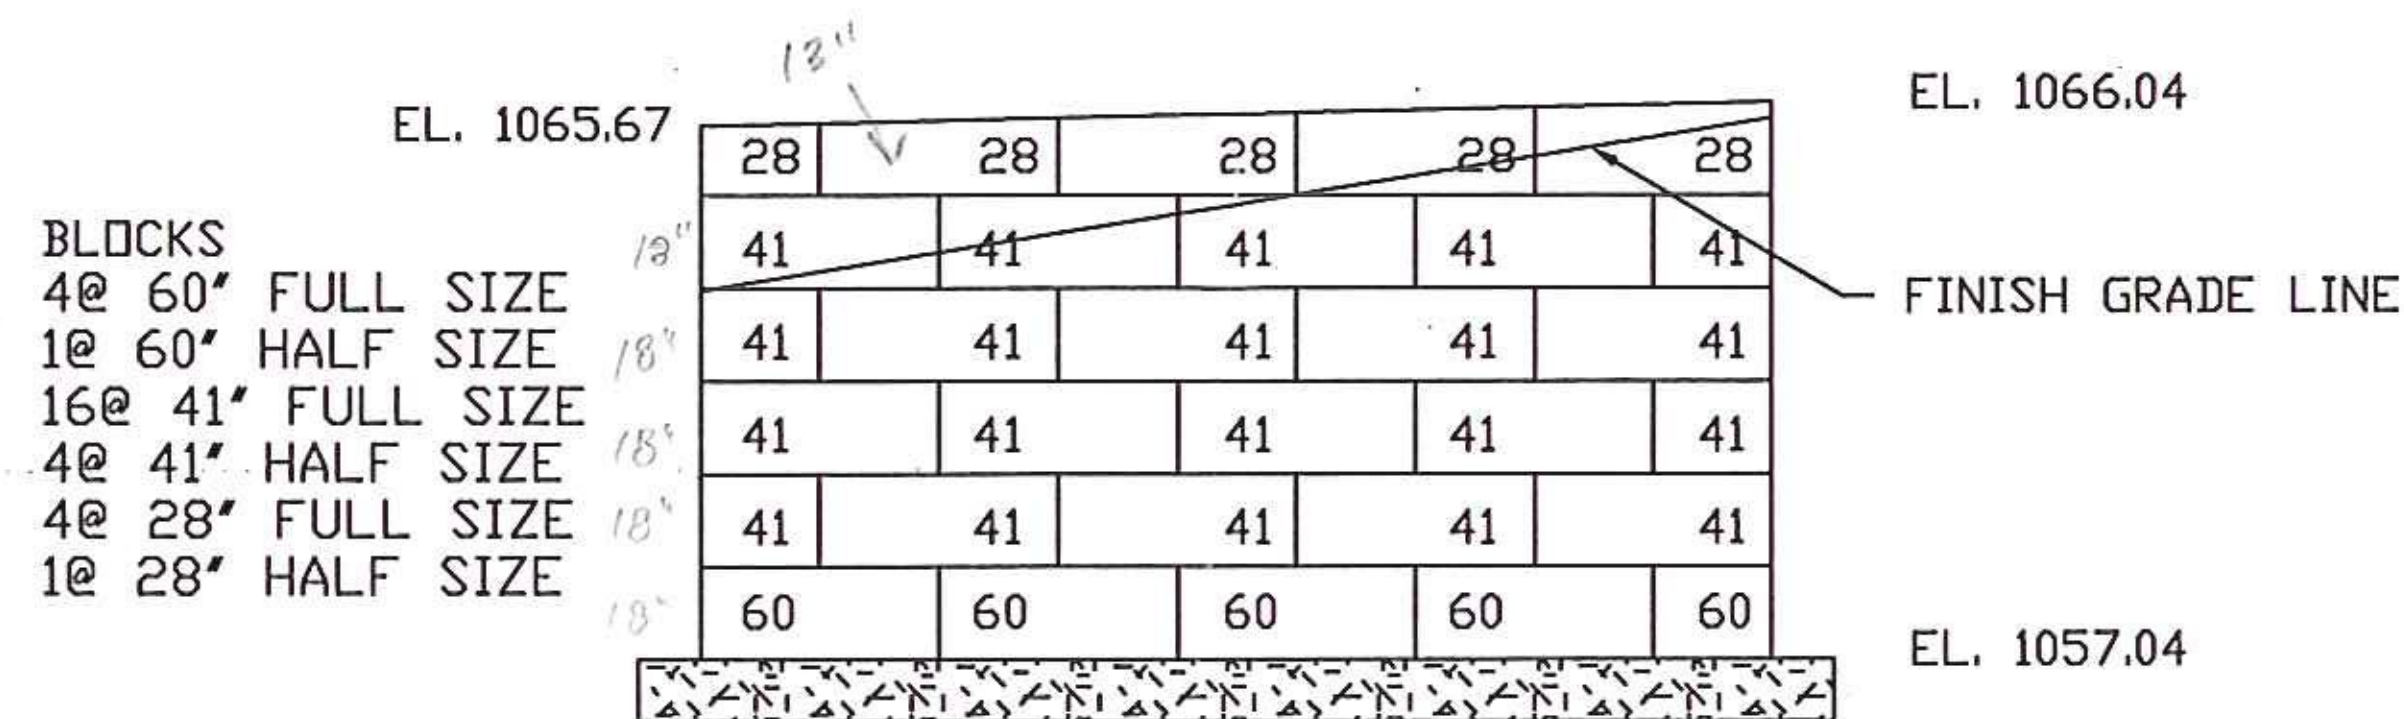

ELEVATION

6  
57.104  
LOSS. 33  
-----  
1.71  
  
1' 8 1/2"

NOTES:  
1. ALL BLOCKS ARE REDI ROCK LIME STONE FINISHED BLOCKS.

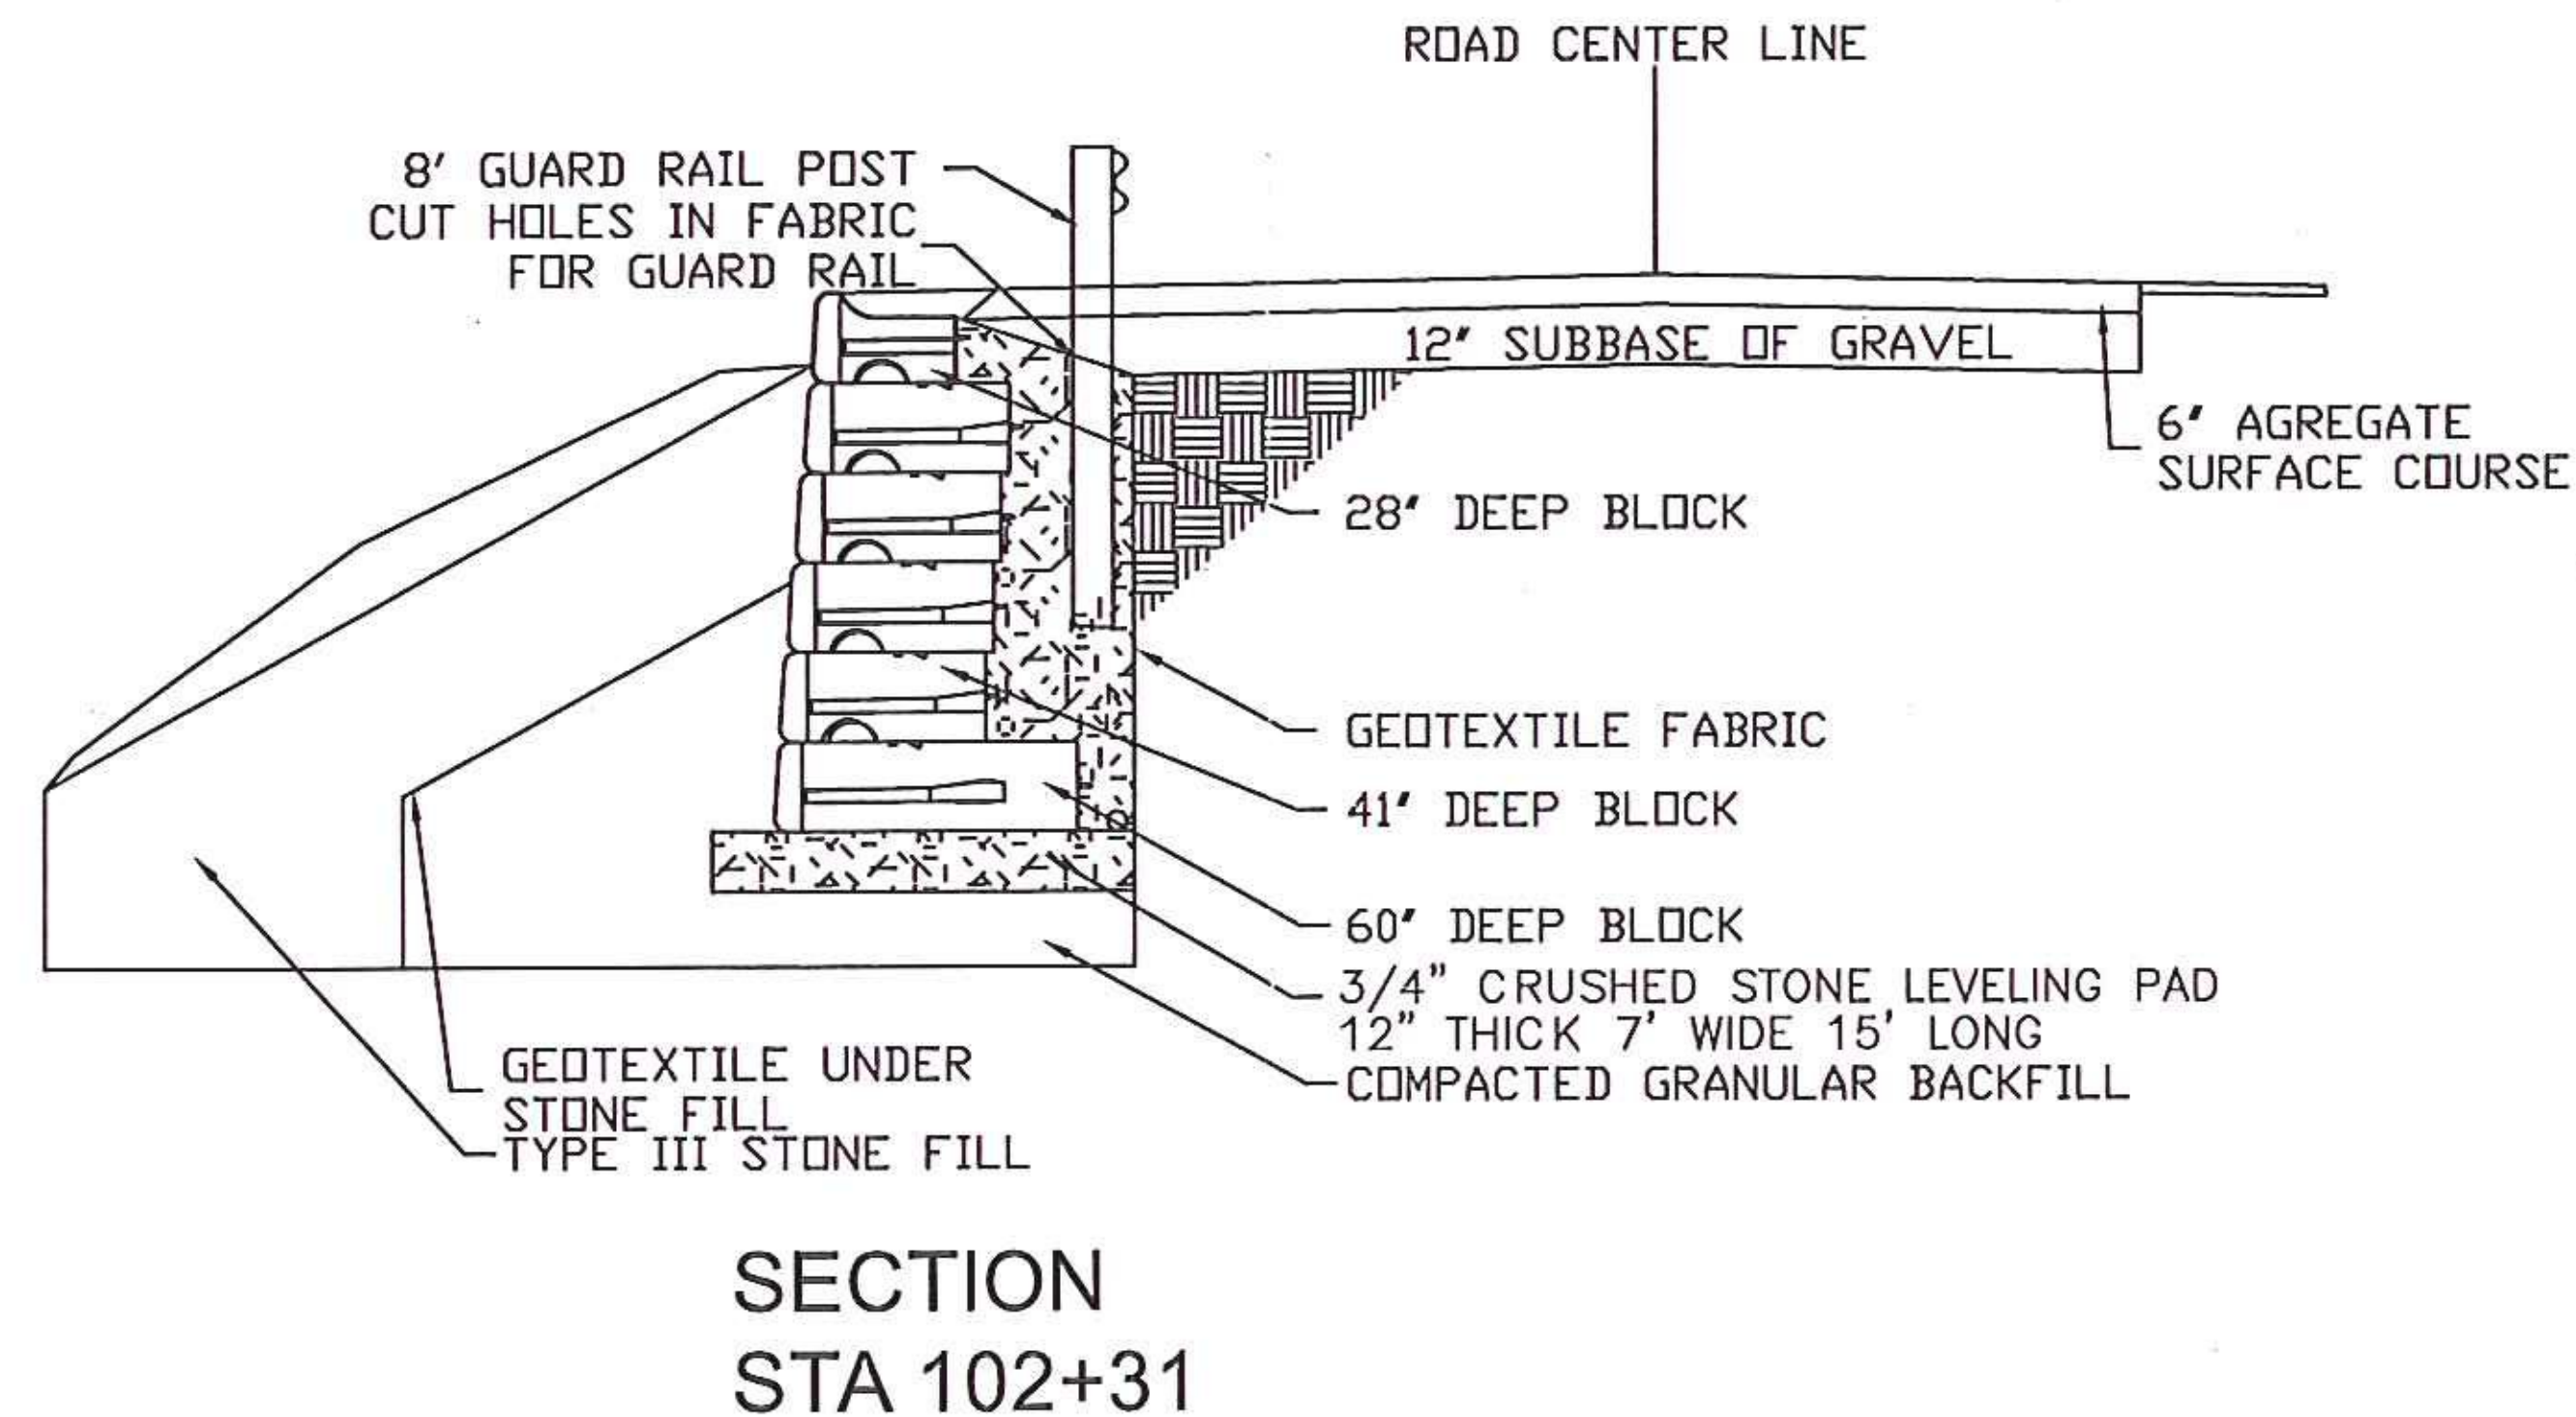

Vermont Agency of Transportation

**RECEIVED**

CK'D BY MJC OK'D BY TAS

August 25, 2014

RESUBMIT No Approved             
BY M. J. Chenette DATE 08/27/2014

REV. NO.		DATE:		SHEET NAME:	
1	?	1	??/??	RETAINING WALL ELEVATION AND SECTION	
PROJECT NAME:				SHEET NO.	
GUILFORD BRO				2	
PROJECT NO:				OF	
1442 (36)				8	
DRAWN BY:		CHK'D BY:		DATE:	
CDE				07/21/2014	

