



WELDING PROCEDURE

NO. SPLICE DETAIL


SHEET: 3 OF 4

283 FT. BRIDGMAN RD. VERNON VT., 05354
PH. (802)257-7383 FAX (802)257-7308

DATE: 4/8/2014 PROJECT NAME: GUILFORD

BY: A. DUNKLEE PROJECT NO. BRO 1442(36)

AWS CODE: PQR REF. NO: N/A

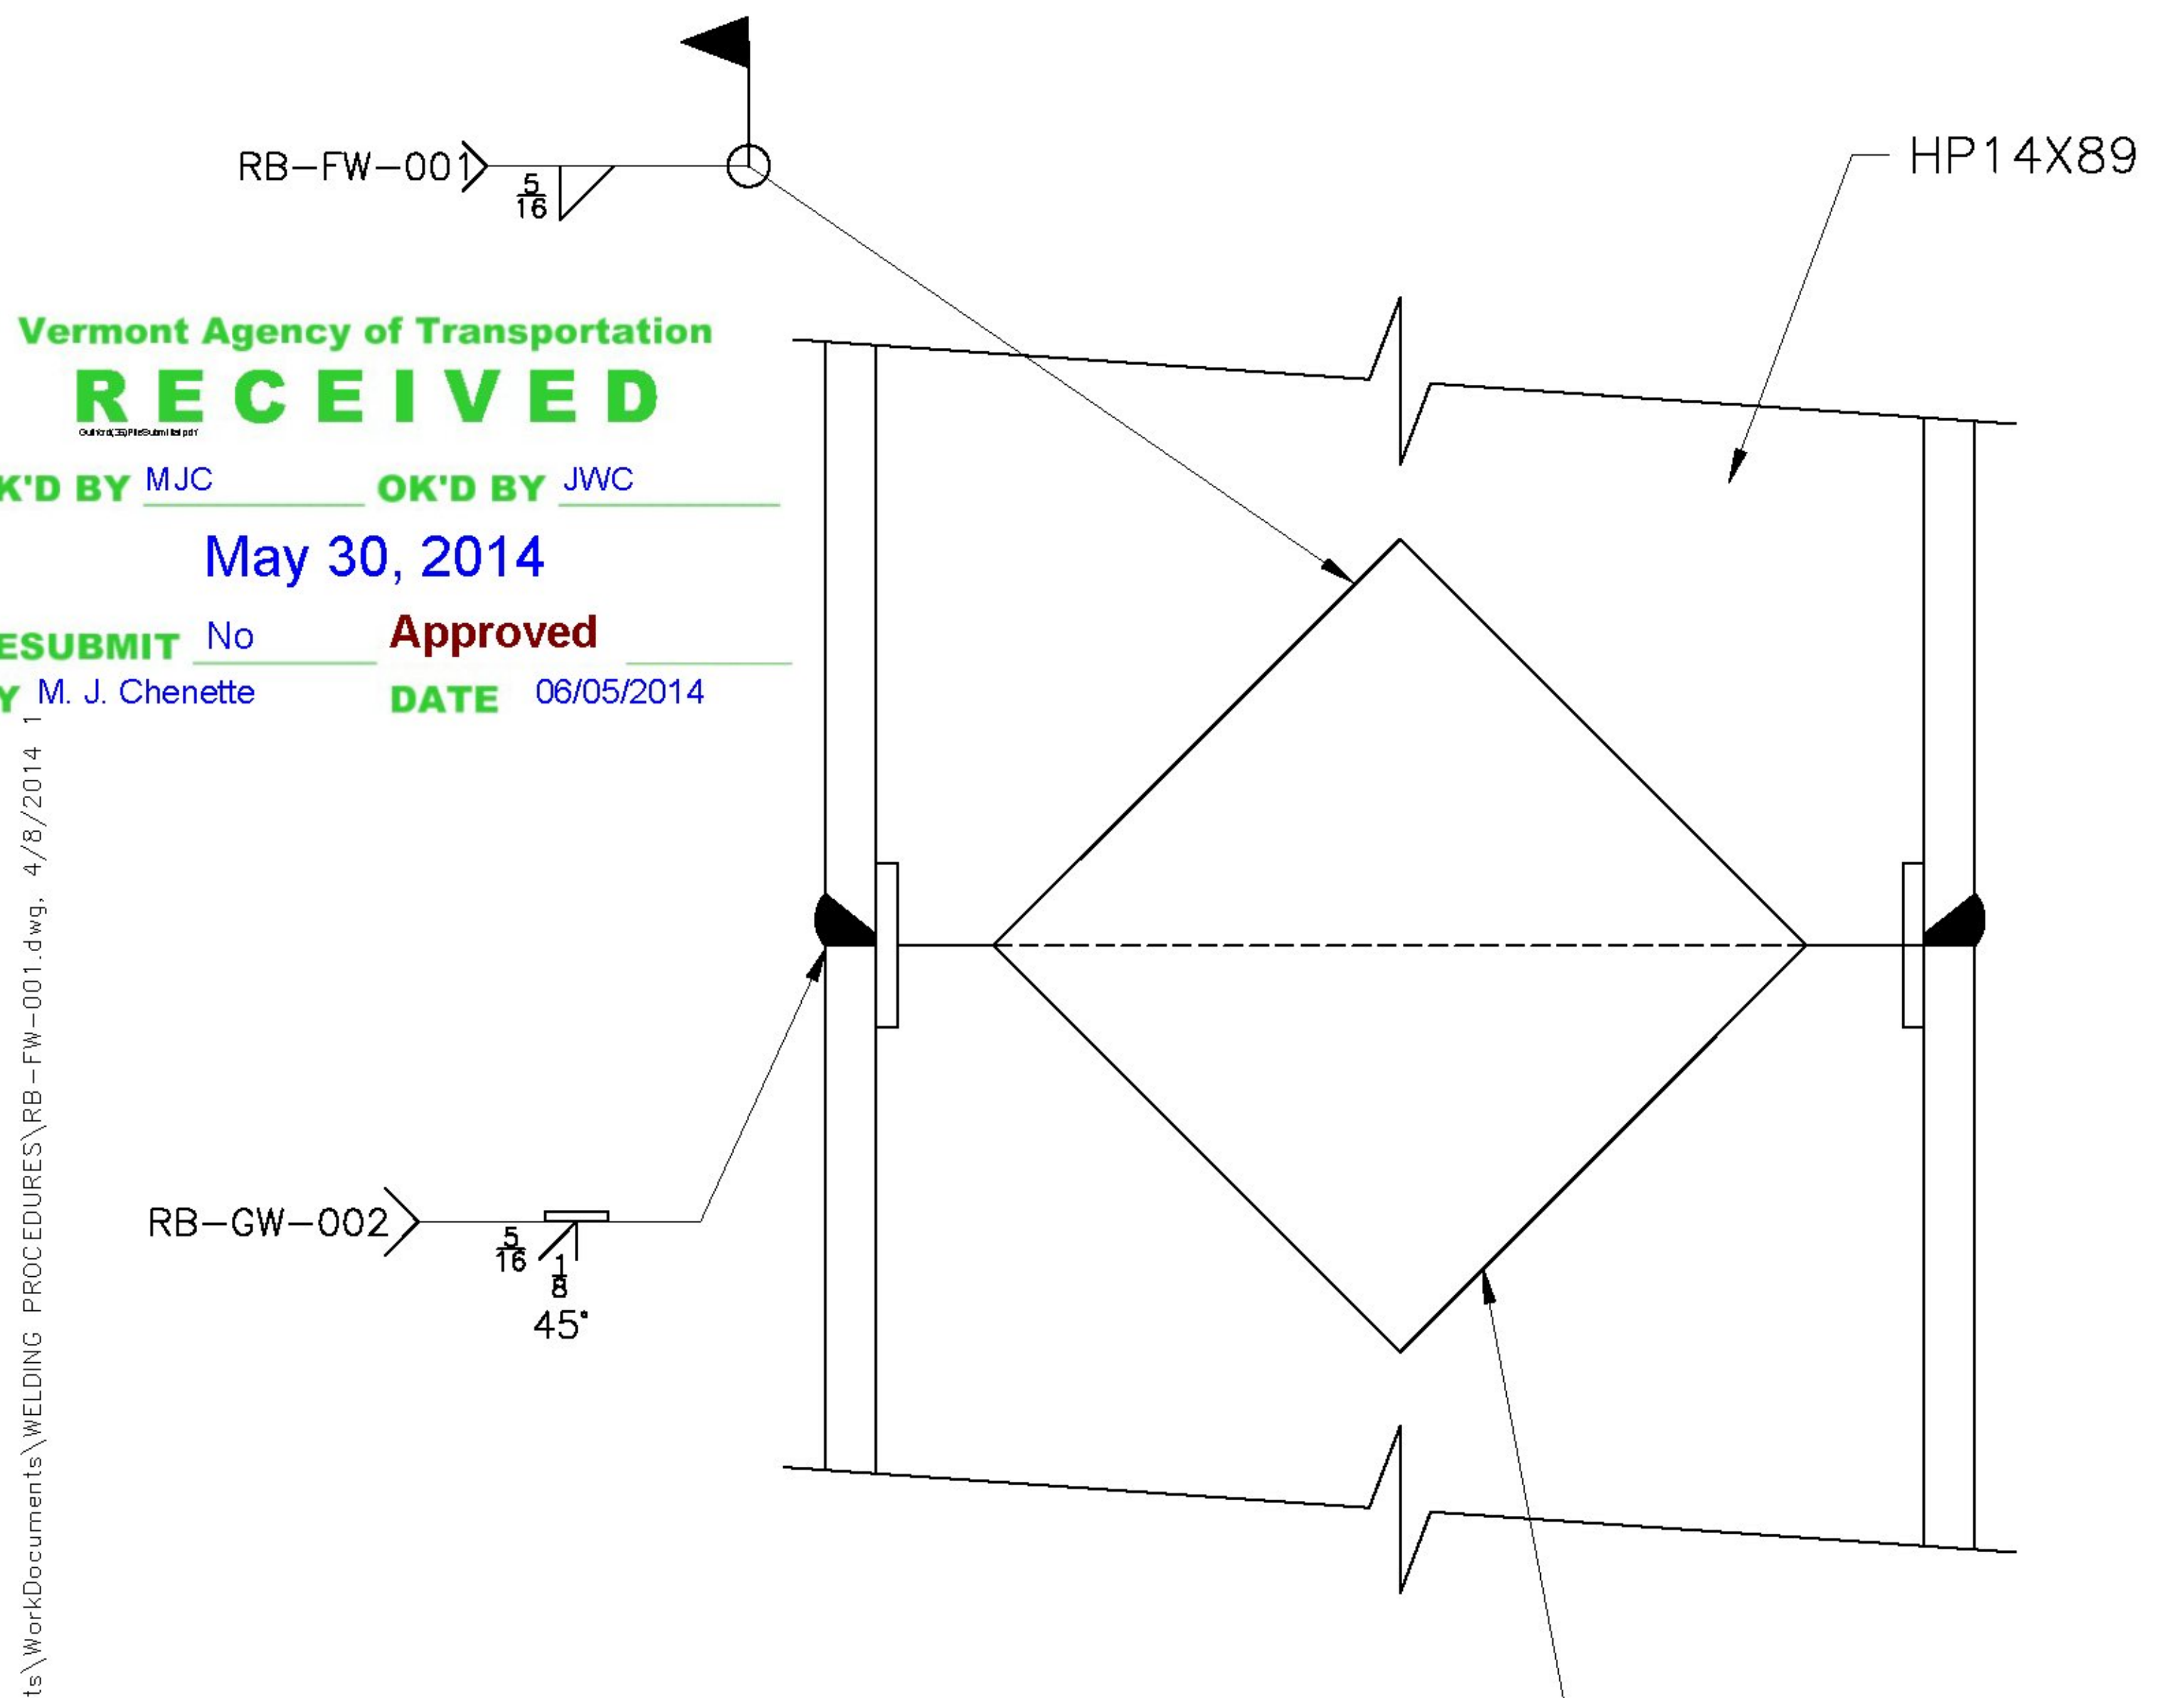

Vermont Agency of Transportation
RECEIVED

CK'D BY MJC OK'D BY JWC
May 30, 2014

RESUBMIT No Approved
BY M. J. Chenette DATE 06/05/2014

C:\Users\ADunklee\Documents\WorkDocuments\Welding Procedures\RB-FW-001.dwg, 4/8/2014

NOTES:
SPLICE CONFIGURATION TO CONFORM TO; SECTION 505.05

3/4" PLATE
7"X7" GR. 50
BOTH SIDES