




1 WING WALL #2 - SOUTH
F4 ELEVATION 1/4" = 1'-0"

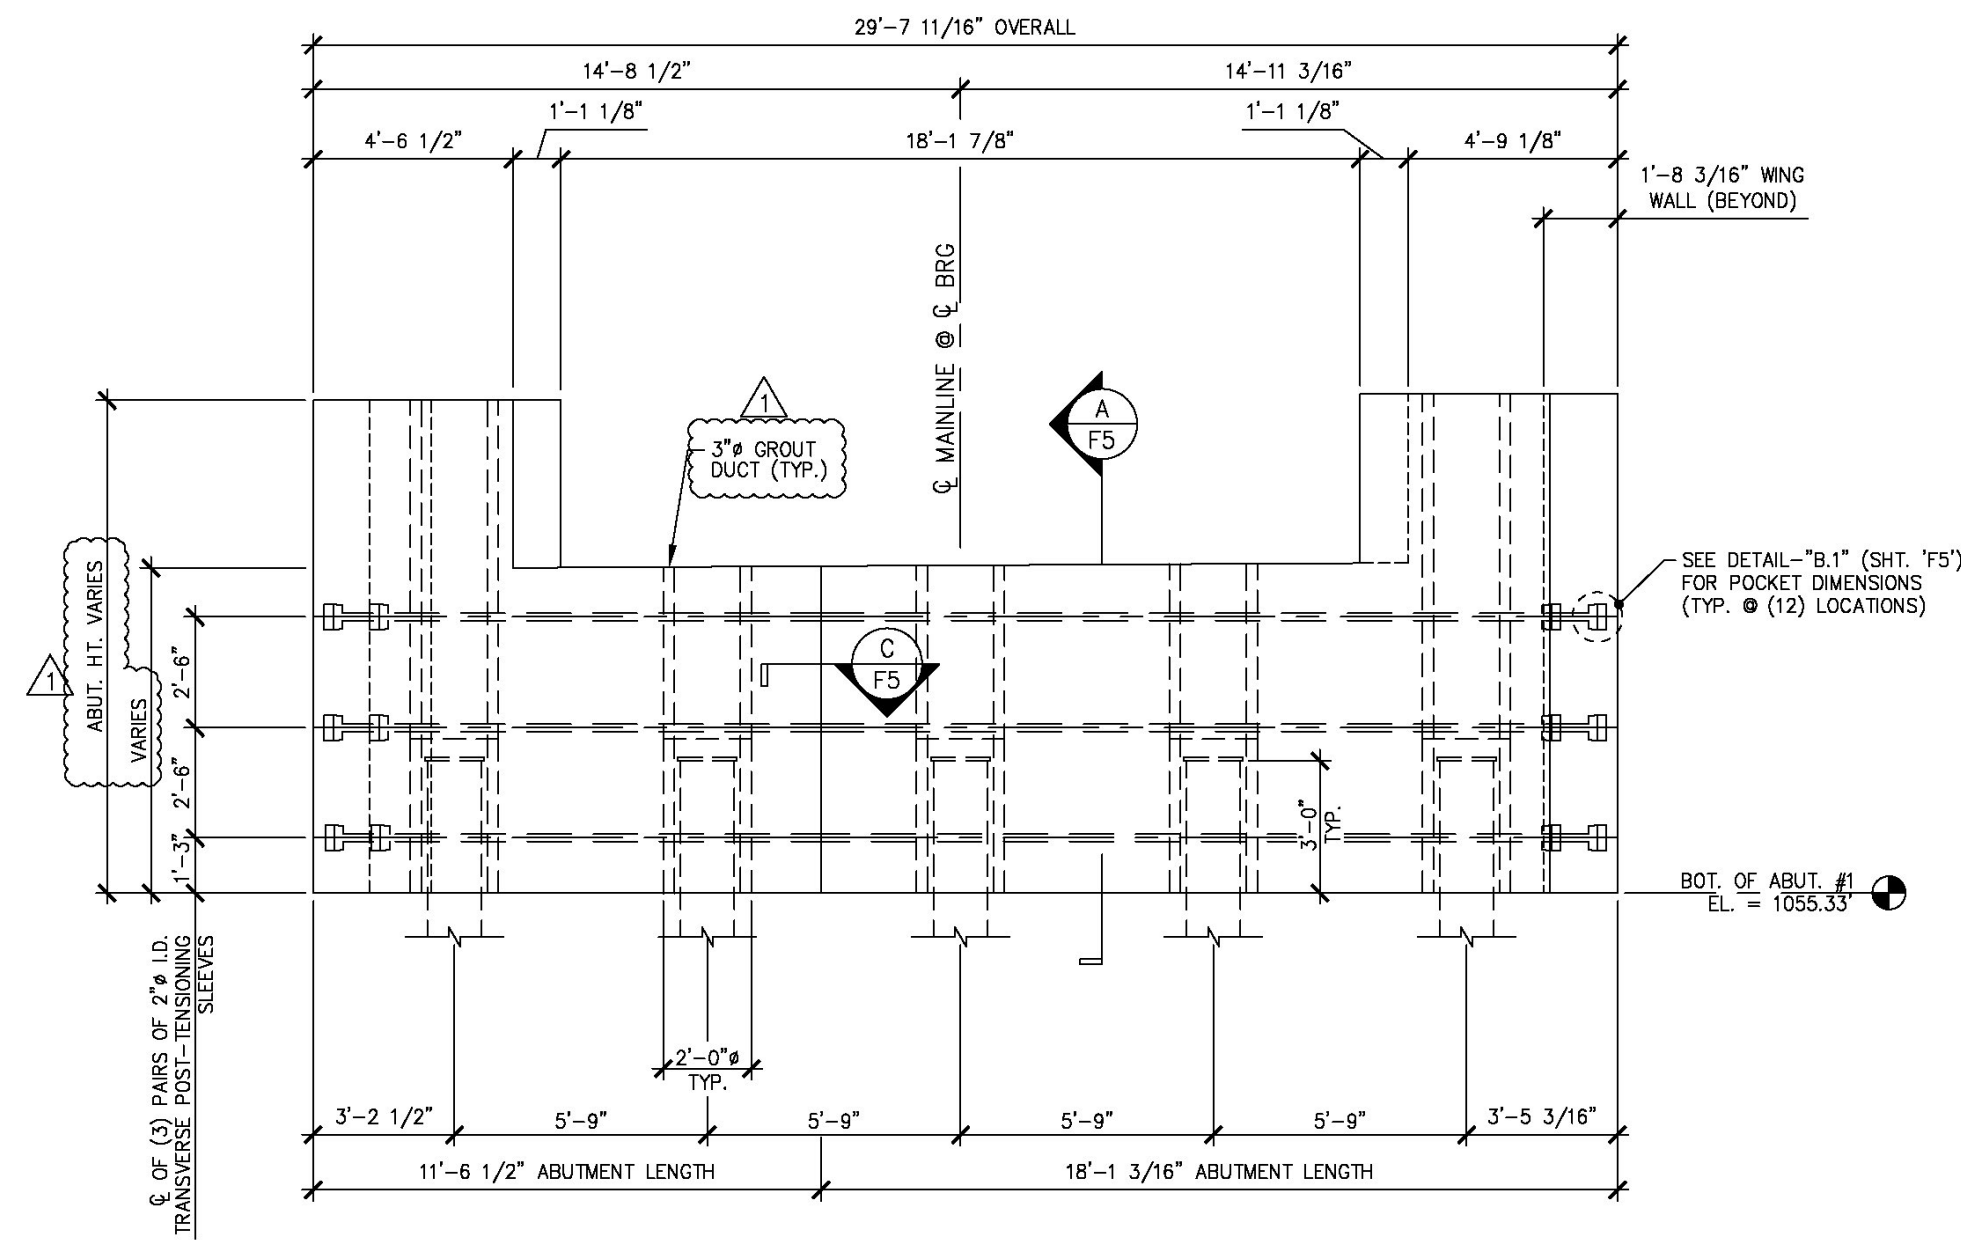


2 ABUTMENT #1 - EAST ELEVATION
F4 1/4" = 1'-0"

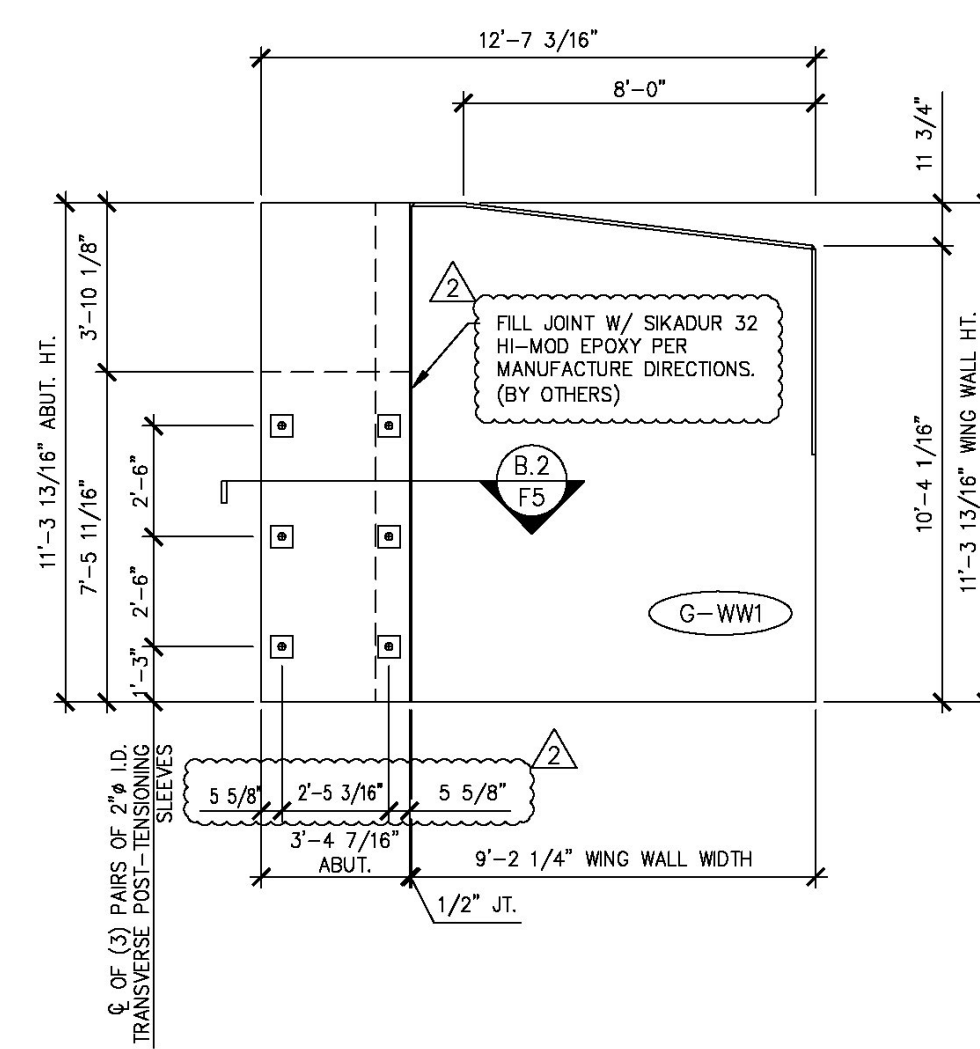


3 WING WALL #1 - NORTH
F4 ELEVATION 1/4" = 1'-0"

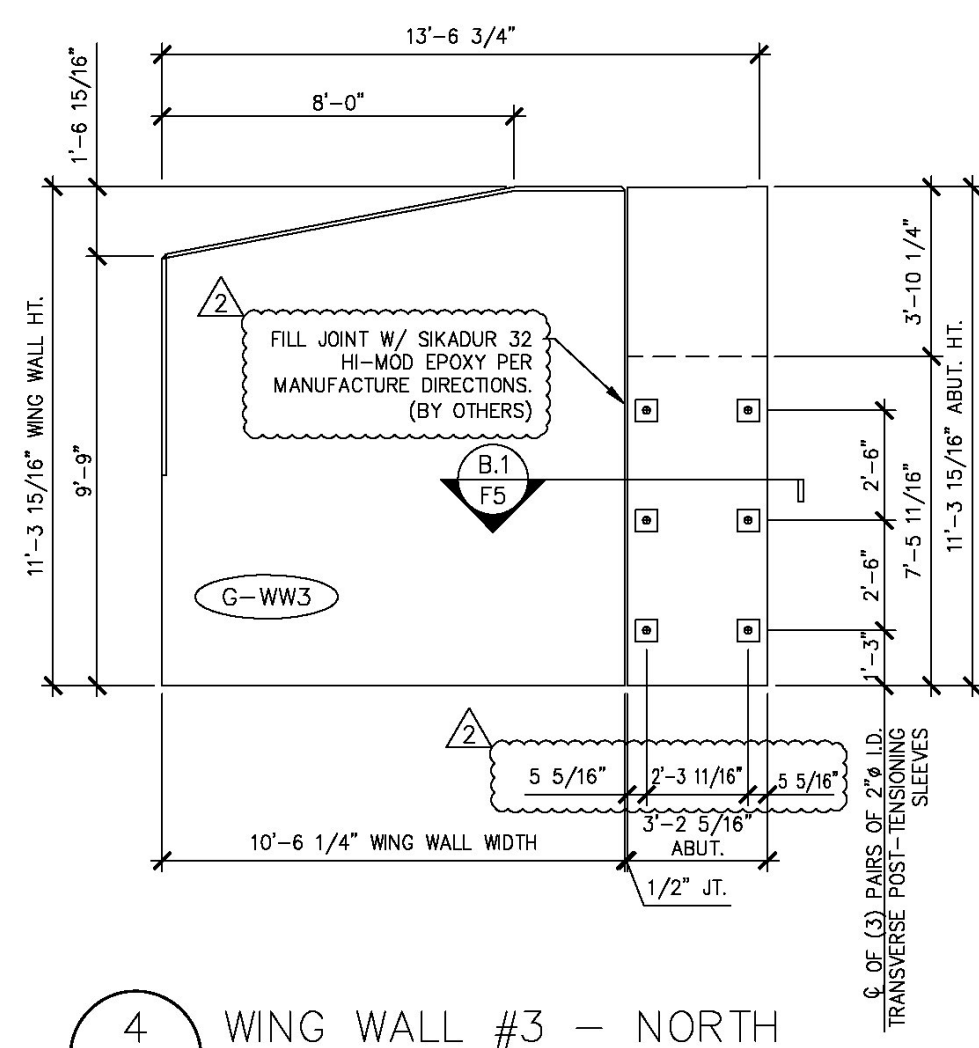

4 WING WALL #3 - NORTH
F4 ELEVATION 1/4" = 1'-0"

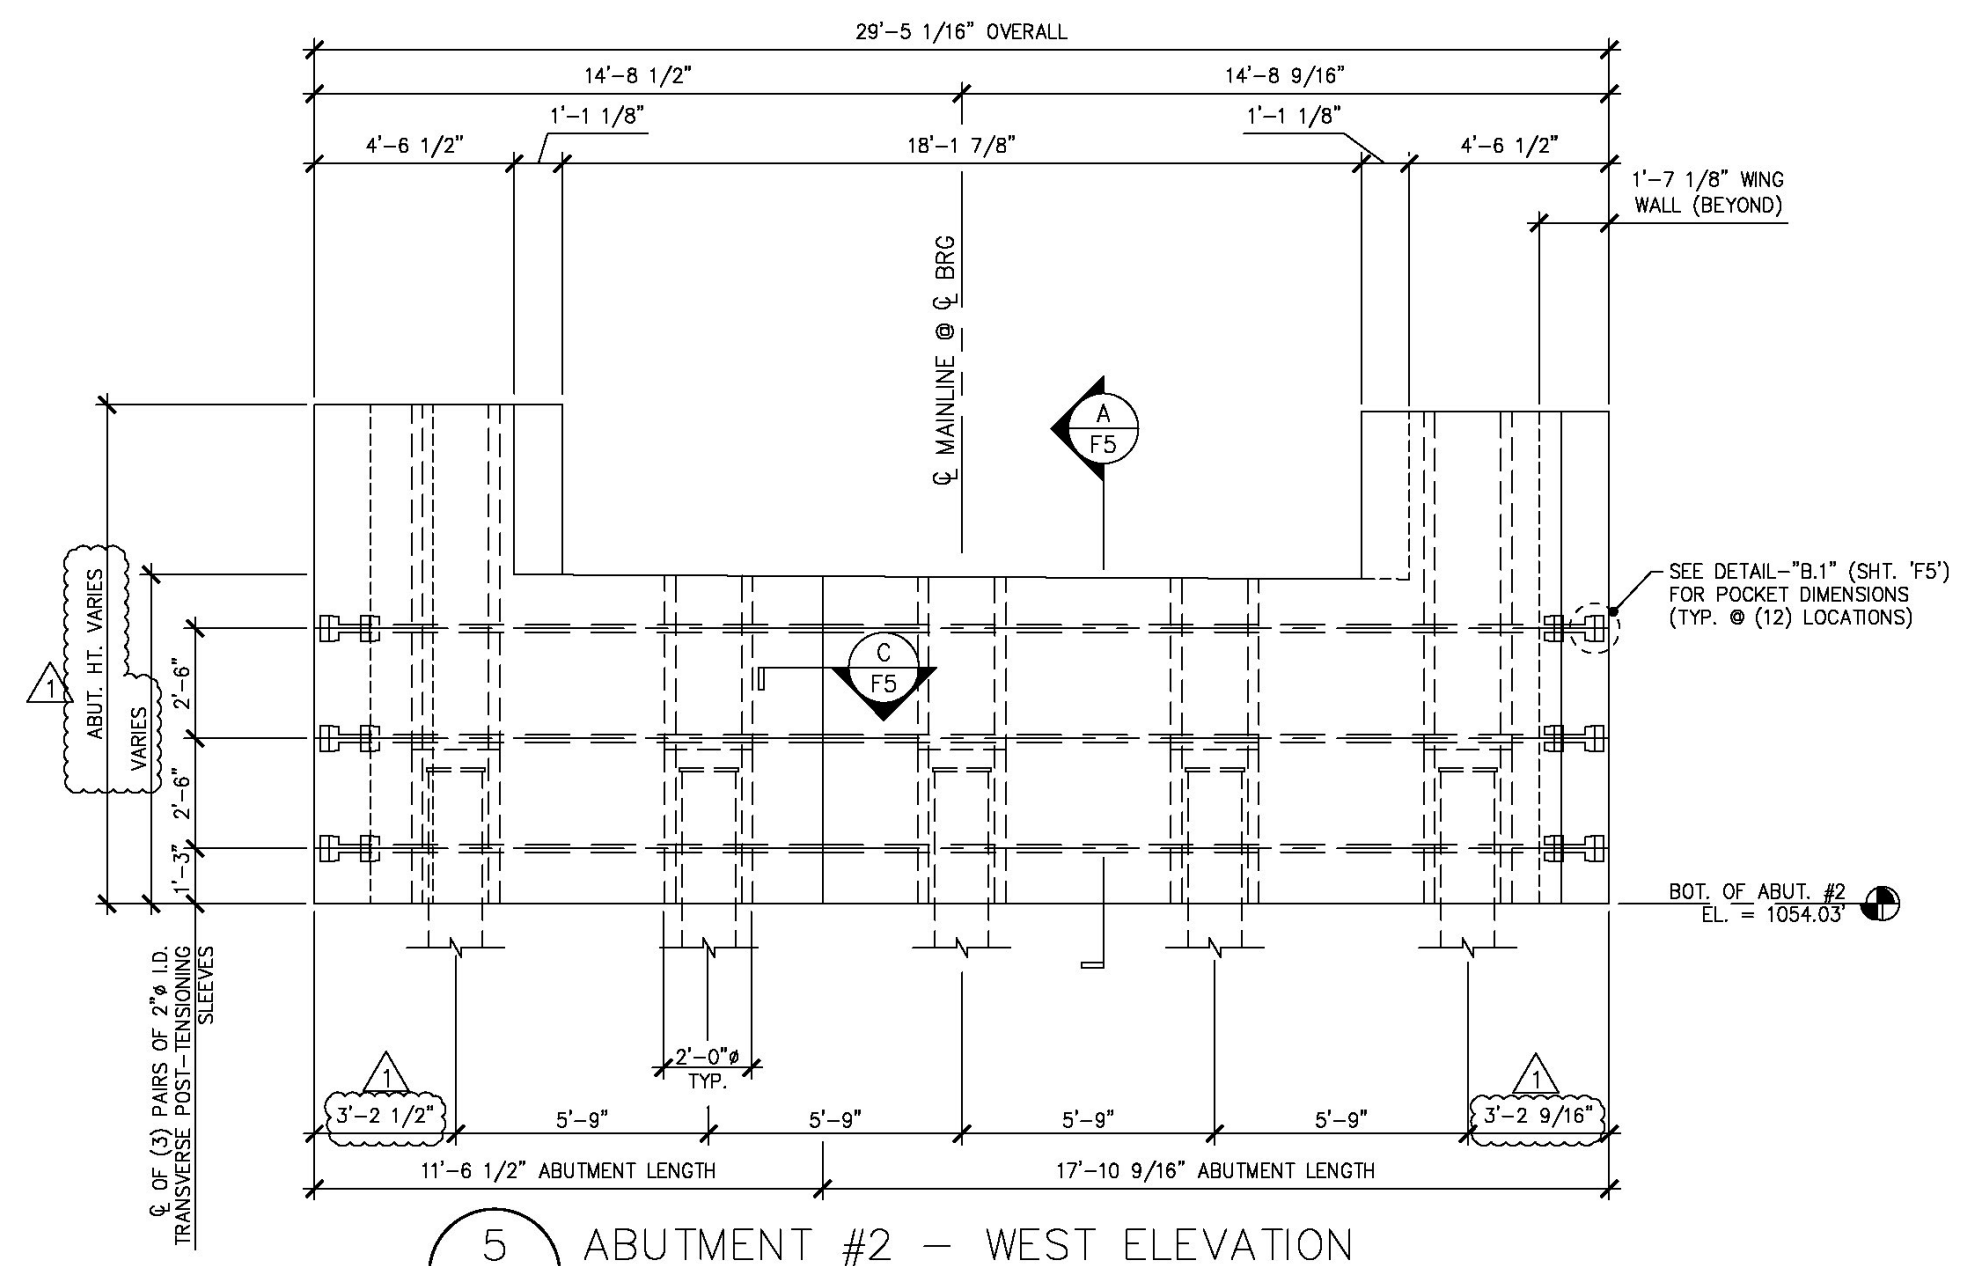

5 ABUTMENT #2 - WEST ELEVATION
F4 1/4" = 1'-0"

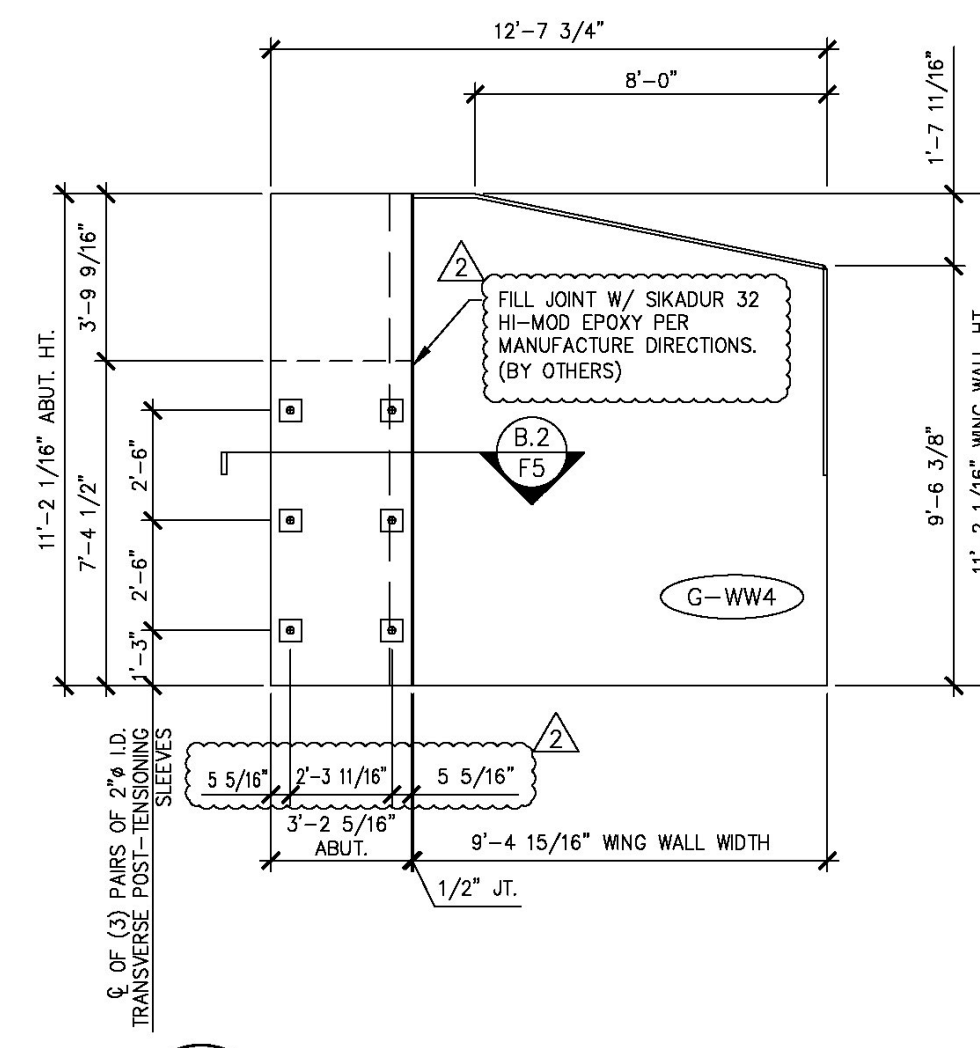

6 WING WALL #4 - SOUTH
F4 ELEVATION 1/4" = 1'-0"

Vermont Agency of Transportation
RECEIVED

CK'D BY MJC OK'D BY TAS

June 18, 2014

RESUBMIT No Approved
BY M. J. Chenette DATE 06/19/2014

SHOP DRAWING REVIEW

- REVIEWED AS REQUIRED BY THE CONSTRUCTION CONTRACT DOCUMENTS AND APPROVED, BUT ONLY FOR CONFORMANCE TO THE DESIGN CONCEPT OF THE WORK, AND SUBJECT TO FURTHER LIMITATIONS AND REQUIREMENTS CONTAINED IN THE CONSTRUCTION CONTRACT DOCUMENTS.
- REJECTED REVISE AND RESUBMIT FURNISH AS CORRECTED

CORRECTIONS OR COMMENTS MADE ON THE SHOP DRAWINGS DURING THIS REVIEW DO NOT RELIEVE CONTRACTOR FROM COMPLIANCE WITH REQUIREMENTS OF THE DRAWINGS AND SPECIFICATIONS. THIS CHECK IS ONLY FOR REVIEW OF GENERAL CONFORMANCE WITH THE DESIGN CONCEPT OF THE PROJECT AND GENERAL COMPLIANCE WITH THE INFORMATION GIVEN IN THE CONTRACT DOCUMENTS. THE CONTRACTOR IS RESPONSIBLE FOR CONFIRMING AND CORRELATING ALL QUANTITIES AND DIMENSIONS, SELECTING FABRICATION PROCESSES AND TECHNIQUES OF CONSTRUCTION, COORDINATING HIS WORK WITH THAT OF ALL OTHER TRADES, AND PERFORMING HIS WORK IN A SAFE AND SATISFACTORY MANNER.

Vannase Hangen Brustlin, Inc.
7056 US Route 7
North Ferrisburgh, VT 05473
802.425.7788

Job Number: 57427.00
Reviewed By: S.E. Burbank
Date: 06/19/2014

- △ 4-7-14 REVISED AS NOTED
- △ 5-6-14 REVISED AS NOTED

APPROVAL STAMP:	J.P. CARRARA & SONS INC. Precast & Prestress Manufacturer N.T.S. 244 OAK ST., MIDDLEBURY, VERMONT 05753 Phone:(802)388-6361 Fax:(802)388-9010	
	STATE OF VERMONT AGENCY OF TRANSPORTATION COUNTY OF WINDHAM	DATE: MAR. 04, 2014 SCALE: NOTED
	TOWN OF GUILFORD ROUTE NO. T.H.10, CLASS III (LOCAL ROAD) BRIDGE NO.: 65 PROJECT NO.: BRO 1442 (36)	CHKD: JJ/KLT DFTM:AA1/RWS JOB NO: 23420-014
	ABUTMENT ELEVATIONS	DWG. NO: F4

Eriksson technologies
813.989.3317
TAMPA, FL LRFD.COM
© 2014 ERIKSSON TECHNOLOGIES, INC. ALL RIGHTS RESERVED