


S:\Engineering Services\Carrara\14001 - Guilford Bridge 65\Production Drawings\AutoCAD Files\144236-M.L.dwg, 5/6/2014 4:44:46 PM, DWG To PDF.pc3

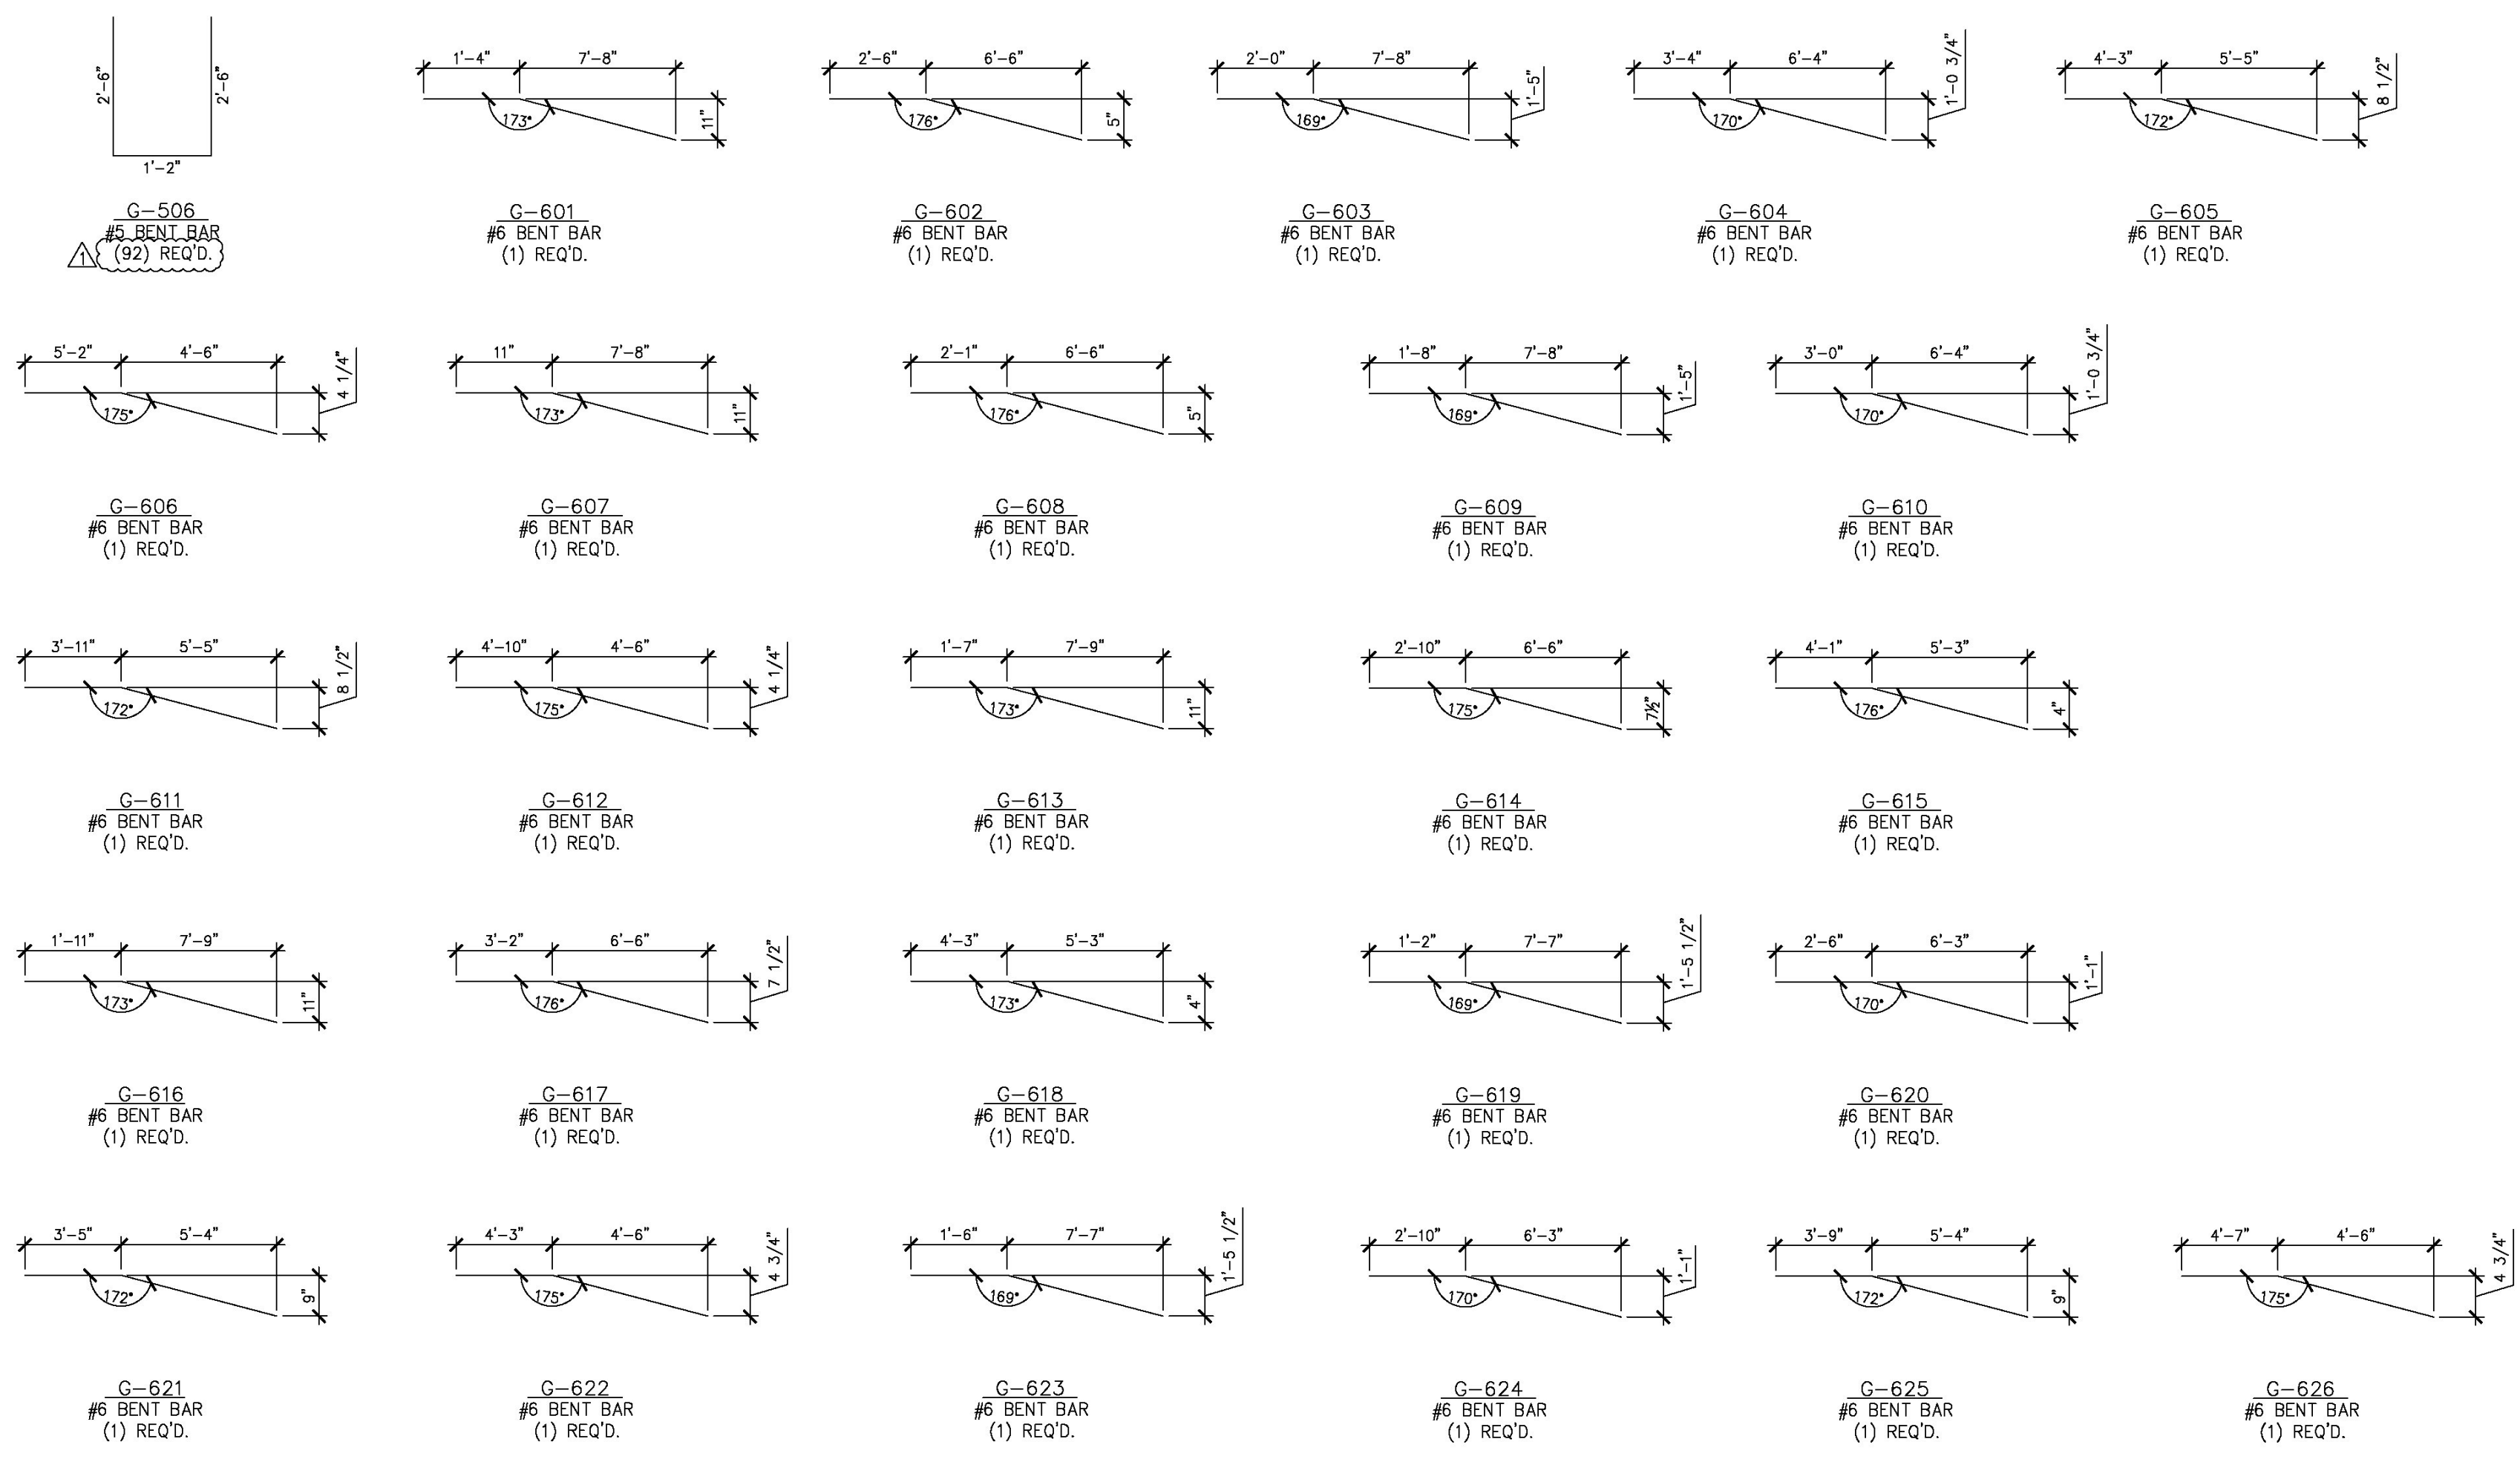

PRECAST WINGWALLS

MISCELLANEOUS MATERIALS				
ITEM	MARK	QTY.	DESCRIPTION	REMARKS
1		22	#5 x 9'-3"	
2		24	#5 x 9'-5"	
3		24	#5 x 9'-9"	
4		22	#5 x 9'-11"	
5				
6				
7		20	#6 x 8'-5"	
8		18	#6 x 8'-7"	
9		38	#6 x 8'-10"	
10		37	#6 x 9'-2"	
11		37	#6 x 9'-5"	
12				
13				
14				
15				
16				
17	MK-G3	16	41 x 9 1/2" SWIFT LIFT LIFTER	
18	MK-G5	176	NMB SPLICE SLEEVE 6U-(PG)	ORDER (3) EXTRA FOR TESTING - TOTAL (179)
19	MK-G6	8	201 x 19 3/4" SWIFT LIFT LIFTER	
20				
21				
22				

PRECAST WING WALLS

Vermont Agency of Transportation
RECEIVED
 CK'D BY MJC OK'D BY TAS
 June 18, 2014
 RESUBMIT No Approved
 BY M. J. Chenette DATE 06/19/2014

SHOP DRAWING REVIEW

REVIEWED AS REQUIRED BY THE CONSTRUCTION CONTRACT DOCUMENTS AND APPROVED, BUT ONLY FOR CONFORMANCE TO THE DESIGN CONCEPT OF THE WORK, AND SUBJECT TO FURTHER LIMITATIONS AND REQUIREMENTS CONTAINED IN THE CONSTRUCTION CONTRACT DOCUMENTS.
 REJECTED REVISE AND RESUBMIT FURNISH AS CORRECTED

CORRECTIONS OR COMMENTS MADE ON THE SHOP DRAWINGS DURING THIS REVIEW DO NOT RELIEVE CONTRACTOR FROM COMPLIANCE WITH REQUIREMENTS OF THE DRAWINGS AND SPECIFICATIONS. THIS CHECK IS ONLY FOR REVIEW OF GENERAL CONFORMANCE WITH THE DESIGN CONCEPT OF THE PROJECT AND GENERAL COMPLIANCE WITH THE INFORMATION GIVEN IN THE CONTRACT DOCUMENTS. THE CONTRACTOR IS RESPONSIBLE FOR CONFIRMING AND CORRELATING ALL QUANTITIES AND DIMENSIONS, SELECTING FABRICATION PROCESSES AND TECHNIQUES OF CONSTRUCTION, COORDINATING HIS WORK WITH THAT OF ALL OTHER TRADES, AND PERFORMING HIS WORK IN A SAFE AND SATISFACTORY MANNER.

VHB Vanasse Hangen Brustlin, Inc.

7055 US Route 7
North Ferrisburgh, VT 05473
802.425.7798

Job Number: 57427.00
 Reviewed By: S E Burbank
 Date: 06/19/2014

4-7-14 REVISED AS NOTED

APPROVAL STAMP:	J.P. CARRARA & SONS INC. Precast & Prestress Manufacturer N.T.S. <small>244 OASE ST., MIDDLEBURY, VERMONT 05753 Phone:(802)388-6361 Fax:(802)388-9010</small>	DATE: MAR. 04, 2014 SCALE: NOTED CHKD: JJ/KLT DFTM:AA1/RWS JOB NO: 23420-014 DWG. NO: M2
STATE OF VERMONT AGENCY OF TRANSPORTATION COUNTY OF WINDHAM TOWN OF GUILFORD ROUTE NO. T.H.10, CLASS III (LOCAL ROAD) BRIDGE NO.: 65 PROJECT NO.: BRO 1442 (36)		
MATERIALS LIST		

813.989.3317
 TAMPA, FL LRFD.COM
© 2014 ERIKSSON TECHNOLOGIES, INC. ALL RIGHTS RESERVED