


ELEVATION

6
57.104
LOSS. 33

1.71

1' 8 1/2"

NOTES:
1. ALL BLOCKS ARE REDI ROCK LIME STONE FINISHED BLOCKS.

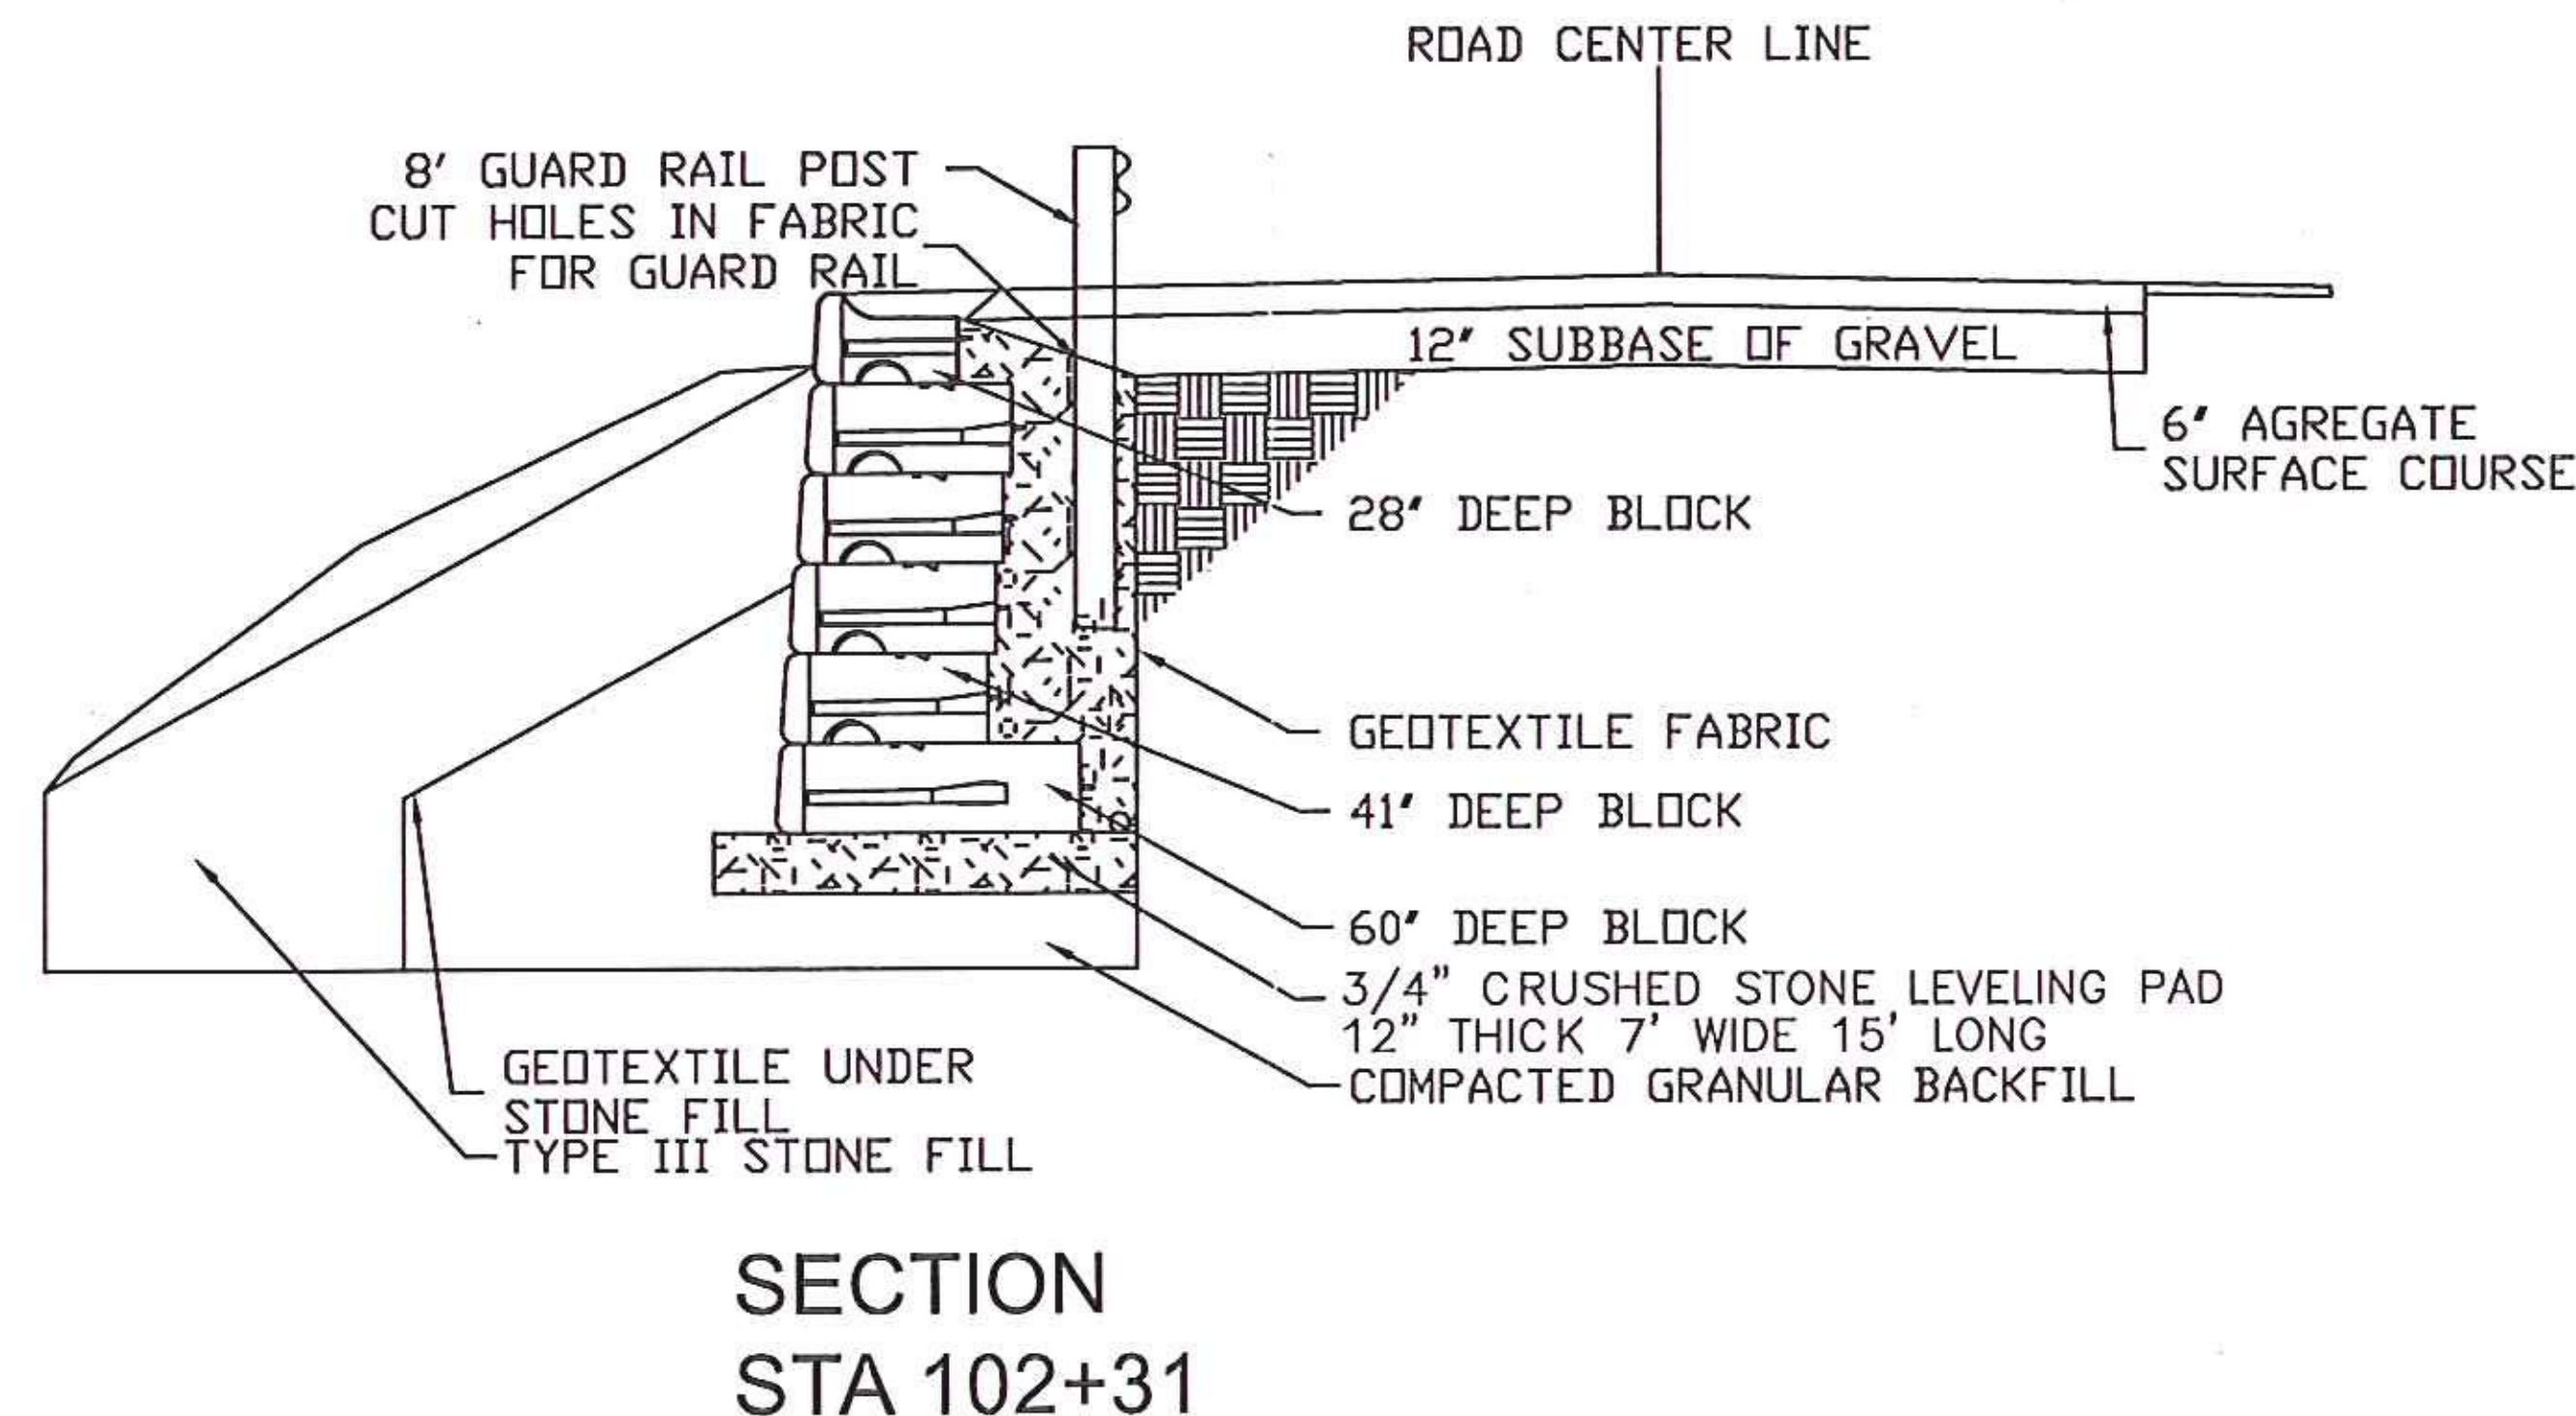

Vermont Agency of Transportation

RECEIVED

CK'D BY MJC OK'D BY TAS

August 25, 2014

RESUBMIT No Approved
BY M. J. Chenette DATE 08/27/2014

REV. NO.		DATE:		SHEET NAME: RETAINING WALL ELEVATION AND SECTION	
1	?	1	??/??	PROJECT NAME: GUILFORD BRO	SHEET NO. 2
				PROJECT NO: 1442 (36)	OF 8
				DRAWN BY: CDE	