



PLAN
SCALE: 1" = 10'-0"

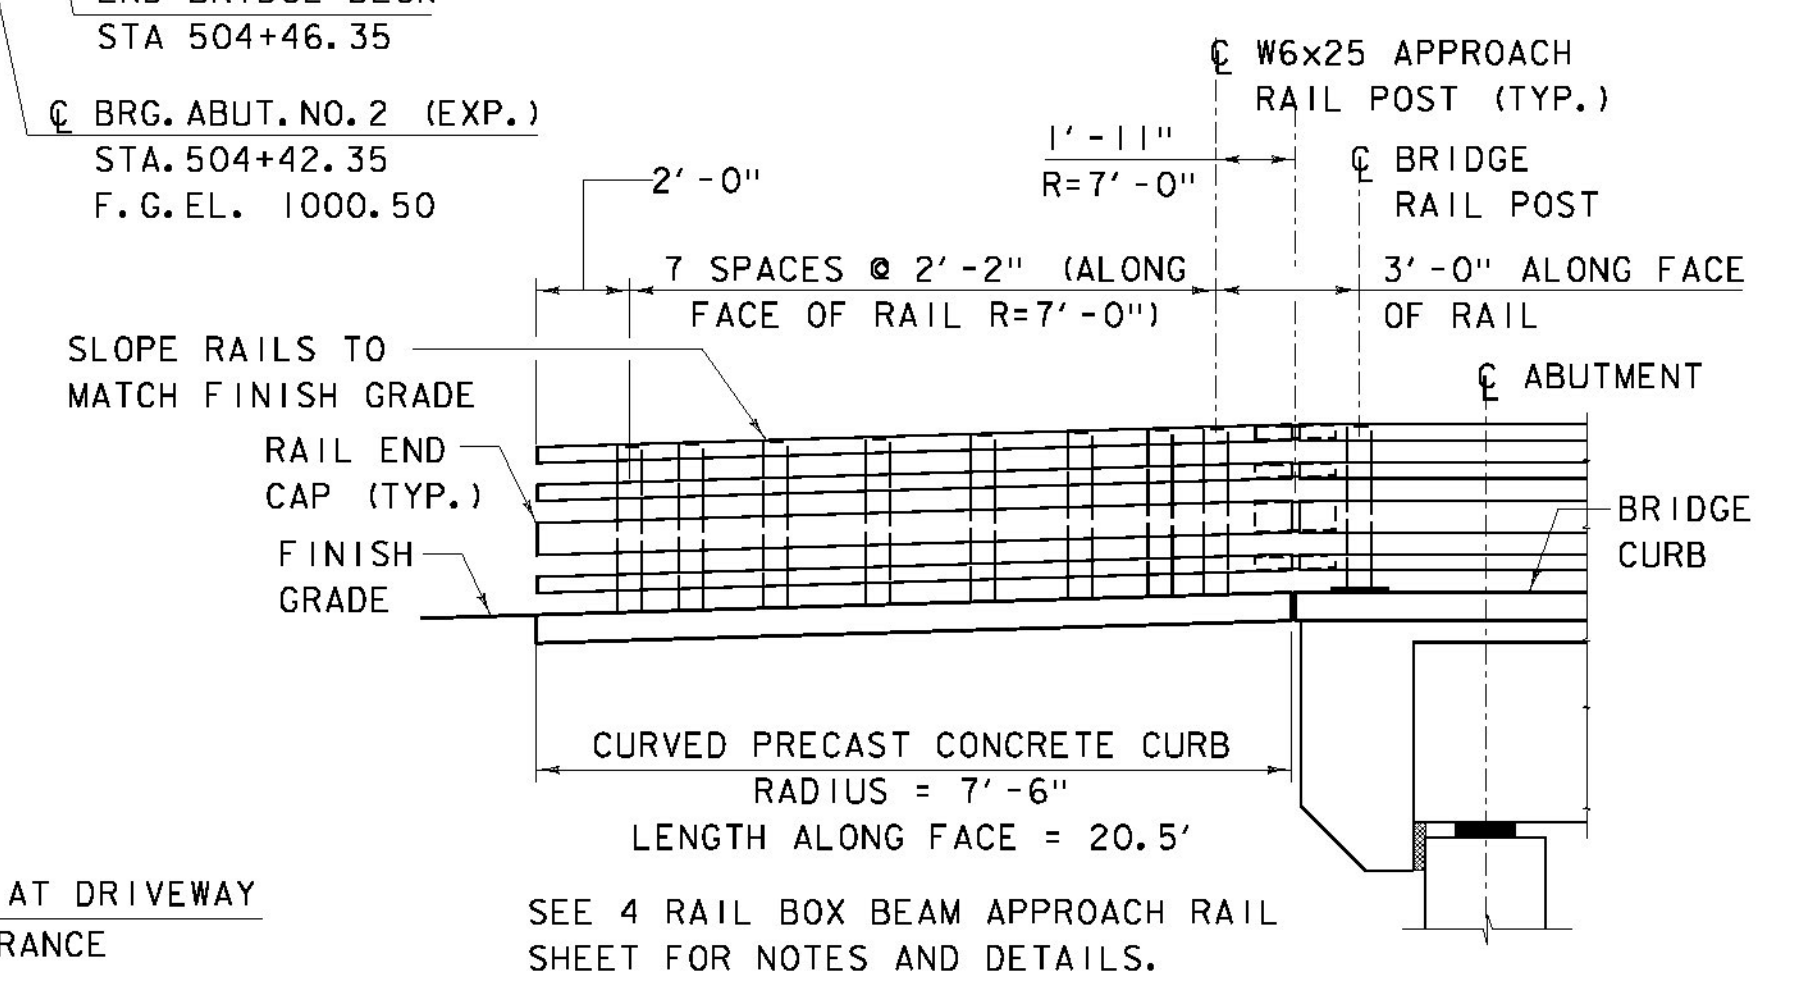

APPROACH RAIL ELEVATION AT WW4
SCALE: 1/4" = 1'-0"

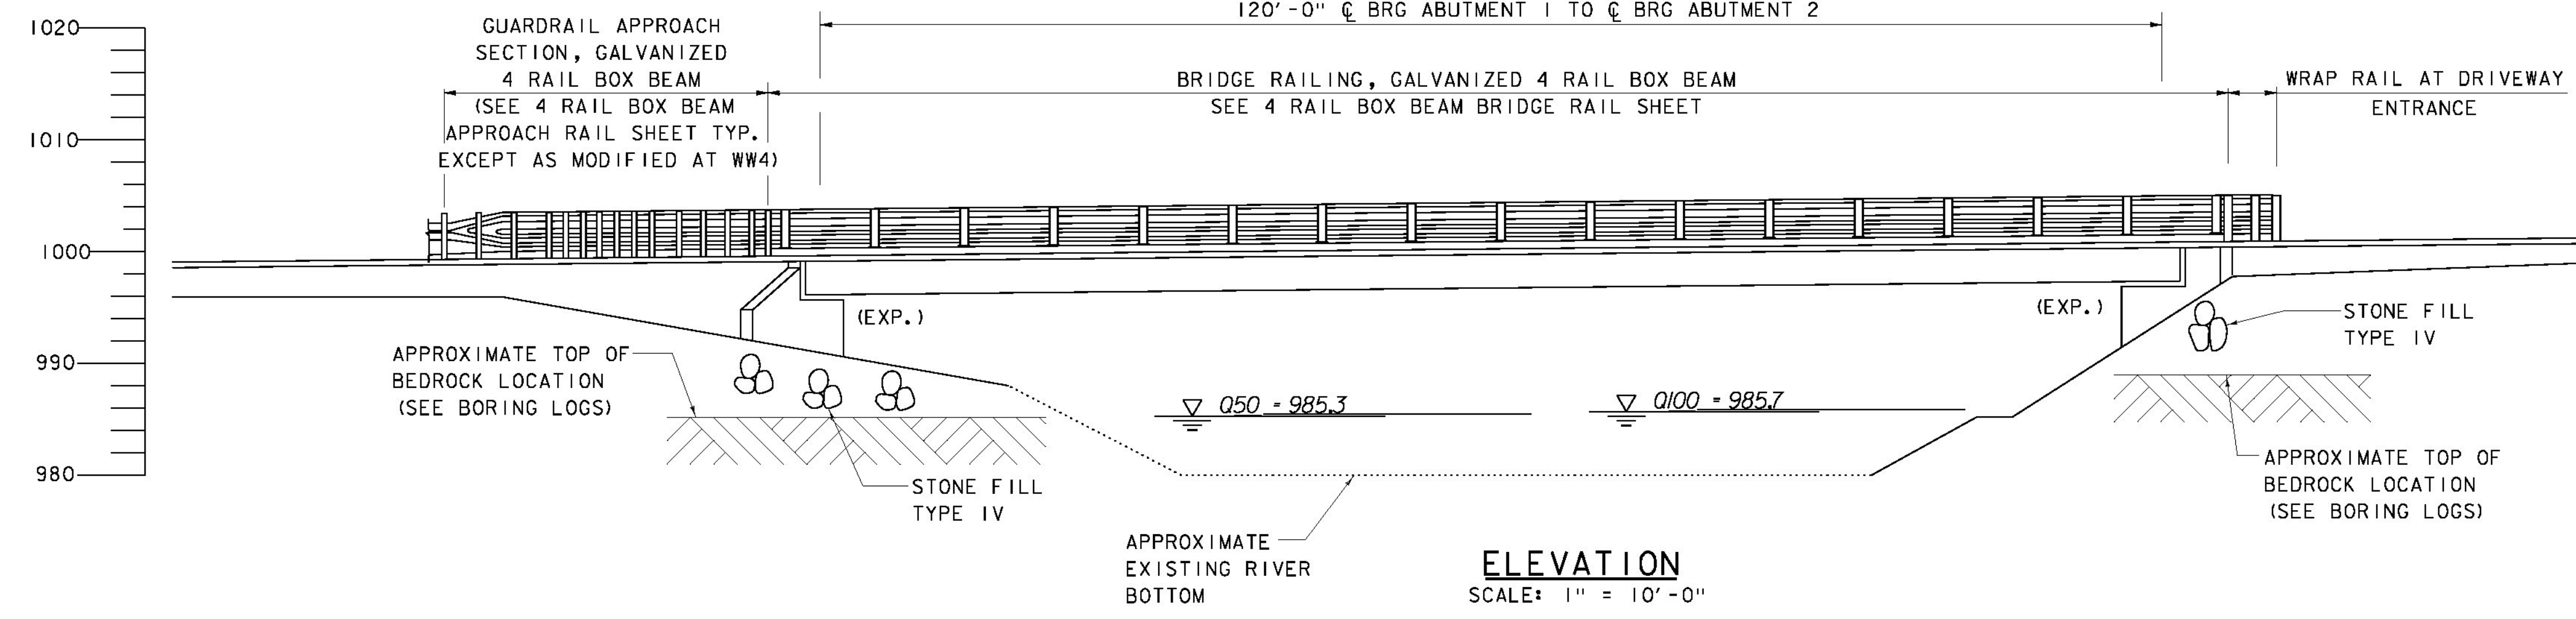

ELEVATION
SCALE: 1" = 10'-0"

△ REVISED PRECAST ABUTMENT CONNECTORS - 1/22/2015



PROJECT NAME:	LINCOLN
PROJECT NUMBER:	BRF 0188 (8)
FILE NAME:	z10j066pe.dgn
PROJECT LEADER:	G.K. DONINGTON
DESIGNED BY:	K JAMES
PLAN AND ELEVATION SHEET	
PLOT DATE:	8-DEC-2014
DRAWN BY:	W GERHOLD
CHECKED BY:	A STOCKIN
SHEET 20	OF 62