




**ABUTMENT #1 PLAN CAST-IN-PLACE FOOTING MASONRY**  
SCALE: 3/16" = 1'-0"

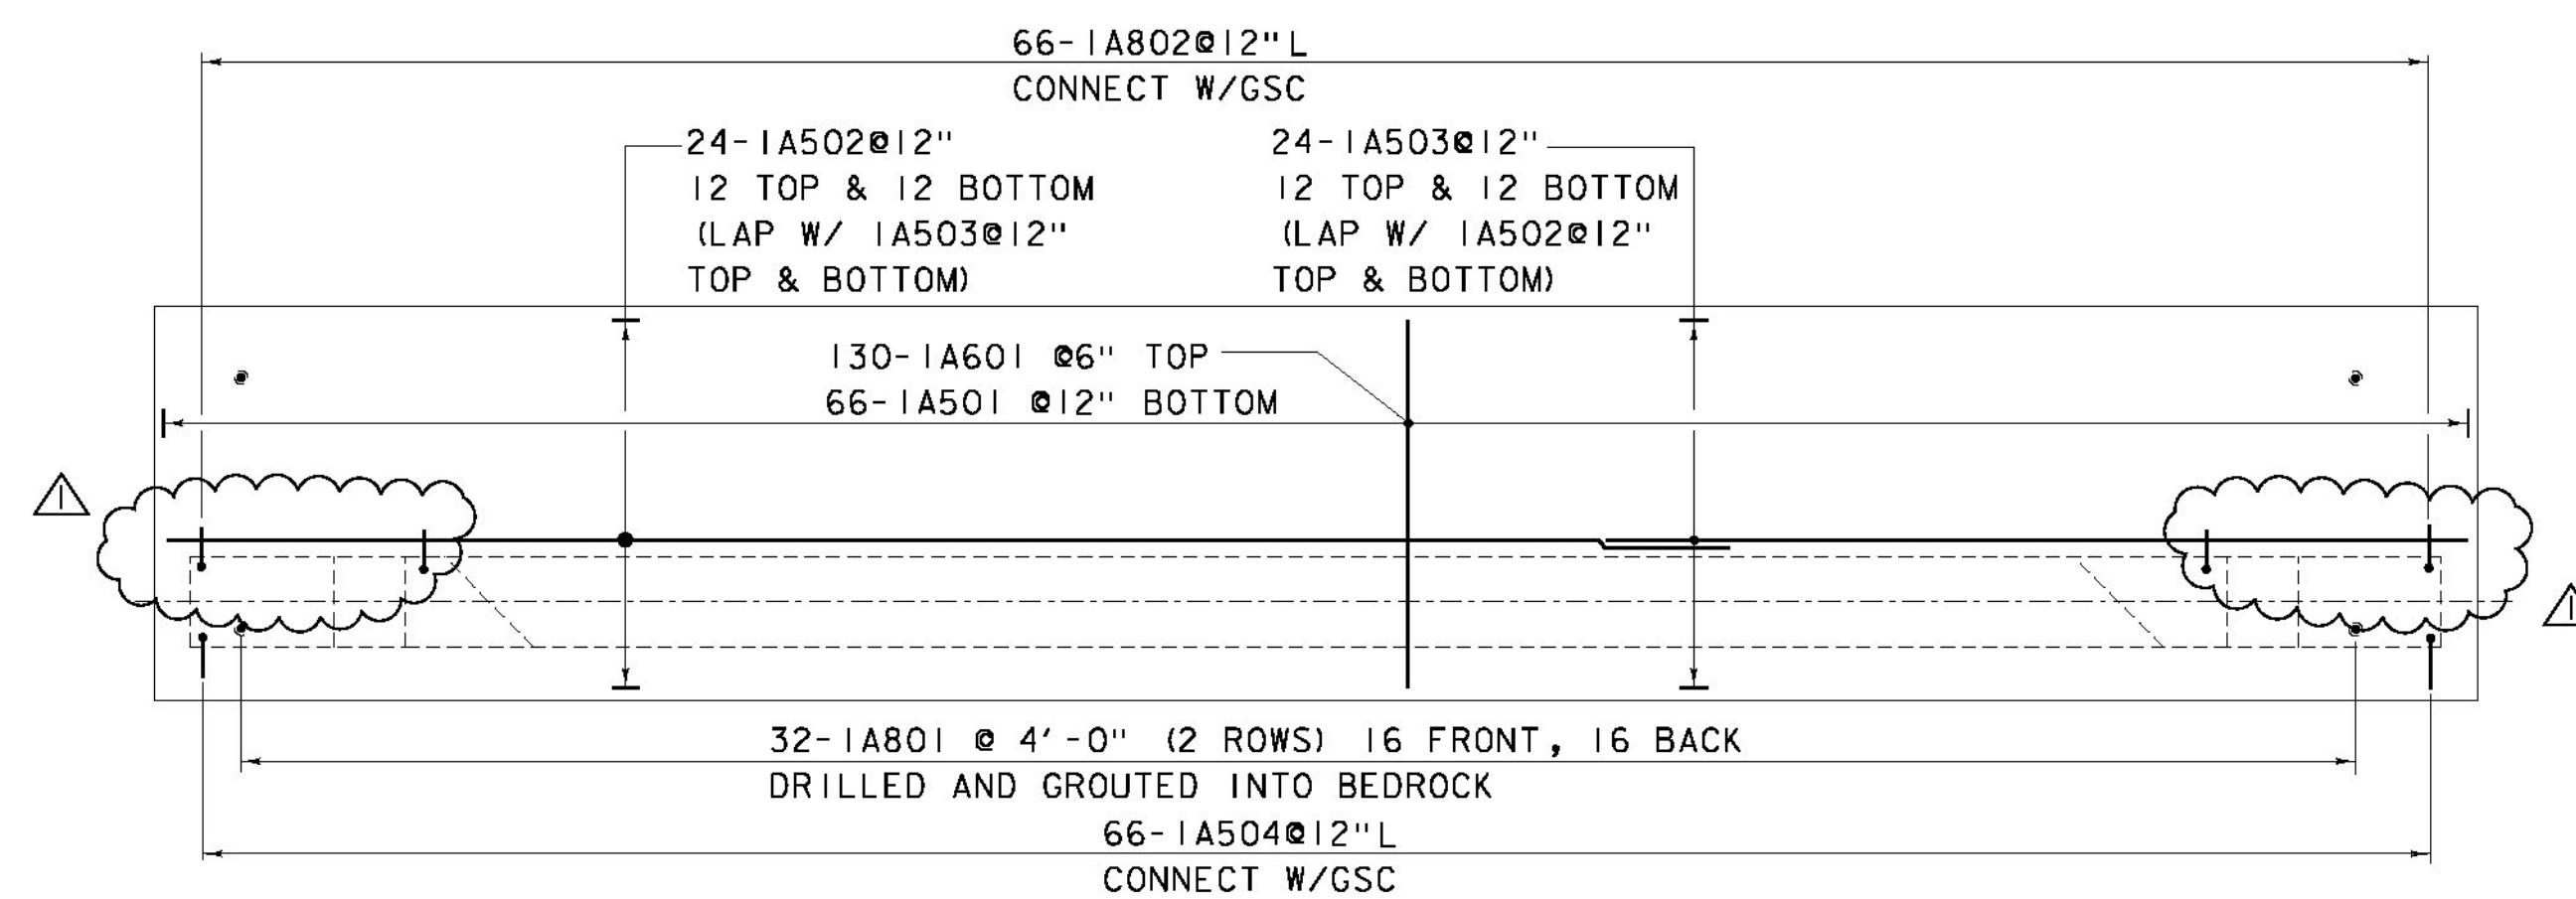

**ABUTMENT #1 PLAN CAST-IN-PLACE FOOTING REINFORCING**  
SCALE: 3/16" = 1'-0"

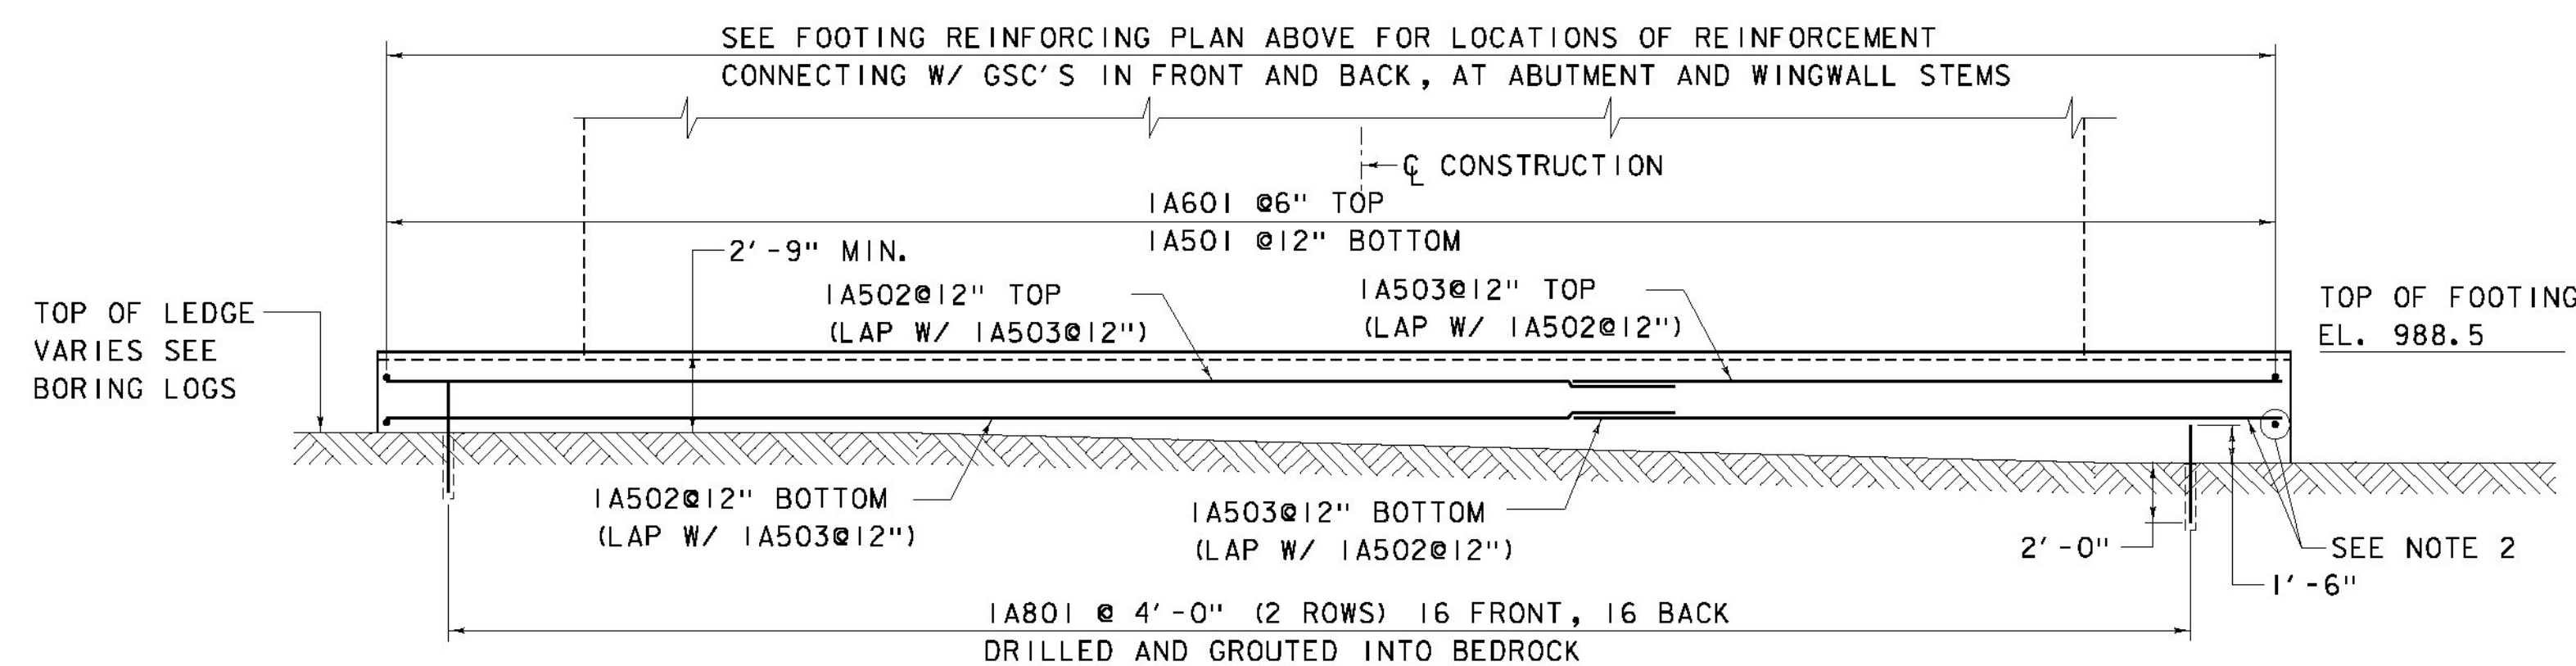

**ABUTMENT #1 CAST-IN-PLACE FOOTING ELEVATION**  
SCALE: 3/16" = 1'-0"

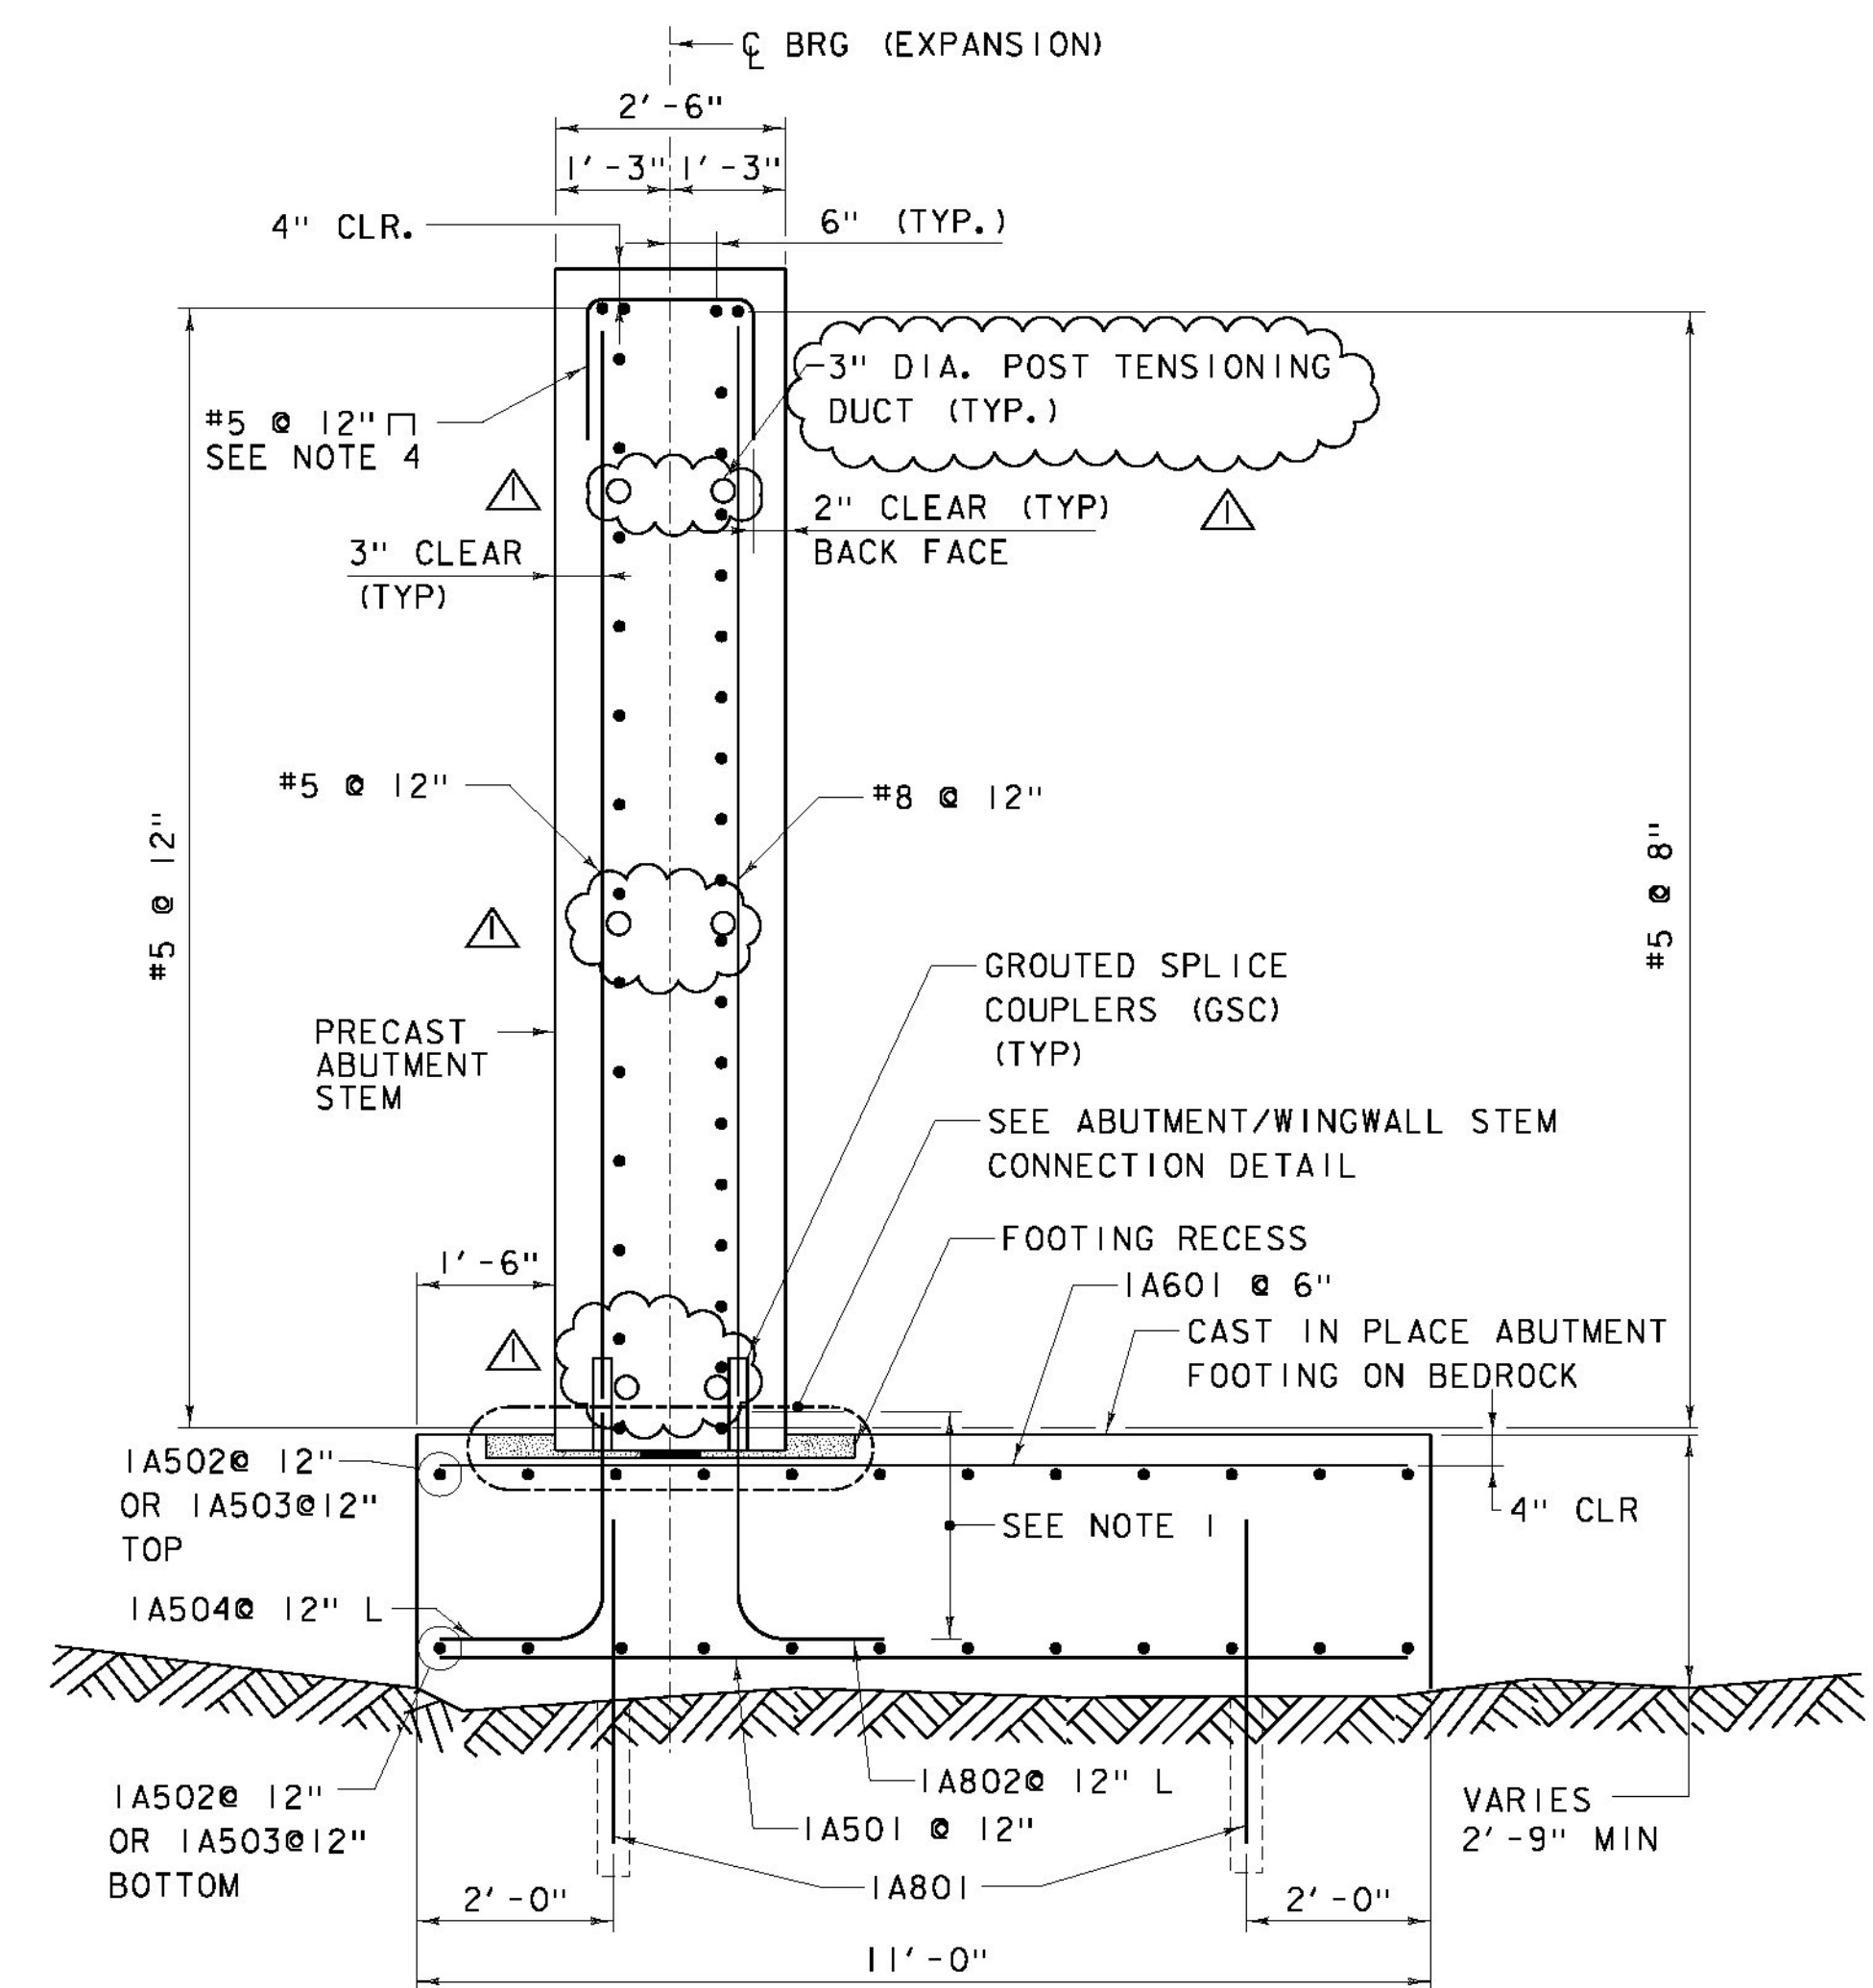

**TYPICAL ABUTMENT SECTION**  
SCALE: 1/2" = 1'-0"

- NOTES:
1. LEG LENGTH SHALL MEET THE REQUIREMENTS OF THE GROUTED SPLICE COUPLERS. DIMENSION IN REBAR SCHEDULE FOR ESTIMATING PURPOSES ONLY.
  2. BOTTOM LAYER OF ABUTMENT FOOTING REINFORCEMENT SHALL BE PLACED BASED ON THEORETICAL 2'-9" THICKNESS.
  3. THE TOP OF THE FOOTING ELEVATION FOR ABUTMENT 1 WAS SET BASED ON THE BEDROCK ELEVATIONS DETERMINED FROM BORINGS B-105 AND B-106. ACTUAL BEDROCK ELEVATIONS WILL VARY.
  4. REINFORCEMENT IN TOP OF ABUTMENT SHALL BE CENTERED ABOUT THE ANCHOR RODS SO THAT NO REINFORCEMENT IS DAMAGED DURING CORING OF THE ANCHOR ROD HOLES.
  5. MINIMUM SPLICE LENGTH FOR HORIZONTAL #5 BARS SHALL BE 3'-9" FOR EPOXY COATED BARS AND 3'-1" FOR BLACK BARS.

△ REVISED PRECAST ABUTMENT CONNECTORS - 1/22/2015

PROJECT NAME: LINCOLN  
PROJECT NUMBER: BRF 0188 (8)

FILE NAME: z10j066sub4.dgn  
PROJECT LEADER: K DONINGTON  
DESIGNED BY: K JAMES  
ABUTMENT 1 FOOTING PLAN

PLOT DATE: 8-DEC-2014  
DRAWN BY: W GERHOLD  
CHECKED BY: R GAUDREAU  
SHEET 27 OF 62

