



STA 500+25
 BEGIN APPROACH
 MATCH EXISTING GRADE AND BANKING

500+25

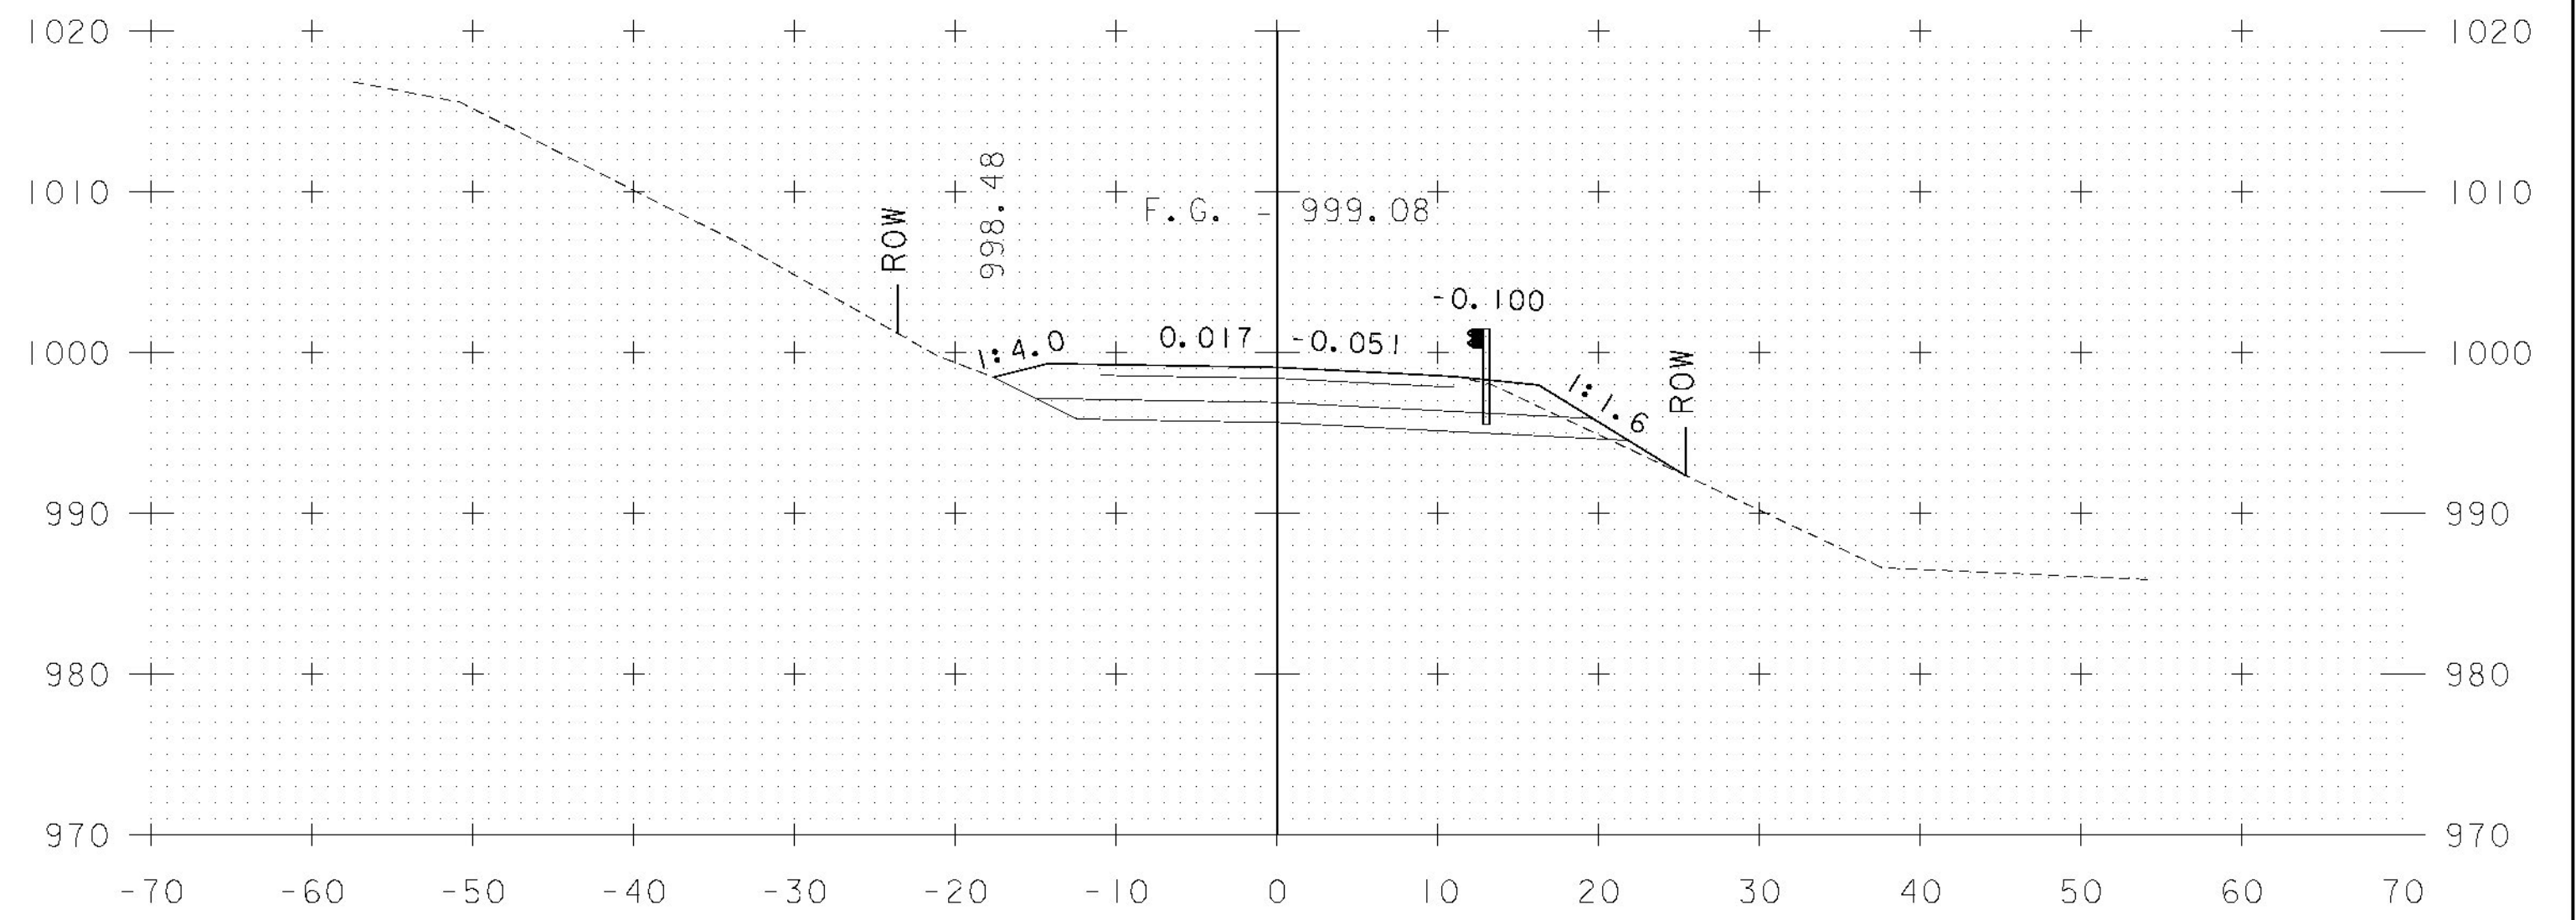


STA 500+75
 END APPROACH
 BEGIN PROJECT

500+75

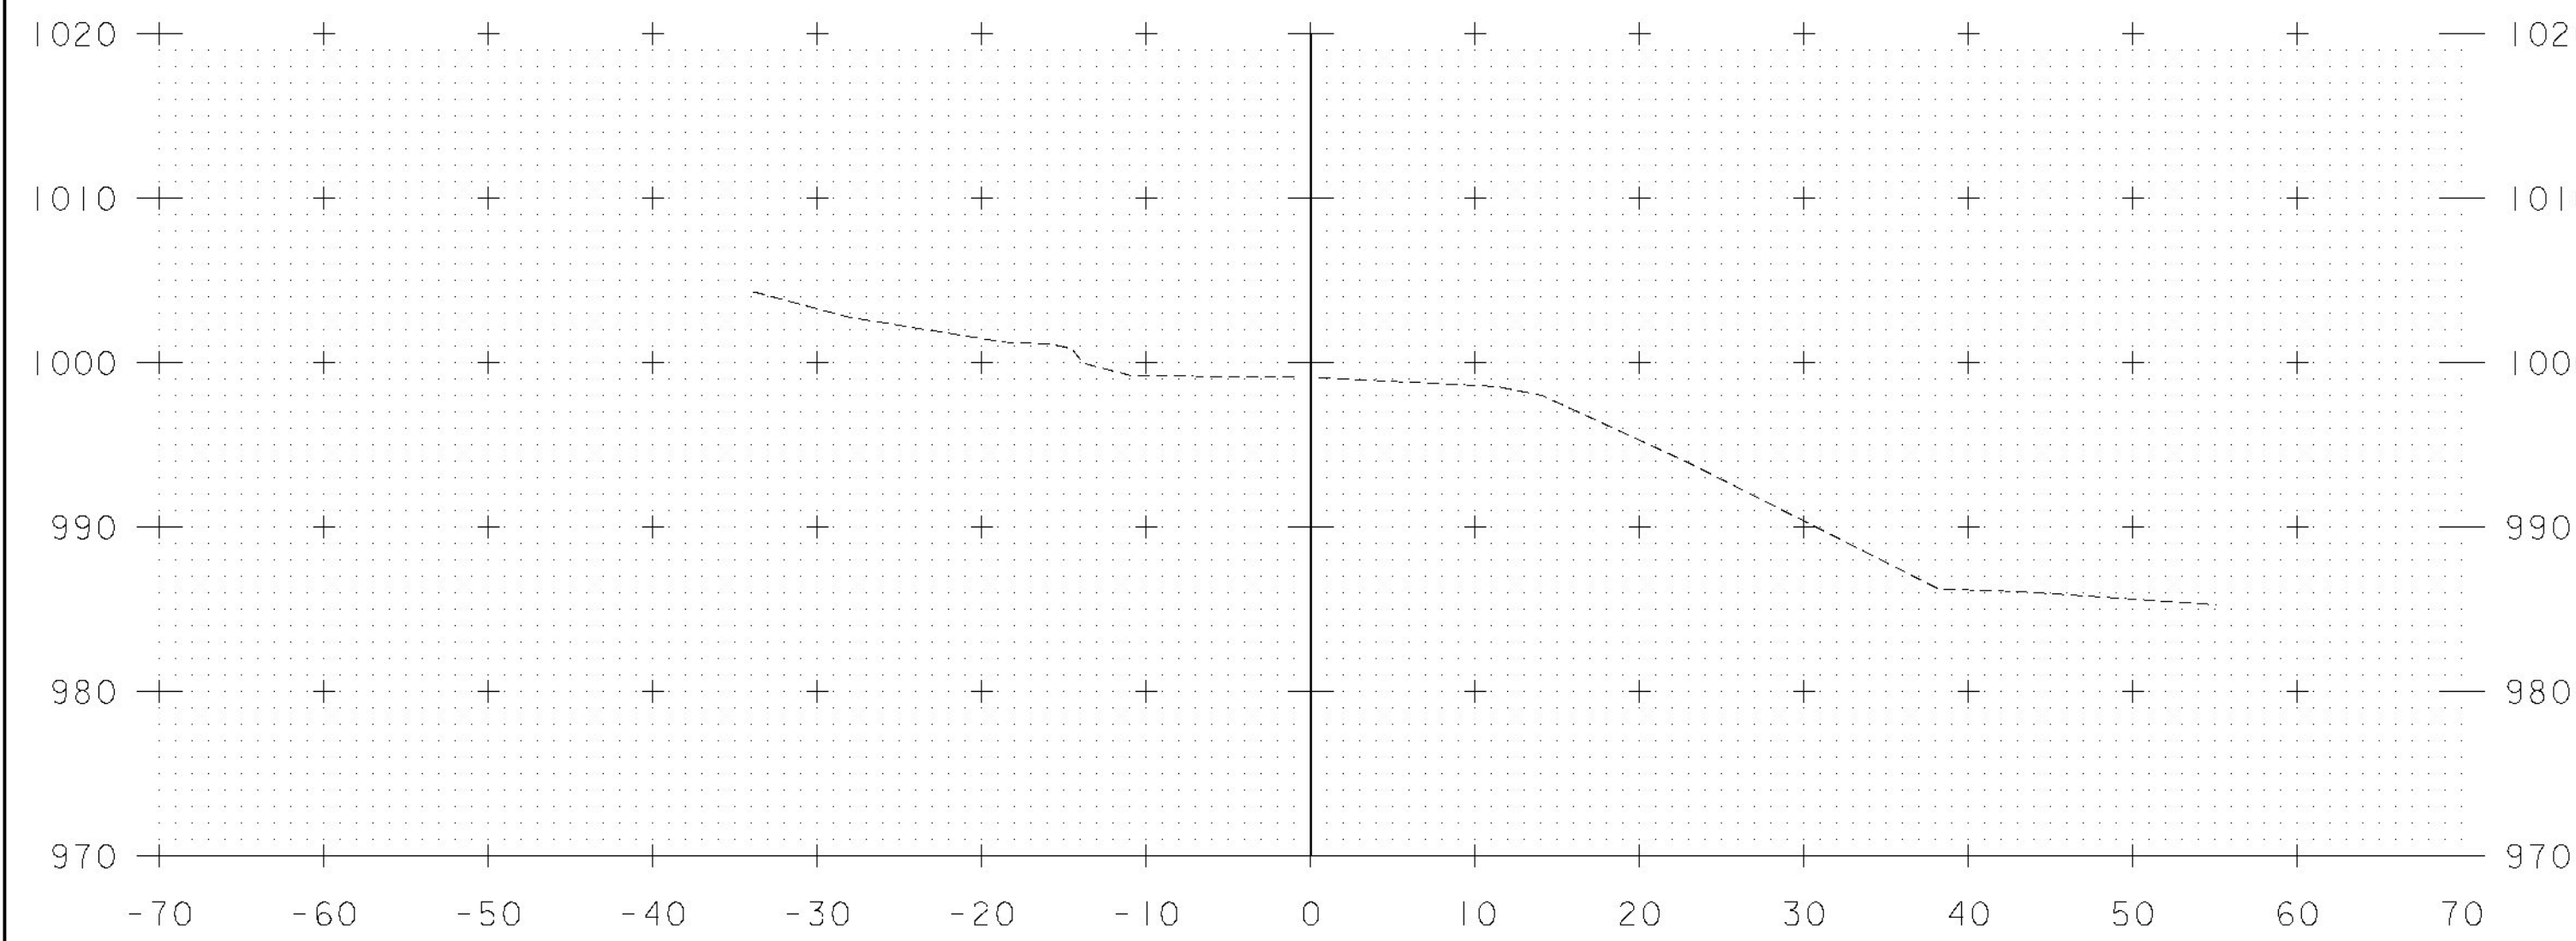

500+00

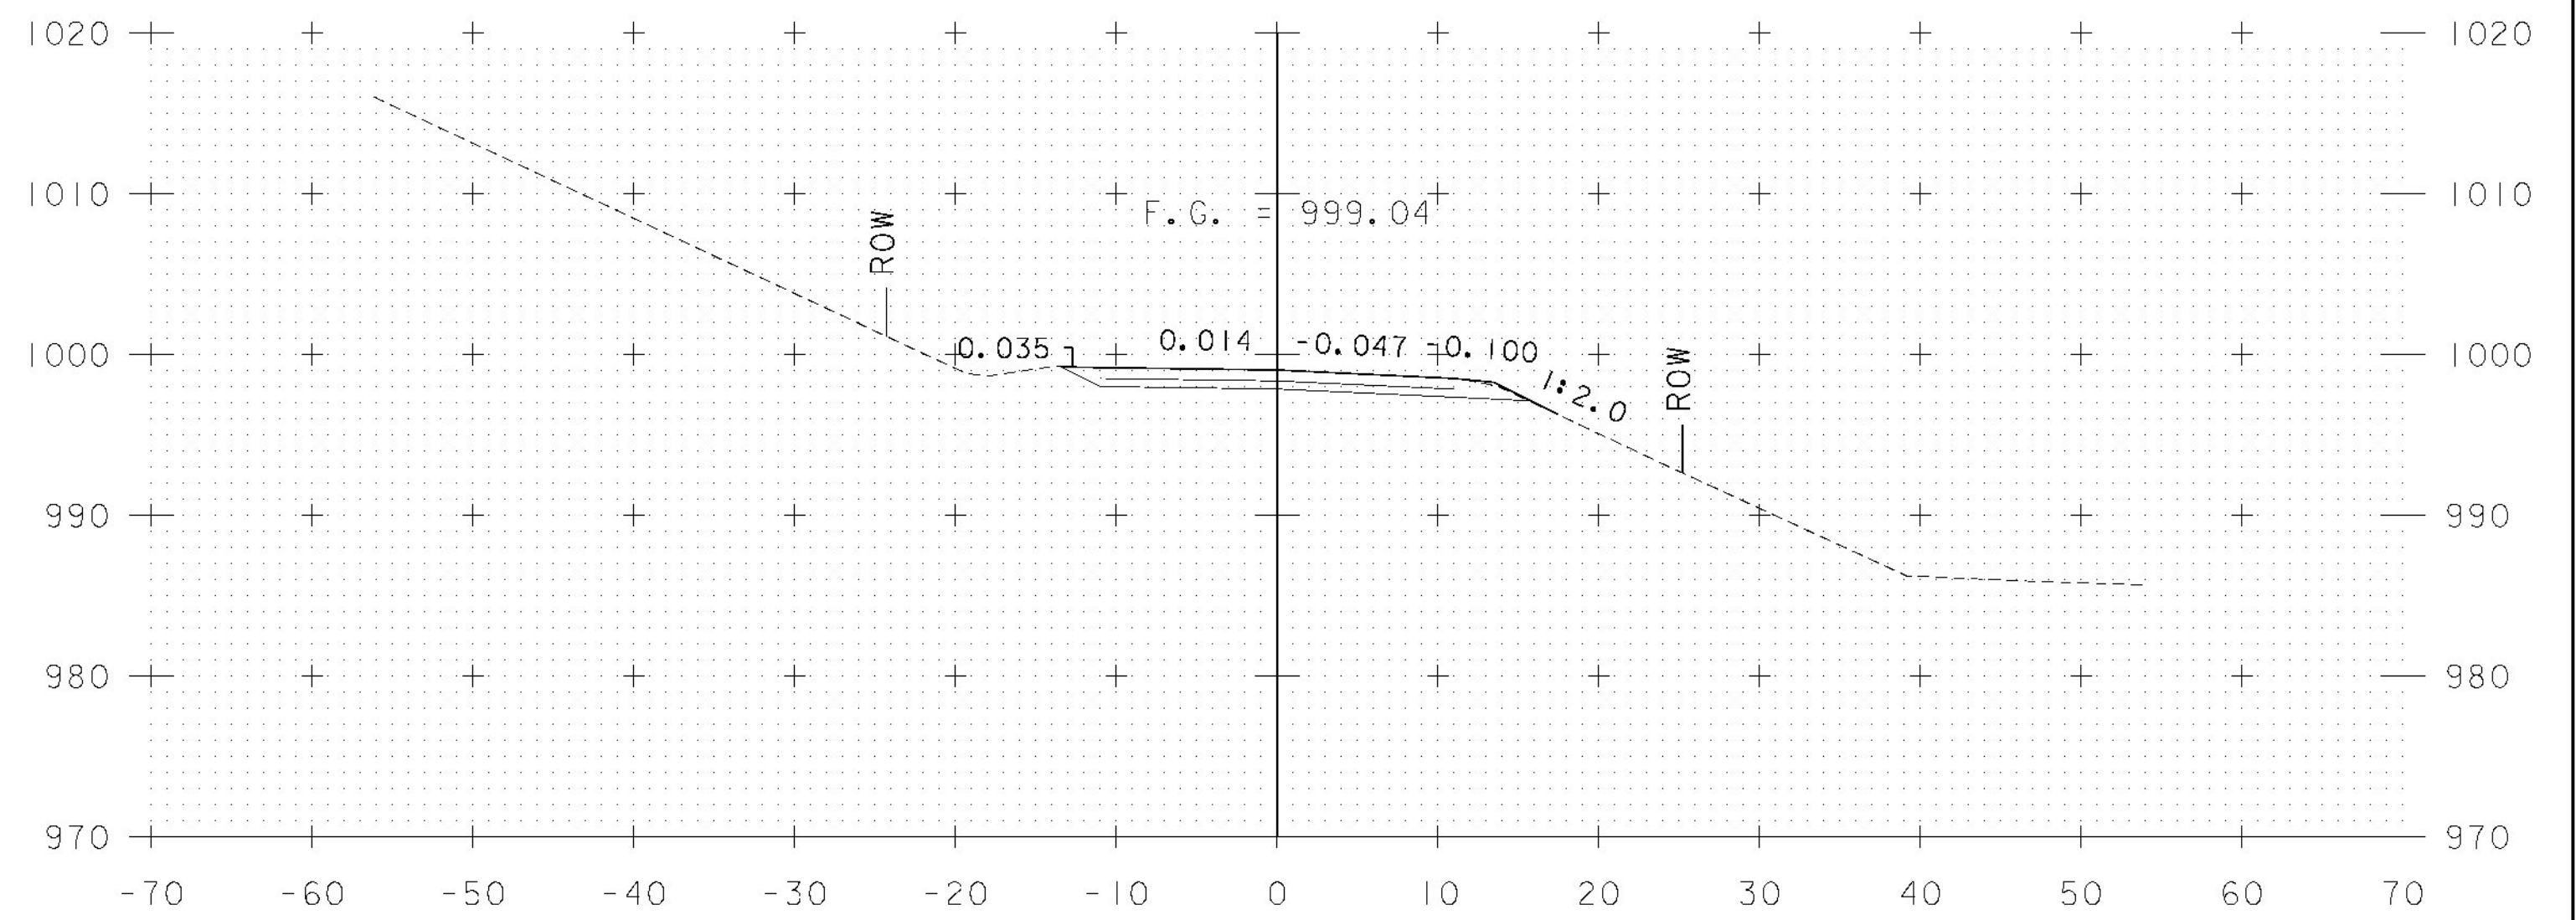

500+50

MAINLINE CROSS SECTIONS
STA. 500+00 - STA. 500+75

PROJECT NAME: LINCOLN
 PROJECT NUMBER: BRF 0188 (8)

FILE NAME: z10j066xsl.dgn
 PROJECT LEADER: G.K. DONINGTON
 DESIGNED BY: C CARNEY
 MAINLINE CROSS SECTIONS (I)

PLOT DATE: 8-DEC-2014
 DRAWN BY: C CARNEY
 CHECKED BY: R BENJAMIN
 SHEET 36 OF 62

