




501+25

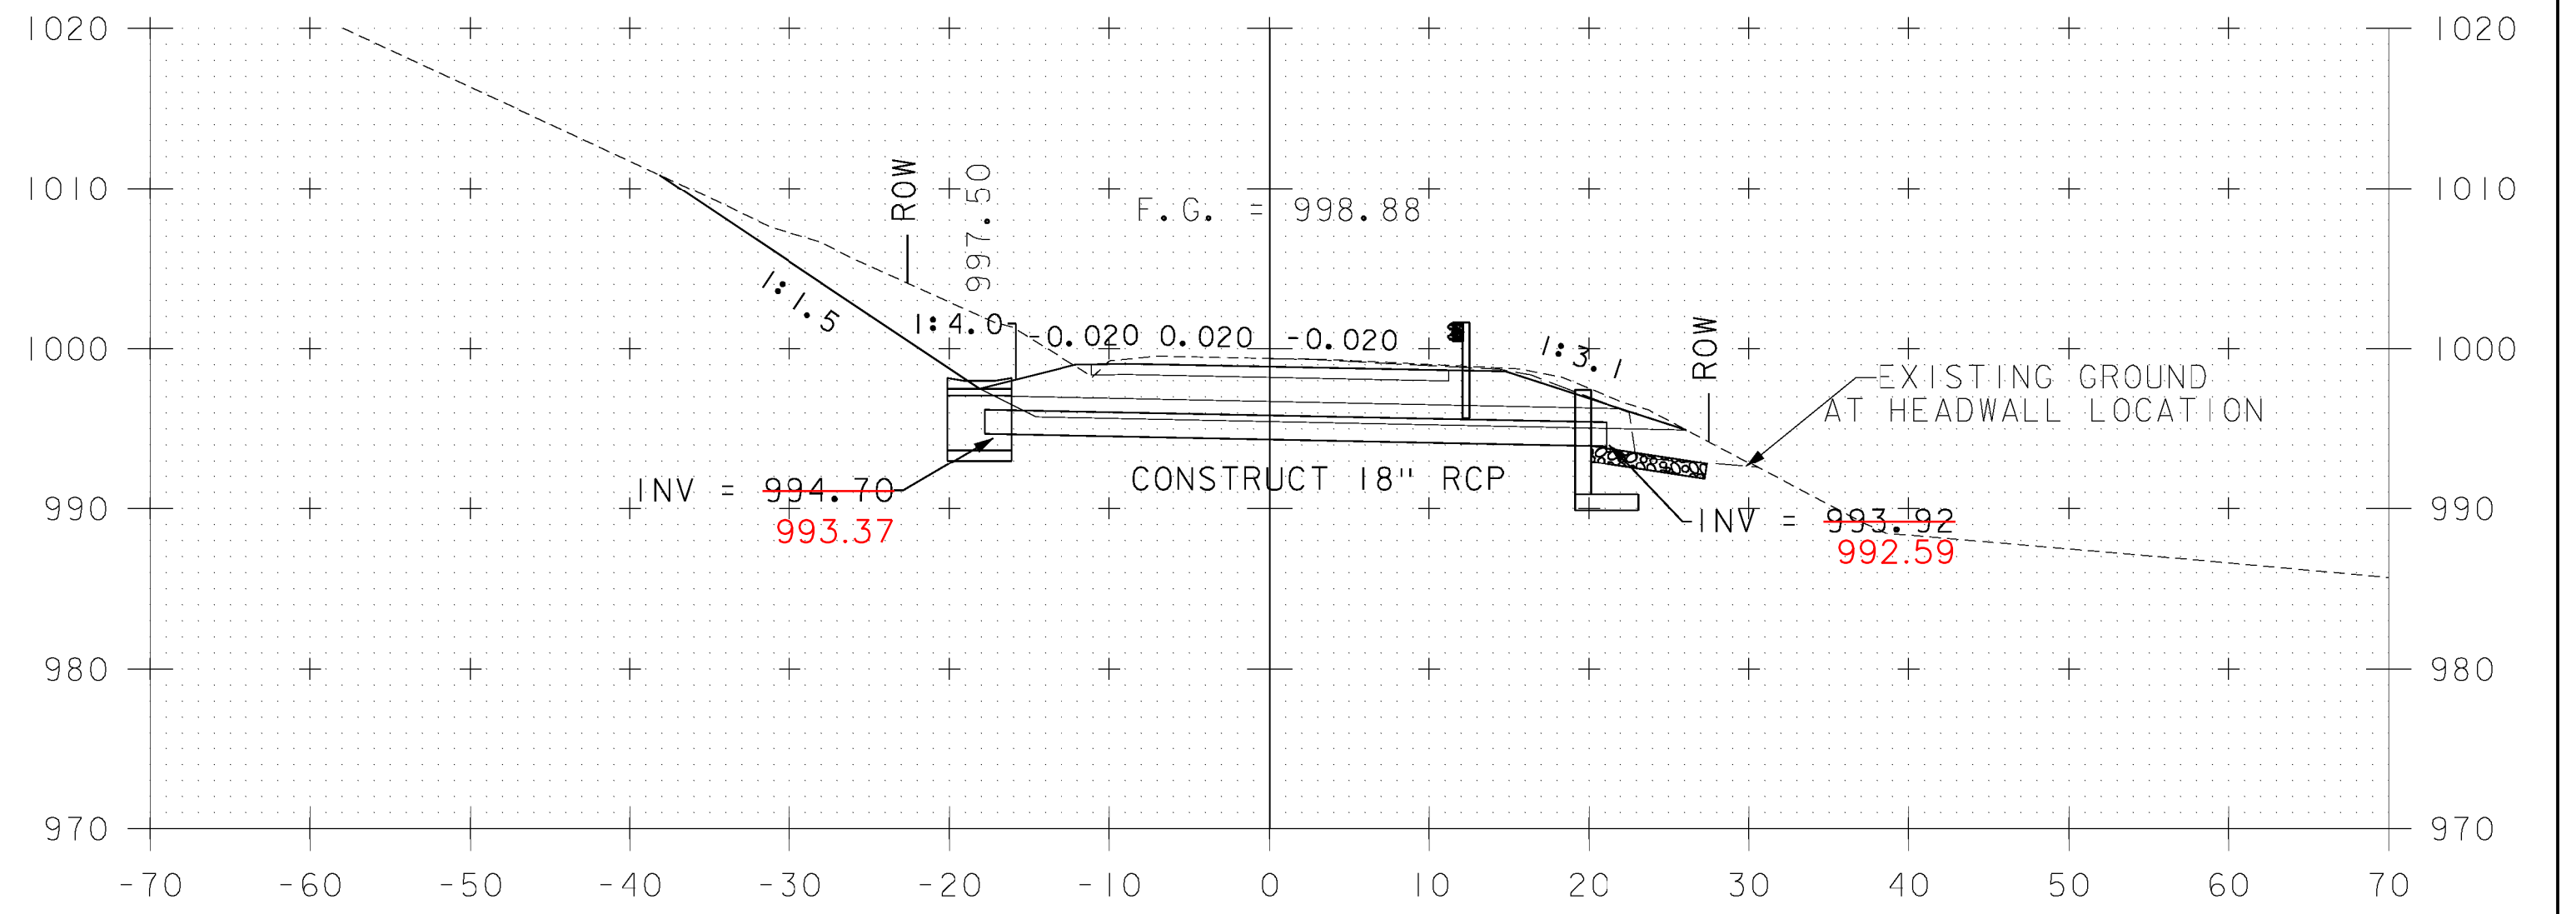

501+75

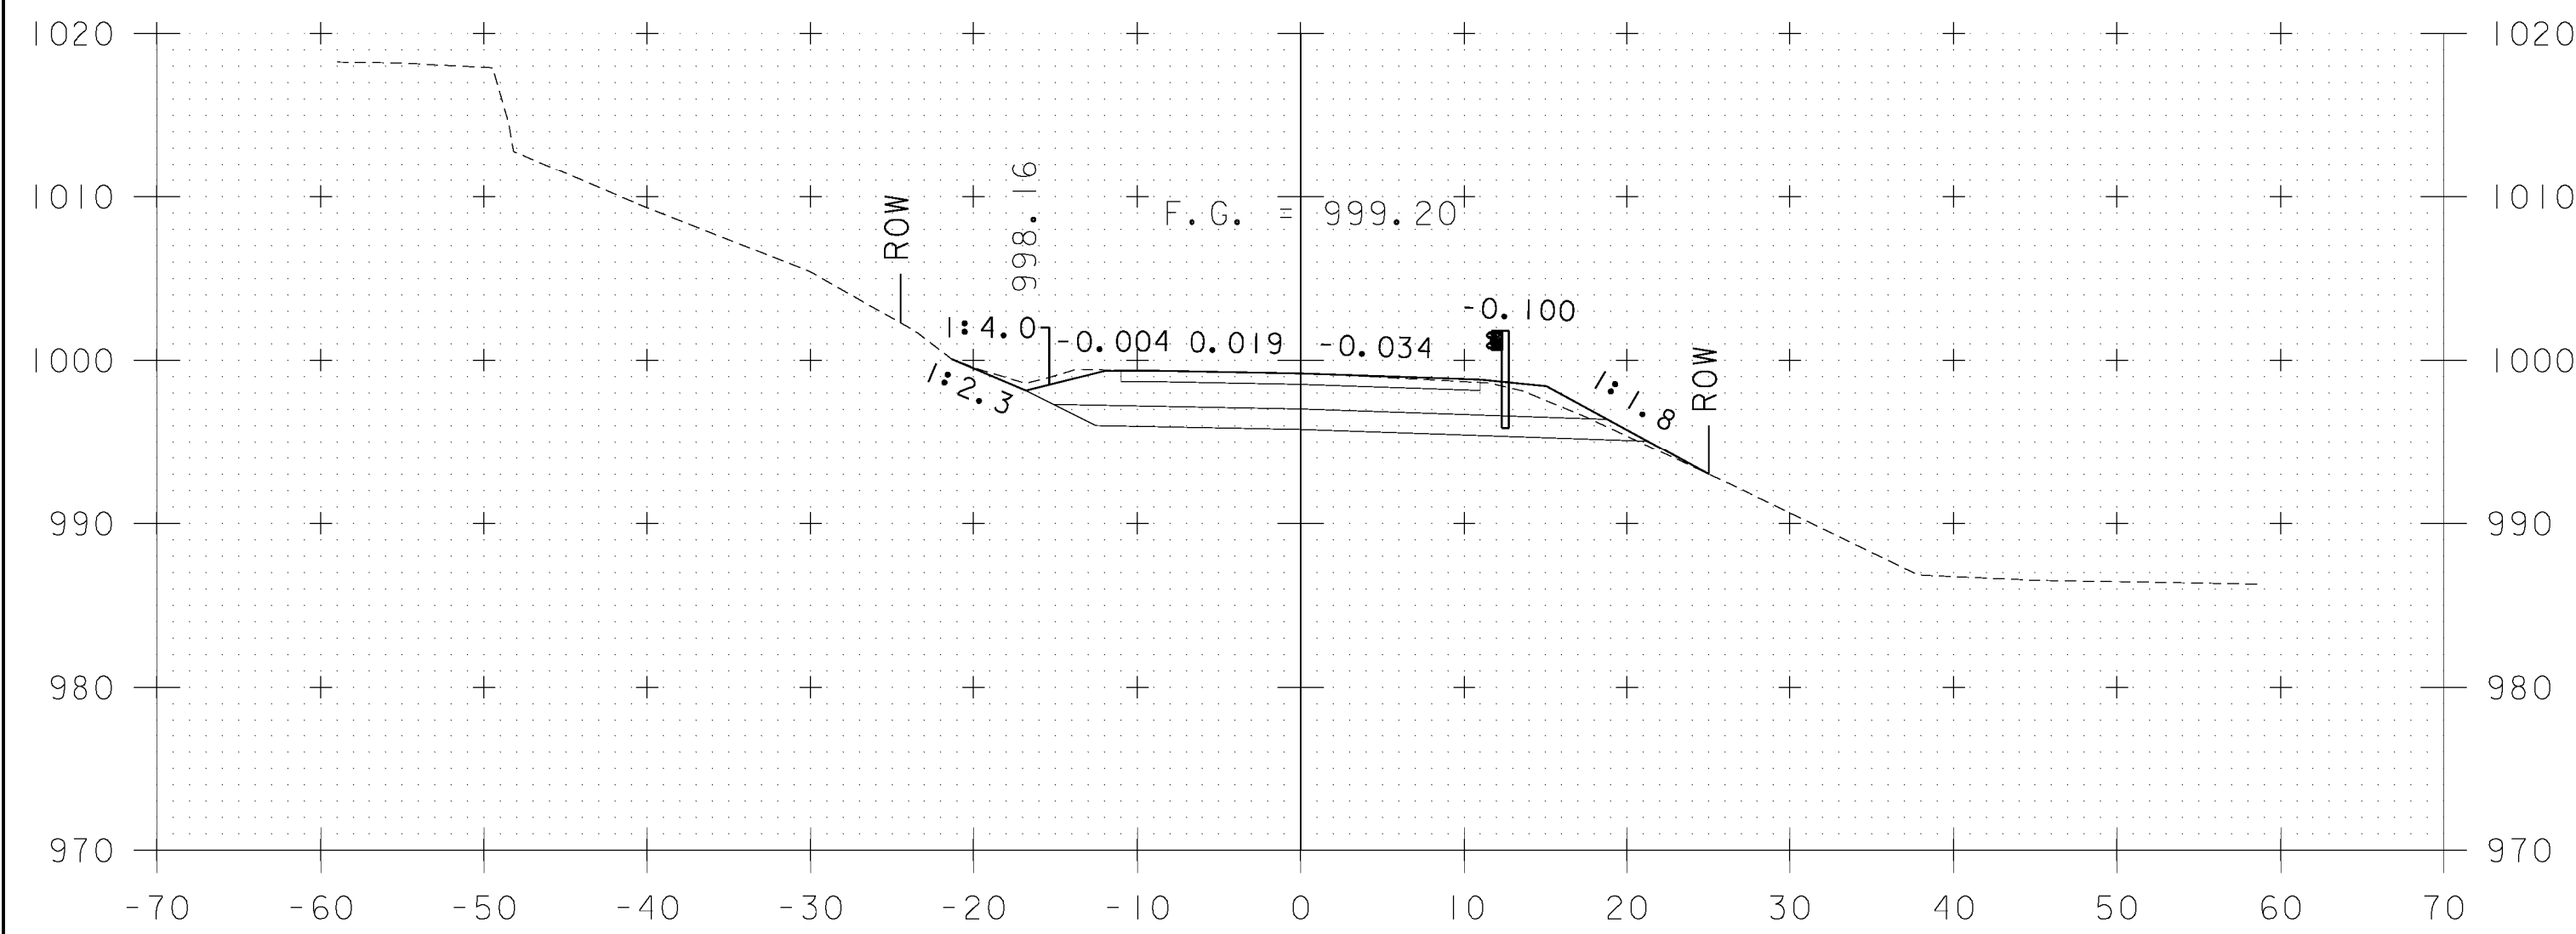

501+00

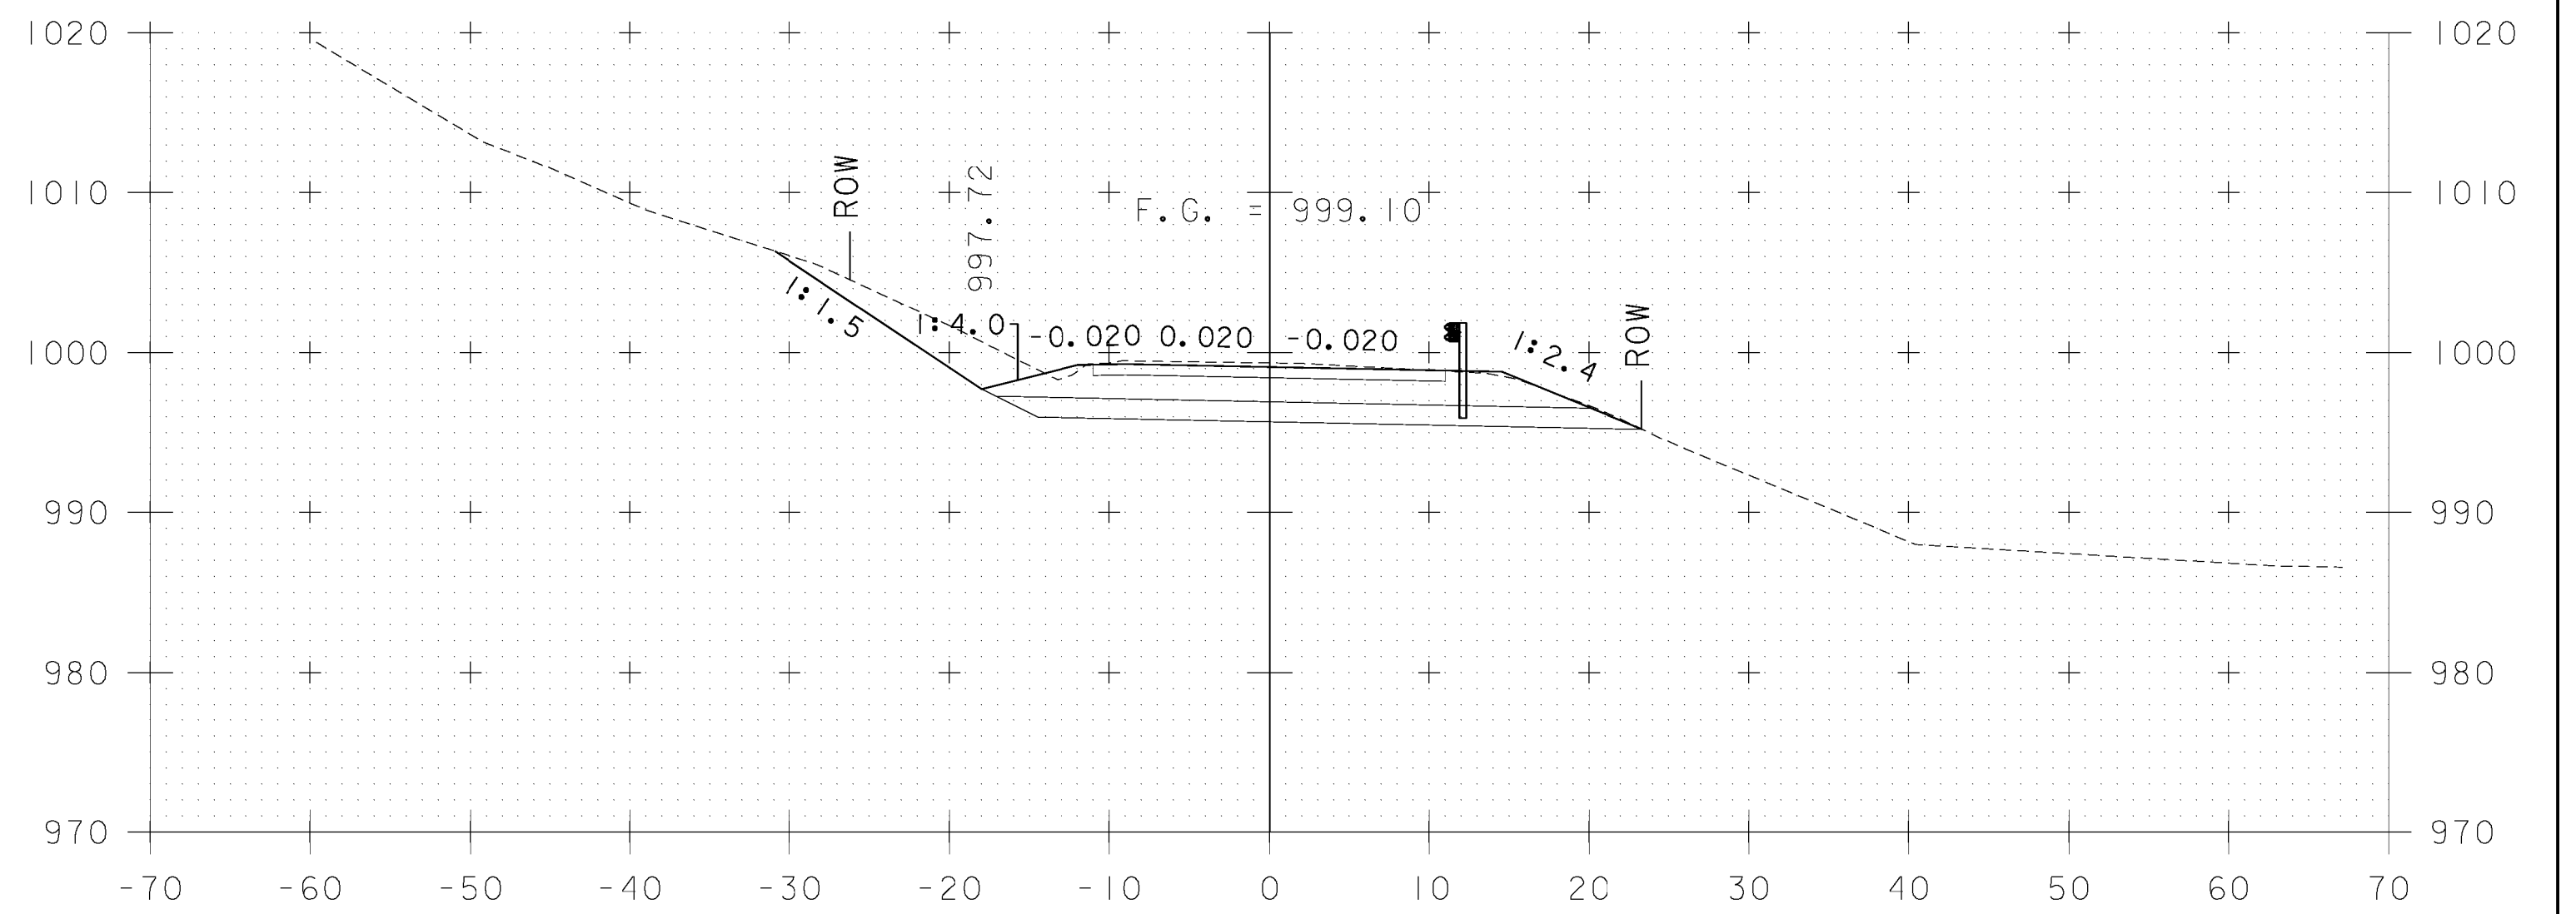

501+50

MAINLINE CROSS SECTIONS
STA. 501+00 - STA. 501+75

PROJECT NAME:	LINCOLN	FILE NAME:	z10j066xsl.dgn	PLOT DATE:	8-DEC-2014
PROJECT NUMBER:	BRF 0188 (8)	PROJECT LEADER:	G.K. DONINGTON	DRAWN BY:	C CARNEY
		DESIGNED BY:	C CARNEY	CHECKED BY:	R BENJAMIN
		MAINLINE CROSS SECTIONS (2)		SHEET 37	OF 62

