




502+25

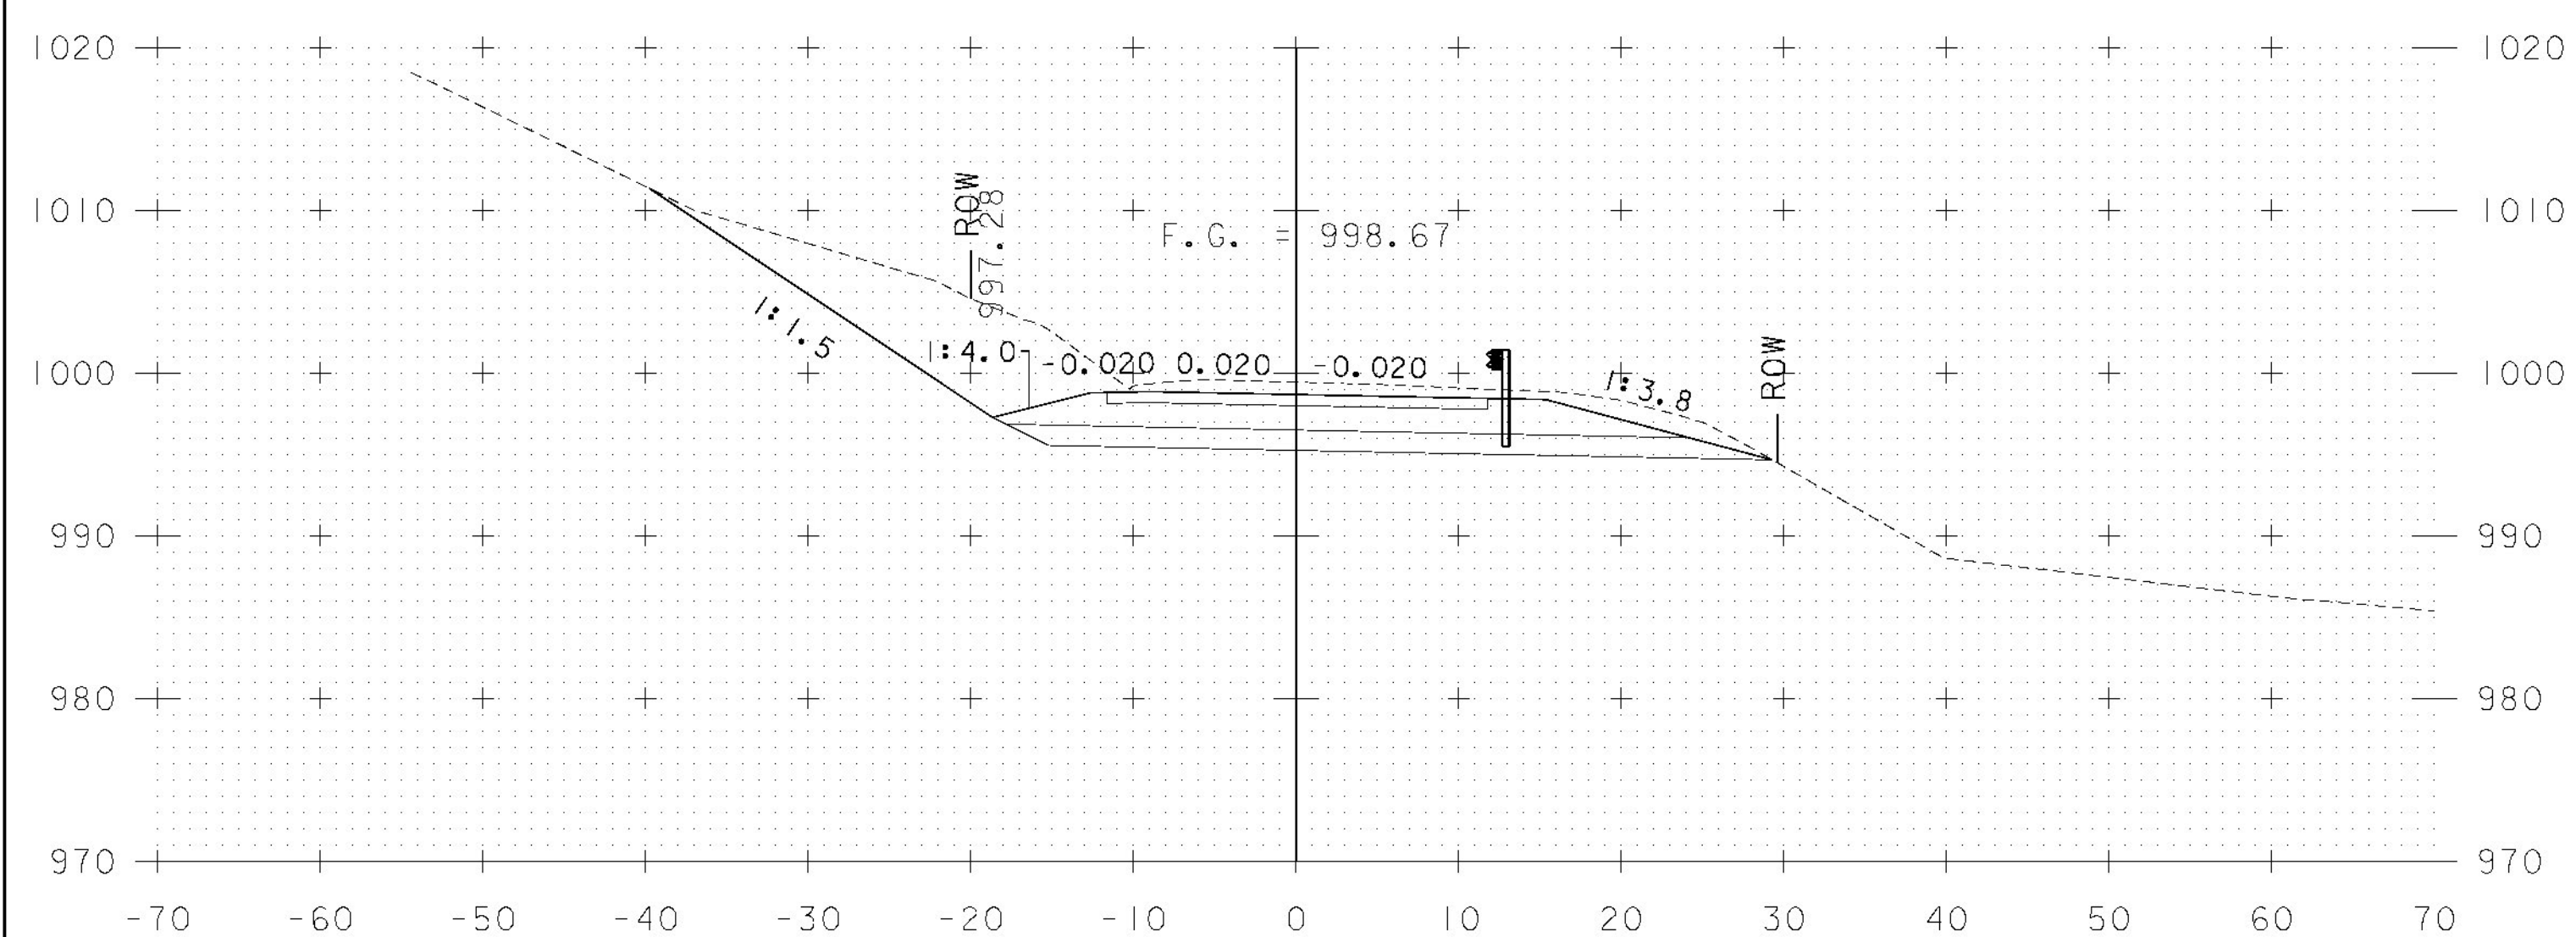

502+00

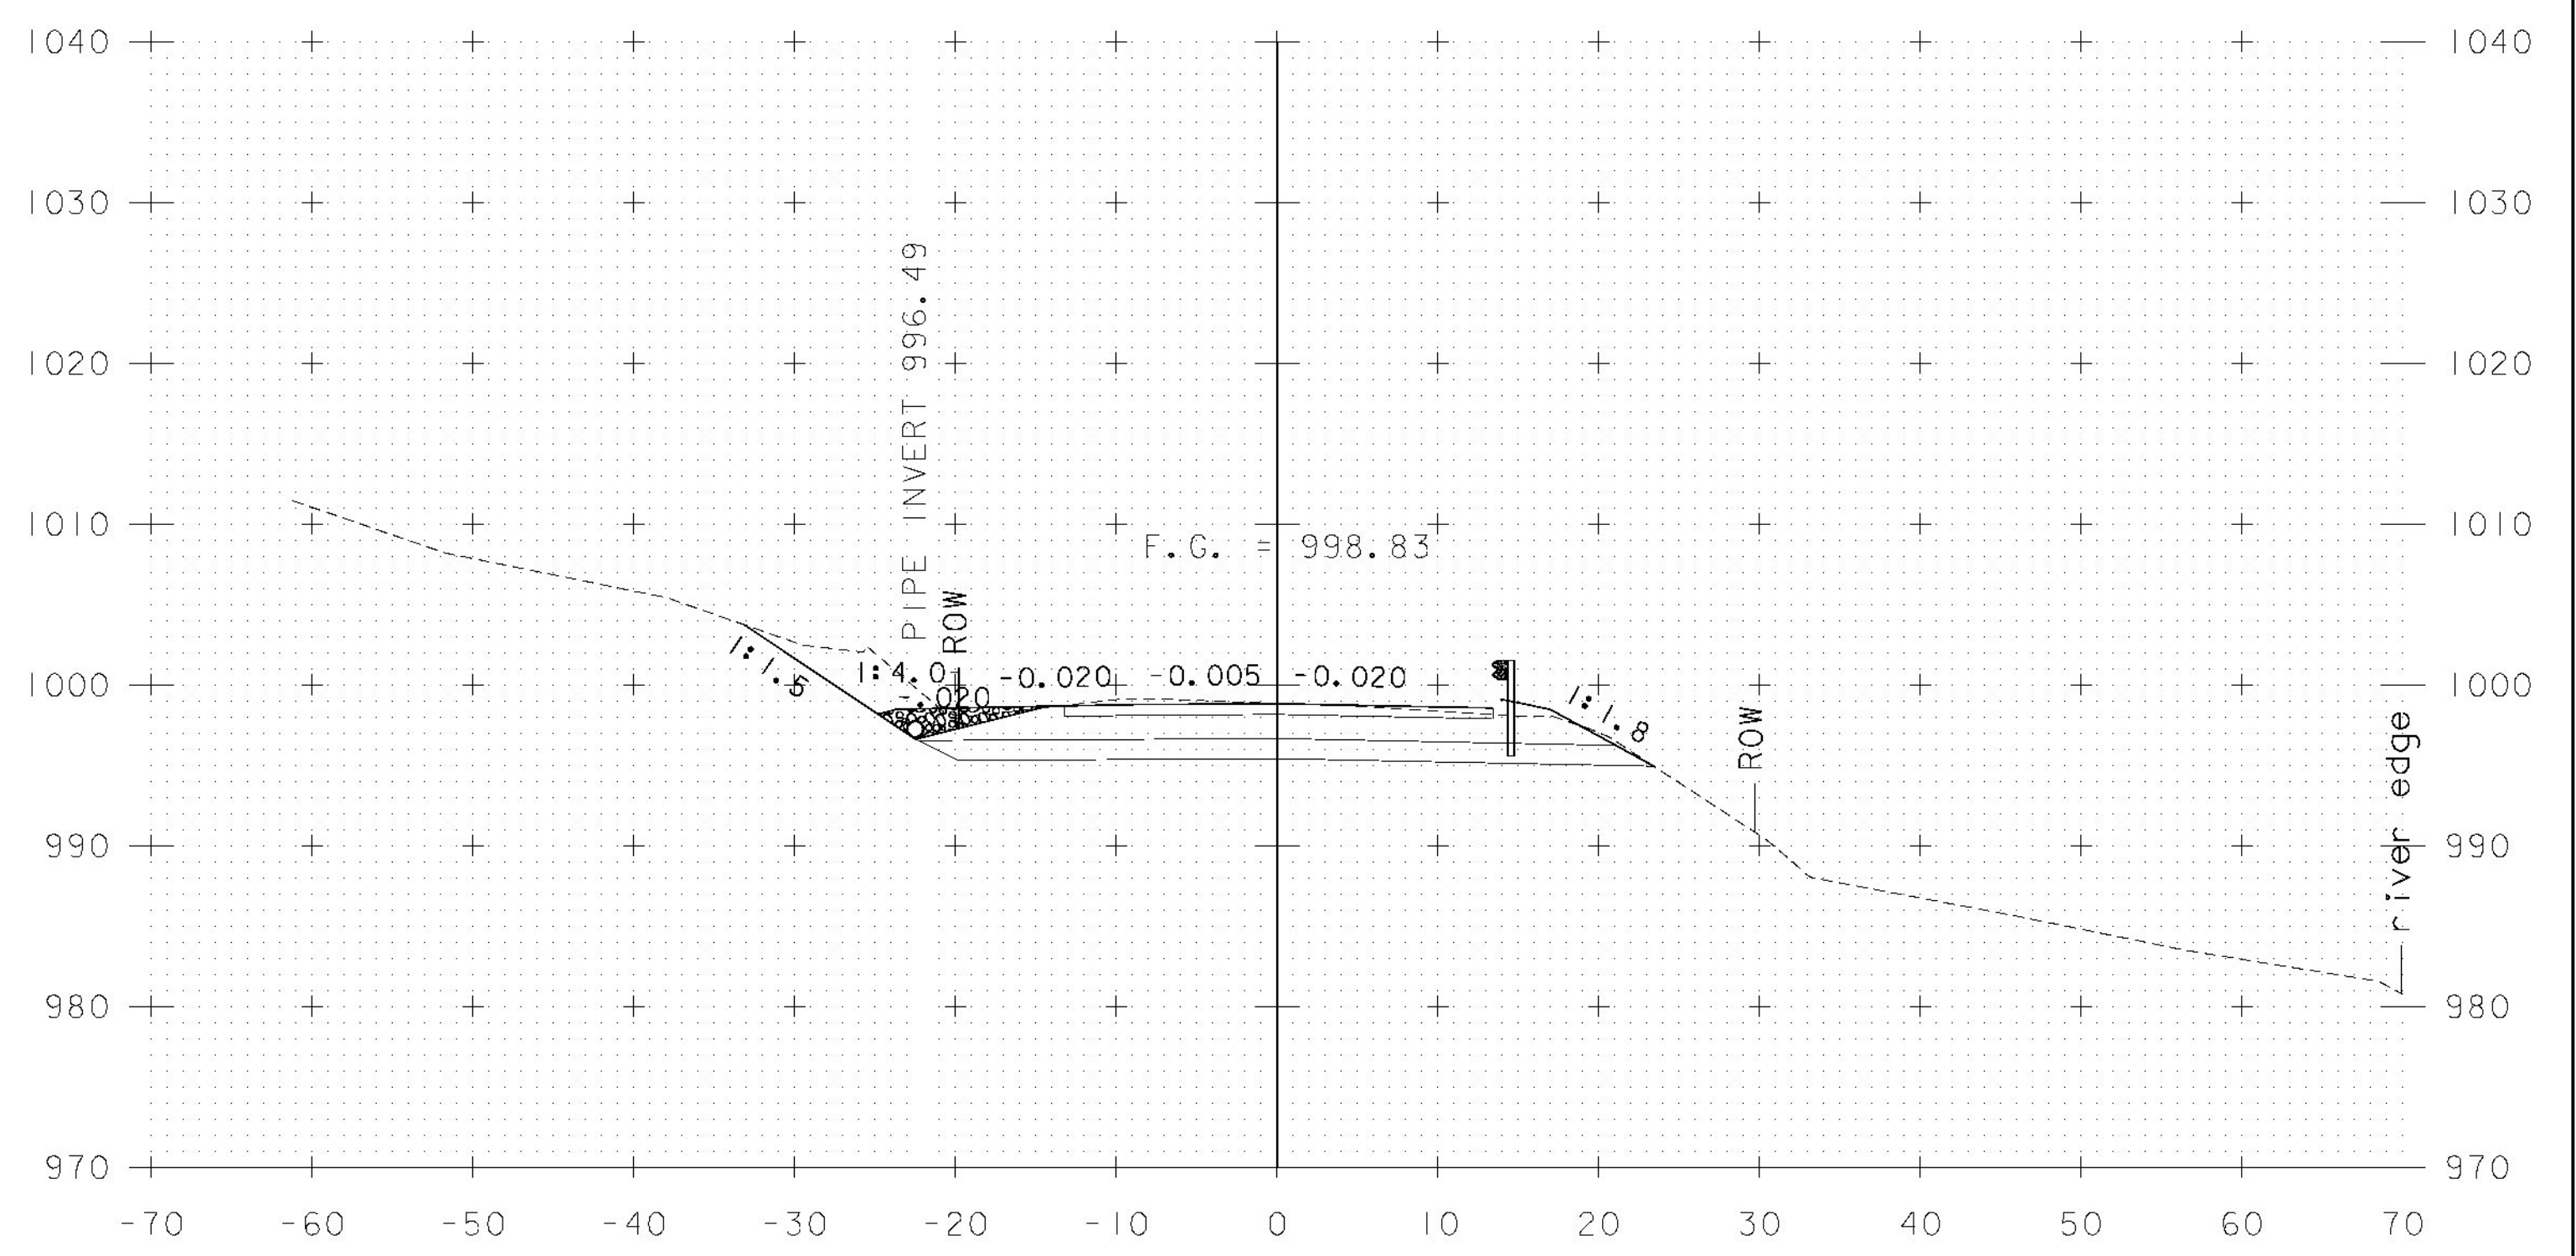

502+75

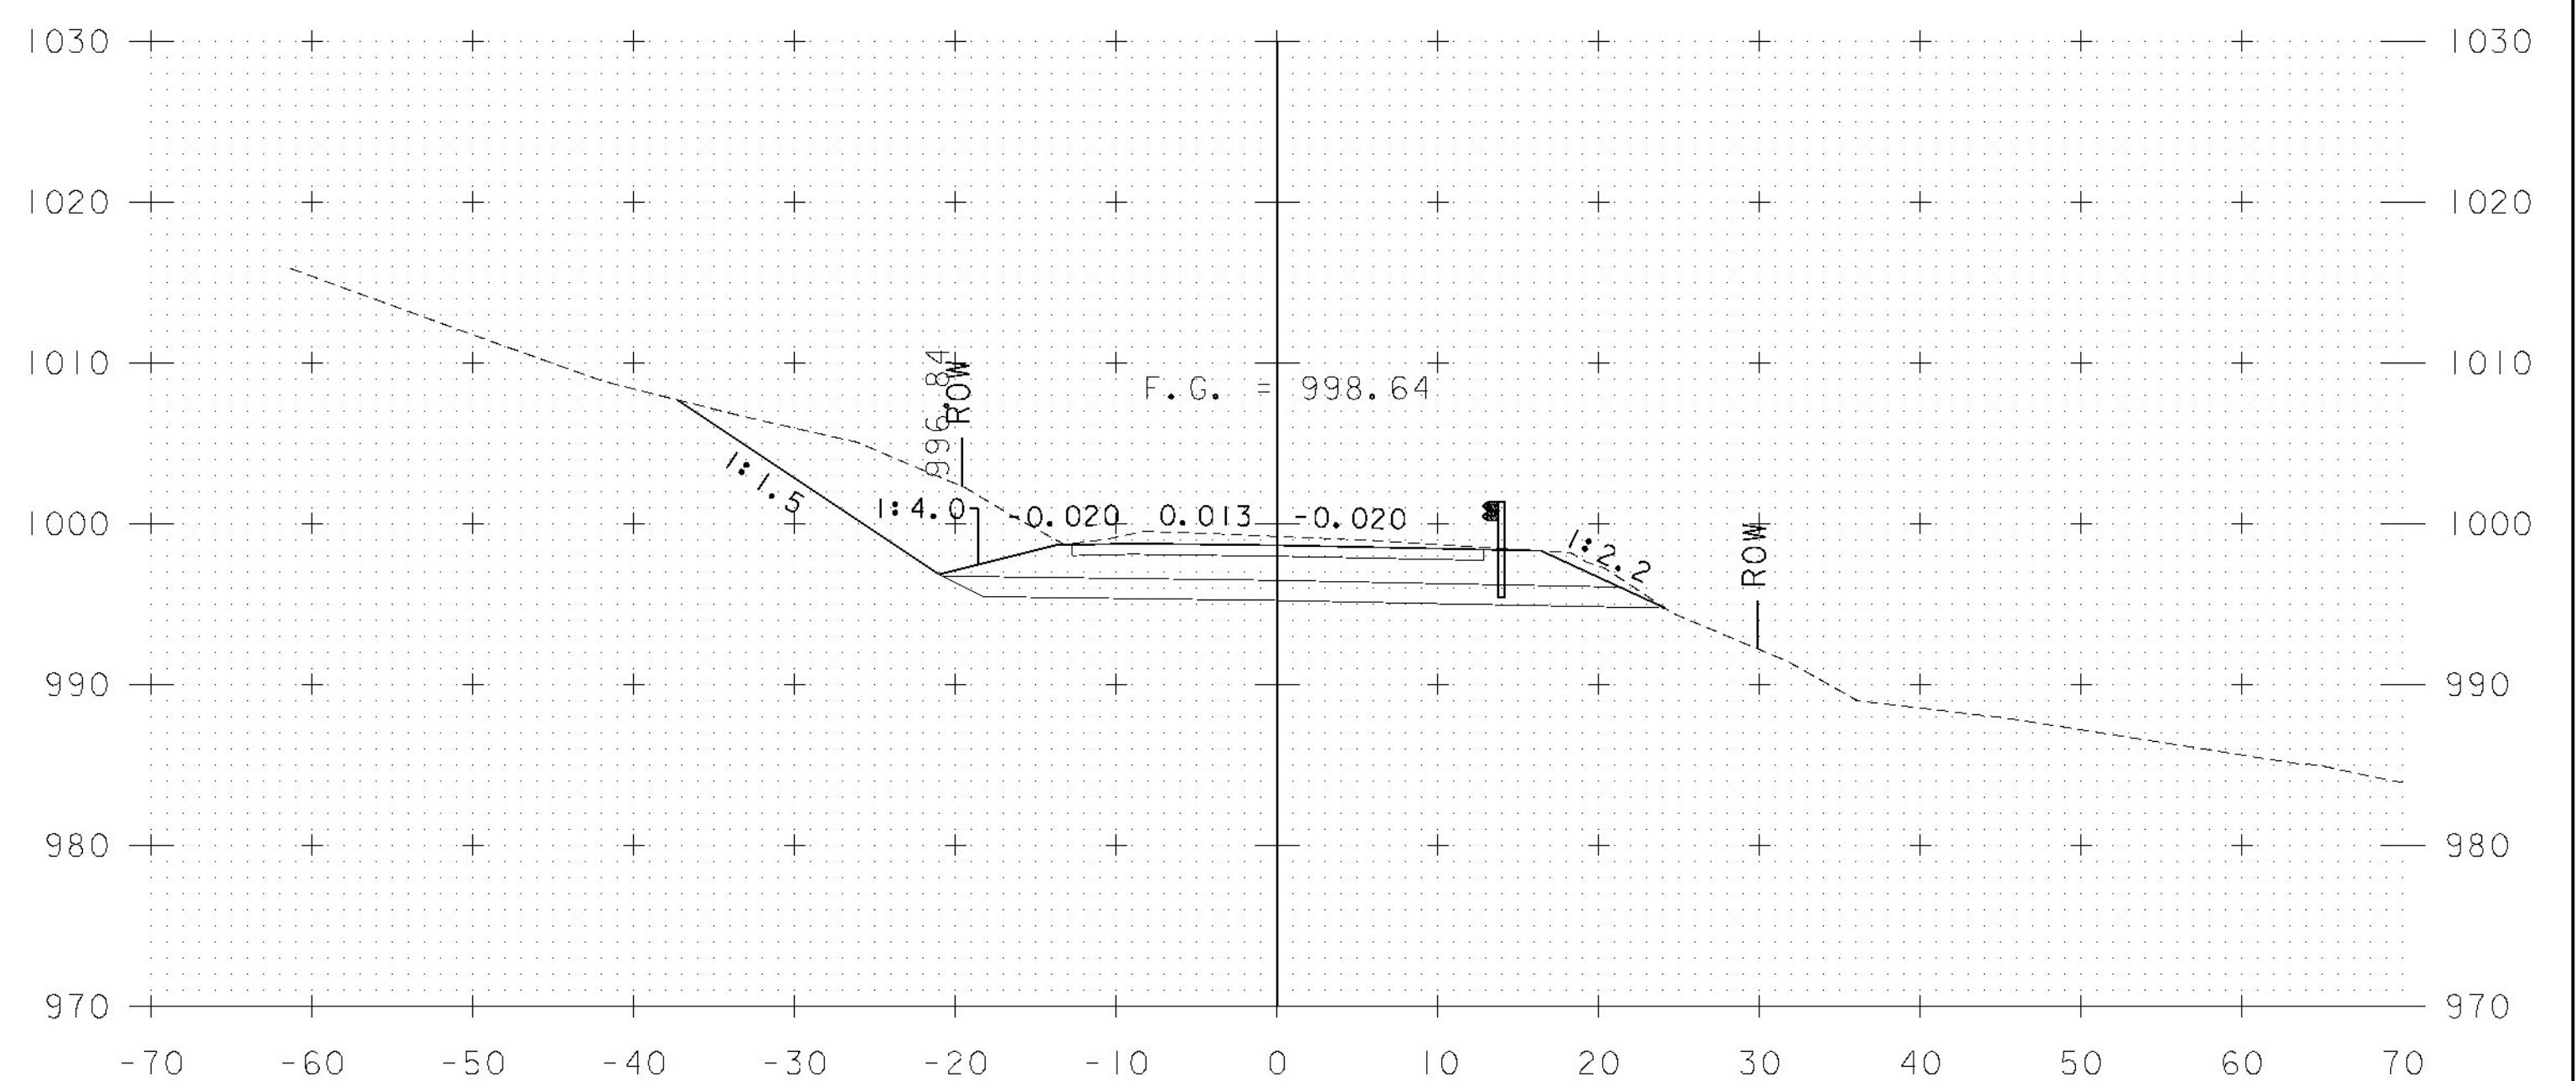

502+50

**MAINLINE CROSS SECTIONS
STA. 502+00 - STA. 502+75**

PROJECT NAME: LINCOLN	PLOT DATE: 8-DEC-2014
PROJECT NUMBER: BRF 0188 (8)	DRAWN BY: C CARNEY
FILE NAME: z10j066xsl.dgn	CHECKED BY: R BENJAMIN
PROJECT LEADER: G.K. DONINGTON	SHEET 38 OF 62
DESIGNED BY: C CARNEY	
MAINLINE CROSS SECTIONS (3)	

