



506+25

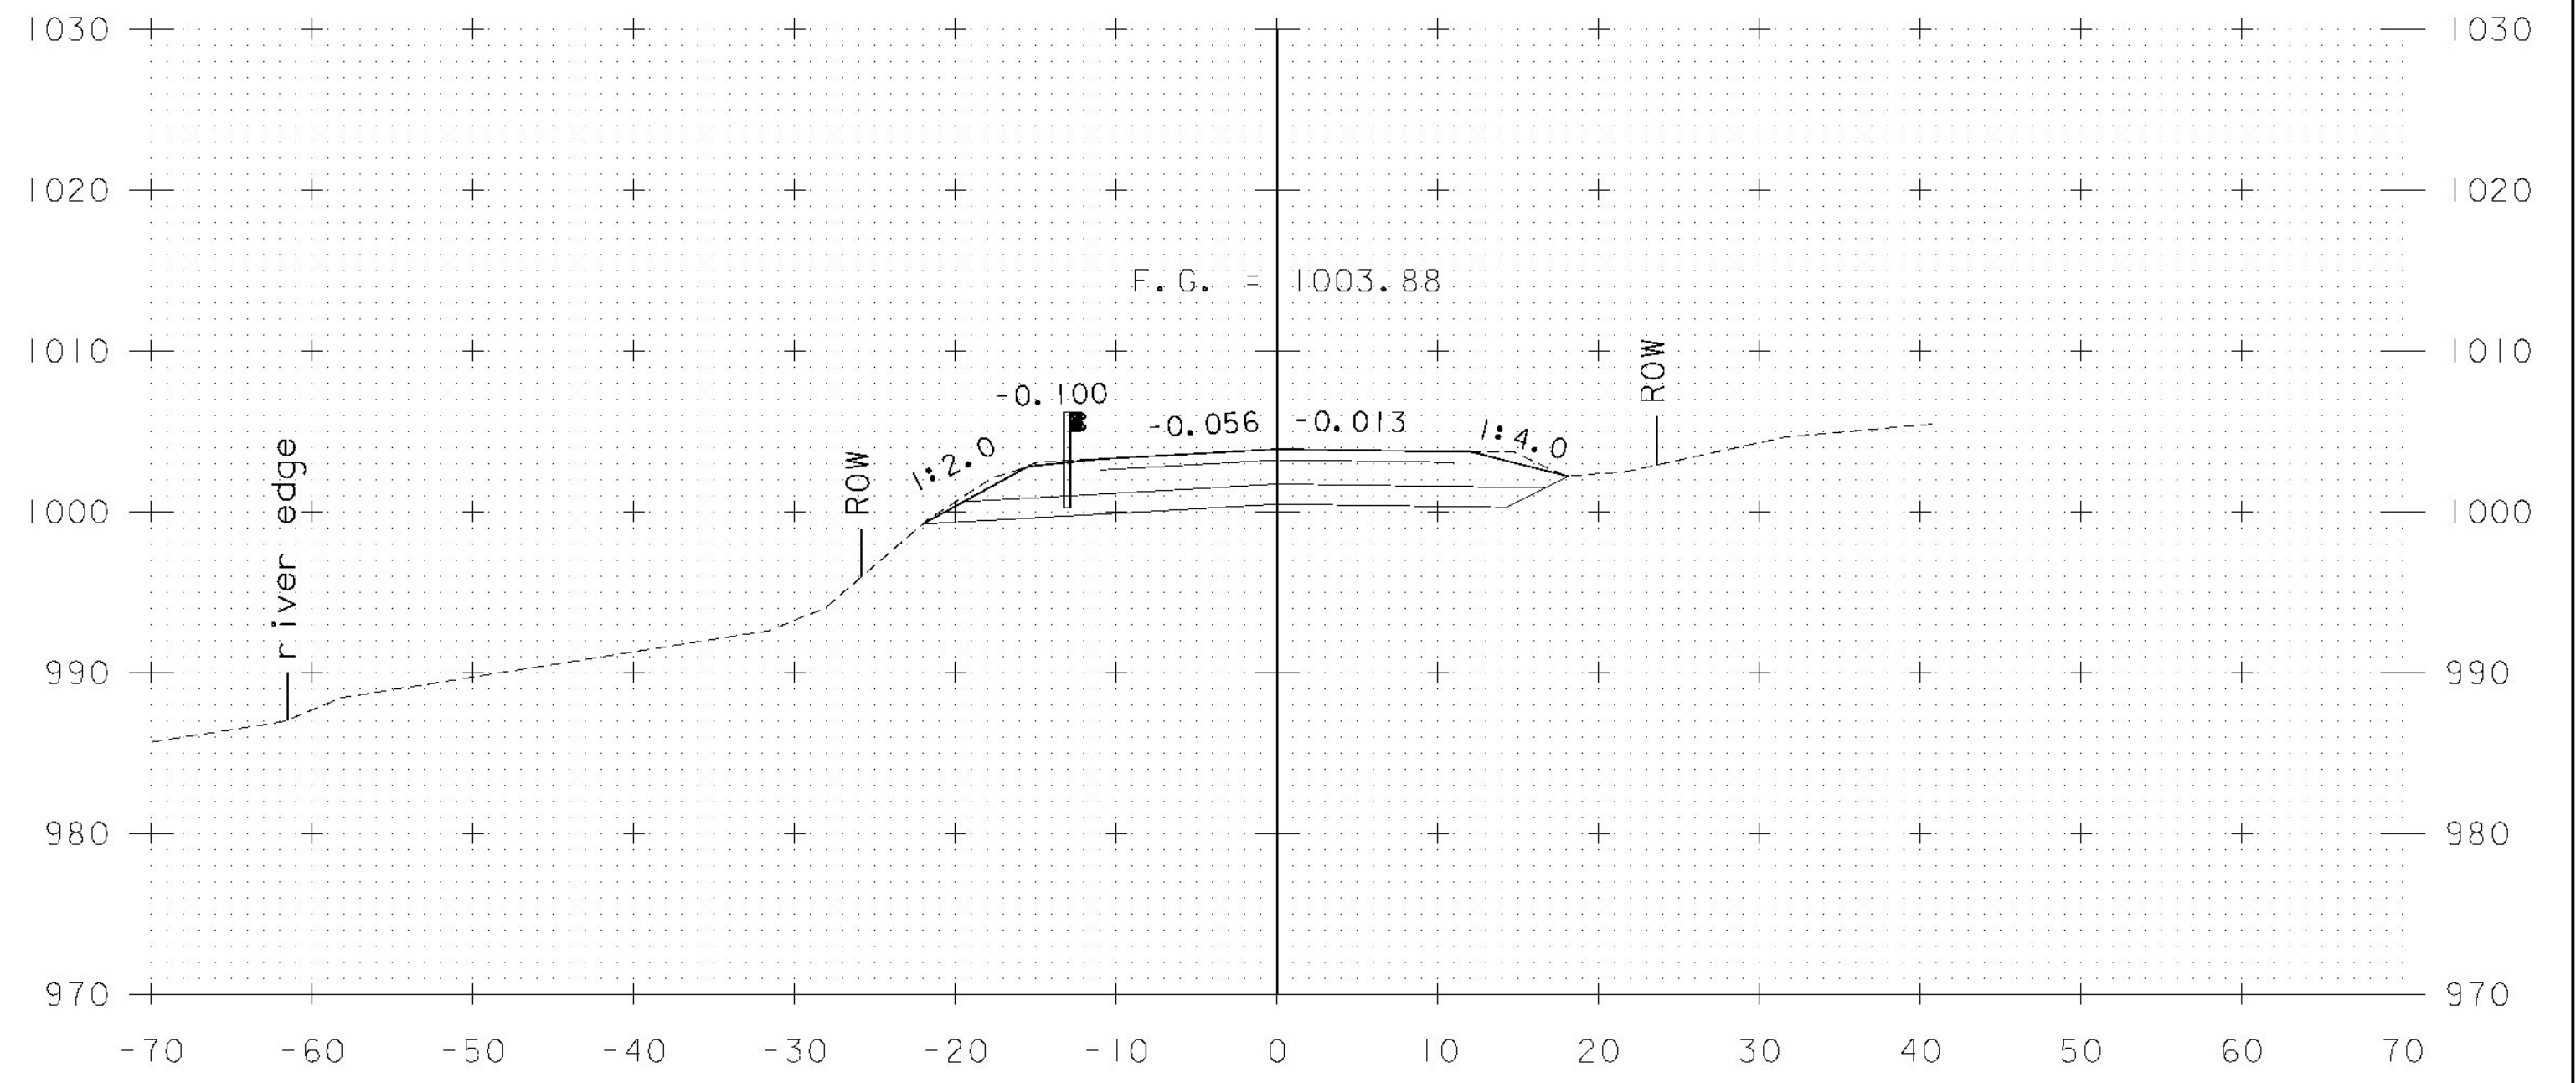


STA 506+75
END PROJECT
BEGIN APPROACH

506+75

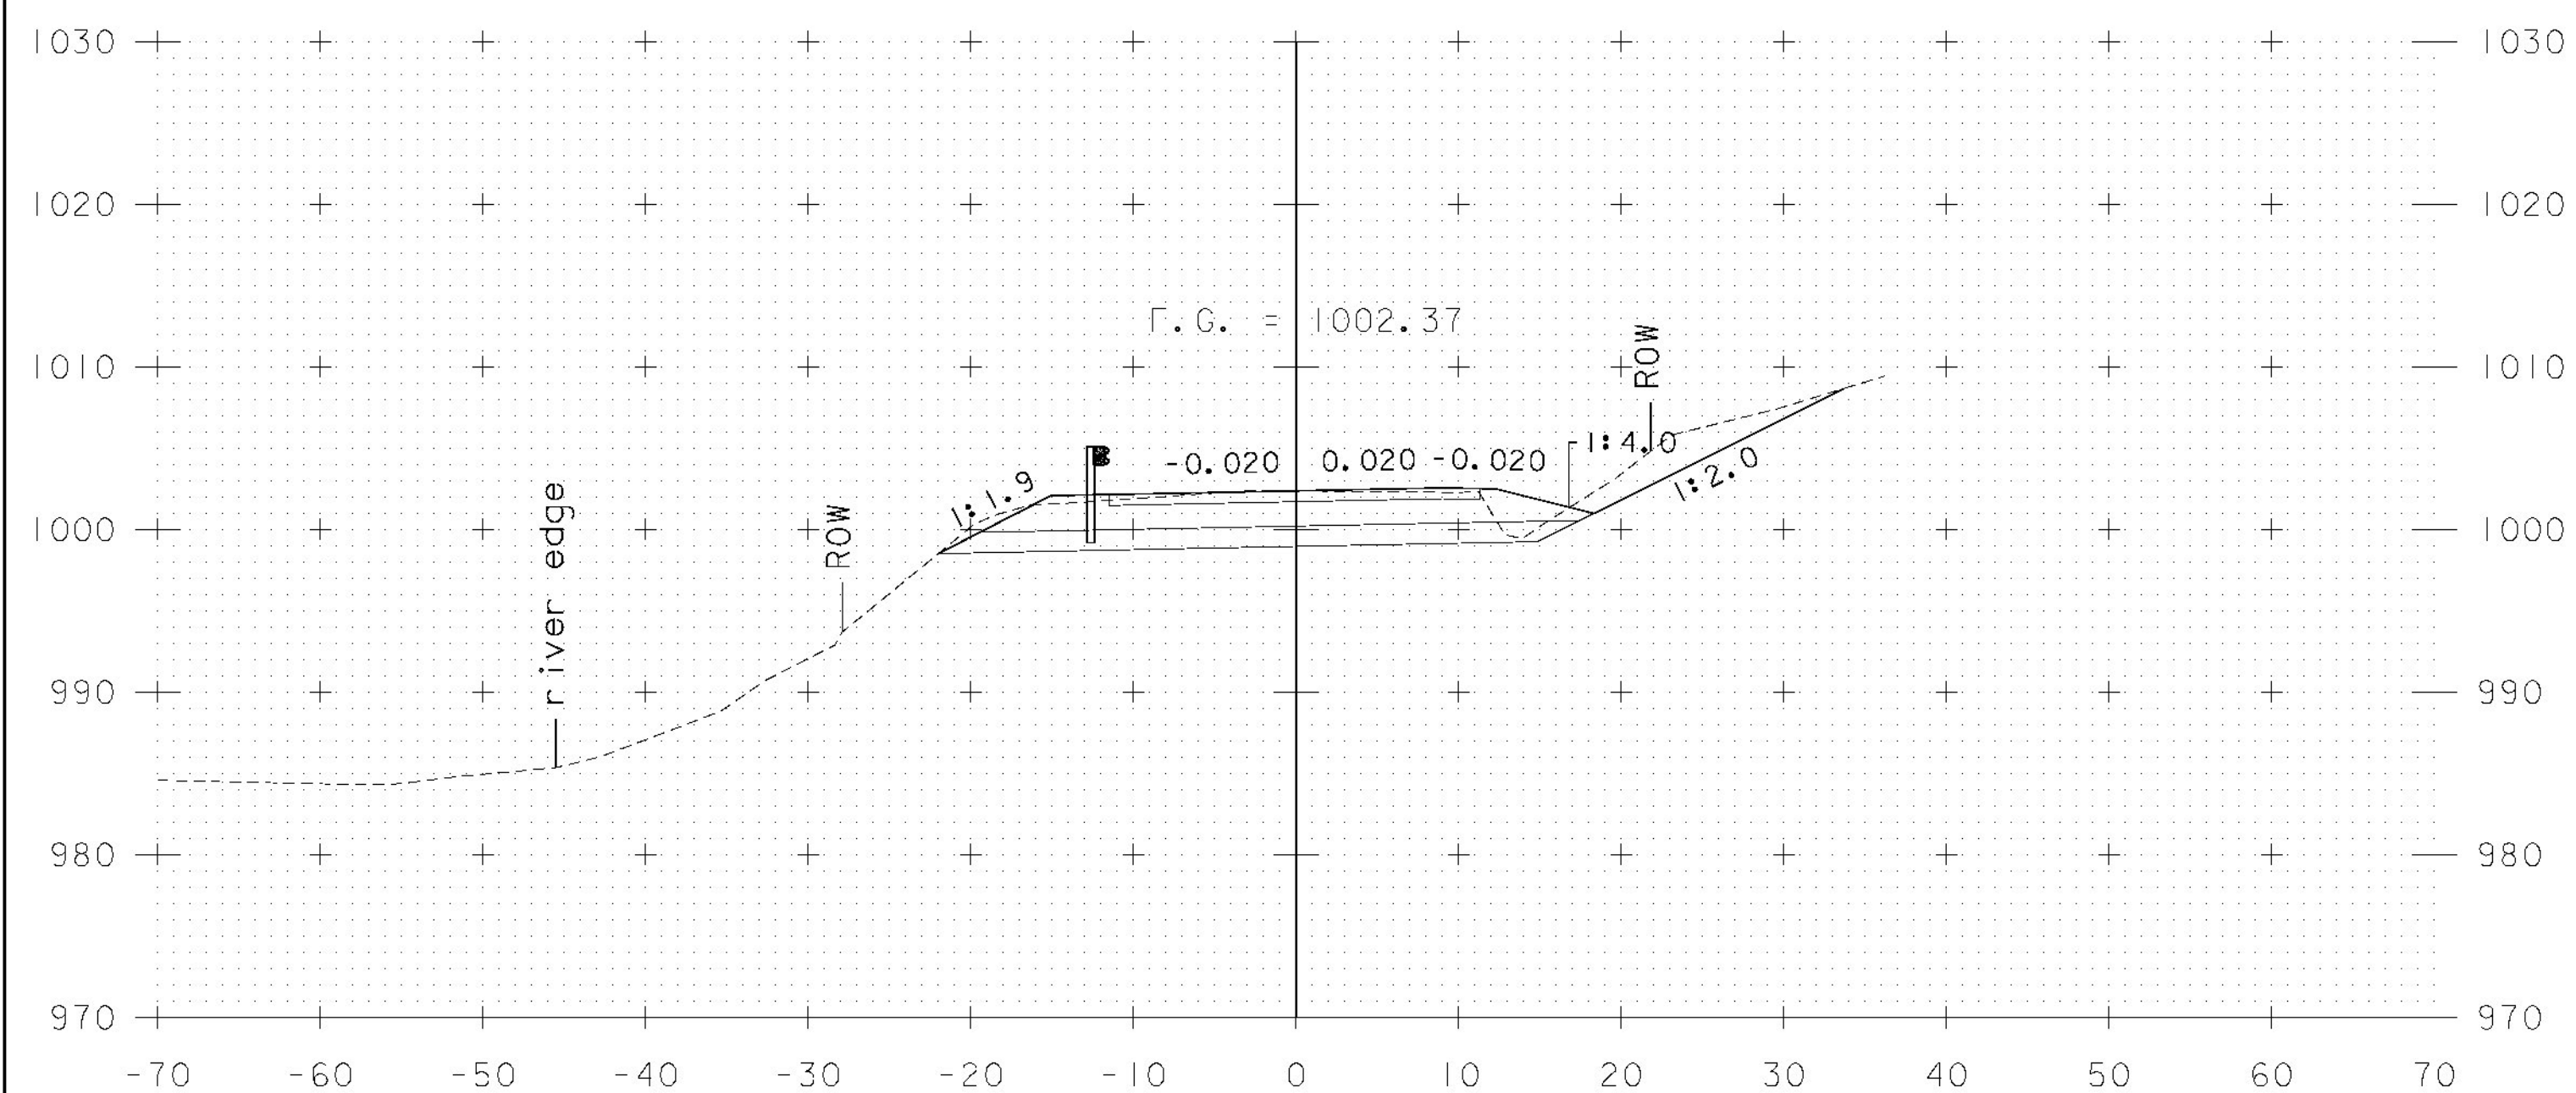

506+00

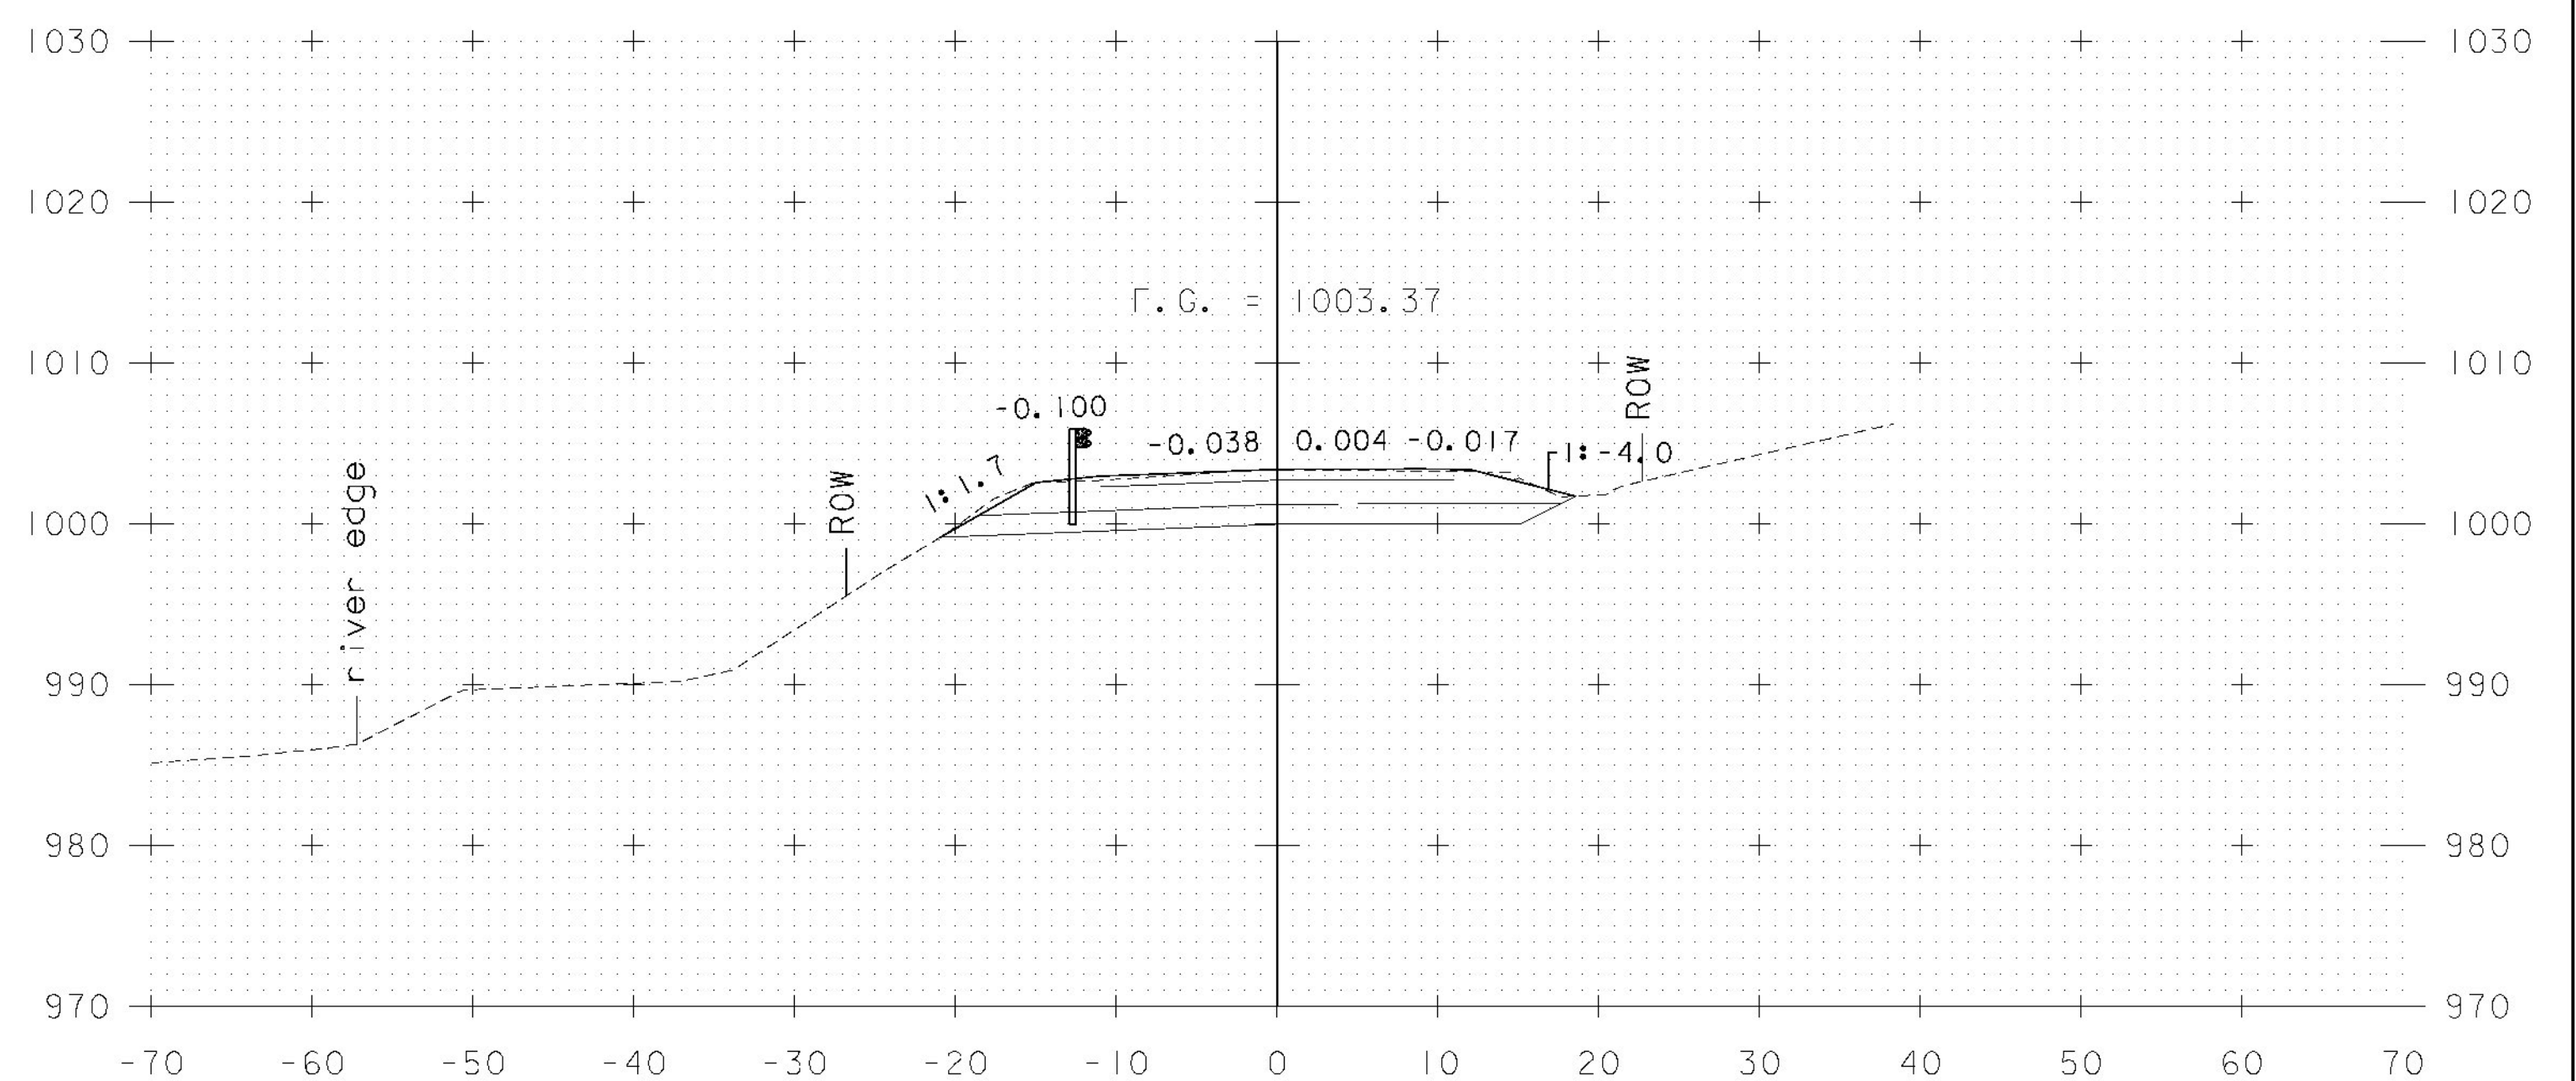

506+50

**MAINLINE CROSS SECTIONS
STA. 506+00 - STA. 506+75**

| | |
|--------------------------------|------------------------|
| PROJECT NAME: LINCOLN | PLOT DATE: 8-DEC-2014 |
| PROJECT NUMBER: BRF 0188 (8) | DRAWN BY: C CARNEY |
| FILE NAME: z10j066xsl.dgn | CHECKED BY: R BENJAMIN |
| PROJECT LEADER: G.K. DONINGTON | SHEET 42 OF 62 |
| DESIGNED BY: C CARNEY | |
| MANCHESTER, NH 03101 | |

