



102+50

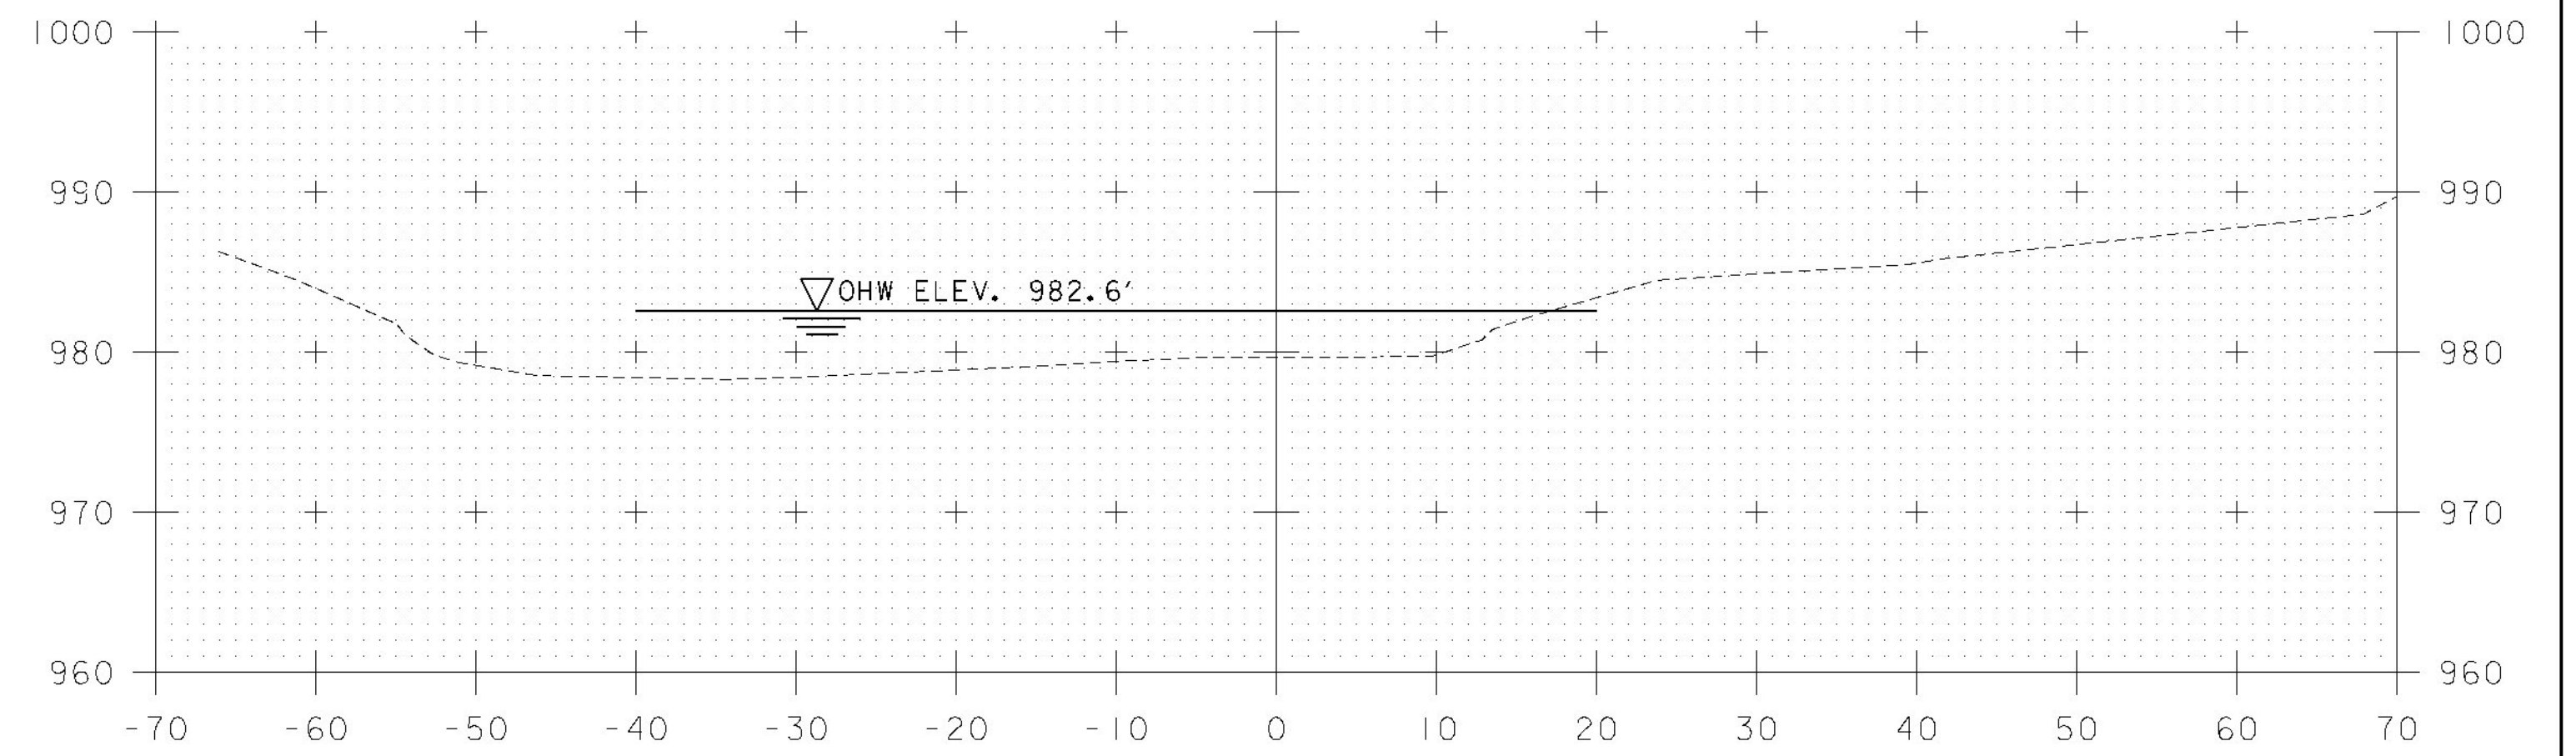


103+00

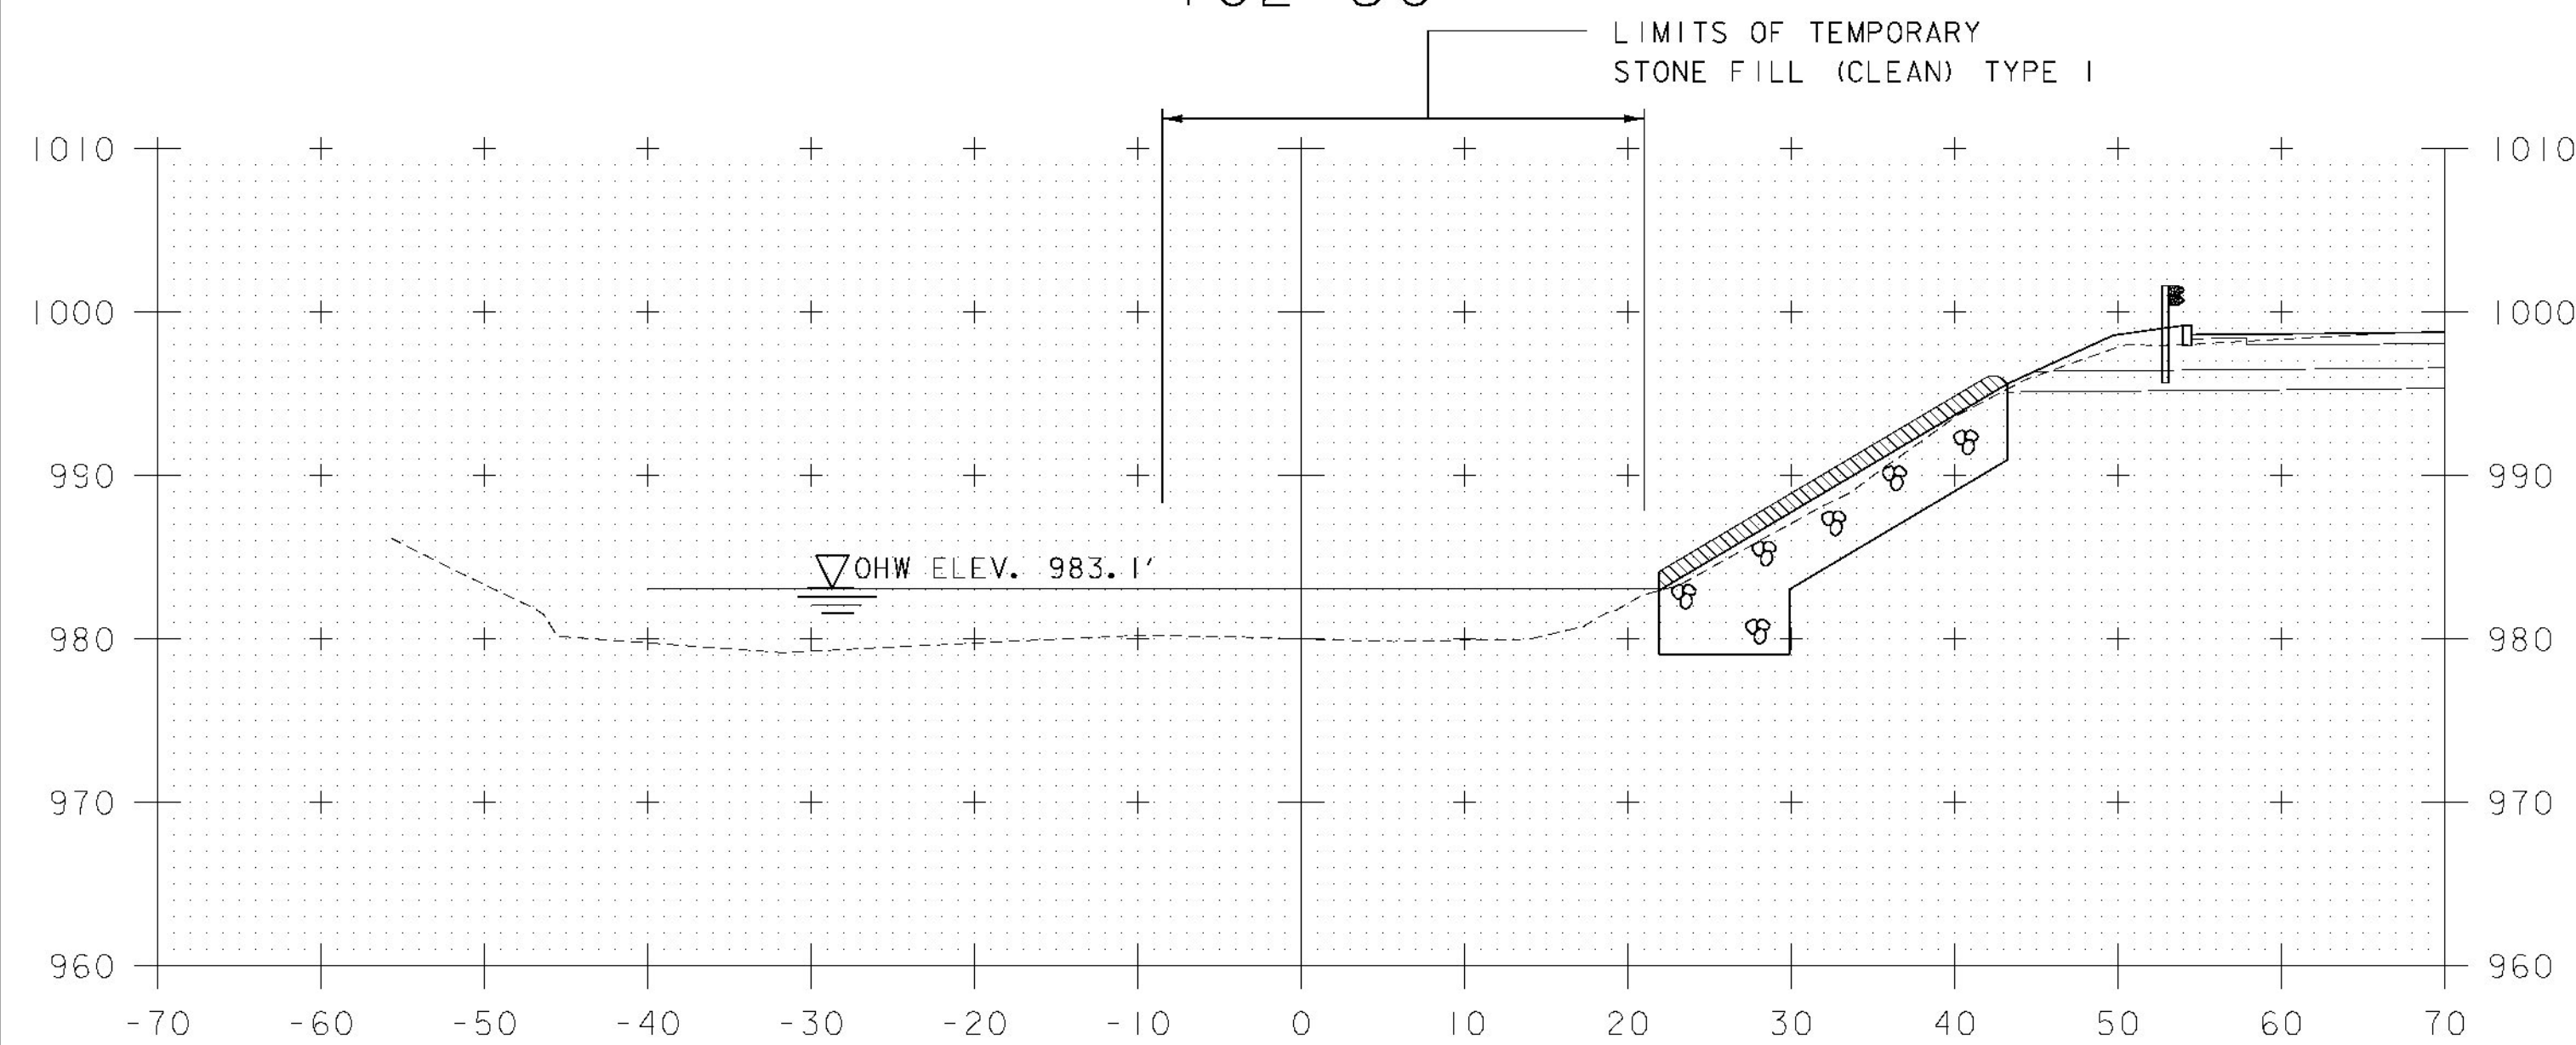

102+25

STA. 102+25 ABUTMENT #1
 END STONE FILL TYPE IV
 GRANULAR BACKFILL
 STRUCTURE EXCAVATION
 GRUBBING MATERIAL
 GEOTEXTILE UNDER STONE FILL

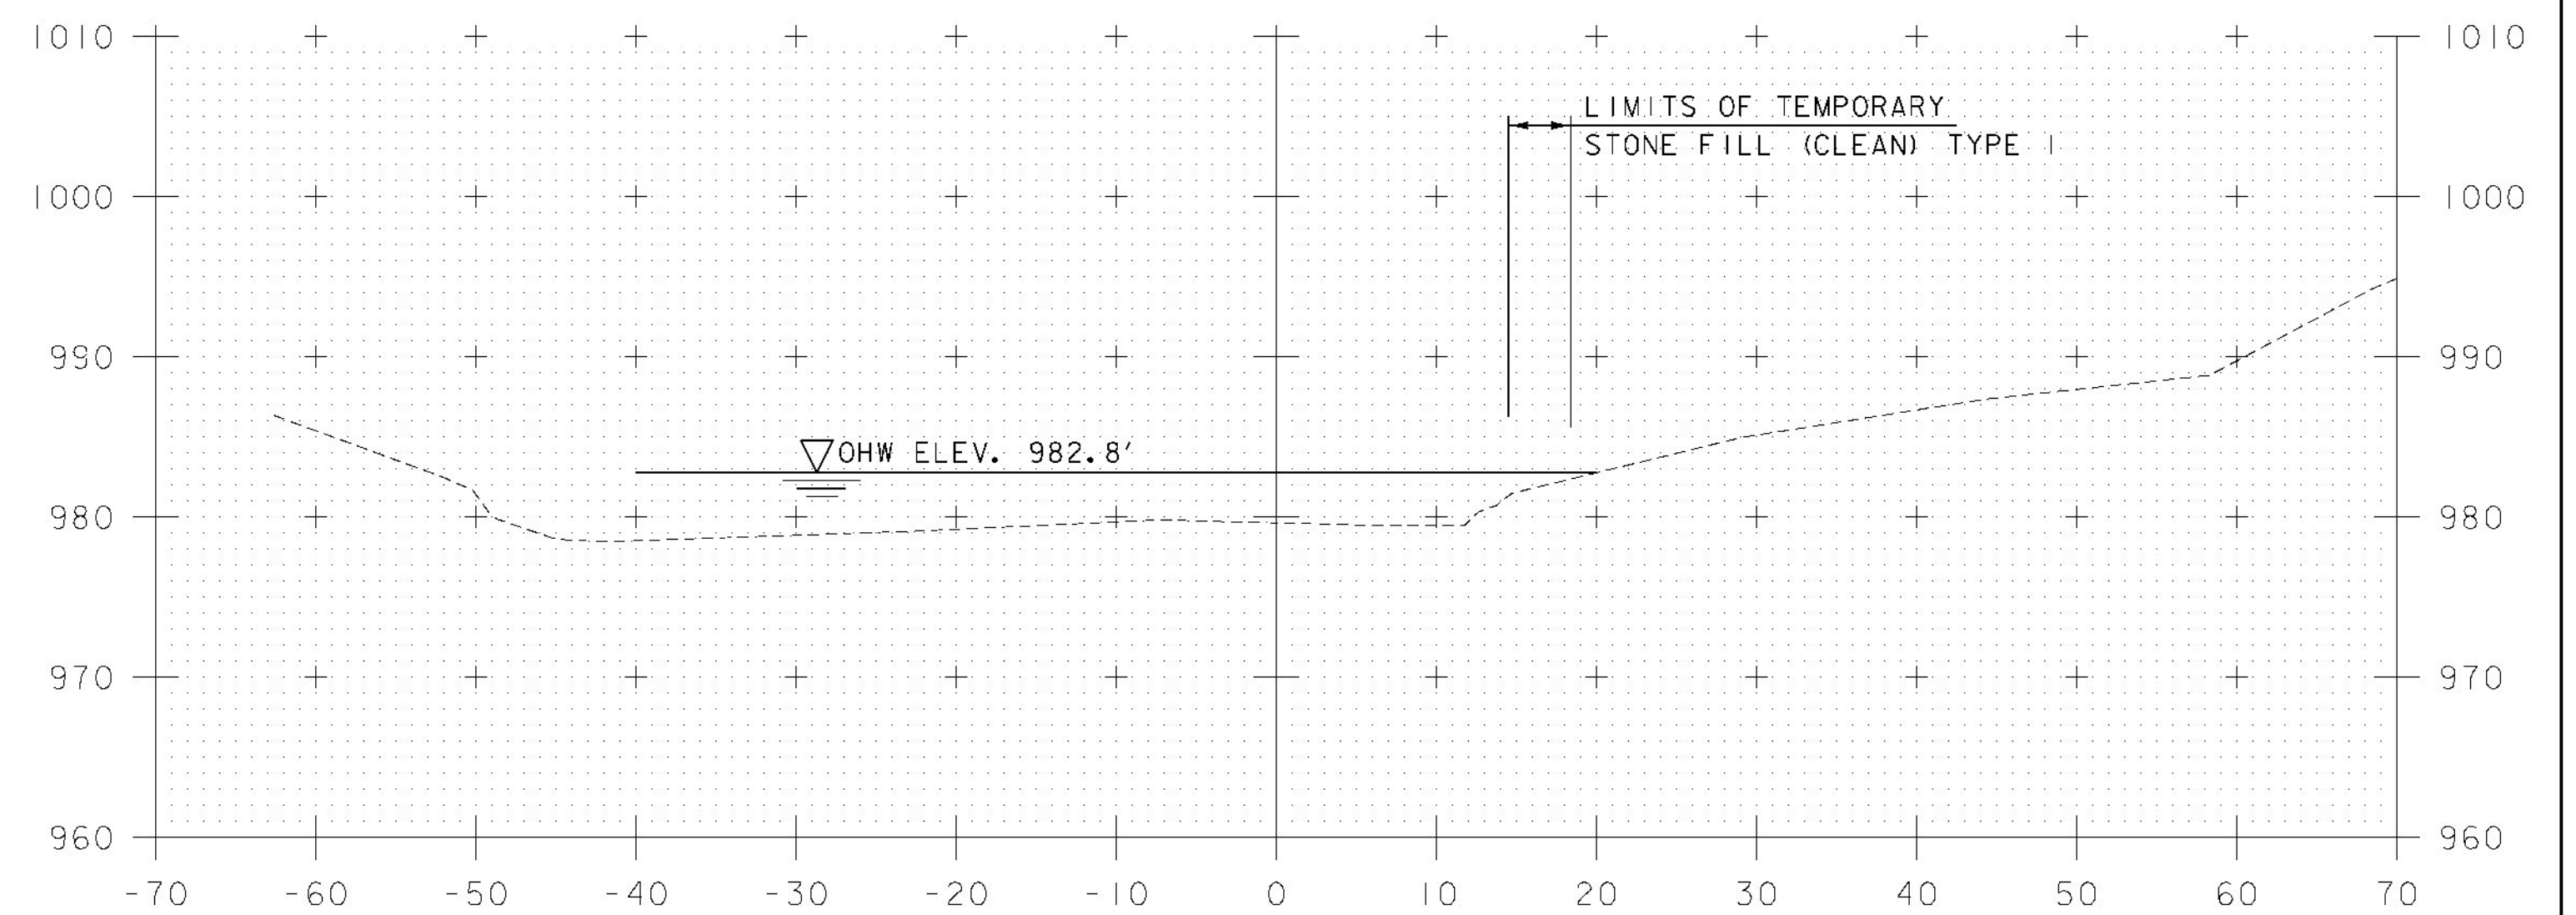

102+75

**CHANNEL CROSS SECTIONS
 STA. 102+25 - STA. 103+00**

PROJECT NAME: LINCOLN	PLOT DATE: 8-DEC-2014
PROJECT NUMBER: BRF 0188 (8)	DRAWN BY: C CARNEY
FILE NAME: z10j066xsl.dgn	CHECKED BY: R BENJAMIN
PROJECT LEADER: G.K. DONINGTON	SHEET 47 OF 62
DESIGNED BY: C CARNEY	
CHANNEL CROSS SECTIONS (3)	