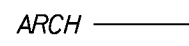
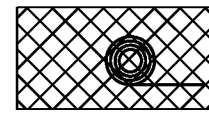
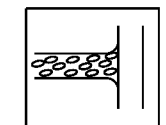

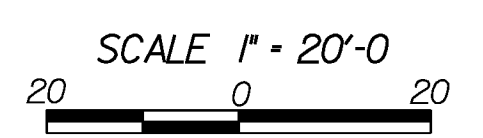


LEGEND	
	ARCHEOLOGICAL AREA
	ROLLED EROSION CONTROL PRODUCT (RECP)
	STABILIZED CONSTRUCTION ENTRANCE
	PIPE INLET PROTECTION

CONTOURS SHOWN ARE EXISTING.
 SEE CROSS SECTIONS FOR PROPOSED GRADING.
 SEE SHEET 6 FOR ADDITIONAL EPSC LEGEND SYMBOLOLOGY.



PROJECT NAME:	LINCOLN
PROJECT NUMBER:	BRF 0188 (8)
FILE NAME:	210J066eobdr.dgn
PROJECT LEADER:	G.K. DONINGTON
DESIGNED BY:	C. CARNEY
EPSC CONSTRUCTION CONDITIONS SITE PLAN (I)	SHEET 51 OF 62
PLOT DATE:	8-DEC-2014
DRAWN BY:	C. CARNEY
CHECKED BY:	R. BENJAMIN