
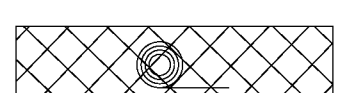
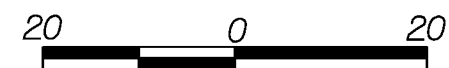
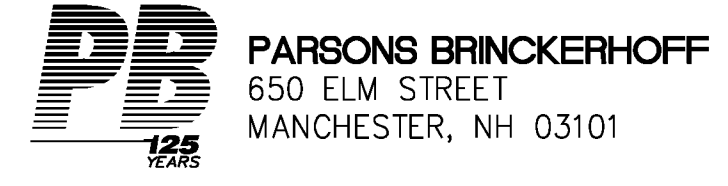


LEGEND	
	DISTURBED AREAS REQUIRING RE-VEGETATION
	EROSION MATTING

CONTOURS SHOWN ARE EXISTING.
 SEE CROSS SECTIONS FOR PROPOSED GRADING.
 SEE SHEET 6 FOR ADDITIONAL EPSC LEGEND SYMBOLGY.

SCALE 1" = 20'-0"




PROJECT NAME:	LINCOLN	FILE NAME:	z10j066sitebdr.dgn	PLOT DATE:	8-DEC-2014
PROJECT NUMBER:	BRF 0188 (8)	PROJECT LEADER:	G.K. DONINGTON	DRAWN BY:	C. CARNEY
		DESIGNED BY:	C. CARNEY	CHECKED BY:	R. BENJAMIN
		EPSC FINAL CONDITIONS SITE PLAN (I)		SHEET 53	OF 62