

File 5.1.2

Contractor:	J.A. McDonald
Job Name:	Lincoln BRF 0188 (8)
Location:	Lincoln, Vt.
Job #	167-15 Date: 6/19/2015



CAMP Precast Concrete Products, Inc.
78 Precast Road, Milton, VT 05468
Phone (802) 893-2401 Fax (802) 893-

Product I.D. DI 506 + 14 **Diameter:** 60"
Invert: No **Ladders:** No **Coating:** No **Access Size:** 24" x 48"
Cast Iron / Hatch: Neenah R-3587-4

Rim:	1001.26	Cone:		Riser#1:		Riser#4:	
Inv. Out:	996.58	Cover:	13" (special)	Riser#2:		Riser#5:	
Diff:	4.68	Base:	3'	Riser#3:		Riser#6:	
Sump:	0.50						
Gross V.F.:	5.18	Angle	0				
C.I. Height:	0.67	Boot:	8029				
Net V.F.:	4.51	Dist. Up:	18" to ctr				
Brick Space:	0.43	Pipe Type:	HDPE				
Actual V.F.:	4.08	Pipe Size:	24"				

Quality Control	Prepour	Form Cleaning: _____	Form Release: _____
		Rein. Steel: Std. Spec.	Form Closure: _____
		Block Out: _____	Rein. Size: _____
		Comments: _____	Q.C. by/date: _____
	Postpour	Finish: _____	Bricking: _____
		Invert: _____	Ladders: _____
		Coating: _____	Boots: _____
		Comments: _____	Q.C. by/date: _____
Special Info. / Comments:		**VT AOT Specs including 8" thick base**	
Mold #:	YDS ³		Wt.


BASE

SUBMITTAL REVIEW

Review is only for general conformity to the contract drawings and specifications and shall not relieve the contractor of his entire responsibility under the contract, including among other things, dimensions to be confirmed and correlated at the job site, and information that pertains to the fabrication processes or to techniques of construction.

NO EXCEPTIONS TAKEN
 MAKE CORRECTIONS NOTED
 RESUBMITTAL NOT REQUIRED
 AMEND AND RESUBMIT
 REJECTED - SEE REMARKS

PB AMERICAS, INC.
 BY: JMR
 DATE: 6/23/15

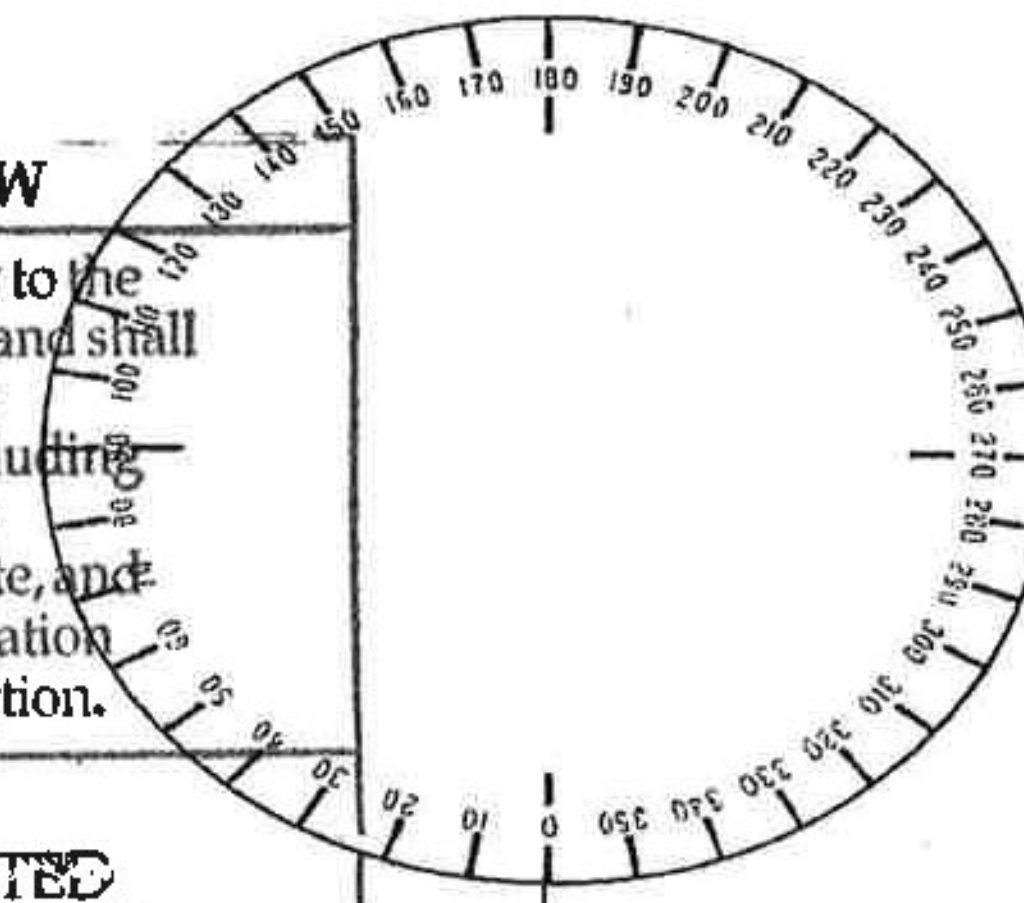

24" HDPE Up 18" To CTR.
 elev. 996.58

Vermont Agency of Transportation

RECEIVED

ON: **June 23, 2015**

and Checked for

CONFORMANCE

BY: Todd A. Sumner DATE: 06/24/2015