

Vermont Agency of Transportation



RECEIVED

ON: June 23, 2015

and Checked for

CONFORMANCE

BY: Todd A. Sumner **DATE:** 06/24/2015

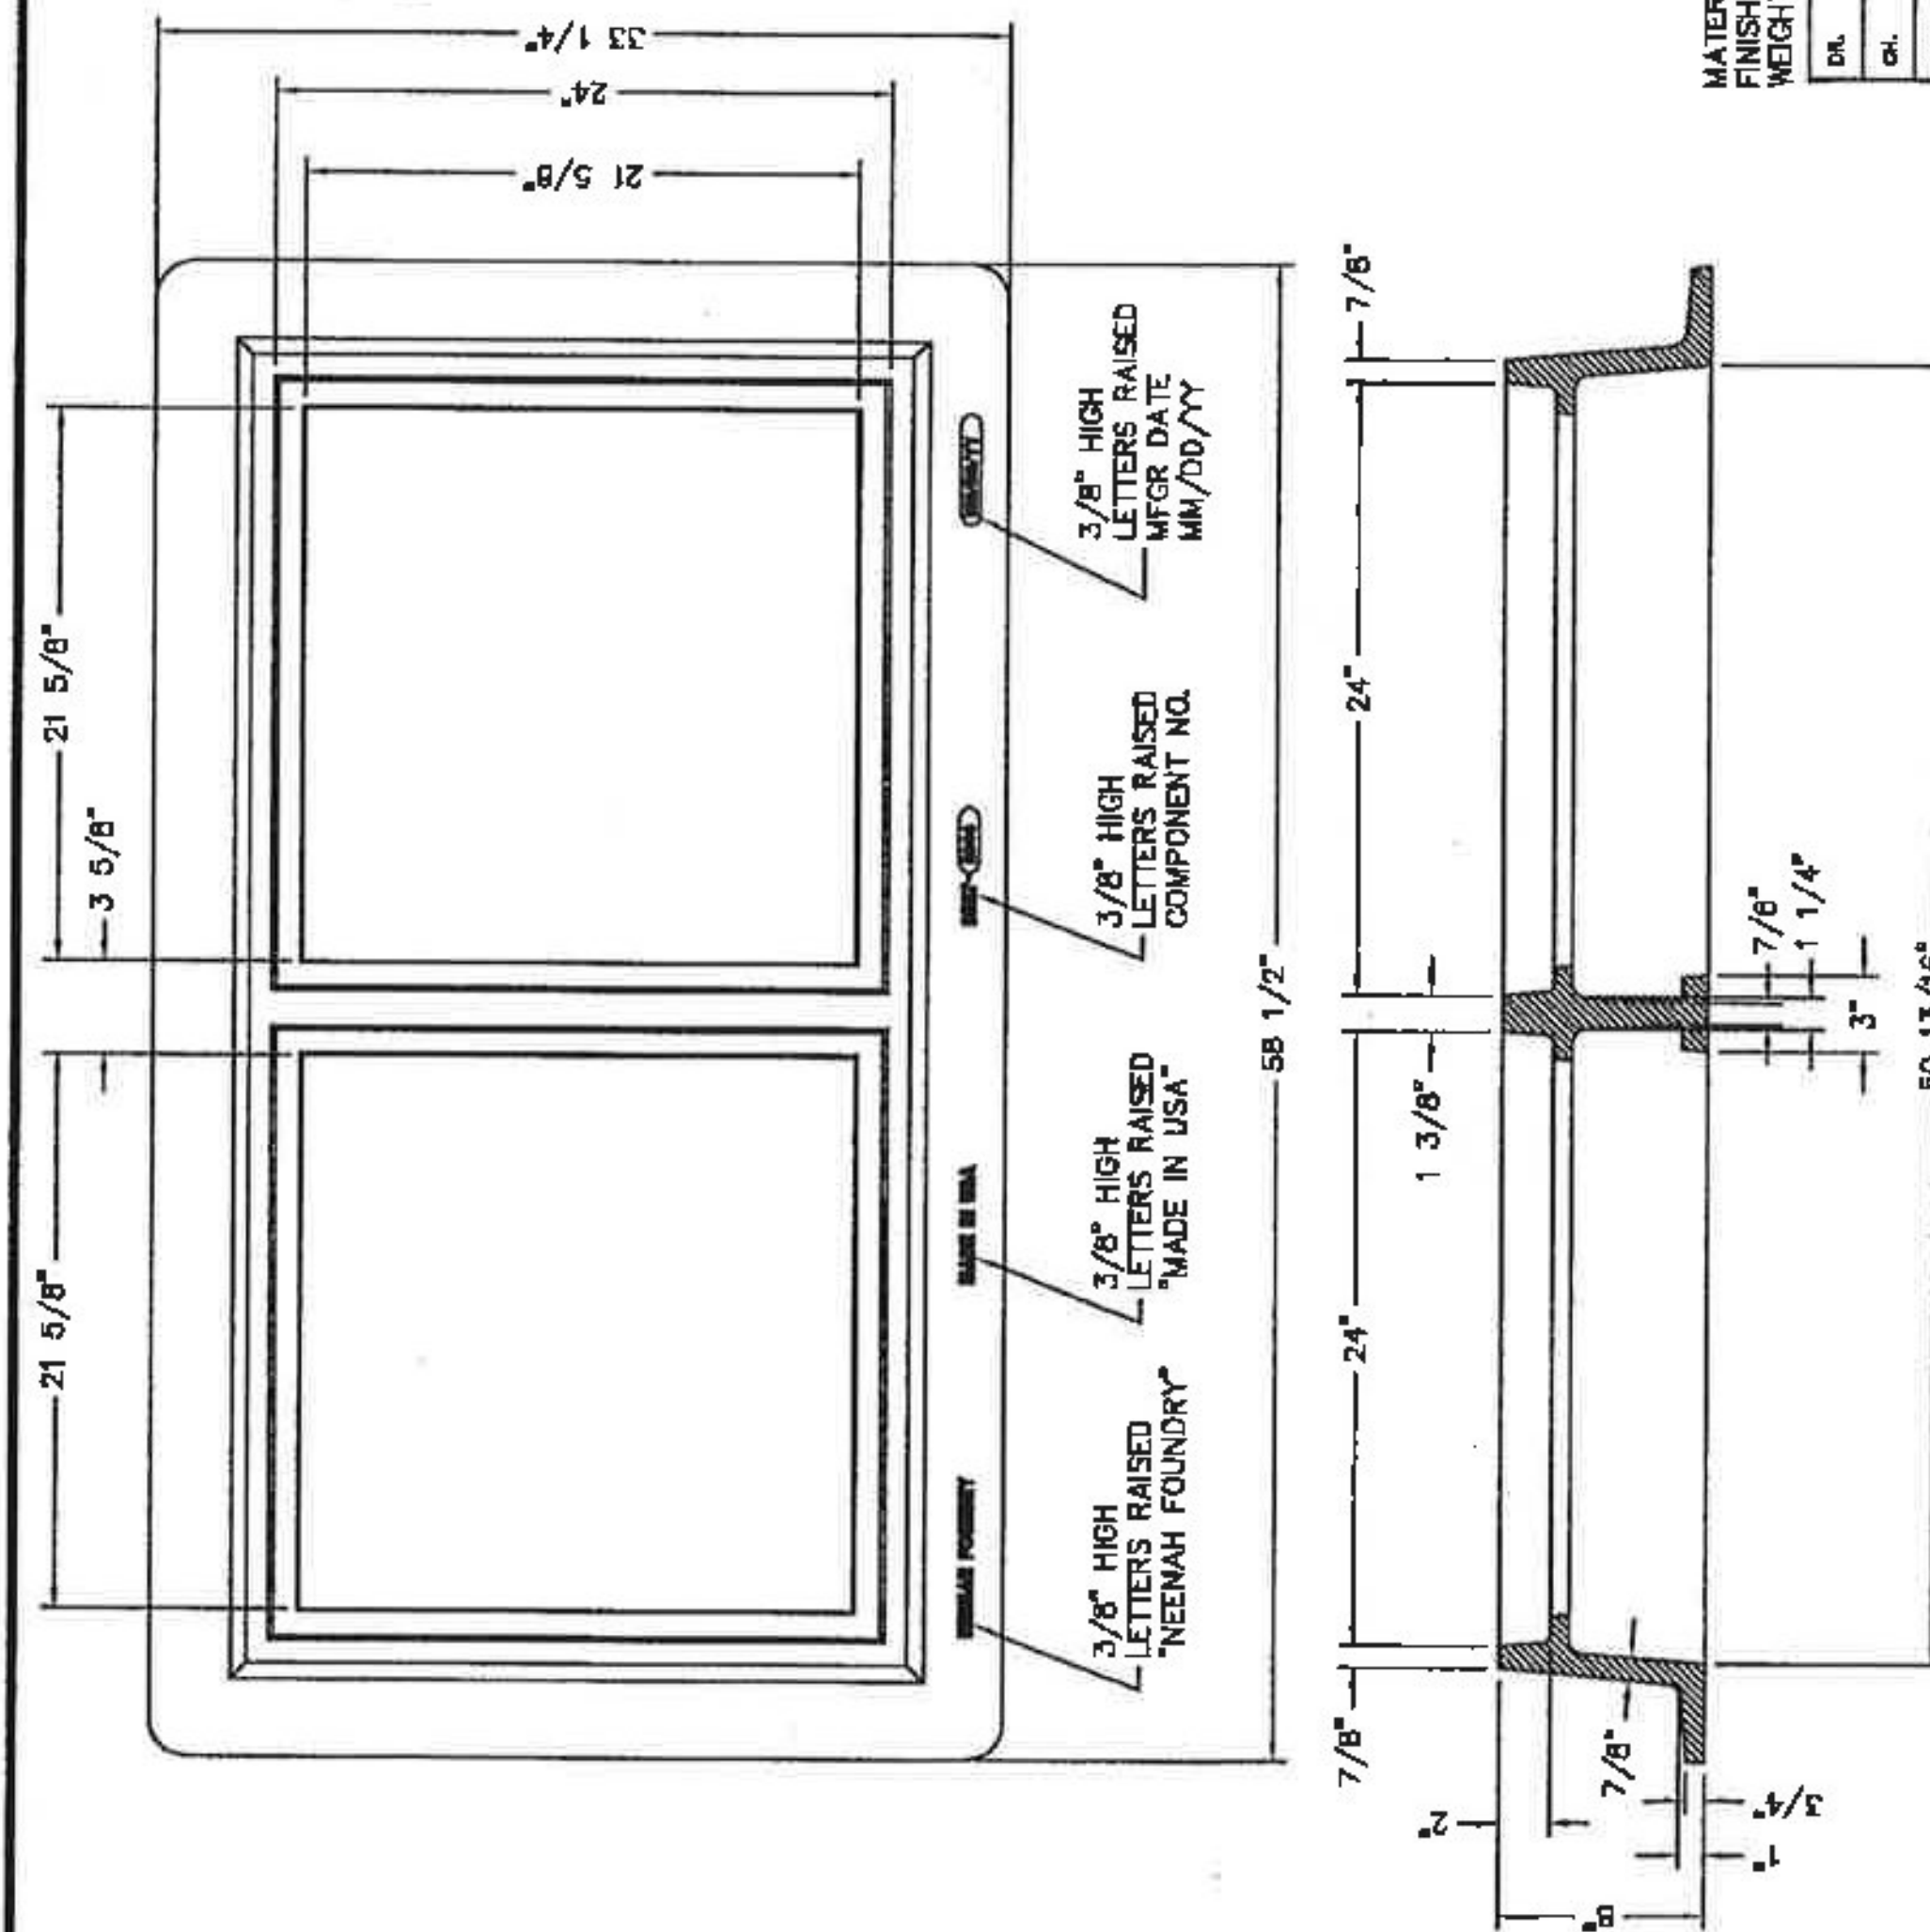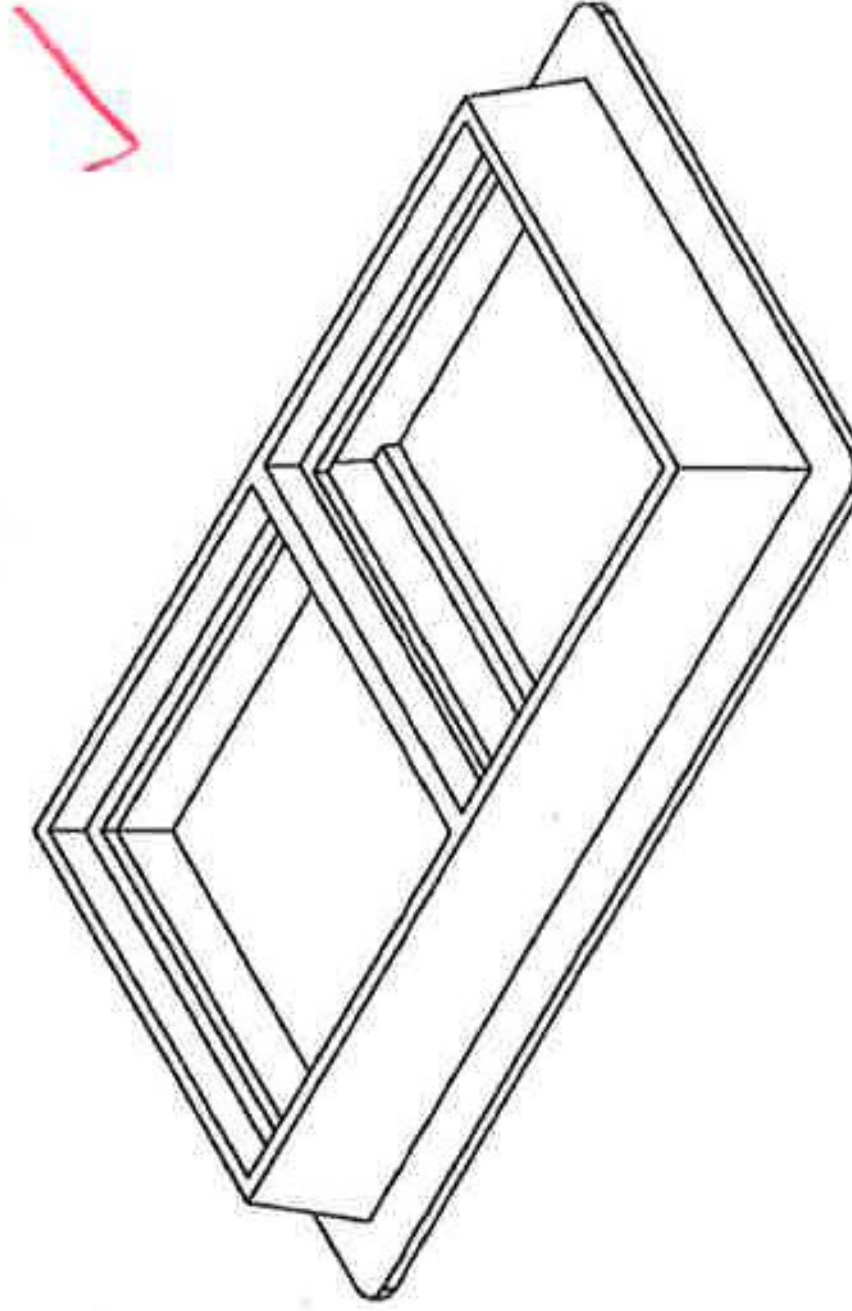

MATERIAL: CAST GRAY IRON ASTM A-48, CLASS 35B
FINISH: NO PAINT UNLESS SPECIFIED ON PURCHASE ORDER
WEIGHT: 516#

WEIGHT: 516#		R-3587 FRAME	
DIL.	RX3	SCALE	1/8"=1'
CH.			
APR.		DATE	12-21-2010
		NEENAH FOUNDRY NEENAH, WISCONSIN 54956	
www.neenahfoundry.com		PHONE: 1-800-558-5075 NF-35872004 B	

CAD DWG. REF: 35872004.DWG-

1

NF-35872004 B