



RECEIVED

ON: June 23, 2015

and Checked for

CONFORMANCE

BY: Todd A. Sumner DATE: 06/24/2015

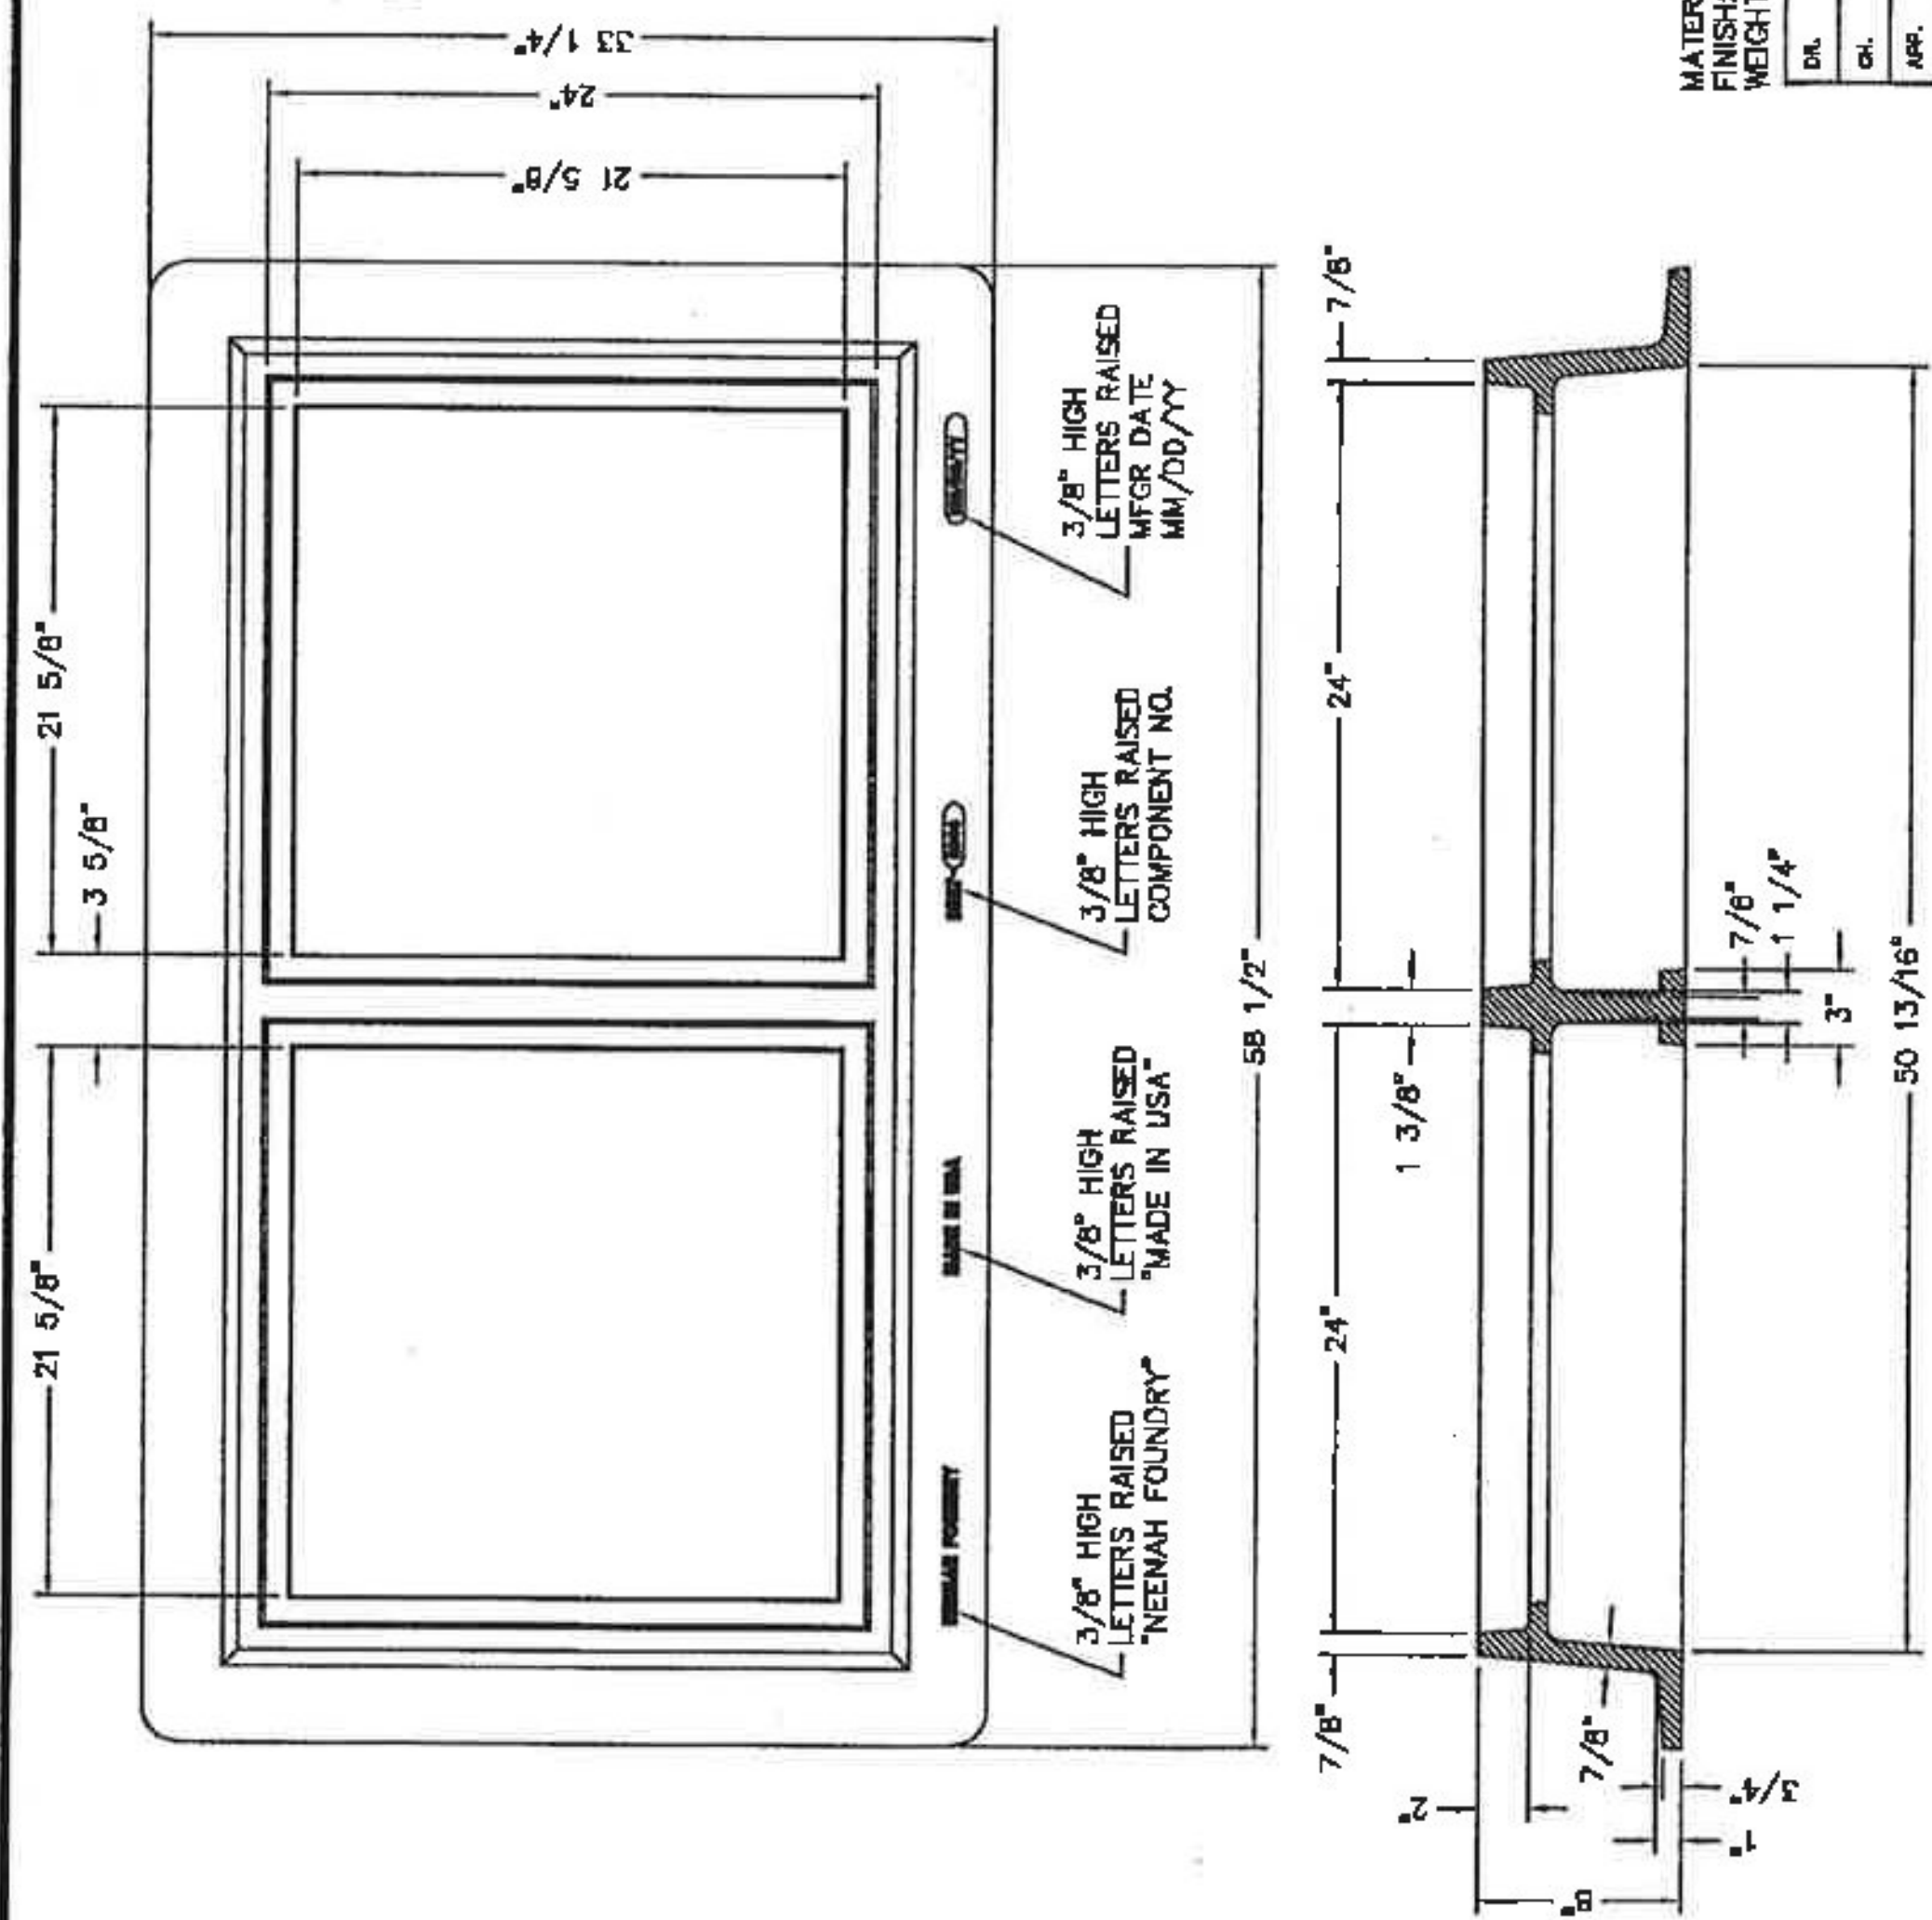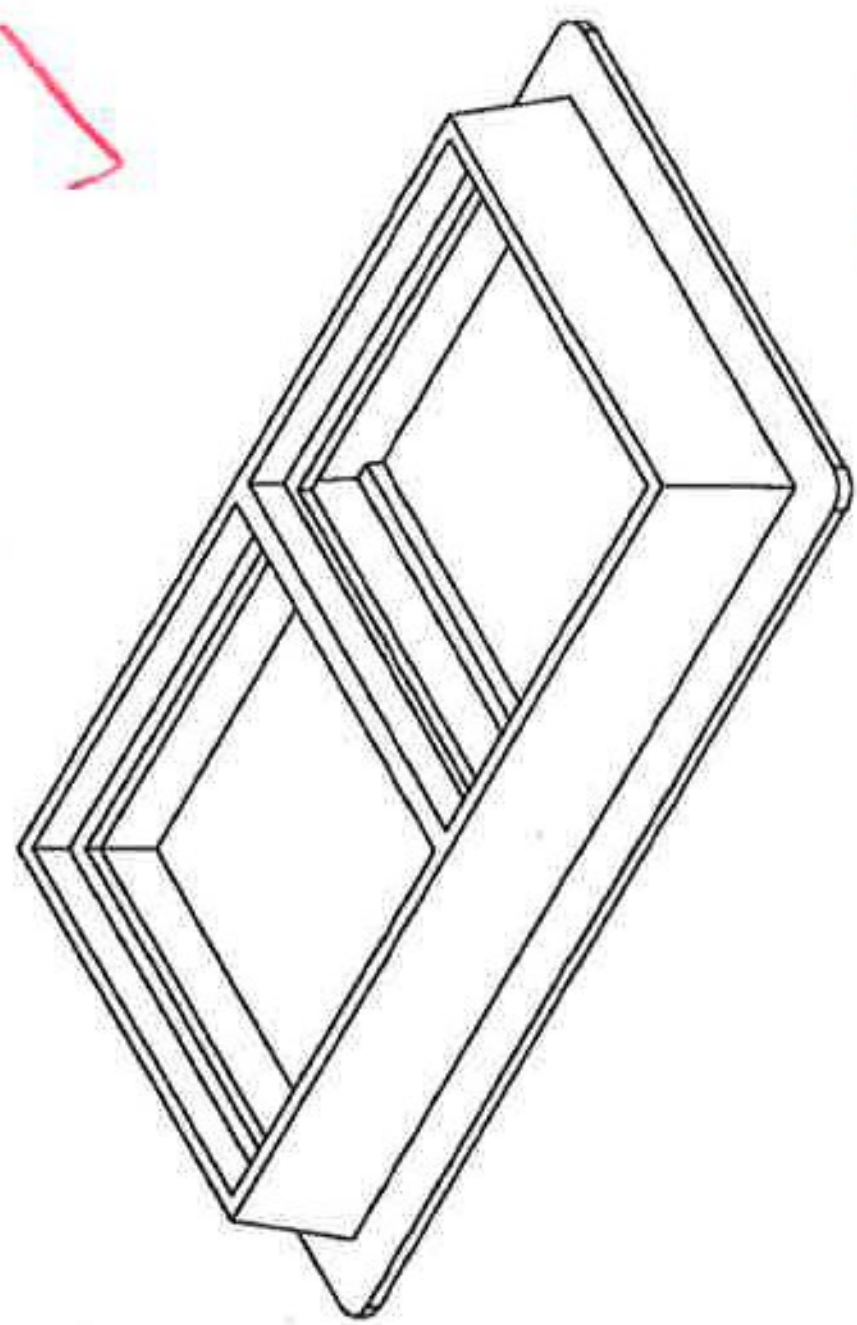

MATERIAL: CAST GRAY IRON ASTM A-48, CLASS 35B
FINISH: NO PAINT UNLESS SPECIFIED ON PURCHASE ORDER
HEIGHT: 516#

DR.	RKB	SCALE	1/8"=1"	TITLE	R-3587
CHK.		DATE	12-21-2010	FRAME	
www.neenahfoundry.com				NEENAH FOUNDRY REPAIR SERVICE DEPT.	NF-35872004 B
PHONE: 1-800-538-5075					