
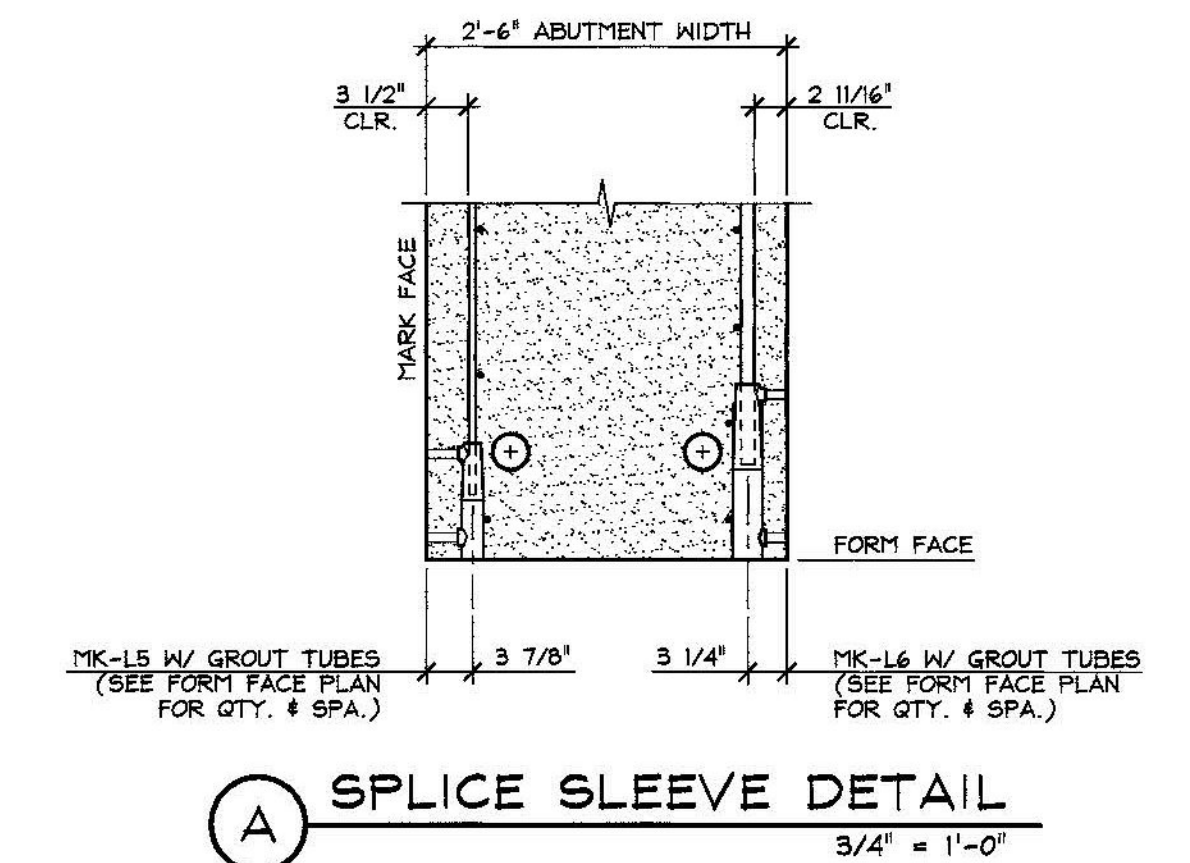
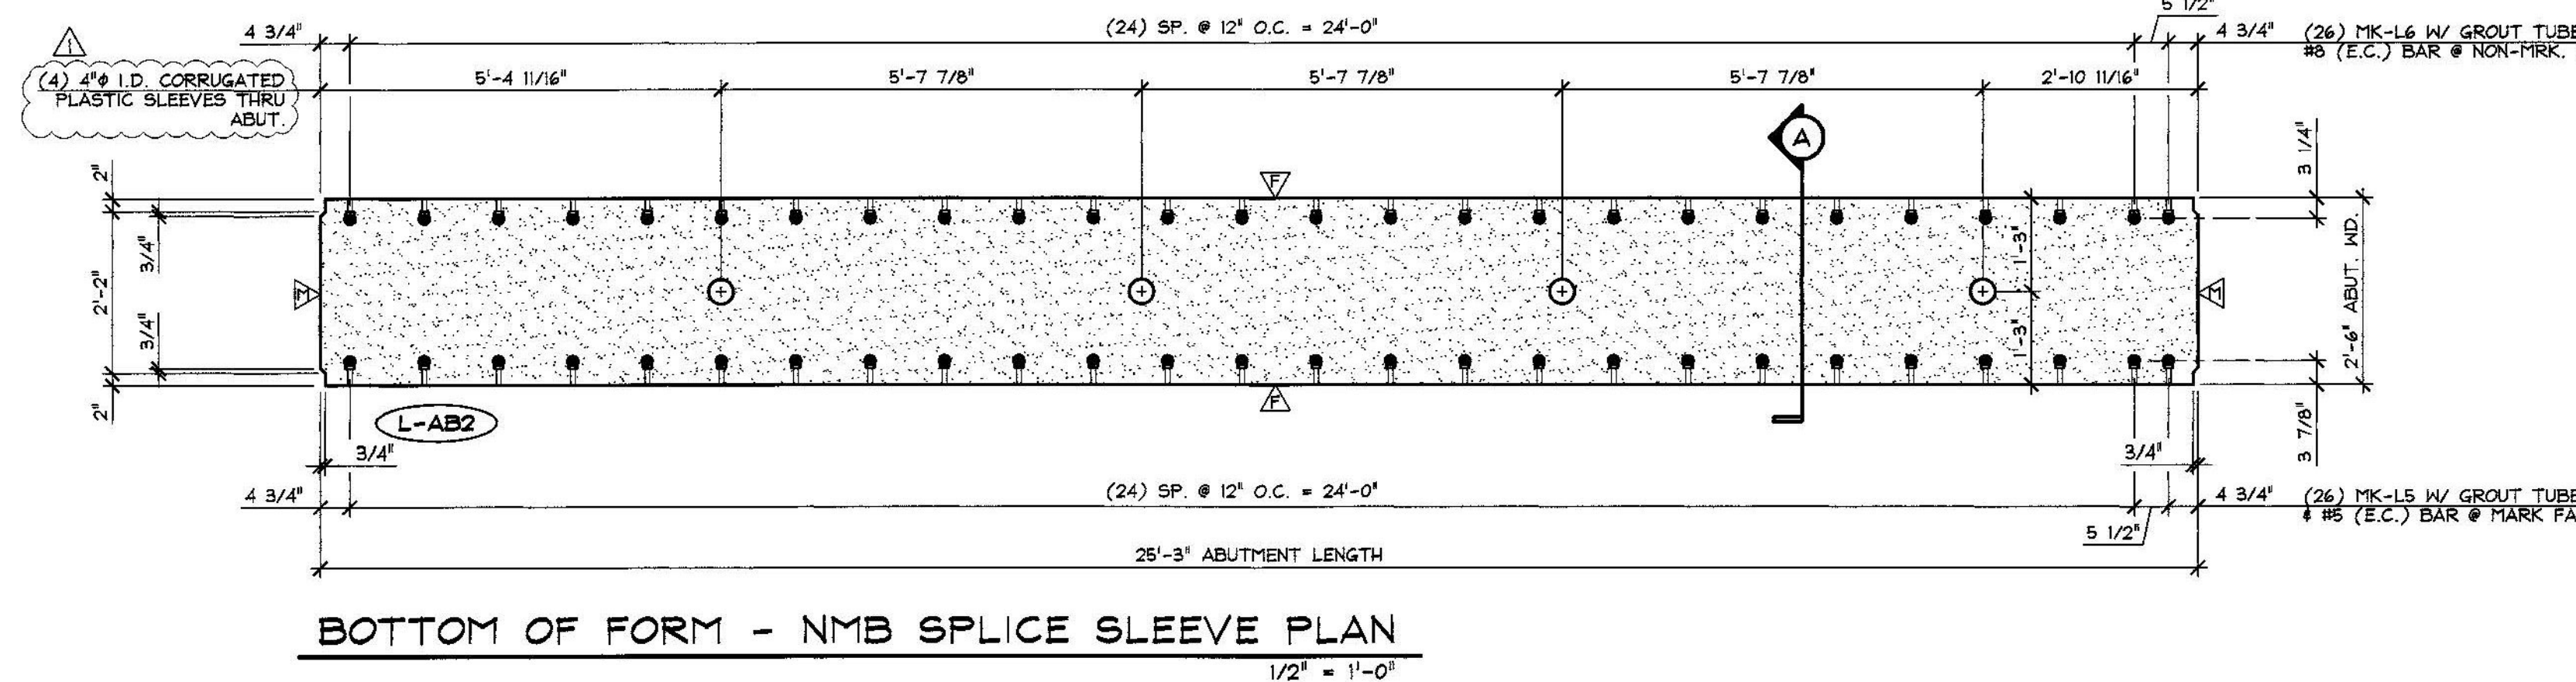
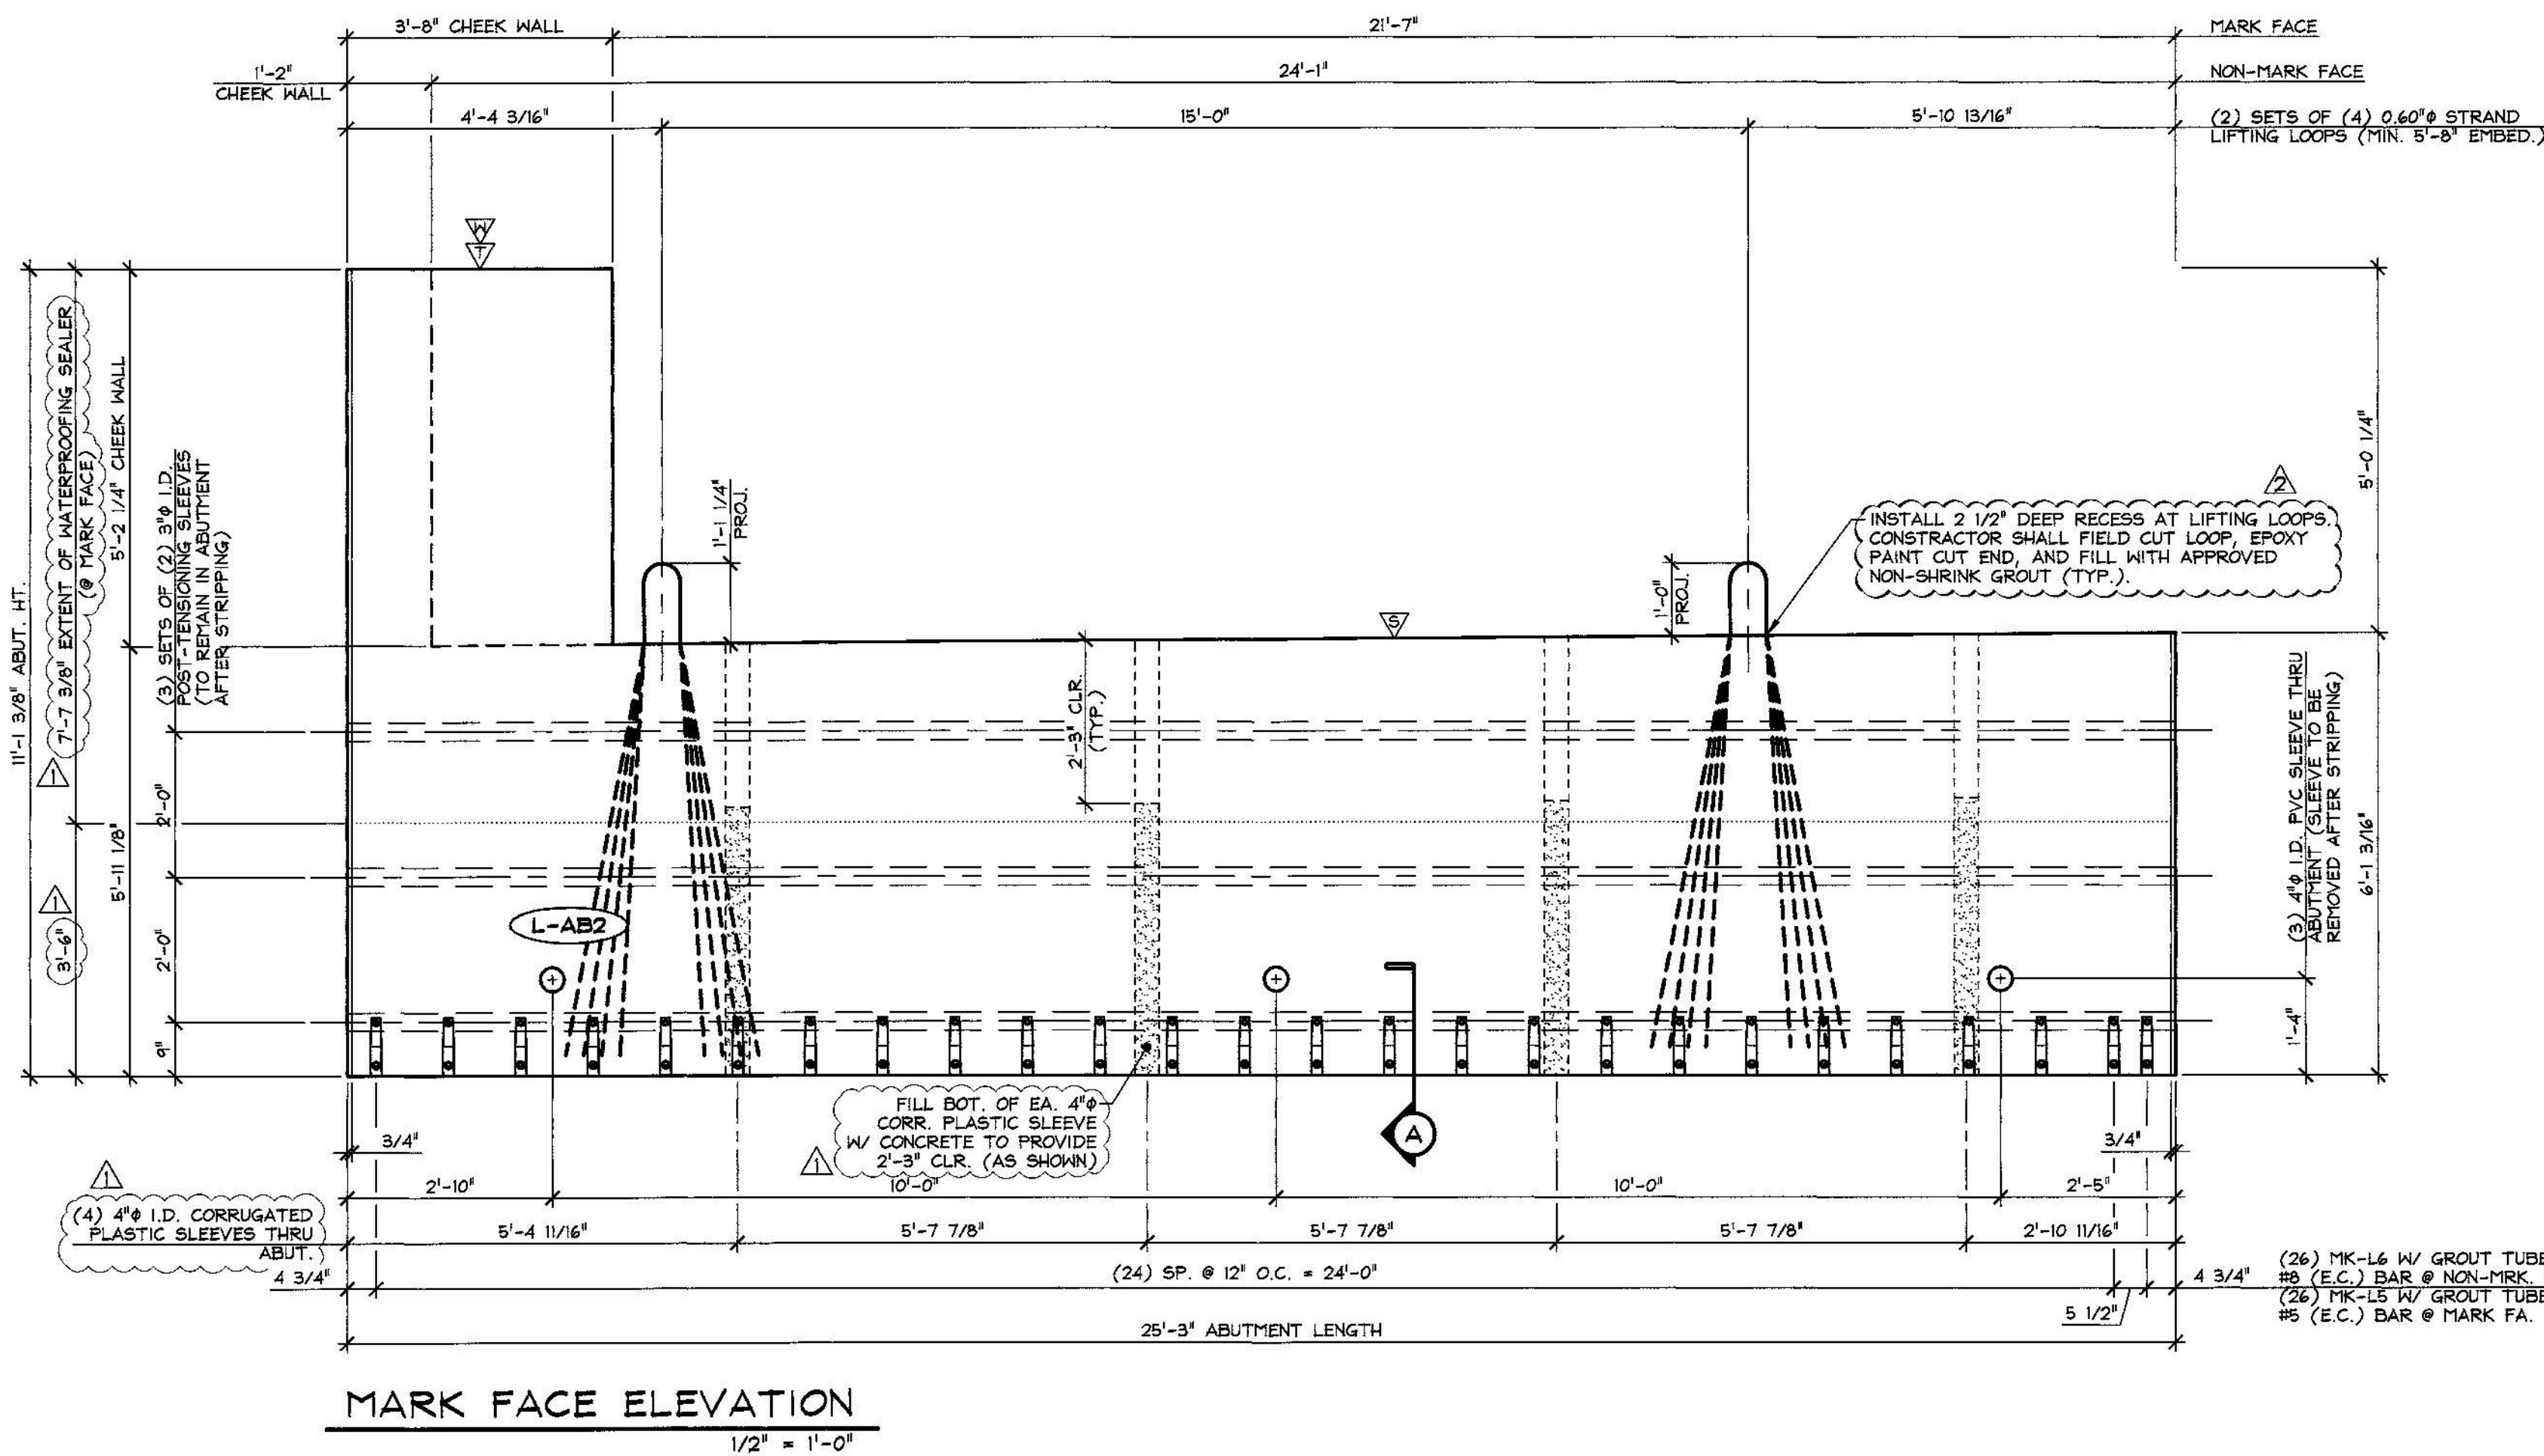


RECEIVED
 ON: **May 12, 2015**
 and Checked for
CONFORMANCE
 BY: **Todd A. Sumner** DATE: **05/13/2015**

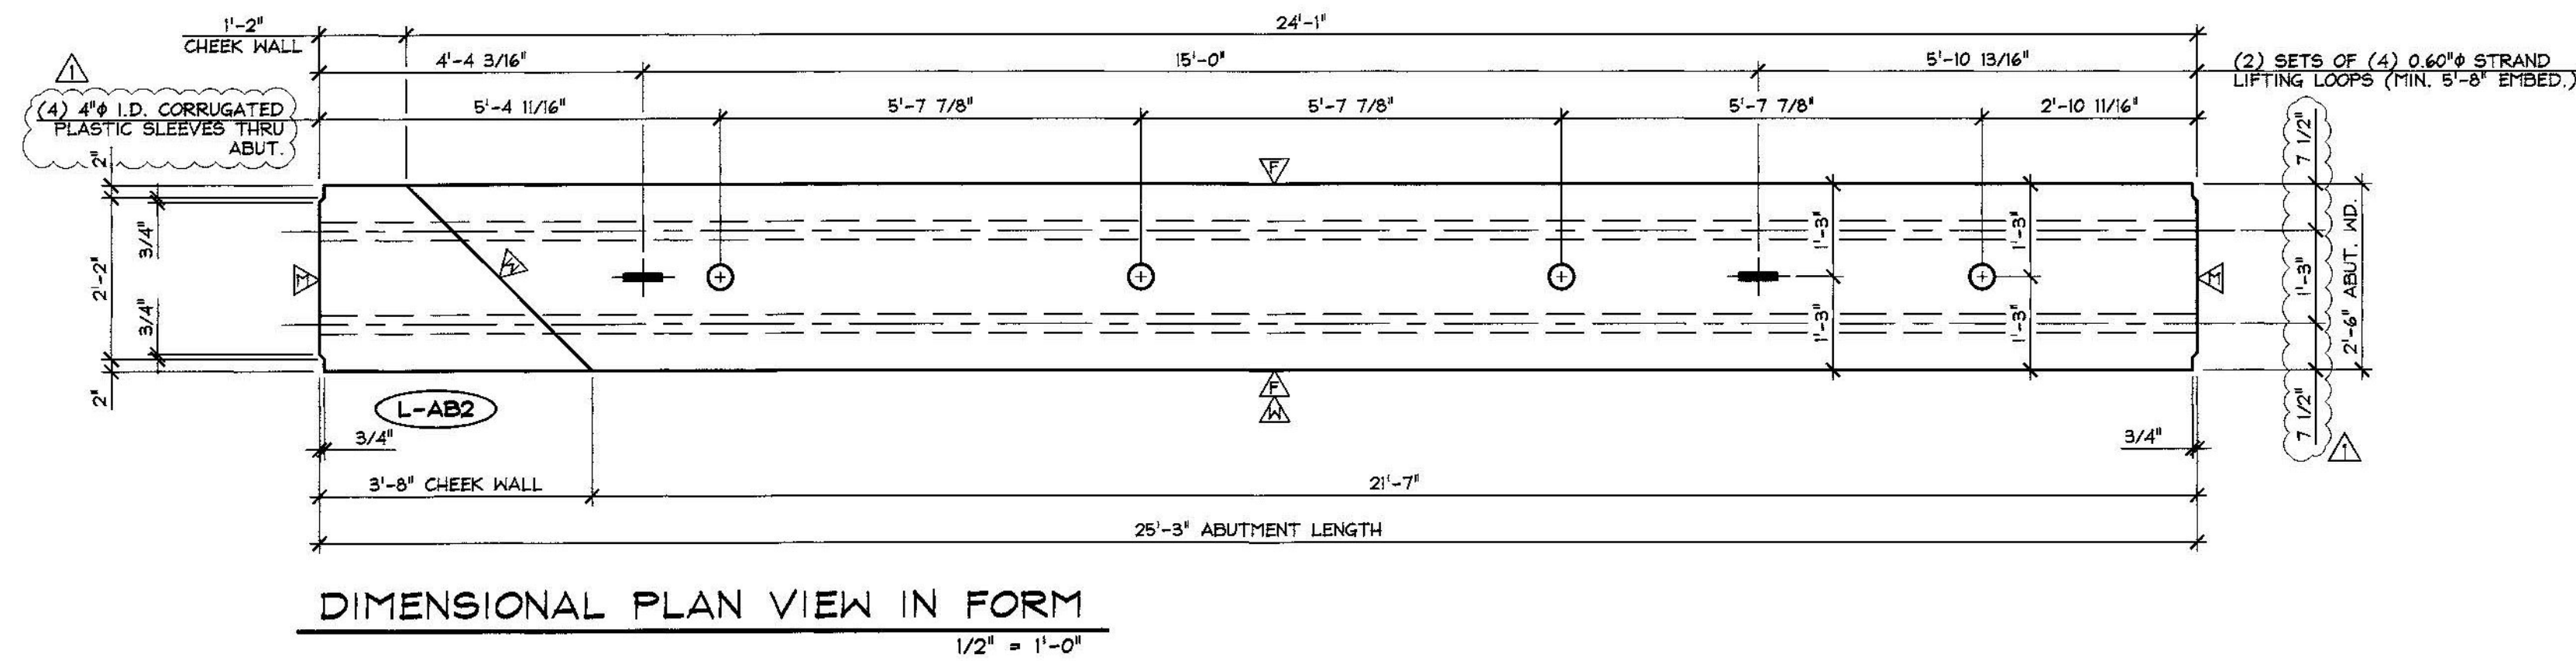

- △ DENOTES SMOOTH SCREED FINISH
- △ DENOTES (1) COAT WATERPROOF SEALER
- △ DENOTES FORM FINISH
- △ DENOTES ROUGHENED FINISH
- △ DENOTES STEEL TROWEL FINISH
- △ DENOTES MATCH CAST

SHOP NOTE:
 f_c = 5,000 PSI
 f_{ci} = 3,500 PSI
 MIX #445MSCC

SUBMITTAL REVIEW

Review is only for general conformity to the contract drawings and specifications and shall not relieve the contractor of his entire responsibility under the contract, including among other things, dimensions to be confirmed and correlated at the job site, and information that pertains to the fabrication processes or to techniques of construction.

NO EXCEPTIONS TAKEN
 MAKE CORRECTIONS NOTED
 RESUBMITTAL NOT REQUIRED
 AMEND AND RESUBMIT
 REJECTED - SEE REMARKS

BY: *Ryan L. Sumner*
 DATE: 5/12/2015

- △ 5-11-15 REVISED AS NOTED
- △ 4-27-15 GENERAL REVISIONS

MARK: L-AB2	QTY.: 1	WT.: 30.79 T	VOL.: 15.21 cy
MATERIAL LIST / ABUTMENT			
ITEM	MARK	DESCRIPTION	QTY.
1	MK-L5	NMB SPLICE SLEEVE 5U-X(PG) (EPOXY COATED)	26
2	MK-L6	NMB SPLICE SLEEVE 6U-X(PG) (EPOXY COATED)	26
3			
4		SET OF (4) 0.60" STRAND LIFTING LOOPS	2
5			
6	△	4" I.D. x 6'-1" CORRUGATED PLASTIC SLEEVE	4
7			
8			
9			
10			

APPROVAL STAMP:

J.P. CARRARA & SONS INC.
 Precast & Prestress Manufacturer
 244 GSE ST., MIDDLEBURY, VERMONT 05753 Phone: (802)388-6361 Fax: (802)388-9010

J.A. McDONALD, INC.
 CONTRACTOR
 LYNDON CENTER, VERMONT

STATE OF VERMONT AGENCY OF TRANSPORTATION
 COUNTY OF ADDISON

DATE: FEB. 6, 2015

TOWN OF LINCOLN
 TH 1 (RURAL MAJOR COLLECTOR) OVER NEW HAVEN RIVER
 BRIDGE NO.: 19 PROJECT NO.: BRP 0188 (8)

SCALE: NOTED

CHKD: M.W. DFTM: B.L.

JOB NO: 23459-015

PRECAST ABUTMENT
DIMENSIONAL DETAILS

DWG. NO: **AB2**