




DIMENSIONAL PLAN VIEW IN FORM
1/2" = 1'-0"

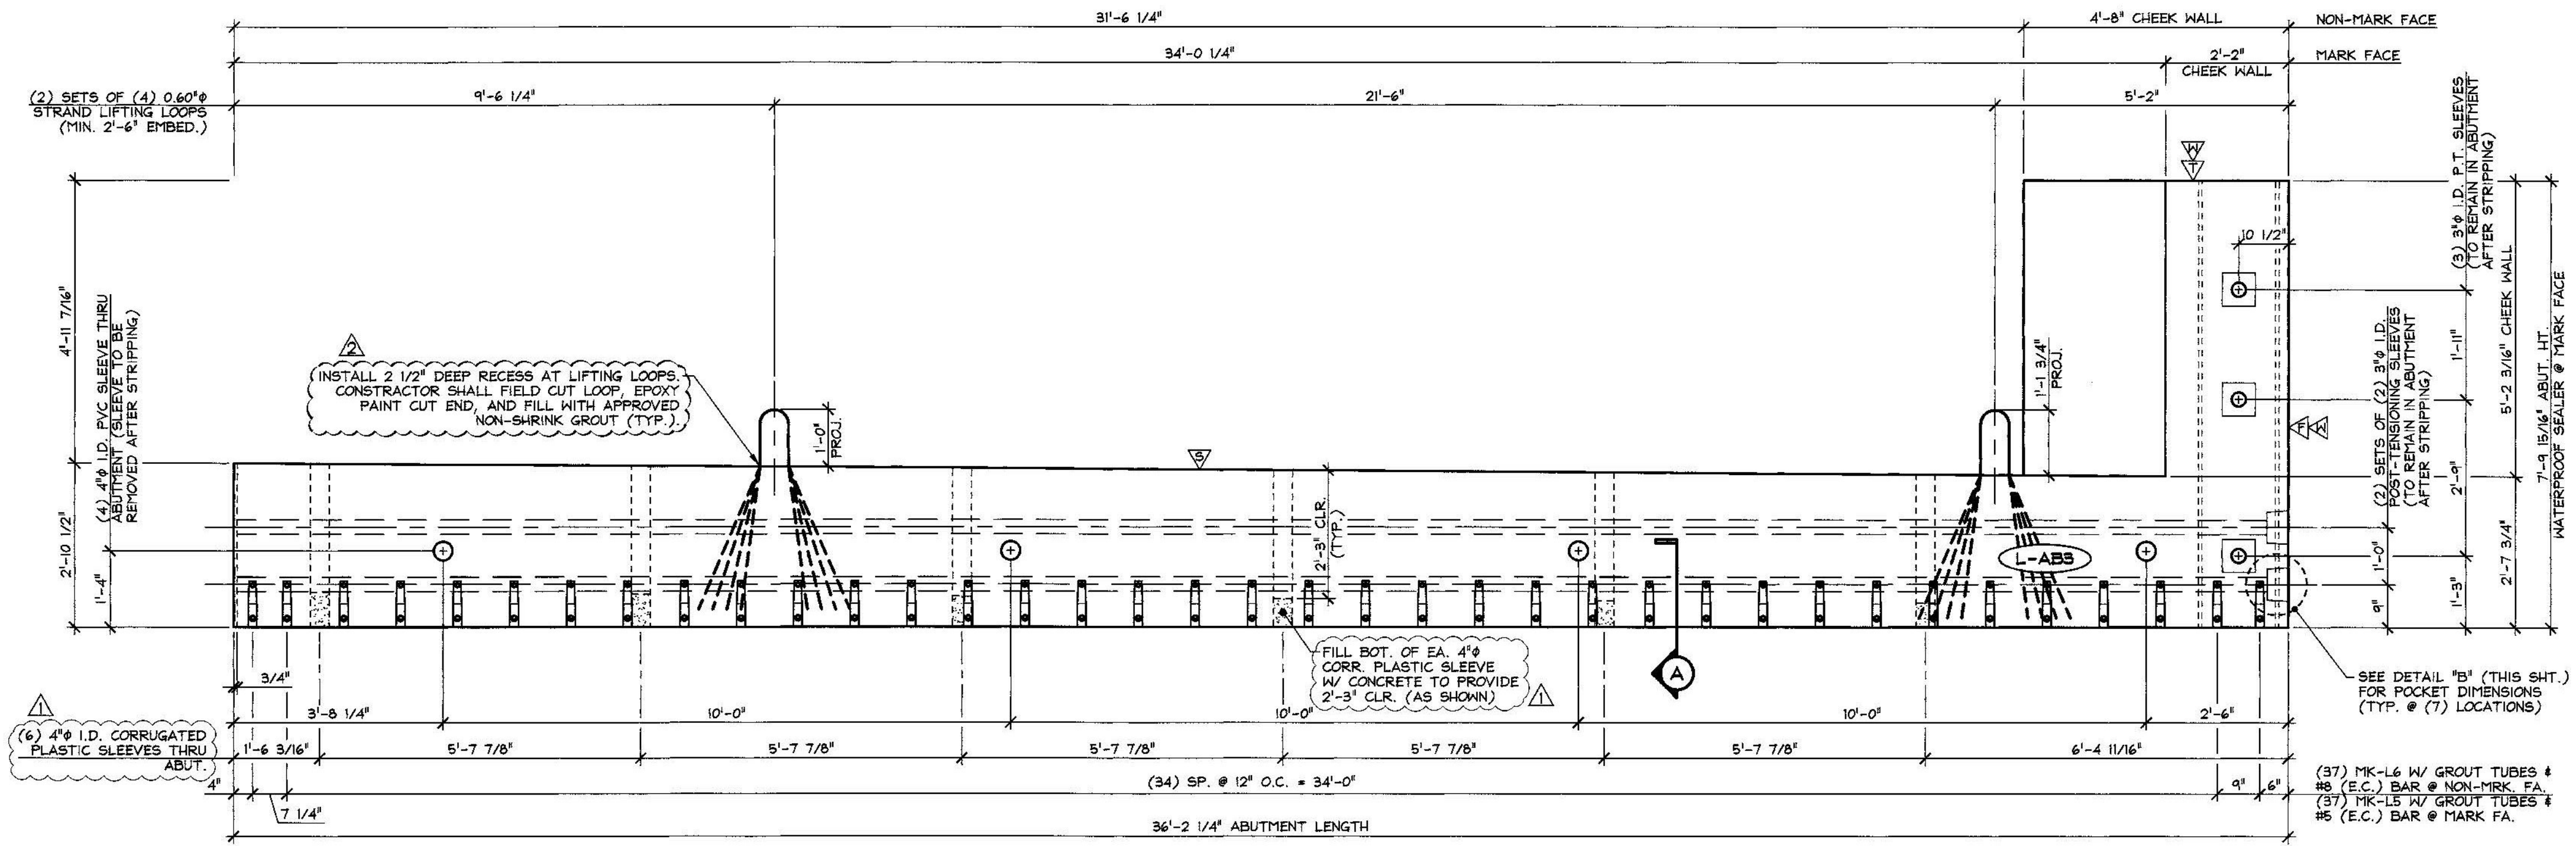


MARK FACE ELEVATION
1/2" = 1'-0"

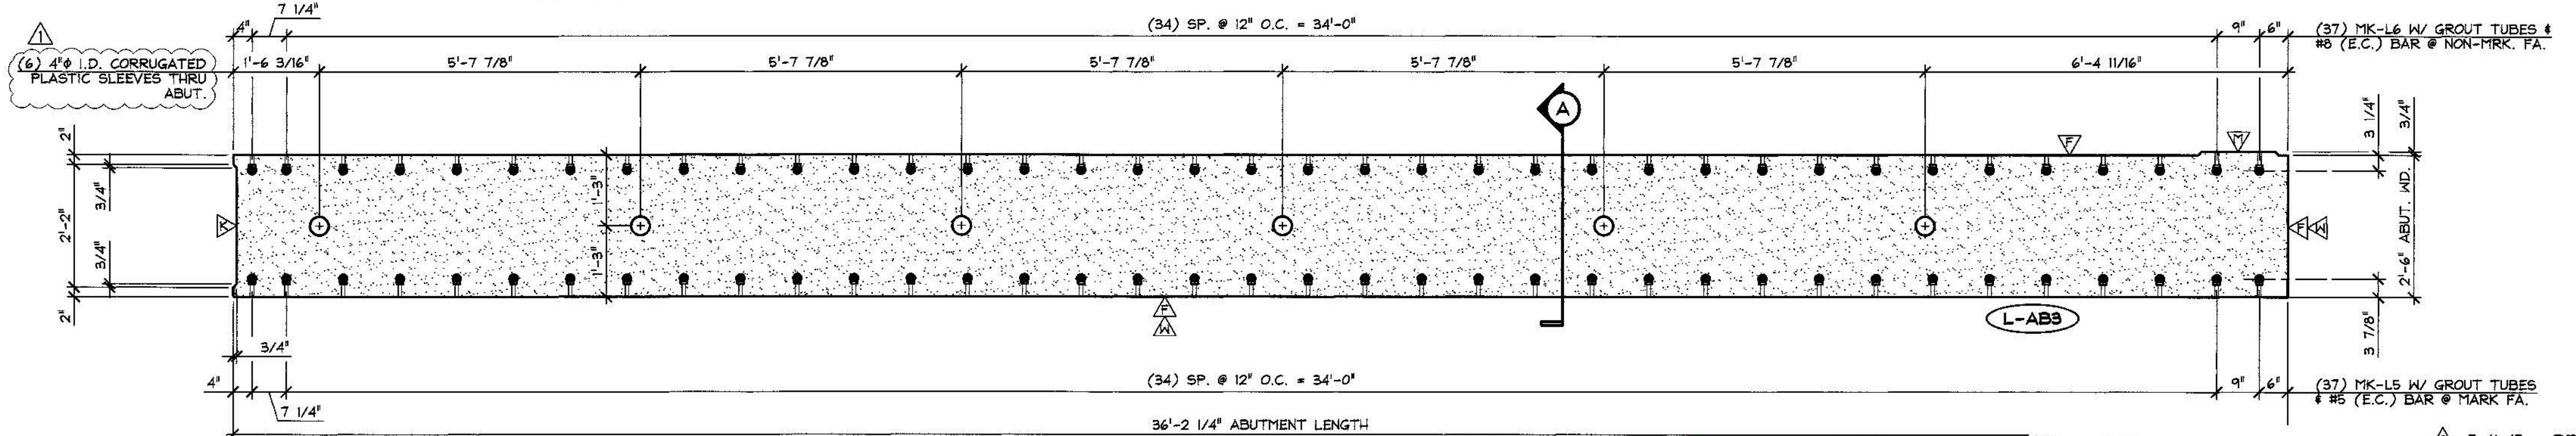

BOTTOM OF FORM - NMB SPLICE SLEEVE PLAN
1/2" = 1'-0"

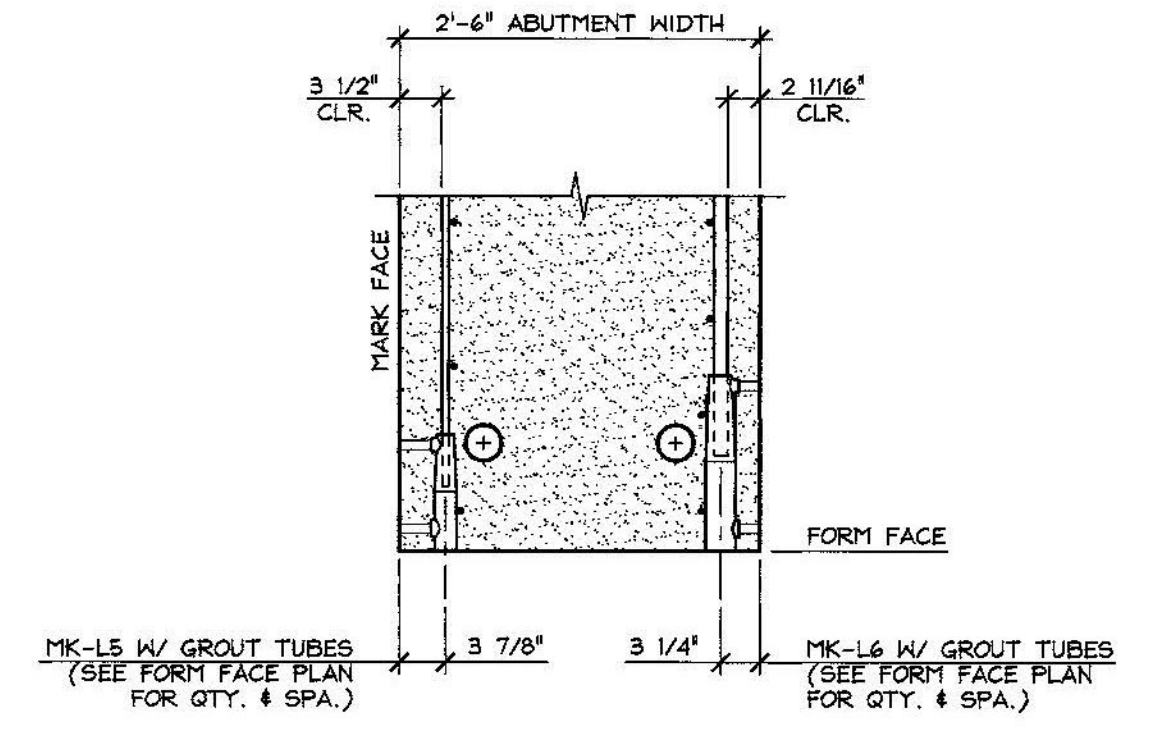

A SPLICE SLEEVE DETAIL
3/4" = 1'-0"

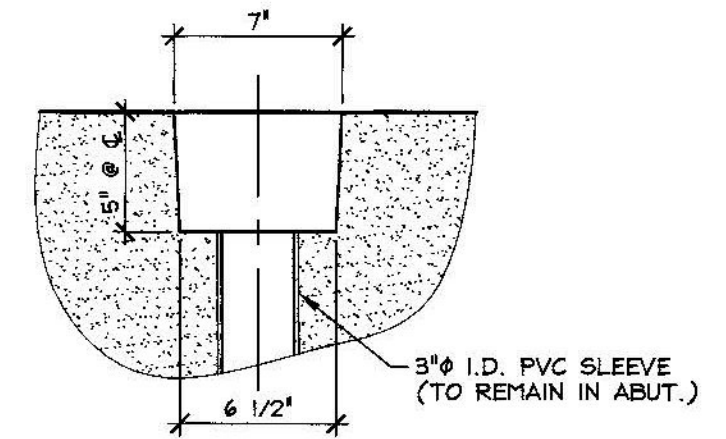

B P.T. POCKET DETAIL
1 1/2" = 1'-0"

- △ DENOTES SMOOTH SCREED FINISH
- △ DENOTES (1) COAT WATERPROOF SEALER
- △ DENOTES FORM FINISH
- △ DENOTES ROUGHENED FINISH
- △ DENOTES STEEL TROWEL FINISH
- △ DENOTES MATCH CAST

SHOP NOTE:
f'c = 5,000 PSI
f'ci = 3,500 PSI
MIX #445MSCC

MARK:	L-AB3	QTY.:	1	WT.:	22.05 T	VOL.:	10.89 cy
MATERIAL LIST / ABUTMENT							
ITEM	MARK	DESCRIPTION				QTY.	
1	MK-L5	NMB SPLICE SLEEVE 5U-X(PG) (EPOXY COATED)				37	
2	MK-L6	NMB SPLICE SLEEVE 6U-X(PG) (EPOXY COATED)				37	
3							
4		SET OF (4) 0.60" STRAND LIFTING LOOPS				2	
5							
6	△	4" I.D. x 2'-10 1/2" CORRUGATED PLASTIC SLEEVE				6	
7							
8							
9							
10							

Vermont Agency of Transportation

RECEIVED
ON: **May 12, 2015**
and Checked for
CONFORMANCE
BY: **Todd A. Sumner** DATE: **05/13/2015**

SUBMITTAL REVIEW
Review is only for general conformity to the contract drawings and specifications and shall not relieve the contractor of his entire responsibility under the contract, including among other things, dimensions to be confirmed and correlated at the job site, and information that pertains to the fabrication processes or to techniques of construction.

NO EXCEPTIONS TAKEN
 MAKE CORRECTIONS NOTED
 RESUBMITTAL NOT REQUIRED
 AMEND AND RESUBMIT
 REJECTED - SEE REMARKS

BY: *Todd A. Sumner*
DATE: *5/12/2015*

5-11-15 REVISED AS NOTED
4-27-15 GENERAL REVISIONS

APPROVAL STAMP:

J.P. CARRARA & SONS INC.
Precast & Prestress Manufacturer
2404 ONE STR. MIDDLEBURY, VERMONT 05753 Phone: (802)388-6361 Fax: (802)388-8010

J.A. McDONALD, INC.
CONTRACTOR
LYNDON CENTER, VERMONT

STATE OF VERMONT AGENCY OF TRANSPORTATION
COUNTY OF ADDISON

DATE: FEB. 6, 2015
SCALE: NOTED

TOWN OF LINCOLN
TH 1 (RURAL MAJOR COLLECTOR) OVER NEW HAVEN RIVER
BRIDGE NO.: 19 PROJECT NO.: BRP 0188 (8)

CHKD: M.W. DFTM: B.L.
JOB NO: 23459-015

PRECAST ABUTMENT DIMENSIONAL DETAILS

DWG. NO: **AB3**