

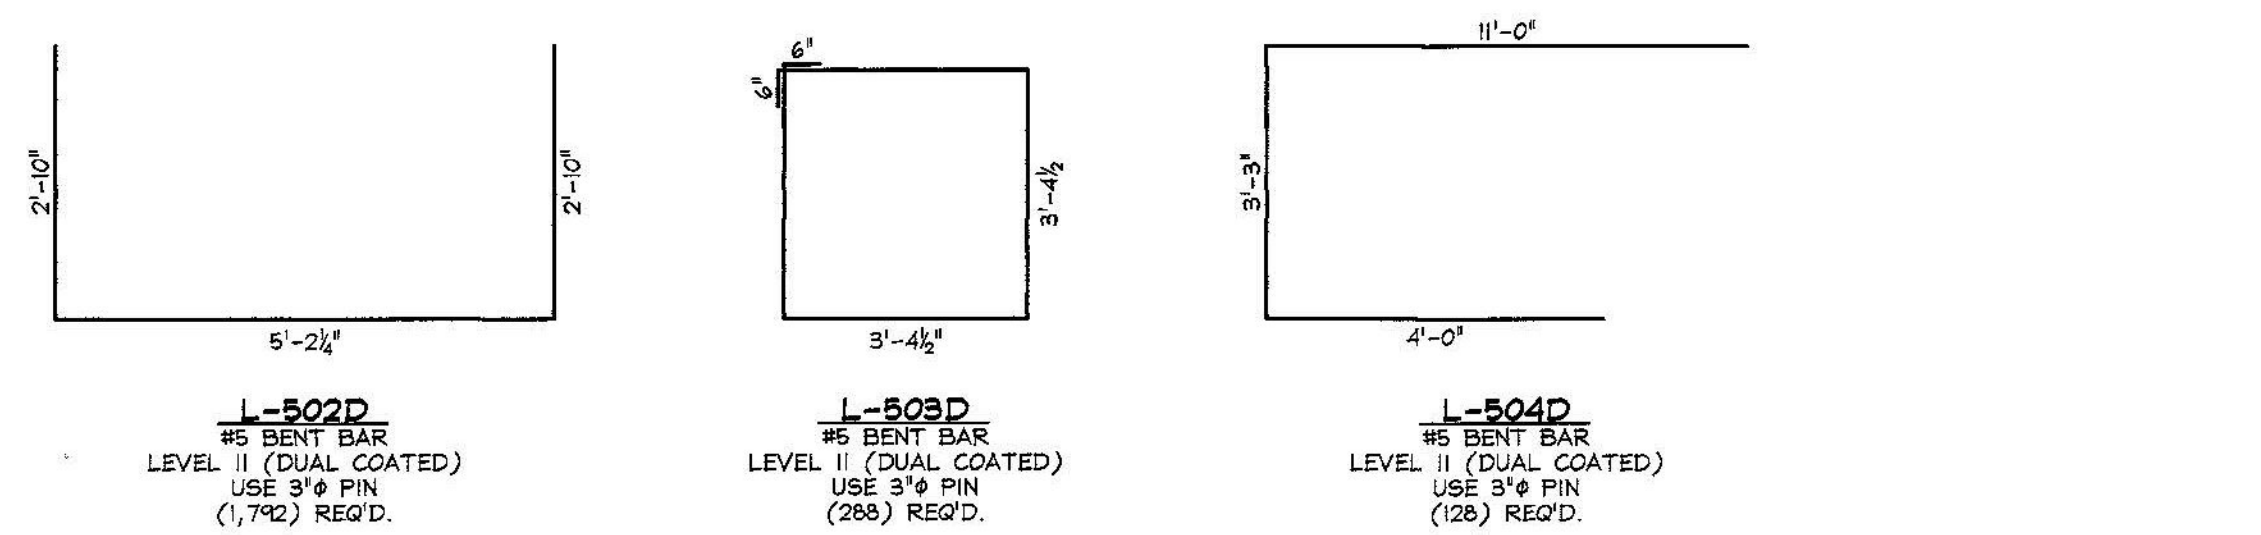



PRECAST APPROACH SLABS

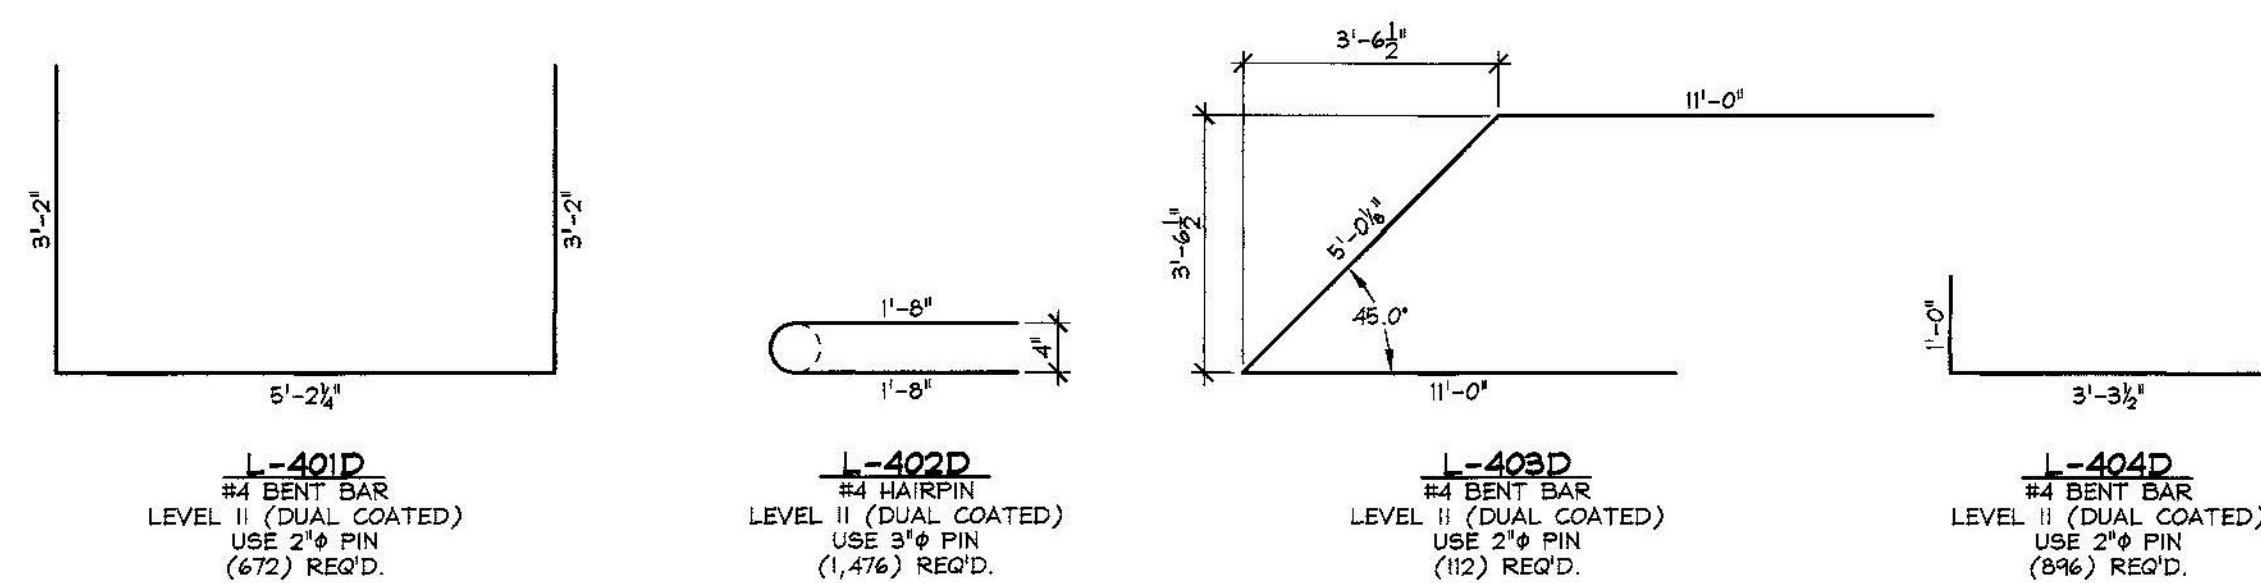

PRESTRESSED BOX BEAMS

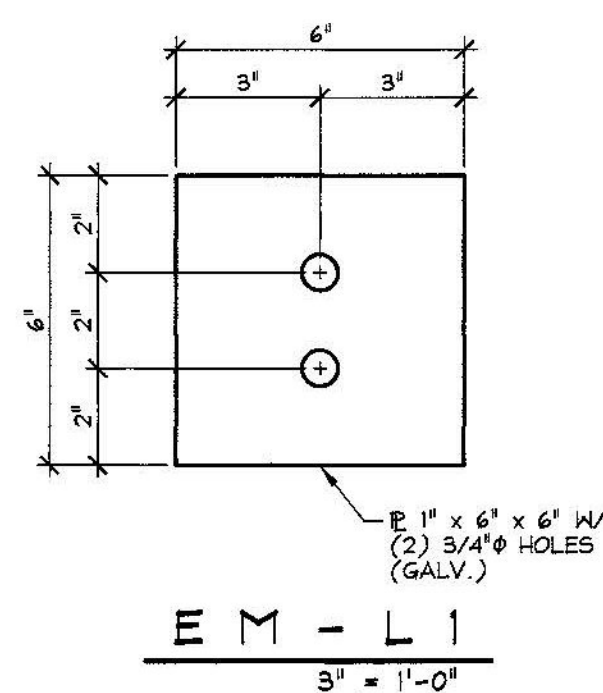

MISCELLANEOUS MATERIALS				
ITEM	MARK	QTY.	DESCRIPTION	REMARKS
1				
2		98	#5 x 8'-8" (LEVEL II, DUAL COATED)	
3		56	#5 x 24'-3 1/2" (LEVEL II, DUAL COATED)	
4				
5		48	4" I.D. x 1'-4" PVC SLEEVE	
6		32	8T x 6 3/4" SWIFT LIFT LIFTER	GALVANIZED
7				
8				
9				
10				
11	EM-L1	36	E 1" x 6" x 6" W/ (2) 3/4" HOLES (GALV.)	FOR ERECTION; SEE DETAIL THIS SHEET
12		36	(0.60" x 270 KSI (LOW LAX) x 4'-2" LONG POLY-STRAND)	FOR ERECTION
13		72	0.60" SINGLE USE STRESSING CHUCK	FOR ERECTION
14		126	COMPRESSIBLE SEALER SELF ADHESIVE	FOR ERECTION
15				
16		512	#4 x 4'-5" (LEVEL II, DUAL COATED)	
17		56	#5 x 12'-9" (LEVEL II, DUAL COATED) W/ (3) 3'-8" STAG. LAPS	
18				
19	MK-L3	138	DAYTON #5 x 2'-3" D-10-A STRAIGHT DOWEL BAR SPLICER	STAINLESS STEEL CLAD
20	MK-L4	56	DAYTON C-24 TYPE 4-APR DECK FORM HANGER	GALVANIZED
21		256	3/4" x 6 1/2" NON-FERROUS VOID DRAIN	
22		16	(2'-10" x 2'-9" x 2'-9" 11/16" BOX VOID)	SEE BOX VOID DETAILS
23		48	(2'-10" x 2'-9" x 12'-10 3/16" BOX VOID)	SEE BOX VOID DETAILS
24		32	SET OF (4) 0.60" STRAND LIFTING LOOPS	MADE USING 4" PIN
25				

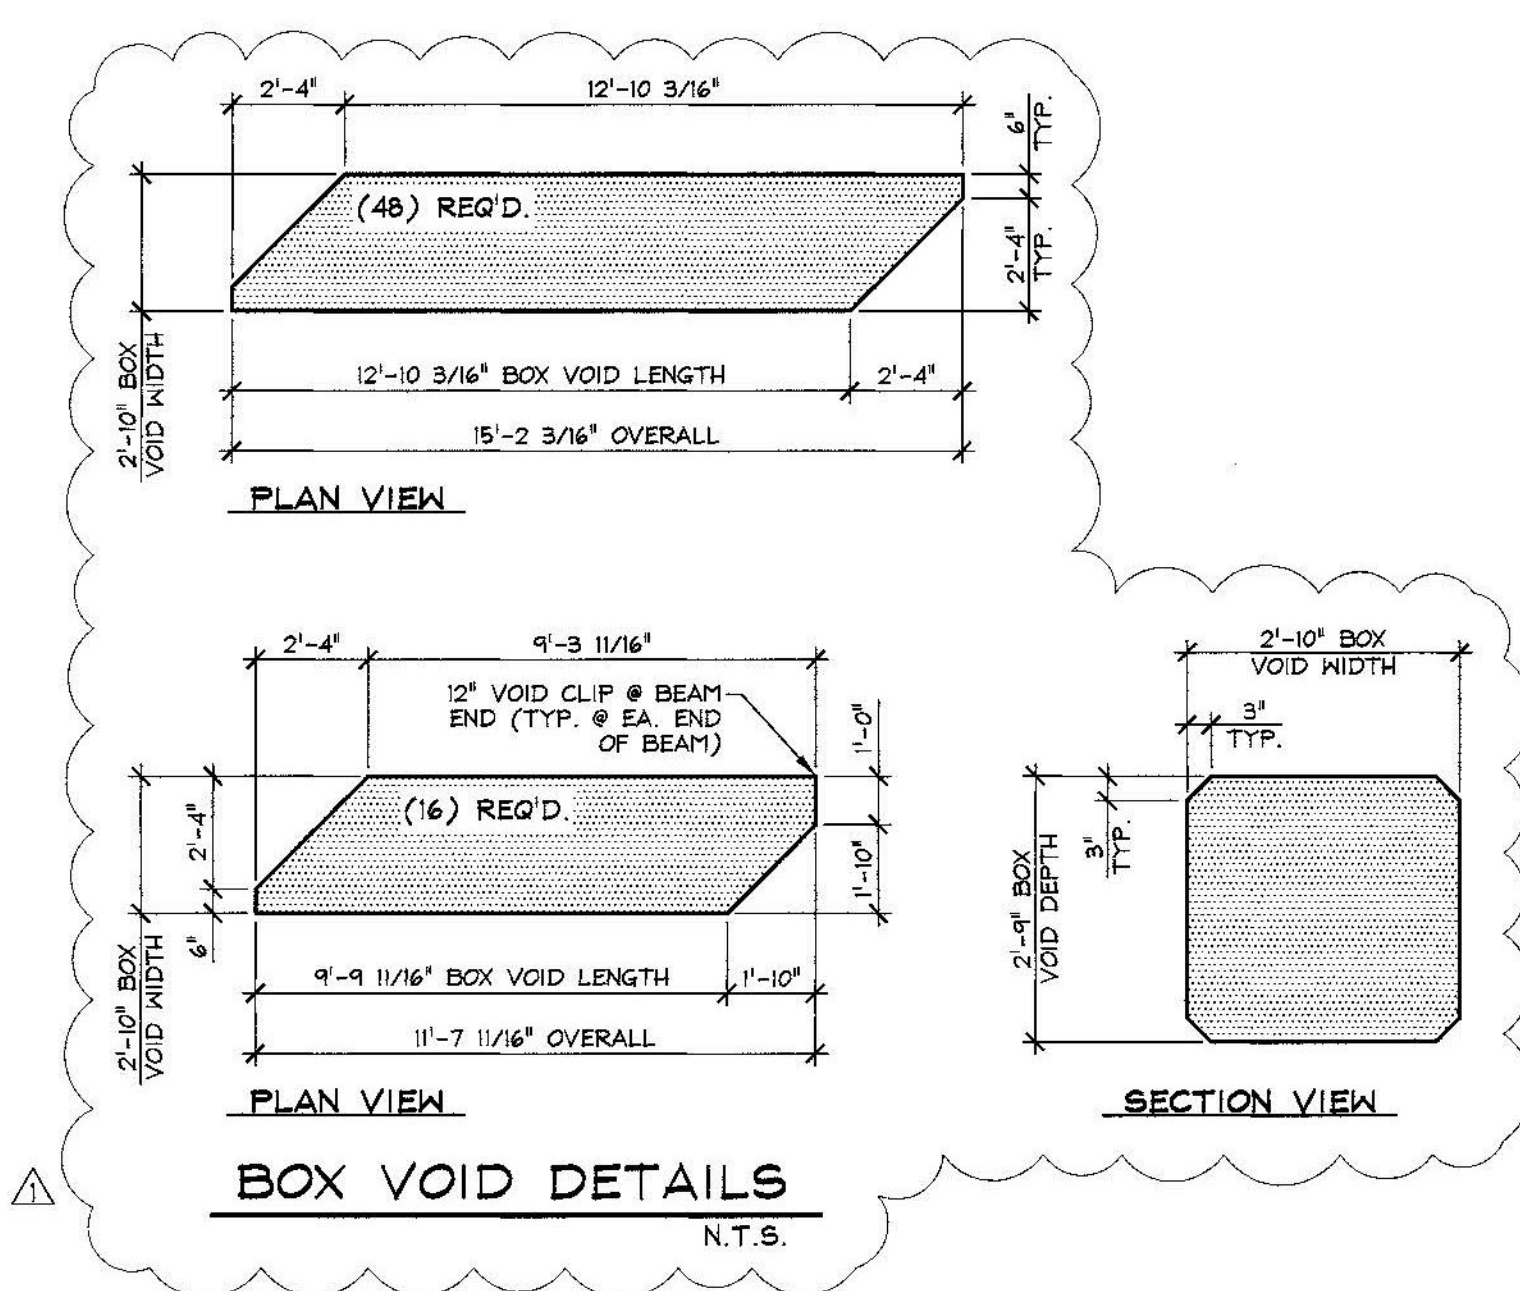

Vermont Agency of Transportation

RECEIVED

ON: **May 12, 2015**

and Checked for

CONFORMANCE

BY: **Todd A. Sumner** DATE: **05/13/2015**

SUBMITTAL REVIEW

Review is only for general conformity to the contract drawings and specifications and shall not relieve the contractor of his entire responsibility under the contract, including among other things, dimensions to be confirmed and correlated at the job-site, and information that pertains to the fabrication processes or to techniques of construction.

NO EXCEPTIONS TAKEN
 MAKE CORRECTIONS NOTED
 RESUBMITTAL NOT REQUIRED
 AMEND AND RESUBMIT
 REJECTED - SEE REMARKS

BY: **PB AMERICAS, INC.**
 DATE: **5/12/2015**

5-11-15 REVISED AS NOTED
 4-27-15 REVISED AS NOTED

APPROVAL STAMP:

J.P. CARRARA & SONS INC.
 Precast & Prestress Manufacturer
 2344 GASE STR., MIDDLEBURY, VERMONT 05753 Phone: (802)388-6361 Fax: (802)388-3010

J.A. McDONALD, INC.
 CONTRACTOR
 LYNDON CENTER, VERMONT

STATE OF VERMONT AGENCY OF TRANSPORTATION
 COUNTY OF ADDISON

TOWN OF LINCOLN
 TH 1 (RURAL MAJOR COLLECTOR) OVER NEW HAVEN RIVER
 BRIDGE NO.: 19 PROJECT NO.: BRP 0188 (8)

DATE: FEB. 6, 2015
 SCALE: NOTED
 CHKD: M.W. DFTM: B.L.
 JOB NO: 23459-015

MATERIALS LIST
 DWG. NO: **M1**