


# STATE OF VERMONT AGENCY OF TRANSPORTATION



## PROPOSED IMPROVEMENT BRIDGE PROJECT TOWN OF NEW HAVEN COUNTY OF ADDISON BRIDGE #10

### TH 2 (CLASS 2 - MAJOR COLLECTOR)


RECORD PLANS	
CONTRACTOR:	CCS CONSTRUCTORS LLC - MORRISVILLE, VT
RESIDENT ENGINEER:	ROBERT SUCKERT
CONSTRUCTION BEGAN:	JUNE 01, 2016
CONSTRUCTION COMPLETE:	SEPTEMBER 26, 2016
RECORD PLANS BY:	ROBERT SUCKERT & JESSE IVES
I HEREBY CERTIFY THAT ALL THE CONSTRUCTION REQUIRED BY THIS SET OF DRAWINGS HAS BEEN ACCOMPLISHED AS INDICATED HEREIN.	
BY:	RESIDENT ENGINEER
DATE:	11-2-18
NOTE: Any further information concerning final quantities, amounts or other details relative to this project may be found at Central Files in the electronic archives.	

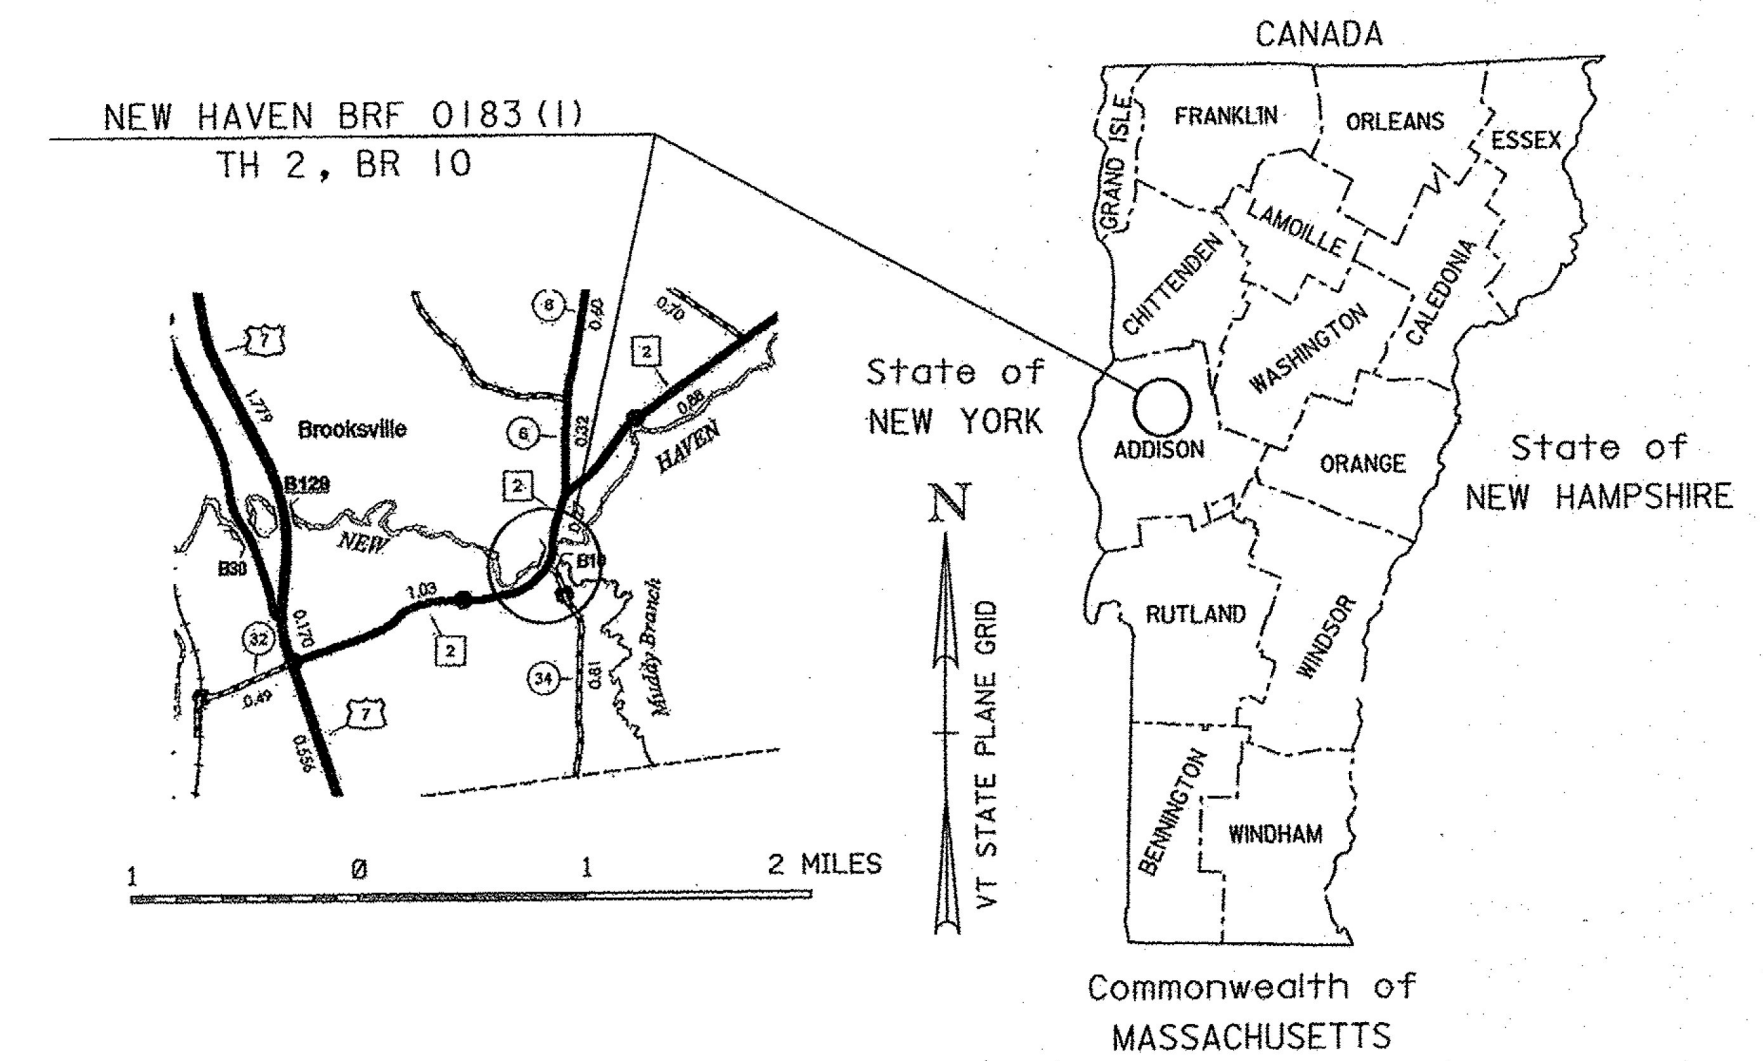

**PROJECT LOCATION:** BEGINNING AT A POINT IN THE TOWN OF NEW HAVEN ON TOWN HIGHWAY 2 (RIVER ROAD) APPROXIMATELY 250 FEET WESTERLY OF THE INTERSECTION WITH TH-34 (HALPIN ROAD) AND PROCEEDING EASTERLY APPROXIMATELY 730 FEET ALONG TOWN HIGHWAY 2.

**PROJECT DESCRIPTION:** WORK TO BE PERFORMED UNDER THIS PROJECT INCLUDES CONSTRUCTION OF A NEW BRIDGE ON A REVISED ALIGNMENT INCLUDING RELATED CHANNEL AND APPROACH WORK FOR TOWN HIGHWAY 2 AND TOWN HIGHWAY 34.

**LENGTH OF ROADWAY:** 562.98 FEET  
**LENGTH OF STRUCTURE:** 167.02 FEET  
**LENGTH OF PROJECT:** 730 FEET

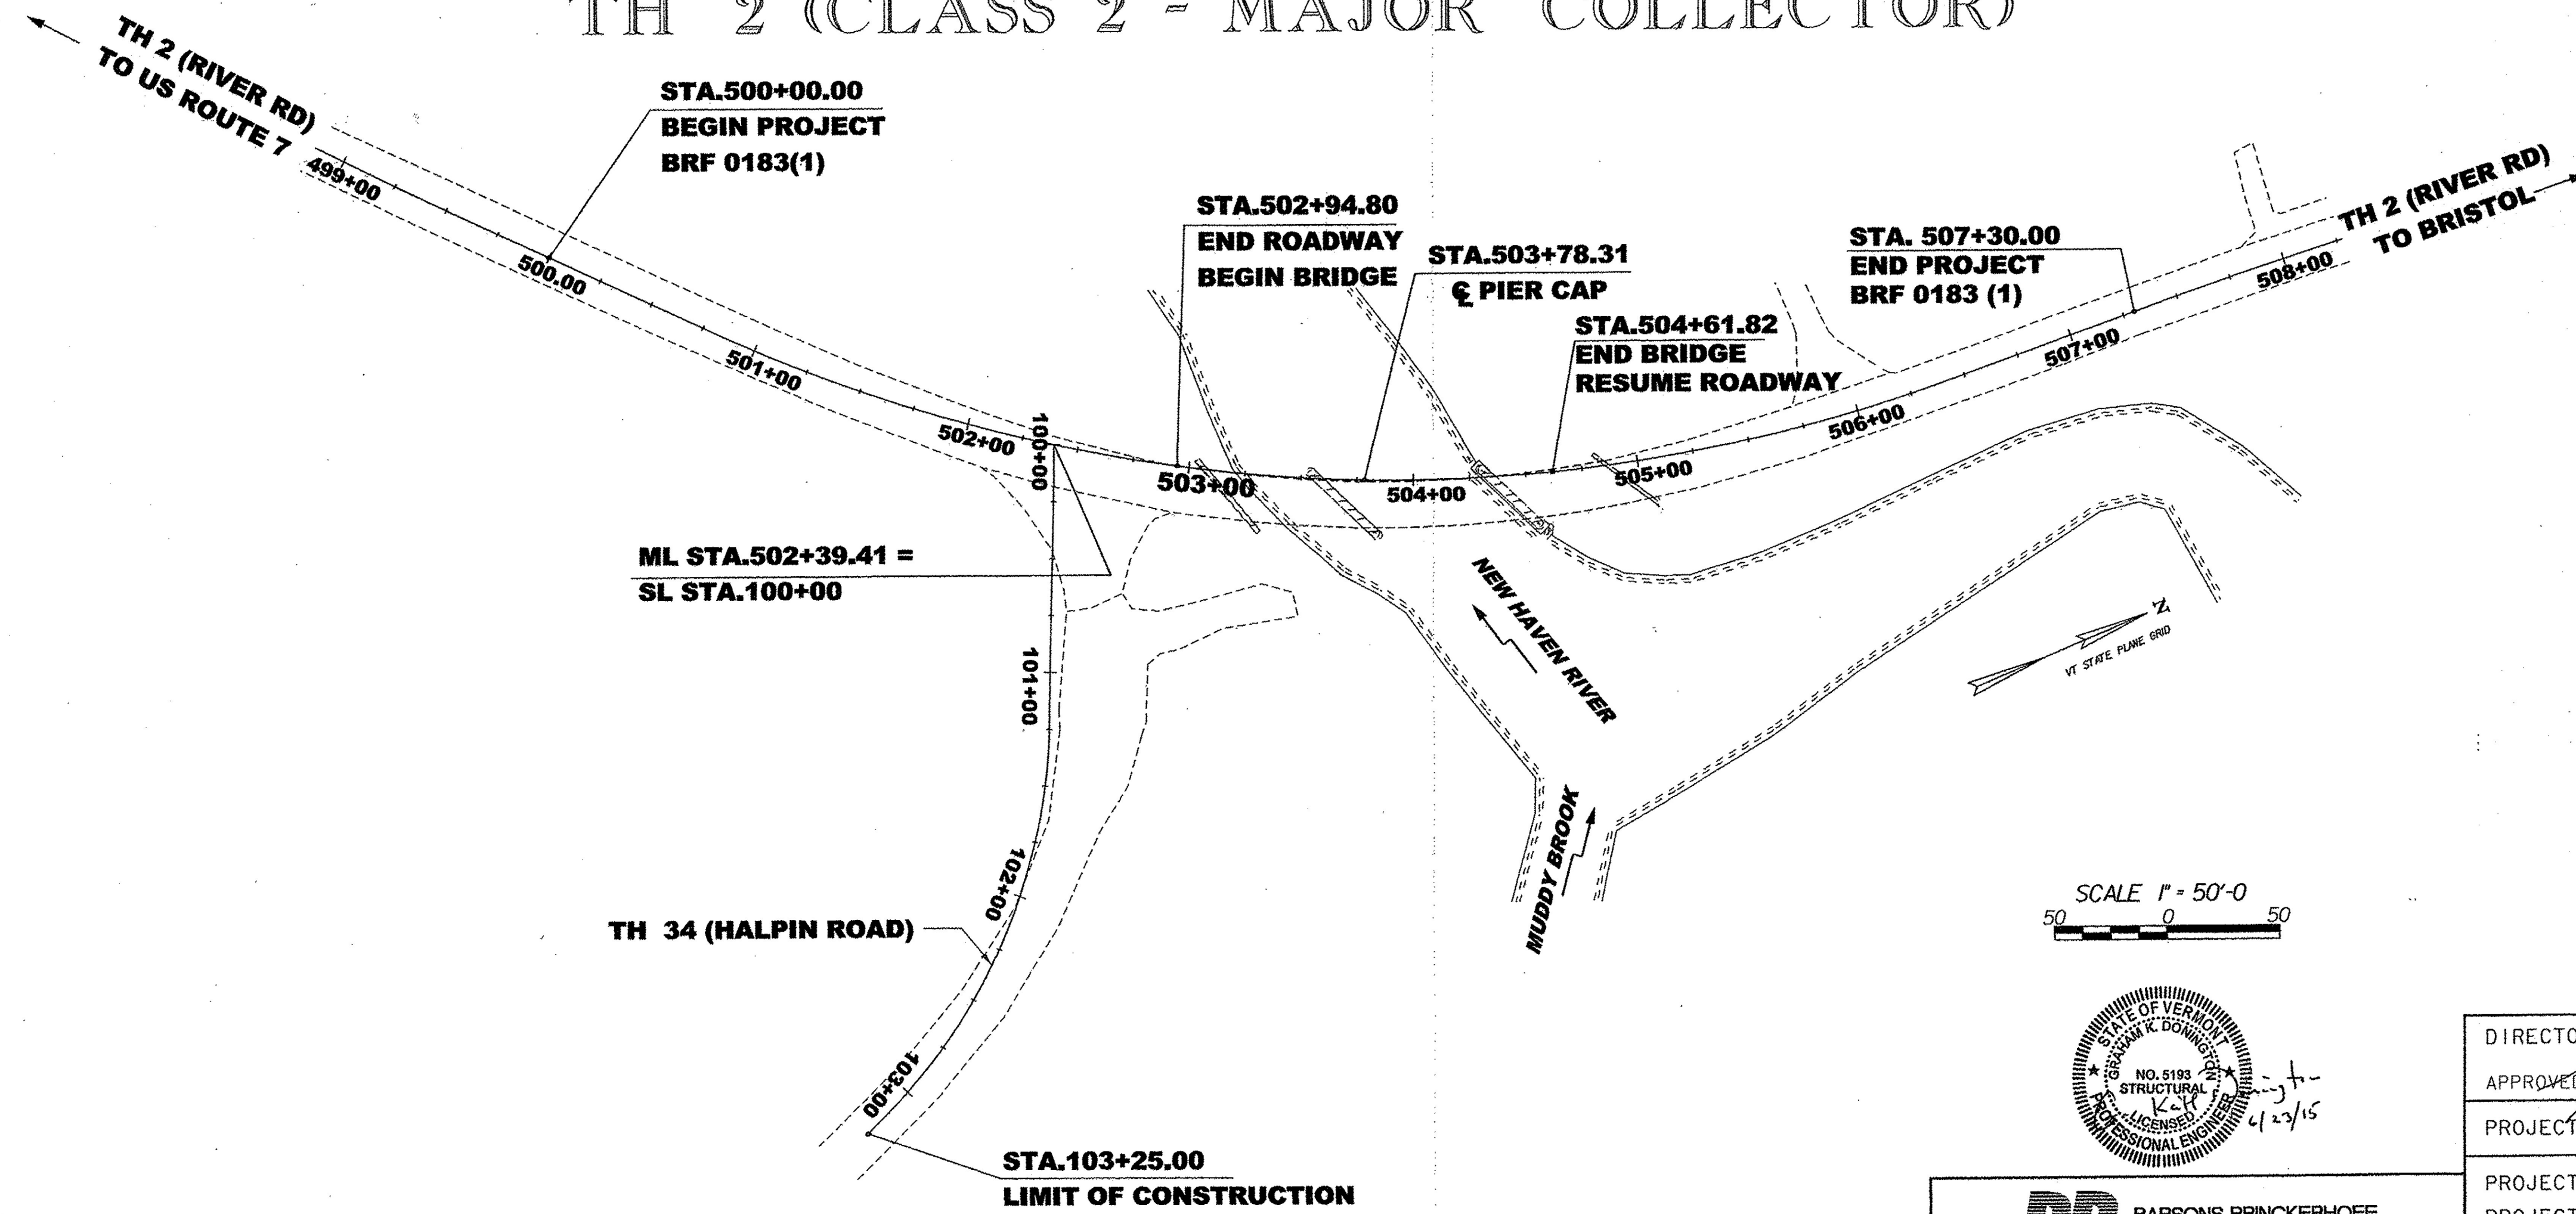


CONSTRUCTION IS TO BE CARRIED ON IN ACCORDANCE WITH THESE PLANS AND THE STANDARD SPECIFICATIONS FOR CONSTRUCTION DATED 2011, AS APPROVED BY THE FEDERAL HIGHWAY ADMINISTRATION ON JULY 20, 2011 FOR USE ON THIS PROJECT, INCLUDING ALL SUBSEQUENT REVISIONS AND SUCH REVISED SPECIFICATIONS AND SPECIAL PROVISIONS AS ARE INCORPORATED IN THESE PLANS.

QUALITY ASSURANCE PROGRAM : LEVEL 2

SURVEYED BY : VERMONT SURVEY & ENGINEERING, INC.  
 SURVEYED DATE : 11/2010

DATUM  
 VERTICAL NAVD 88 (GEOID 091) FT  
 HORIZONTAL NAD 83 (CORS) SPC (4400VT) SFT

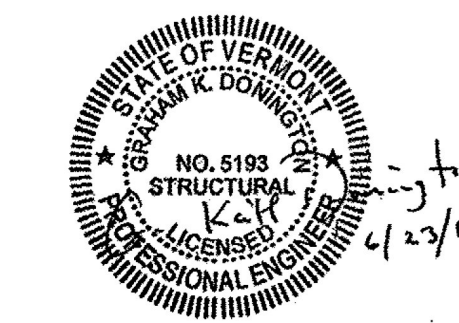

**PB** PARSONS BRINCKERHOFF  
 650 ELM STREET  
 MANCHESTER, NH 03101

DIRECTOR OF PROJECT DELIVERY  
 APPROVED: DATE 8-5-15  
 PROJECT MANAGER : TODD SUMNER P.E.  
 PROJECT NAME : **NEW HAVEN**  
 PROJECT NUMBER : **BRF 0183 (1)**  
 SHEET 1 OF 67 SHEETS