
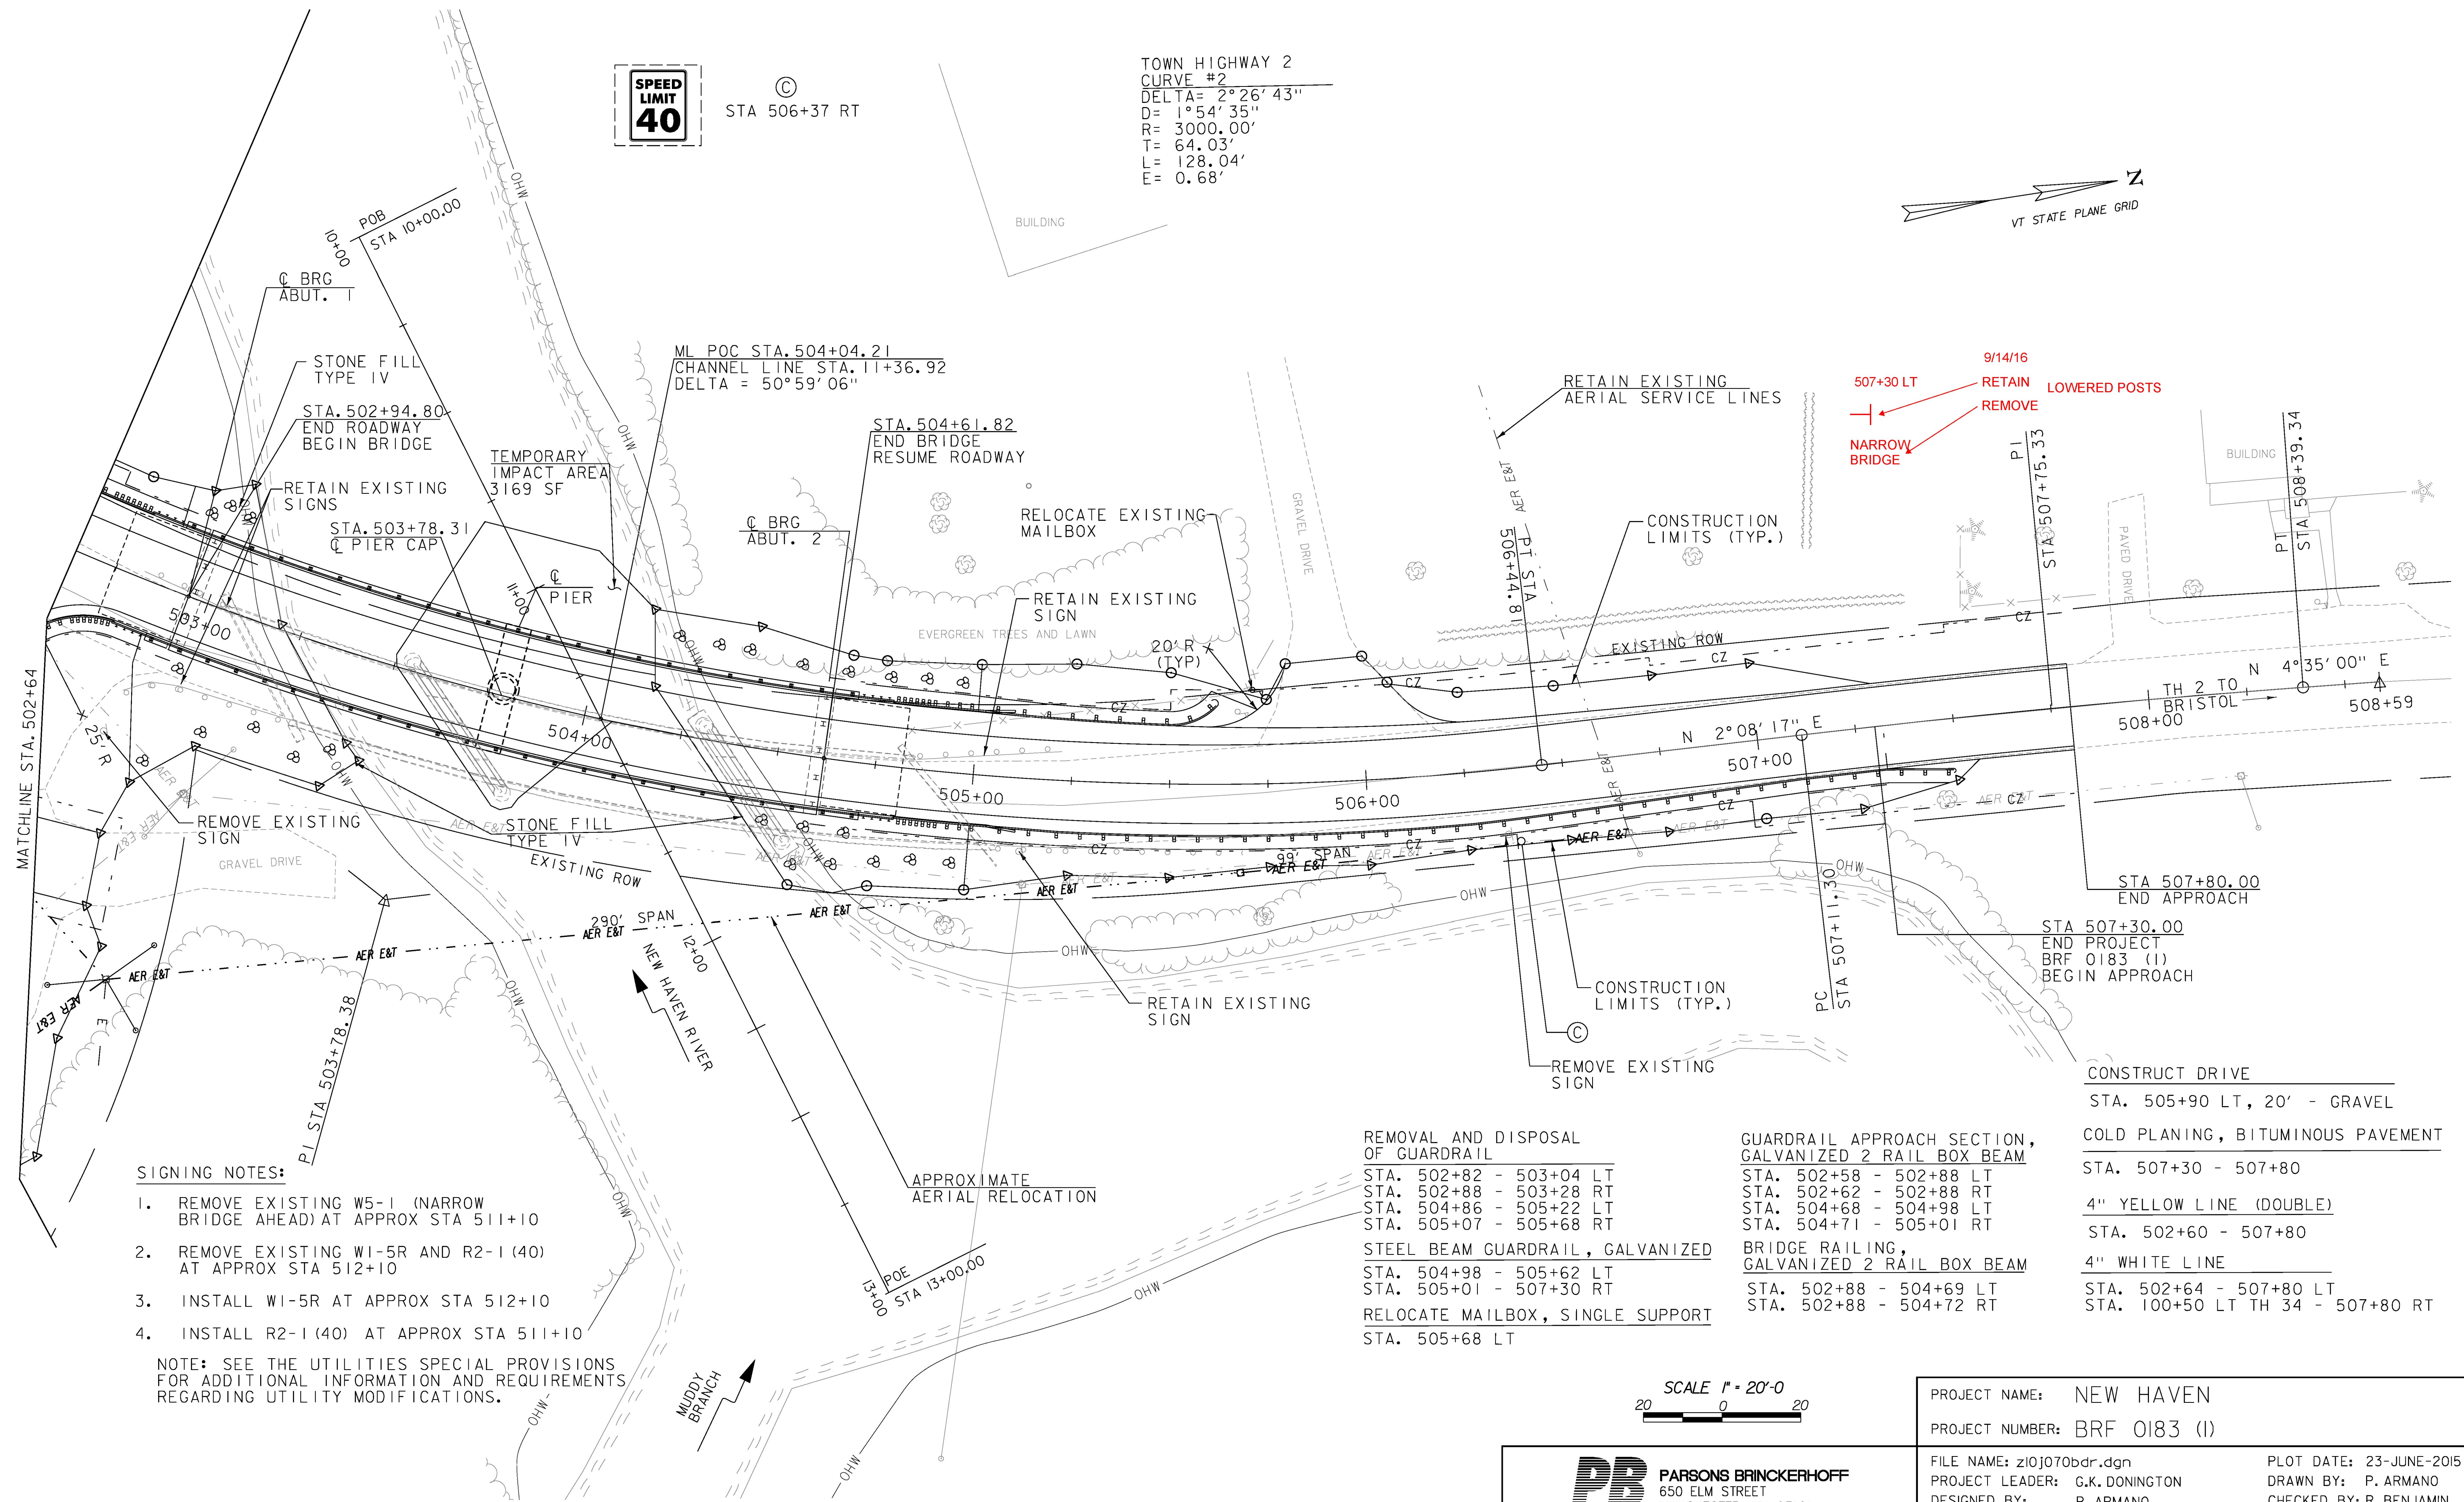


FOR STONE SWALE LOCATIONS SEE SHEET #26

SPEED LIMIT 40

© STA 506+37 RT

TOWN HIGHWAY 2
CURVE #2
DELTA = 2° 26' 43"
D = 1° 54' 35"
R = 3000.00'
T = 64.03'
L = 128.04'
E = 0.68'

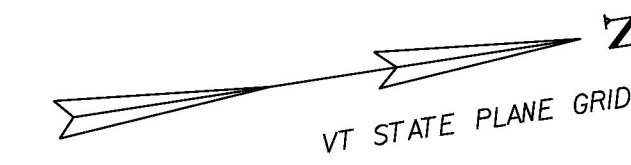

SIGNING NOTES:

1. REMOVE EXISTING W5-1 (NARROW BRIDGE AHEAD) AT APPROX STA 511+10
2. REMOVE EXISTING W1-5R AND R2-1 (40) AT APPROX STA 512+10
3. INSTALL W1-5R AT APPROX STA 512+10
4. INSTALL R2-1 (40) AT APPROX STA 511+10

NOTE: SEE THE UTILITIES SPECIAL PROVISIONS FOR ADDITIONAL INFORMATION AND REQUIREMENTS REGARDING UTILITY MODIFICATIONS.

REMOVAL AND DISPOSAL OF GUARDRAIL

- STA. 502+82 - 503+04 LT
- STA. 502+88 - 503+28 RT
- STA. 504+86 - 505+22 LT
- STA. 505+07 - 505+68 RT

STEEL BEAM GUARDRAIL, GALVANIZED

- STA. 504+98 - 505+62 LT
- STA. 505+01 - 507+30 RT

RELOCATE MAILBOX, SINGLE SUPPORT

- STA. 505+68 LT

GUARDRAIL APPROACH SECTION, GALVANIZED 2 RAIL BOX BEAM

- STA. 502+58 - 502+88 LT
- STA. 502+62 - 502+88 RT
- STA. 504+68 - 504+98 LT
- STA. 504+71 - 505+01 RT

BRIDGE RAILING, GALVANIZED 2 RAIL BOX BEAM

- STA. 502+88 - 504+69 LT
- STA. 502+88 - 504+72 RT

CONSTRUCT DRIVE

- STA. 505+90 LT, 20' - GRAVEL
- COLD PLANING, BITUMINOUS PAVEMENT
- STA. 507+30 - 507+80
- 4" YELLOW LINE (DOUBLE)
- STA. 502+60 - 507+80
- 4" WHITE LINE
- STA. 502+64 - 507+80 LT
- STA. 100+50 LT TH 34 - 507+80 RT

SCALE 1" = 20'-0"
20 0 20



PROJECT NAME: NEW HAVEN
PROJECT NUMBER: BRF 0183 (I)

FILE NAME: z10j070bdr.dgn
PROJECT LEADER: G.K. DONINGTON
DESIGNED BY: P. ARMANO
LAYOUT SHEET (2)

PLOT DATE: 23-JUNE-2015
DRAWN BY: P. ARMANO
CHECKED BY: R. BENJAMIN
SHEET 14 OF 67