


PROFILE: RIVER ROAD (TH 2)



THE GRADES SHOWN TO THE NEAREST TENTH ARE THE ORIGINAL GROUND ELEVATIONS ALONG THE PROPOSED ALIGNMENT AT THE CENTERLINE.  
THE GRADES SHOWN TO THE NEAREST HUNDREDTH ARE THE FINISH GRADES ALONG THE PROPOSED ALIGNMENT AT CENTERLINE.

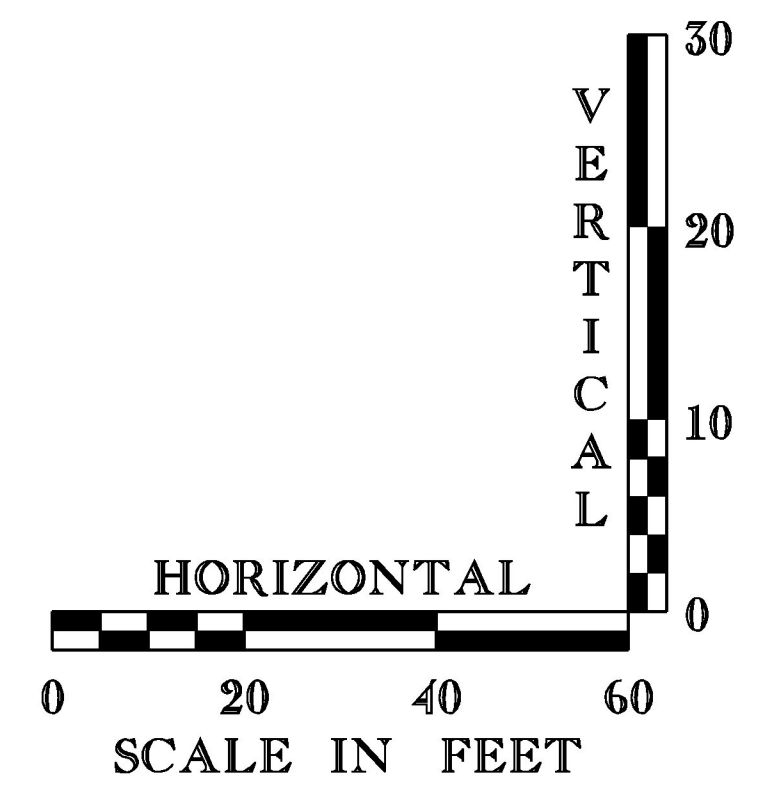

PROJECT NAME: NEW HAVEN  
PROJECT NUMBER: BRF 0183 (I)

FILE NAME: z10j070Pro.dgn  
PROJECT LEADER: G.K. DONINGTON  
DESIGNED BY: P. ARMANO  
PROFILE SHEET (I)

PLOT DATE: 23-JUNE-2015  
DRAWN BY: P. ARMANO  
CHECKED BY: R. BENJAMIN  
SHEET 15 OF 67