


PROFILE: RIVER ROAD (TH 2)



THE GRADES SHOWN TO THE NEAREST TENTH ARE THE ORIGINAL GROUND ELEVATIONS ALONG THE PROPOSED ALIGNMENT AT THE CENTERLINE.
 THE GRADES SHOWN TO THE NEAREST HUNDREDTH ARE THE FINISH GRADES ALONG THE PROPOSED ALIGNMENT AT CENTERLINE.

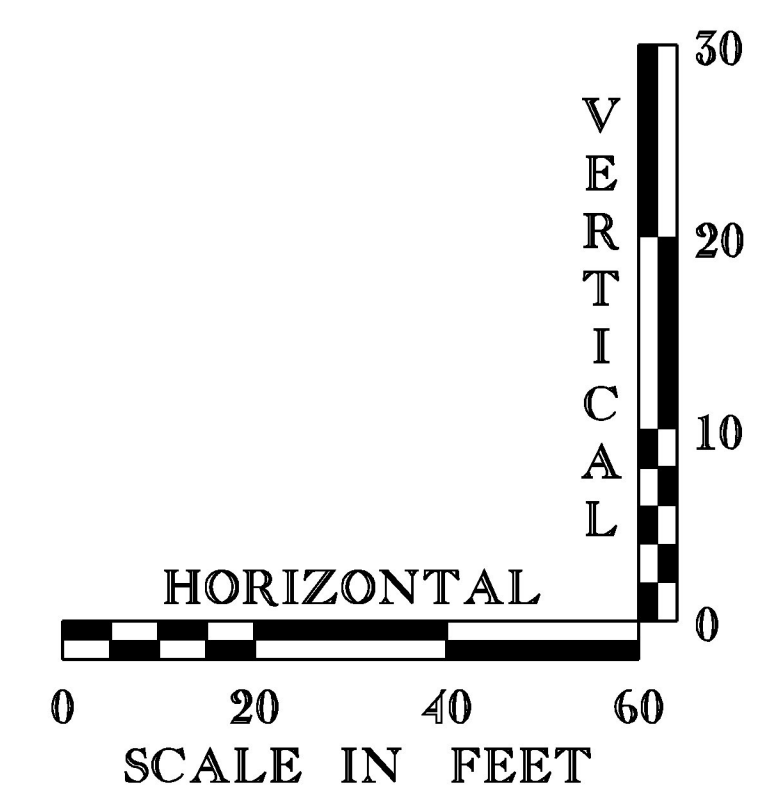

PROJECT NAME:	NEW HAVEN	FILE NAME:	z10j070Pro.dgn	PLOT DATE:	23-JUNE-2015
PROJECT NUMBER:	BRF 0183 (I)	PROJECT LEADER:	G.K. DONINGTON	DRAWN BY:	P. ARMANO
		DESIGNED BY:	P. ARMANO	CHECKED BY:	R. BENJAMIN
		PROFILE SHEET (2)		SHEET 16	OF 67