
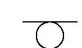





LEGEND

-  TYPE III BARRICADE
-  CONSTRUCTION SIGN
-  WORK ZONE
-  TEMPORARY TRAFFIC BARRIER
-  FLOW OF TRAFFIC

PB PARSONS BRINCKERHOFF
 650 ELM STREET
 MANCHESTER, NH 03101

SCALE 1" = 20'-0"
 20 0 20

| | |
|--------------------------------|-------------------------|
| PROJECT NAME: NEW HAVEN | PLOT DATE: 23-JUNE-2015 |
| PROJECT NUMBER: BRF 0183 (I) | DRAWN BY: |
| FILE NAME: z10j070+cs.dgn | CHECKED BY: |
| PROJECT LEADER: G.K. DONINGTON | SHEET 19 OF 67 |
| DESIGNED BY: | |
| TRAFFIC CONTROL SHEET (2) | |