


PLAN

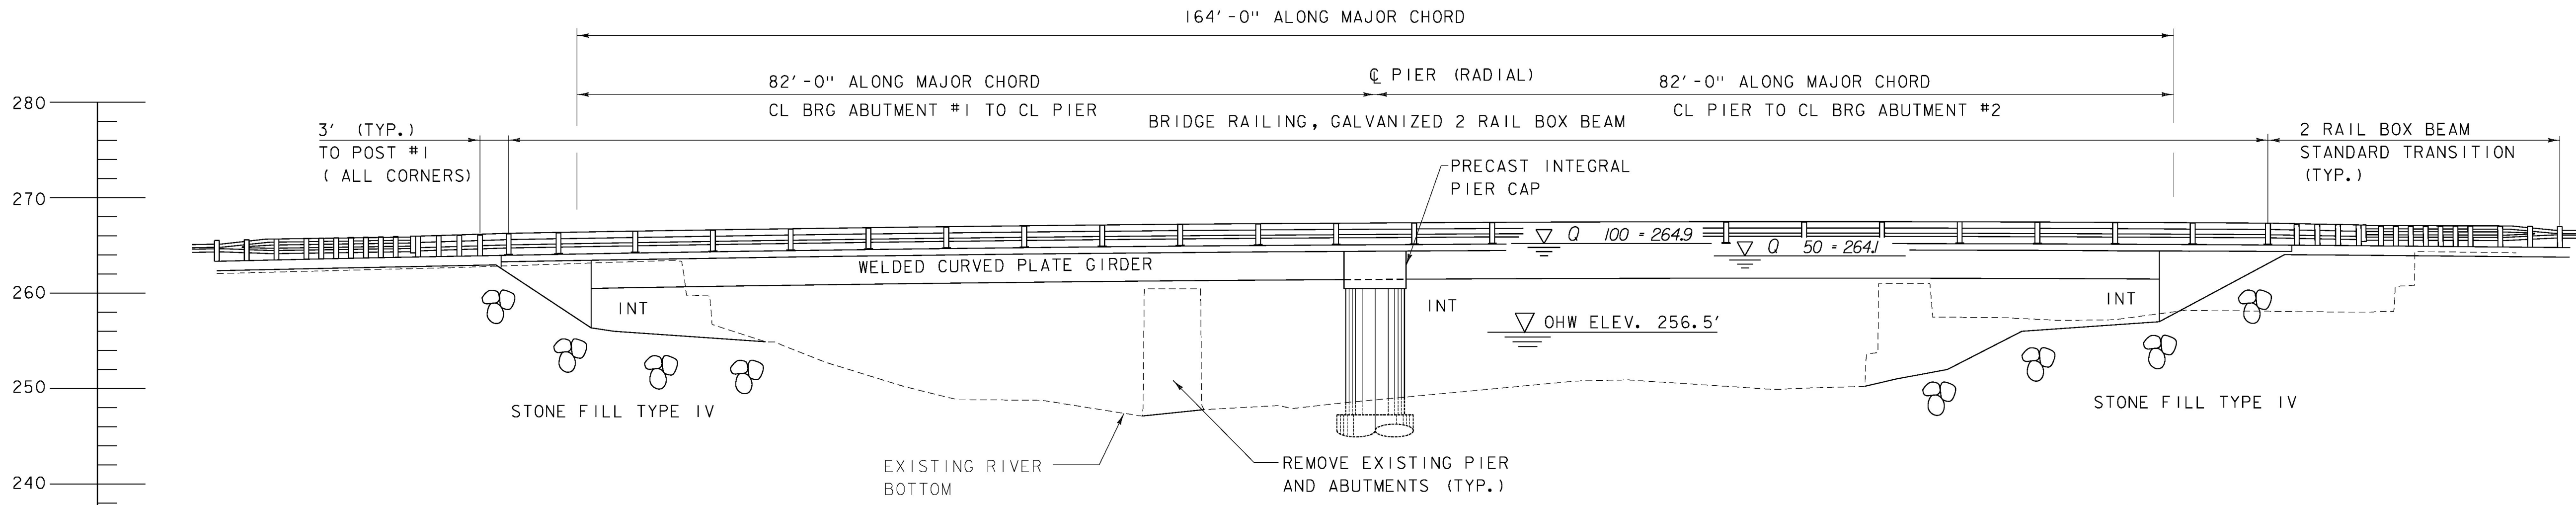

ELEVATION

<p><b>PARSONS BRINCKERHOFF</b> 650 ELM STREET MANCHESTER, NH 03101</p>	<p>PROJECT NAME: NEW HAVEN</p> <p>PROJECT NUMBER: BRF 0183 (I)</p>	<p>FILE NAME: z10j070Spe.dgn</p> <p>PROJECT LEADER: G.K. DONINGTON</p> <p>DESIGNED BY: R. GAUDREAU</p> <p>PLAN AND ELEVATION SHEET</p>	<p>PLOT DATE: 23-JUNE-2015</p> <p>DRAWN BY: W. GERHOLD</p> <p>CHECKED BY: A. STOCKIN</p> <p>SHEET 26 OF 67</p>
	<p>SCALE 1" = 10'-0"</p>		