
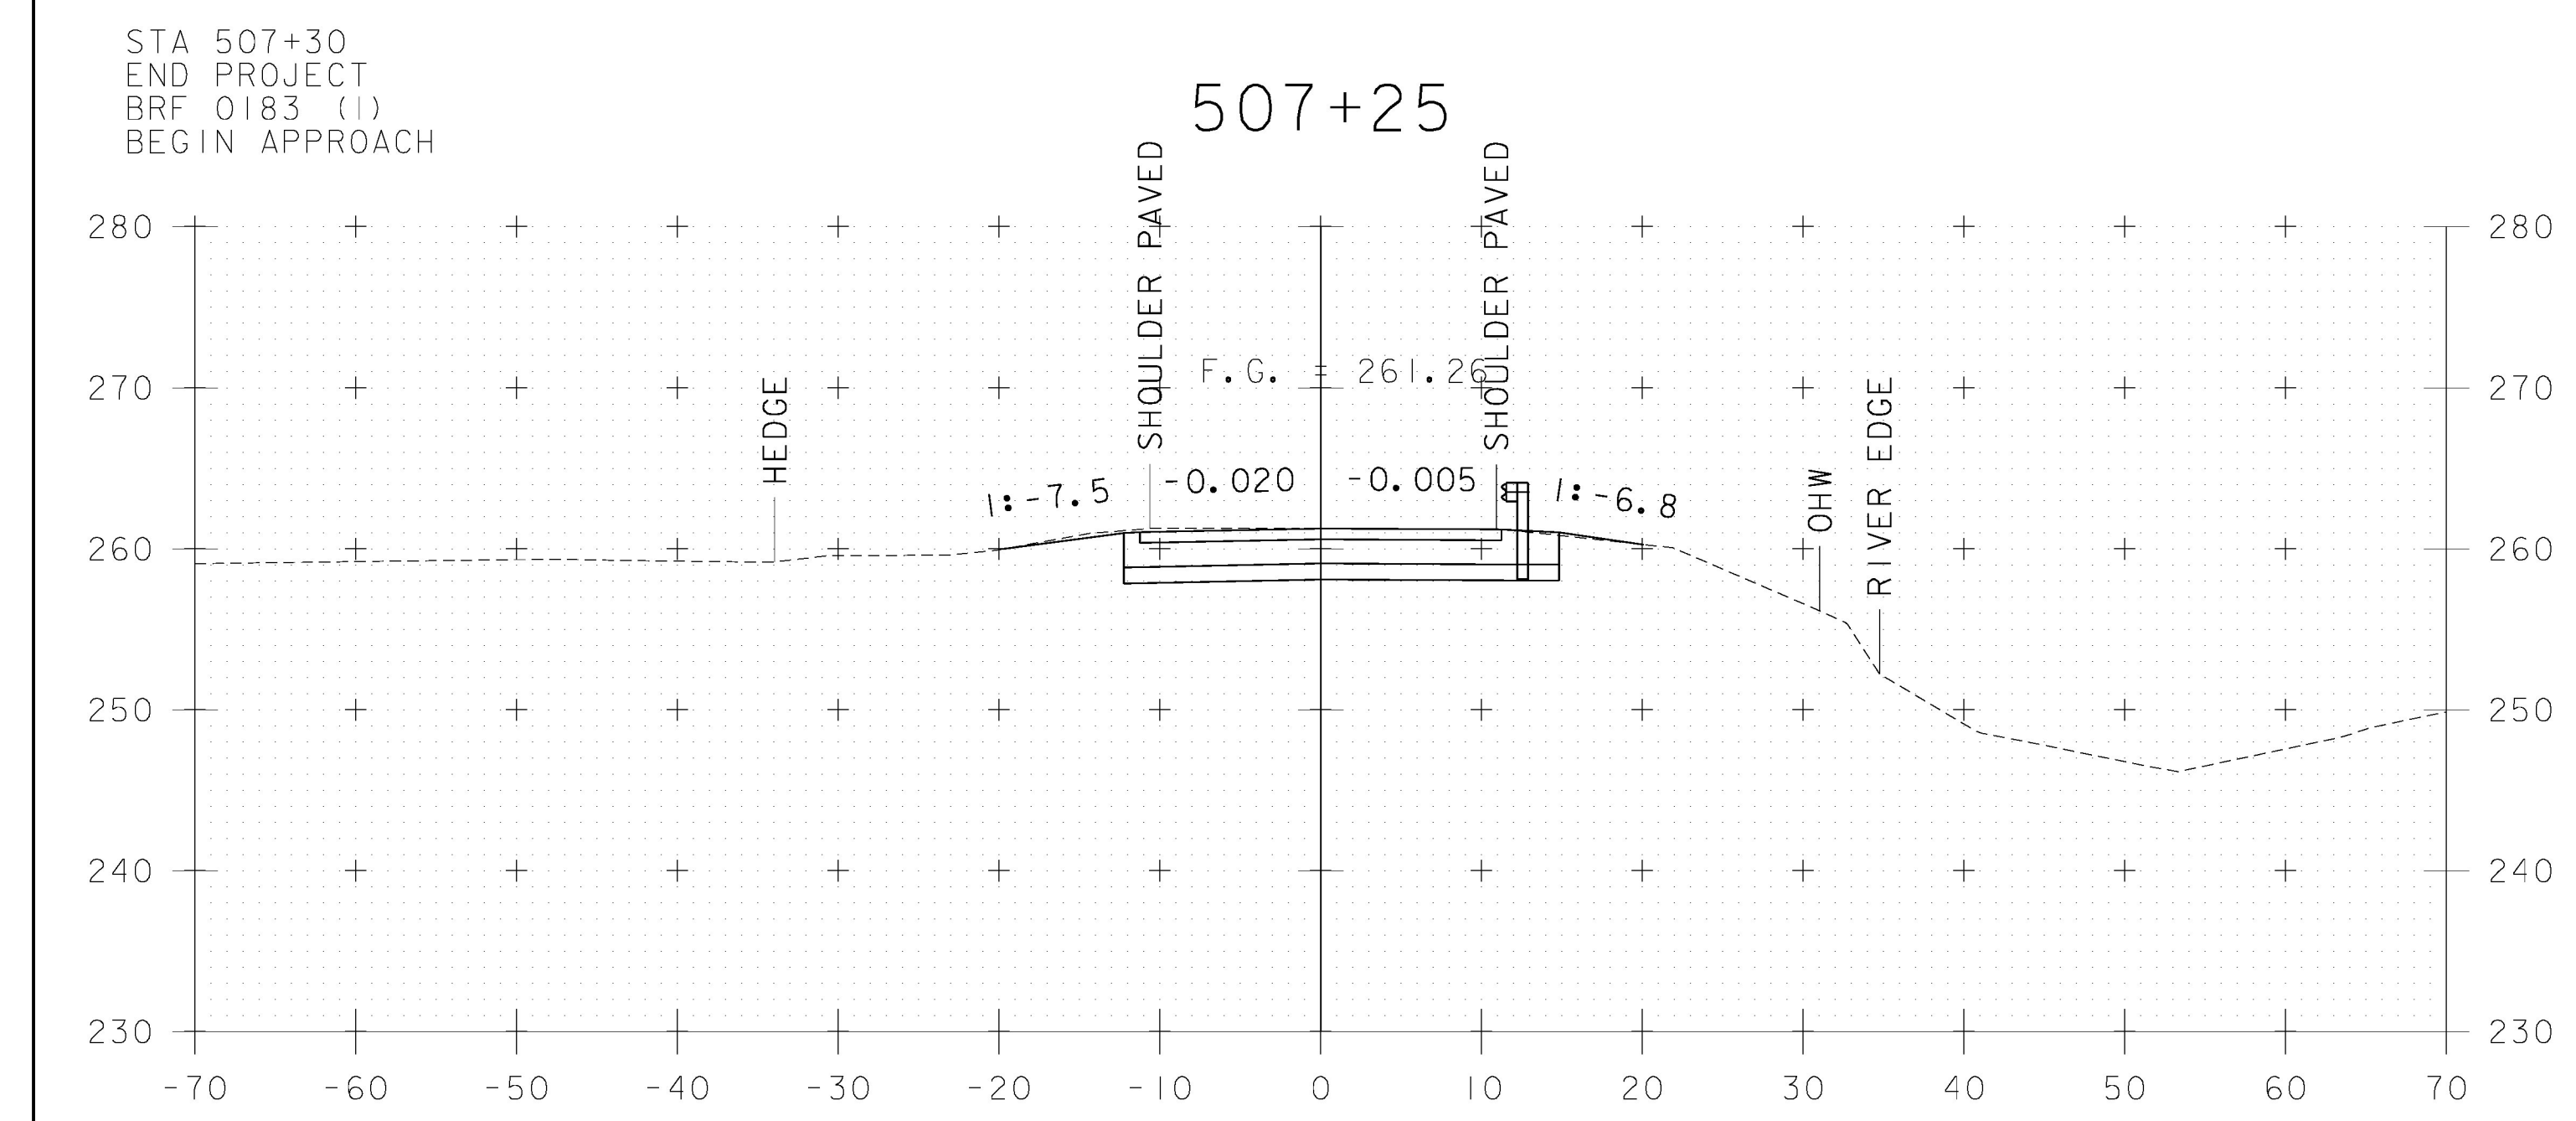


507+50 **STA. 507+00 - STA. 508+00**

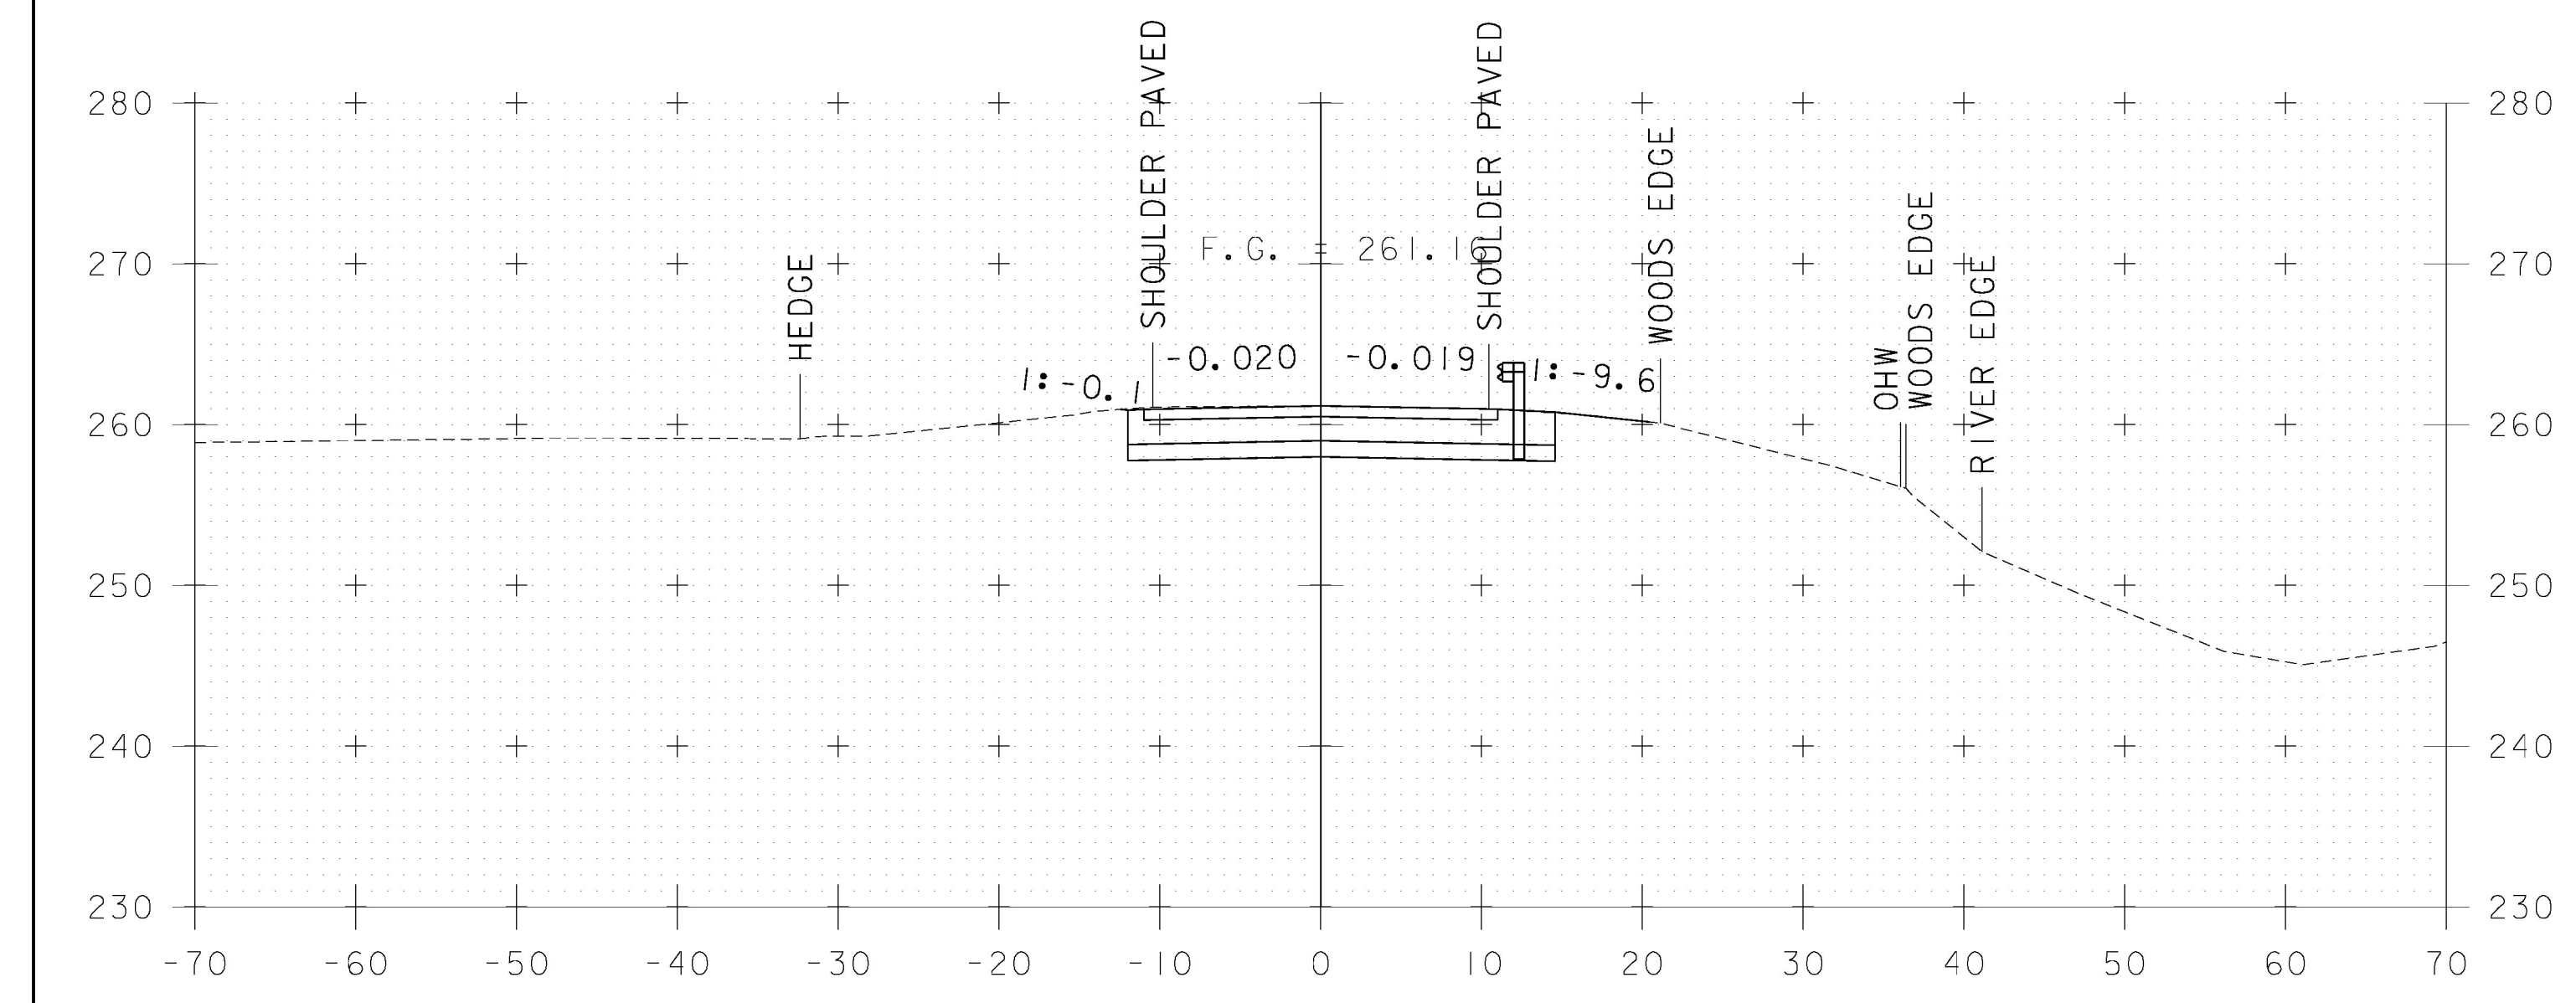

507+00

STA 507+30
END PROJECT
BRF 0183 (1)
BEGIN APPROACH

STA 507+80
END APPROACH
MATCH EXISTING CROSS-SLOPES

SCALE 1" = 10'-0"
10 0 10

PROJECT NAME:	NEW HAVEN	PLOT DATE:	23-JUNE-2015
PROJECT NUMBER:	BRF 0183 (1)	DRAWN BY:	P ARMANO
FILE NAME:	z10j070xsl.dgn	CHECKED BY:	R BENJAMIN
PROJECT LEADER:	G.K. DONINGTON	SHEET	50 OF 67
DESIGNED BY:	P ARMANO		
MAINLINE CROSS SECTIONS			