


STA 103+25
LIMIT OF CONSTRUCTION
MATCH EXISTING CROSS-SLOPES

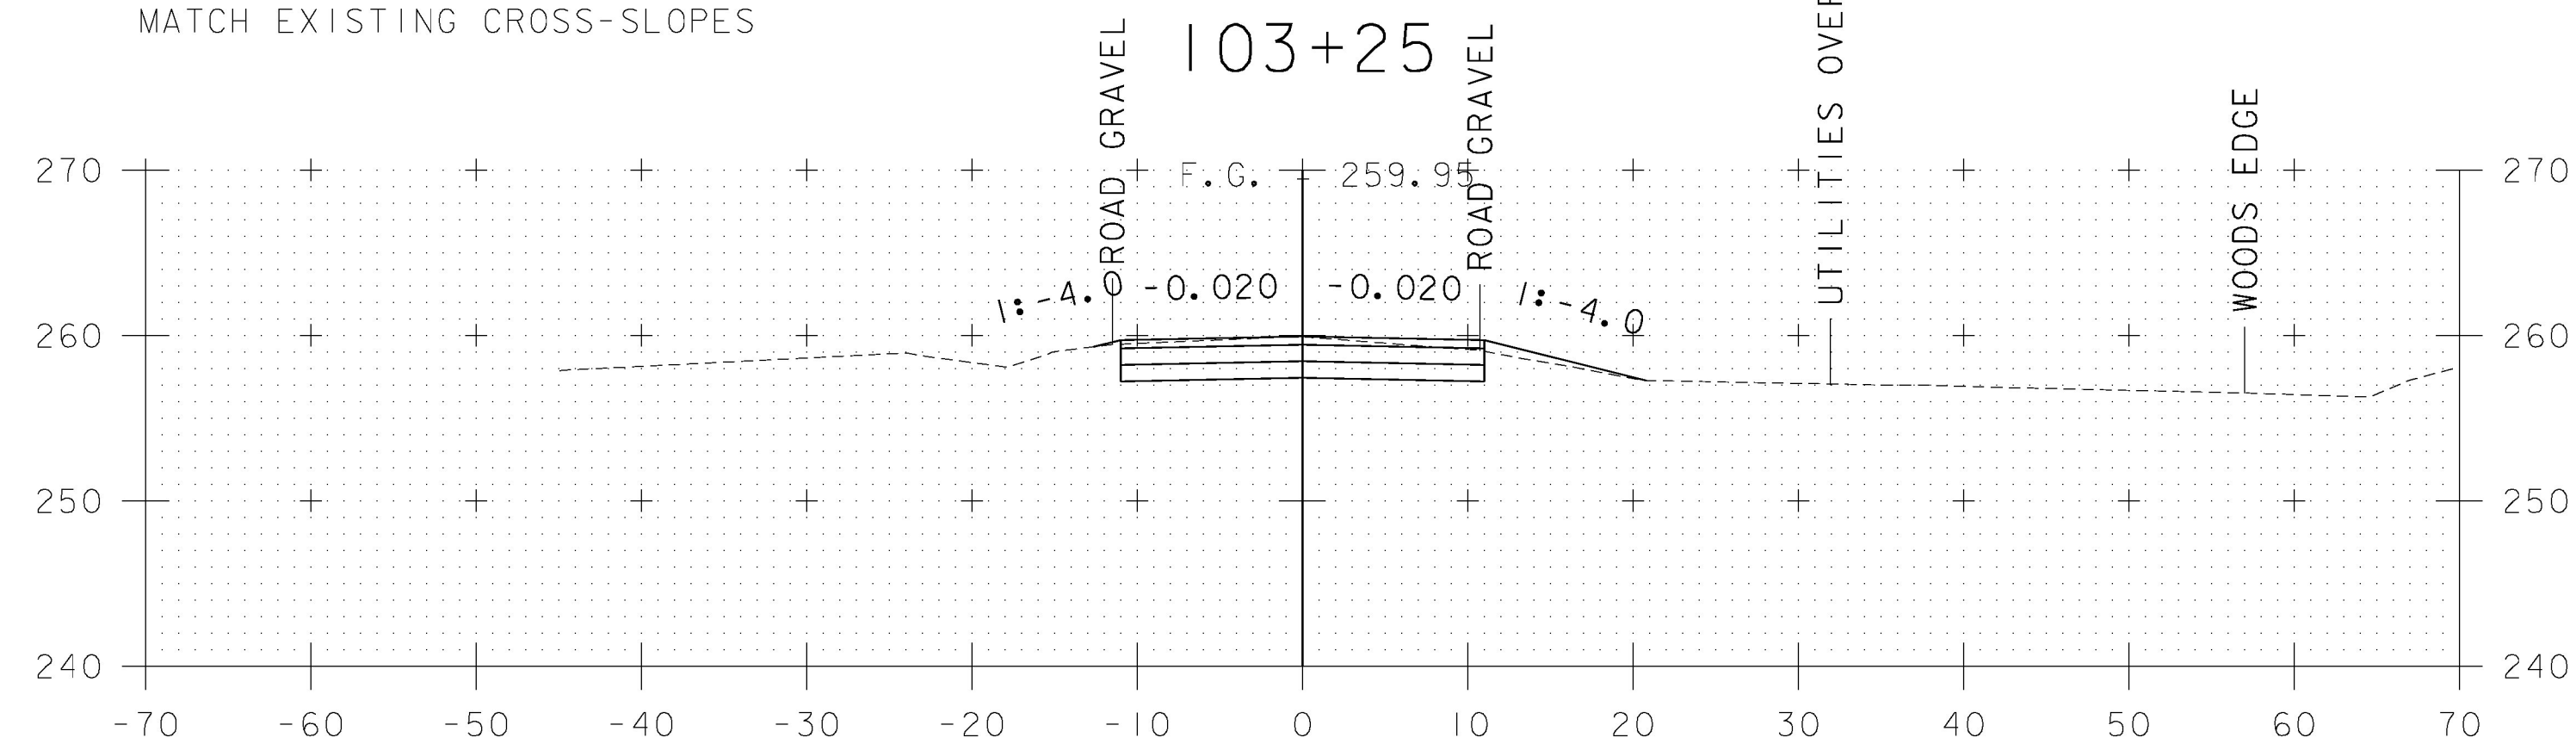

103+00

SCALE 1" = 10'-0"
10 0 10

STA. 103+00 - STA. 103+38

PROJECT NAME: NEW HAVEN

PROJECT NUMBER: BRF 0183 (I)

FILE NAME: z10j070xsl.dgn

PROJECT LEADER: G.K. DONINGTON

DESIGNED BY: P ARMANO

HALPIN ROAD CROSS SECTIONS

PLOT DATE: 23-JUNE-2015

DRAWN BY: P ARMANO

CHECKED BY: R BENJAMIN

SHEET 53 OF 67