



BANKING DIAGRAM

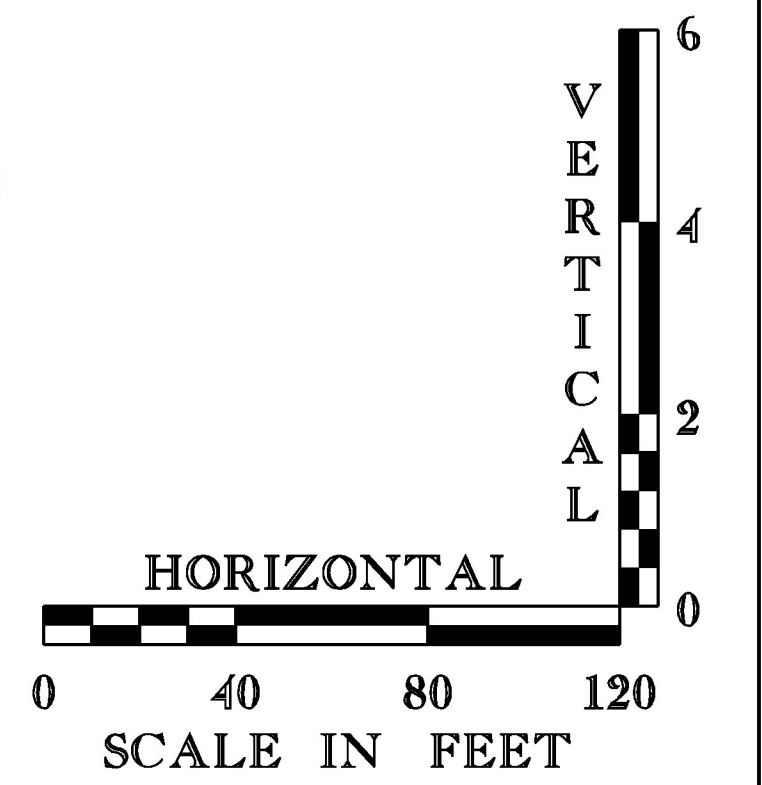

MATERIAL TRANSITION

PROJECT NAME: NEW HAVEN
 PROJECT NUMBER: BRF 0183 (I)

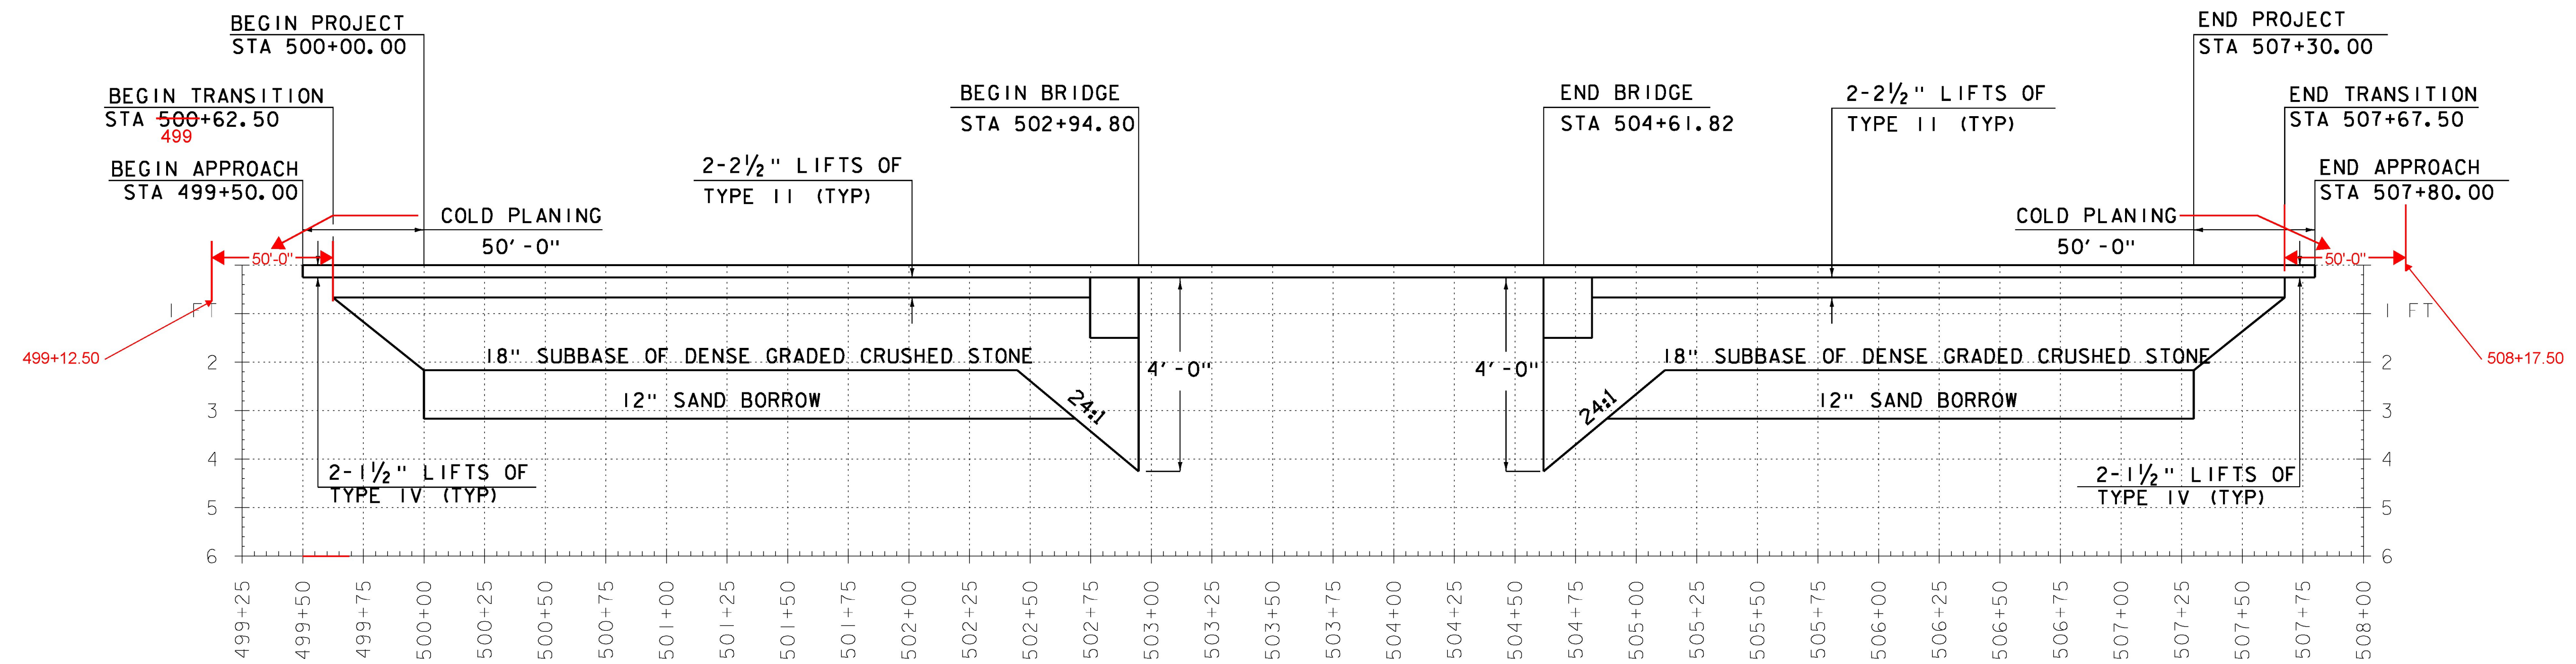

FILE NAME: z10j070xs2.dgn
 PROJECT LEADER: G.K. DONINGTON
 DESIGNED BY: P. ARMANO
 BANKING DIAGRAM & MATERIAL TRANSITION

PLOT DATE: 23-JUNE-2015
 DRAWN BY: P. ARMANO
 CHECKED BY: R. BENJAMIN
 SHEET 54 OF 67