




10+50

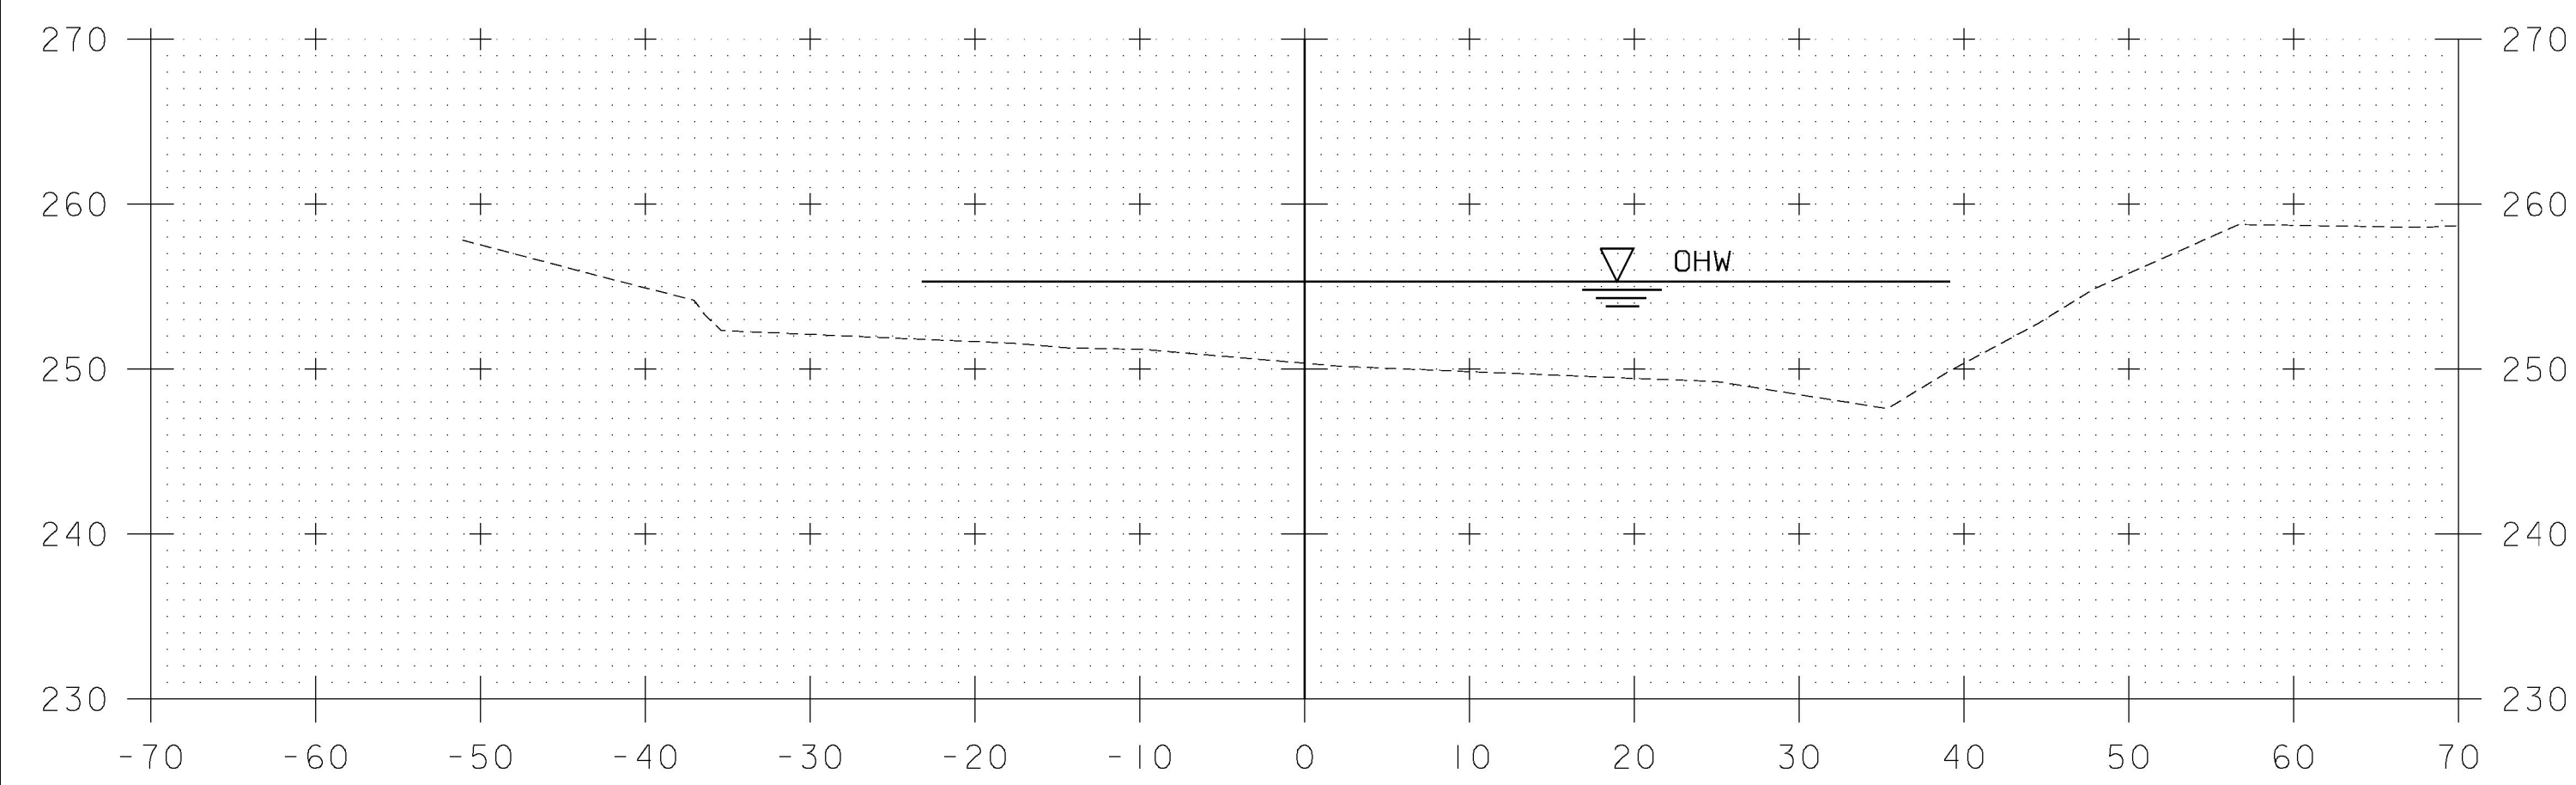


10+25

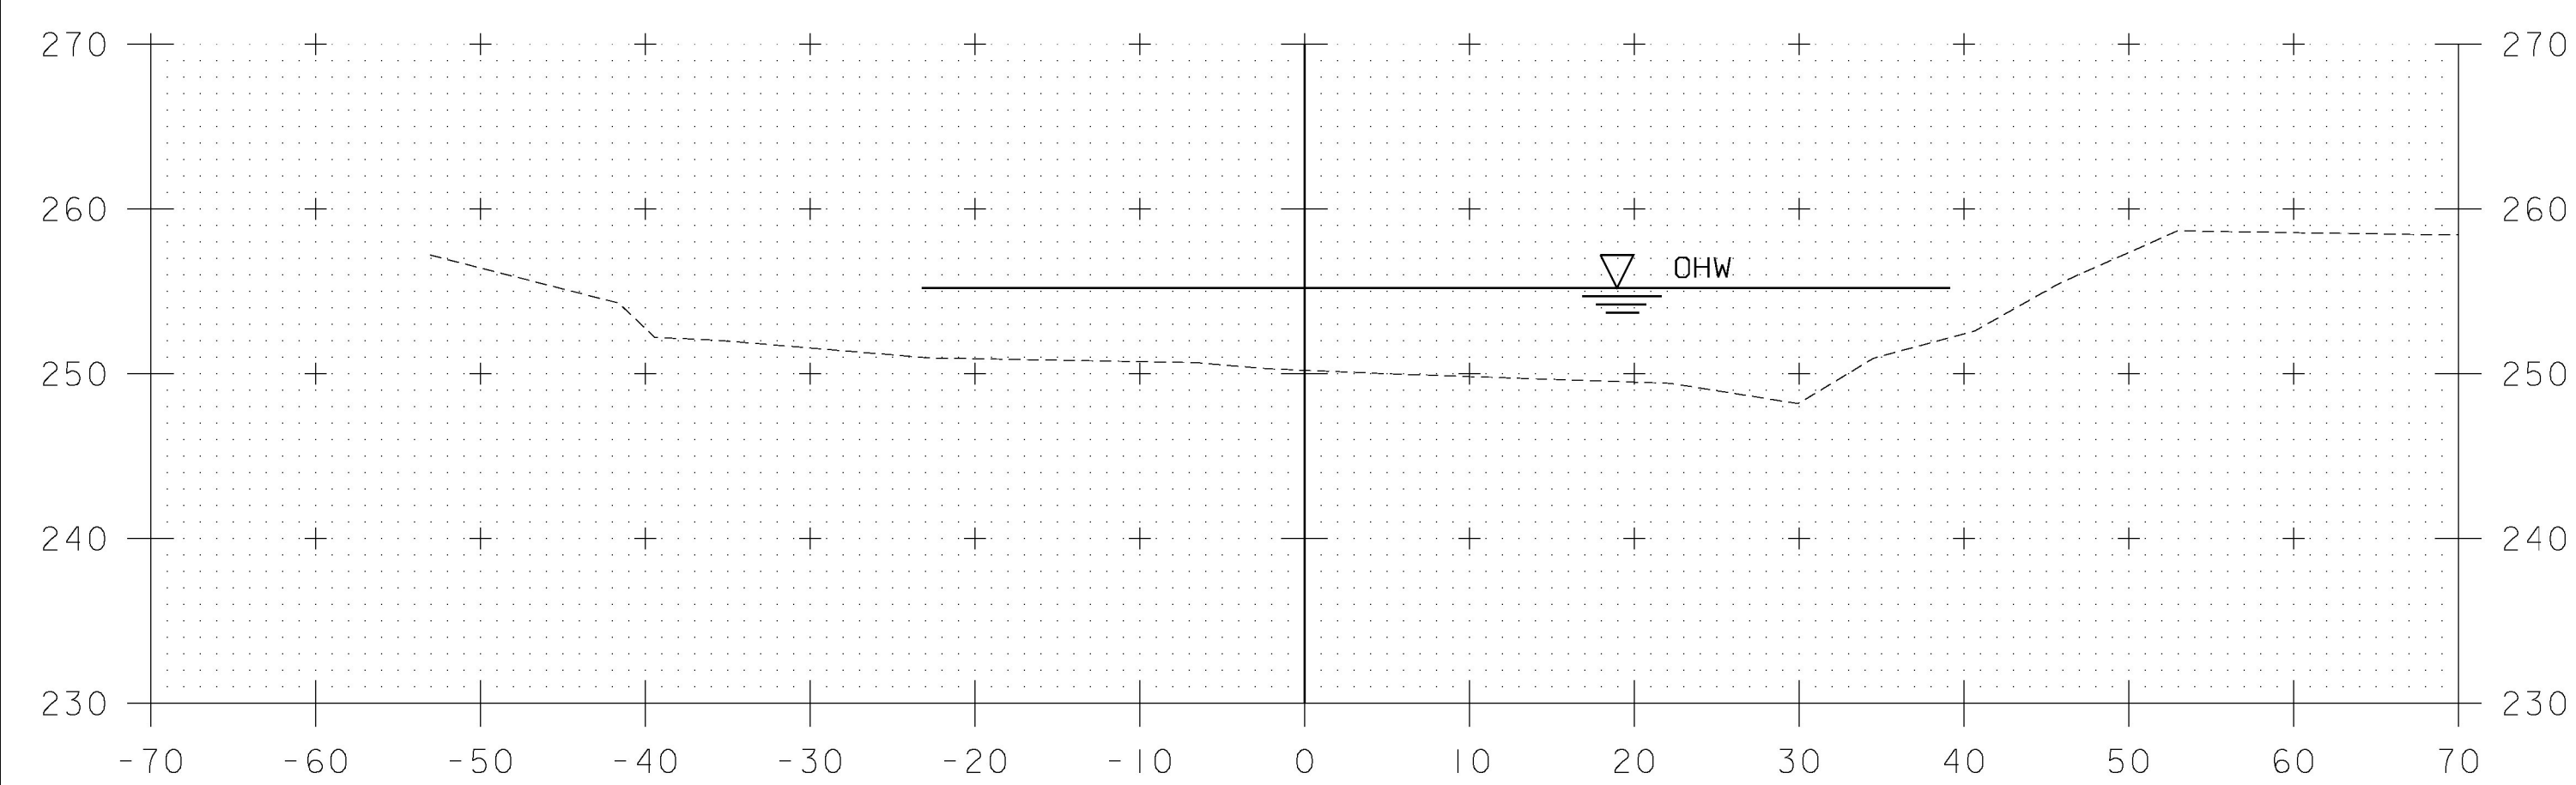

10+00

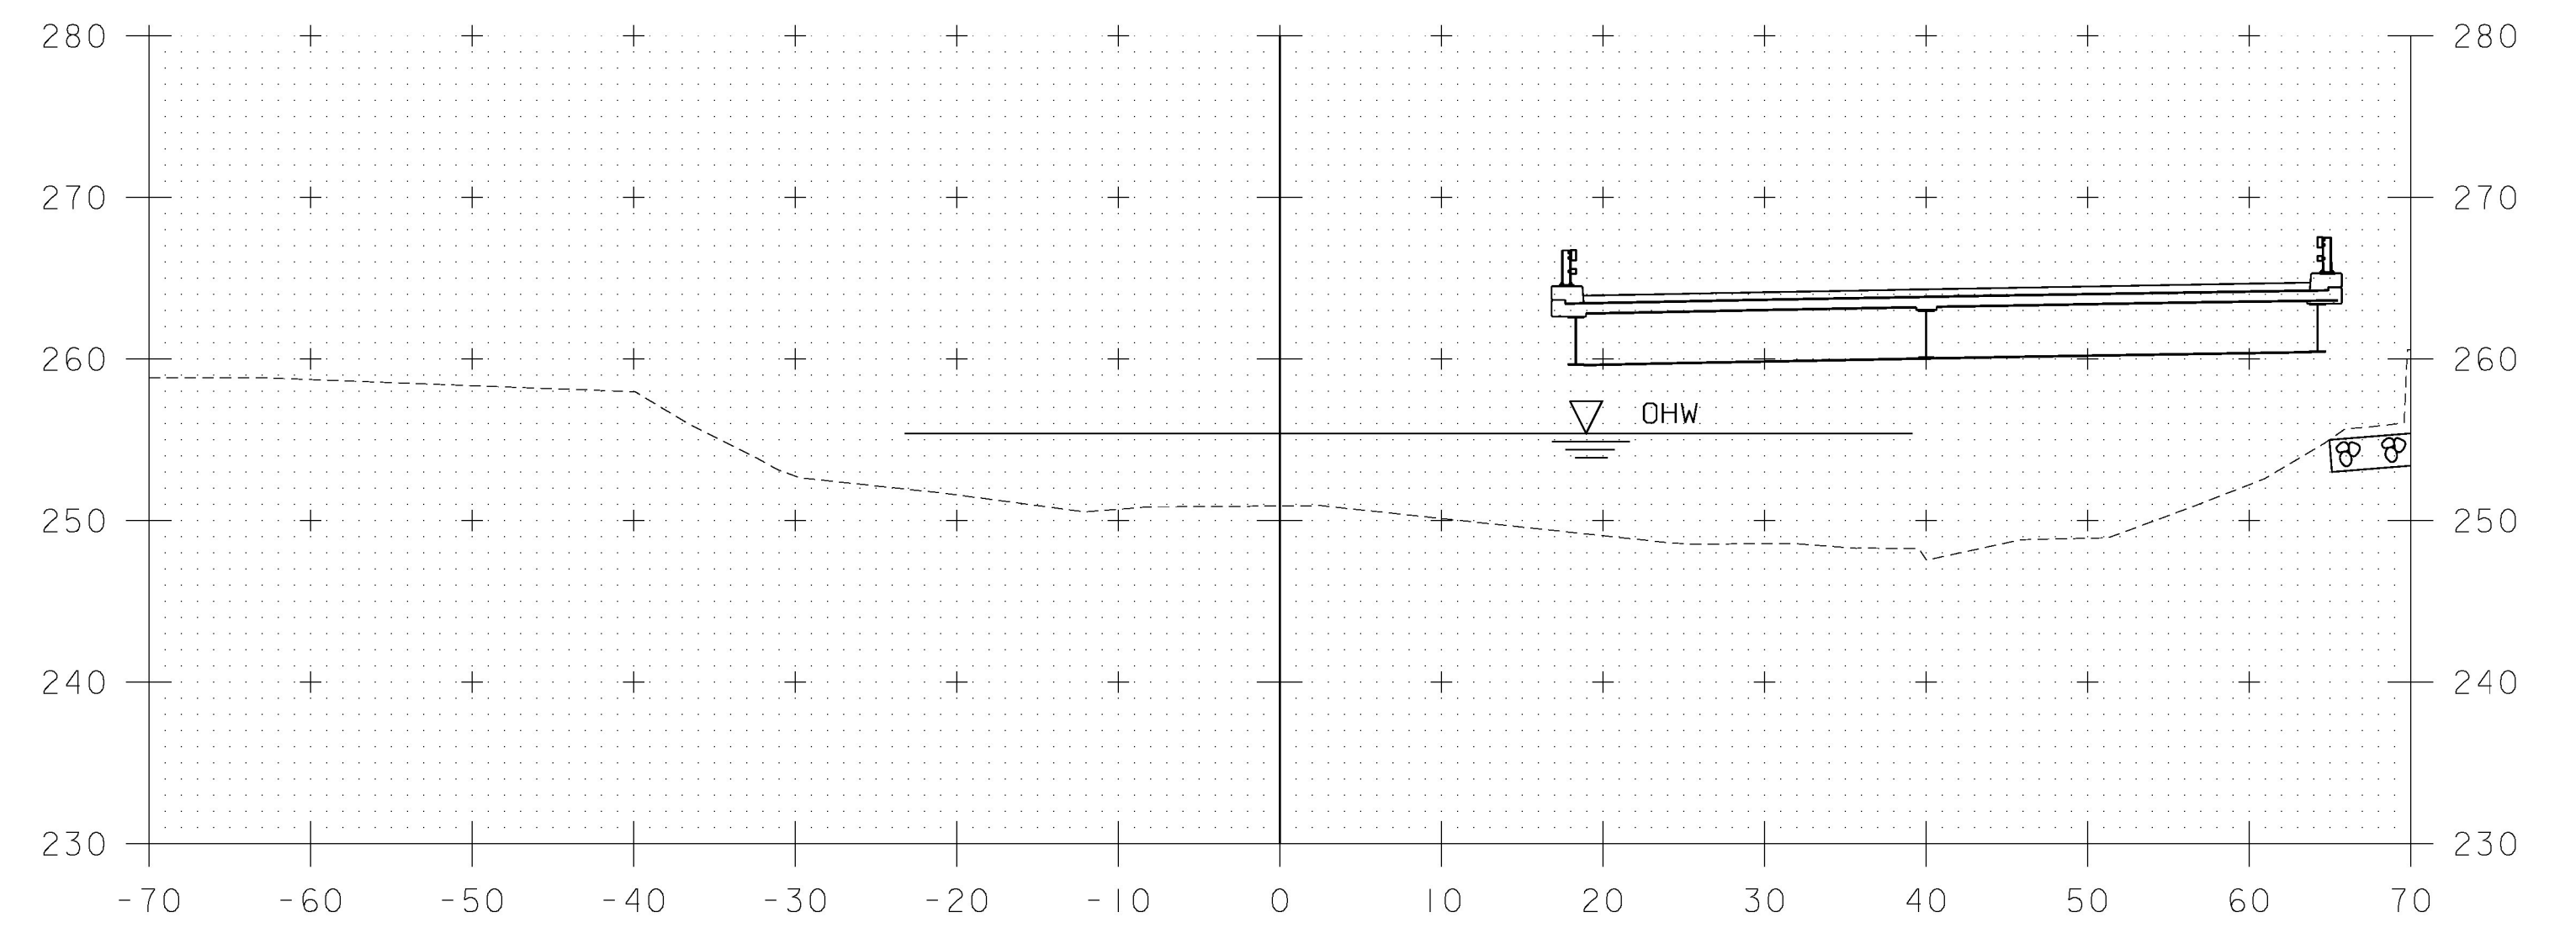

11+00

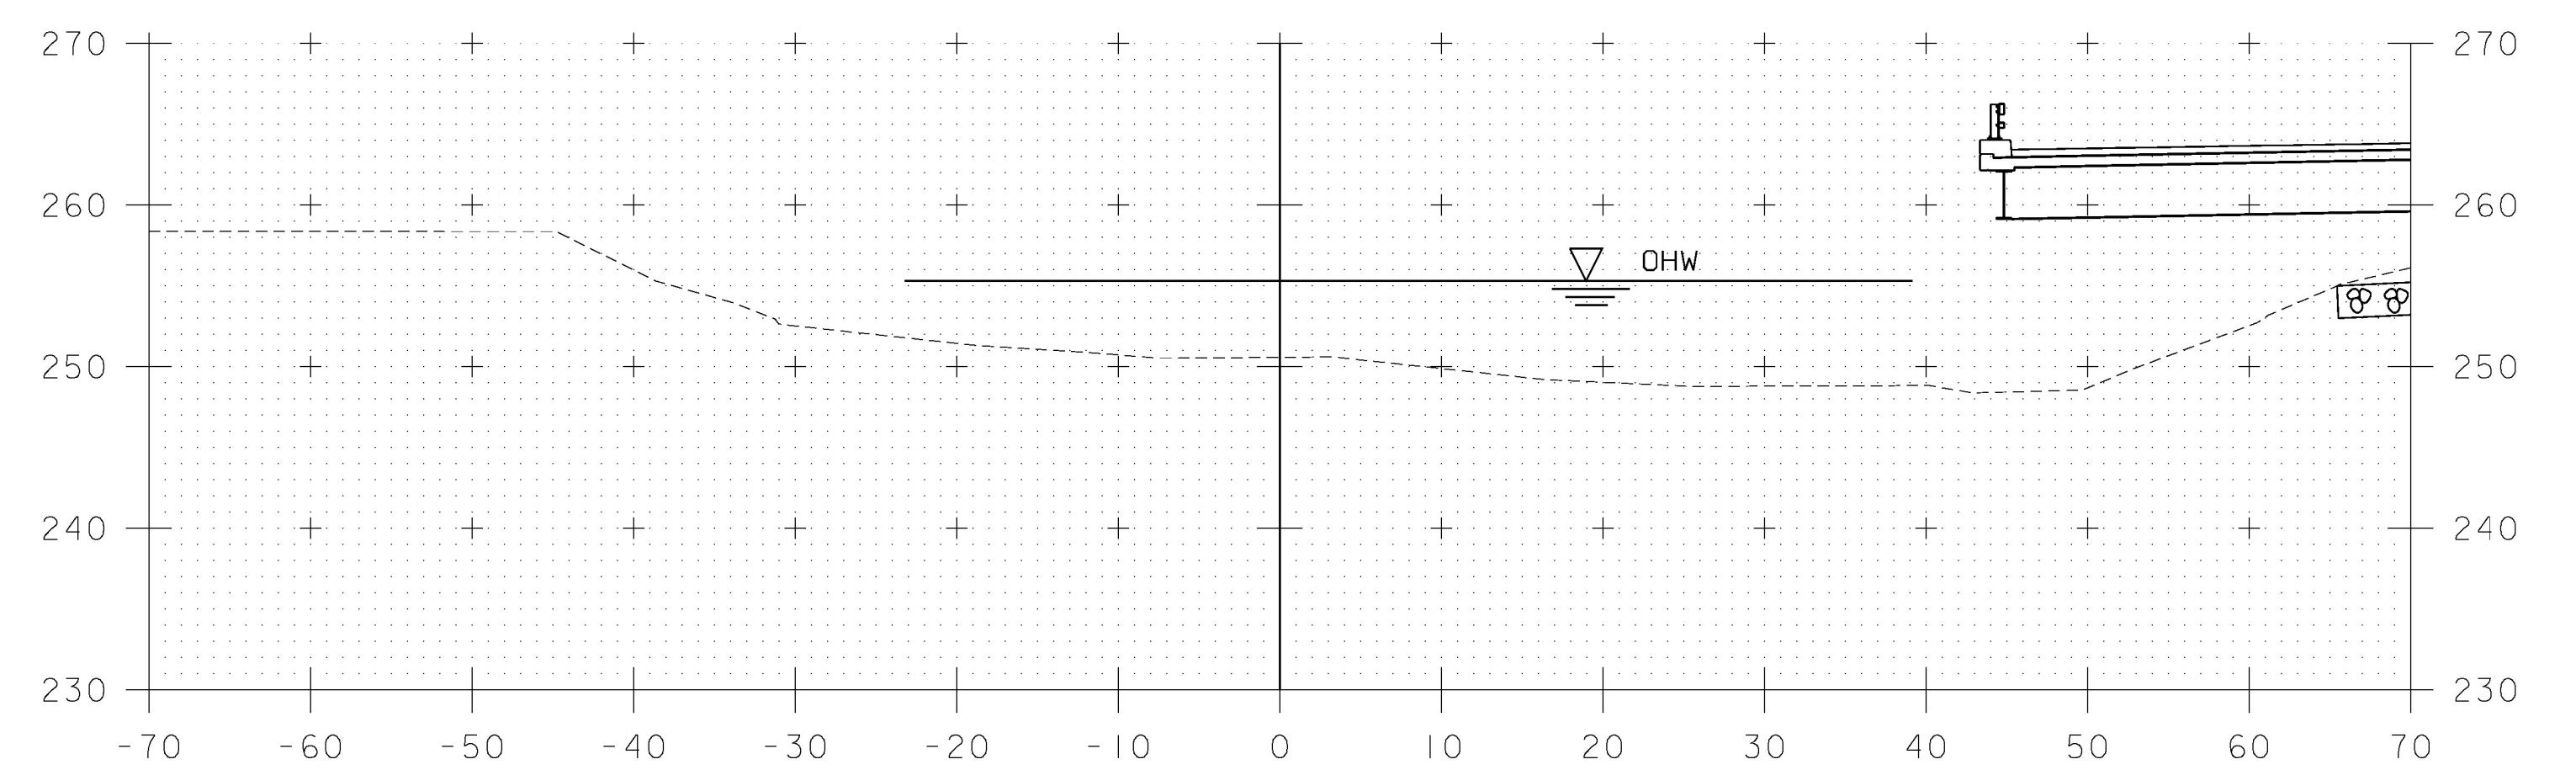

10+75

STA. 10+00 - STA. 11+00

SCALE 1" = 10'-0"

PROJECT NAME: NEW HAVEN	PLOT DATE: 23-JUNE-2015
PROJECT NUMBER: BRF 0183 (I)	DRAWN BY: P ARMANO
FILE NAME: z10j070xsl.dgn	CHECKED BY: R BENJAMIN
PROJECT LEADER: G.K. DONINGTON	SHEET 55 OF 67
DESIGNED BY: P ARMANO	
CHANNEL CROSS SECTIONS	