




1 PRECAST ABUTMENT PLAN VIEW IN FORM
ABI
3/8" = 1'-0"

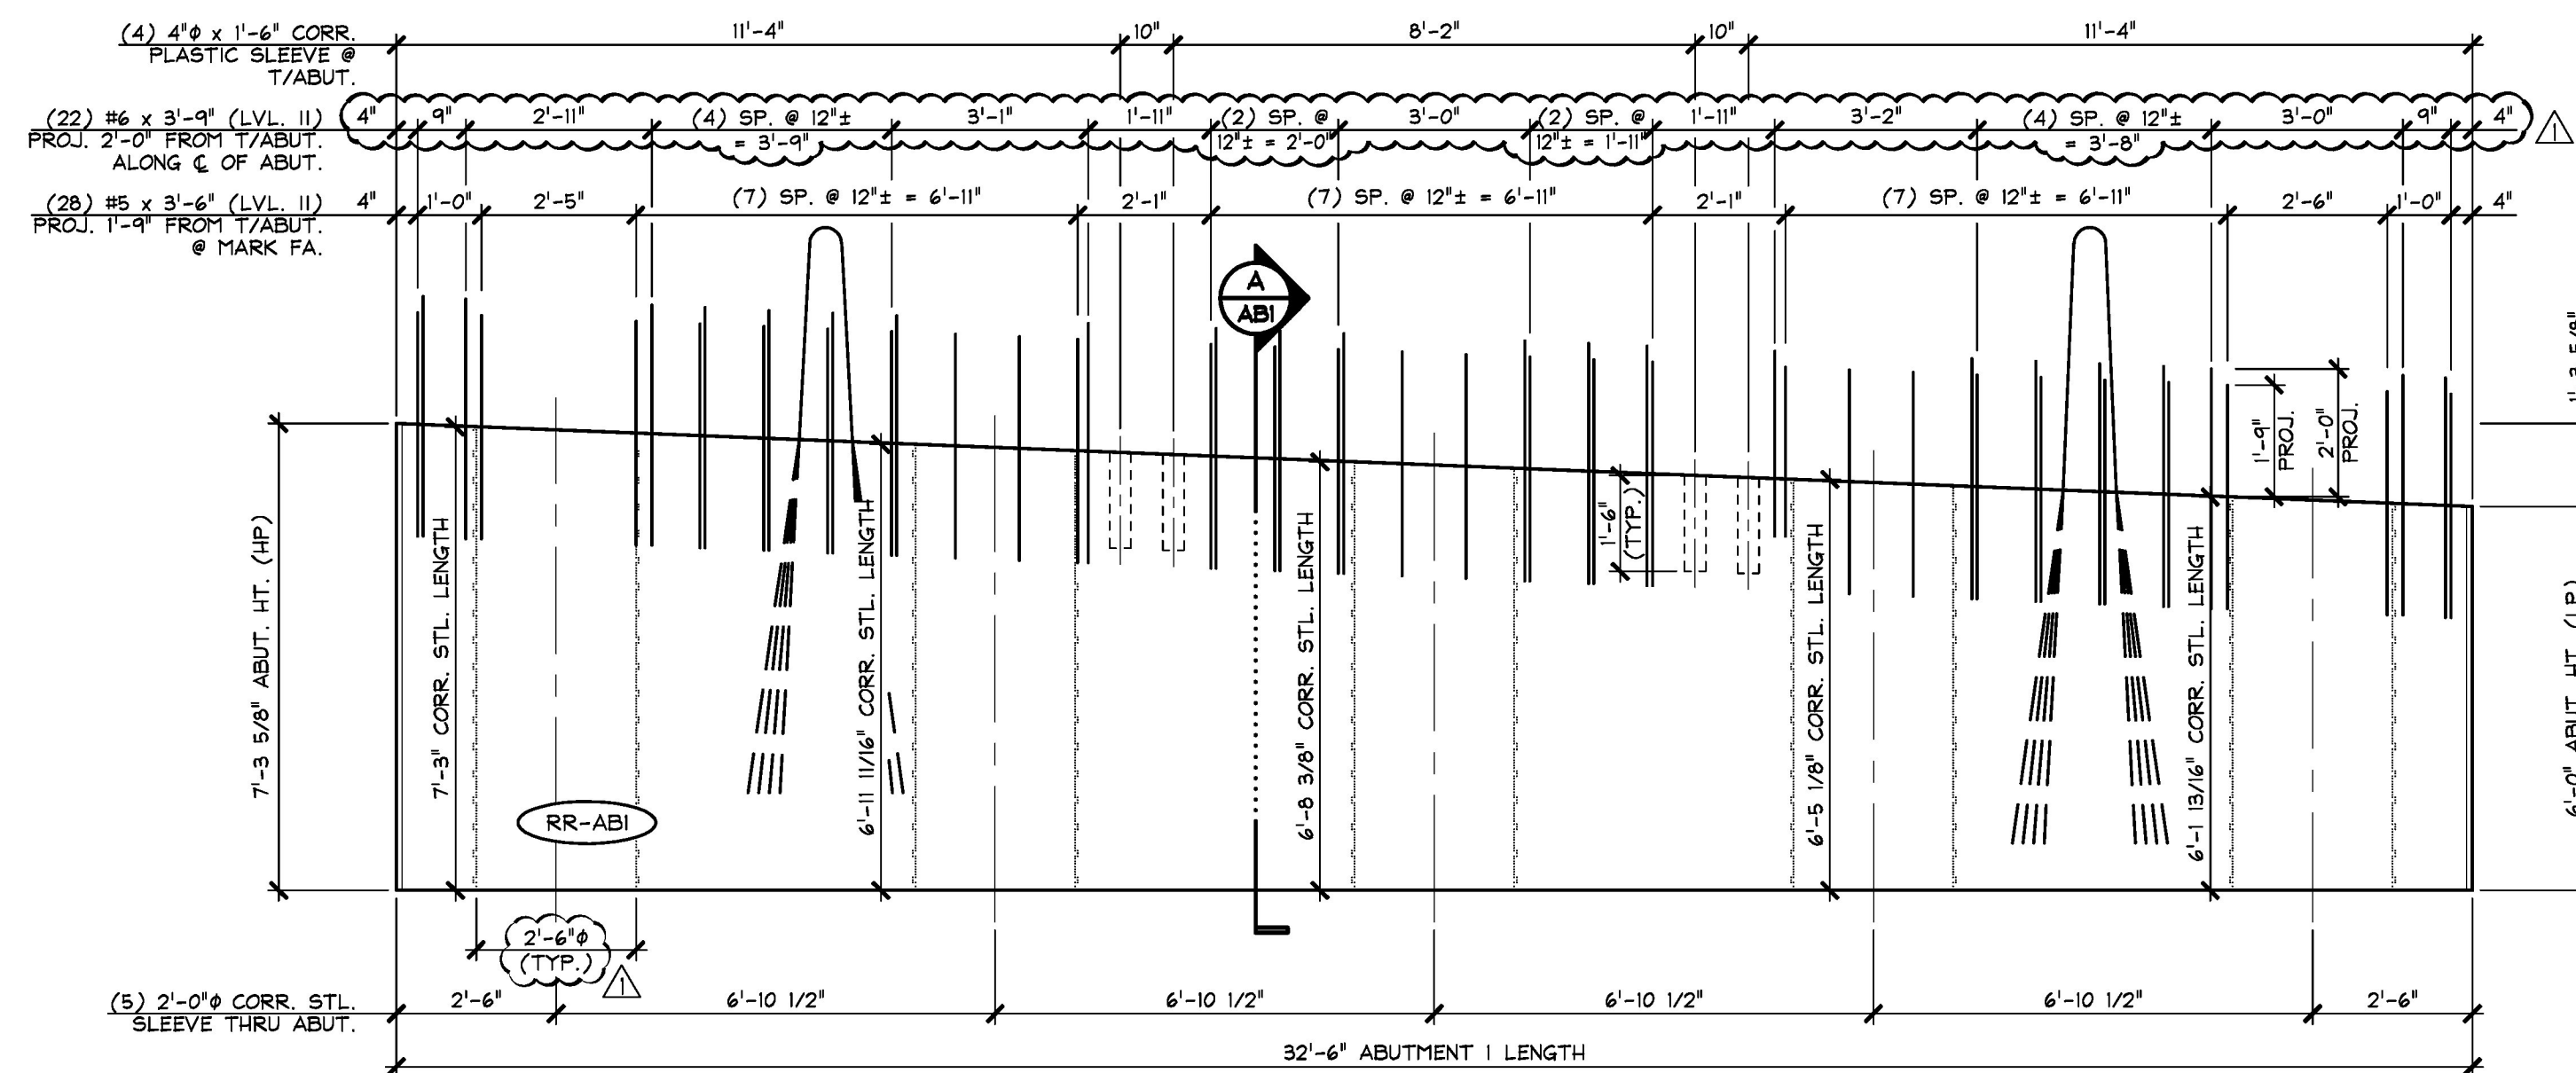

2 MARK FACE ABUTMENT ELEVATION
ABI
3/8" = 1'-0"

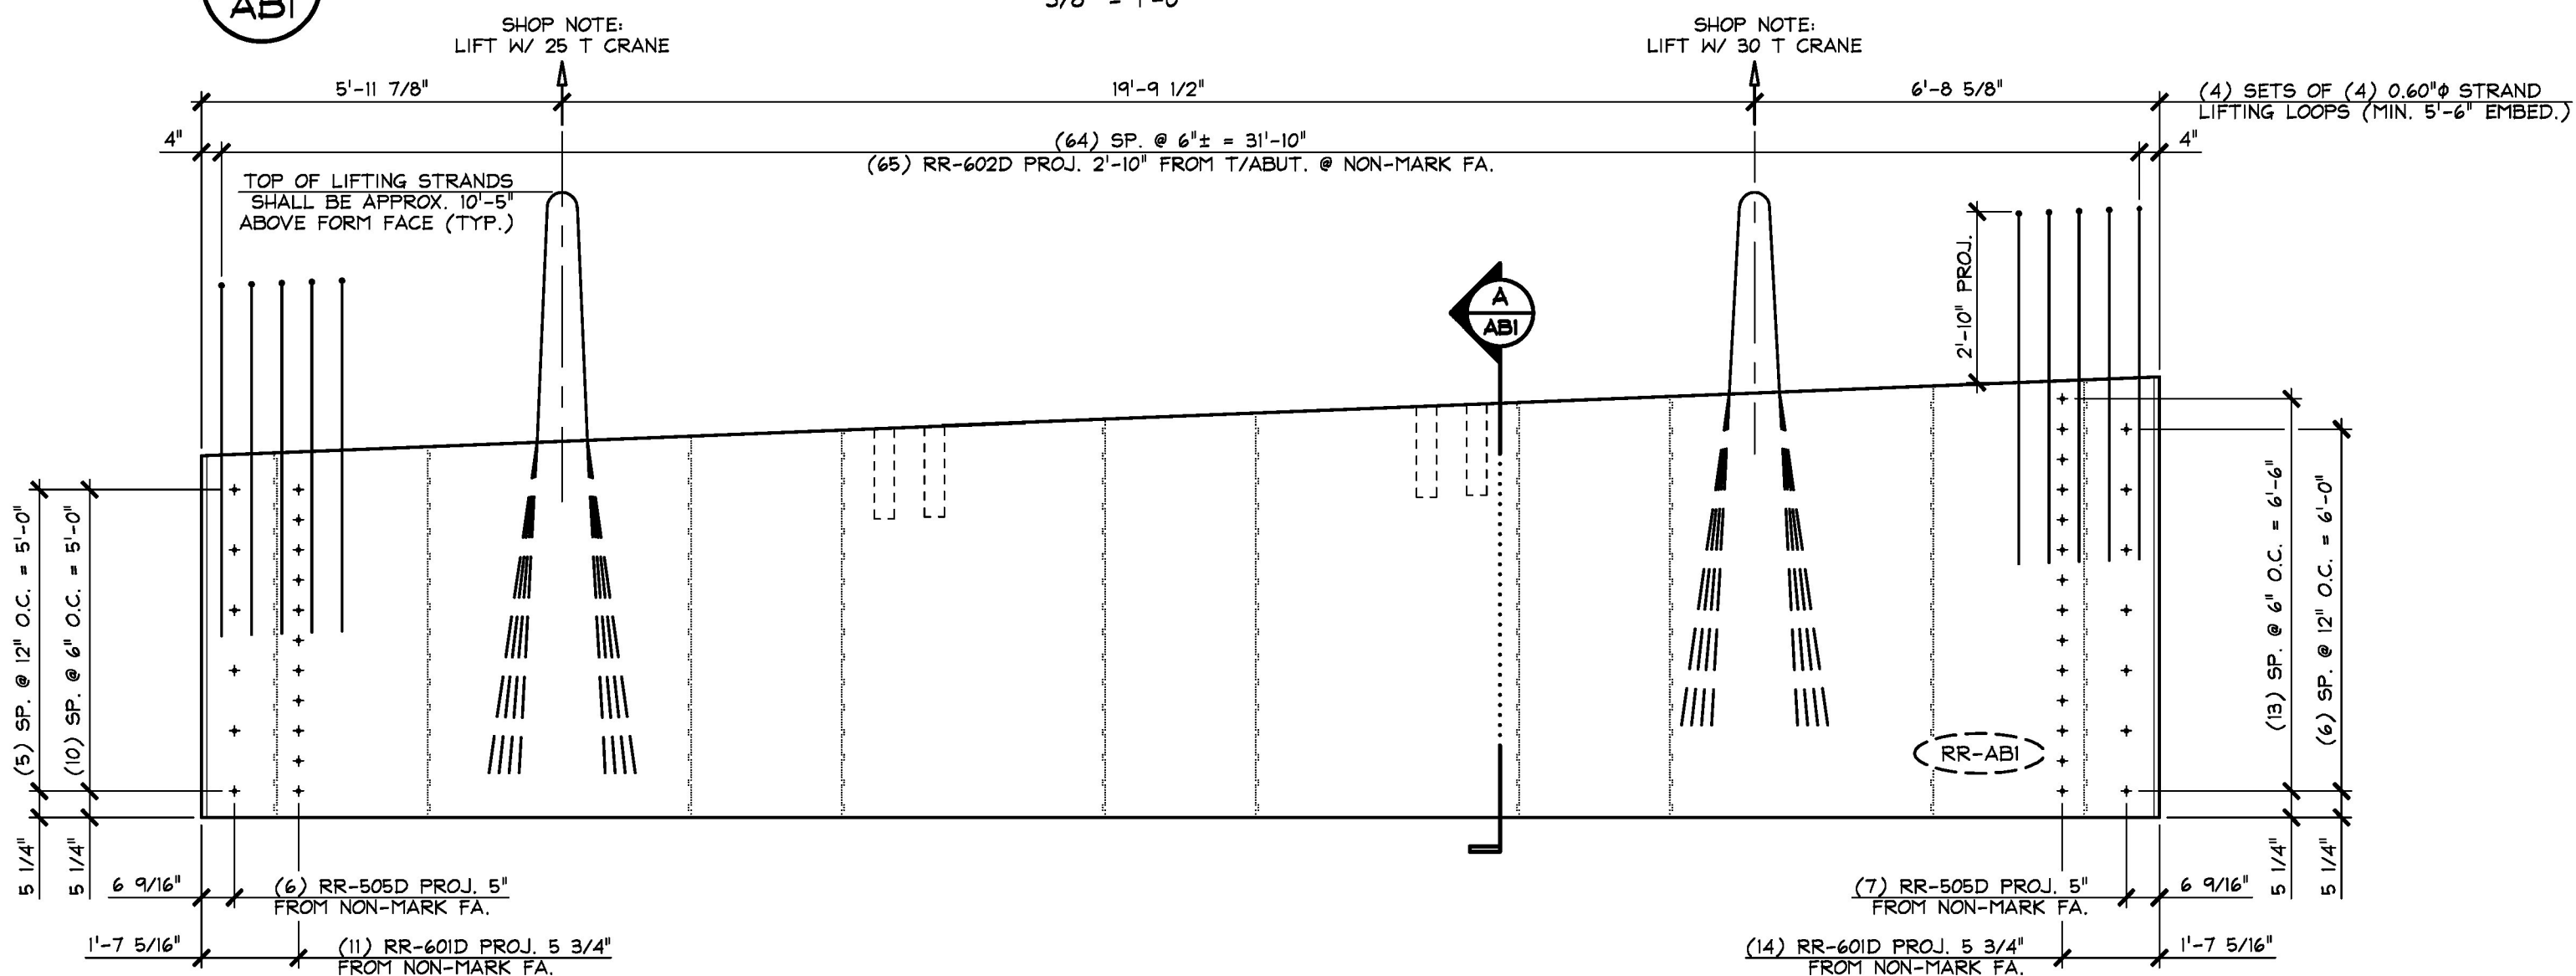

3 NON-MARK FACE ABUTMENT ELEVATION
ABI
3/8" = 1'-0"

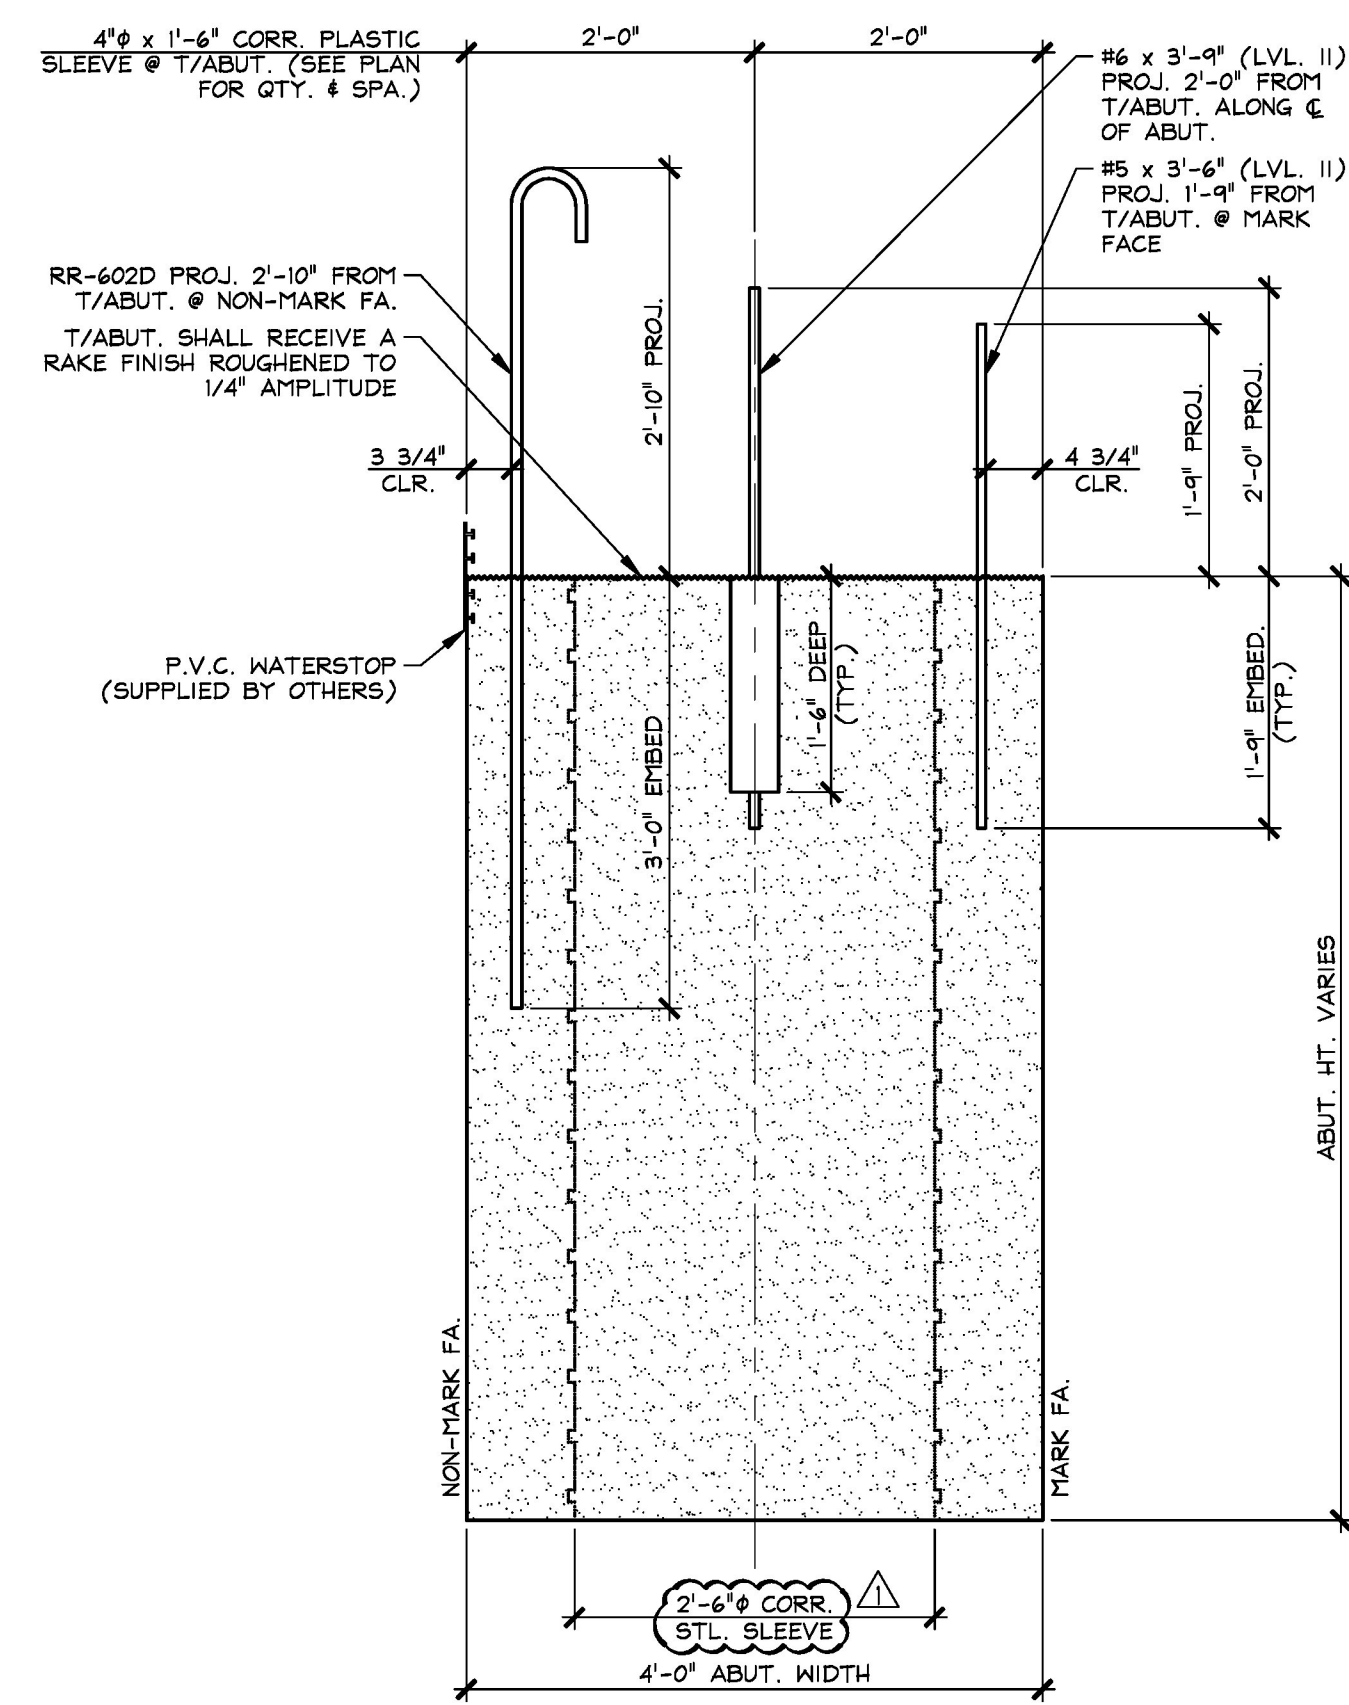

A DIMENSIONAL SECTION
ABI
3/4" = 1'-0"

SHOP NOTE:
SEE DRAWING NO. 'ABI.1' FOR
ABUTMENT REINFORCING

SHOP NOTE:
f_c = 5,000 PSI
f_s = 3,500 PSI
MIX #445MSCC

MARK:	RR-ABI	QTY.:	1	WT.:	54.3 T	VOL.:	28.13 cy
MATERIAL LIST / ABUTMENT							
ITEM	MARK	DESCRIPTION	QTY.				
1	RR-505D	#5 BENT BAR (LEVEL II, DUAL COATED)	13				
2		#5 x 3'-6" (LEVEL II, DUAL COATED)	28				
3							
4							
5	RR-601D	#6 BENT BAR (LEVEL II, DUAL COATED)	25				
6	RR-602D	#6 BENT BAR (LEVEL II, DUAL COATED)	65				
7		#6 x 3'-9" (LEVEL II, DUAL COATED)	22				
8							
9							
10							
11		P.V.C. WATERSTOP (SUPPLIED BY OTHERS)	32.3 LF				
12		2'-6" x 7'-3" CORRUGATED STEEL SLEEVE	1				
13		2'-6" x 6'-11 1/16" CORRUGATED STEEL SLEEVE	1				
14		2'-6" x 6'-8 3/8" CORRUGATED STEEL SLEEVE	1				
15		2'-6" x 6'-5 1/8" CORRUGATED STEEL SLEEVE	1				
16		2'-6" x 6'-1 13/16" CORRUGATED STEEL SLEEVE	1				
17		4" x 1'-6" CORRUGATED PLASTIC SLEEVE	4				
18		SET OF (4) 0.60" STRAND LIFTING LOOPS	4				
19							
20							

12-2-15 REVISED PER GENERAL CONTRACTOR'S
ENGINEER REVIEW

APPROVAL STAMP:	J.P. CARRARA & SONS INC. Precast & Prestress Manufacturer 2464 CASE STR., MIDDLEBURY, VERMONT 05753 Phone: (802)388-6361 Fax: (802)388-9010	CCS CONSTRUCTORS, INC. CONTRACTOR MORRISVILLE, VERMONT
	STATE OF VERMONT AGENCY OF TRANSPORTATION COUNTY OF ADDISON	DATE: OCT. 15, 2015 SCALE: NOTED
	TOWN OF NEW HAVEN T.H. 2 (RIVER ROAD) (CLASS 2 - MAJOR COLLECTOR) BRIDGE NO.: 10 PROJECT NO.: BRP 0183 (1)	CHKD: A.S. DFTM: B.L. JOB NO: 23475-015
	PRECAST ABUTMENT DIMENSIONAL DETAILS	DWG. NO: ABI