




1 PRECAST ABUTMENT PLAN VIEW IN FORM
AB2
3/8" = 1'-0"

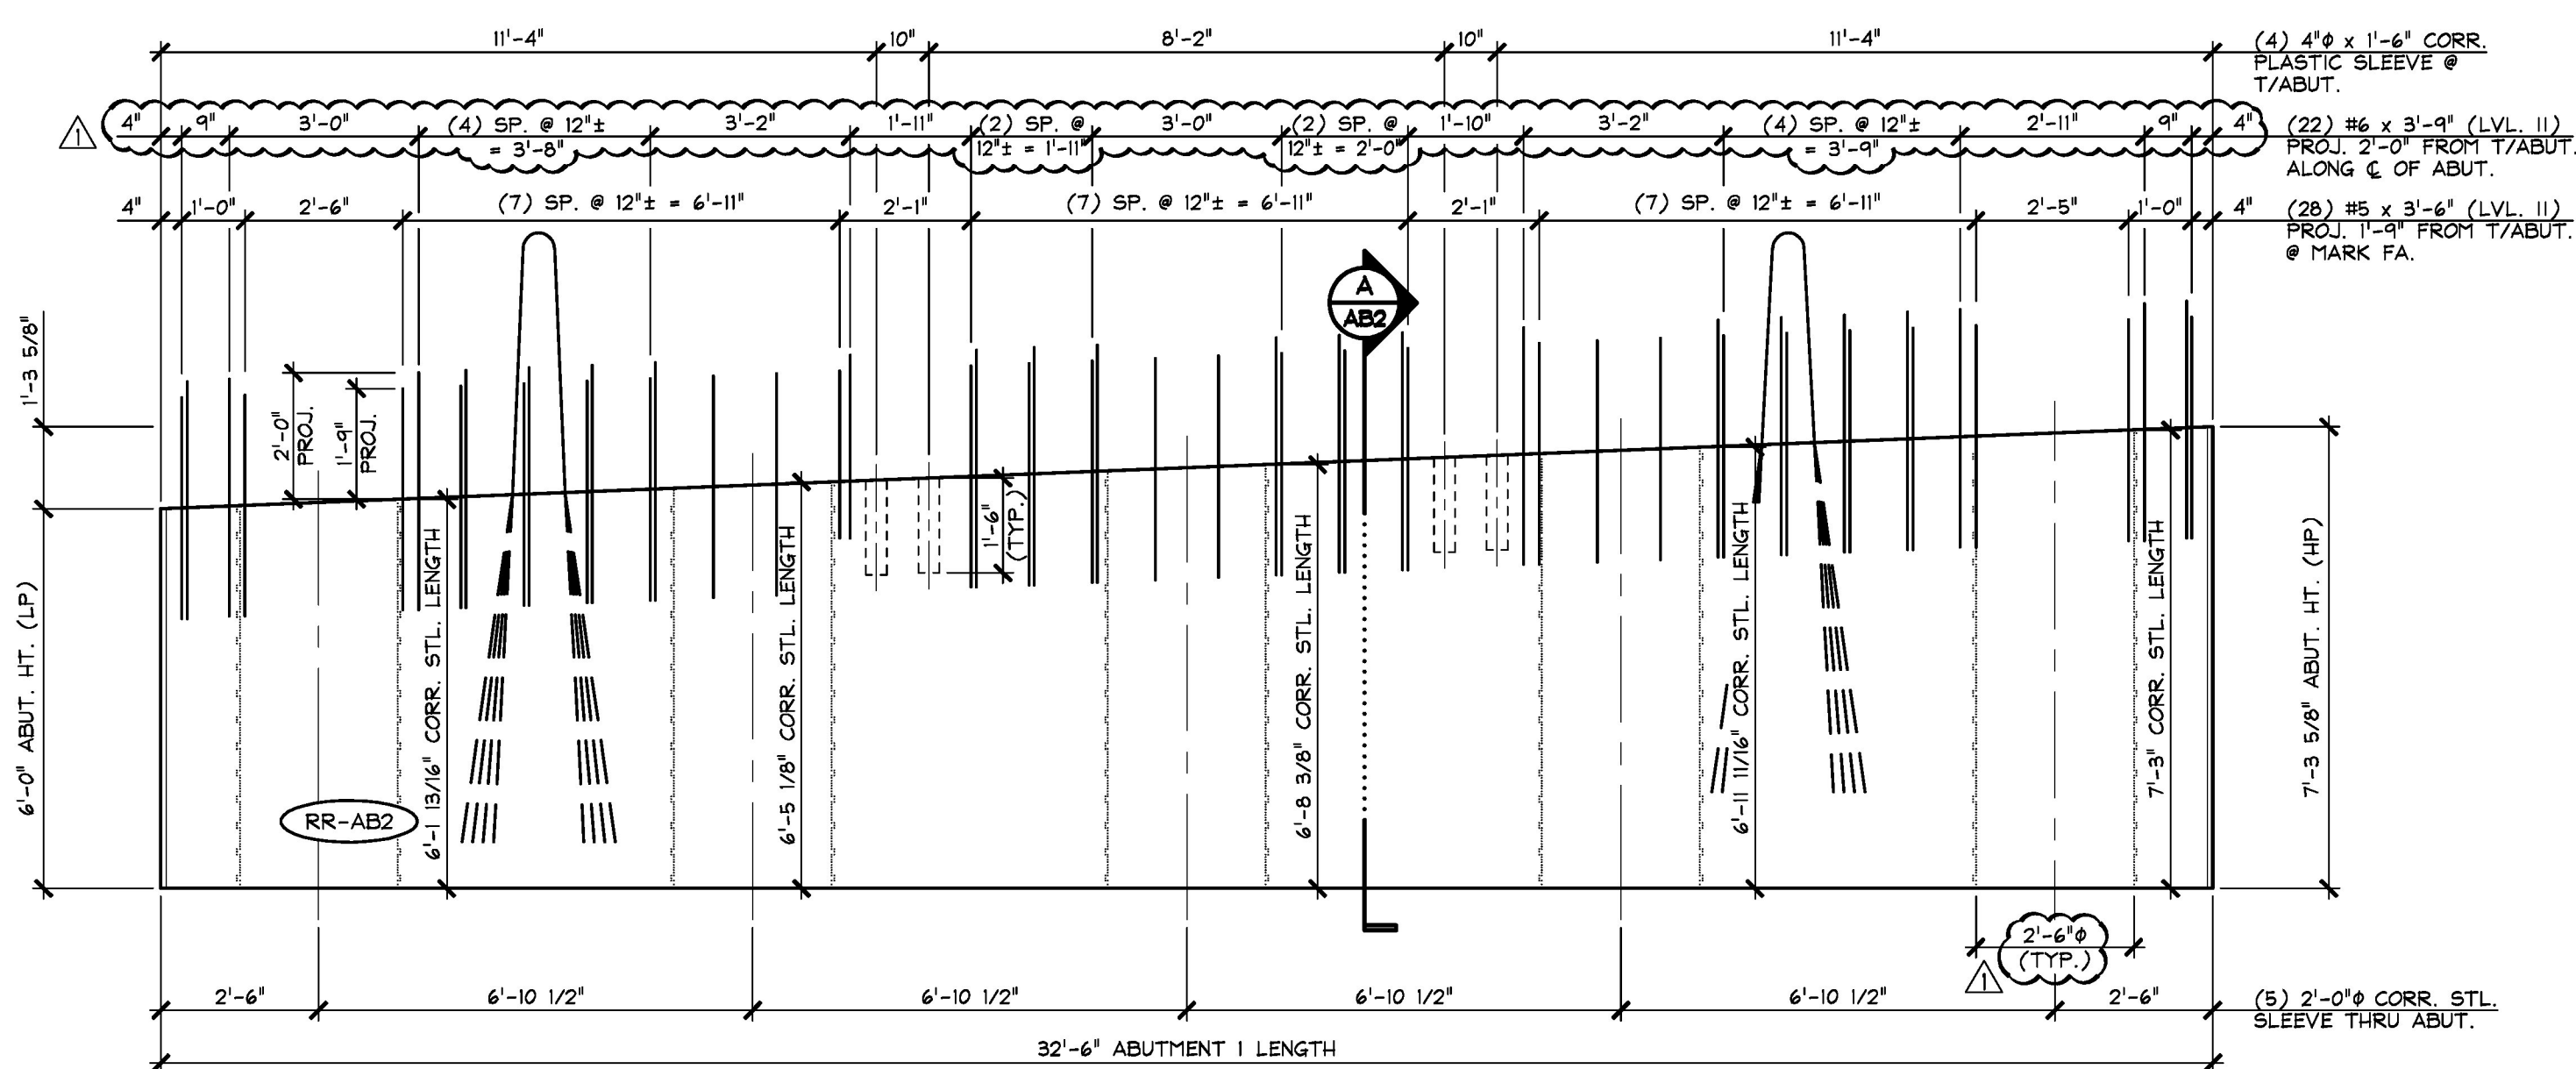

2 MARK FACE ABUTMENT ELEVATION
AB2
3/8" = 1'-0"

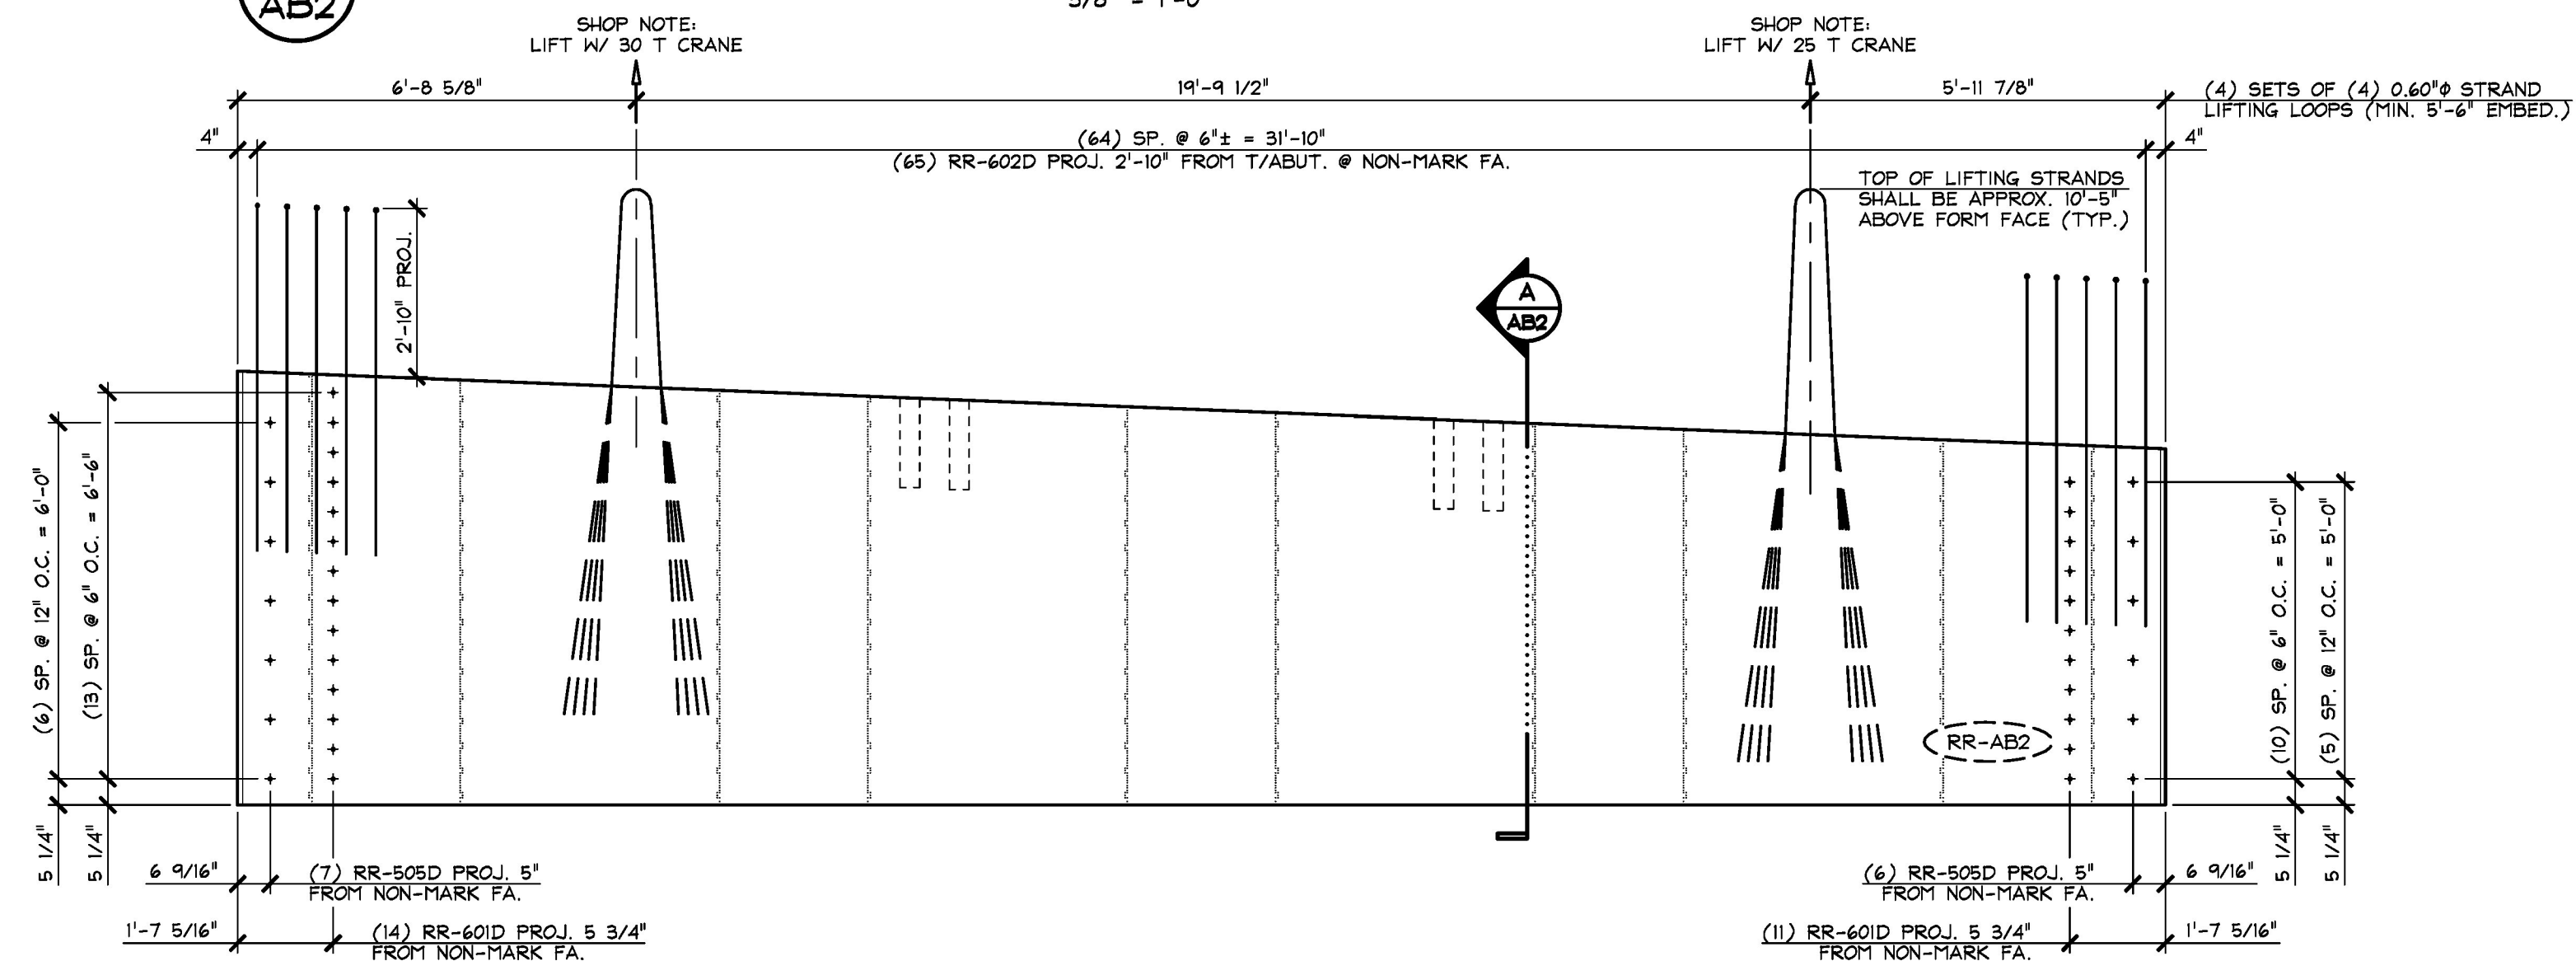

3 NON-MARK FACE ABUTMENT ELEVATION
AB2
3/8" = 1'-0"

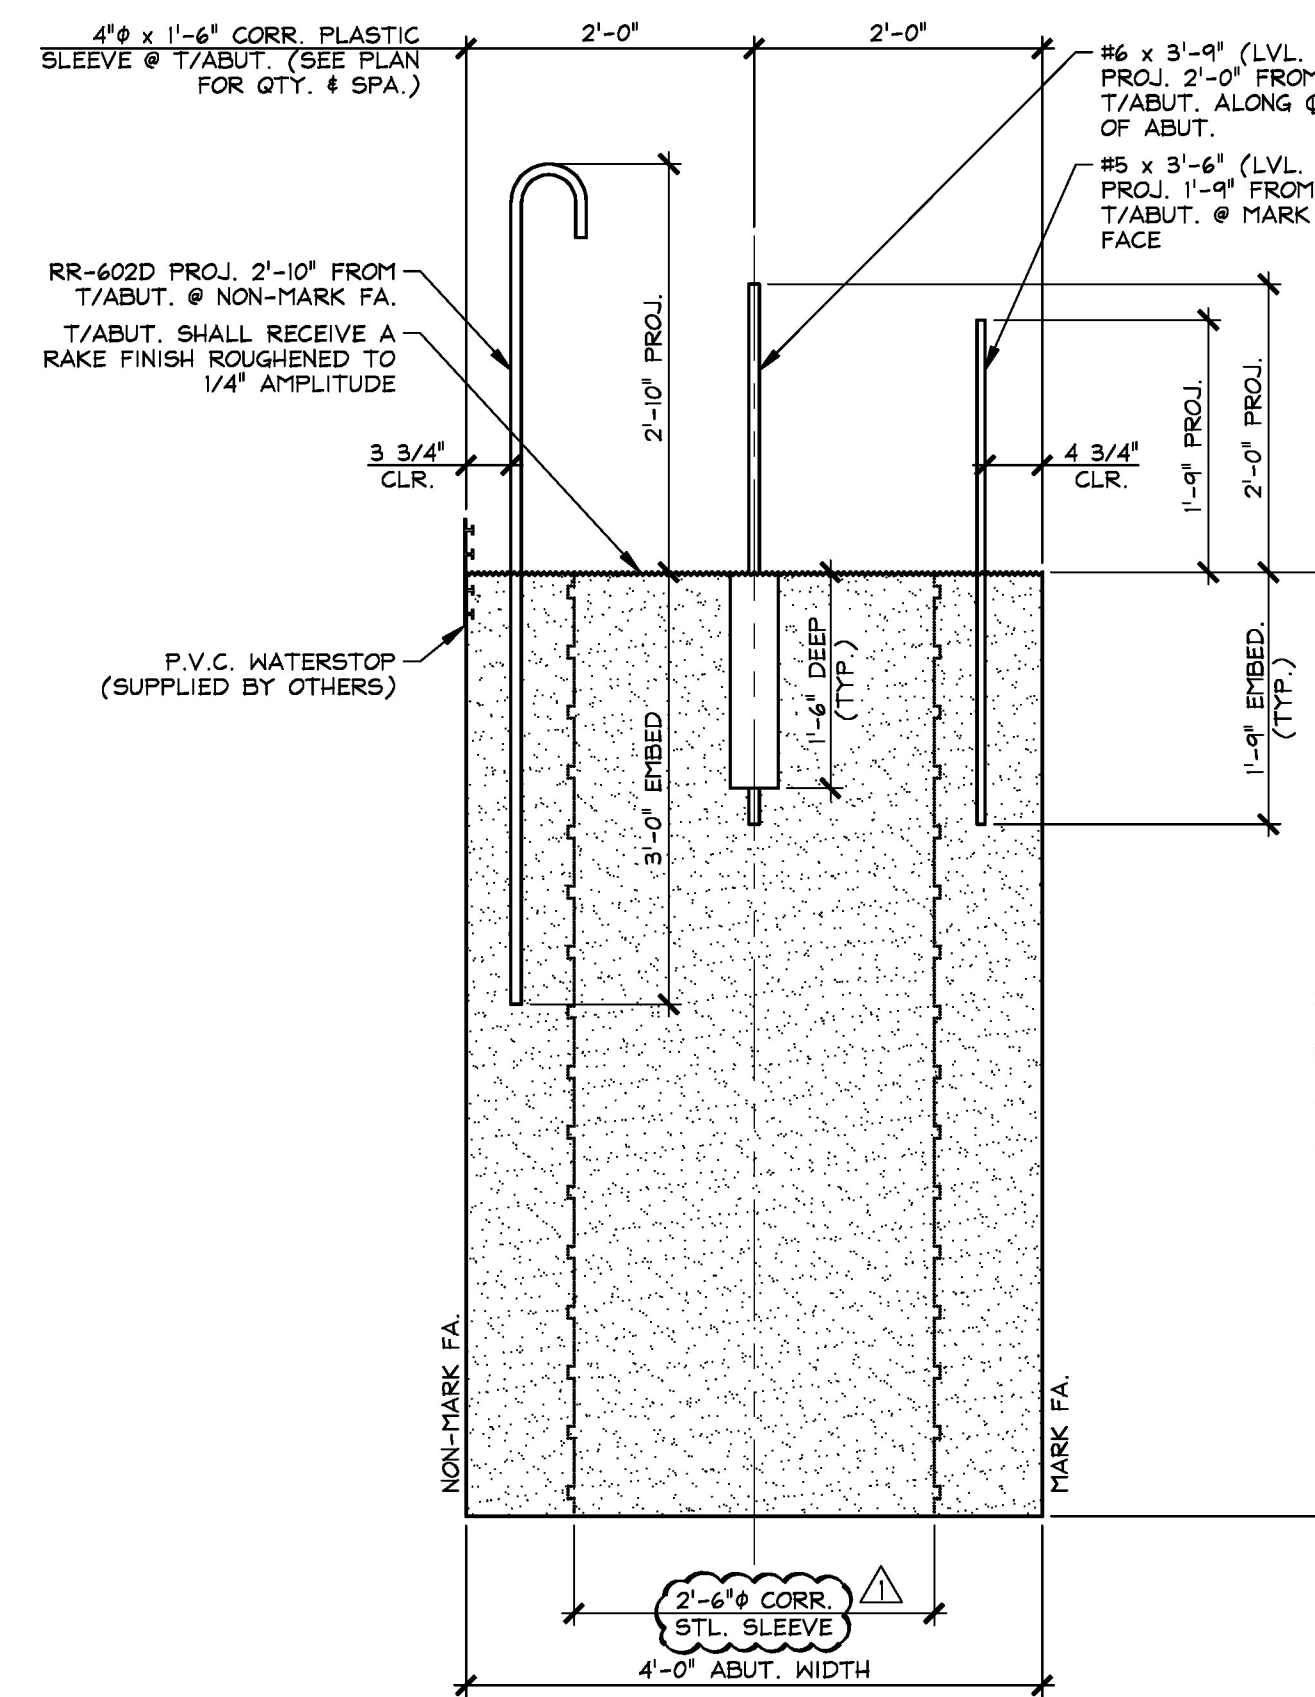

A DIMENSIONAL SECTION
AB2
3/4" = 1'-0"

SHOP NOTE:
SEE DRAWING NO. AB2.1 FOR
ABUTMENT REINFORCING

SHOP NOTE:
f'c = 5,000 PSI
f'st = 3,500 PSI
MIX #445M5CC

MATERIAL LIST / ABUTMENT			
ITEM	MARK	DESCRIPTION	QTY.
1	RR-505D	#5 BENT BAR (LEVEL II, DUAL COATED)	13
2		#5 x 3'-6" (LEVEL II, DUAL COATED)	28
3			
4			
5	RR-601D	#6 BENT BAR (LEVEL II, DUAL COATED)	25
6	RR-602D	#6 BENT BAR (LEVEL II, DUAL COATED)	65
7		#6 x 3'-9" (LEVEL II, DUAL COATED)	22
8			
9			
10			
11		P.V.C. WATERSTOP (SUPPLIED BY OTHERS)	32.3 LF
12		2'-6" x 7'-3" CORRUGATED STEEL SLEEVE	1
13		2'-6" x 6'-11 1/16" CORRUGATED STEEL SLEEVE	1
14		2'-6" x 6'-8 3/8" CORRUGATED STEEL SLEEVE	1
15		2'-6" x 6'-5 1/8" CORRUGATED STEEL SLEEVE	1
16		2'-6" x 6'-1 13/16" CORRUGATED STEEL SLEEVE	1
17		4" x 1'-6" CORRUGATED PLASTIC SLEEVE	4
18		SET OF (4) 0.60" STRAND LIFTING LOOPS	4
19			
20			

12-2-15 REVISED PER GENERAL CONTRACTOR'S
ENGINEER REVIEW

APPROVAL STAMP:	J.P. CARRARA & SONS INC. Precast & Prestress Manufacturer 264 CASE STR., MIDDLEBURY, VERMONT 05753 Phone: (802)388-6361 Fax: (802)388-9010	CCS CONSTRUCTORS, INC. CONTRACTOR MORRISVILLE, VERMONT
	STATE OF VERMONT AGENCY OF TRANSPORTATION COUNTY OF ADDISON	DATE: OCT. 15, 2015 SCALE: NOTED
	TOWN OF NEW HAVEN T.H. 2 (RIVER ROAD) (CLASS 2 - MAJOR COLLECTOR) BRIDGE NO.: 10 PROJECT NO.: BRP 0183 (1)	CHKD: A.S. DFTM: B.L. JOB NO: 23475-015
	PRECAST ABUTMENT DIMENSIONAL DETAILS	DWG. NO: AB2