


1.50" RADIUS, 0.375" BORDER, 0.00" INDENT  
 COLORS: LEGEND - WHITE  
 BACKGROUND - GREEN  
 TEXT STYLE: B

**D1-1**

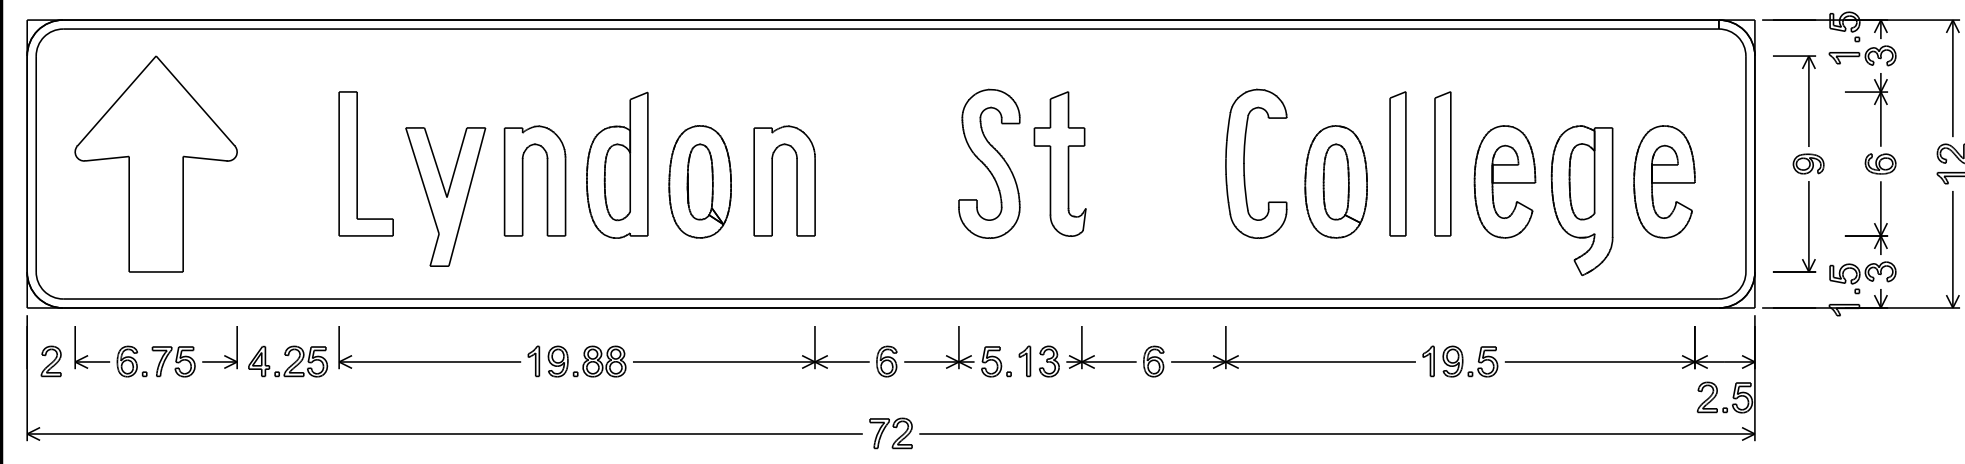


1.50" RADIUS, 0.375" BORDER, 0.00" INDENT  
 COLORS: LEGEND - WHITE  
 BACKGROUND - GREEN  
 TEXT STYLE: B

**D1-1**




1.50" RADIUS, 0.375" BORDER, 0.00" INDENT  
 COLORS: LEGEND - WHITE  
 BACKGROUND - GREEN  
 TEXT STYLE: B

**D1-1**

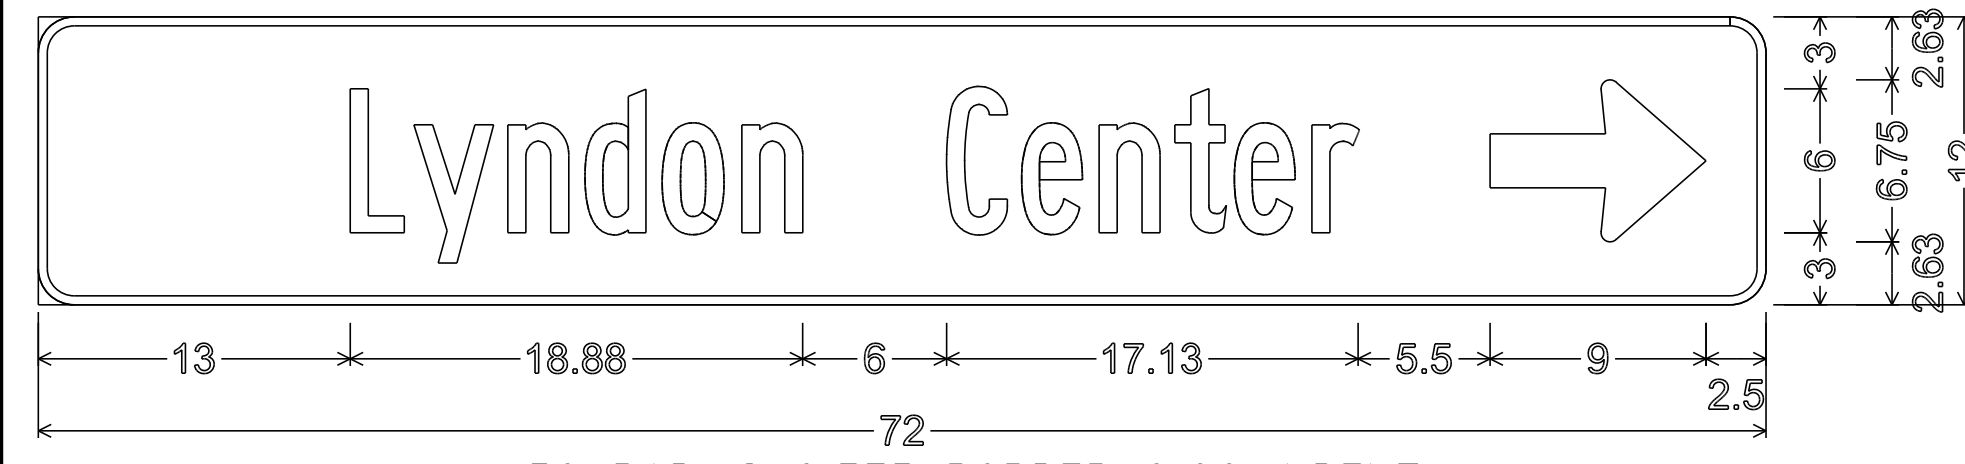


1.50" RADIUS, 0.375" BORDER, 0.00" INDENT  
 COLORS: LEGEND - WHITE  
 BACKGROUND - GREEN  
 TEXT STYLE: B

**D1-1**

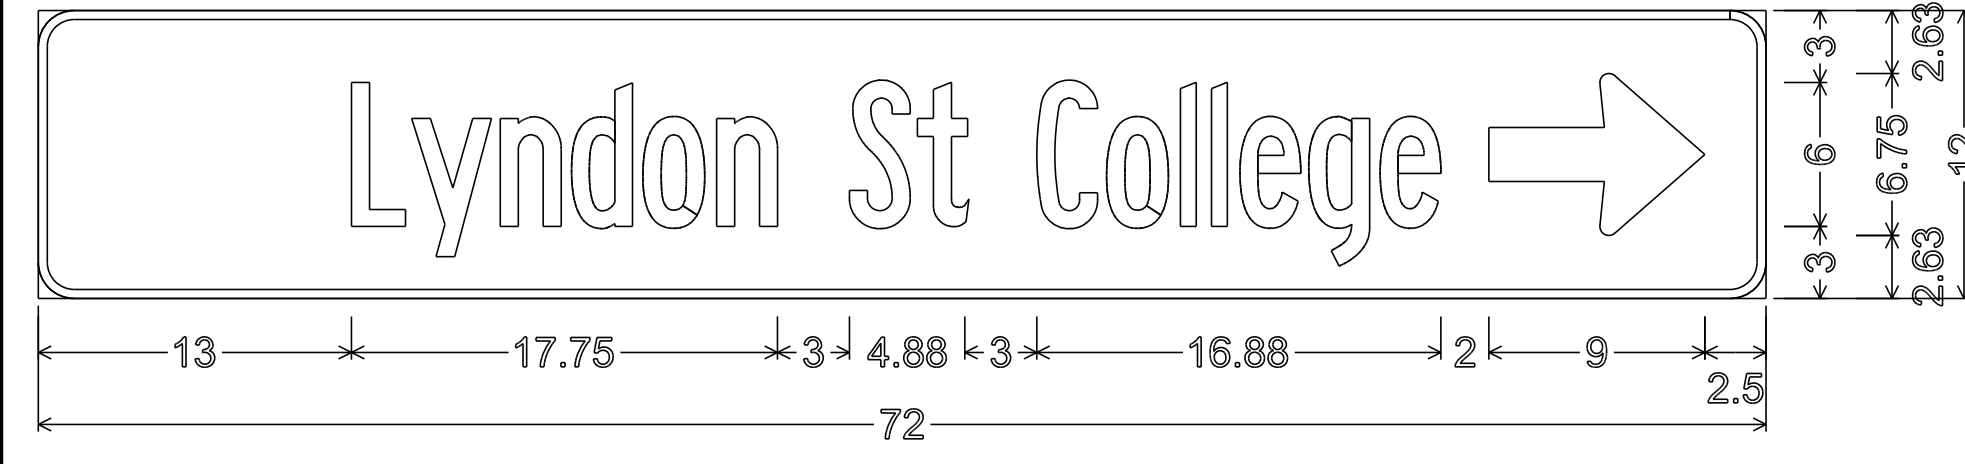


1.50" RADIUS, 0.375" BORDER, 0.00" INDENT  
 COLORS: LEGEND - WHITE  
 BACKGROUND - GREEN  
 TEXT STYLE: B

**D1-1**

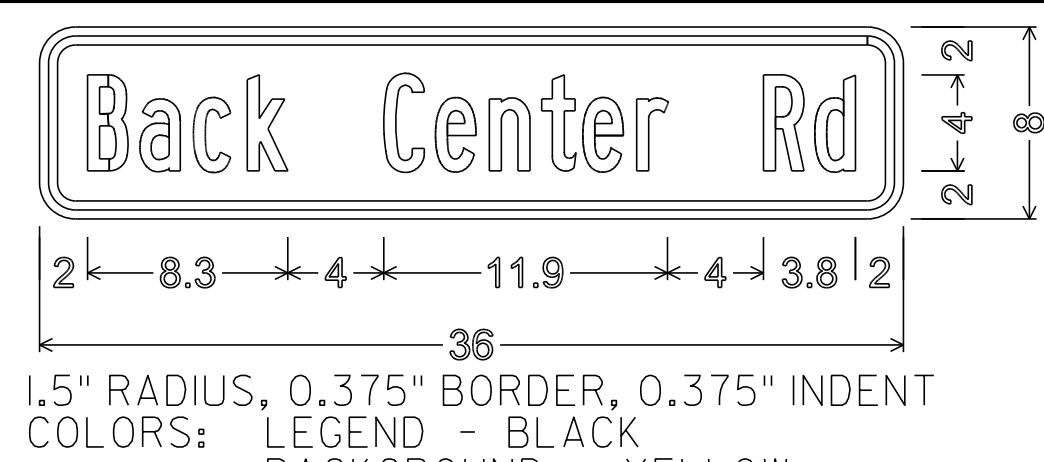


1.5" RADIUS, 0.375" BORDER, 0.375" INDENT  
 COLORS: LEGEND - BLACK  
 BACKGROUND - YELLOW  
 TEXT STYLE: B

**W16-8P**

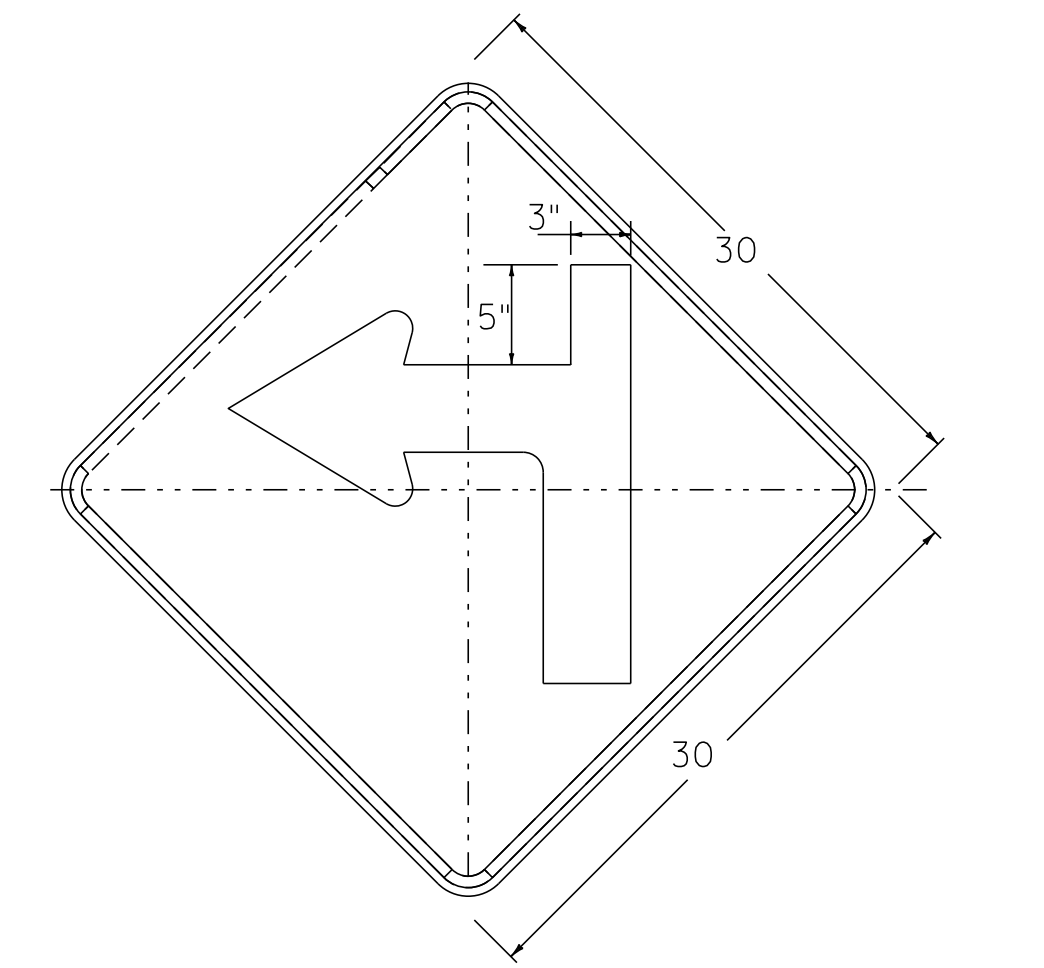


**W1-1Mb L(R)**

DIMENSIONS NOT SHOWN  
 FOR THIS DETAIL SHALL CONFORM  
 TO THE LATEST EDITION OF THE 2009 MUTCD  
 FOR SIGN DETAIL W1-1.  
 UNLESS OTHERWISE NOTED FOR THIS DETAIL

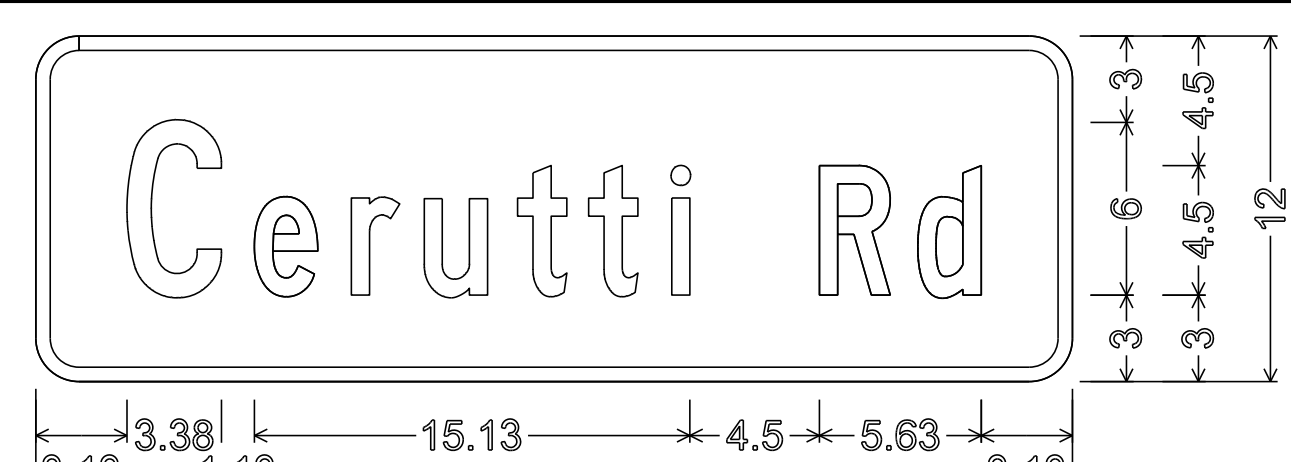


1.50" RADIUS, 0.50" BORDER, 0.00" INDENT  
 COLORS: LEGEND - WHITE  
 BACKGROUND - GREEN  
 TEXT STYLE: C

**D3-1**

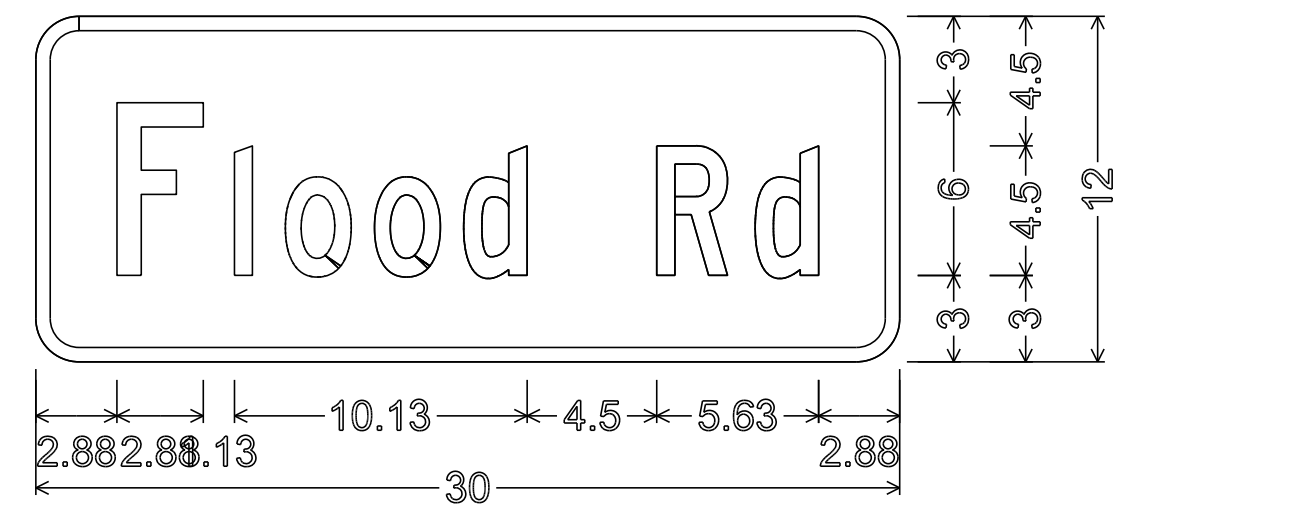


1.50" RADIUS, 0.50" BORDER, 0.00" INDENT  
 COLORS: LEGEND - WHITE  
 BACKGROUND - GREEN  
 TEXT STYLE: C

**D3-1**

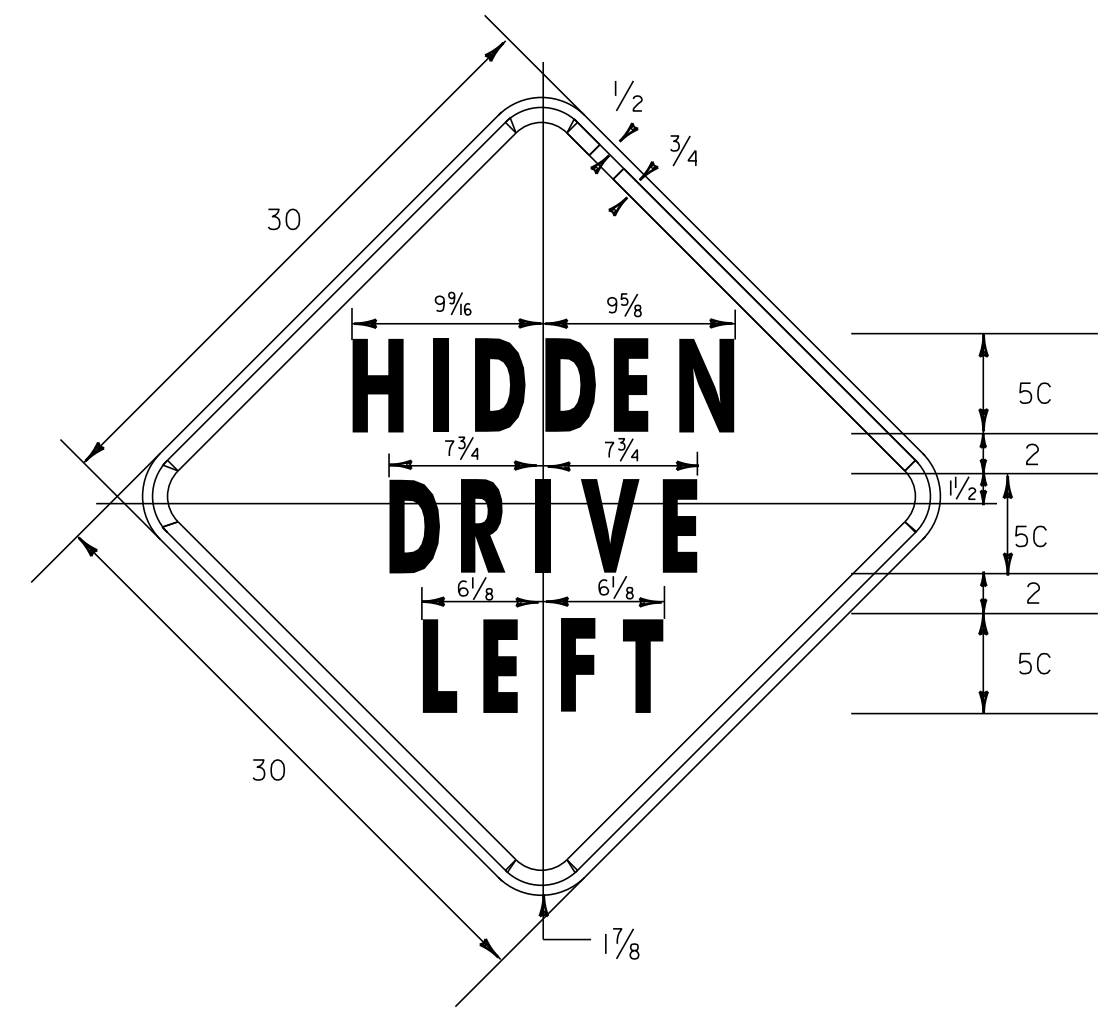


**VW-133**

1.1875" RADIUS, 0.75" BORDER, 0.50" INDENT  
 COLORS: LEGEND - BLACK  
 BACKGROUND - YELLOW  
 TEXT STYLE: C

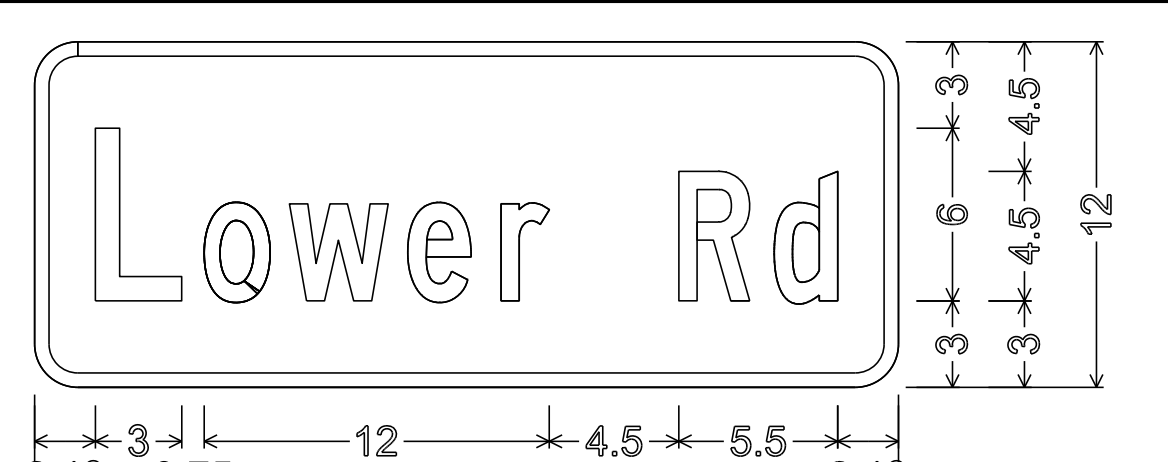


1.50" RADIUS, 0.50" BORDER, 0.00" INDENT  
 COLORS: LEGEND - WHITE  
 BACKGROUND - GREEN  
 TEXT STYLE: C

**D3-1**

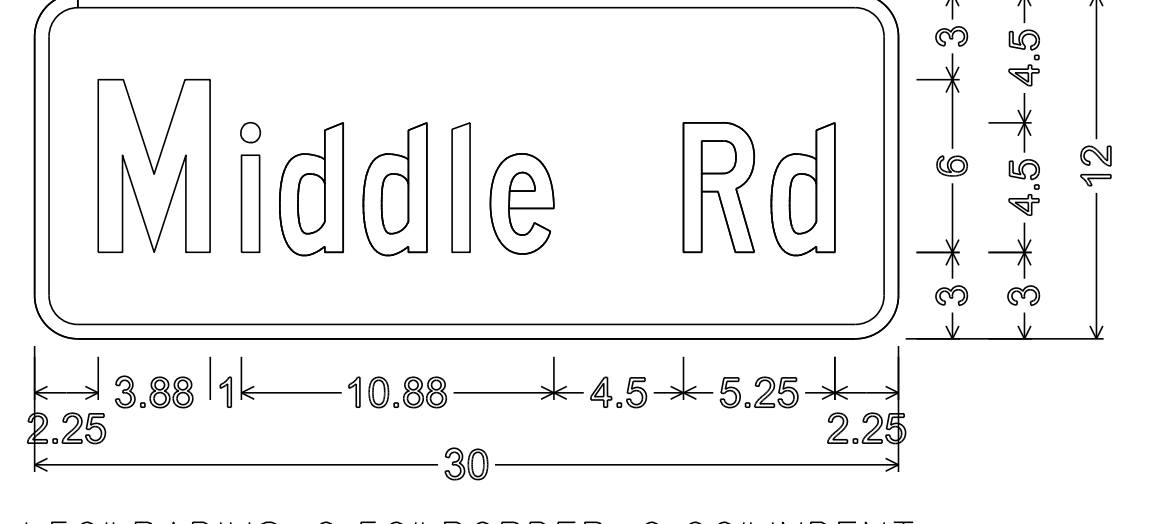


1.50" RADIUS, 0.50" BORDER, 0.00" INDENT  
 COLORS: LEGEND - WHITE  
 BACKGROUND - GREEN  
 TEXT STYLE: C

**D3-1**

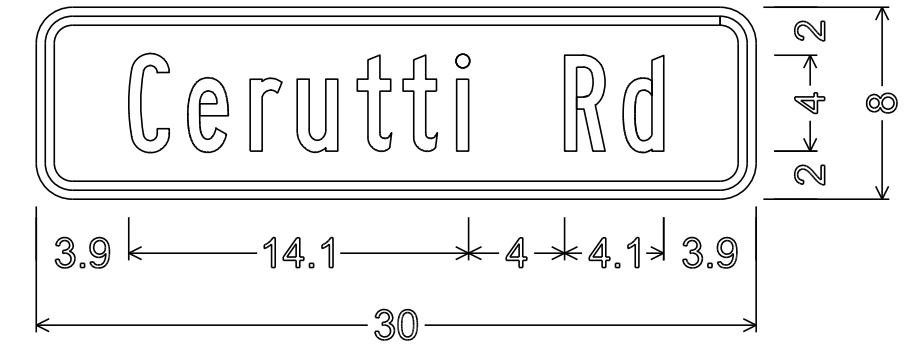

1.5" RADIUS, 0.375" BORDER, 0.375" INDENT  
 COLORS: LEGEND - BLACK  
 BACKGROUND - YELLOW  
 TEXT STYLE: B

**W16-8P**

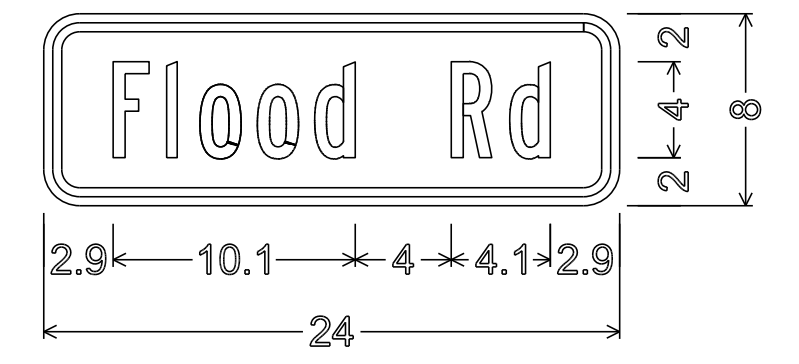

1.5" RADIUS, 0.375" BORDER, 0.375" INDENT  
 COLORS: LEGEND - BLACK  
 BACKGROUND - YELLOW  
 TEXT STYLE: B

**W16-8P**

ALL DIMENSIONS SHOWN IN INCHES UNLESS OTHERWISE NOTED.

PROJECT NAME: STATEWIDE NORTHEAST REGION  
 PROJECT NUMBER: STP HRRR(4)

FILE NAME: I0K016\_wrk.dgn PLOT DATE: 13-SEP-2012 15:46  
 PROJECT LEADER: JLS DRAWN BY: NLA  
 DESIGNED BY: NLA CHECKED BY: JLS  
 SPECIFIC SIGN DETAILS LYNDON & PLAINFIELD SHEET 12 OF 64

**LYNDON**

**PLAINFIELD**