


## TOWNSTATE HIGHWAY INVENTORY FOR PAVING MARKINGS

▪ NOTE ALL LOCATIONS ARE MEASURED FROM THE CENTER OF THE INTERSECTING ROADWAYS FOR THAT INTERSECTION AND ARE APPROXIMATE. FIELD VERIFY BEFORE INSTALLING OR AS DIRECTED BY THE ENGINEER.

TOWN/STATE HIGHWAY NAME	LOCATION MM	EXISTING PAVED/ GRAVEL	MAINLINE CENTERLINE BREAK	MAINLINE EDGE LINE BREAK	4" YELLOW CENTERLINE	EDGE LINE	8" WHITE LINE	STOP BAR	STOP SIGN	STOP LETTERS	YIELD SIGN	YIELD SYMBOLS	YIELD AHEAD LETTERS	STOP AHEAD LETTERS	STOP AHEAD SIGN	MAINLINE CROSSWALK	TH CROSSWALK	GRINDING	REMARKS
DUMMERSTON																			
MIDDLE ROAD	0.000 CL	PAVED			MM 0.004 TO 0.493 CL			MM 0+004 LT	YES	MM 0.005 LT				MM 0.130 LT	YES				ITEM 646.85
HOUGHTON ROAD	0.583 RT	PAVED	GRAVEL		<del>STA 0+17 TO 0+42 CL</del>			<del>STA 0+18 LT</del>	YES										REMOVE 40 L.F. OF C FOR HOUGHTON AND NOURSE HOLLOW ROADS.
NOURSE HOLLOW ROAD	0.583 RT	PAVED	GRAVEL		<del>STA 0+17 TO 0+42 CL</del>			<del>STA 0+18 LT</del>	YES										
MIDDLE ROAD	0.583 RT	PAVED				REMARKS													ADDED BY C.O.D. #1 DATED 5-23-2012
HARTFORD								MM 0.00 LT											
CHRISTIAN STREET (SLIP LANE)	0.000 CL	PAVED						STA 0+20 LT	YES	MM 0.011 LT									
CHRISTIAN STREET	0.000 CL	PAVED			MM 0.010 TO 0.025 CL			MM 0.010 LT	YES	MM 0.011 LT				MM 0.050 LT	YES				
SUMMER STREET	0.074 LT	PAVED			STA 0+17 TO 0+42 CL			STA 0+18 LT	YES								YES		
HARRY GIBBS STREET	0.124 LT	PAVED			STA 0+17 TO 0+42 CL			STA 0+18 LT	YES								YES		
PUTNEY																			
HOUGHTON BROOK ROAD	1.202 RT	PAVED			STA 0+17 TO 0+42 CL			STA 0+18 LT	YES	STA 0+27 LT									
WEST HILL ROAD	2.624 CL	PAVED						MM 2.621 RT	YES	MM 2.619 RT				MM 2.547 RT	YES				
SPRINGFIELD																			
PLEASANT VALLEY ROAD	3.215 CL	PAVED			MM 3.211 TO 3.206 CL			MM 3.211 RT	YES	MM 3.209 RT				MM 3.129 RT	YES				
THETFORD																			
SAWNEE BEAN ROAD	2.830 CL	PAVED			MM 2.826 TO 2.821 CL			MM 2.286 RT	YES	MM 2.284 RT					YES				
TOTALS					450 LF			132 LF		28 EA				36 EA			64 LF		

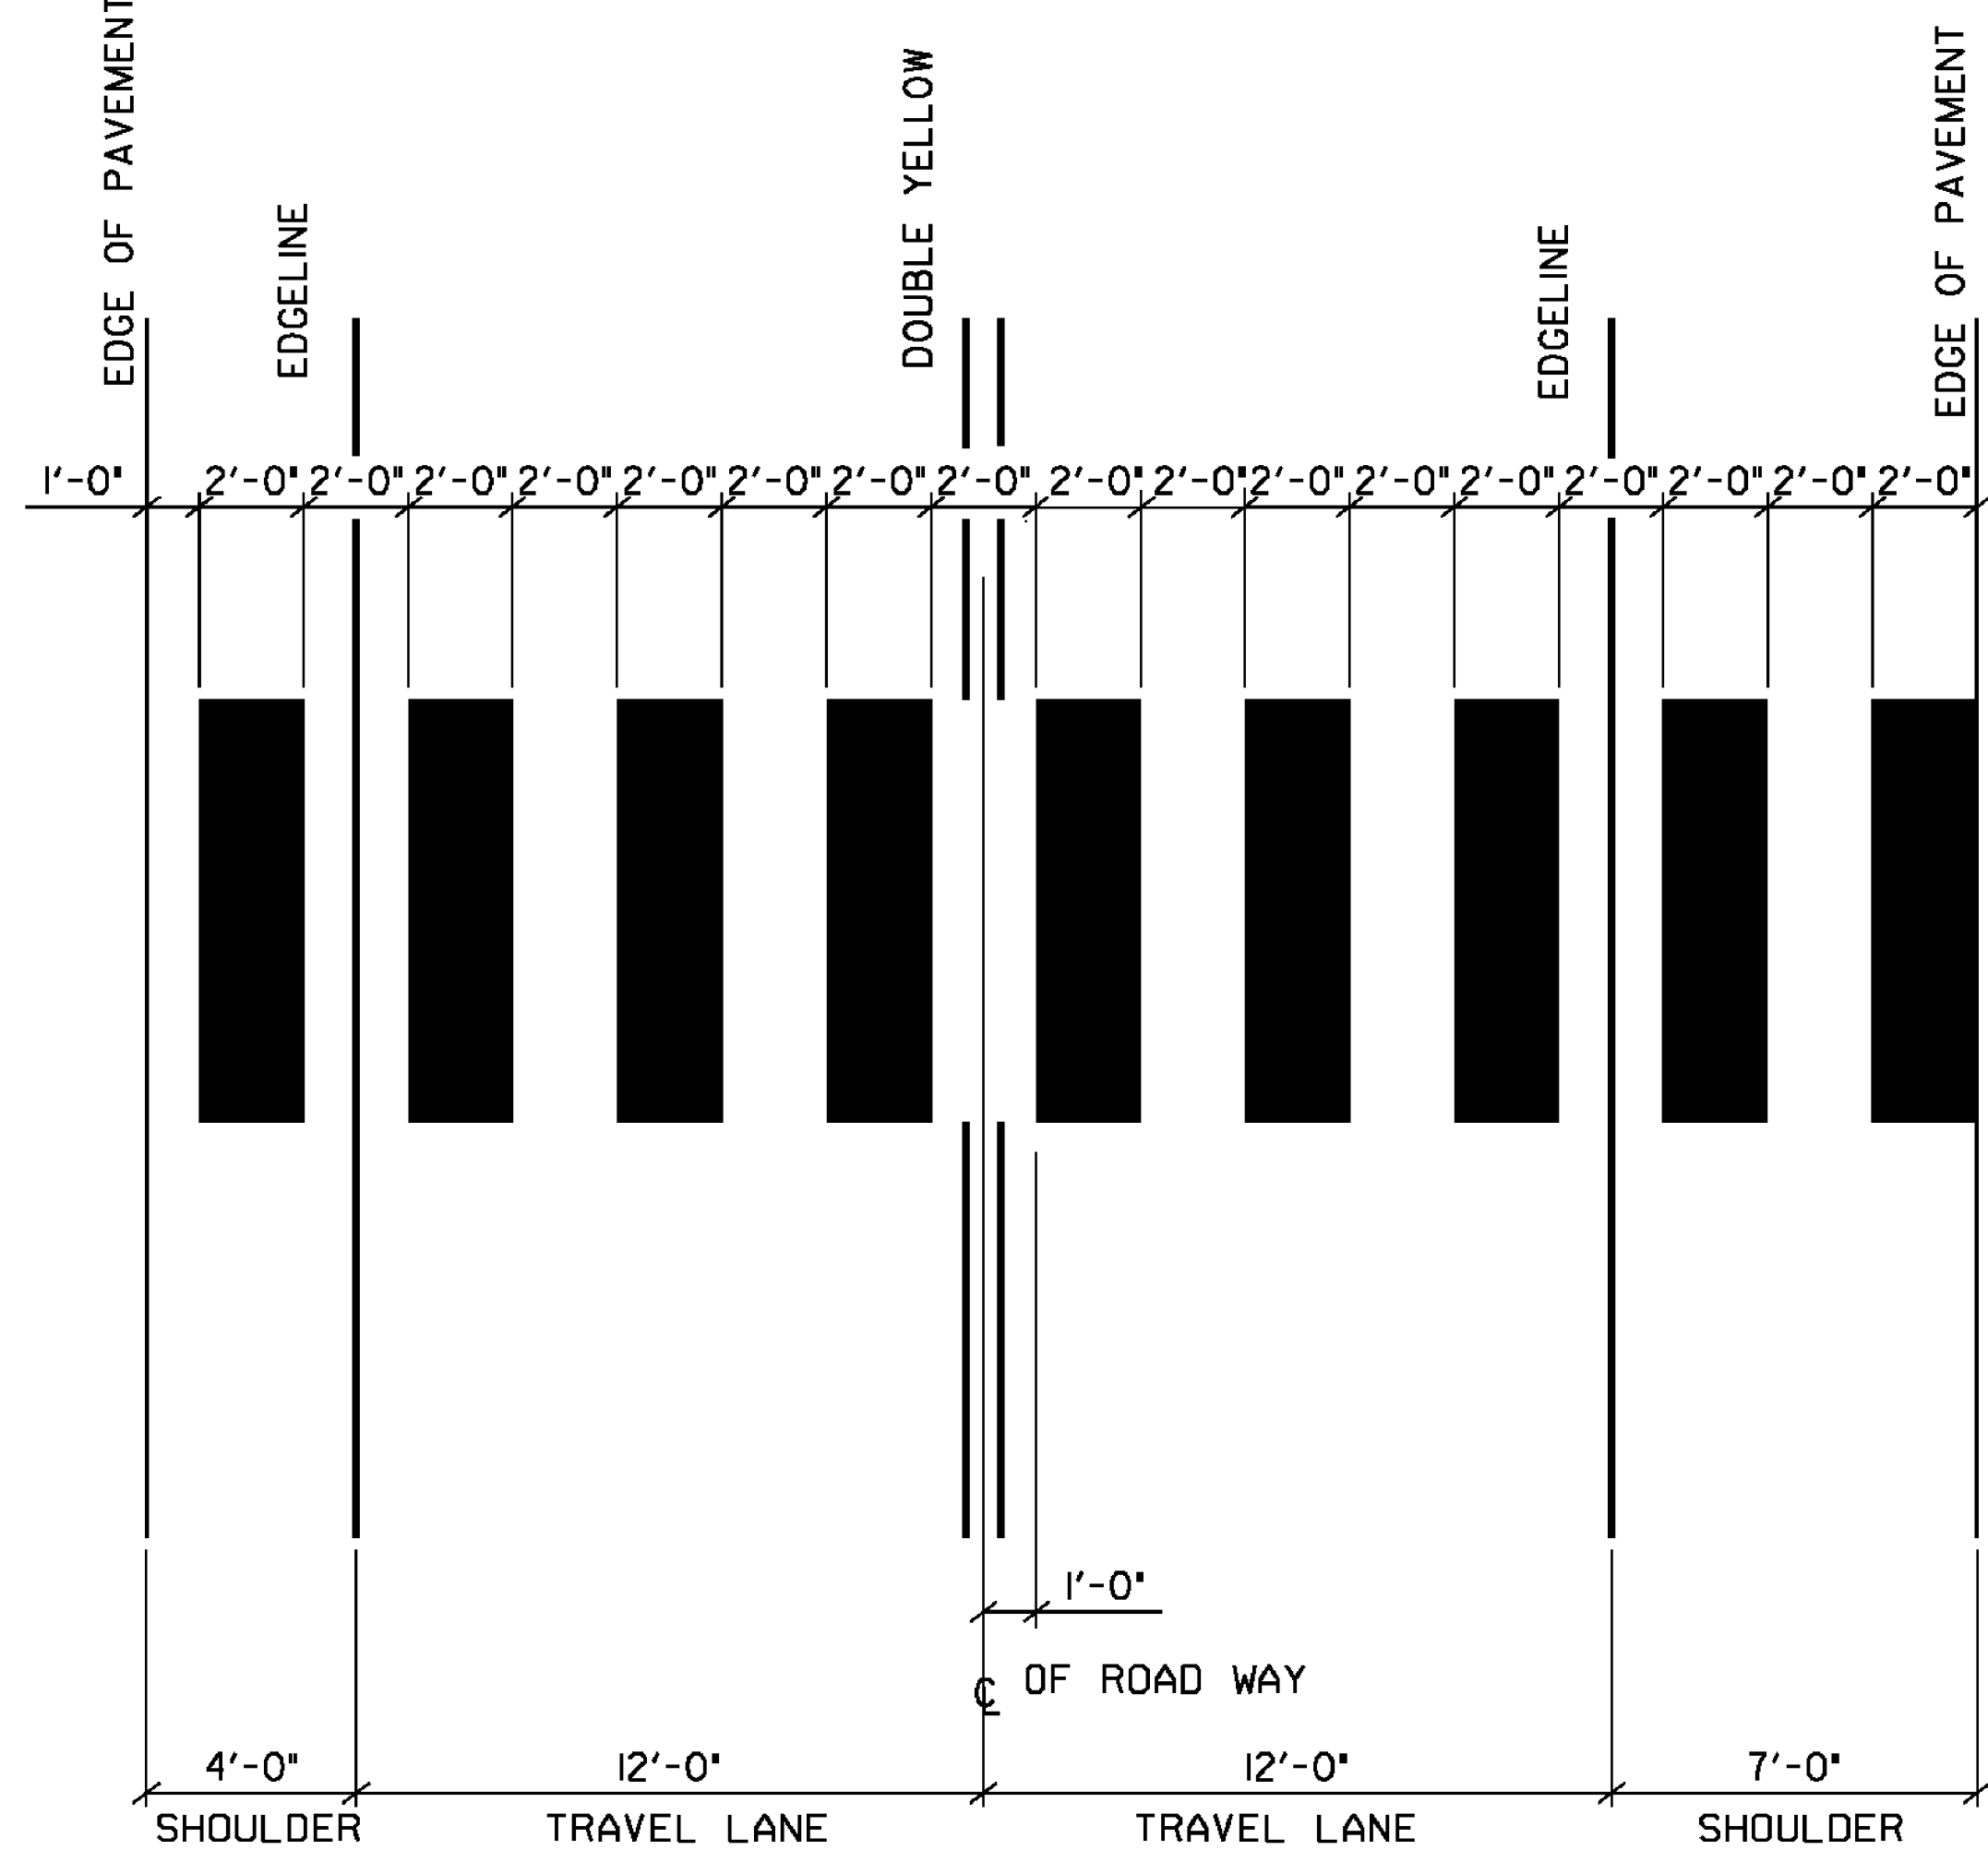


▪ ADJUST SPACING (1- 2 FT) TO AVOID WHEEL PATHS

NOTES:

### BLOCK PATTERN CROSSWALK DETAIL

IN ADDITION TO WHITE MARKINGS CROSSWALK PAVEMENT MAY BE TEXTURED AND/OR COLORED BRICK RED. MUTCD RESERVED COLORS (WHITE, YELLOW, BLUE, RED) SHALL NOT BE USED AS BACKGROUND COLORS.

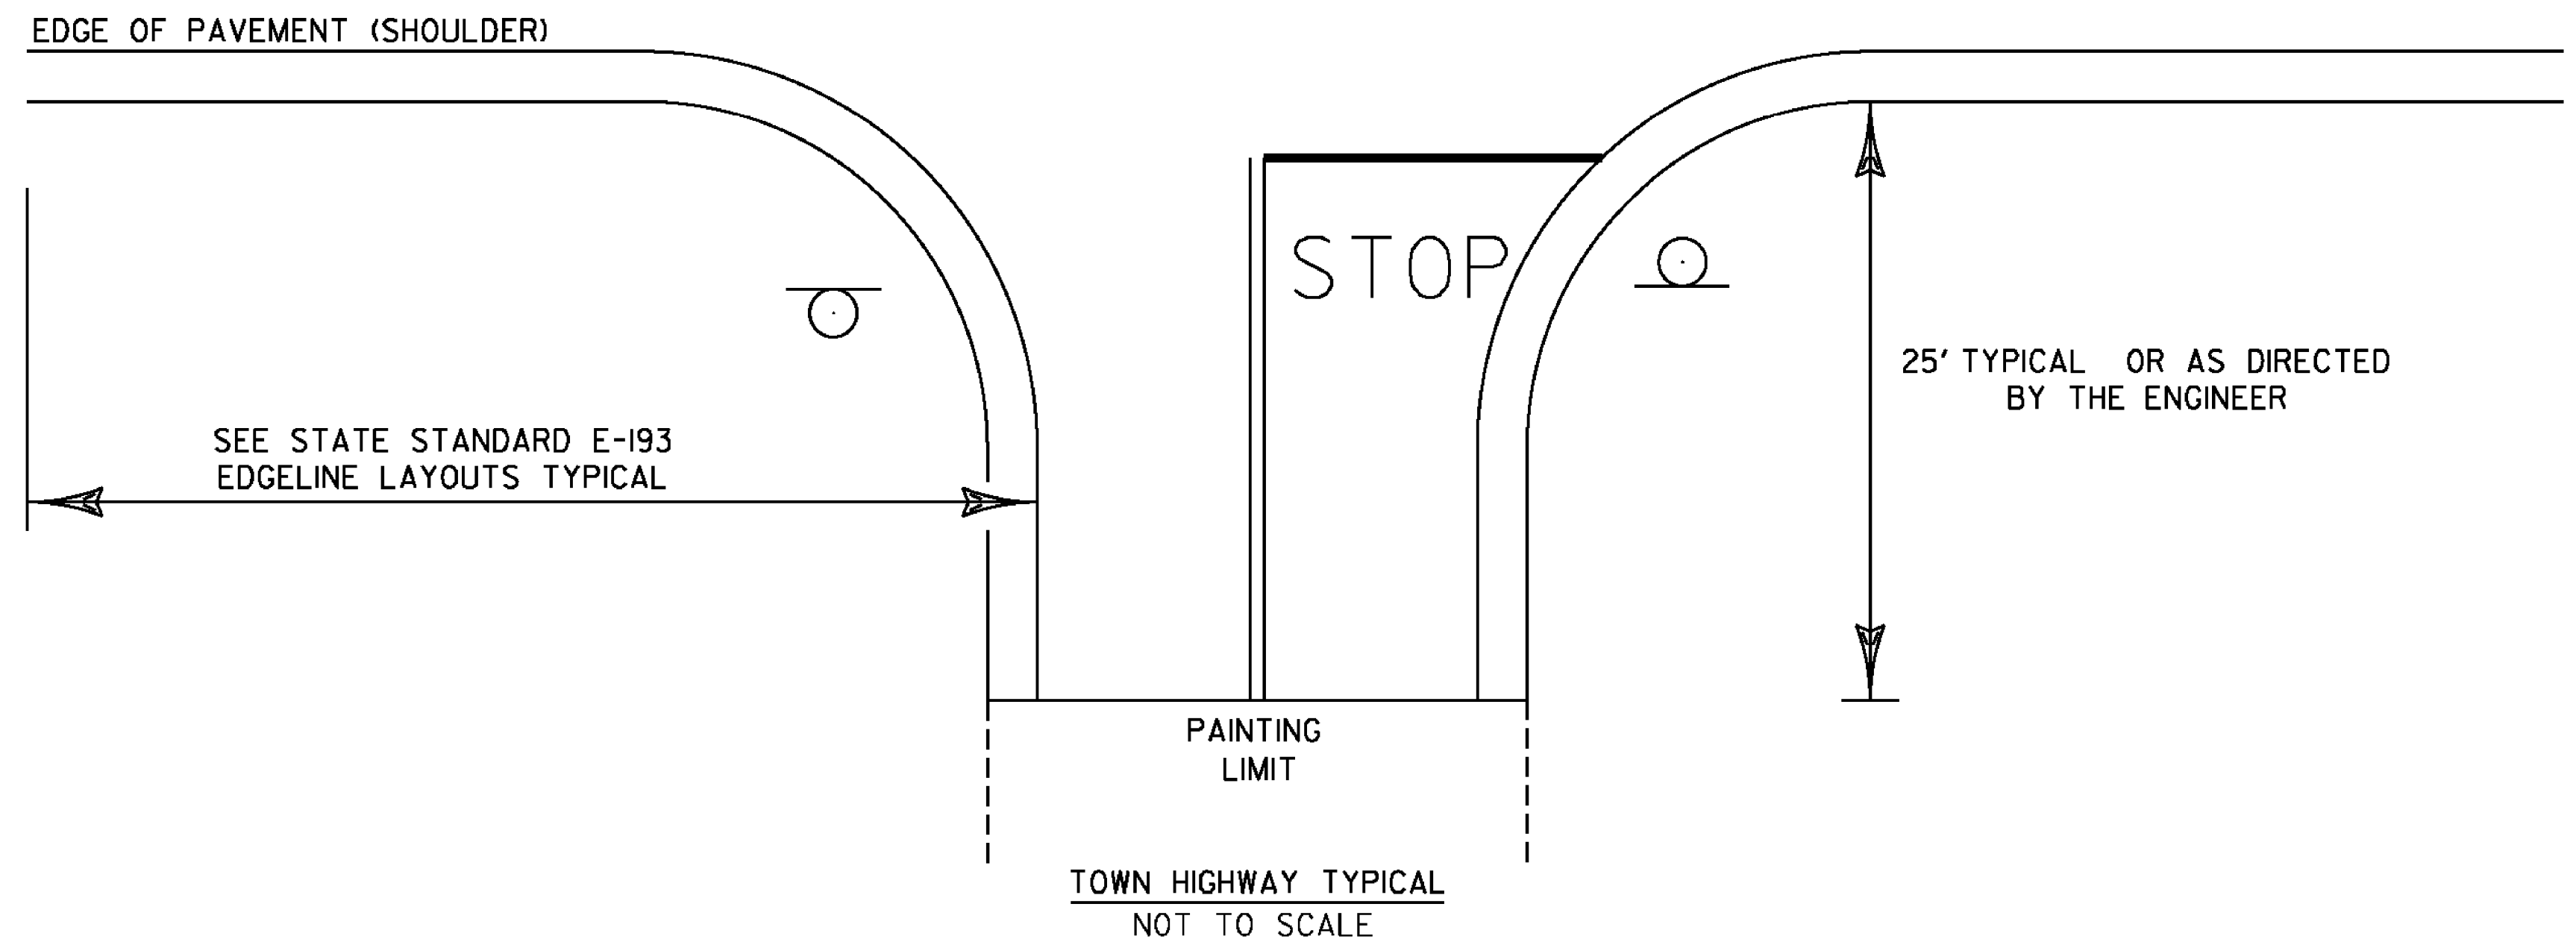

NOTES:

- 1.) SEE STD E-121 FOR THE PLACEMENT OF STOP AND LEGAL LOAD LIMIT SIGNS.
- 2.) SEE STD E-193 FOR THE PLACEMENT OF CENTERLINE, EDGELINE, STOP BARS, AND STOP LETTERS.

PROJECT NAME: STATEWIDE SOUTHEAST REGION  
PROJECT NUMBER: STP HRRR(10)

FILE NAME: d10k320.wrk.dgn  
PROJECT LEADER: JLS  
DESIGNED BY: NLA  
TOWN HIGHWAY PAVEMENT MARKINGS

PLOT DATE: 09-AUG-2011  
DRAWN BY: ITS  
CHECKED BY: JLS  
SHEET 35 OF 38