



MATERIAL TOLERANCES (IF USED ON PROJECT)	
SURFACE	
- PAVEMENT (TOTAL THICKNESS)	+/- 1/4"
- AGGREGATE SURFACE COURSE	+/- 1/2"
SUBBASE	
SUBBASE	+/- 1"
SAND BORROW	+/- 1"

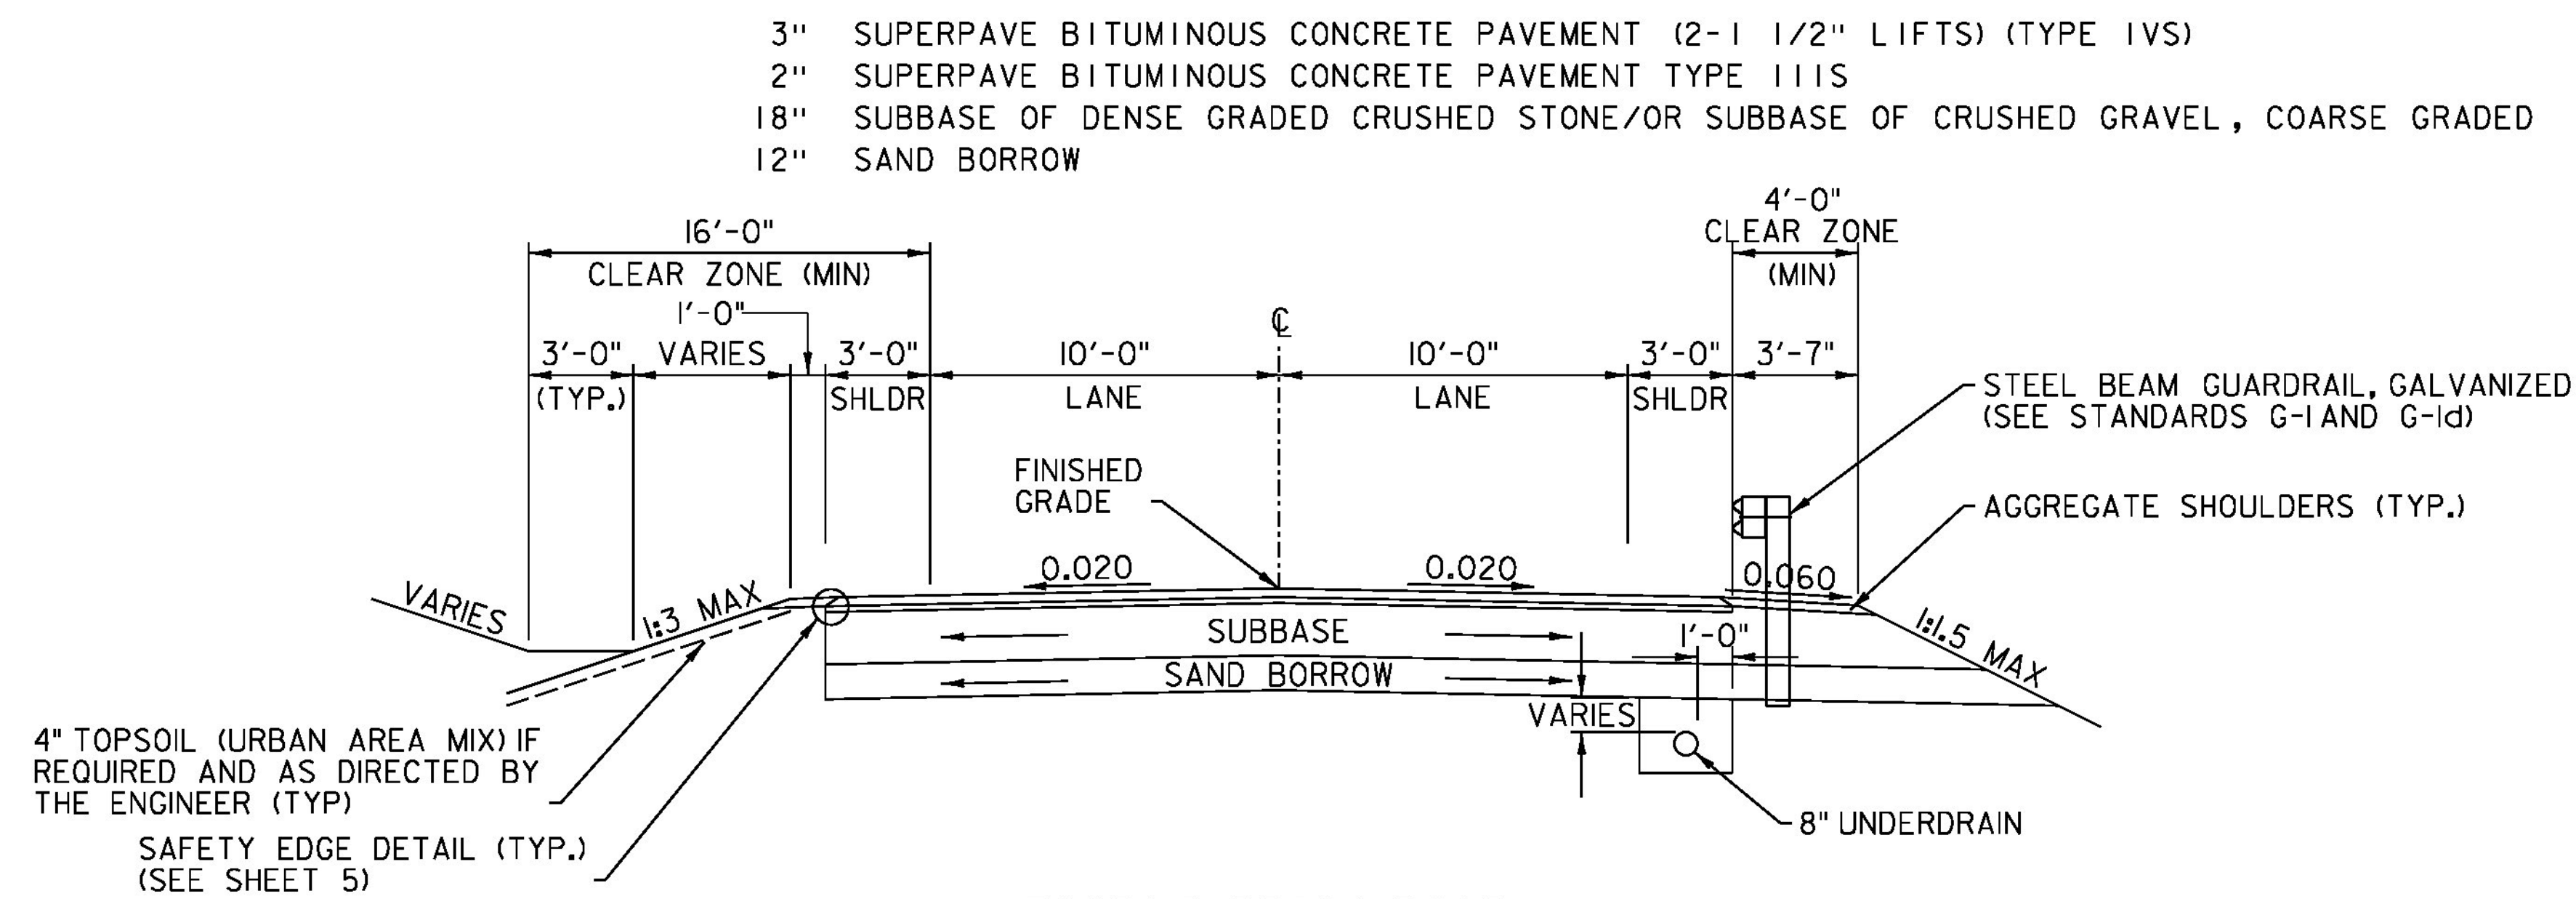

ROARING BROOK ROAD  
 NORMAL SECTION

SCALE: 1/4" = 1'-0"

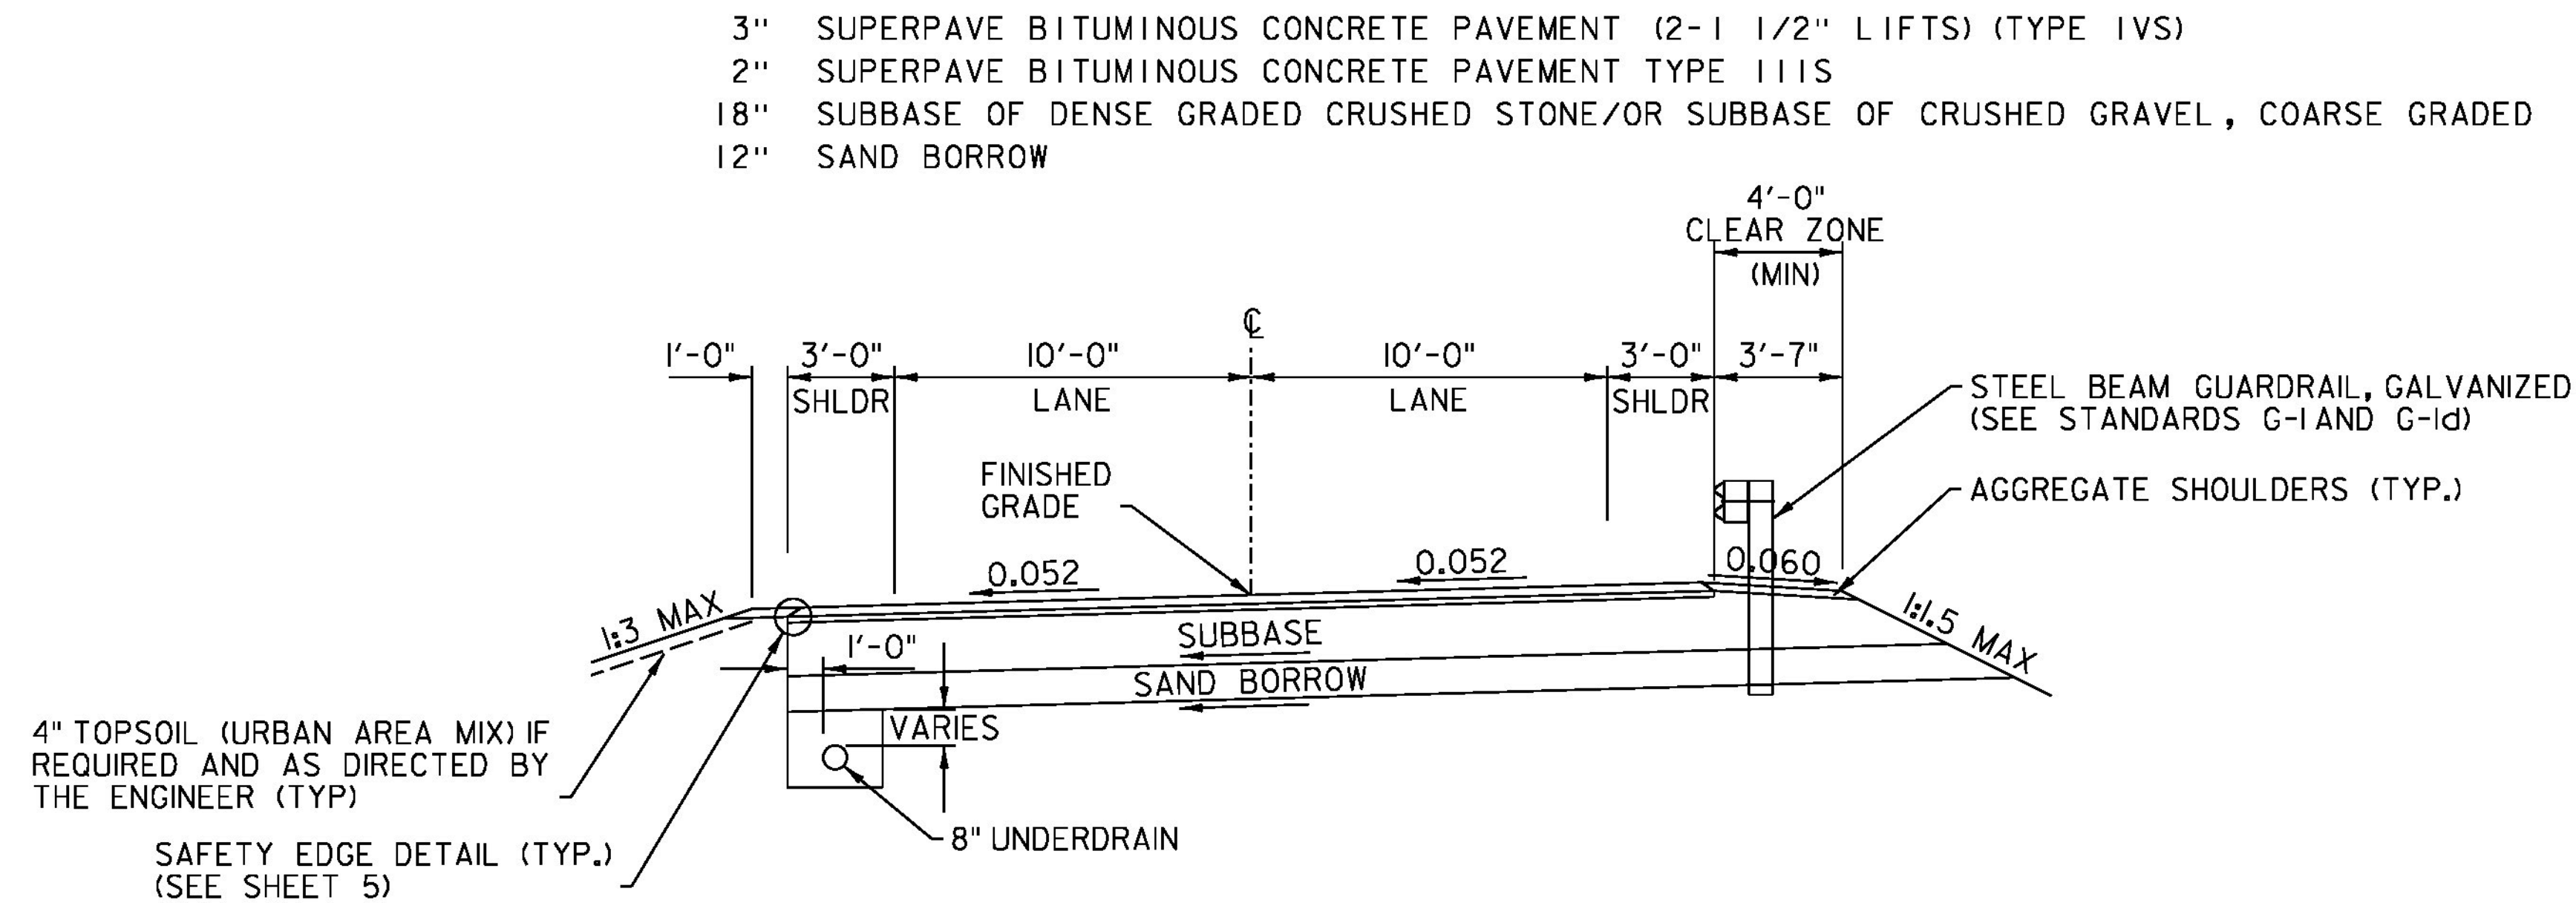

ROARING BROOK ROAD  
 MAXIMUM BANKED SECTION

SCALE: 1/4" = 1'-0"

PROJECT NAME: BARTON  
 PROJECT NUMBER: BRO 1449(31)

FILE NAME: I1J068/cos/z11J068frm.dgn  
 PROJECT LEADER: J. BYATT  
 DESIGNED BY: M. HALEY  
 TYPICAL ROADWAY SECTIONS SHEET 1

PLOT DATE: 12/17/2014  
 DRAWN BY: W. GORDON  
 CHECKED BY: P. SHEDD  
 SHEET 4 OF 52

