


THE ELEVATIONS SHOWN TO THE NEAREST TENTH ARE THE OLD GROUND ALONG THE CENTERLINE.

THE ELEVATIONS SHOWN TO THE NEAREST HUNDRETH ARE THE PROPOSED FINISHED GRADE ALONG THE CENTERLINE.

ROARING BROOK ROAD PROFILE

HOR. SCALE 1" = 20' - 0"
VER. SCALE 1" = 10' - 0"

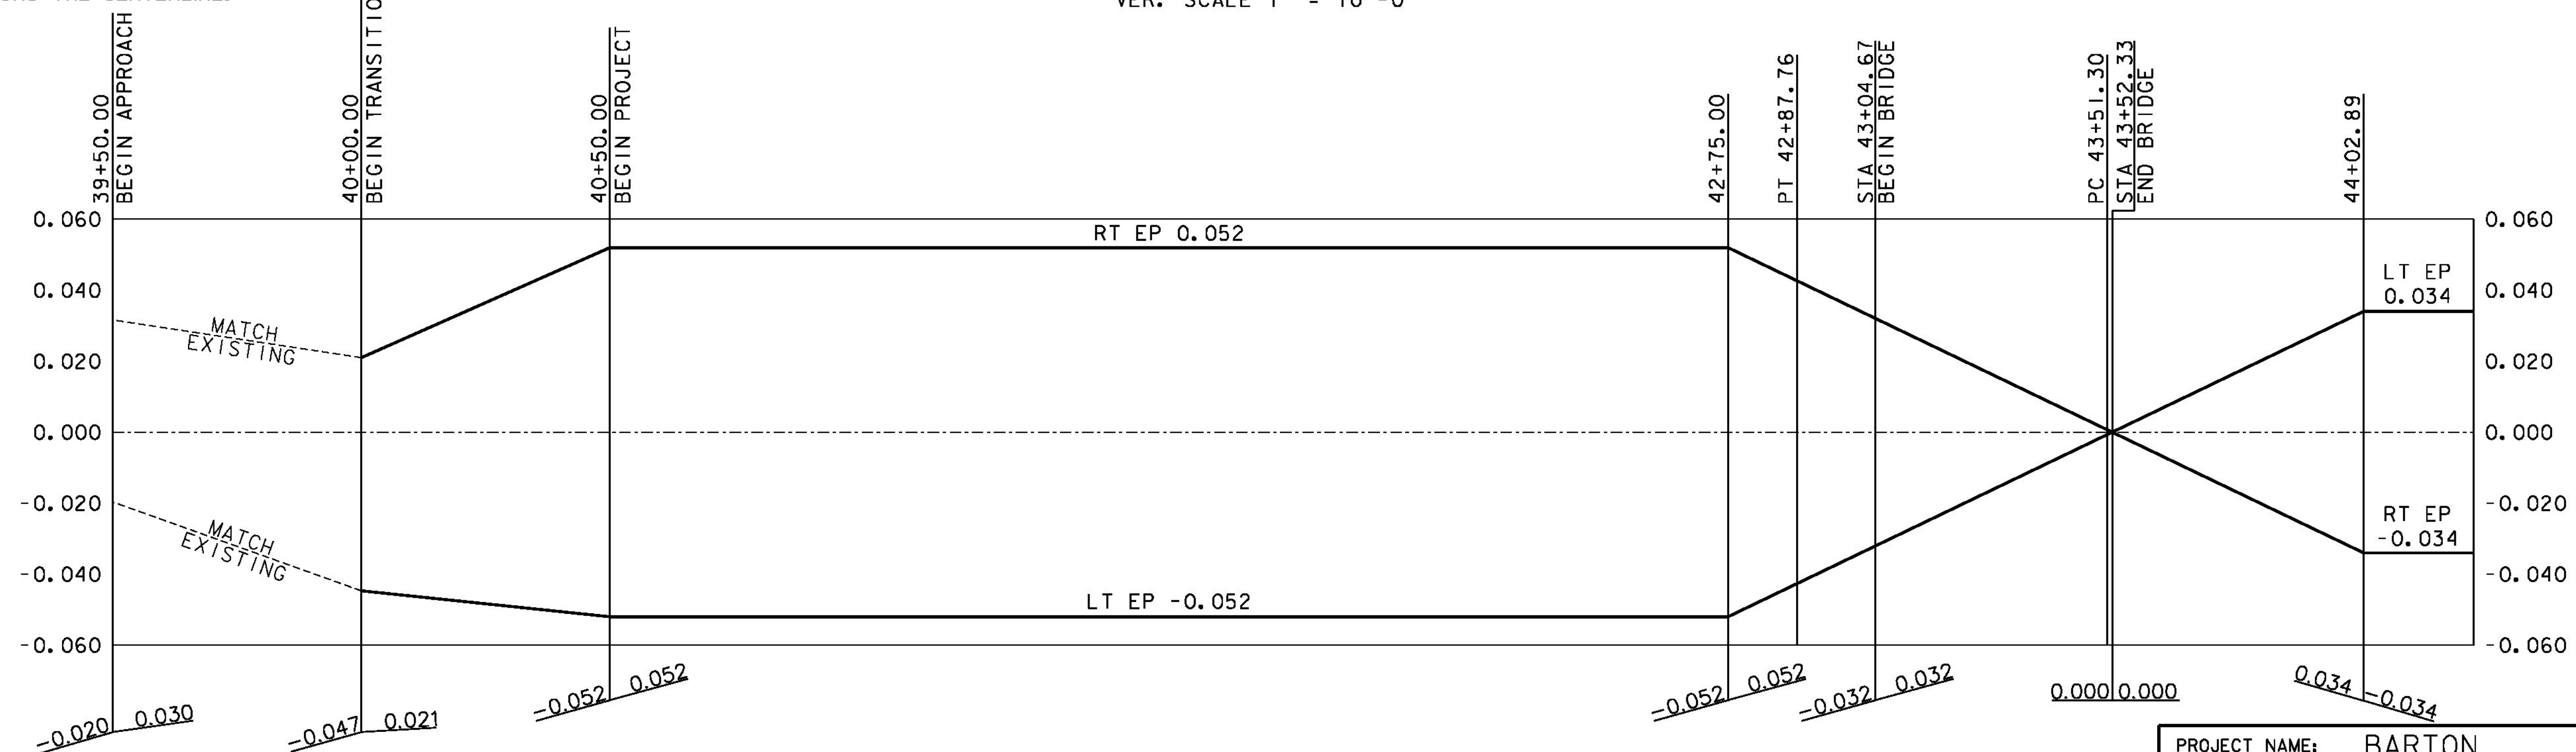

ROARING BROOK ROAD BANKING DIAGRAM

NOT TO SCALE

PROJECT NAME: BARTON
PROJECT NUMBER: BRO 1449(31)

FILE NAME: I:\J068\cos\zllj068pro.dgn
PROJECT LEADER: J. BYATT
DESIGNED BY: M. HALEY
PROFILE AND BANKING DIAGRAM SHEET 1

PLOT DATE: 12/17/2014
DRAWN BY: M. HALEY
CHECKED BY: P. SHEDD
SHEET 17 OF 52

