




TYPICAL DECK REINFORCING AT BEAM END
SCALE: 1" = 1'-0"

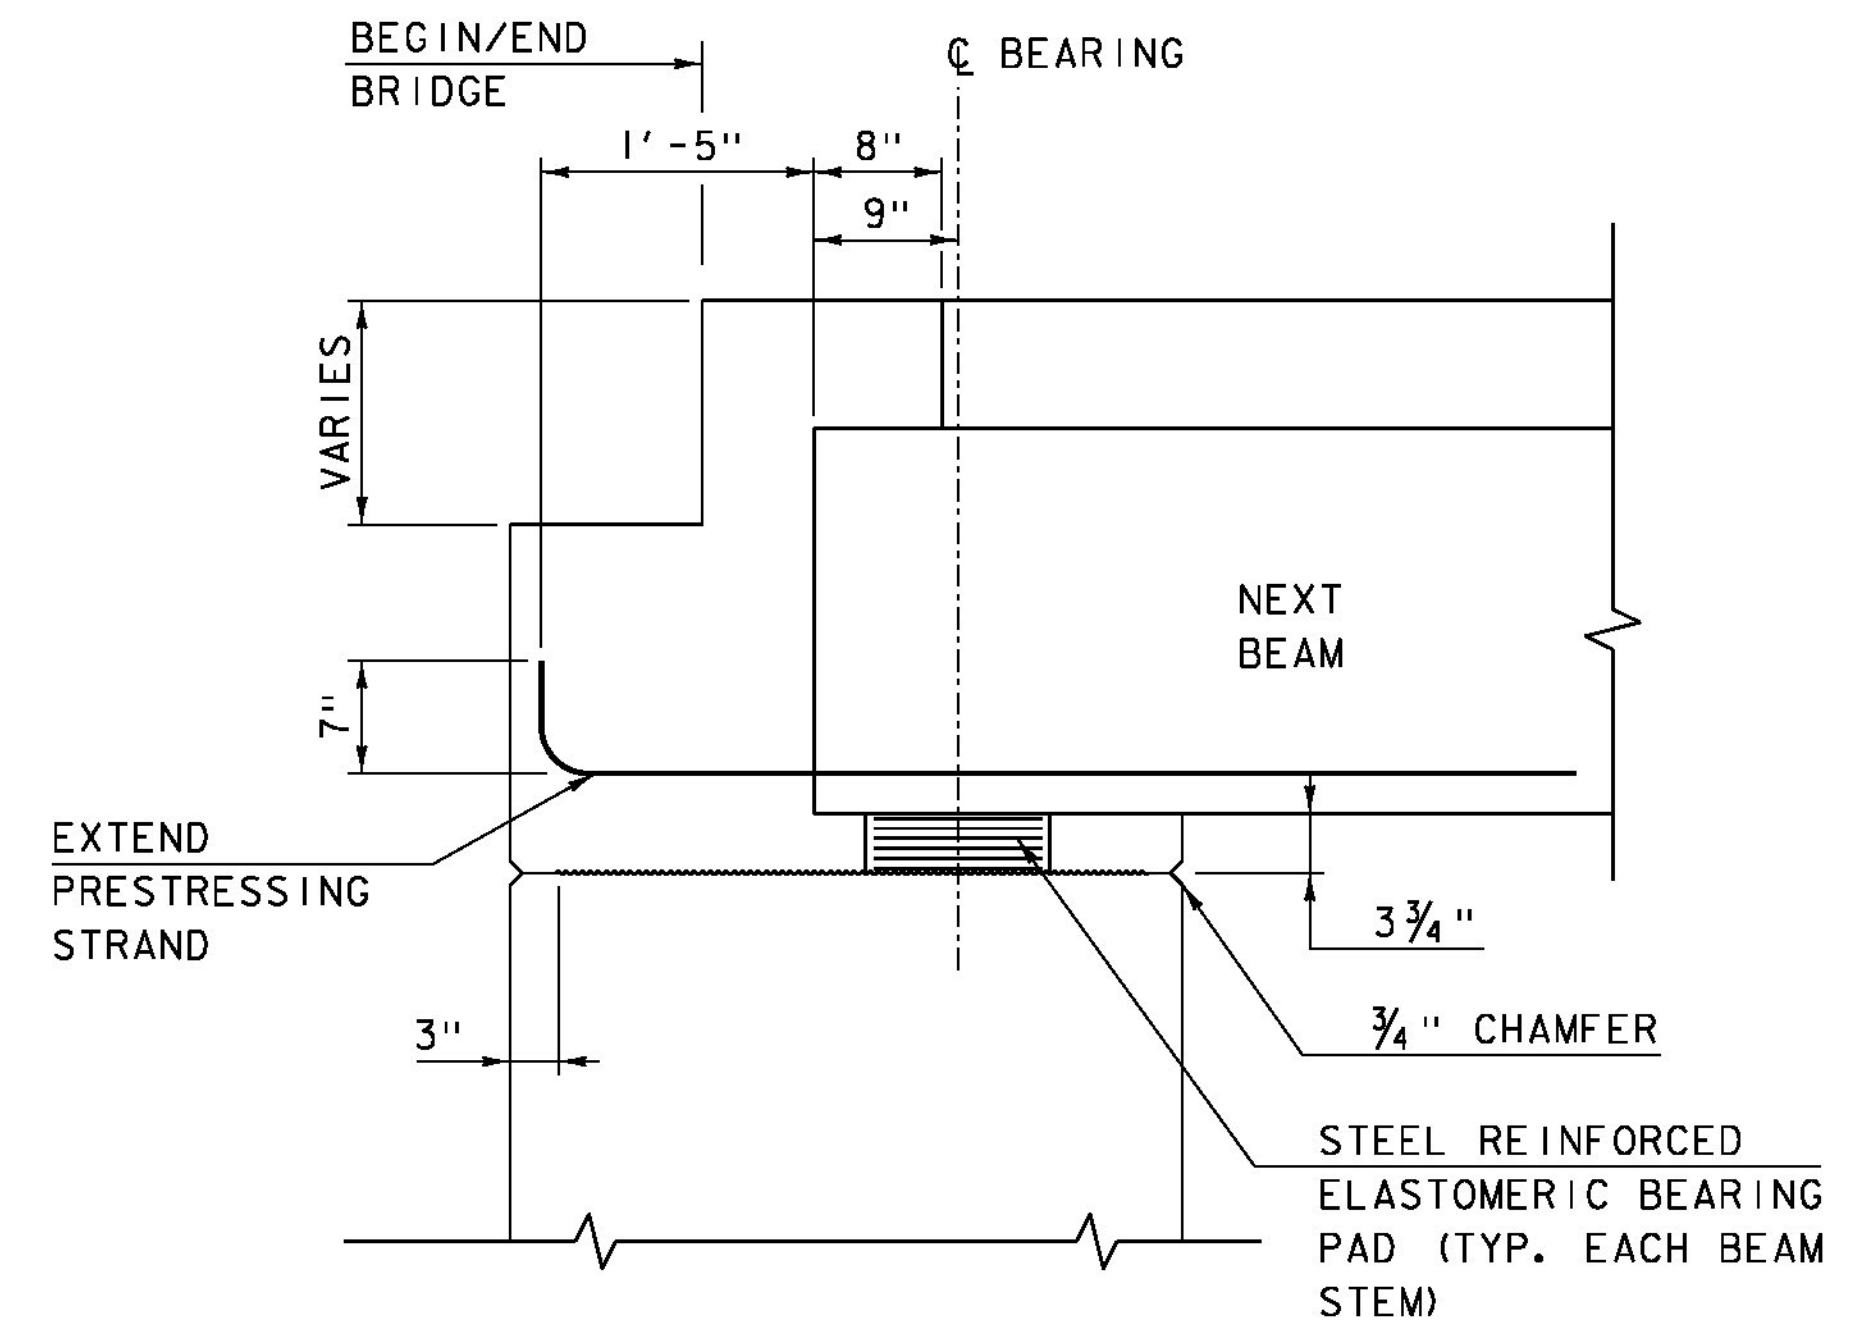

TYPICAL BEAM END DETAIL
SCALE: 1" = 1'-0"

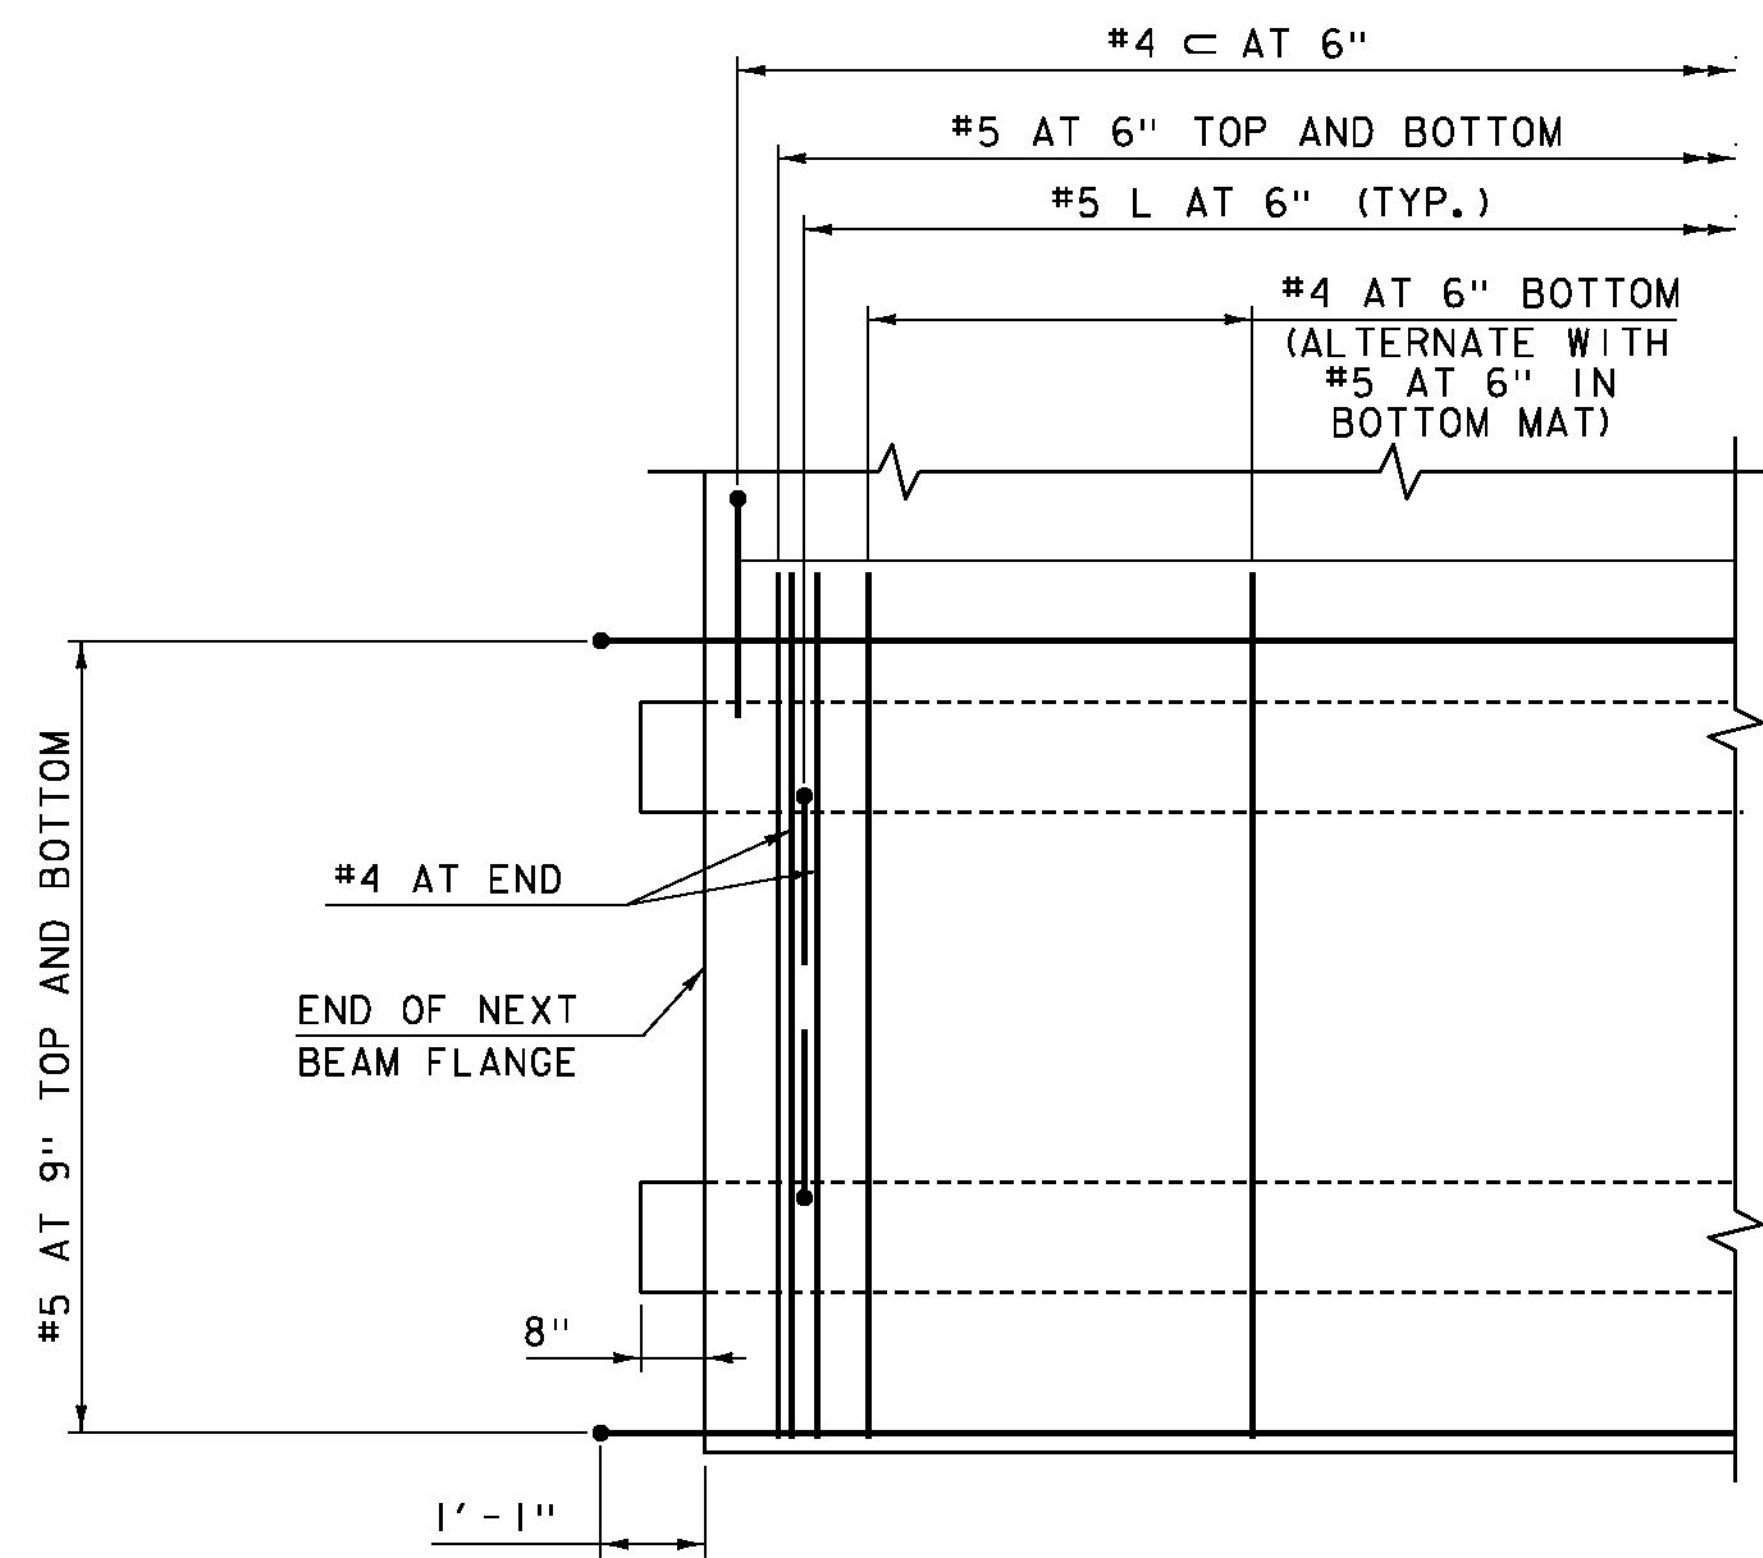

PARTIAL BEAM FLANGE PLAN
SCALE: 1/2" = 1'-0"

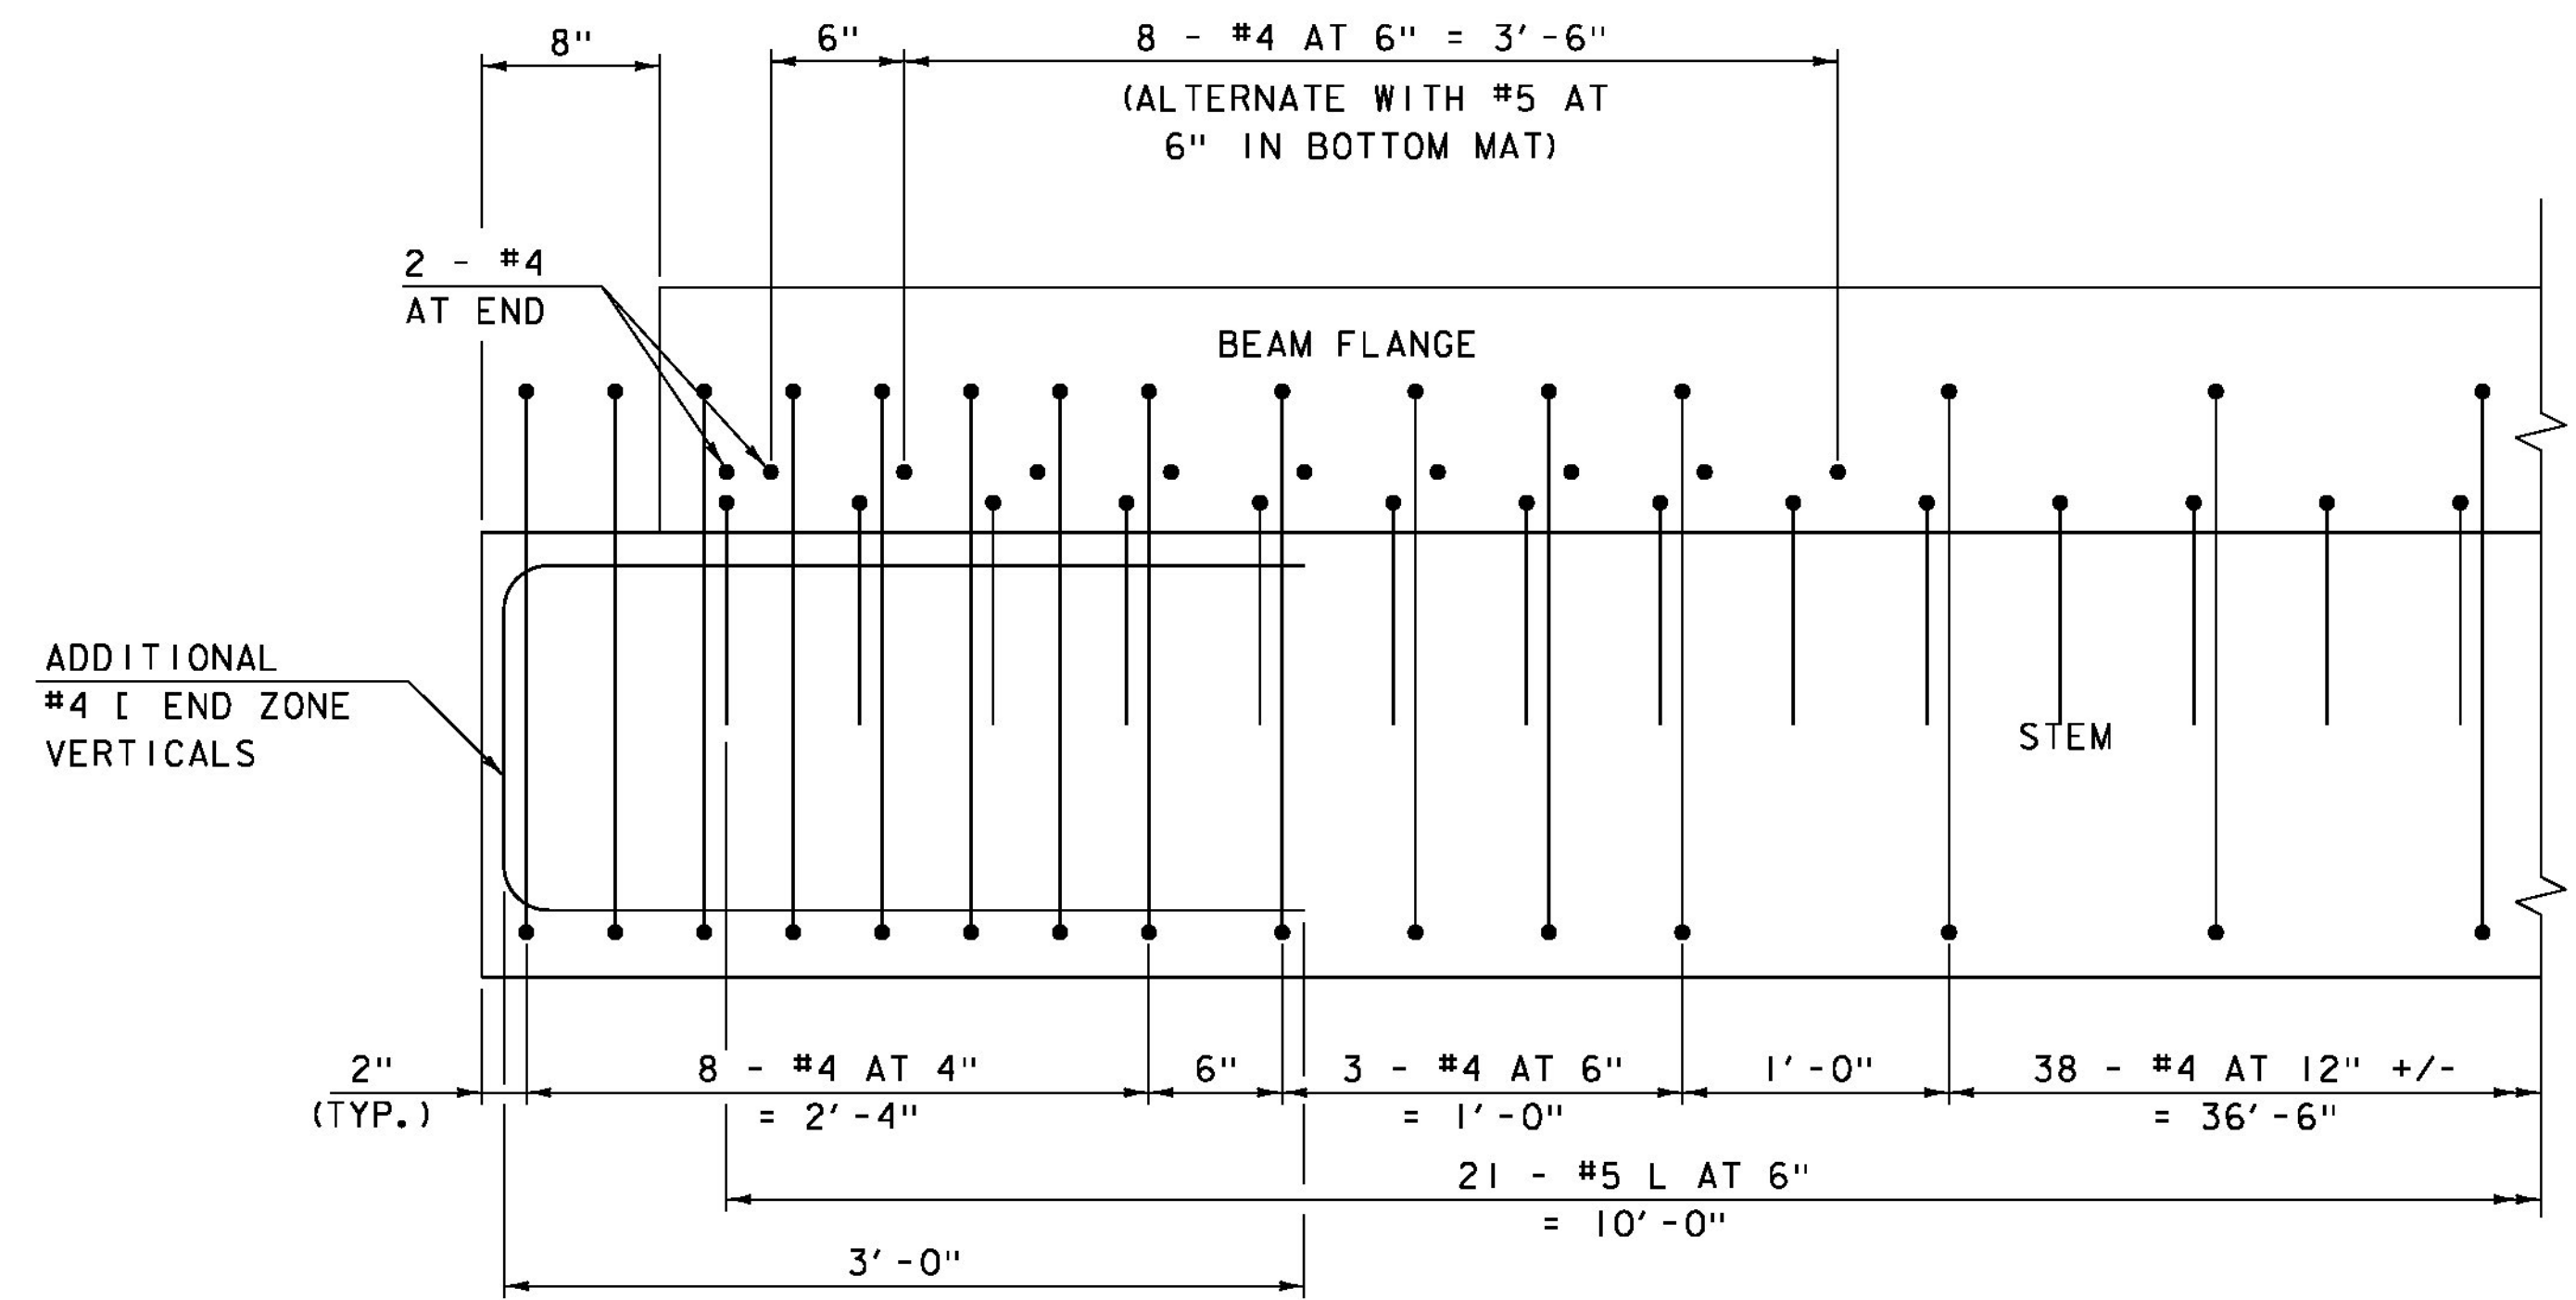

LONGITUDINAL SECTION
SCALE: 1/2" = 1'-0"

PROJECT NAME: BARTON
PROJECT NUMBER: BRO 1449(31)

FILE NAME: z11j068sup.dgn
PROJECT LEADER: J. BYATT
DESIGNED BY: N. CARON
NEXT BEAM DETAILS (3 OF 3)

PLOT DATE: 12/17/2014
DRAWN BY: M. SMITH
CHECKED BY: J. BYATT
SHEET 31 OF 52

