



RAIL AND CURB LAYOUT PLAN
SCALE: 1" = 10'-0"

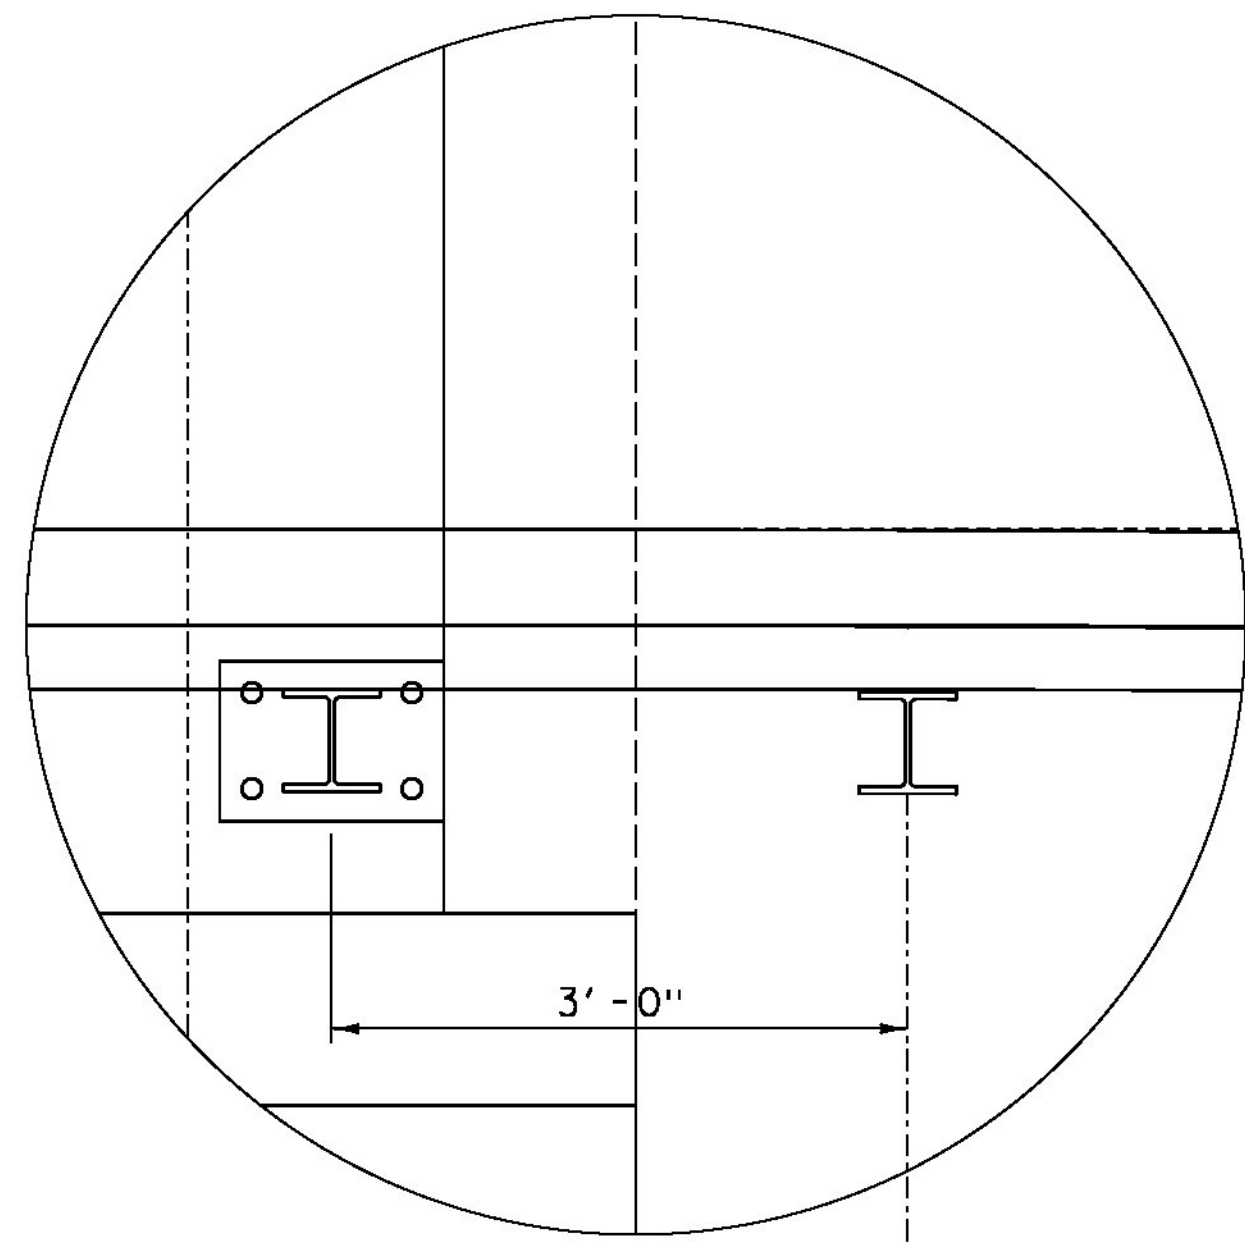

INSERT "A"
(SOUTHEAST CORNER SHOWN, OTHER CORNERS SIMILAR)
SCALE: 1" = 10'-0"

NOTES:

1. SEE STANDARDS G-1, G-1d, S-360A AND S-360B.
2. NORTHWEST CURB LENGTH HAS BEEN MODIFIED FROM STANDARD TO ACCOMMODATE DRAINAGE AT THE LOW POINT OF THE ROAD. PROVIDE REVEAL TAPER AND FLARE DETAILED IN STANDARD AT REVISED LOCATION.

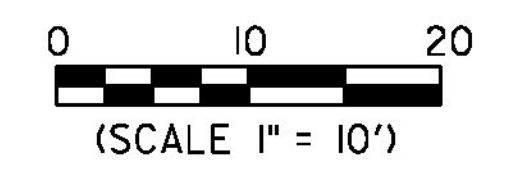

PROJECT NAME:	BARTON	FILE NAME:	I1J068/cos/z11J068rail.dgn	PLOT DATE:	12/17/2014
PROJECT NUMBER:	BRO 1449(31)	PROJECT LEADER:	J. BYATT	DRAWN BY:	M. SMITH
		DESIGNED BY:	S. BEAUMONT	CHECKED BY:	J. BYATT
		RAIL AND CURB LAYOUT SHEET		SHEET	39 OF 52



MODEL: RAIL01
GLD 12-0174