




40+00

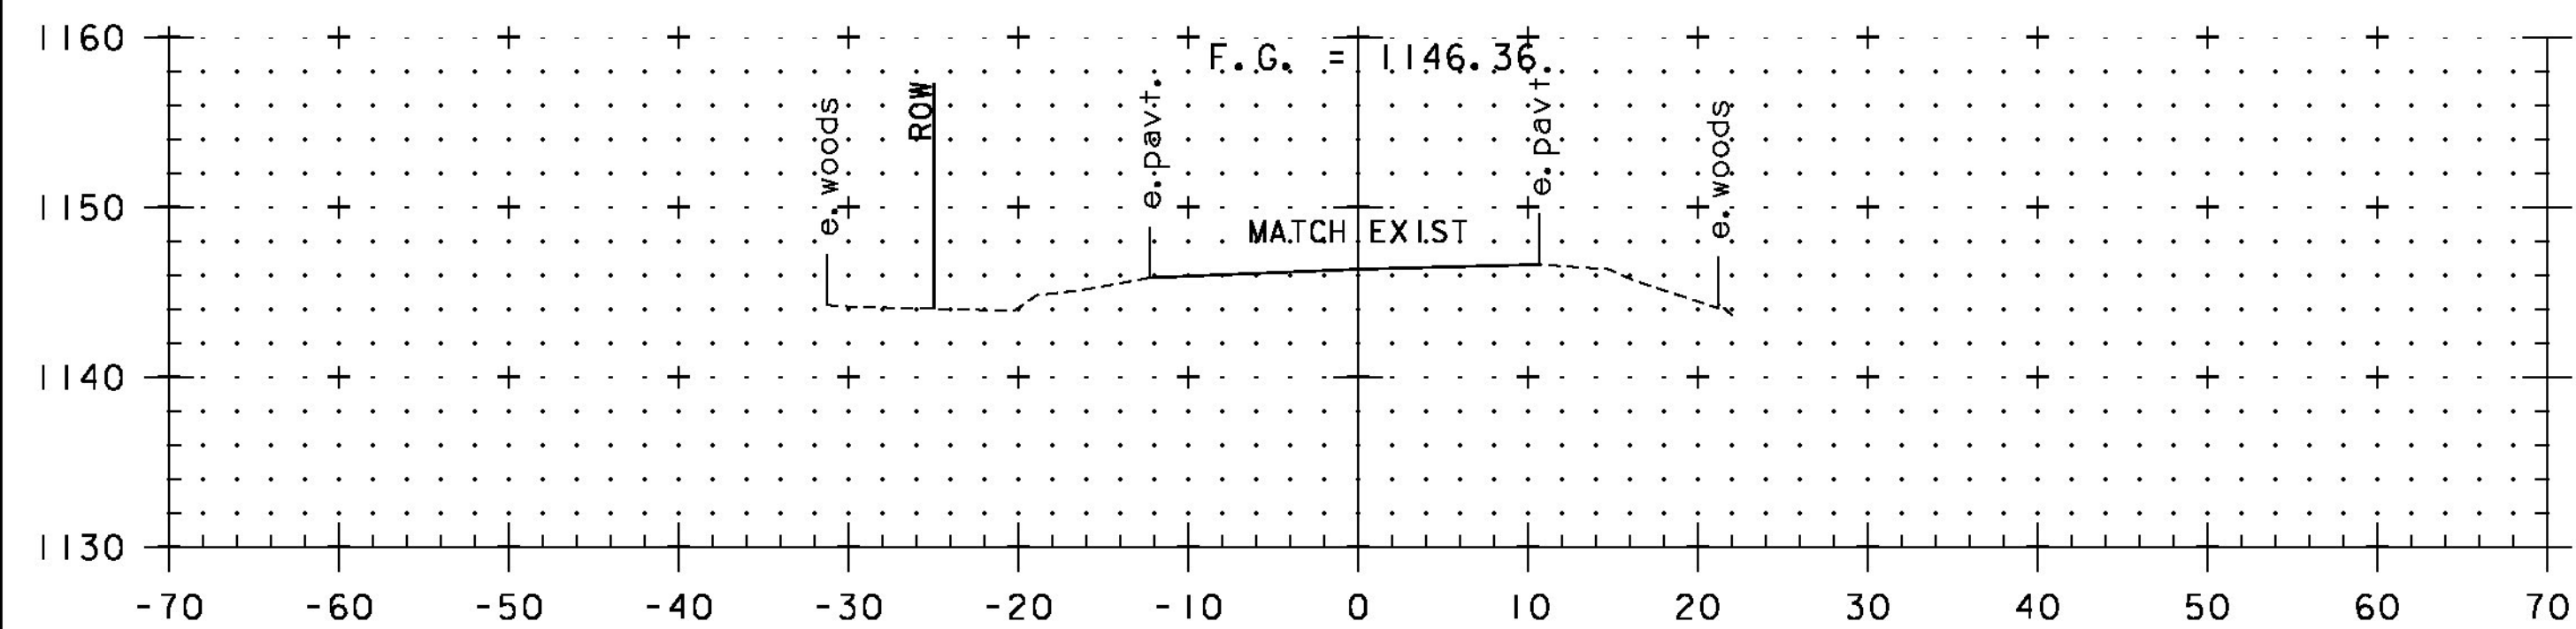


39+75

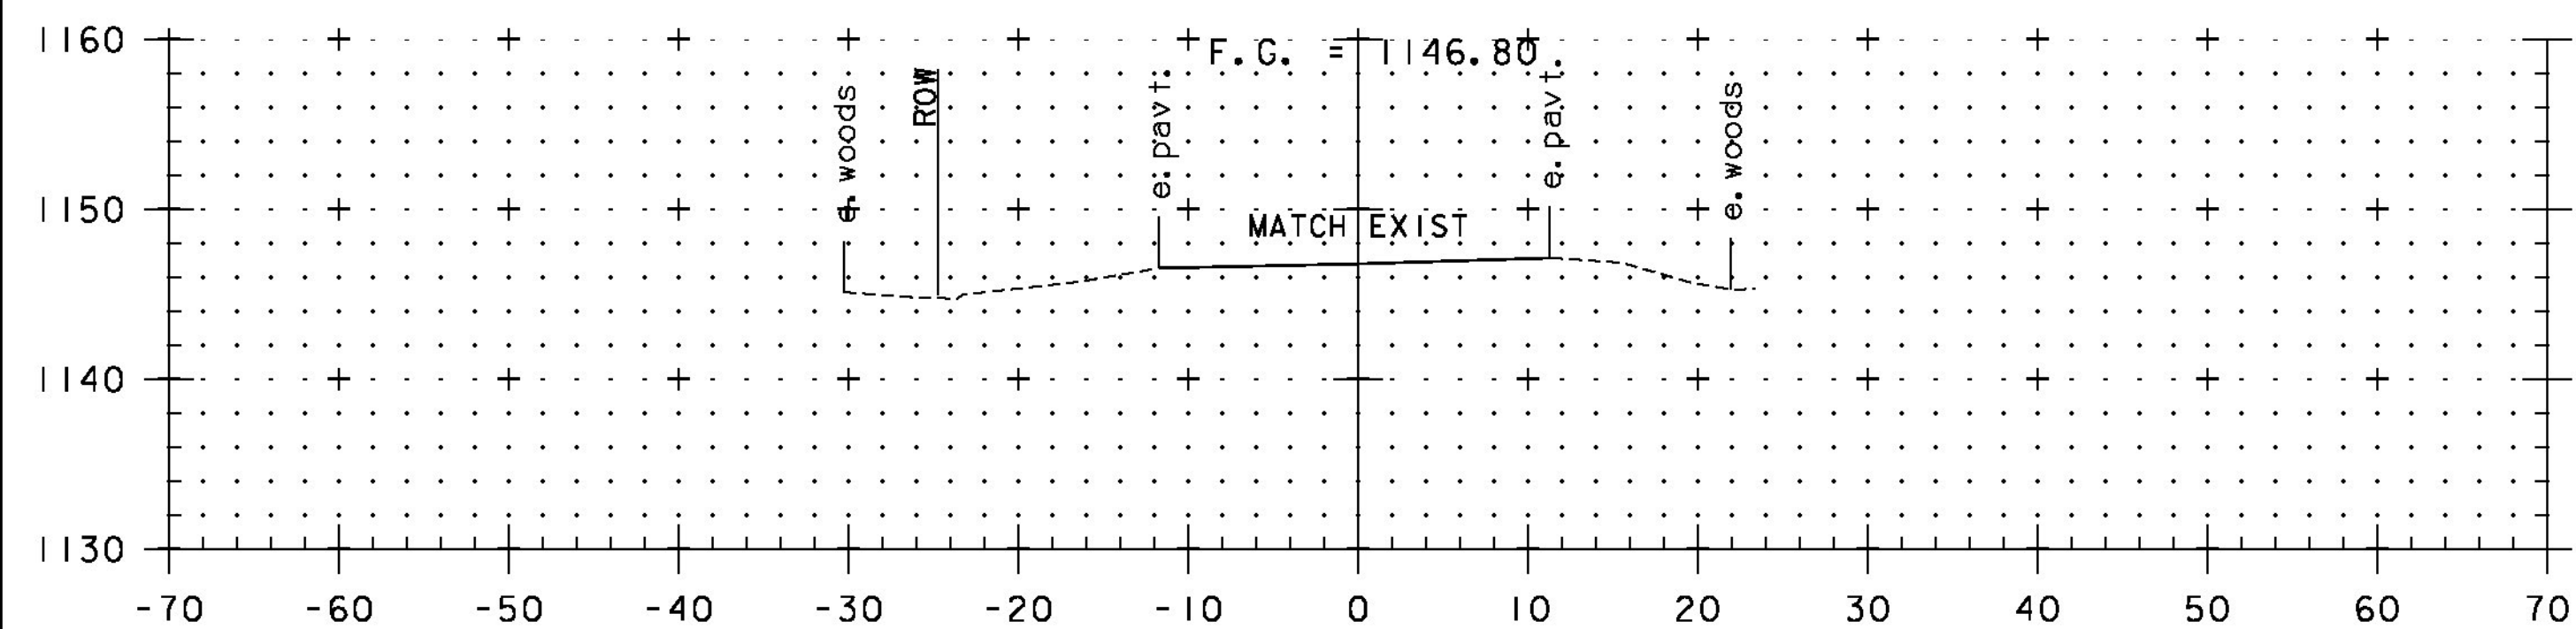


39+50  
BEGIN APPROACH

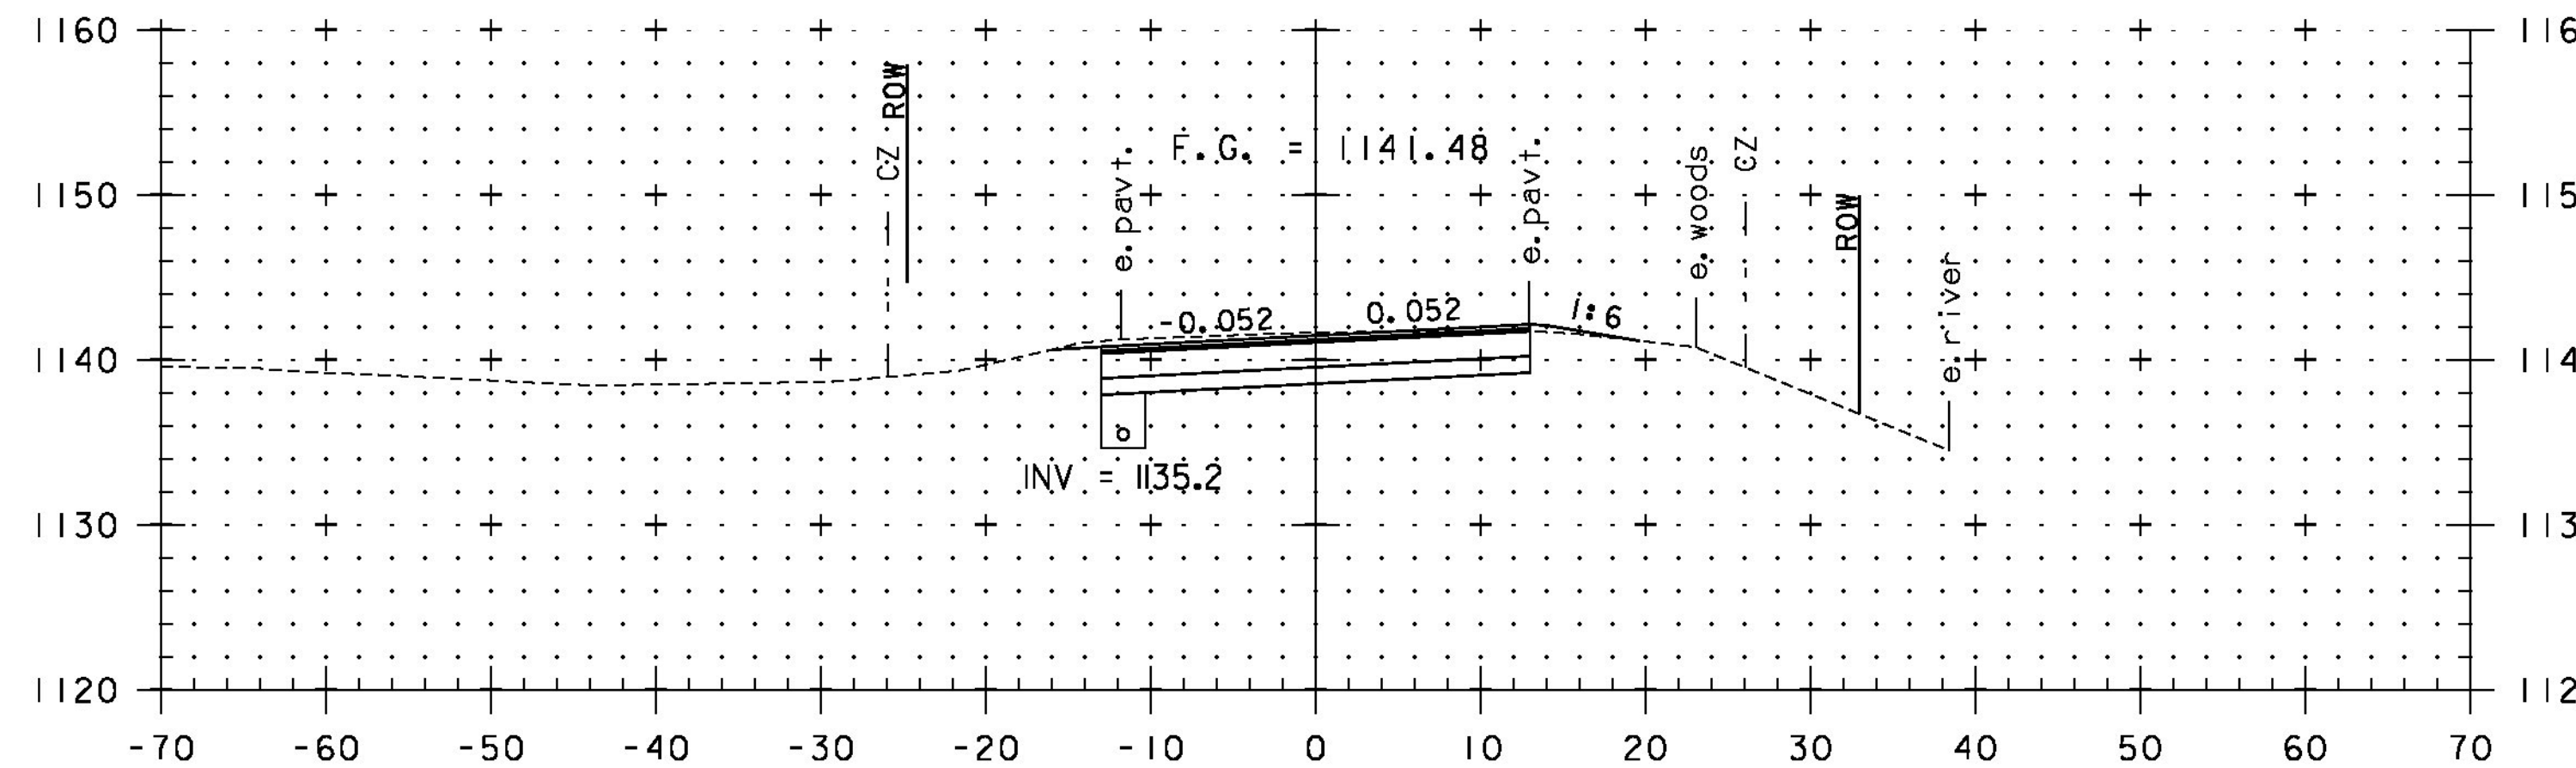

41+50

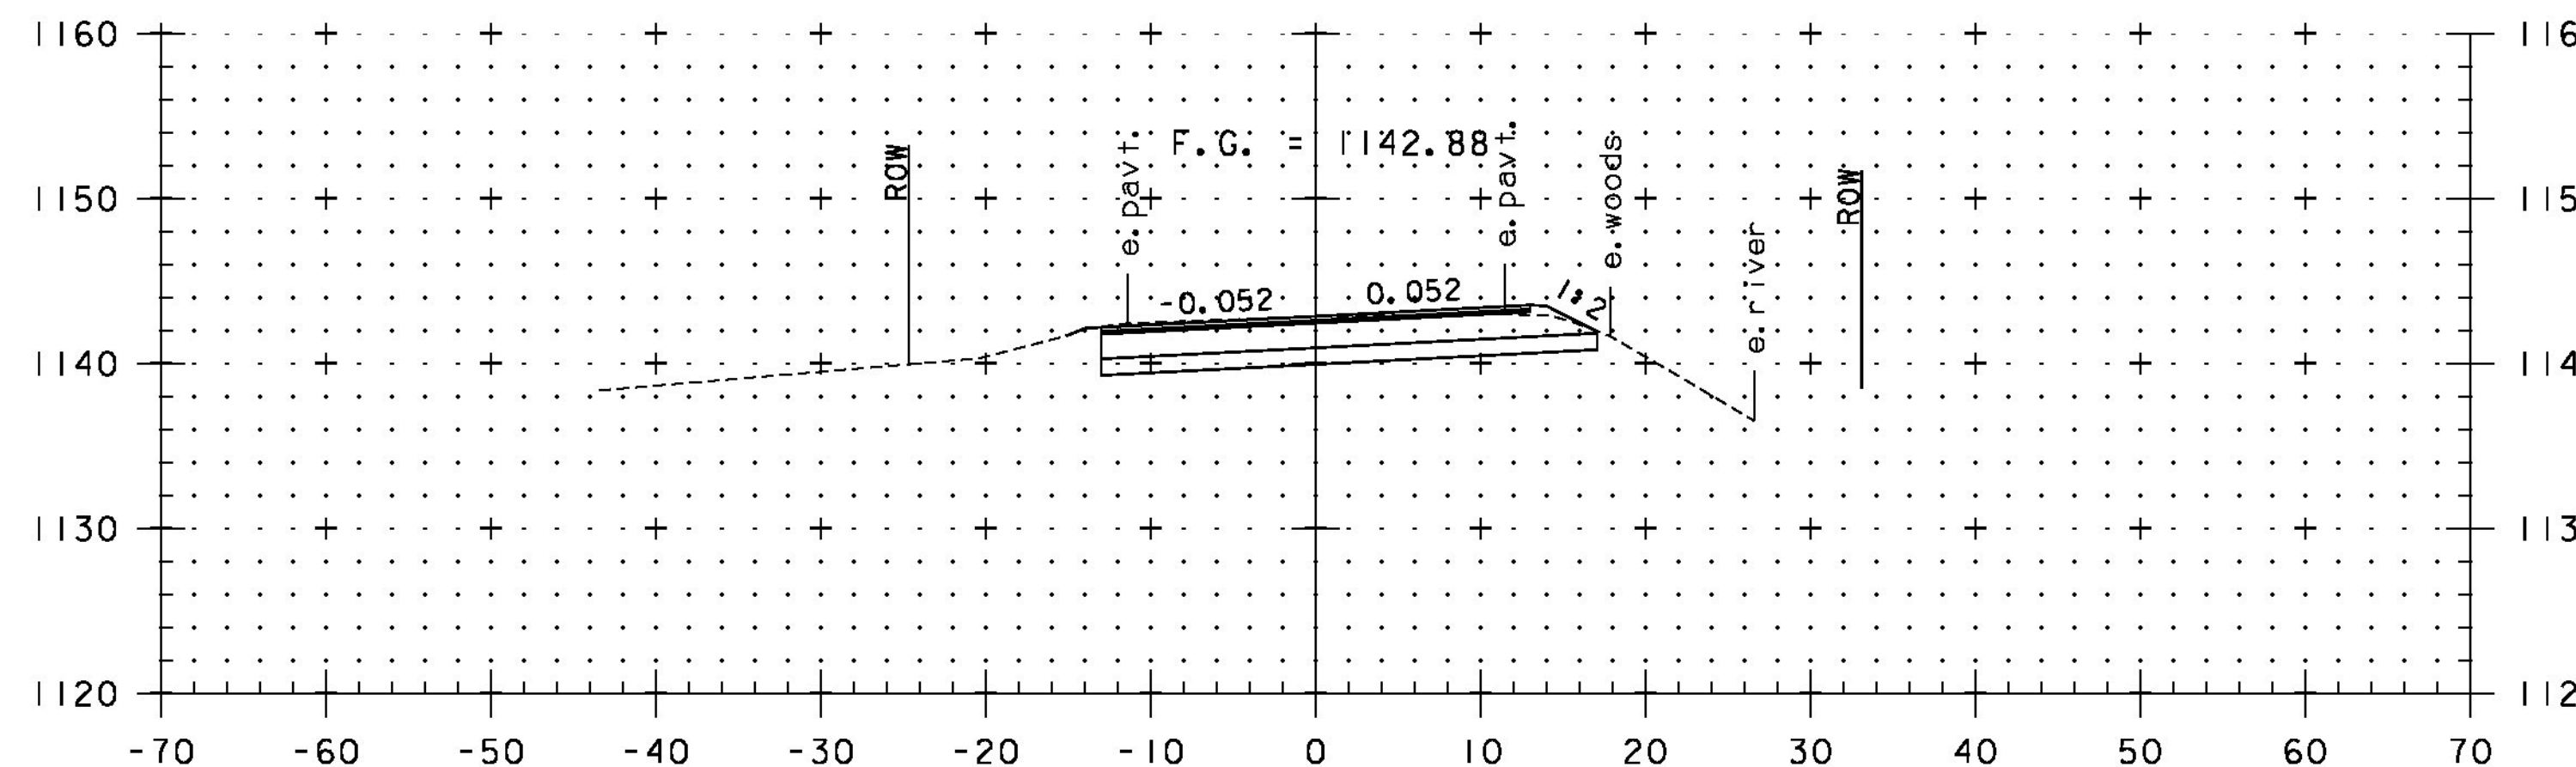


41+00

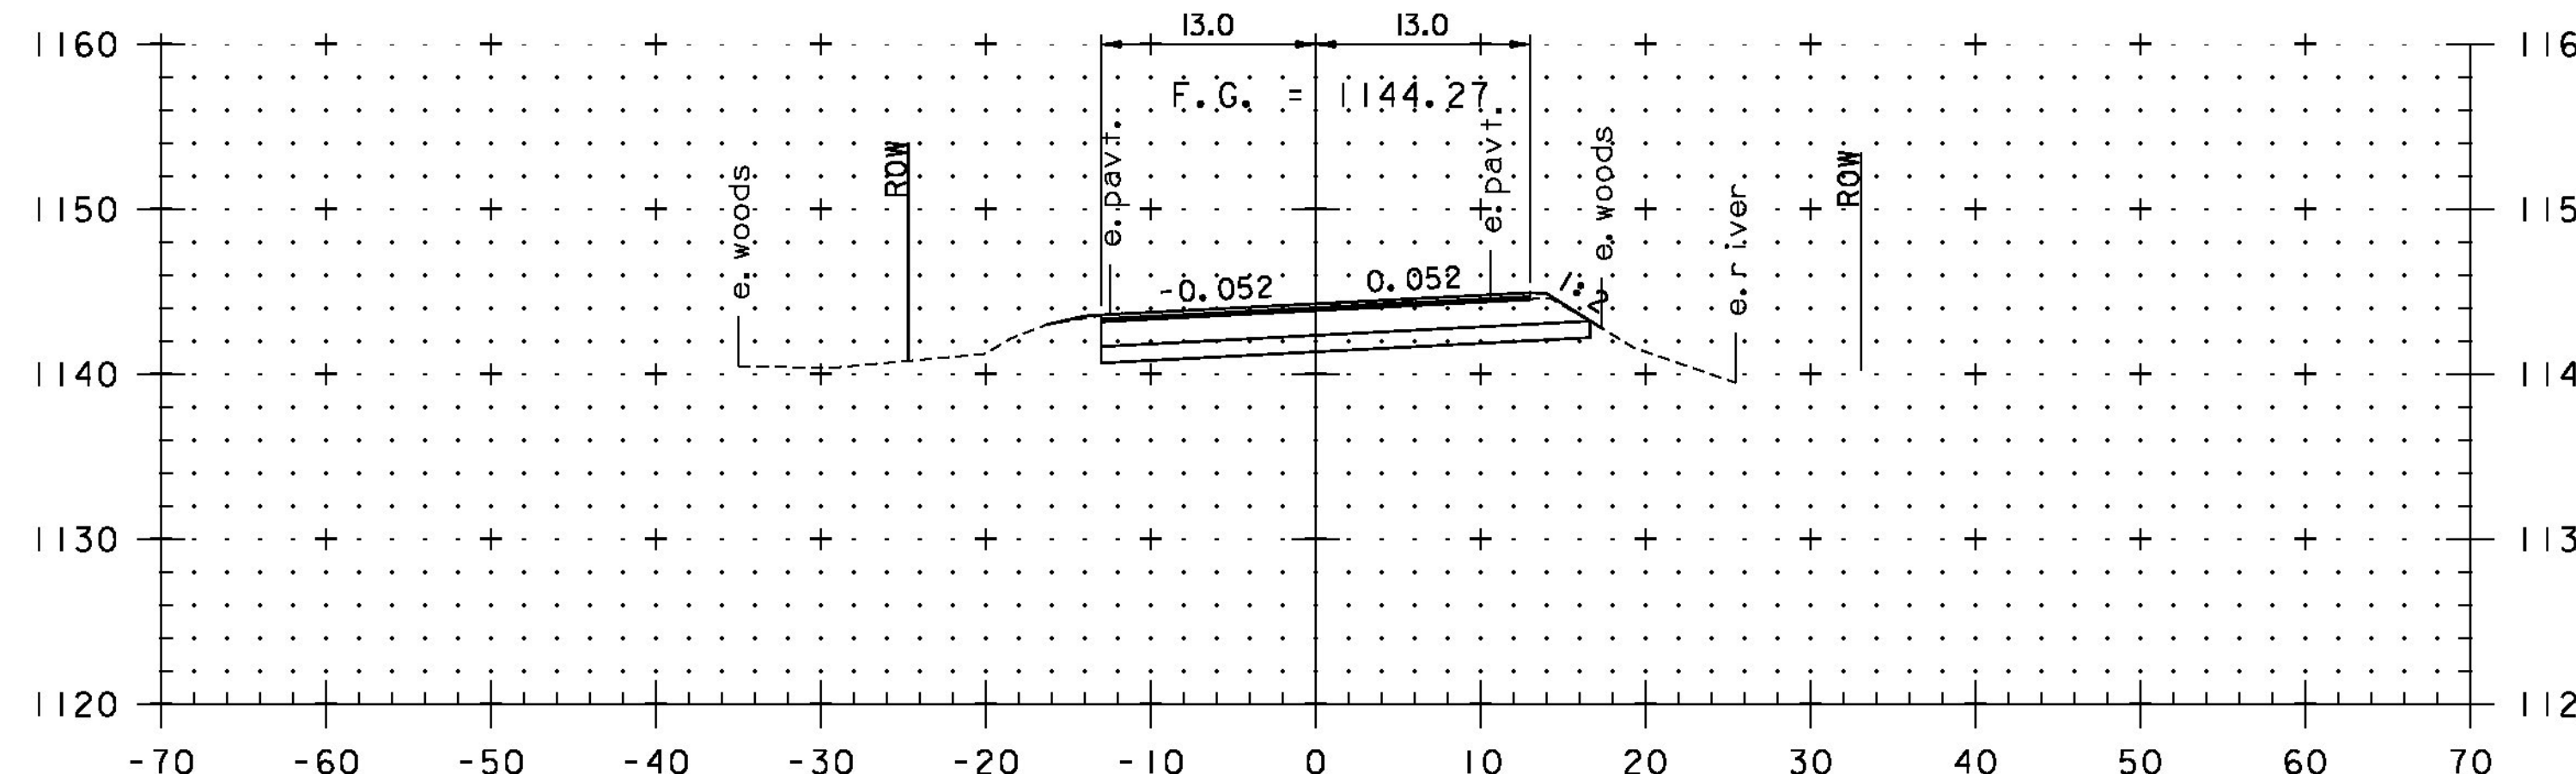

40+50  
BEGIN PROJECT

STA. 39+50 TO STA. 41+50

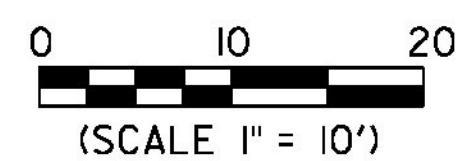

PROJECT NAME: BARTON  
PROJECT NUMBER: BRO 1449(31)

FILE NAME: I1J068/cos/z11J068xs.dgn  
PROJECT LEADER: J. BYATT  
DESIGNED BY: M. HALEY  
ROADWAY CROSS SECTIONS I

PLOT DATE: 12/17/2014  
DRAWN BY: M. HALEY  
CHECKED BY: P. SHEDD  
SHEET 41 OF 52