




42+00

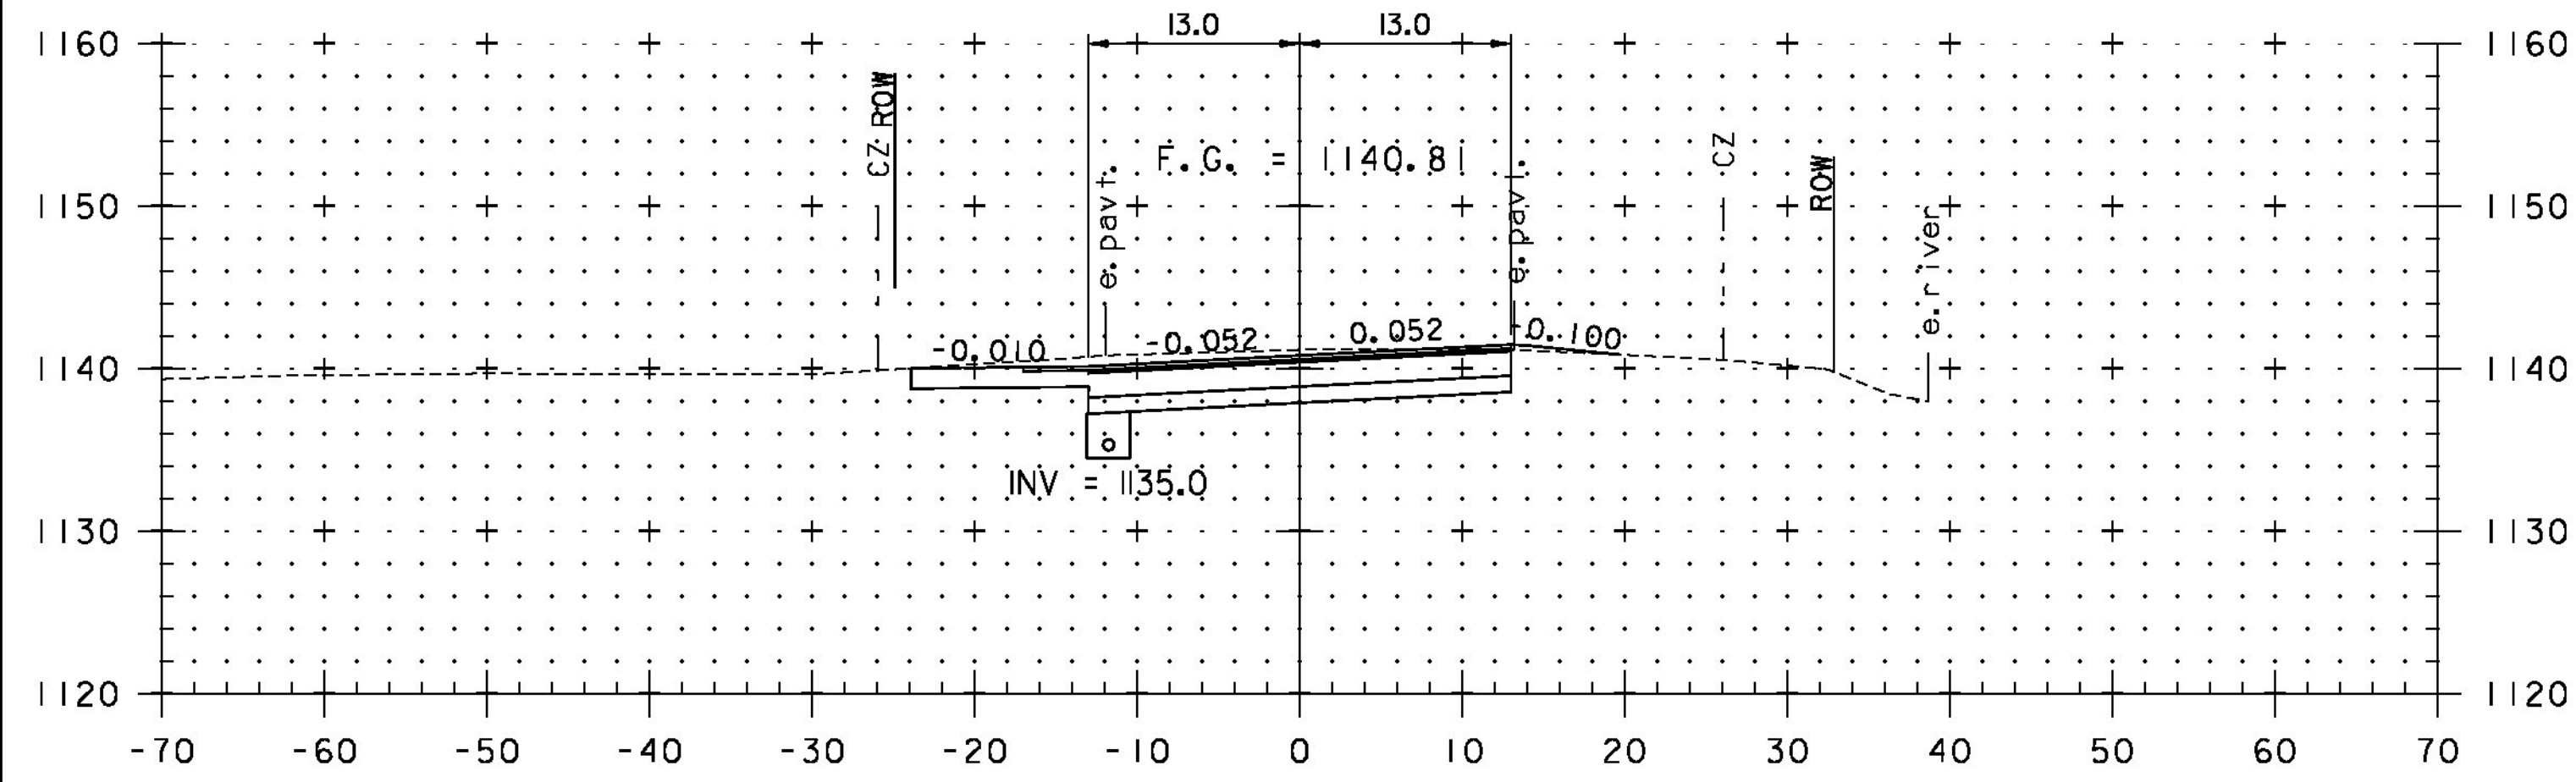

41+75
DRIVE LT

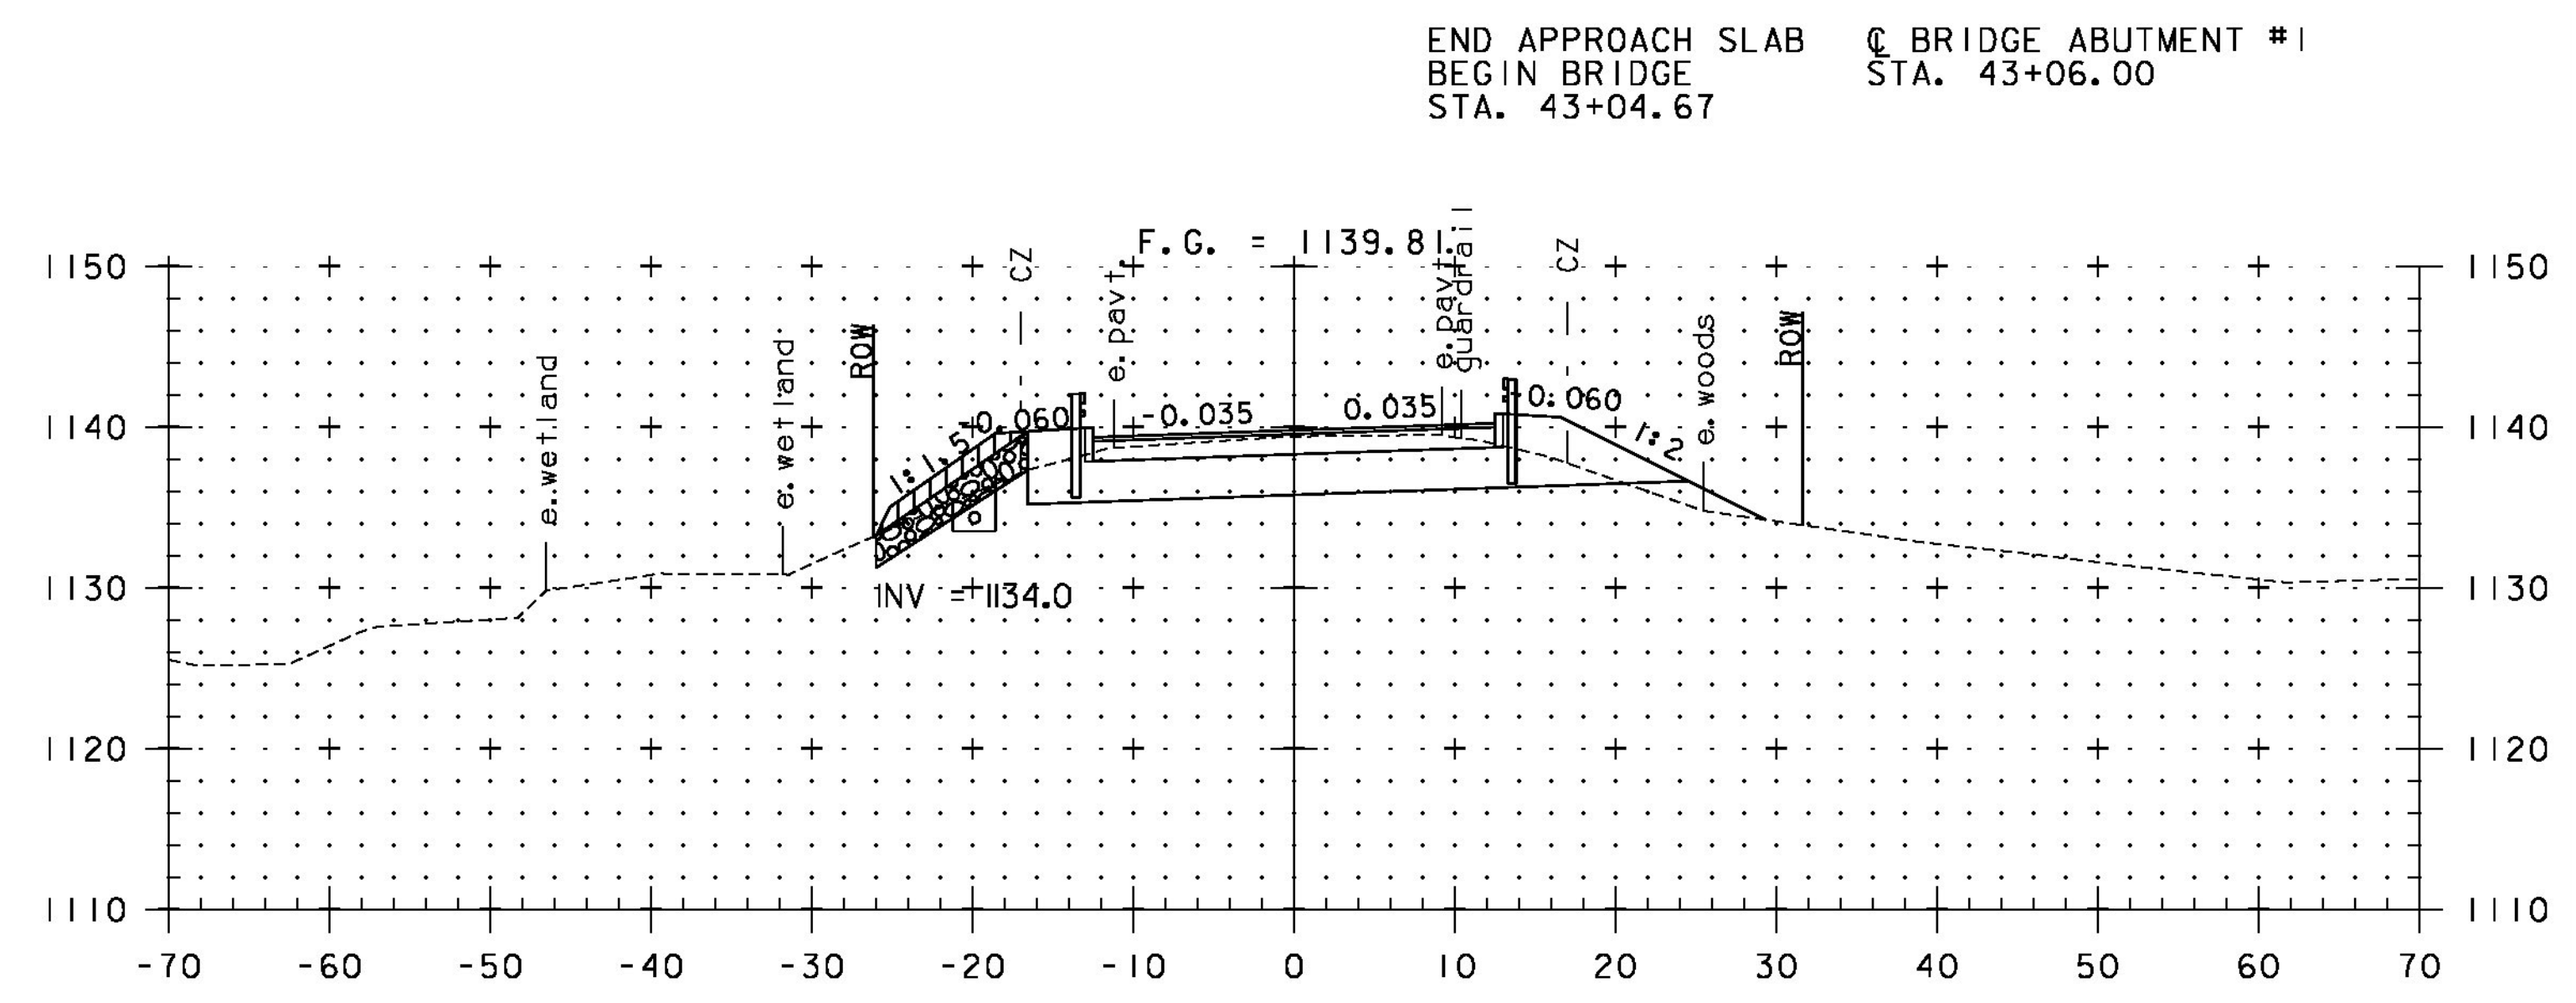

43+00

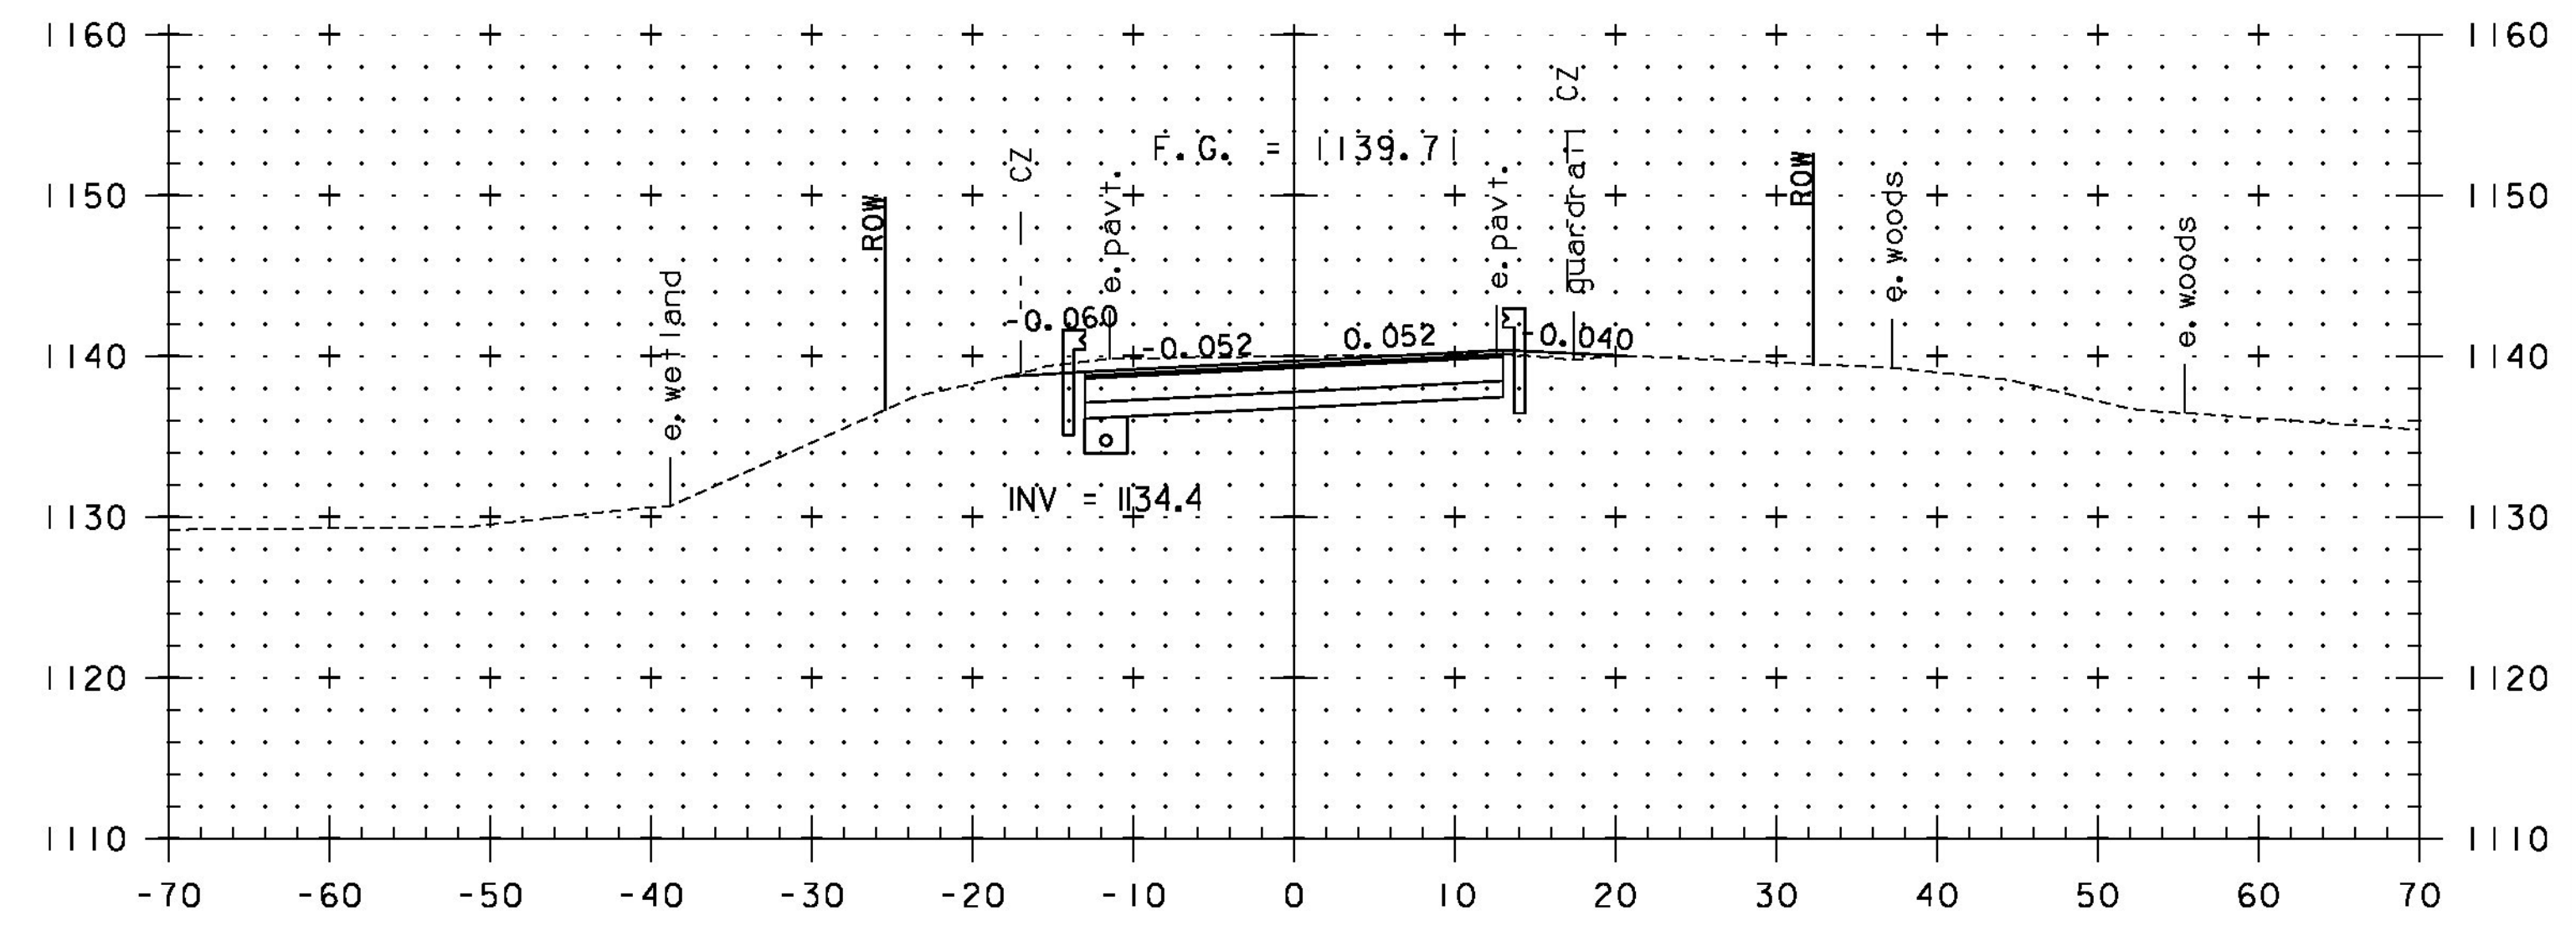


42+50

END APPROACH SLAB @ BRIDGE ABUTMENT #1
 BEGIN BRIDGE STA. 43+06.00
 STA. 43+04.67

BEGIN APPROACH SLAB
 STA. 42+89.67

STA. 41+75 TO STA. 43+00

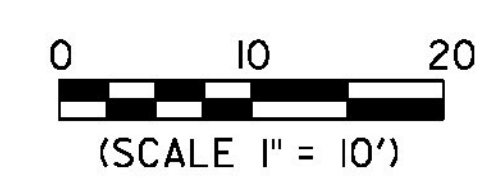

PROJECT NAME: BARTON	PLOT DATE: 12/17/2014
PROJECT NUMBER: BRO 1449(31)	DRAWN BY: M. HALEY
FILE NAME: I1J068/cos/z11J068xs.dgn	CHECKED BY: P. SHEDD
PROJECT LEADER: J. BYATT	SHEET 42 OF 52
DESIGNED BY: M. HALEY	
ROADWAY CROSS SECTIONS 2	