




46+25

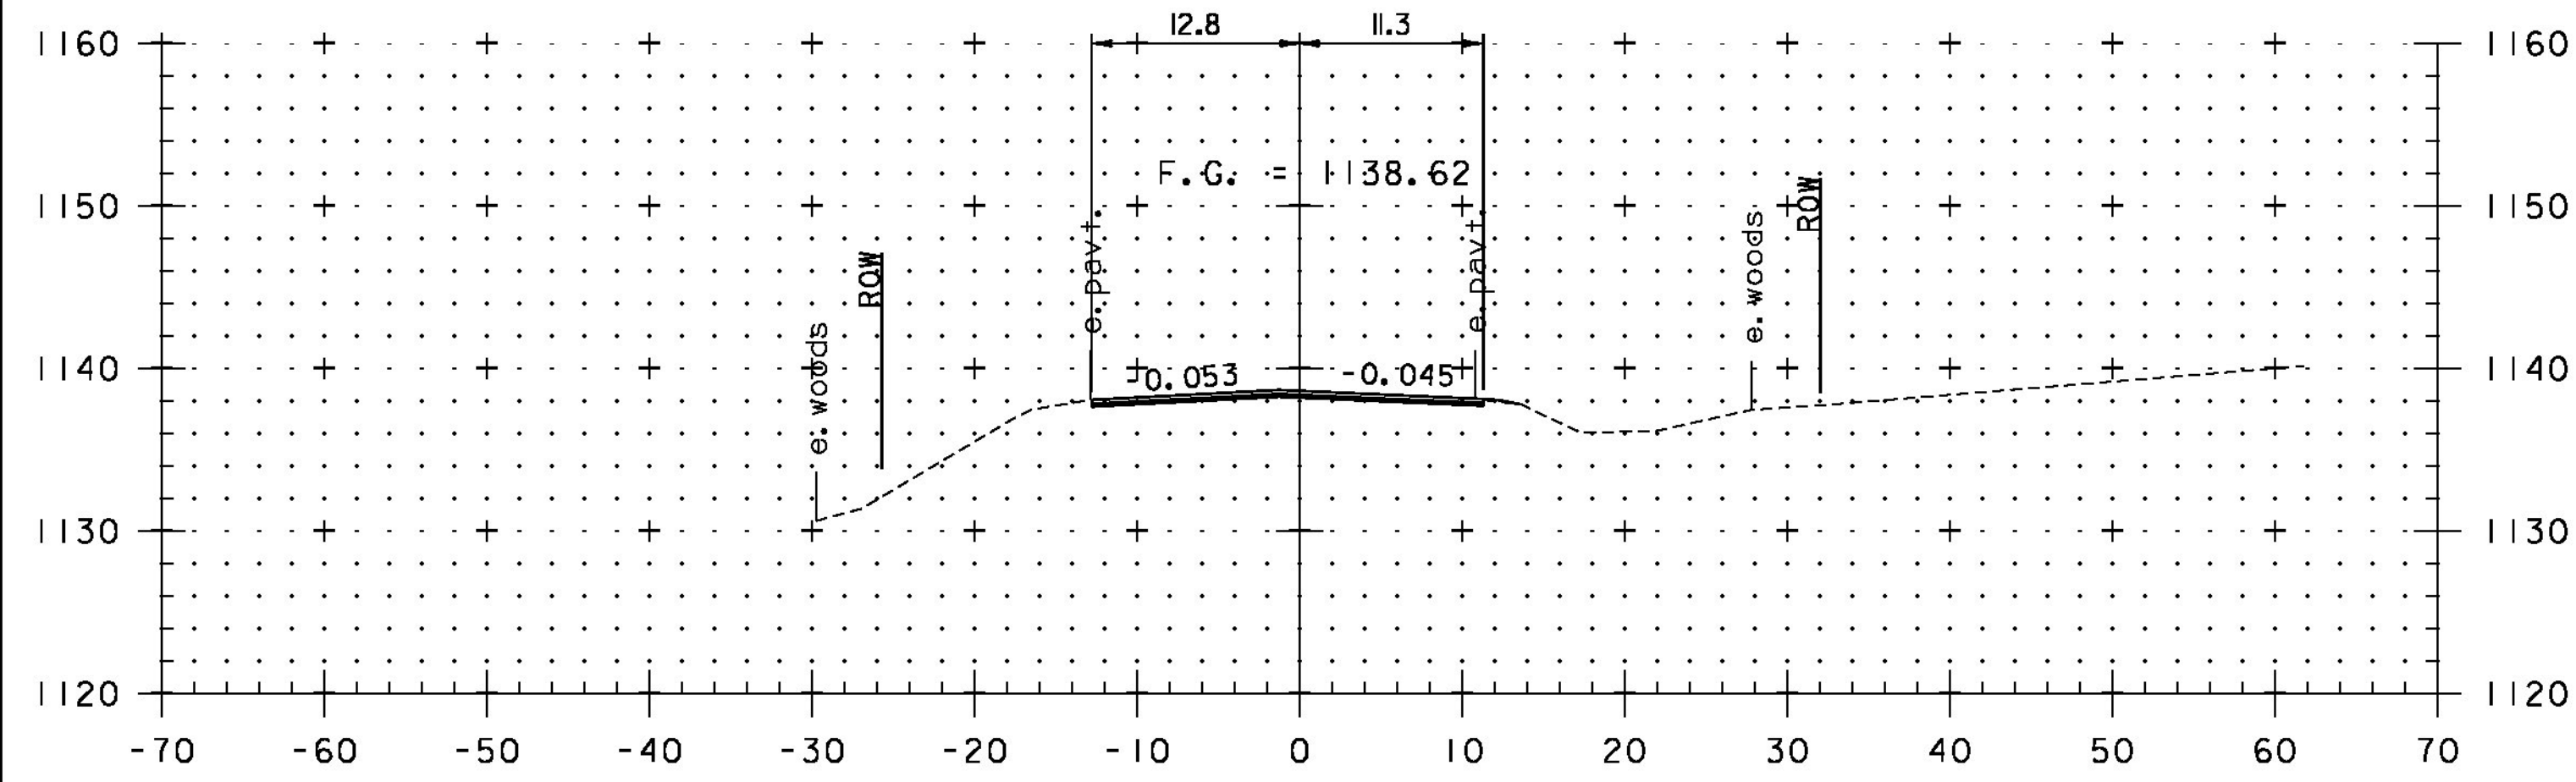

46+00

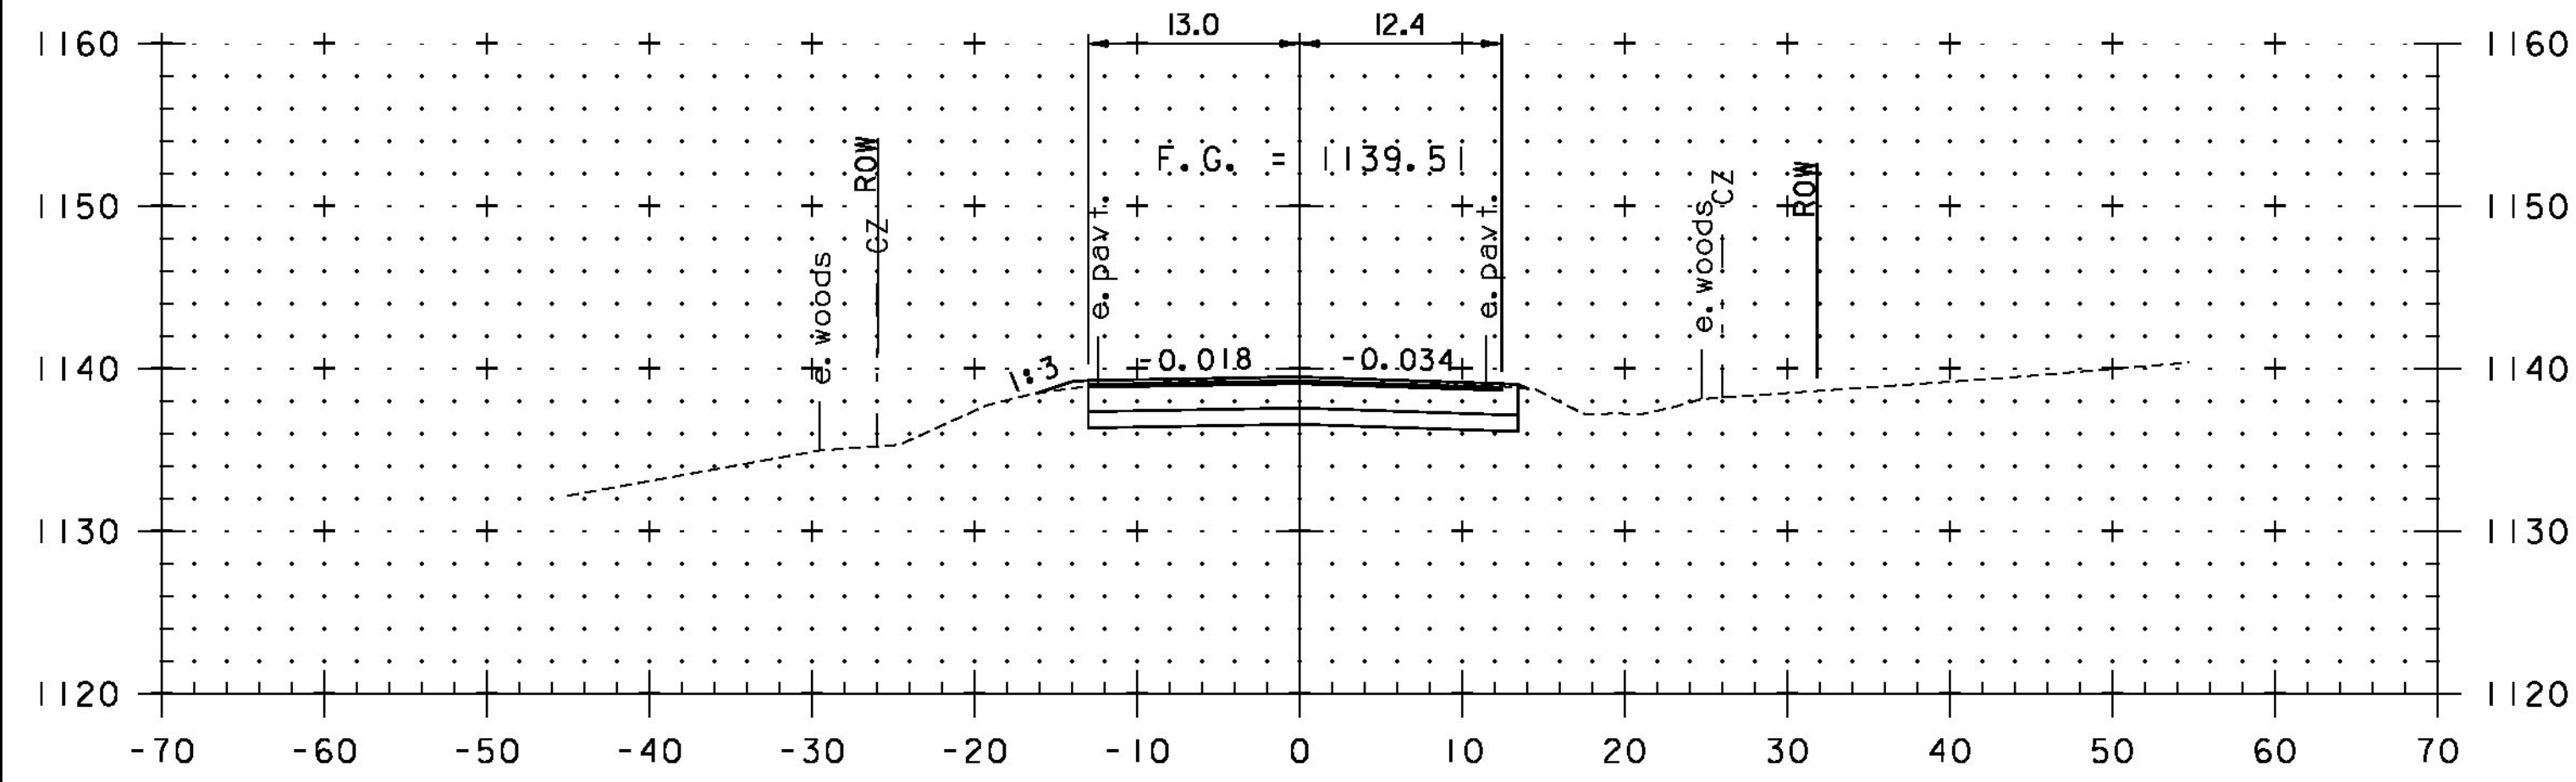


45+50
END PROJECT

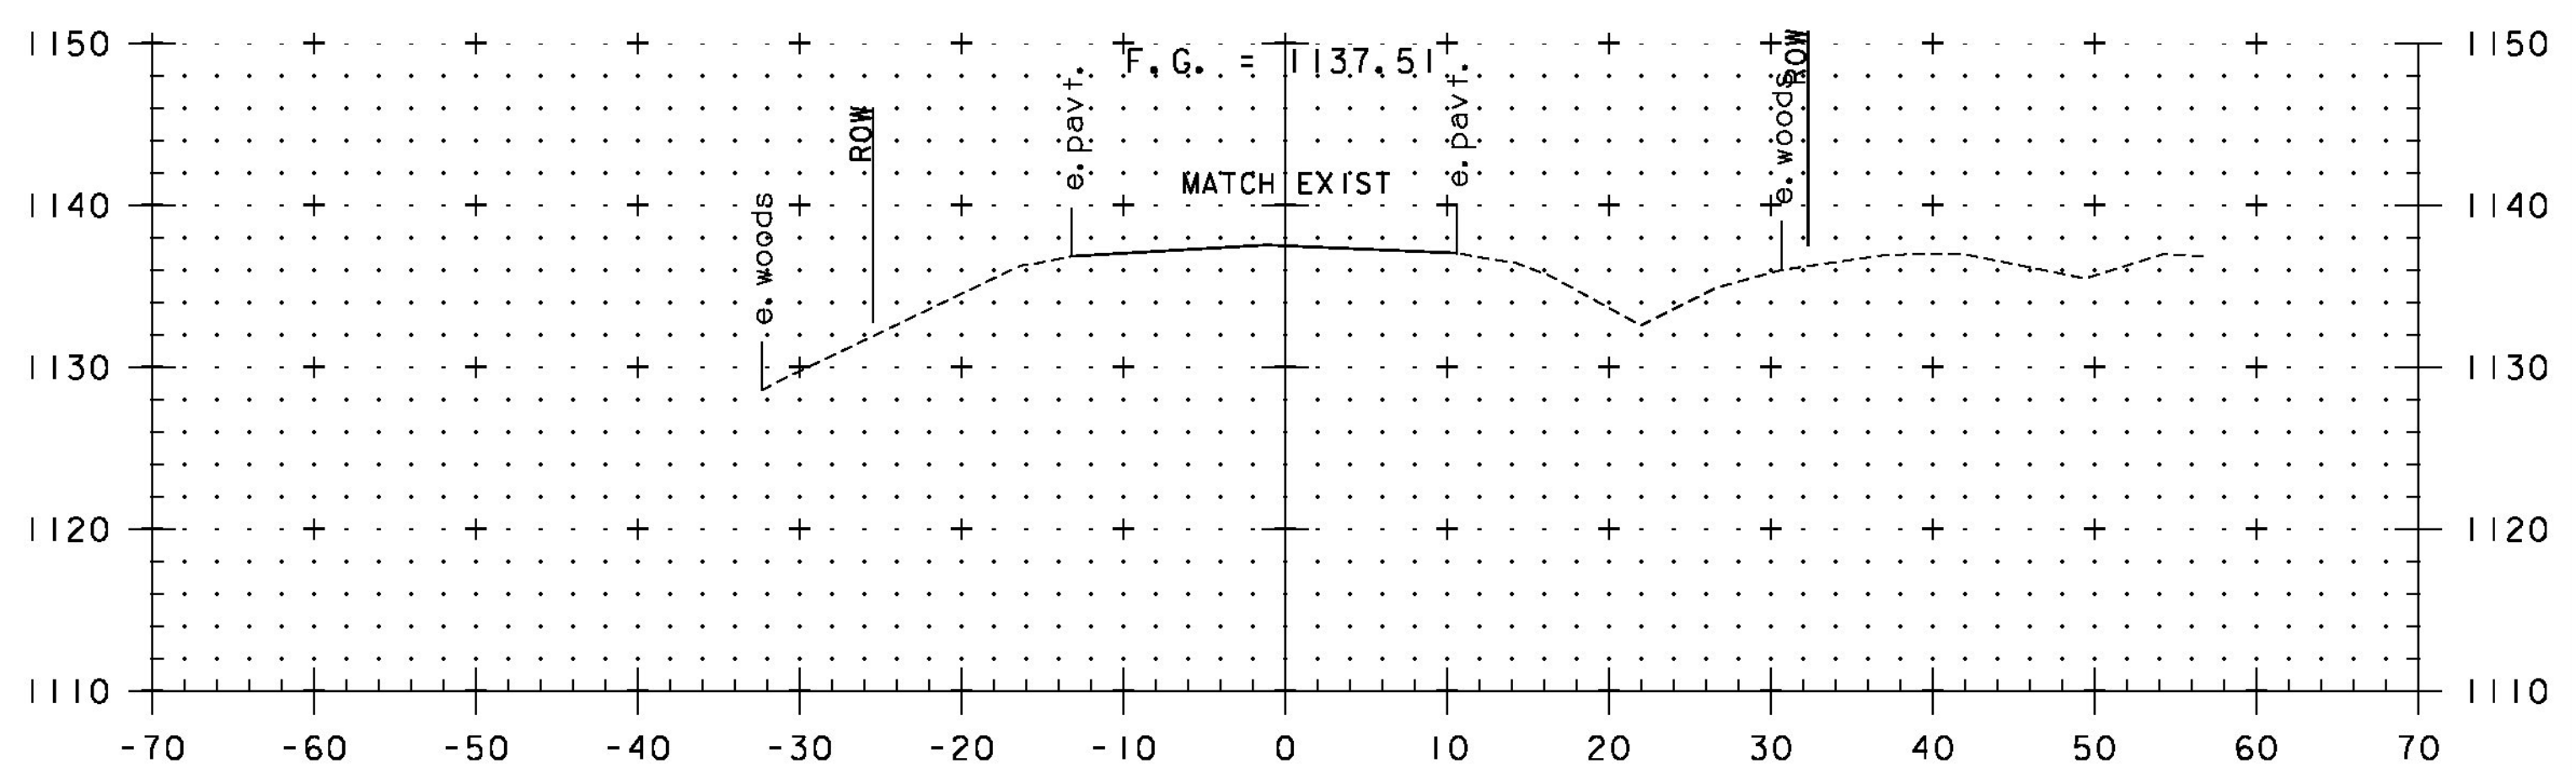

46+50
END APPROACH

GLD 12-0174 MODEL: X504

STA. 45+50 TO STA. 46+50

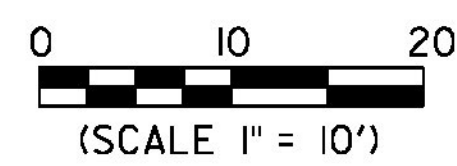

PROJECT NAME: BARTON	PROJECT NUMBER: BRO 1449(31)
FILE NAME: I1J068/cos/z11J068xs.dgn	PLOT DATE: 12/17/2014
PROJECT LEADER: J. BYATT	DRAWN BY: M. HALEY
DESIGNED BY: M. HALEY	CHECKED BY: P. SHEDD
ROADWAY CROSS SECTIONS 4	SHEET 44 OF 52