


STA. 0+70 LT
 END UNCLASSIFIED CHANNEL EXCAVATION
 GEOTEXTILE UNDER STONE FILL
 STONE FILL, TYPE IV
 GRUBBING MATERIAL

0+70


STA. 0+69 RT
 END UNCLASSIFIED CHANNEL EXCAVATION
 GEOTEXTILE UNDER STONE FILL
 STONE FILL, TYPE IV
 GRUBBING MATERIAL

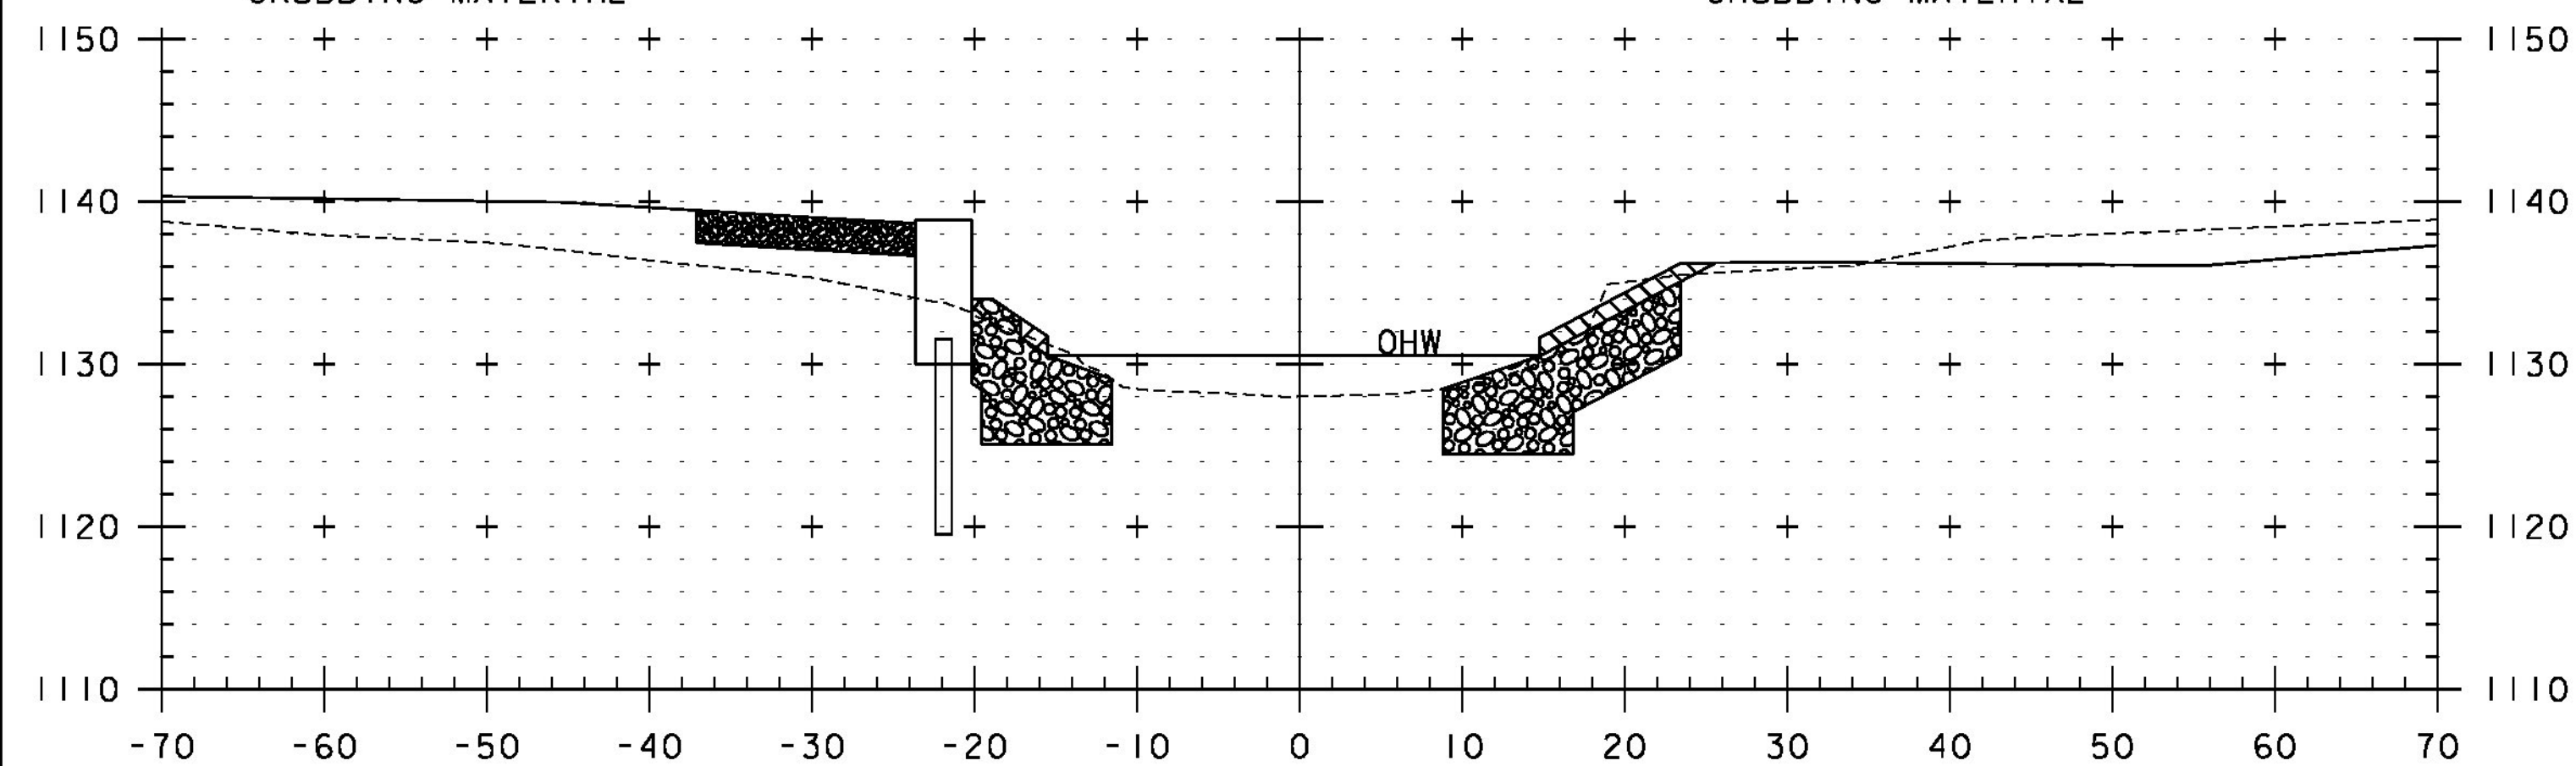

STA. 0+55 LT
 RESUME GRUBBING MATERIAL

0+60

STA. 0+52 RT
 RESUME GRUBBING MATERIAL

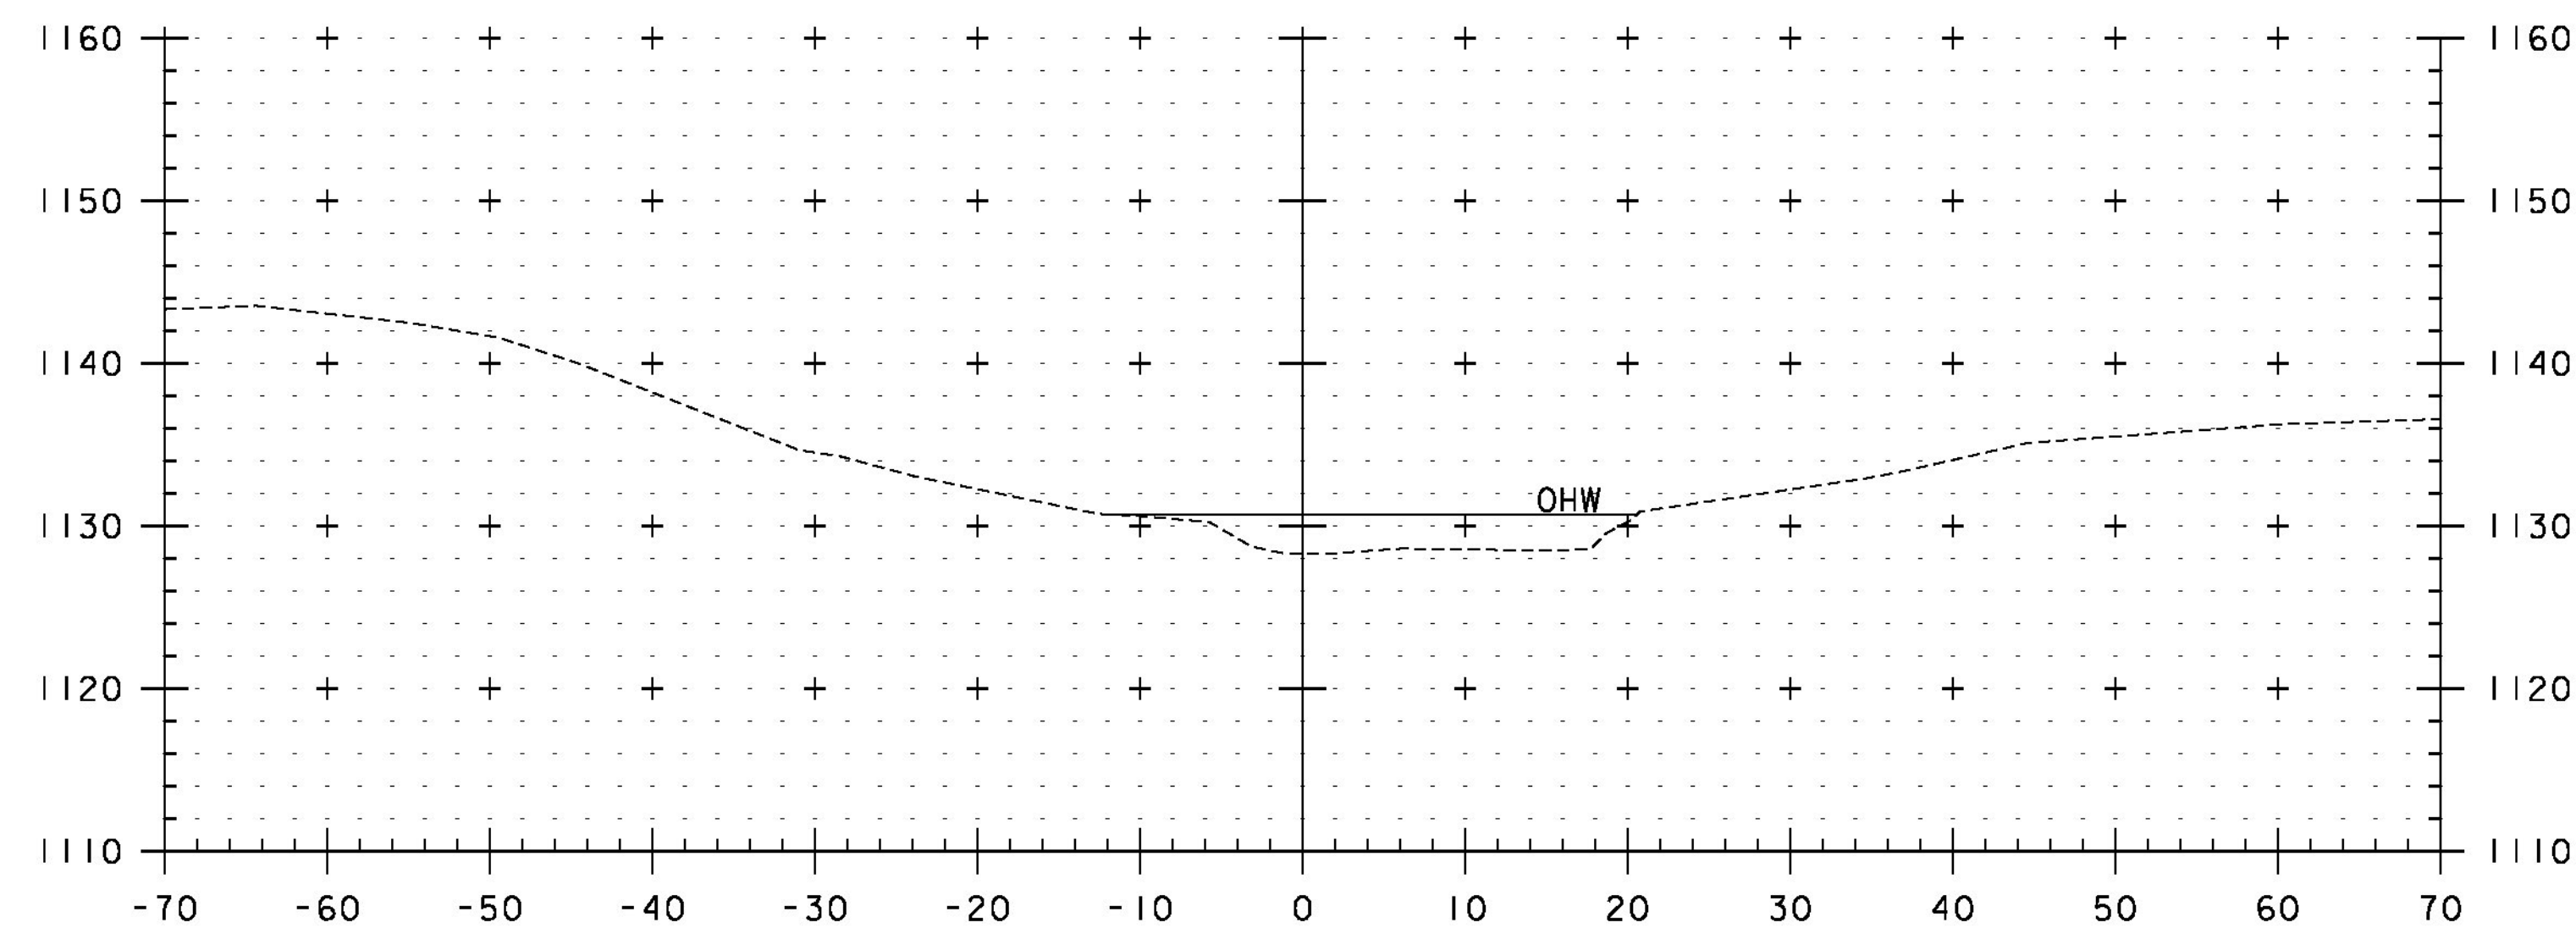

0+80

STA. 0+60 TO STA. 0+80



PROJECT NAME: BARTON
 PROJECT NUMBER: BRO 1449(31)

FILE NAME: z11j068xschan.dgn
 PROJECT LEADER: J. BYATT
 DESIGNED BY: S. BEAUMONT
 CHANNEL CROSS SECTIONS 2

PLOT DATE: 12/17/2014
 DRAWN BY: M. SMITH
 CHECKED BY: J. BYATT
 SHEET 46 OF 52