



A ABUTMENT SECTION
 AB3A (B-AB3 & B-AB4) 3/4" = 1'-0"

SHOP NOTE:
 ALL EDGES OF ABUTMENT SHALL
 RECEIVE A 1" CHAMFER (U.N.O.)

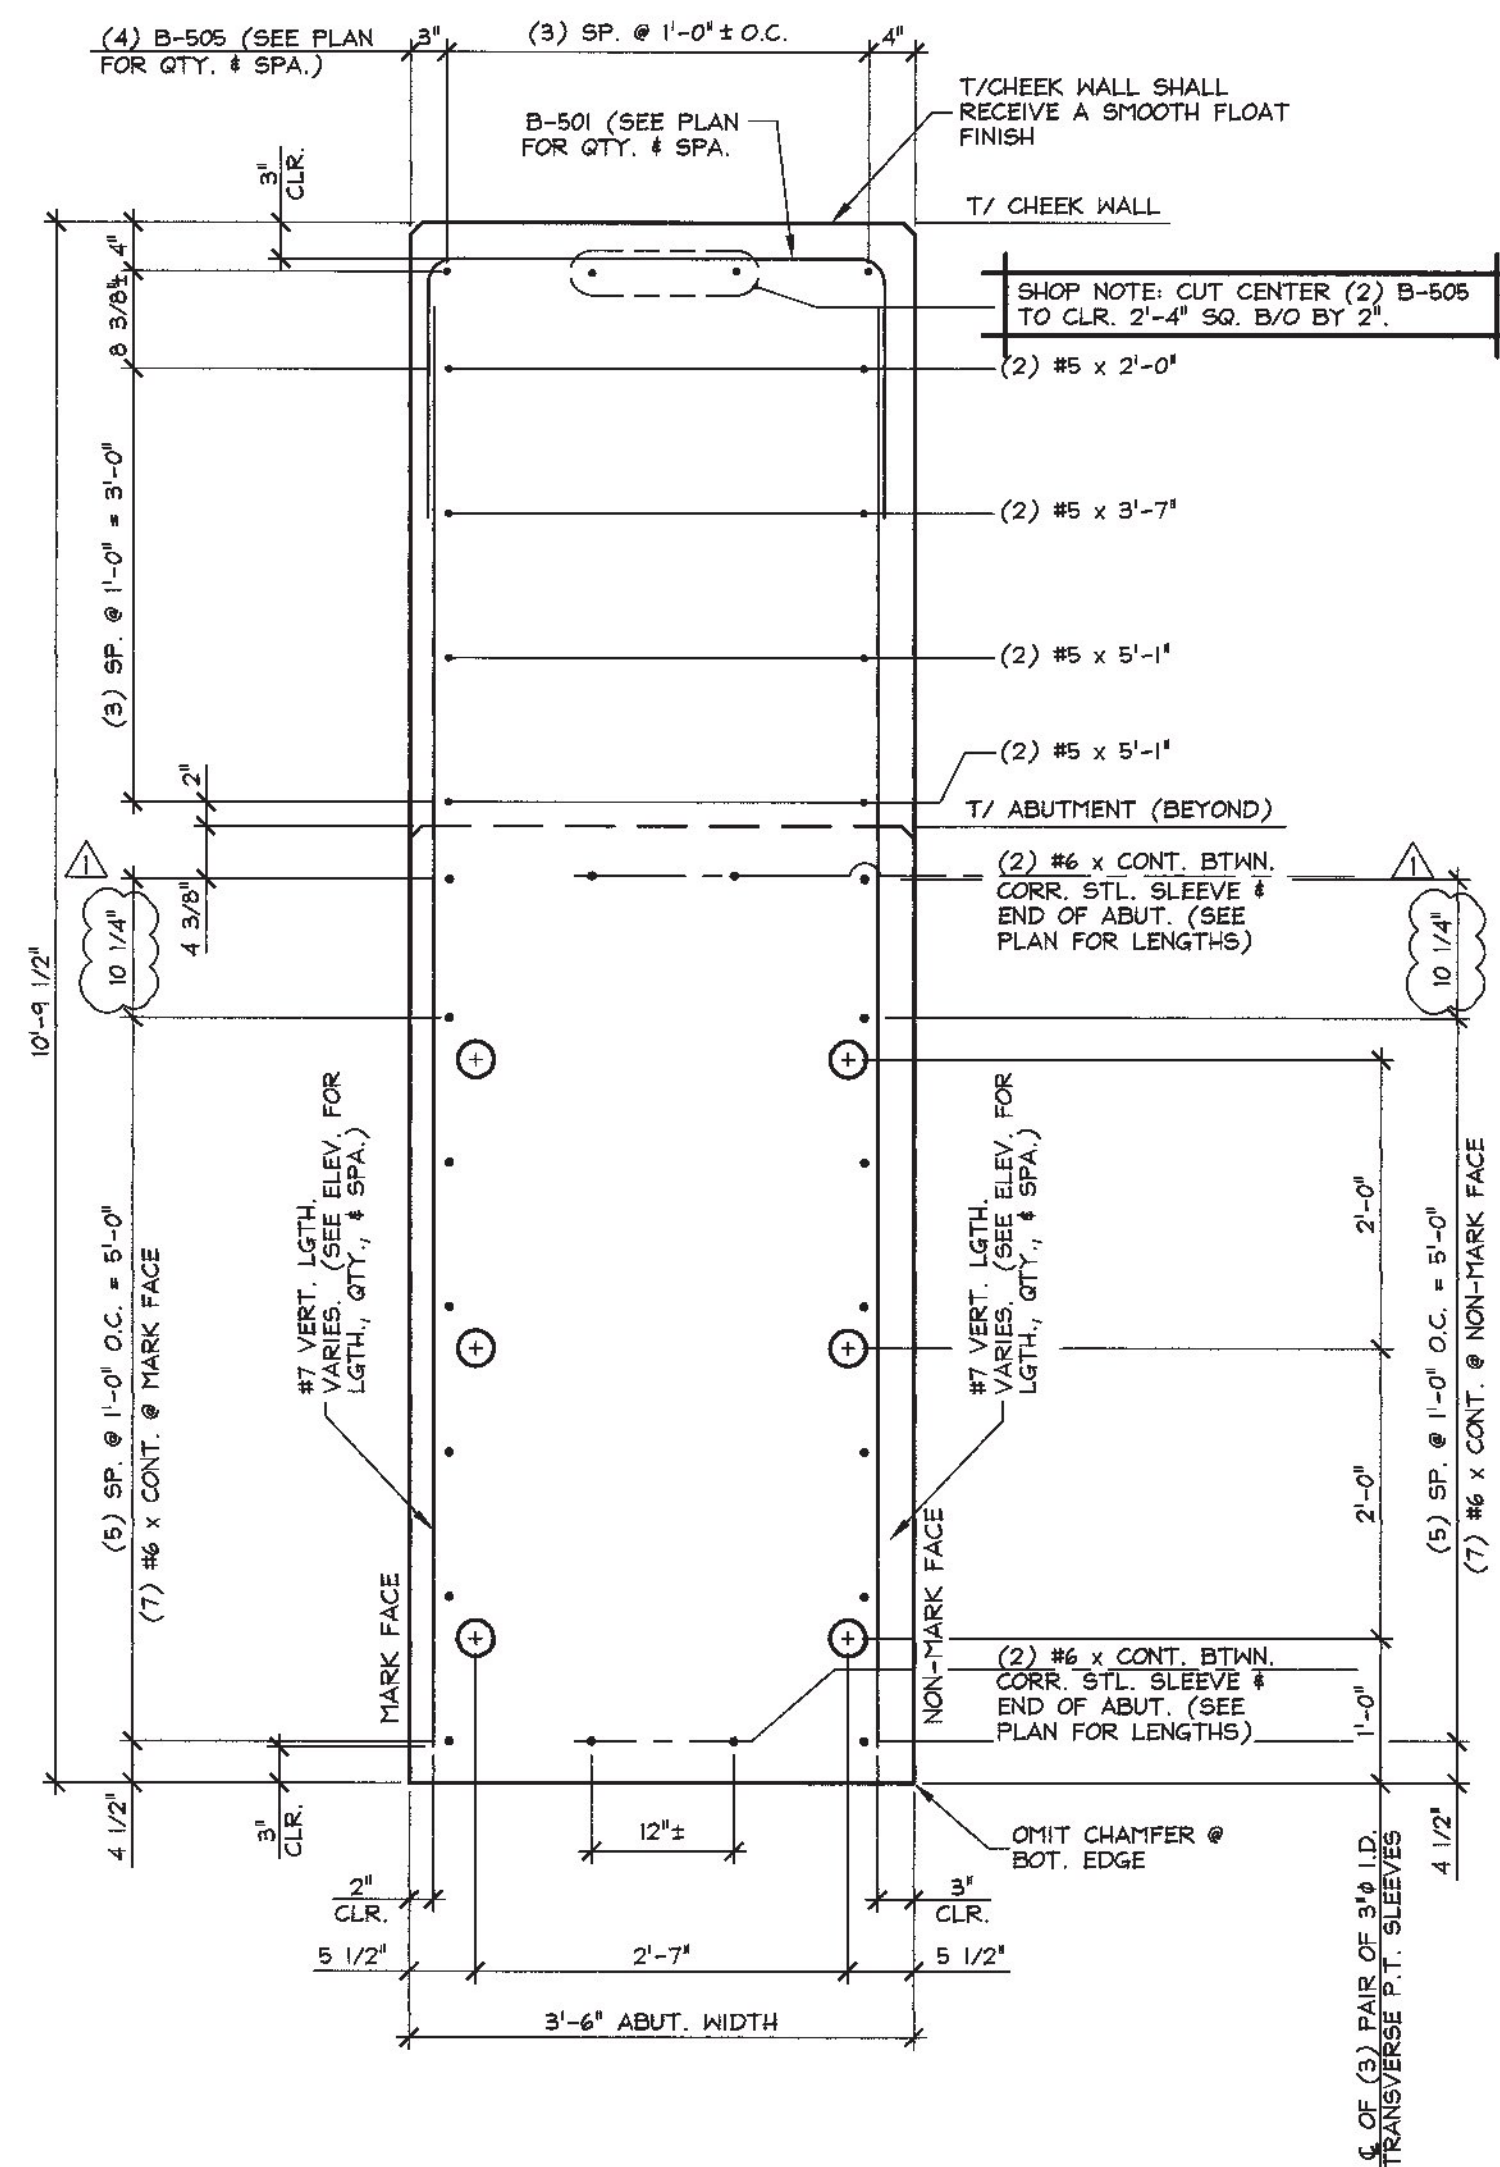

B ABUTMENT SECTION
 AB3A (B-AB3) 3/4" = 1'-0"

SHOP NOTE:
 ALL EDGES OF ABUTMENT SHALL
 RECEIVE A 1" CHAMFER (U.N.O.)

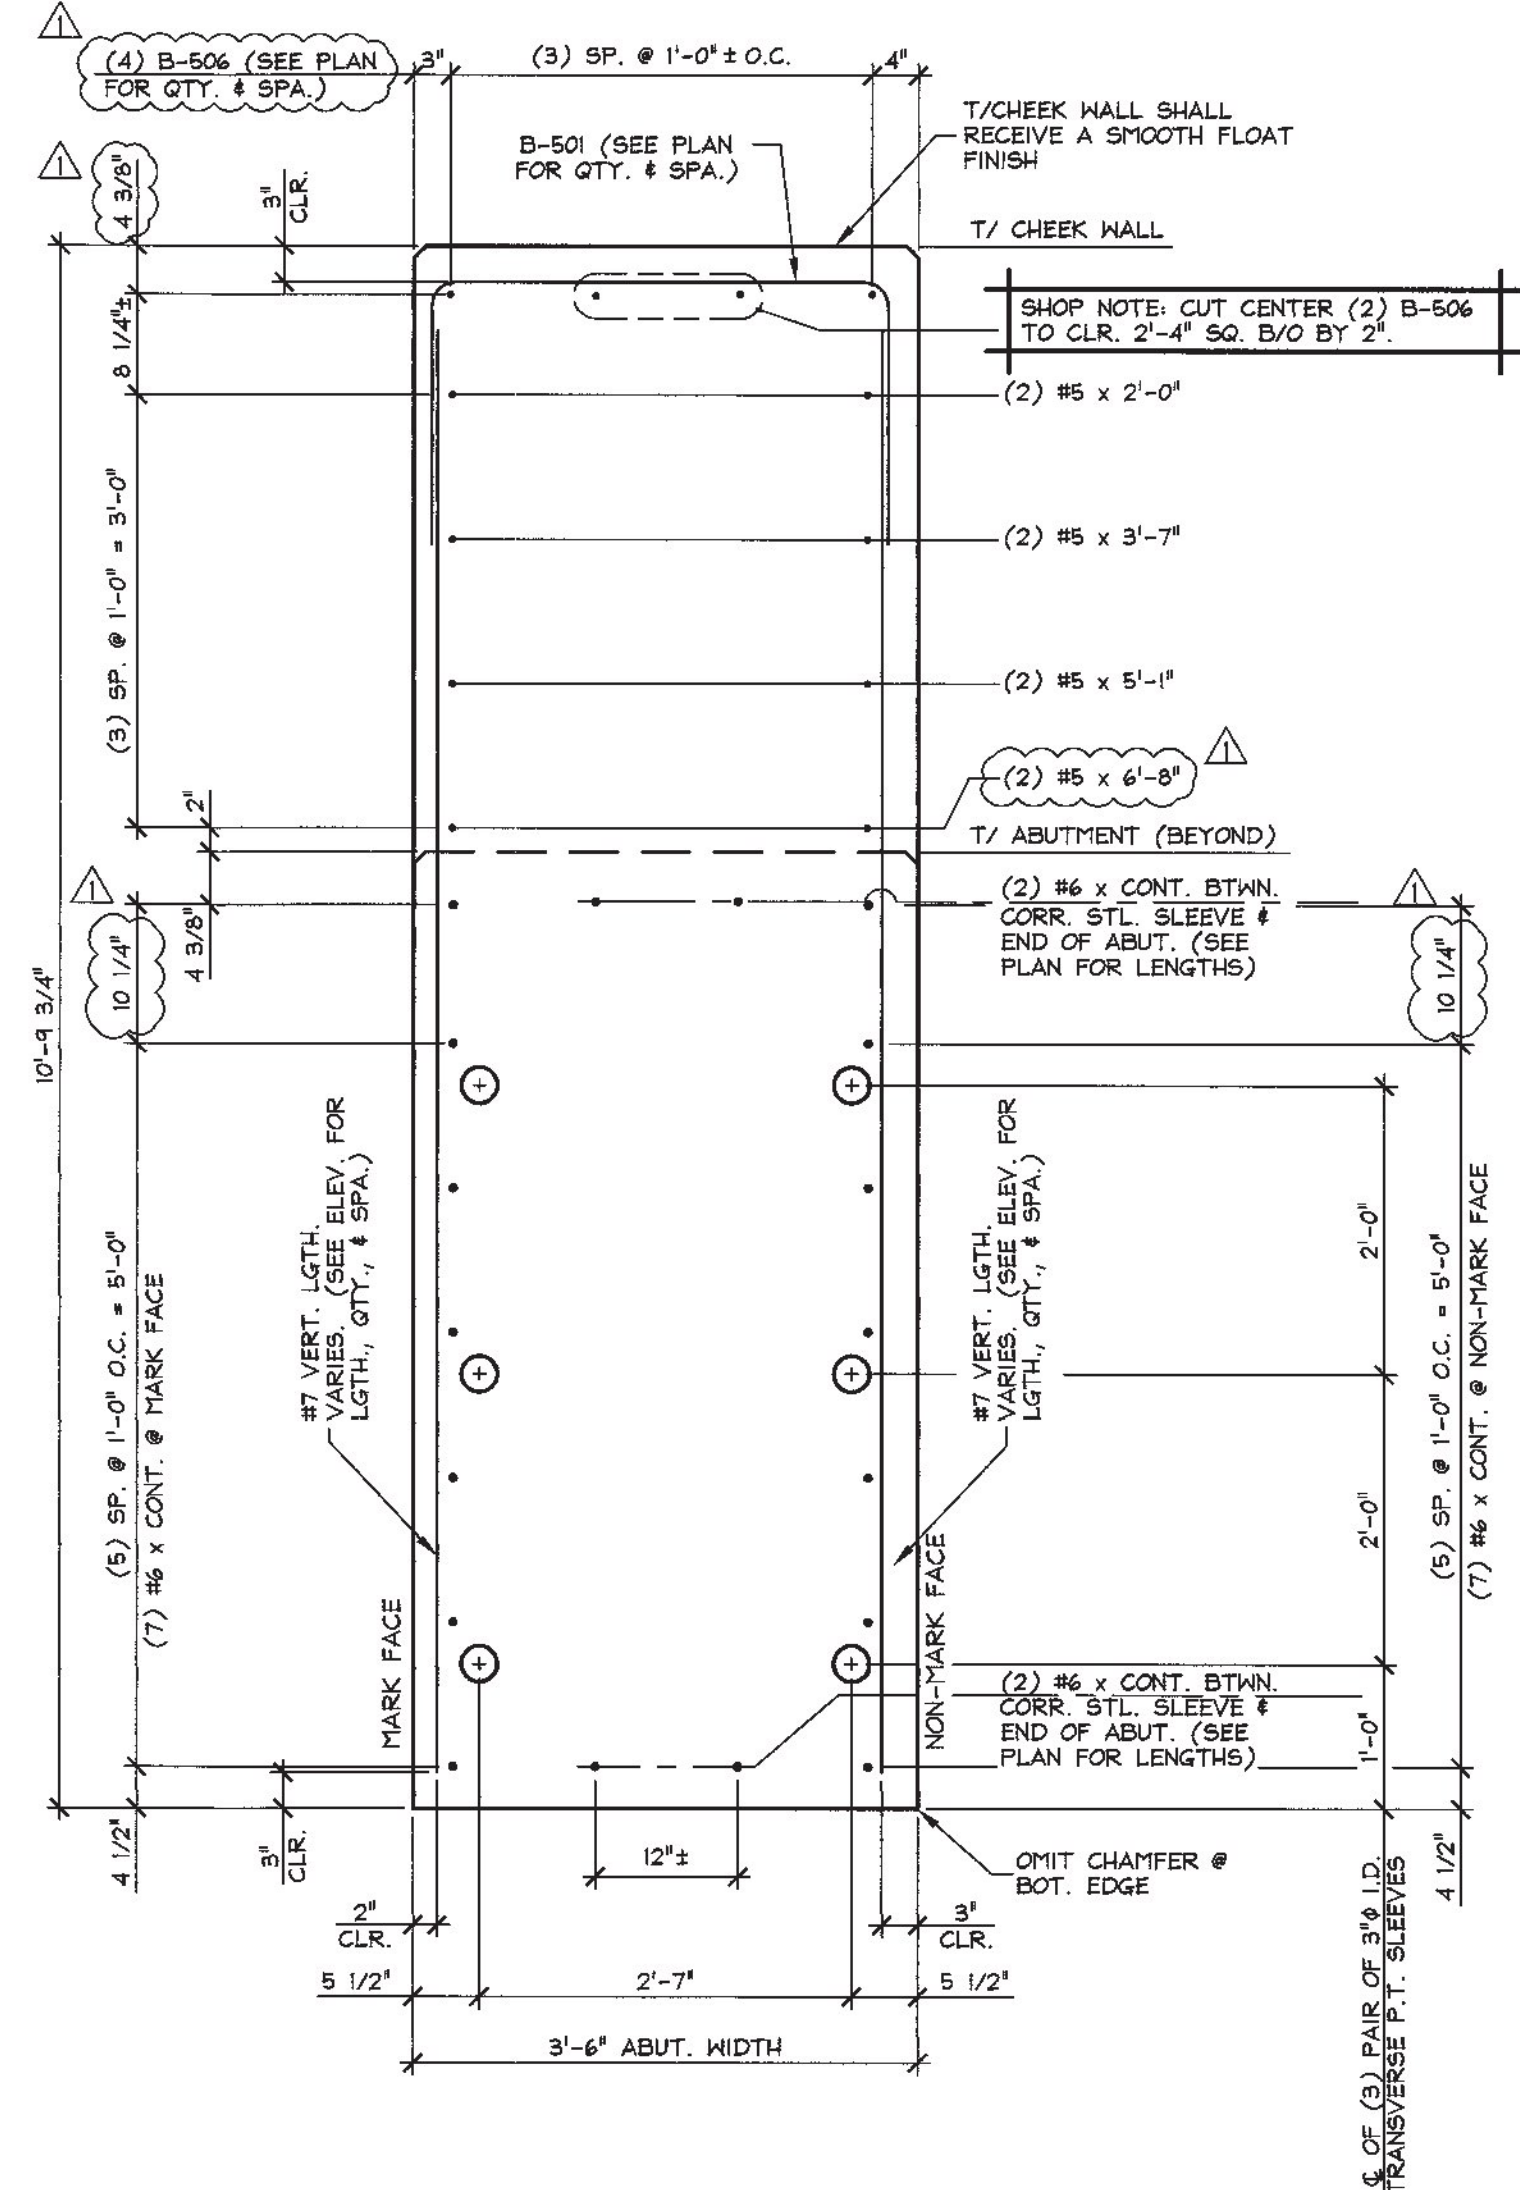

C ABUTMENT SECTION
 AB3A (B-AB4) 3/4" = 1'-0"

SHOP NOTE:
 ALL EDGES OF ABUTMENT SHALL
 RECEIVE A 1" CHAMFER (U.N.O.)

SHOP DRAWING REVIEW

REVIEWED AS REQUIRED BY THE CONSTRUCTION CONTRACT DOCUMENTS AND APPROVED BUT ONLY FOR CONFORMANCE TO THE DESIGN CONCEPT OF THE WORK, AND SUBJECT TO FURTHER LIMITATIONS AND REQUIREMENTS CONTAINED IN THE CONSTRUCTION CONTRACT DOCUMENTS.

REJECTED REVISE AND RESUBMIT APPROVED AS NOTED

CORRECTIONS OR COMMENTS MADE ON THE SHOP DRAWINGS DURING THIS REVIEW DO NOT RELIEVE CONTRACTOR FROM COMPLIANCE WITH REQUIREMENTS OF THE DRAWINGS AND SPECIFICATIONS. THIS CHECK IS ONLY FOR REVIEW OF GENERAL CONFORMANCE WITH THE DESIGN CONCEPT OF THE PROJECT AND GENERAL CONFORMANCE WITH THE INFORMATION GIVEN IN THE CONTRACT DOCUMENTS. THE CONTRACTOR IS RESPONSIBLE FOR CONFIRMING AND CORRELATING ALL QUANTITIES AND DIMENSIONS, SELECTING FABRICATION PROCESSES AND TECHNIQUES OF CONSTRUCTION COORDINATING THEIR WORK WITH THAT OF ALL OTHER TRADES AND PERFORMING THEIR WORK IN A SAFE AND SATISFACTORY MANNER.

 C.D. Consulting Engineers
 540 Commercial Street
 Montpelier, VT 05602
 802-253-8222

Job Number: 120174
 Reviewed by: SRB
 Date: 06/11/2015

5/28/2015 REVISED AS NOTED T.D.

APPROVAL STAMP:	J.P. CARRARA & SONS INC. Precast & Prestress Manufacturer <small>2464 CASE ST., MIDDLEBURY, VERMONT 05753 Phone: (802)388-6361 Fax: (802)388-9010</small>	
	STATE OF VERMONT AGENCY OF TRANSPORTATION COUNTY OF ORLEANS	DATE: FEB. 25, 2015 SCALE: NOTED
	TOWN OF BARTON ROARING BROOK ROAD TH #2, RURAL MINOR COLLECTOR BRIDGE NO.: 8 PROJECT NO.: BRO 1449(31)	CHKD: DFTM: T.D. JOB NO: 23462-015
	PRECAST ABUTMENT SECTIONS	
	DWG. NO: AB3A	