




1 PLAN VIEW IN FORM
AS4 1/2" = 1'-0"

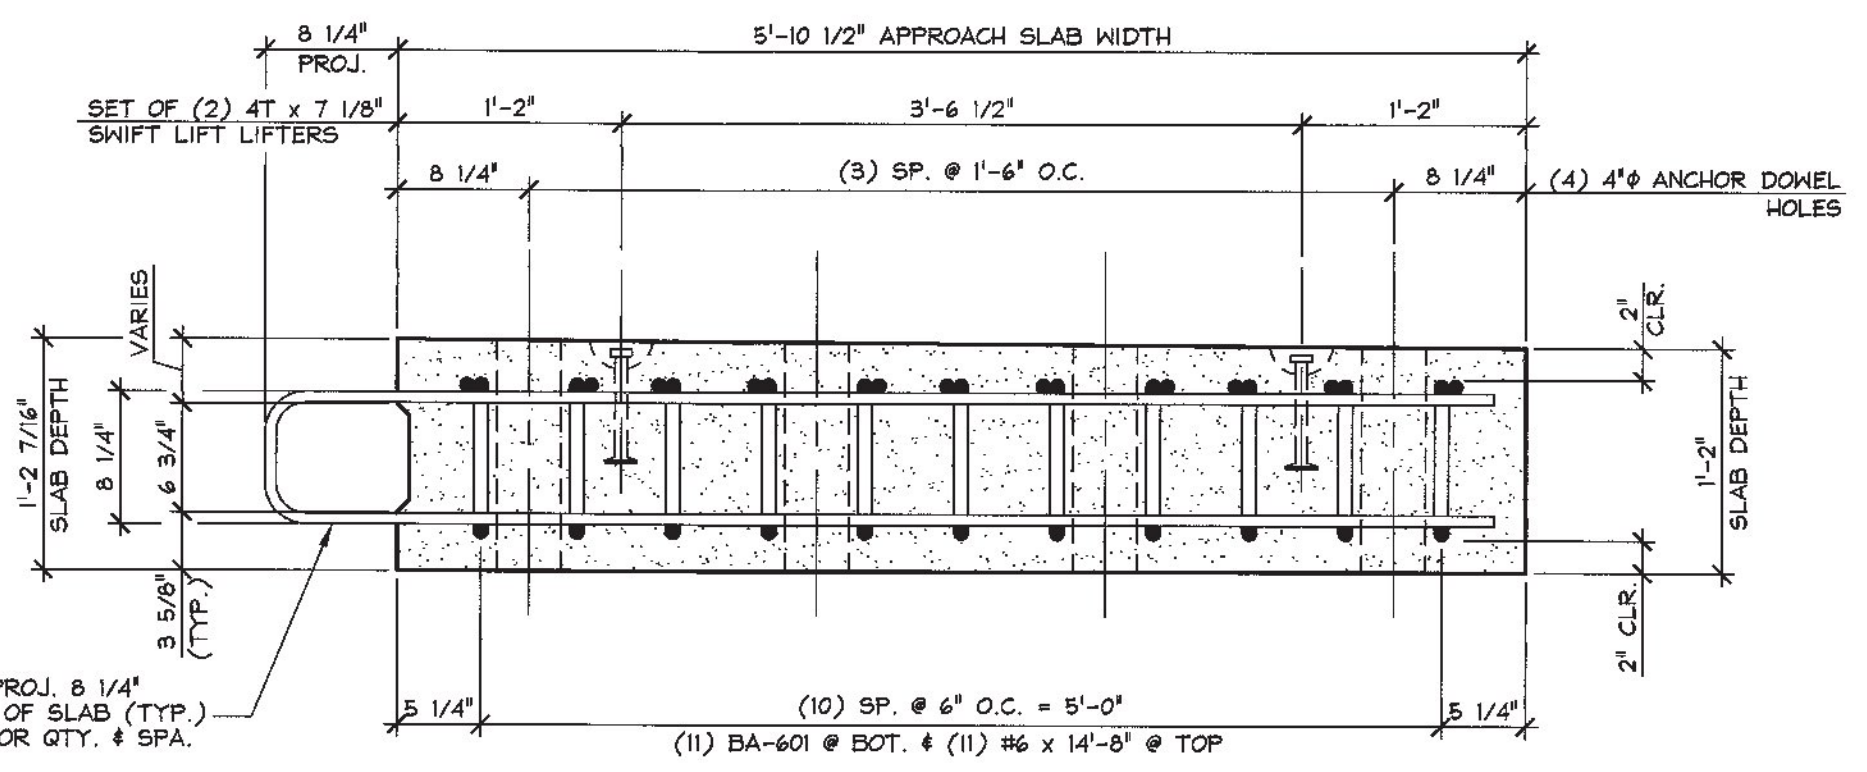


C SECTION
AS4 1" = 1'-0"

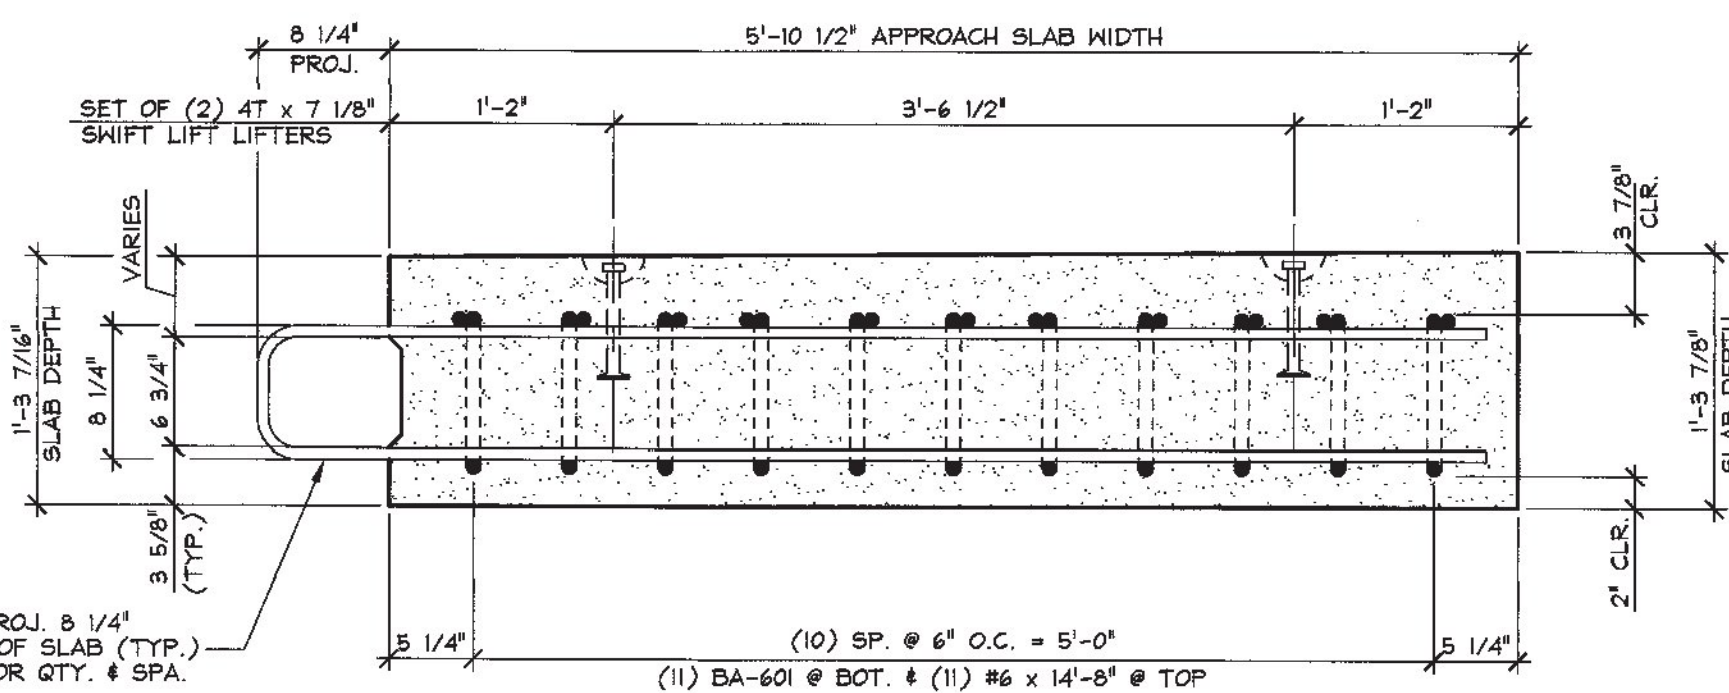

B SECTION
AS4 1" = 1'-0"

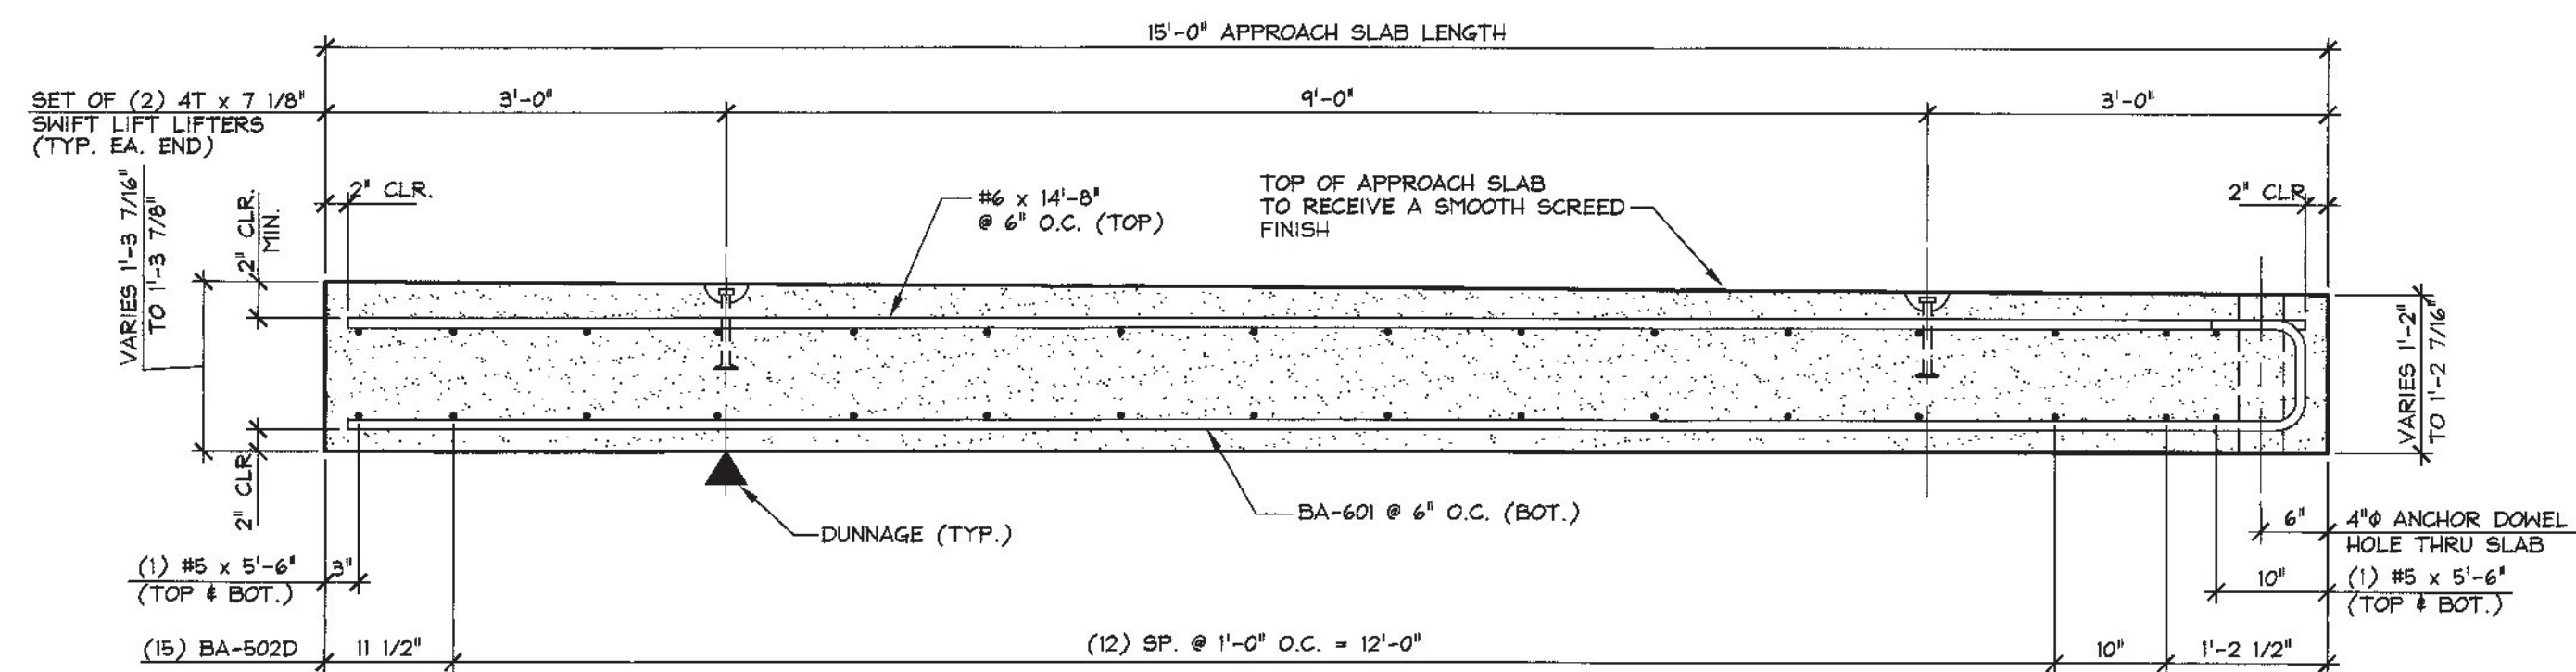

A LONGITUDINAL SECTION
AS4 3/4" = 1'-0"

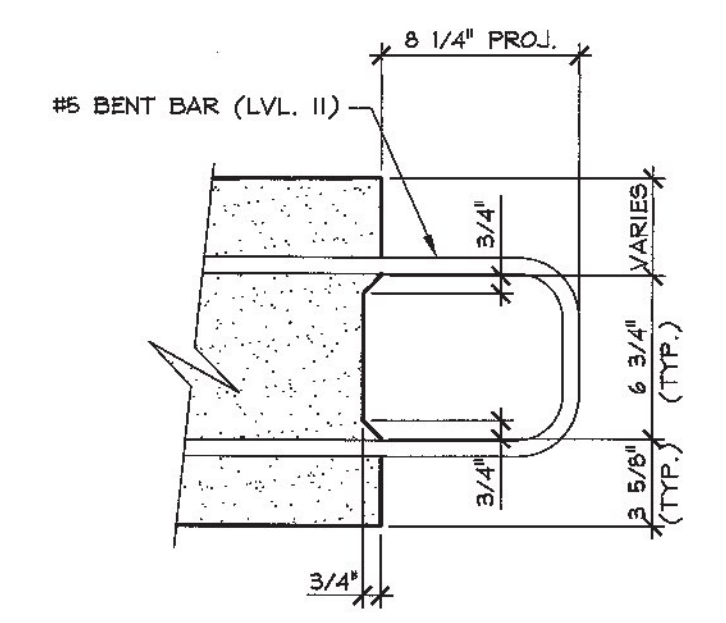

SHEAR KEY DETAIL
1 1/2" = 1'-0"

MARK: B-AS4	QTY.: 2	WT.: 8.26 T	VOL.: 4.08 cy
MATERIAL LIST / APPROACH SLAB			
ITEM	MARK	DESCRIPTION	QTY.
1			
2	BA-502D	#5 BENT BAR (LEVEL II, DUAL COATED)	14
3	BA-601	#6 BENT BAR (LEVEL I)	11
4			
5			
6		#6 x 14'-8" (LEVEL I)	11
7		#5 x 5'-6" (LEVEL I)	4
8			
9			
10			
11			
12			
13			
14		DAYTON 4T x 7 1/8" SHIFT LIFT (DOMESTIC)	4
15			

SHOP DRAWING REVIEW

REVIEWED AS REQUIRED BY THE CONSTRUCTION CONTRACT DOCUMENTS AND APPROVED, BUT ONLY FOR CONFORMANCE TO THE DESIGN CONCEPT OF THE WORK, AND SUBJECT TO FURTHER LIMITATIONS AND REQUIREMENTS CONTAINED IN THE CONSTRUCTION CONTRACT DOCUMENTS.

REJECTED REVISE AND RESUBMIT APPROVED AS NOTED

CORRECTIONS OR COMMENTS MADE ON THE SHOP DRAWINGS DURING THIS REVIEW DID NOT RELIEVE CONTRACTOR FROM COMPLIANCE WITH REQUIREMENTS OF THE DRAWINGS AND SPECIFICATIONS. THIS CHECK IS ONLY FOR REVIEW OF GENERAL CONFORMANCE WITH THE DESIGN CONCEPT OF THE PROJECT AND GENERAL COMPLIANCE WITH THE INFORMATION GIVEN IN THE CONTRACT DOCUMENTS. THE CONTRACTOR IS RESPONSIBLE FOR CONFIRMING AND CORRELATING ALL QUANTITIES AND DIMENSIONS, SELECTING FABRICATION PROCESSES AND TECHNIQUES OF CONSTRUCTION, COORDINATING THEIR WORK WITH THAT OF ALL OTHER TRADES, AND PERFORMING THEIR WORK IN A SAFE AND SATISFACTORY MANNER.

OLD Consulting Engineers
240 Commercial Street
Manchester, NH 03101
603-498-6253

Job Number: T20174
Reviewed by: SRB
Date: 06/11/2015

5/28/2015 REVISED AS NOTED T.D.

APPROVAL STAMP:

J.P. CARRARA & SONS INC.
Precast & Prestress Manufacturer
244 USE SR, WEXLEBURY, VERMONT 05753 Phone: (802)388-6361 Fax: (802)388-9010

J.P. Sicard
CONTRACTOR
BARTON, VERMONT

STATE OF VERMONT AGENCY OF TRANSPORTATION
COUNTY OF ORLEANS

TOWN OF BARTON
ROARING BROOK ROAD TH #2, RURAL MINOR COLLECTOR
BRIDGE NO.: 8 PROJECT NO.: BRO 1449(31)

DATE: FEB. 25, 2015
SCALE: NOTED
CHKD: DFTM: T.D.
JOB NO: 23462-015

APPROACH SLAB DETAILS
DWG. NO: AS4