



**TYPICAL ROADWAY SECTION**  
SCALE 1/4" = 1'-0"

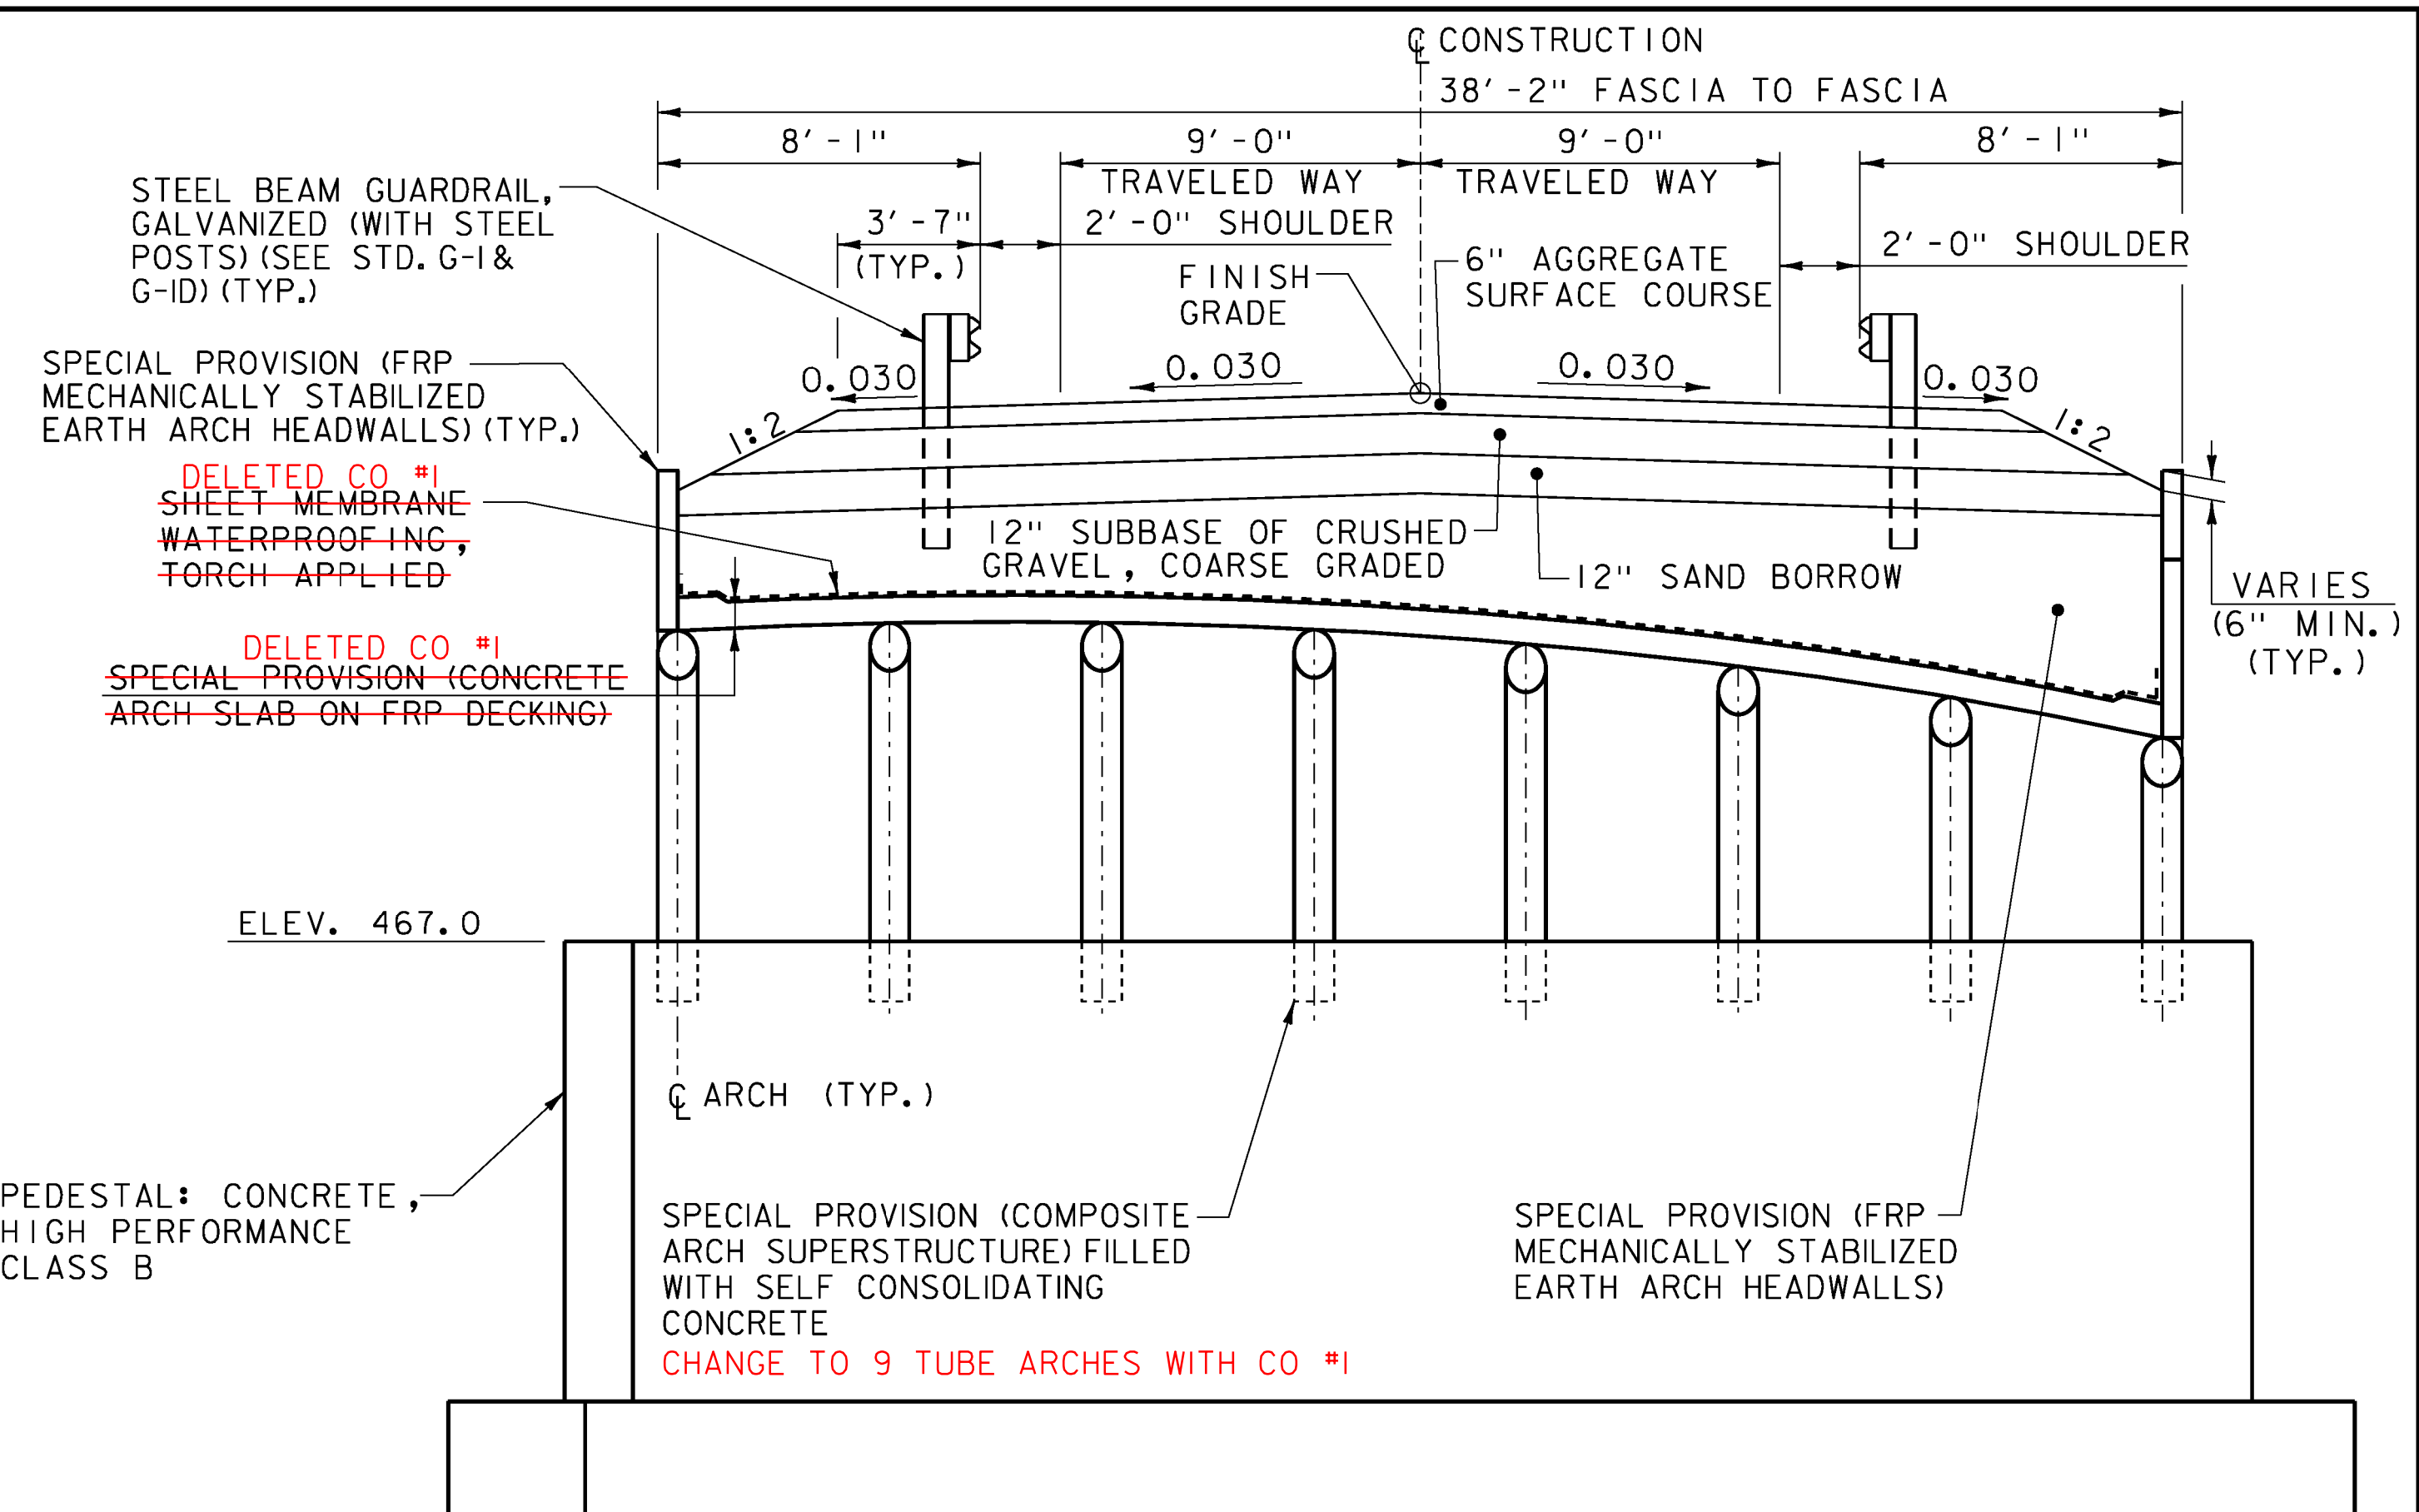

**TYPICAL BRIDGE SECTION  
(NORMAL TO CONSTRUCTION)**  
SCALE 1/4" = 1'-0"

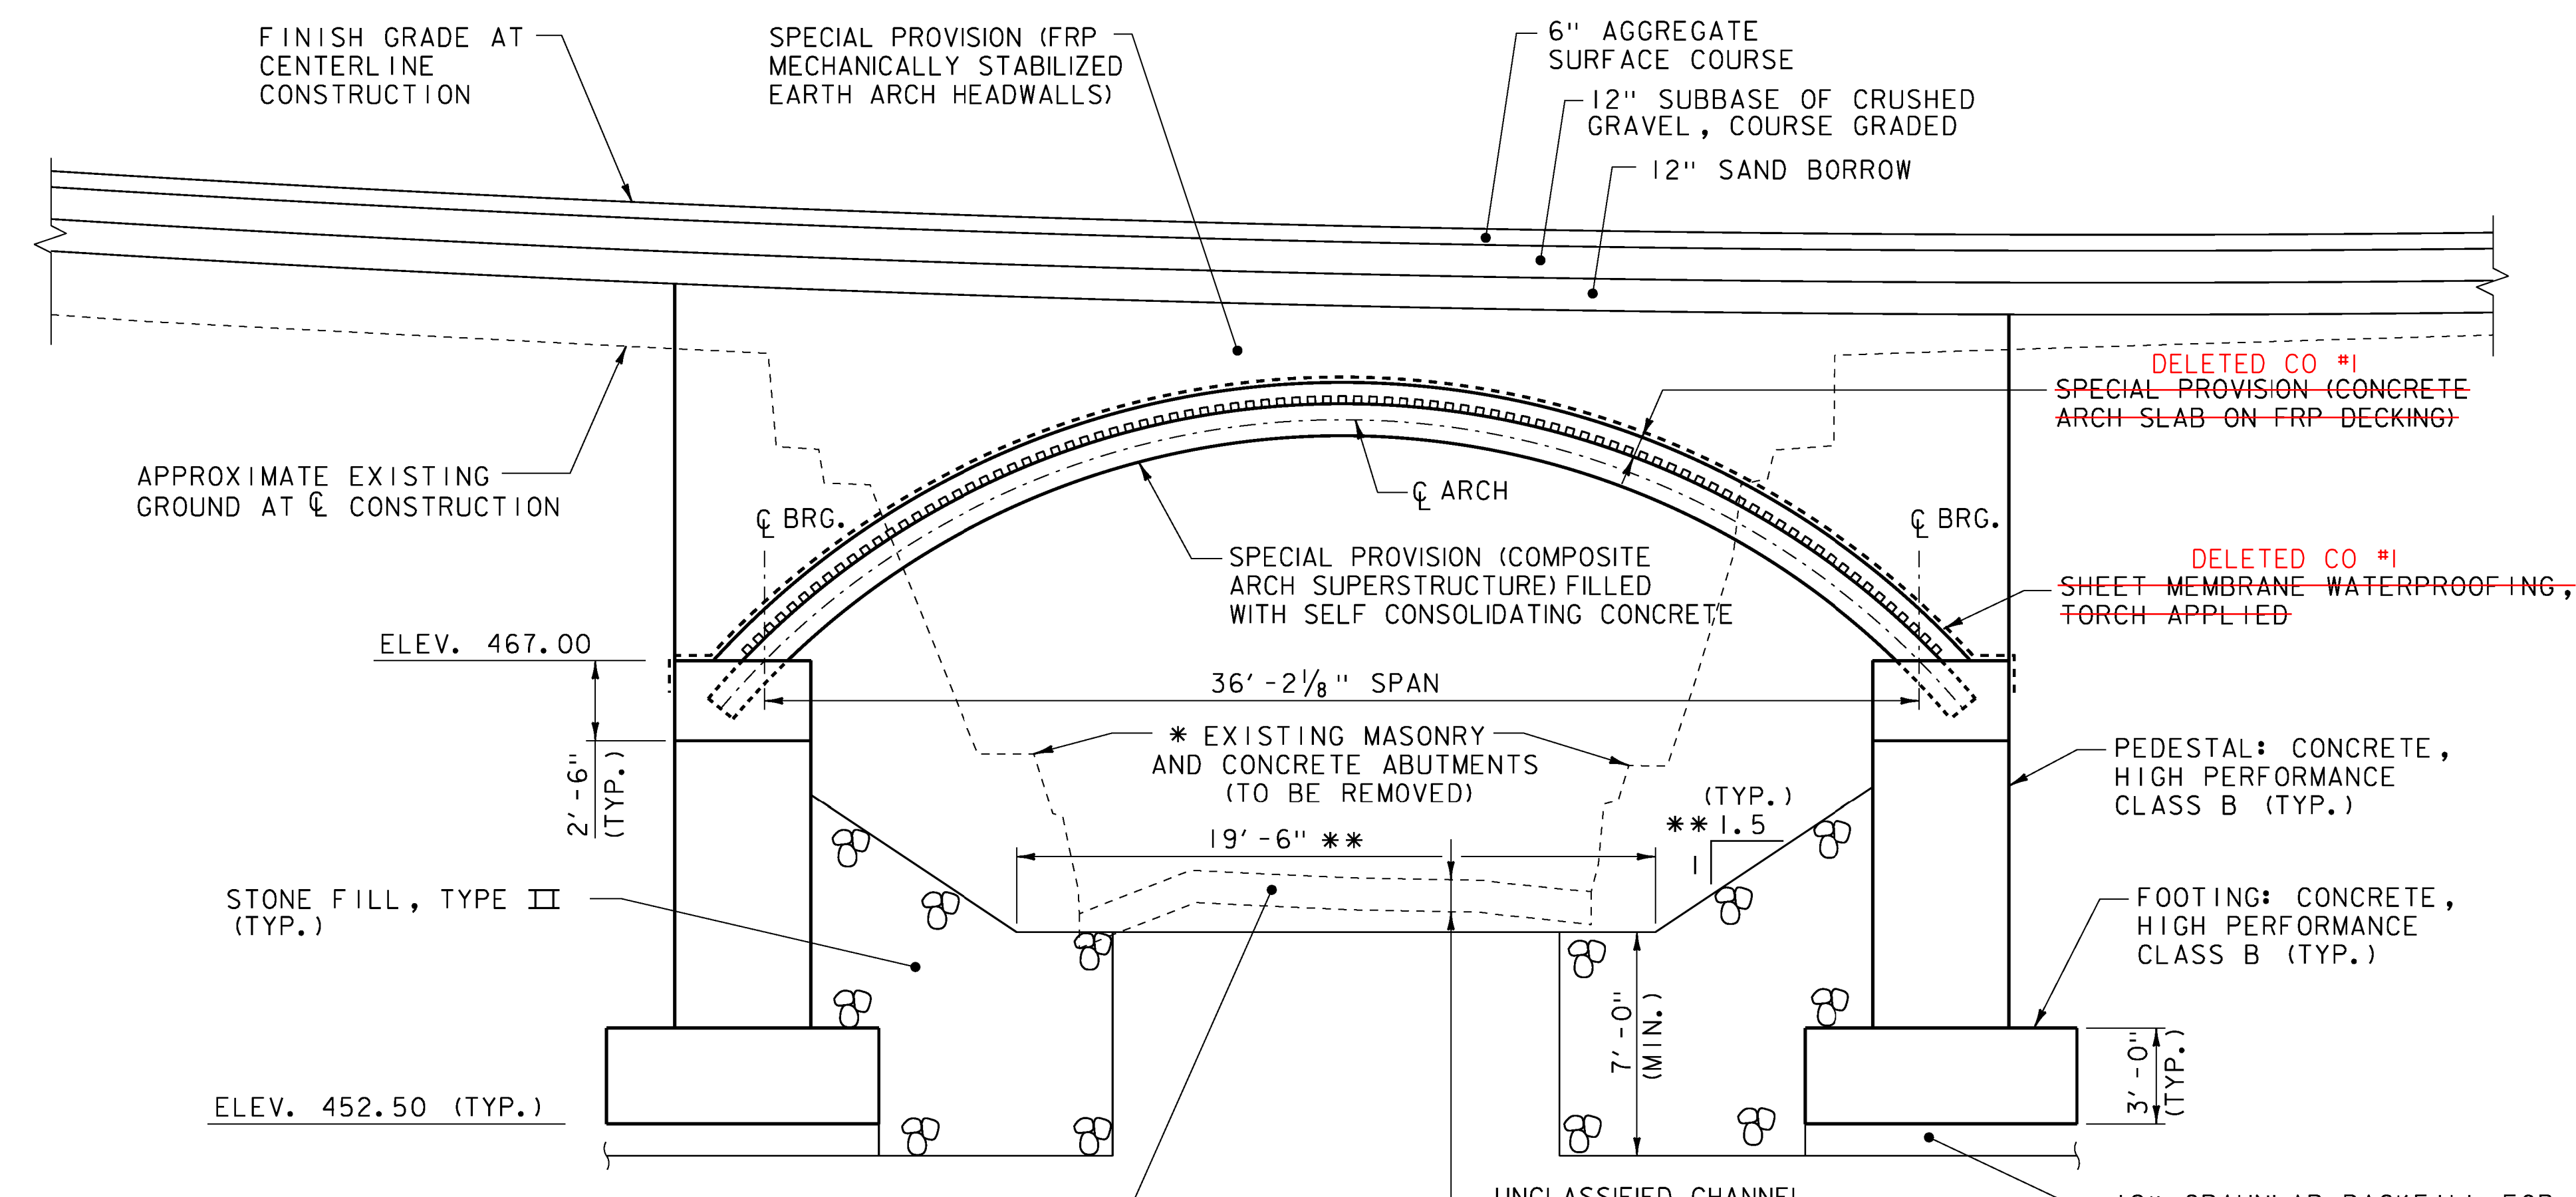

**LONGITUDINAL SECTION**  
SCALE 1/4" = 1'-0"

\* SIZE AND DEPTH OF EXISTING ABUTMENTS ARE UNKNOWN. REMOVAL COST INCLUDED IN COFFERDAM EXCAVATION, ROCK.  
\*\* DIMENSION AND SLOPE PERPENDICULAR TO CHANNEL BASELINE.

PROJECT NAME: FAIRFIELD	PLOT DATE: 01-NOV-2013
PROJECT NUMBER: BRO 1448(38)	DRAWN BY: W. GAYNOR
FILE NAME: z11j072+typ.dgn	DESIGNED BY: E. ALEXOPOULOS
	CHECKED BY: T. KENDRICK
TYPICAL SECTIONS (1 OF 2)	SHEET 3 OF 41

