


CURVE #1 DATA (TH 30)  
 PC STA. 11+60.15  
 $\Delta=8^{\circ}26'26.51''$  LT  
 $D=5^{\circ}12'31.35''$   
 $R=1100.00'$   
 $T=81.17'$   
 $L=162.050'$   
 $E=2.991'$

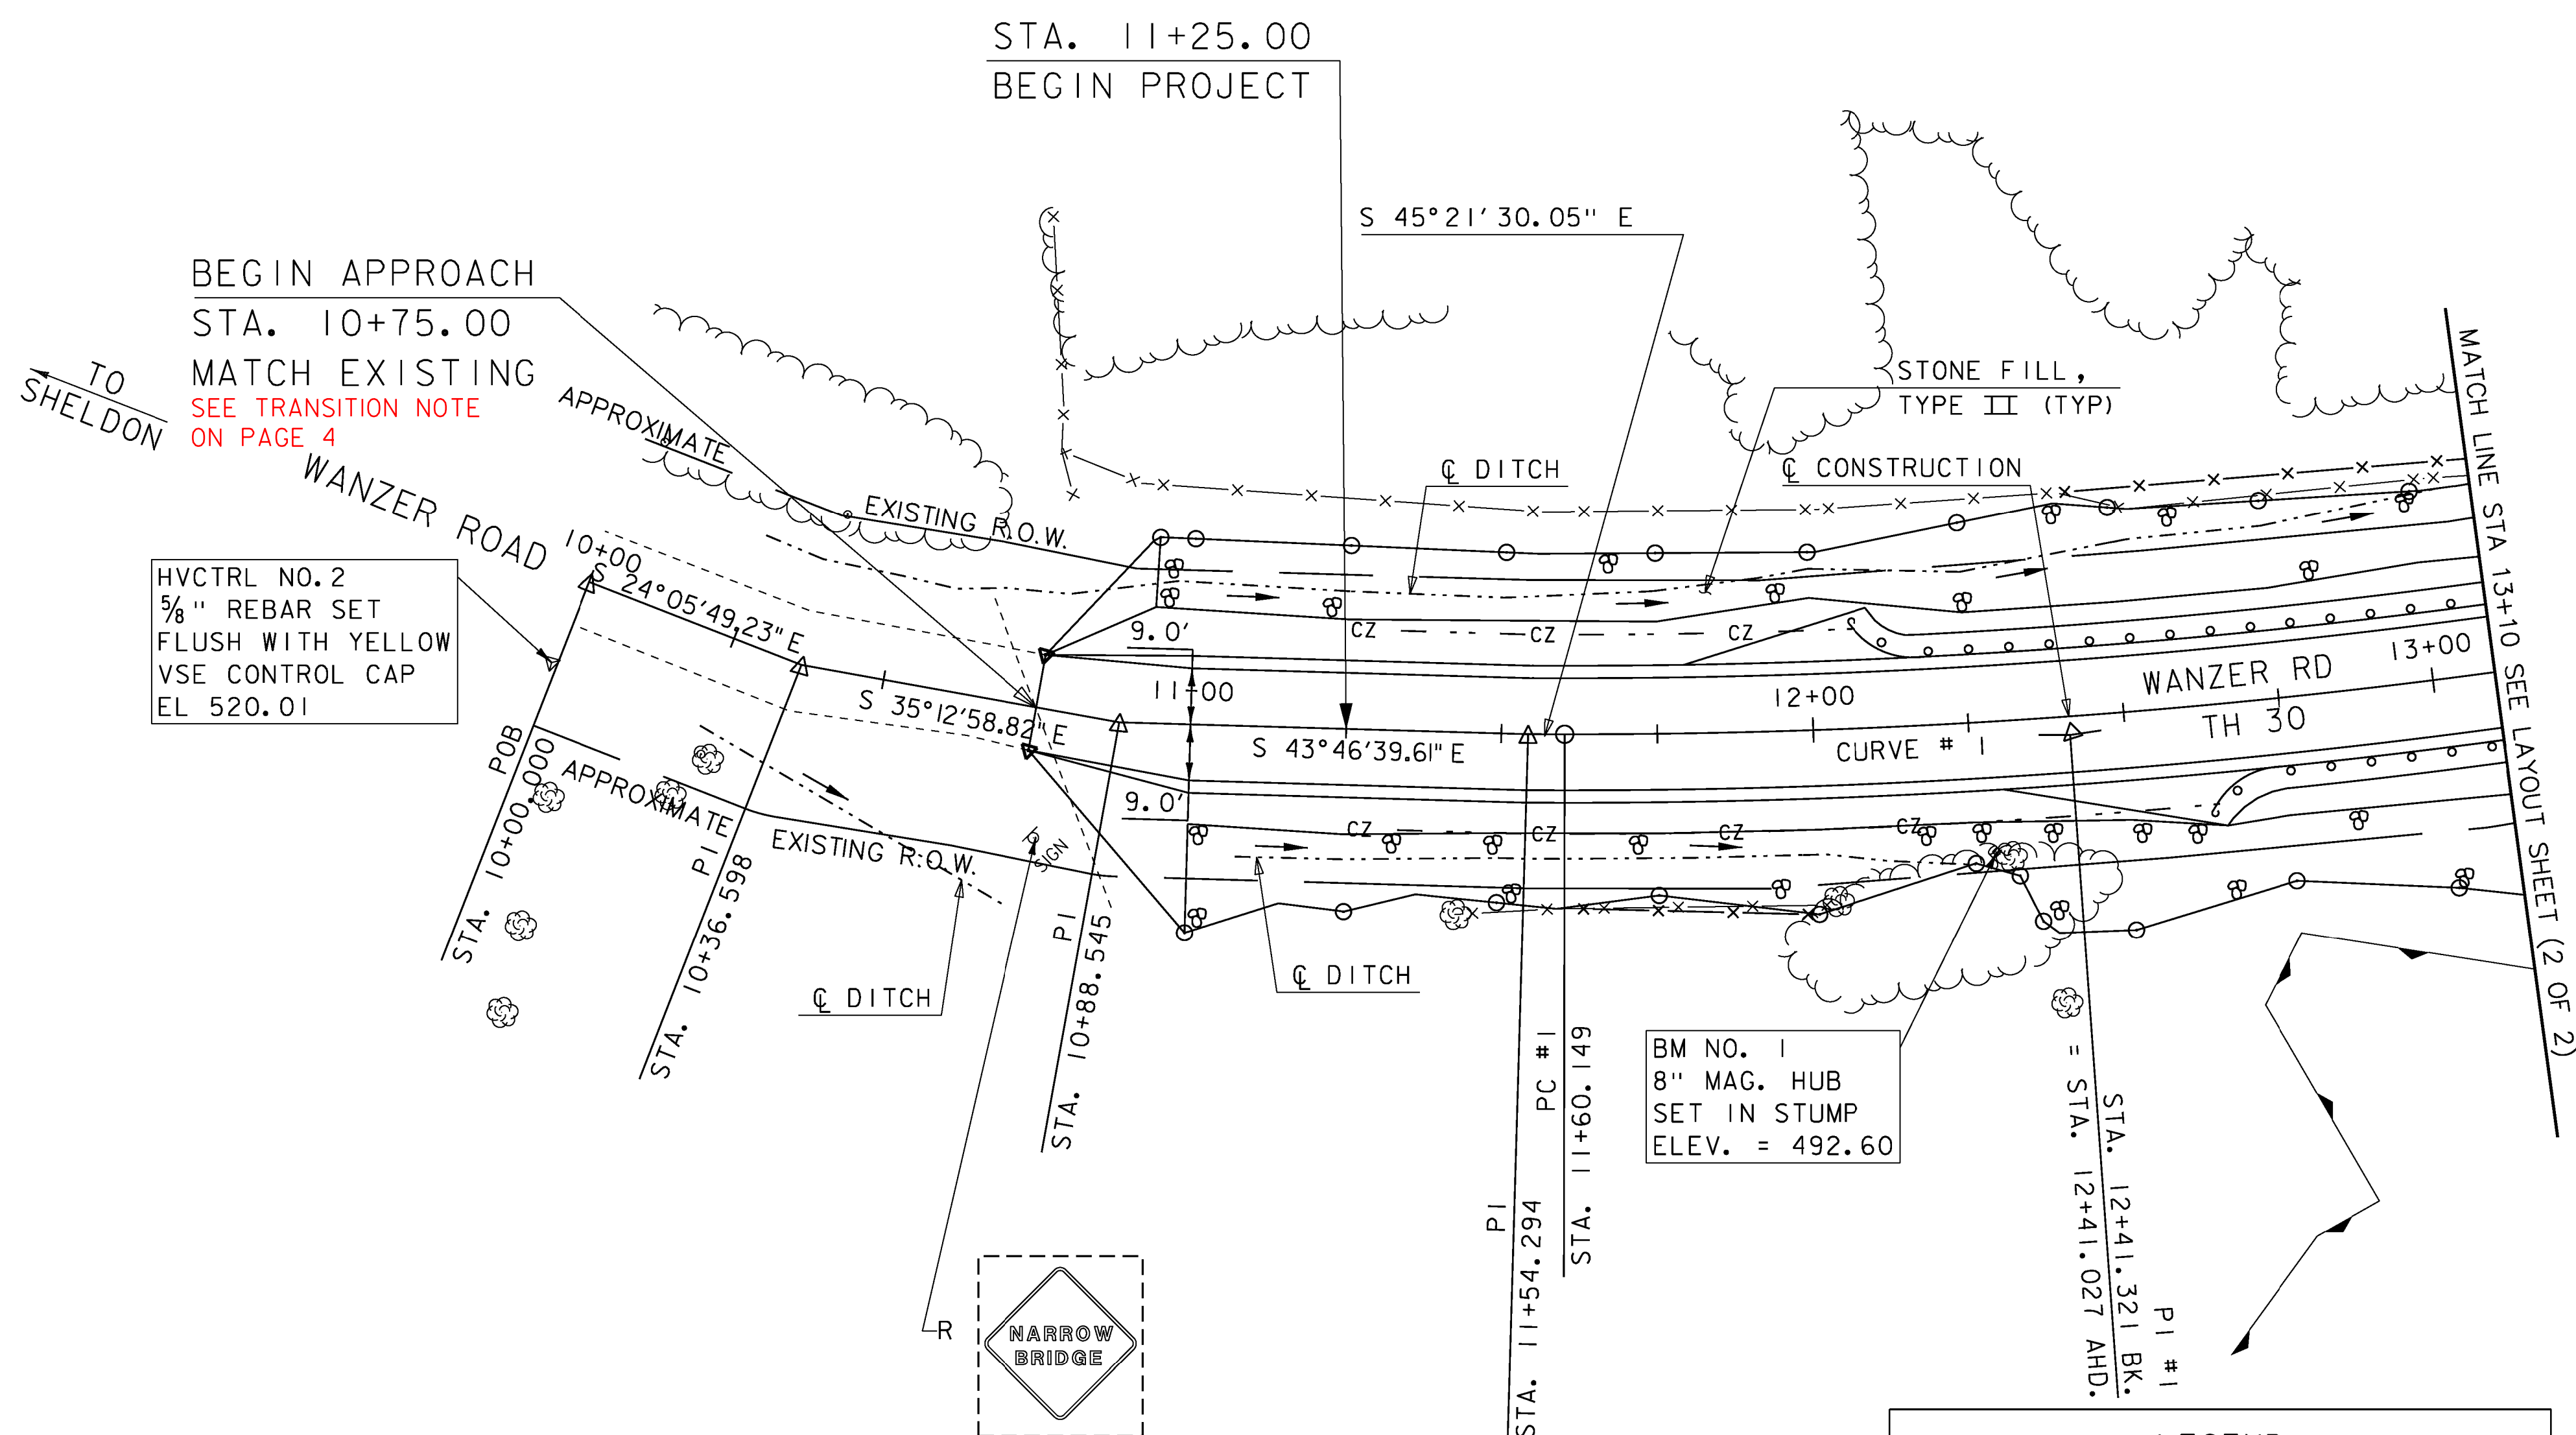

HVCTRL NO. 2  
 5/8" REBAR SET  
 FLUSH WITH YELLOW  
 VSE CONTROL CAP  
 EL 520.01

BM NO. 1  
 8" MAG. HUB  
 SET IN STUMP  
 ELEV. = 492.60

**LEGEND**

- x-x-x-x RELOCATED FENCE
- cz - - - CLEAR ZONE
- - - - - C DITCH
- R [ ] REMOVE EXISTING SIGNS AND POSTS (SALVAGE TO TOWN)

**REMOVING AND RESETTING FENCE**  
 STA. 12+41.00 LT. TO STA. 13+68.00 LT.  
 STA. 11+61.00 RT. TO STA. 12+00.00 RT.

**LAYOUT SHEET 1**  
 SCALE 1" = 20'-0"  
 20 0 20



PROJECT NAME: FAIRFIELD  
 PROJECT NUMBER: BRO 1448(38)  
 FILE NAME: z11j072bdr\_nu\_01  
 PROJECT LEADER: D. LANDRY  
 DESIGNED BY: M. VALLETTA  
 LAYOUT SHEET (1 OF 2)

PLOT DATE: 01-NOV-2013  
 DRAWN BY: M. VALLETTA  
 CHECKED BY: T. KENDRICK  
 SHEET 10 OF 41